


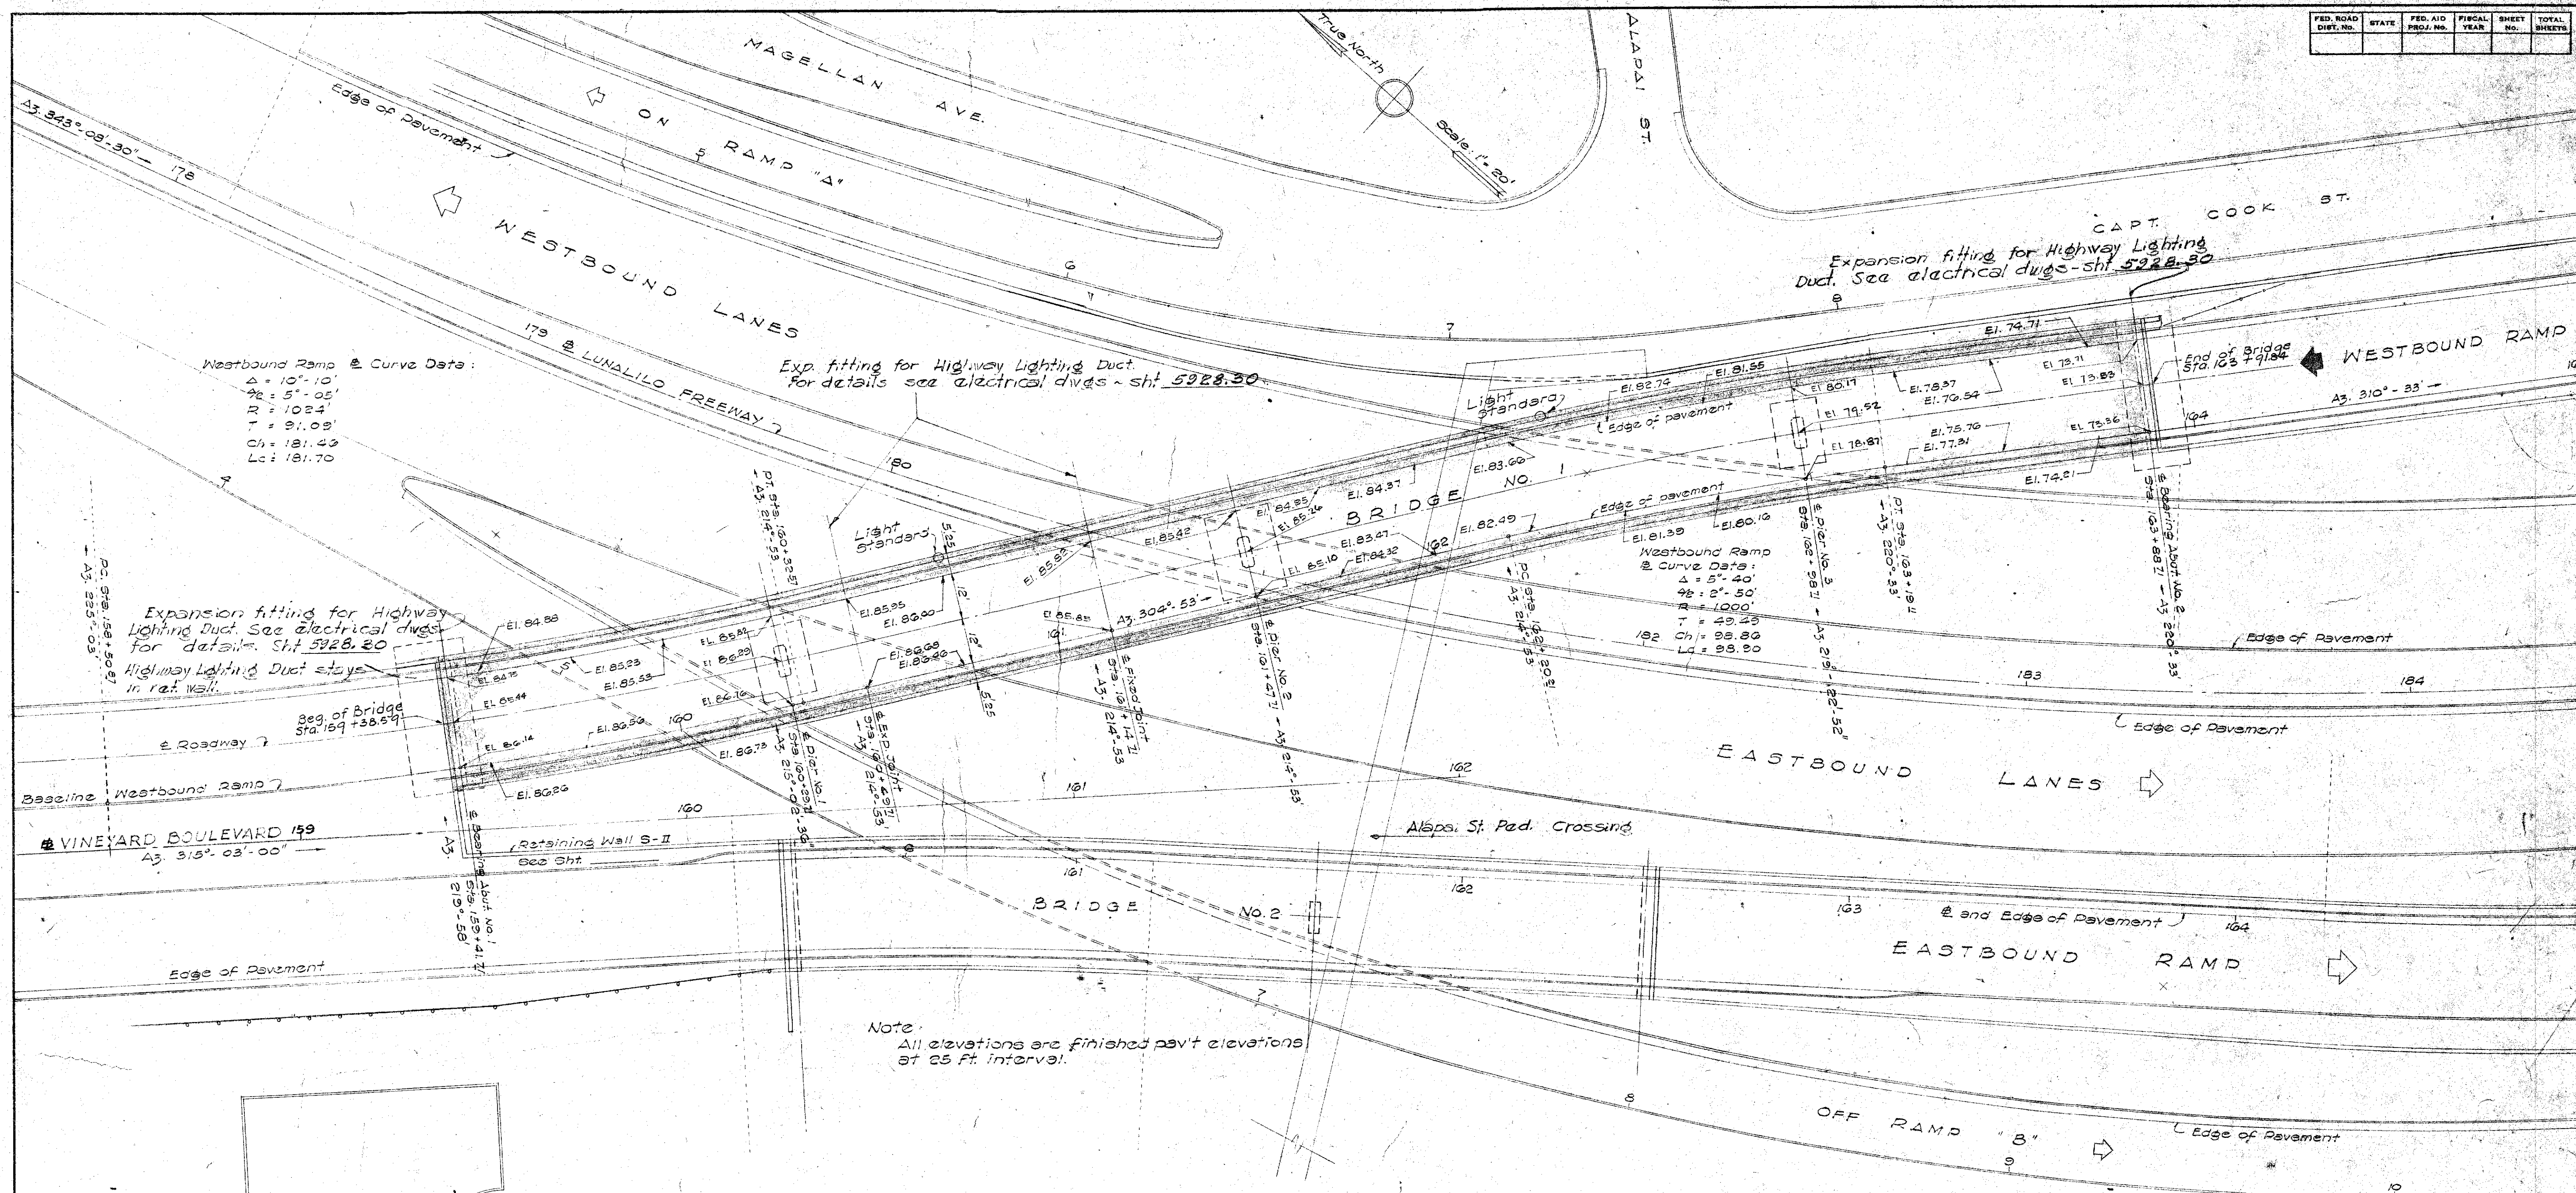

Note:
All elevations are finished pav't elevations
at 25 ft. interval.

LAYOUT PLAN
Scale: 1" = 20'



ESTIMATED QUANTITIES

CONCRETE INCLUDING PARAPETS	LUMP SUM
REINFORCING STEEL	LUMP SUM
STRUCTURAL EXCAVATION	882 CU YDS
A.C. MIX NO. IV	76.3 TONS
FILTER MATERIAL	97.2 CU YDS
TACK COAT	30 @ 2 GALS
ALUMINUM RAILING	895 L.F.

GENERAL NOTES:

- I. Design Data:
 - (1) H20-S-12-44
 - (2) $f_s = 20,000$ PSI
 - (3) $f_c = 1,200$ PSI
 - (4) $n = 10$
 - (5) Special concrete for columns see note on Sht. No. 3
- II. Construction Methods
 - (1) Backfill behind abutments & wingwalls shall be complete in place before pouring concrete for the superstructure.
 - (2) Curbs and parapets shall not be poured until after release of false work.
 - (3) Finish - See Standard Specifications.
 - (4) Form - Forms for bottom slab of box girders shall be 5 ply panel board.
 - (5) Footings to be poured neat against soil.

DATE	
SURVEY PLOTTED BY	
DESIGNED BY	
DRAWN BY	
QUANTITIES CHECKED BY	
NOTE BOOK NO.	

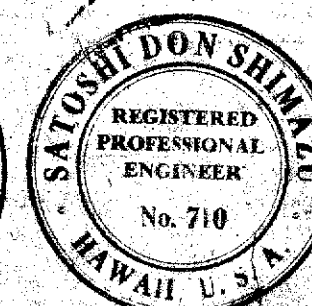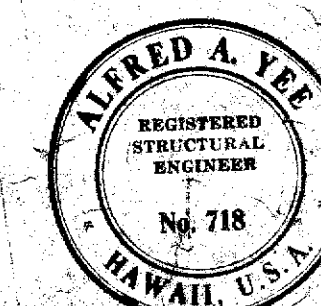


STATE OF HAWAII
DEPARTMENT OF TRANSPORTATION
HIGHWAYS DIVISION

BRIDGE No. 1

Base Line Sta. 159+38.55 To Sta. 163+91.335

VINEYARD BOULEVARD
PROJECT NO. F-008-1-(3)








FED. ROAD DIST. NO.	STATE	FED. AID PROJ. NO.	FISCAL YEAR	SHEET NO.	TOTAL SHEETS

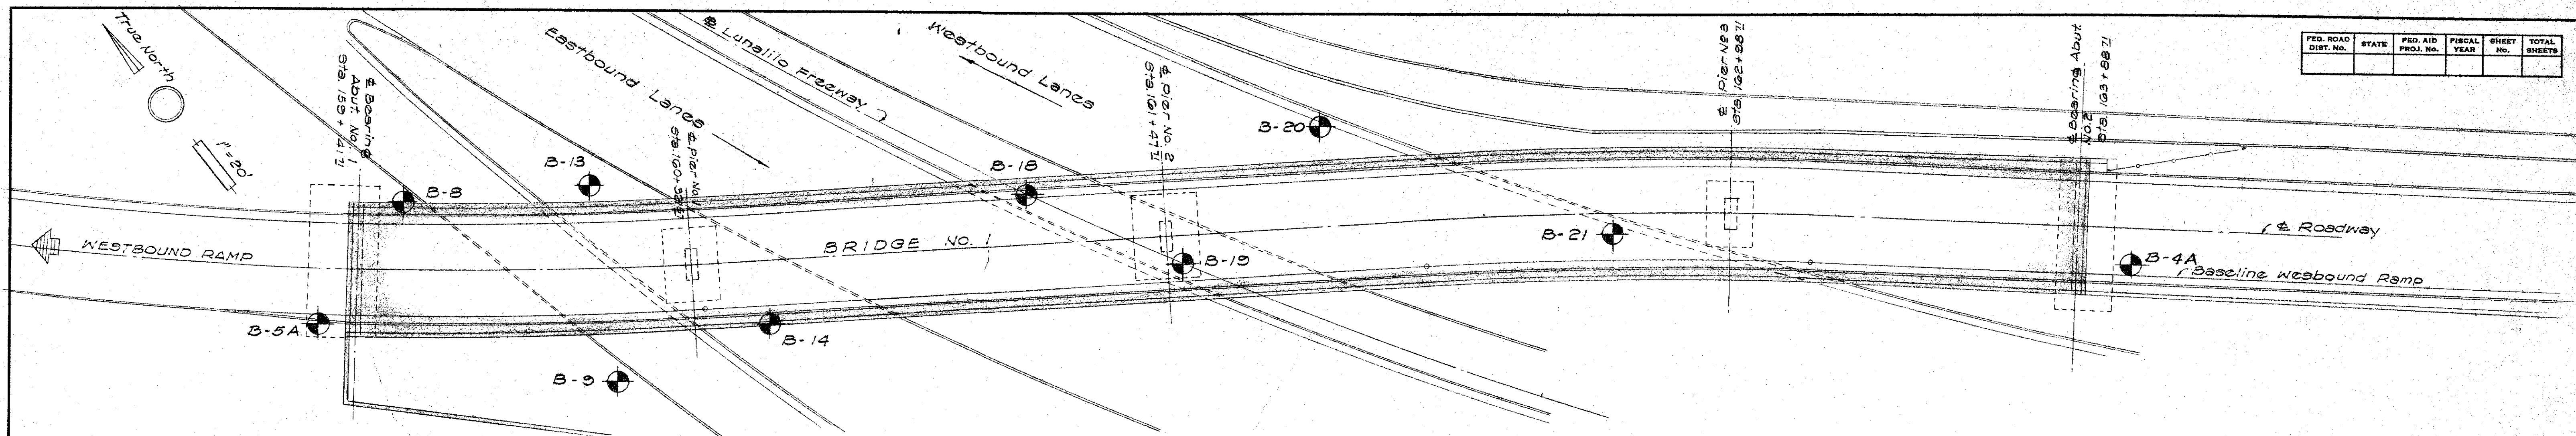

BORING LOCATION PLAN

Scale: 1" = 20'

* NOTE: Punchbowl tuff as used in these plans stands for "cemented volcanic ejecta" including fines up to boulders.
Barf Hirasima

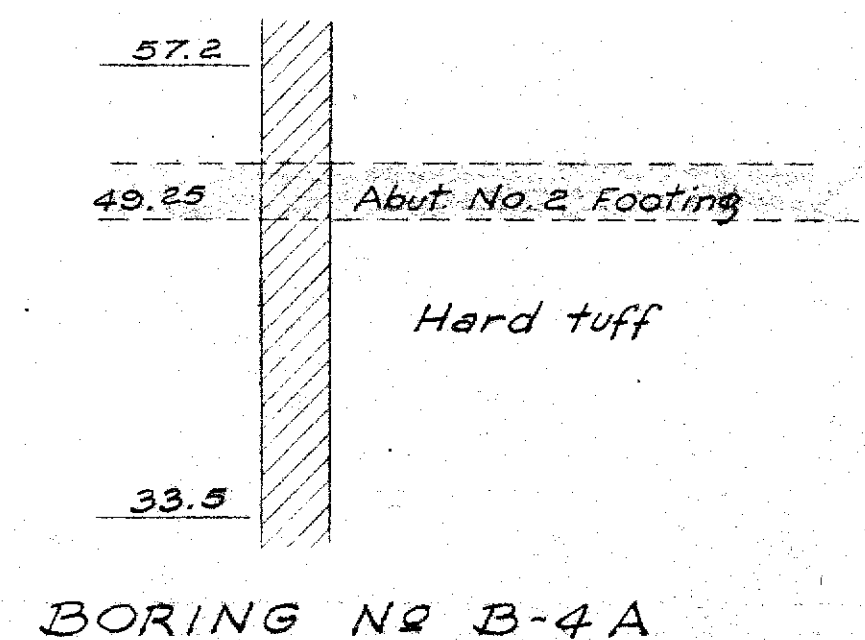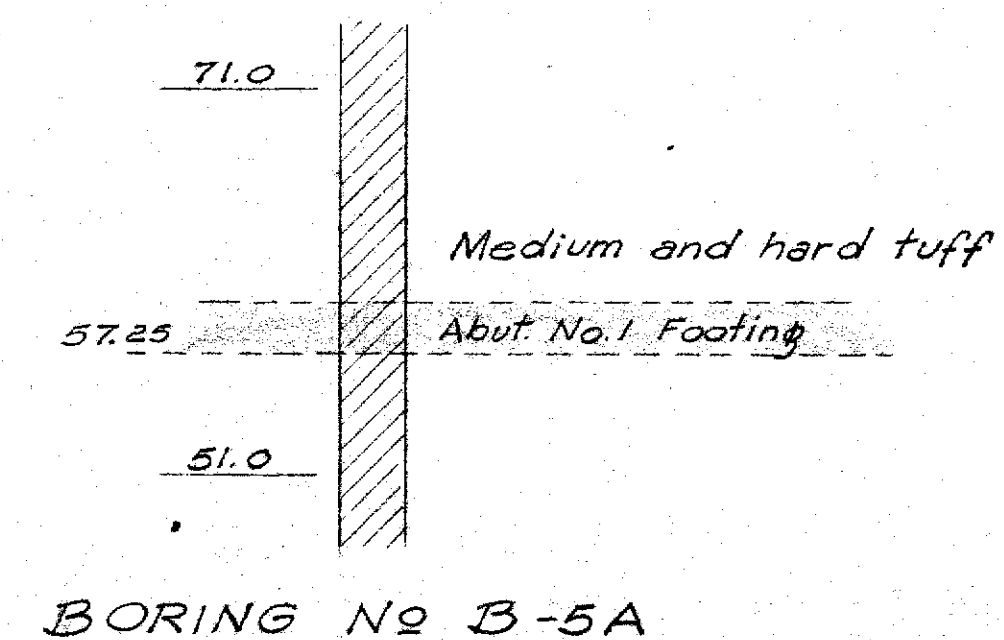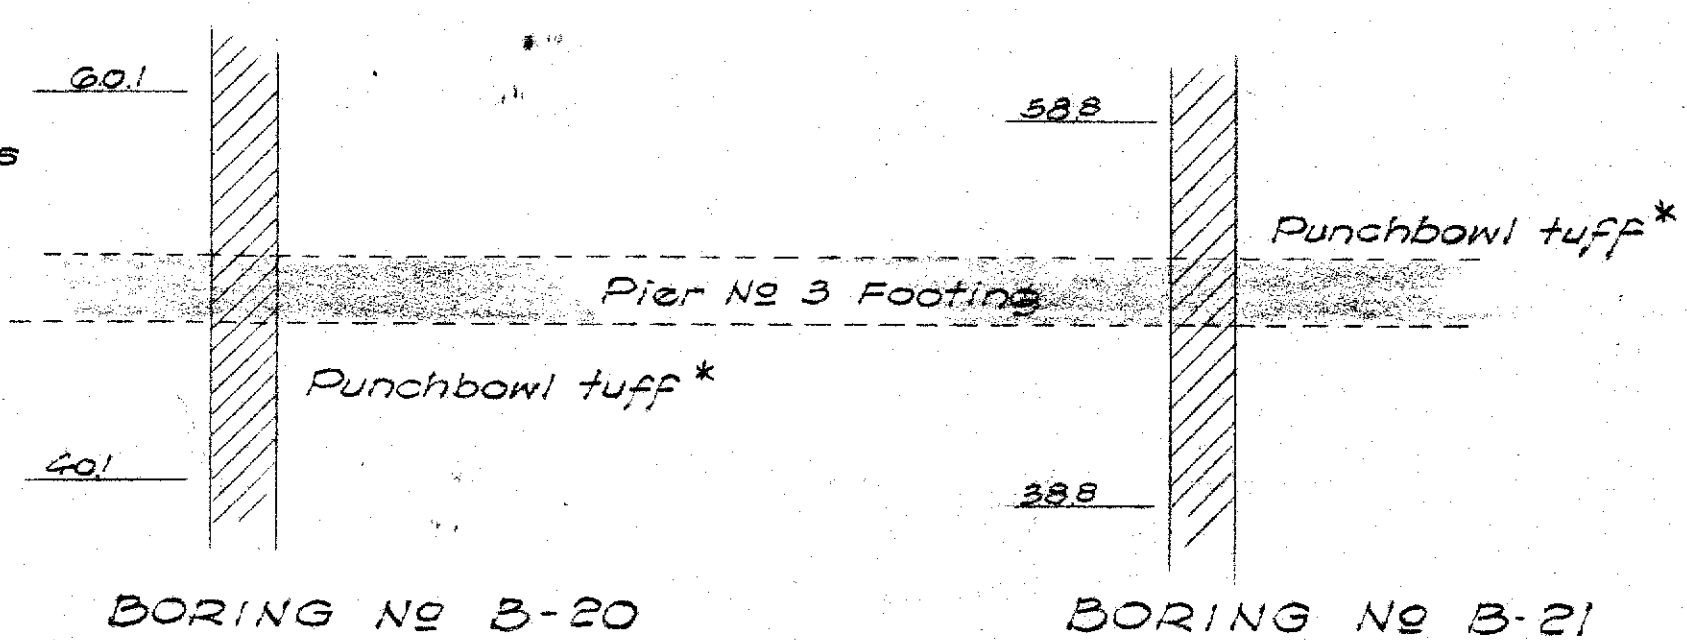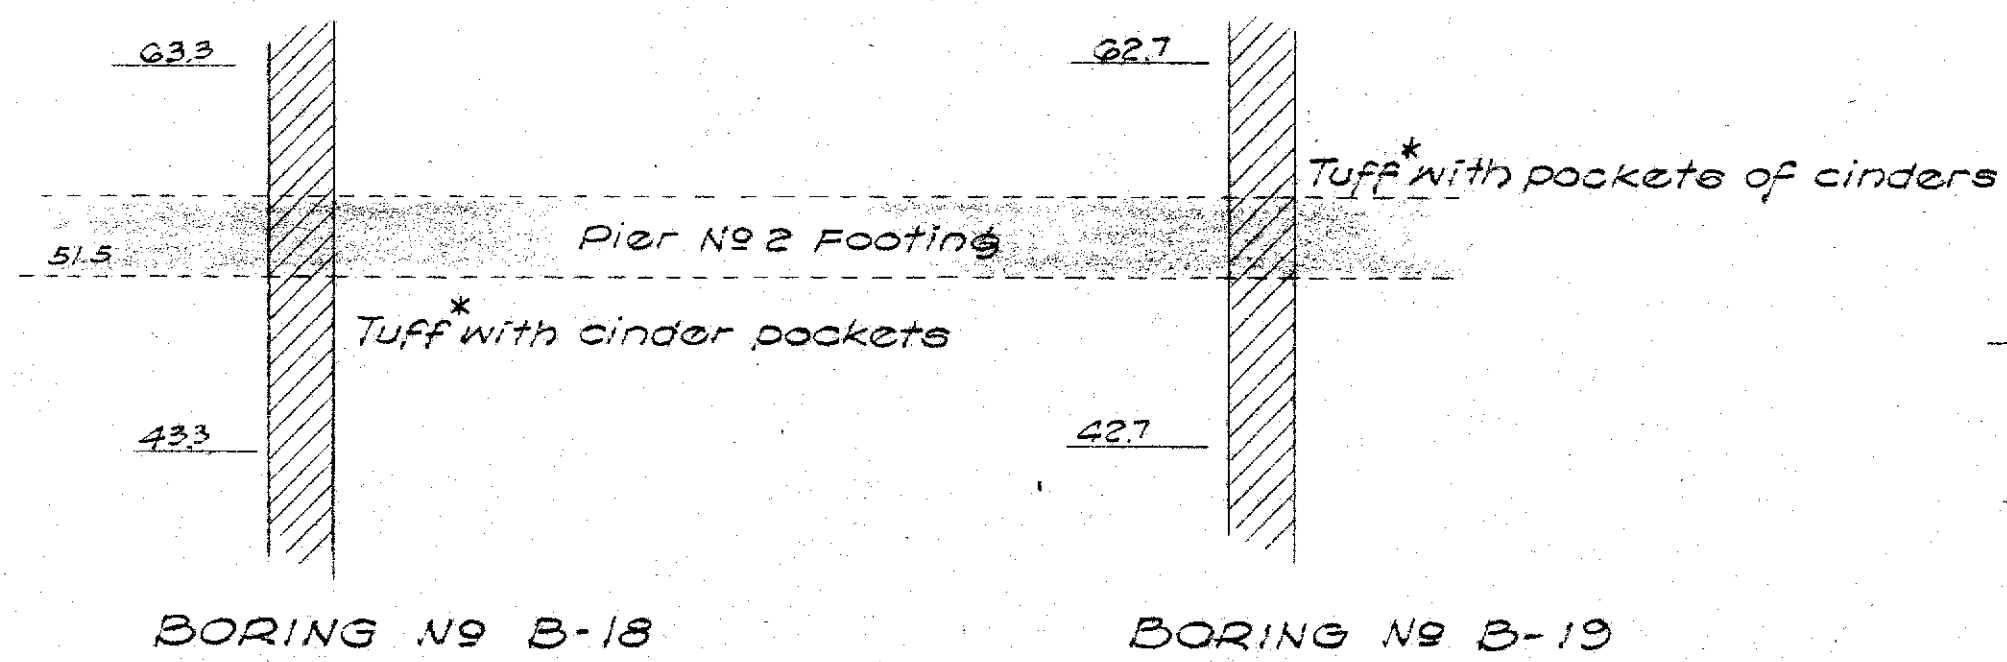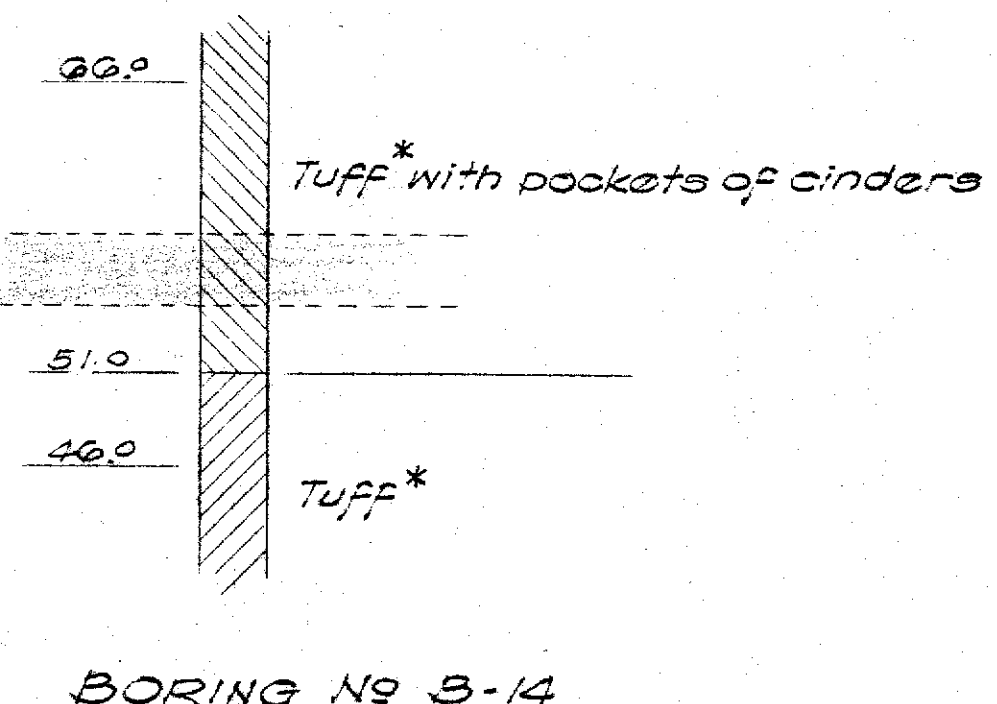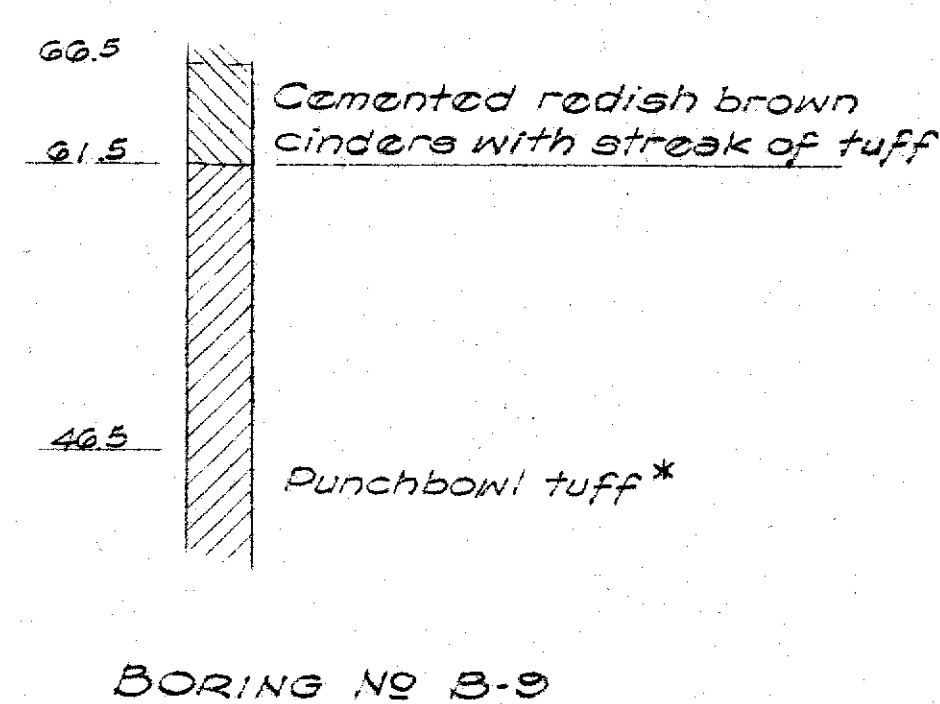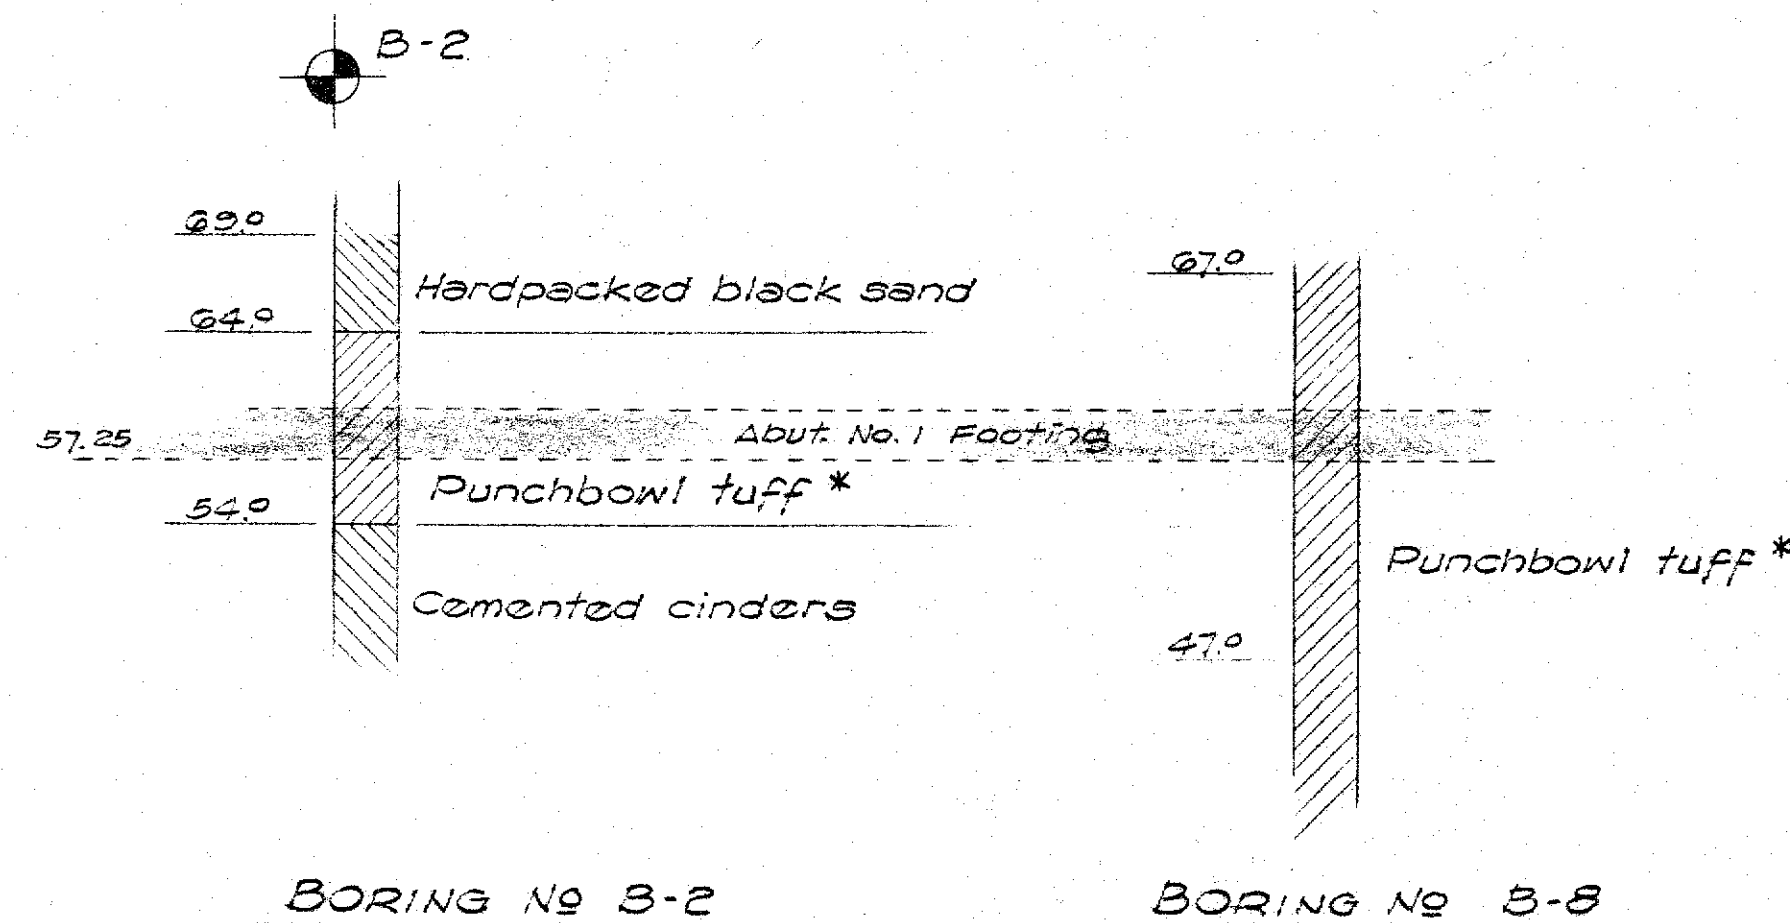

BORING DATA

Scale: 1" = 10'



SURVEY PLOTTED BY	DATE
DESIGNED BY	
DRAWN BY	
QUANTITIES CHECKED BY	
NOTE BOOK	
NO.	

STATE OF HAWAII
DEPARTMENT OF TRANSPORTATION
HIGHWAYS DIVISION

BRIDGE No. 1

Base Line Sta. 159+38.25 to Sta. 163+00.00

VINEYARD BOULEVARD
PROJECT NO. F-098-1 (3)

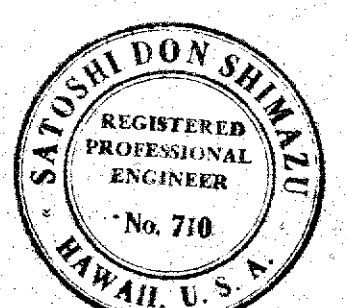
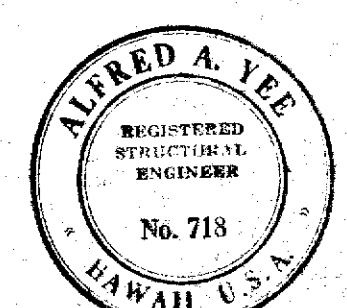


SHEET No. 2 OF 22 SHEETS







CONSULTANT SUBMISSION

5928.59


SURVEY PLOTTED BY	DATE
DESIGNED BY	
DRAWN BY	
QUANTITIES CHECKED BY	
NOTE BOOK	
NO.	

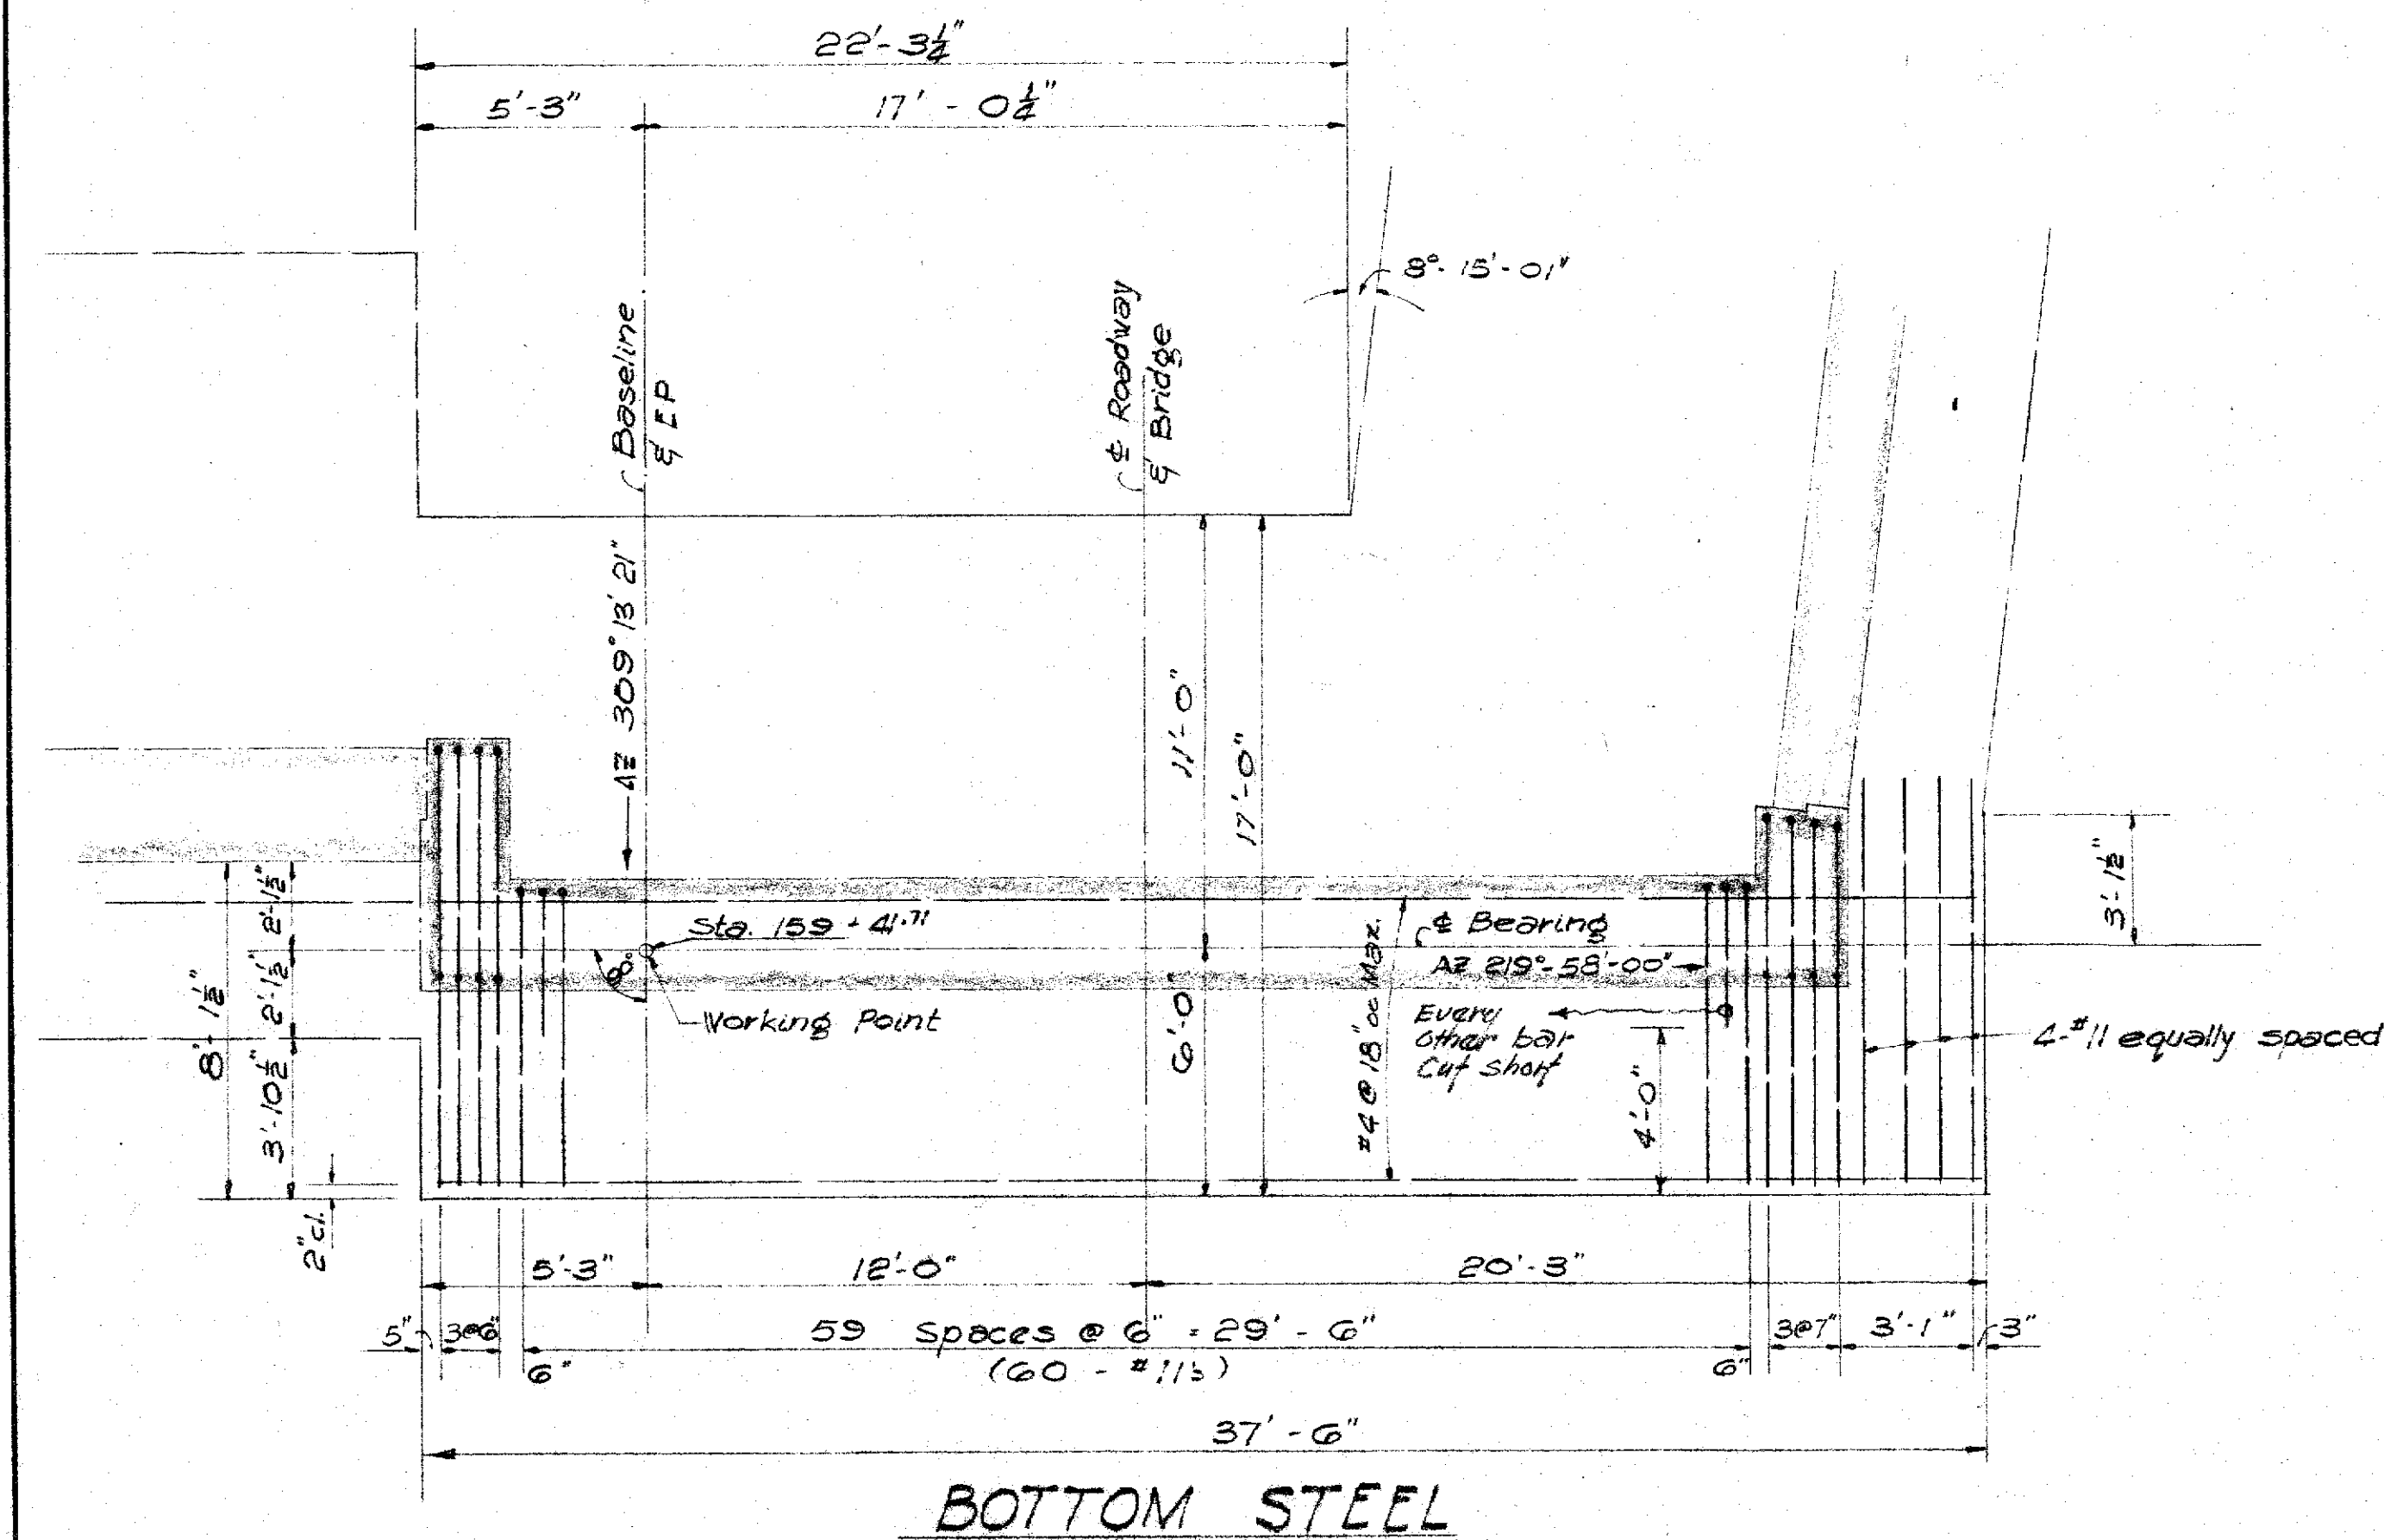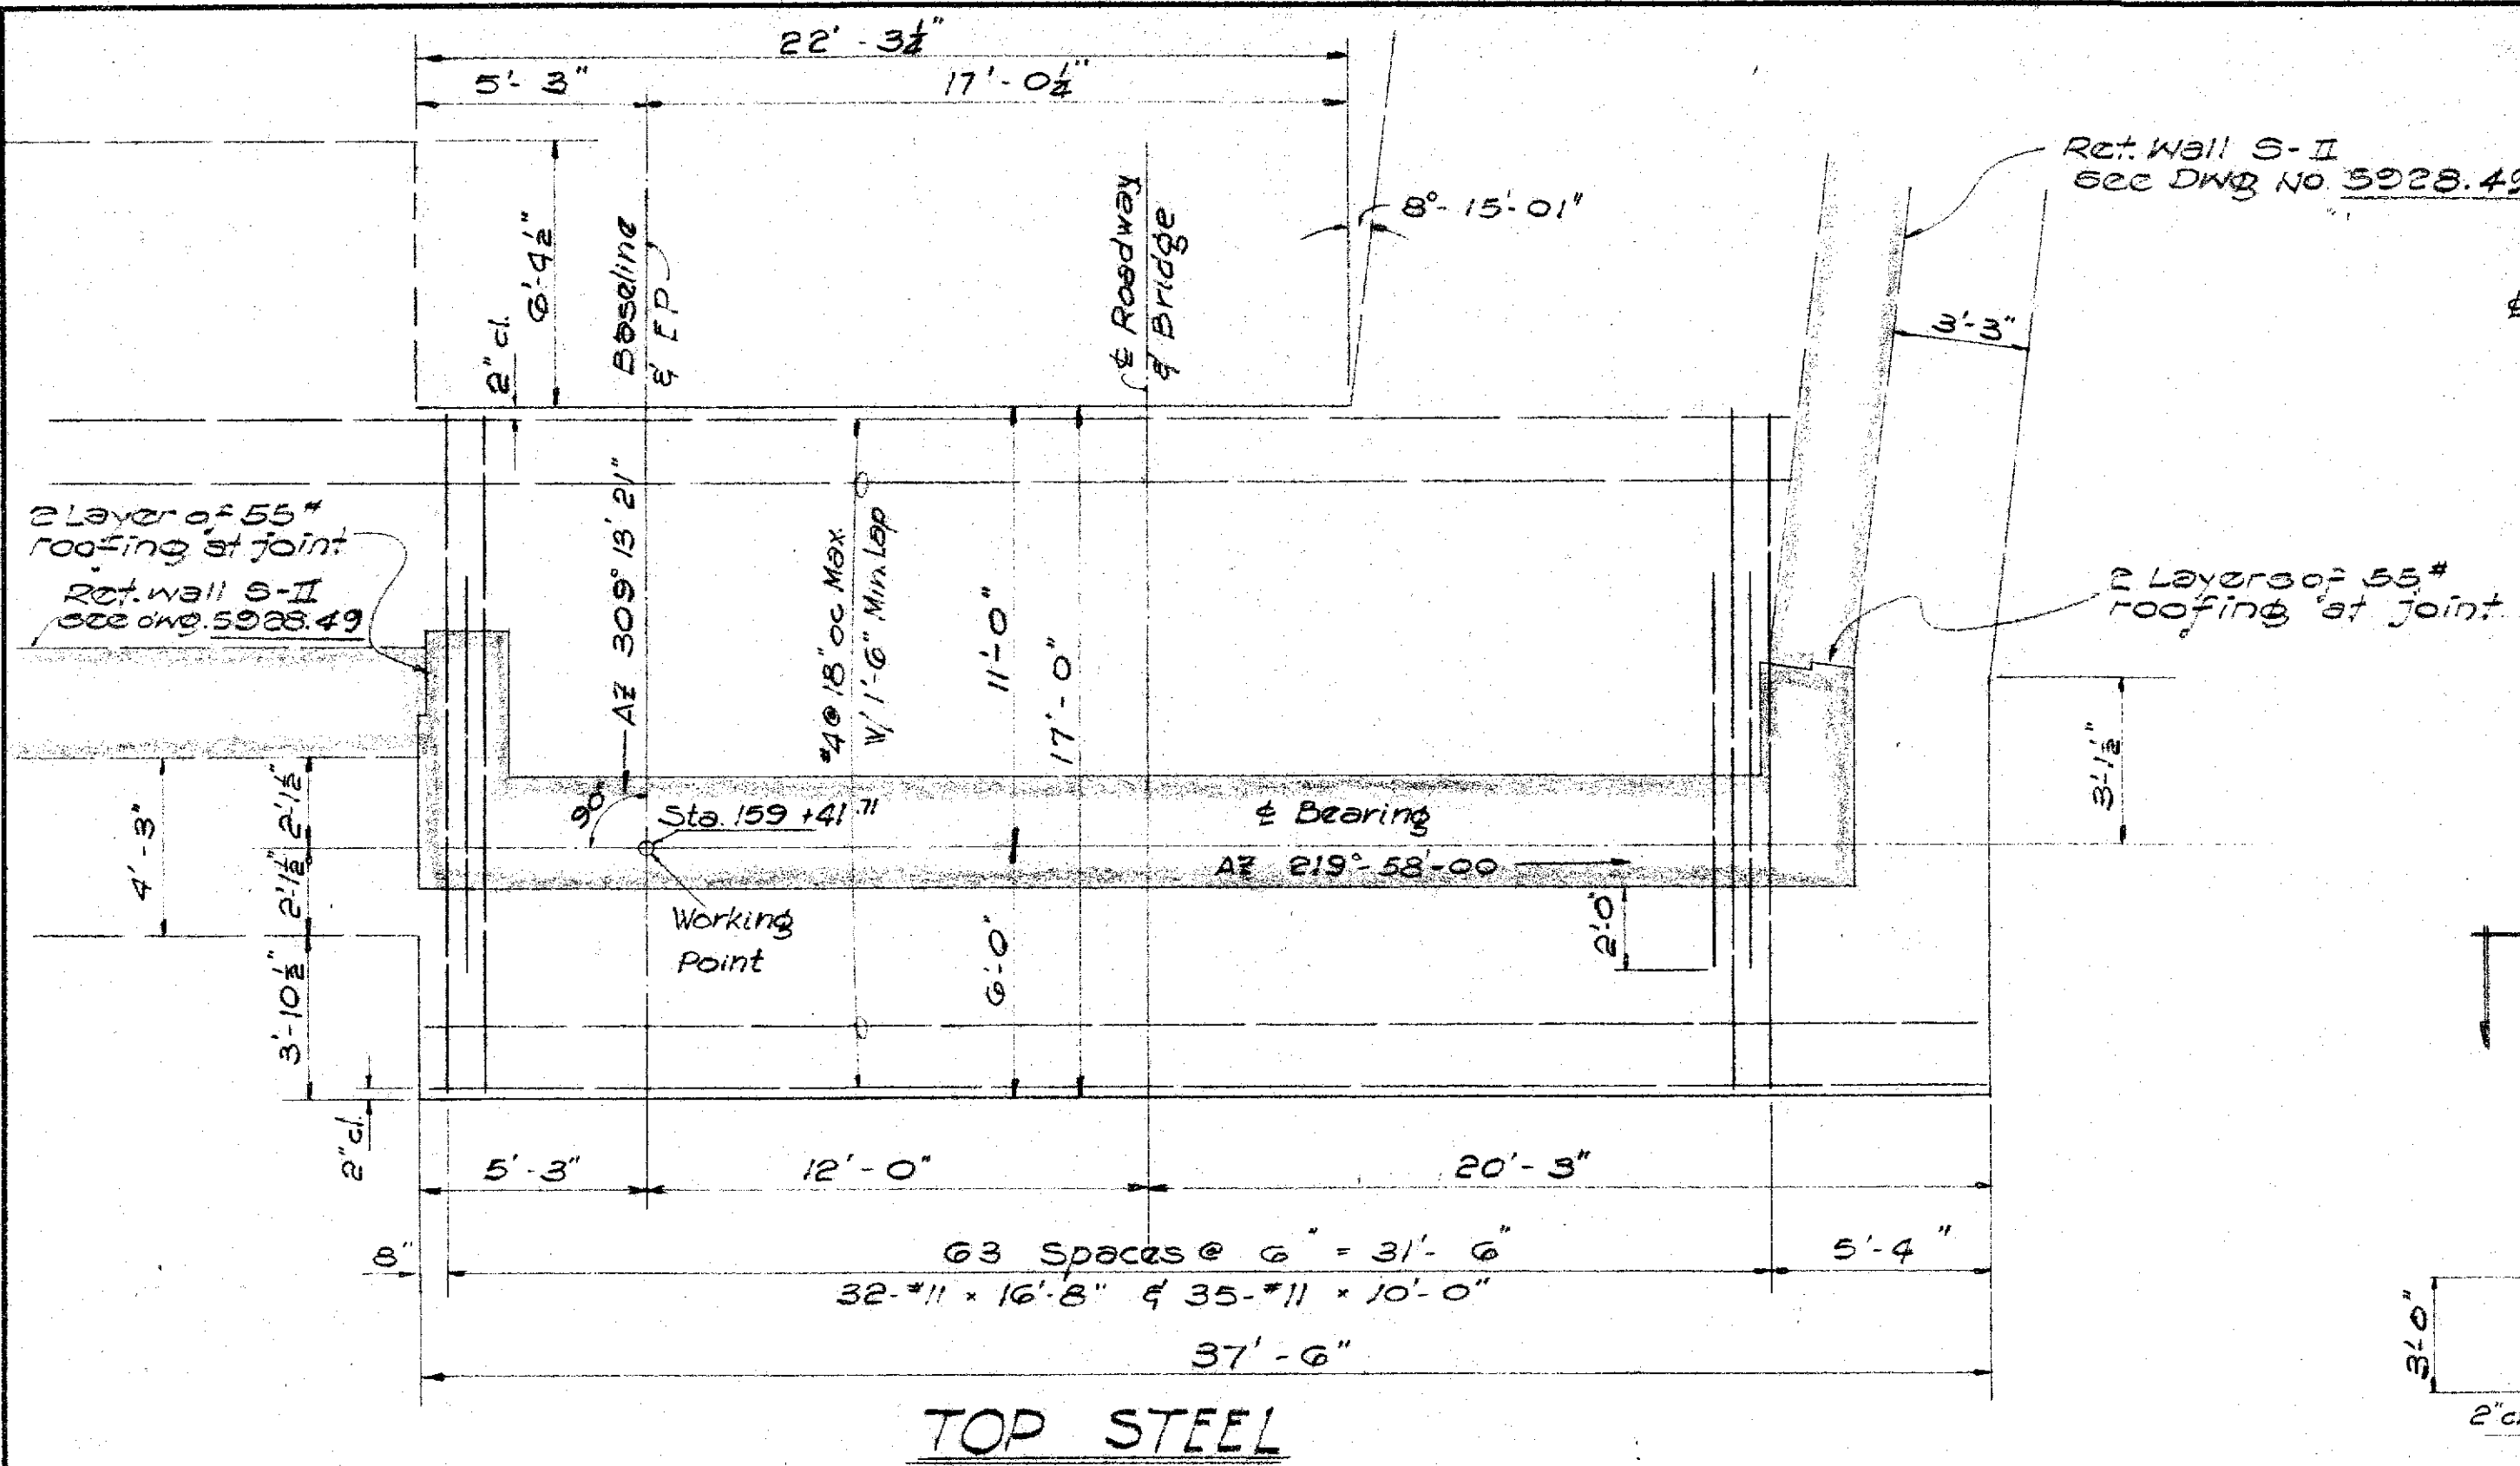

ABUTMENT NO 1 FOOTING STEEL PLAN




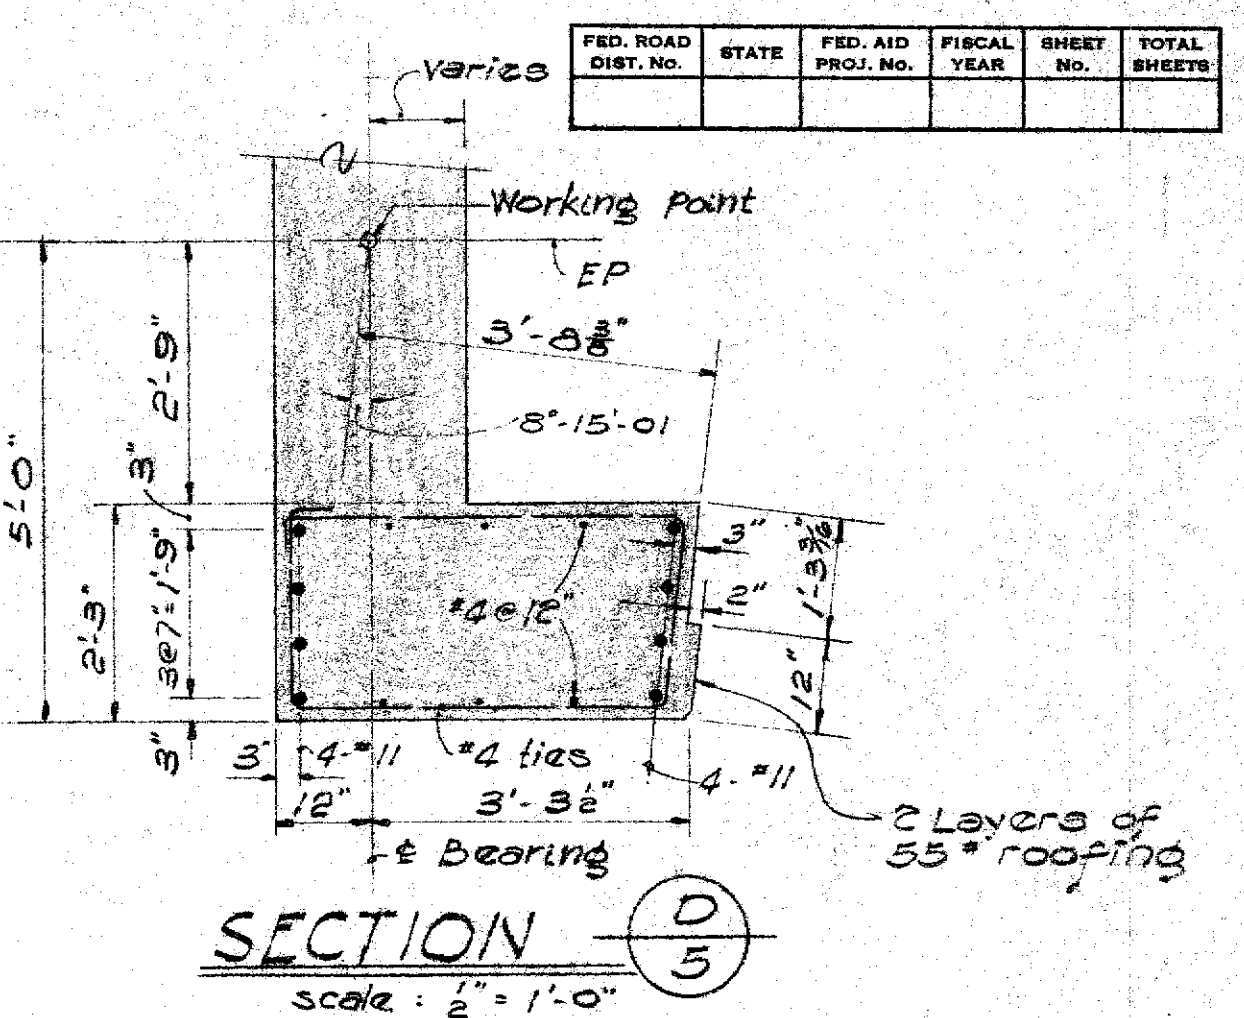
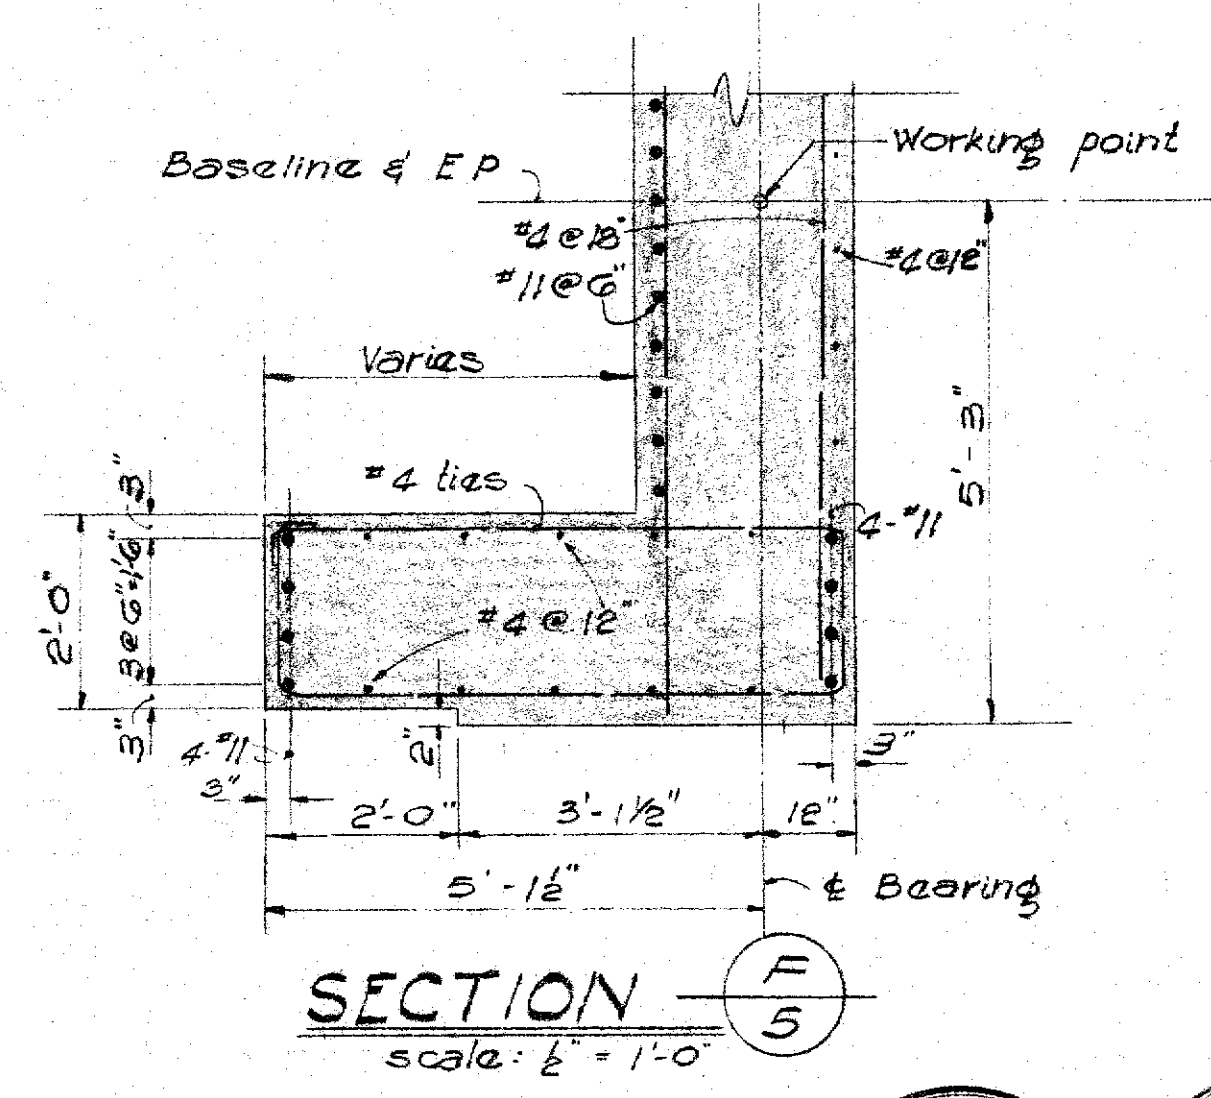
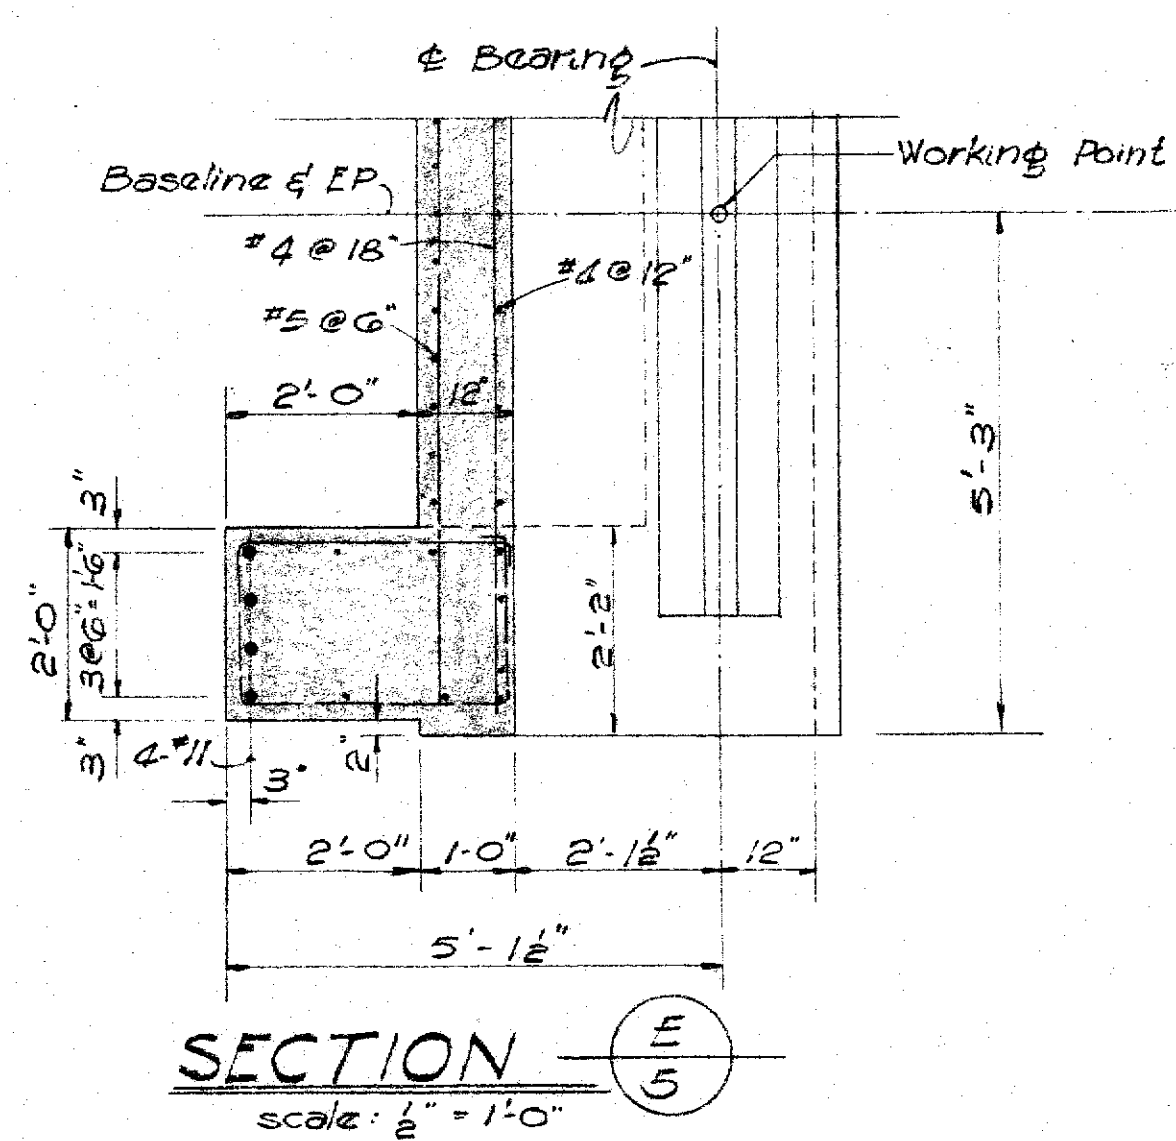
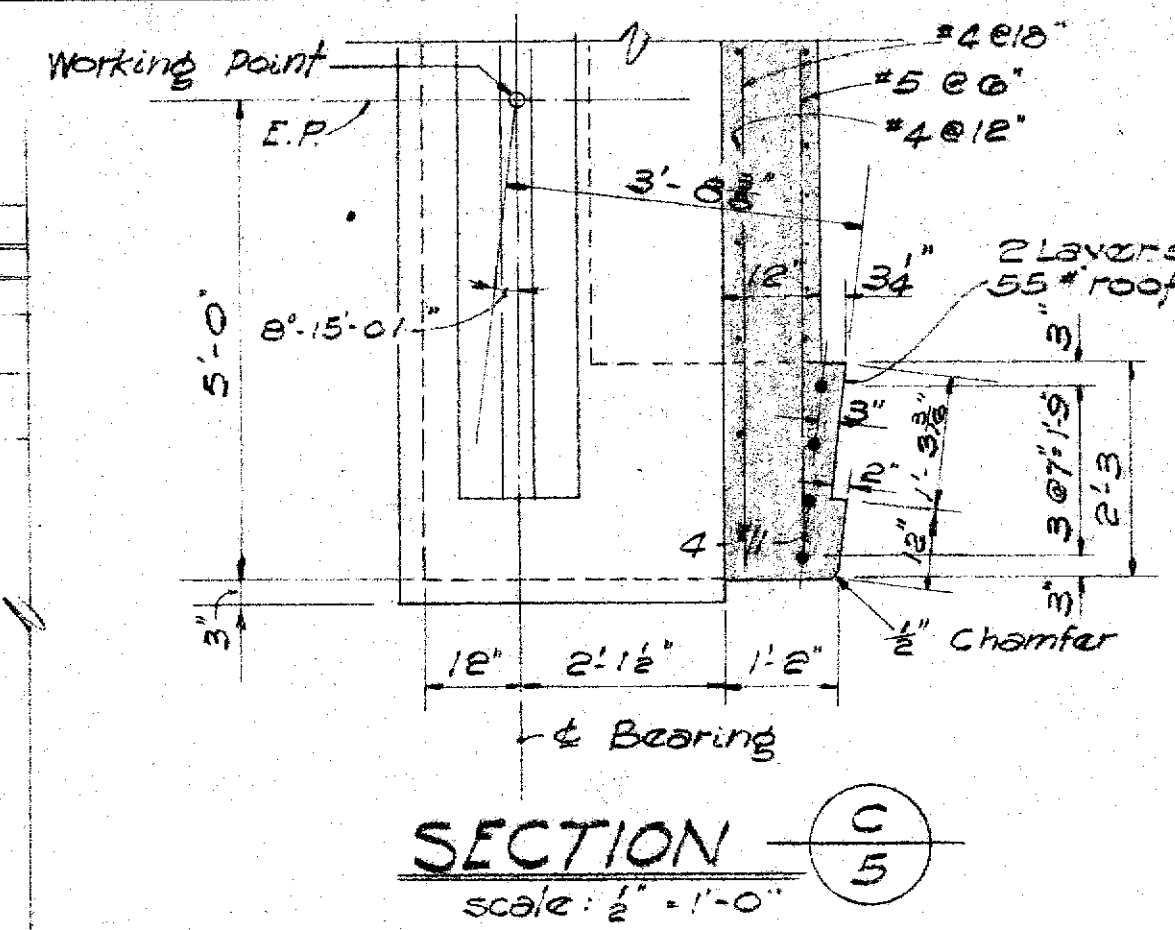
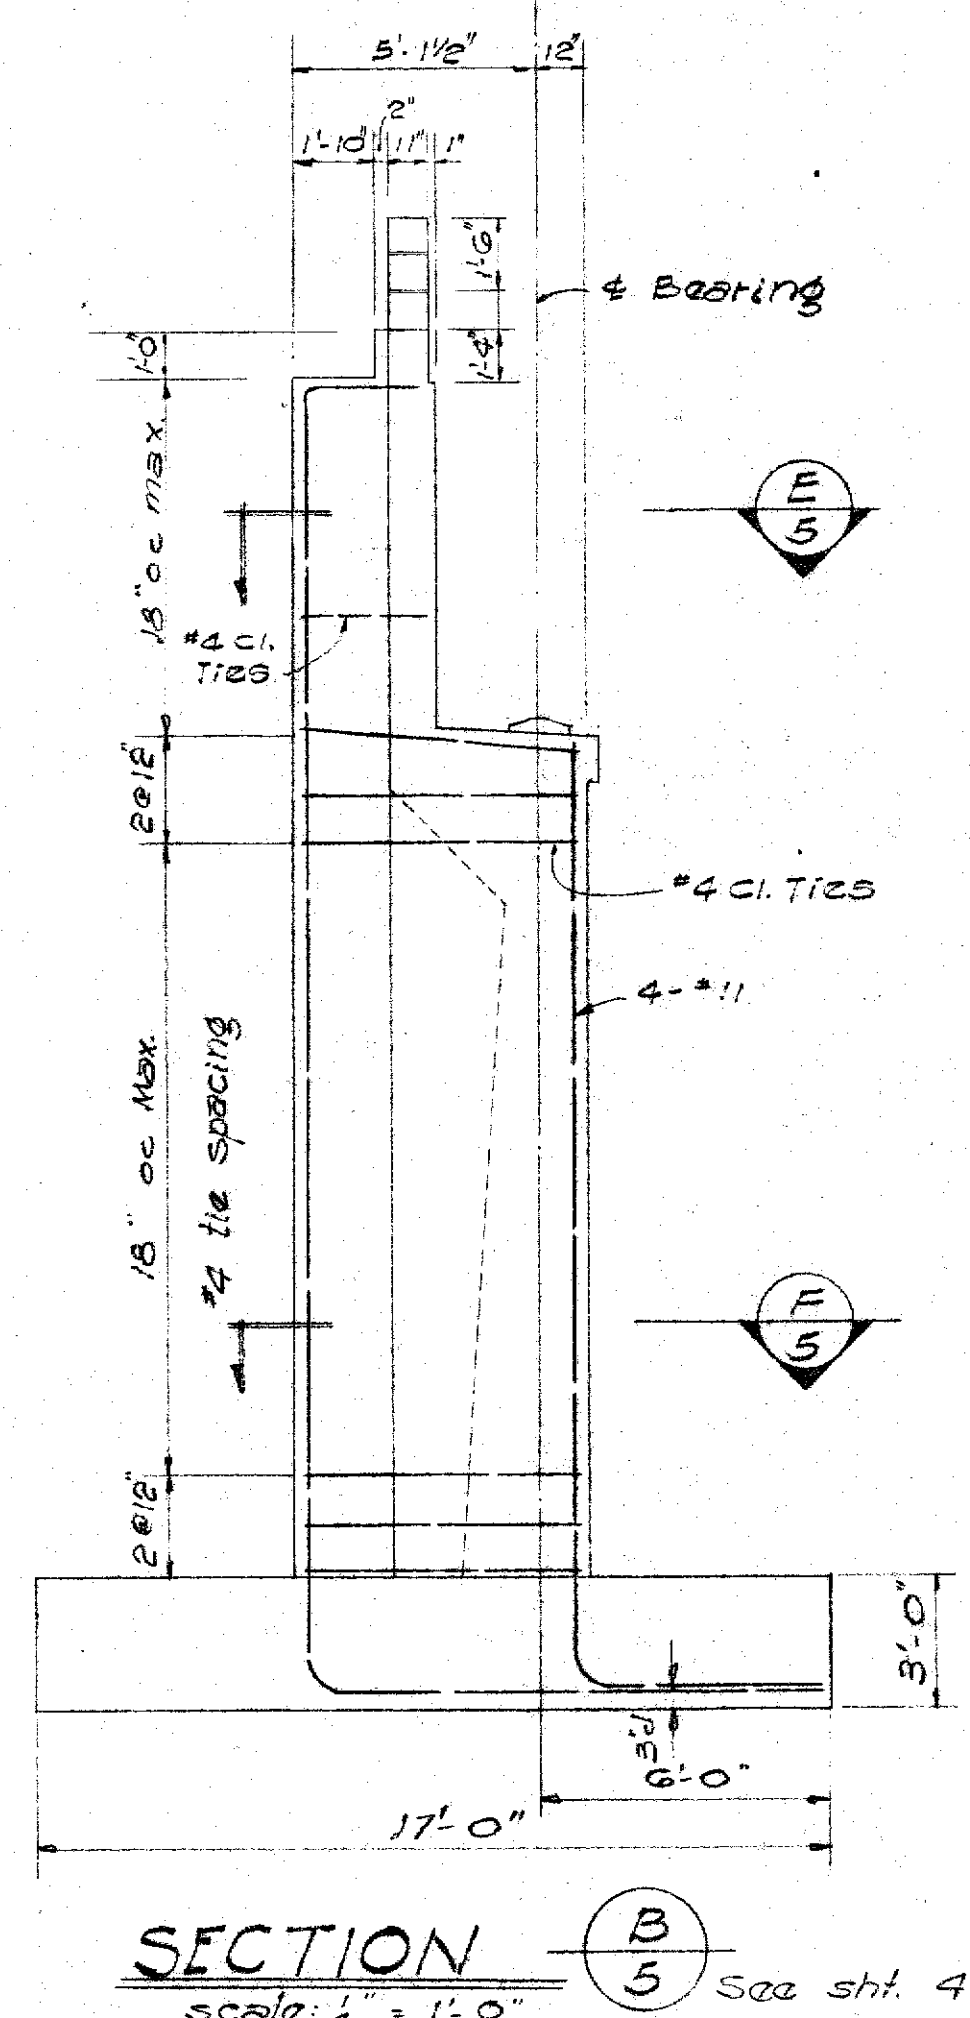
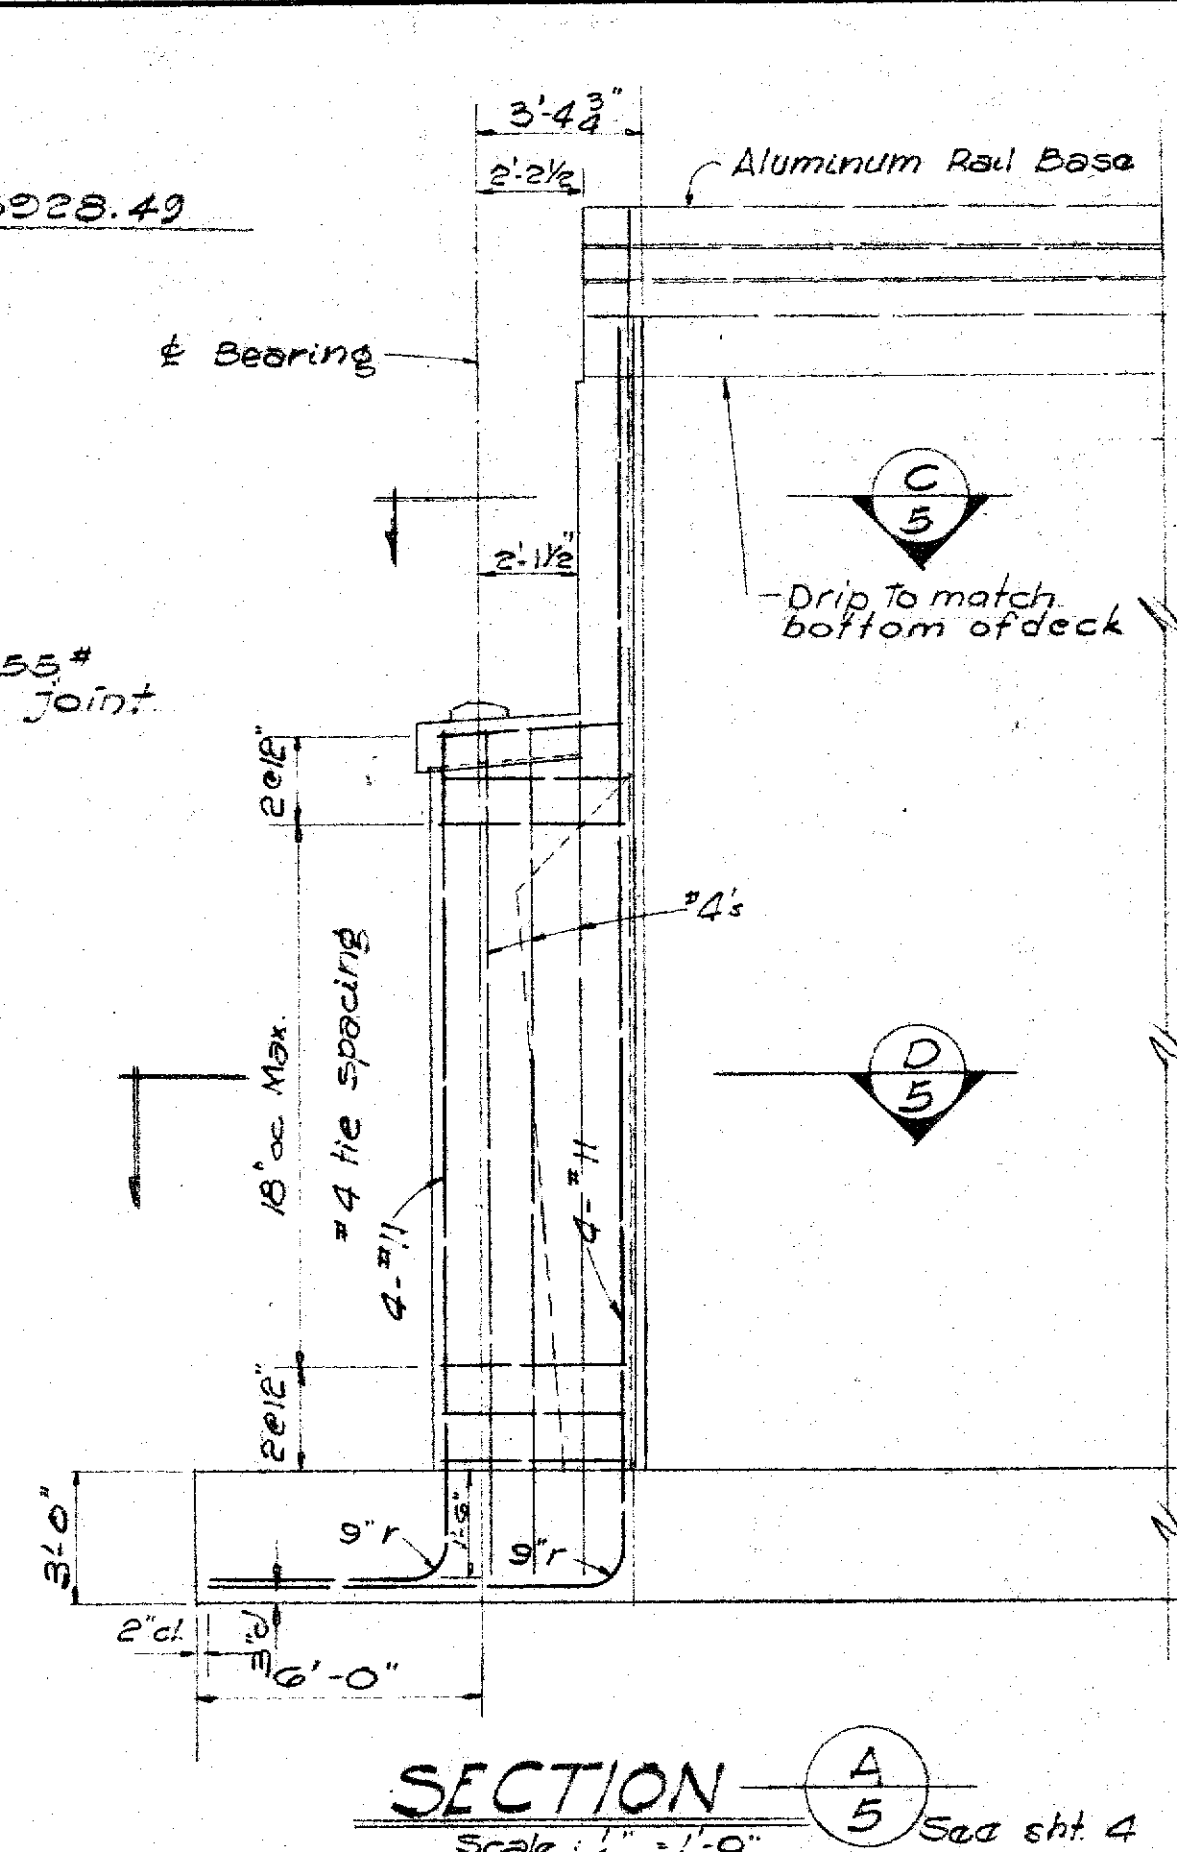


STATE OF HAWAII
DEPARTMENT OF TRANSPORTATION
HIGHWAYS DIVISION
BRIDGE No 1
Base Line Sta. 159+38.58 to Sta. 163+91.99
VINEYARD BOULEVARD
PROJECT NO. F-028-1-(3)

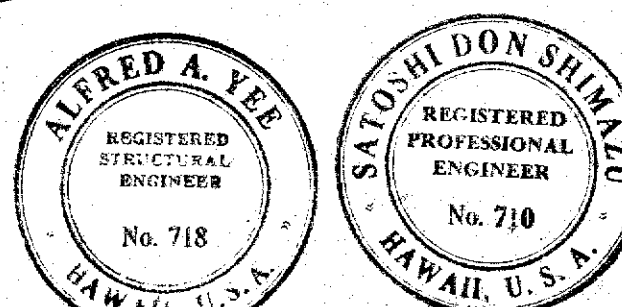

ORIGINAL	SURVEY PLOTTED BY _____	DATE _____
PLAN	DESIGNED BY _____	" _____
	DRAWN BY _____	" _____
NOTE BOOK	TRACED BY _____	" _____
	QUANTITIES BY _____	" _____
No. _____	QUANTITIES CHECKED BY _____	" _____
	CHECKED BY _____	" _____

SURVEY PLOTTED BY: _____
 DESIGNED BY: _____
 DRAWN BY: _____
 QUANTITIES BY: _____
 NOTE BOOK: _____
 CHECKED BY: _____
 No. _____

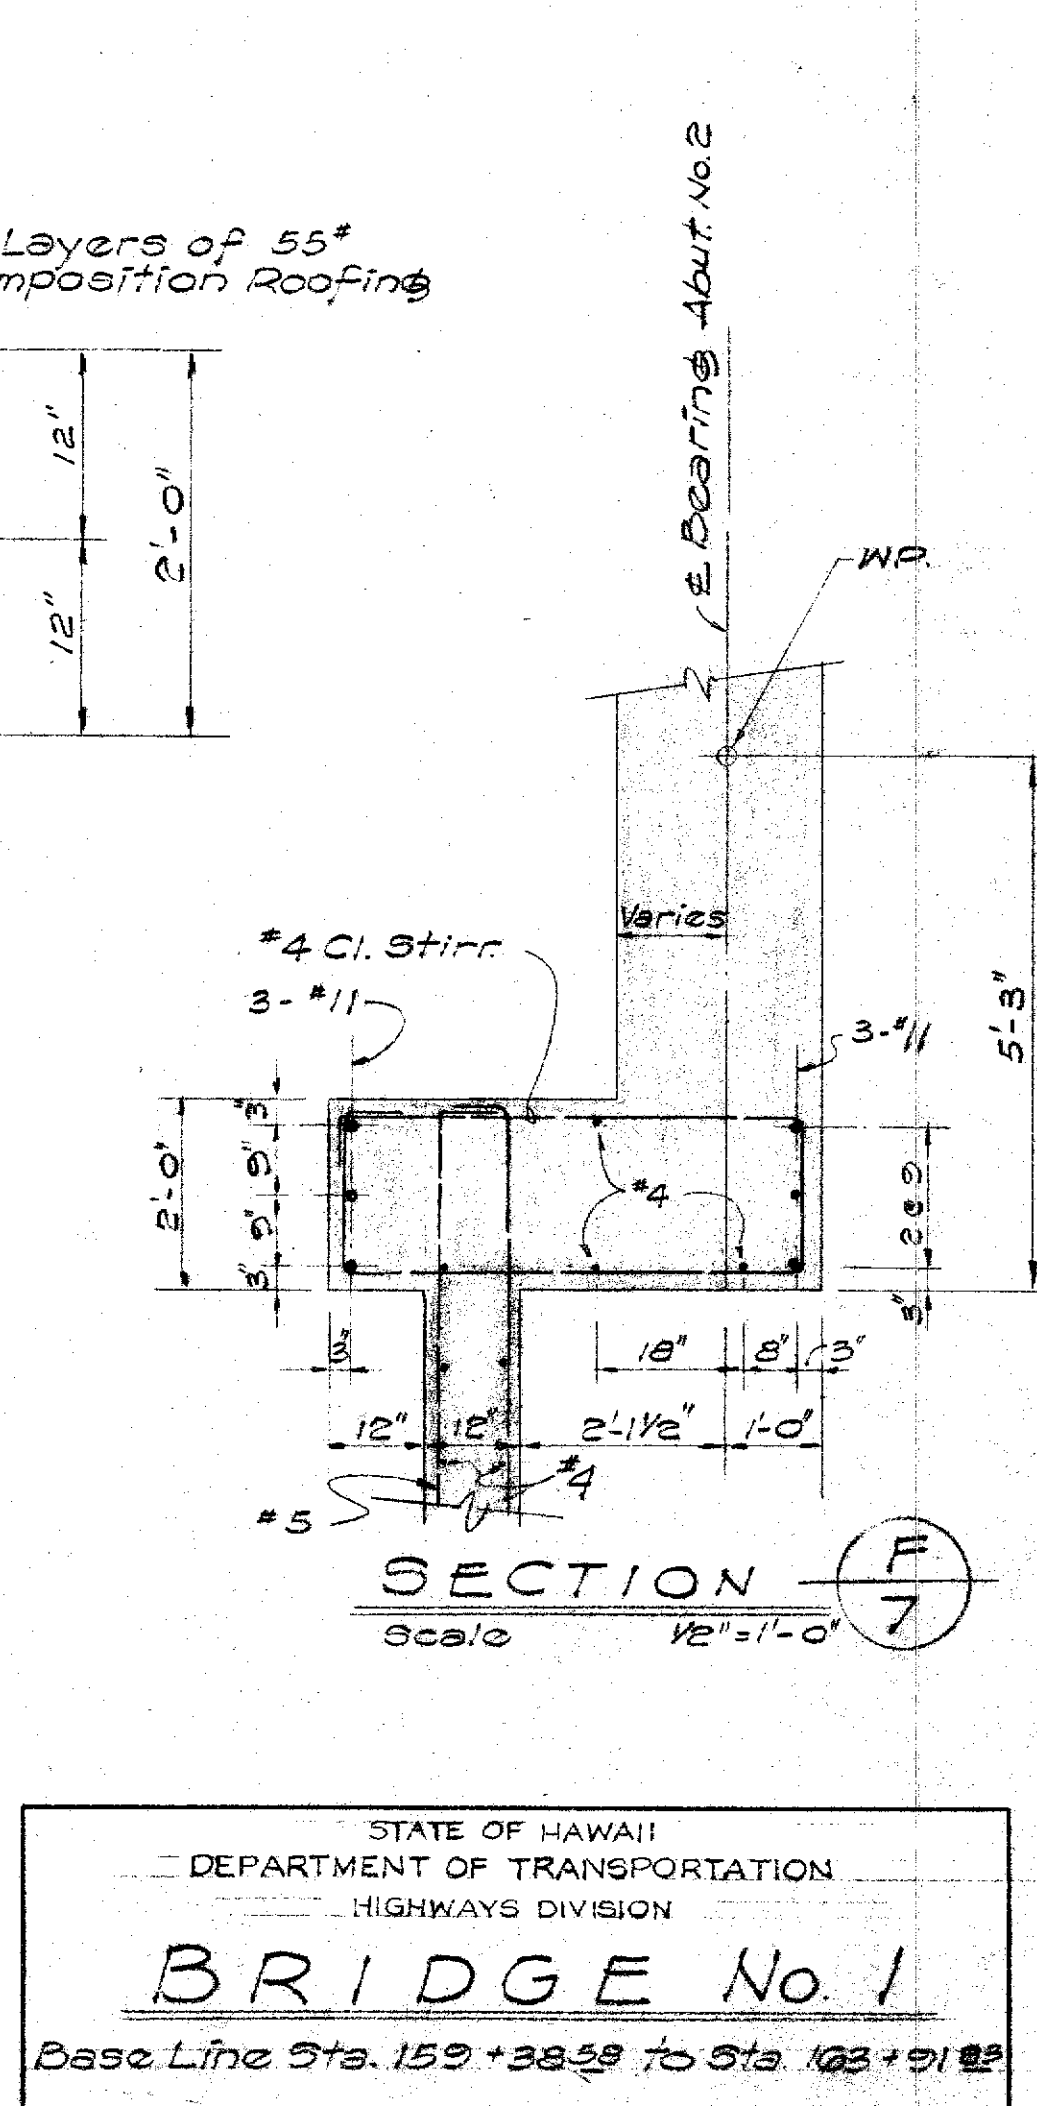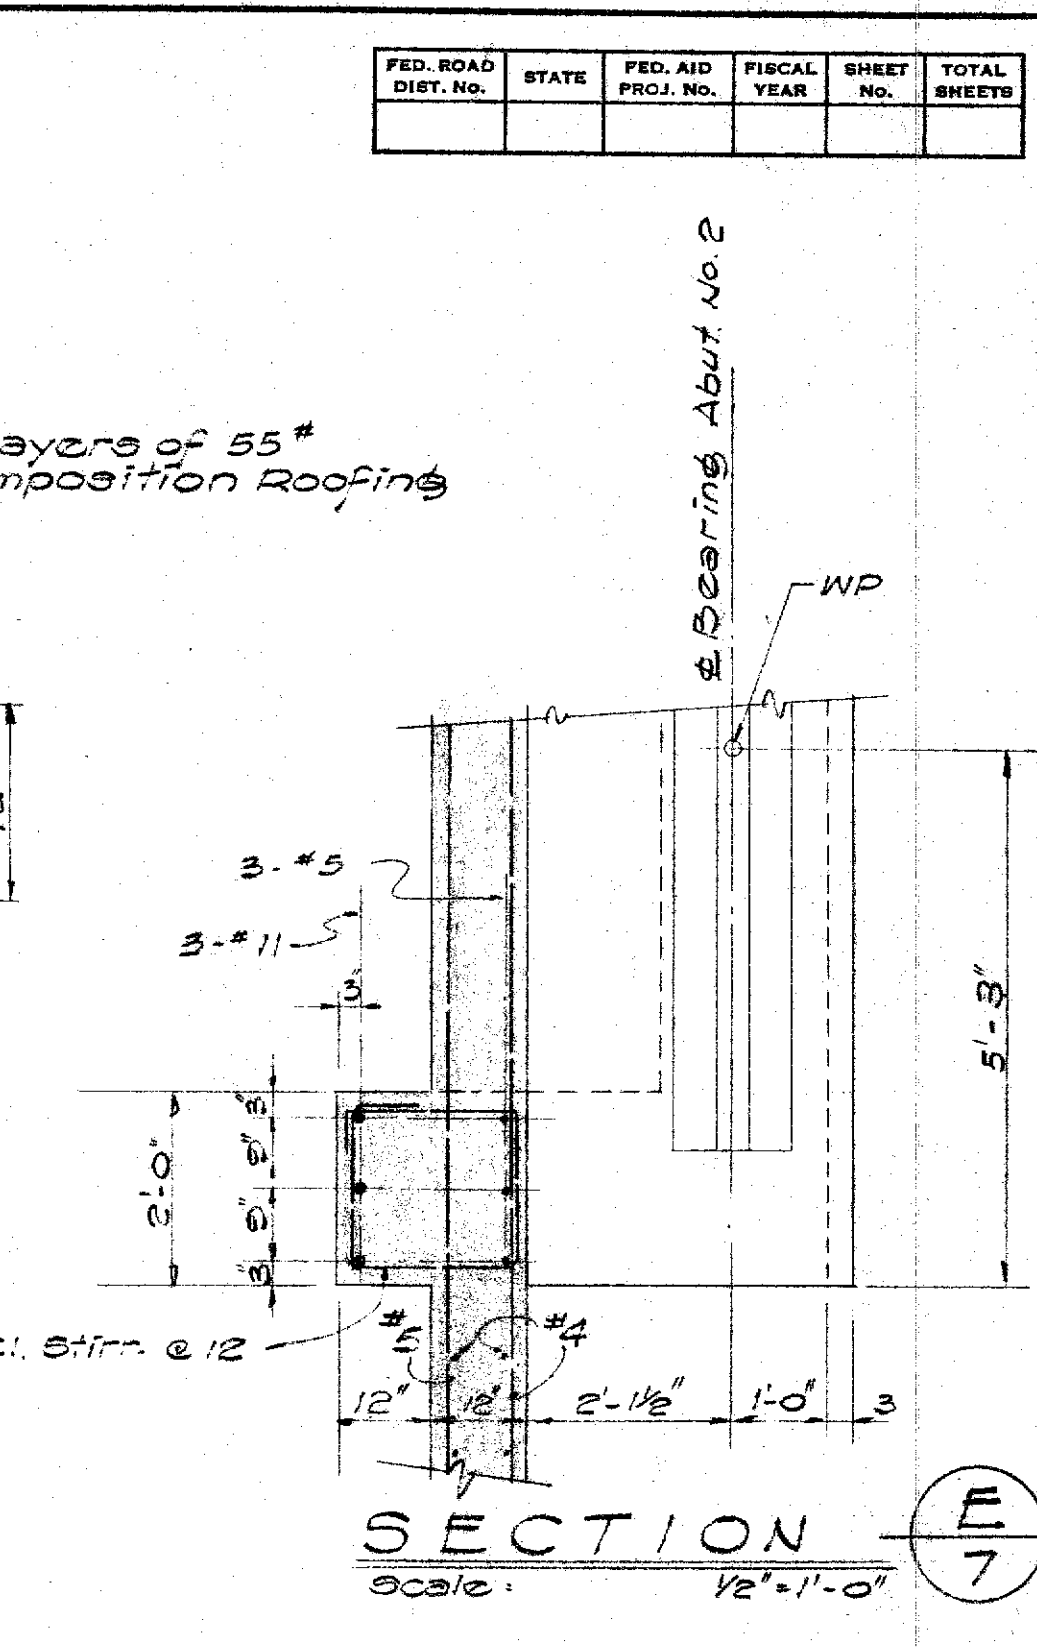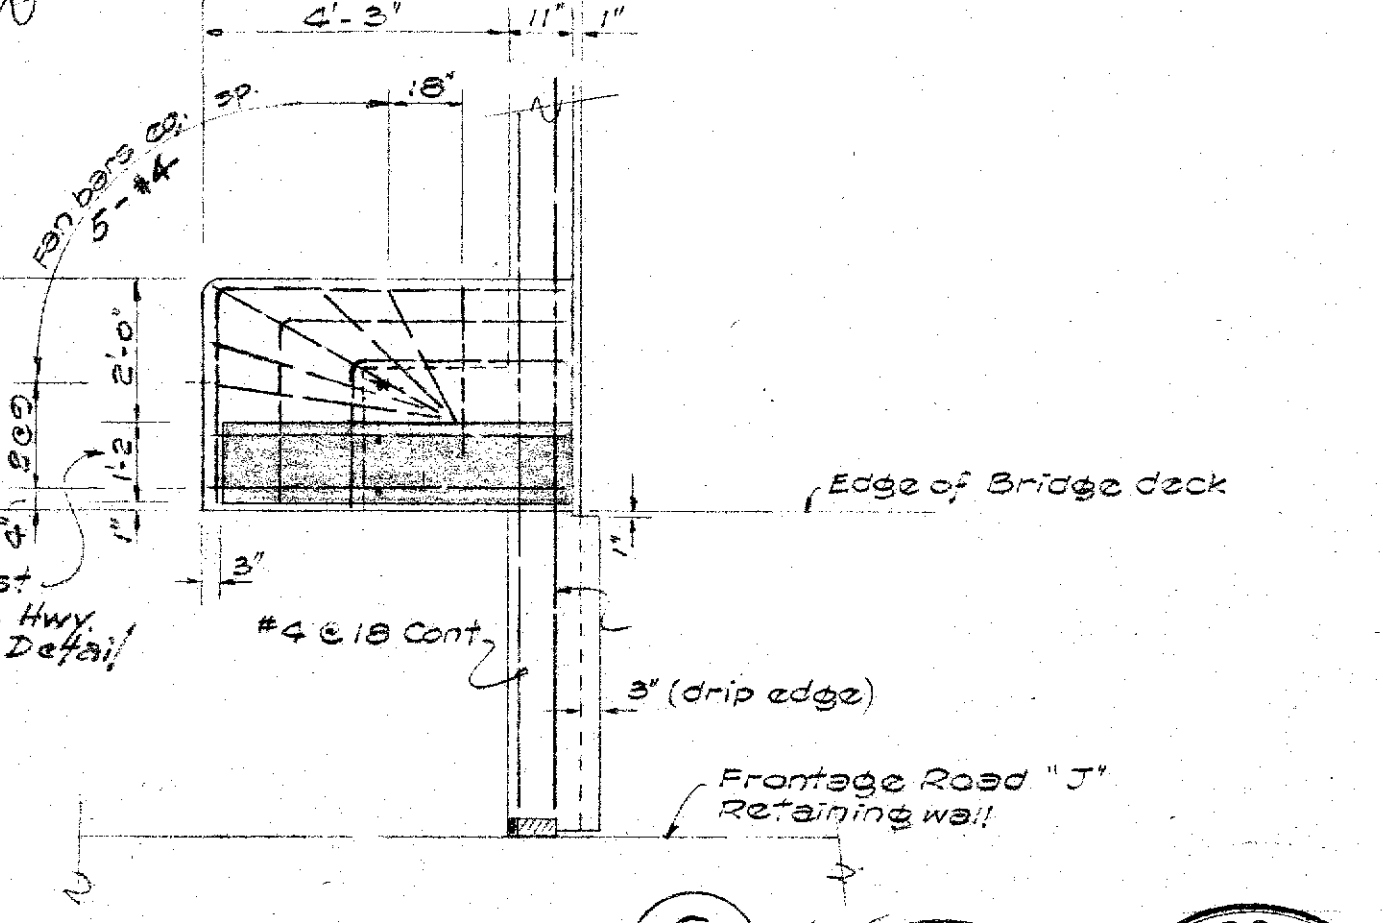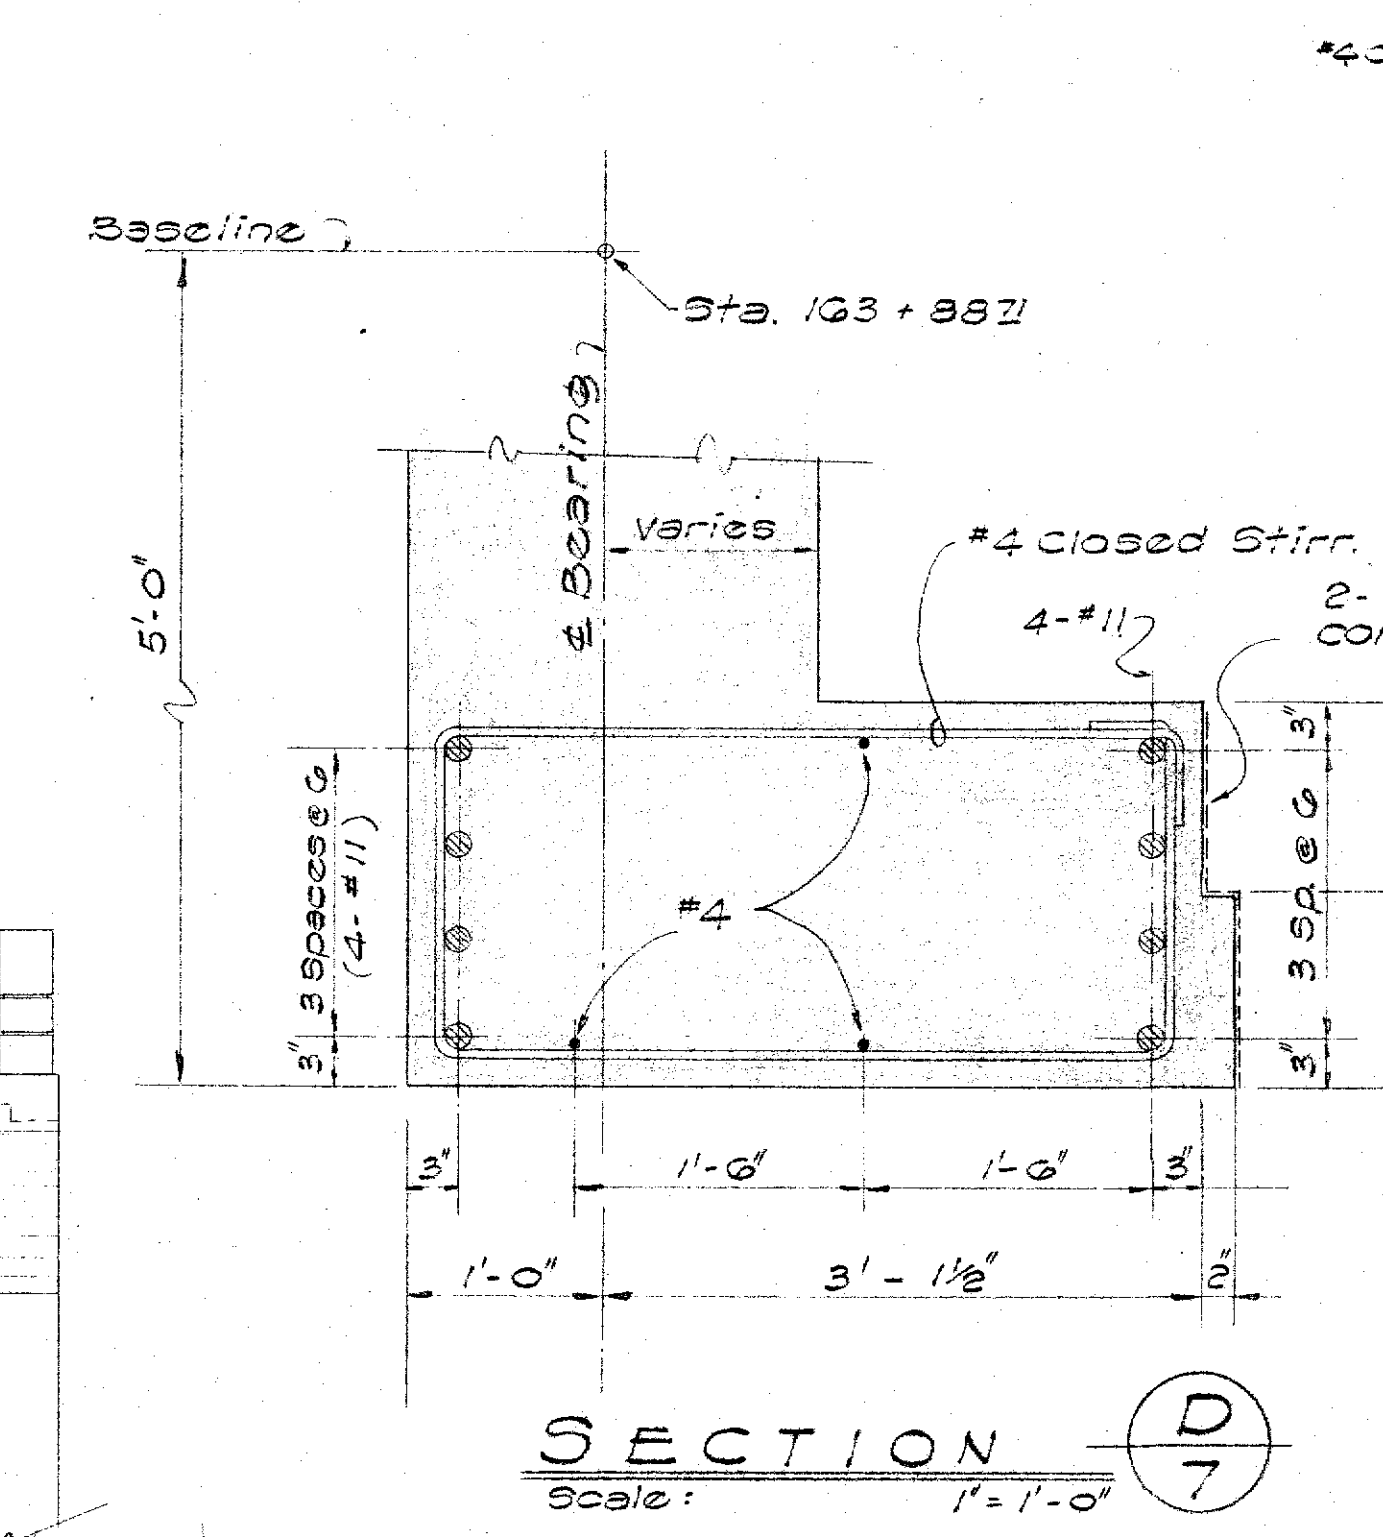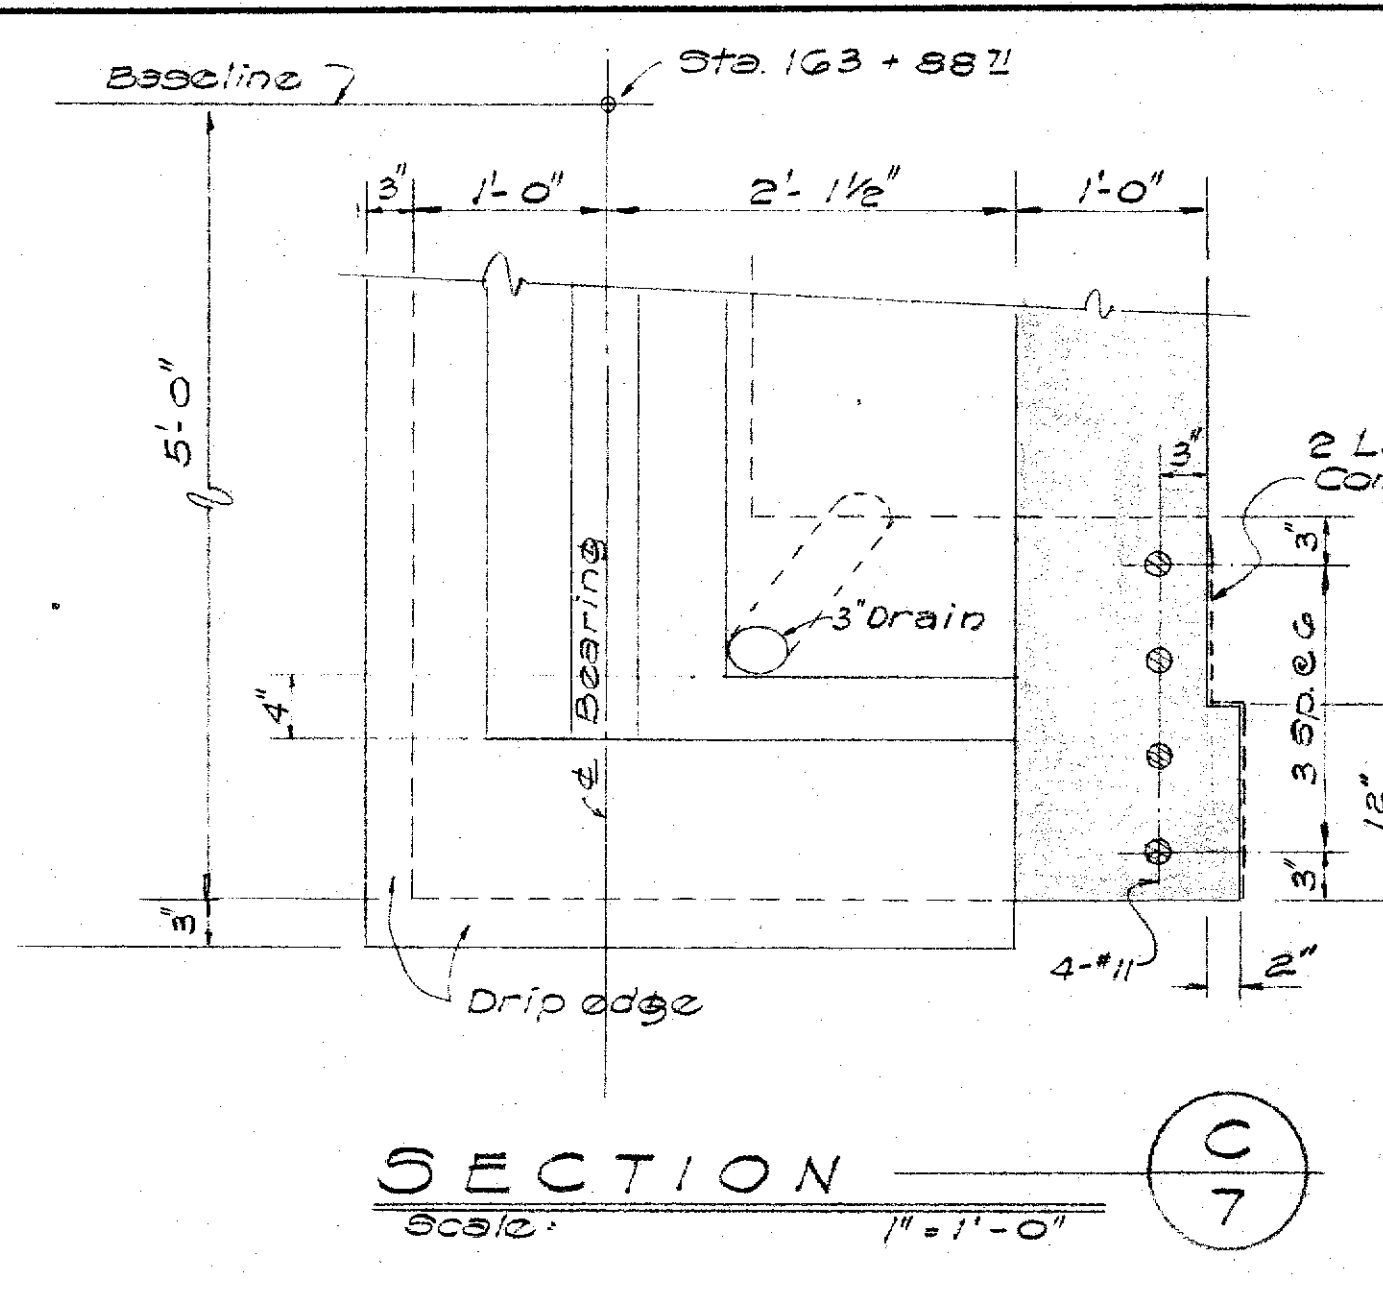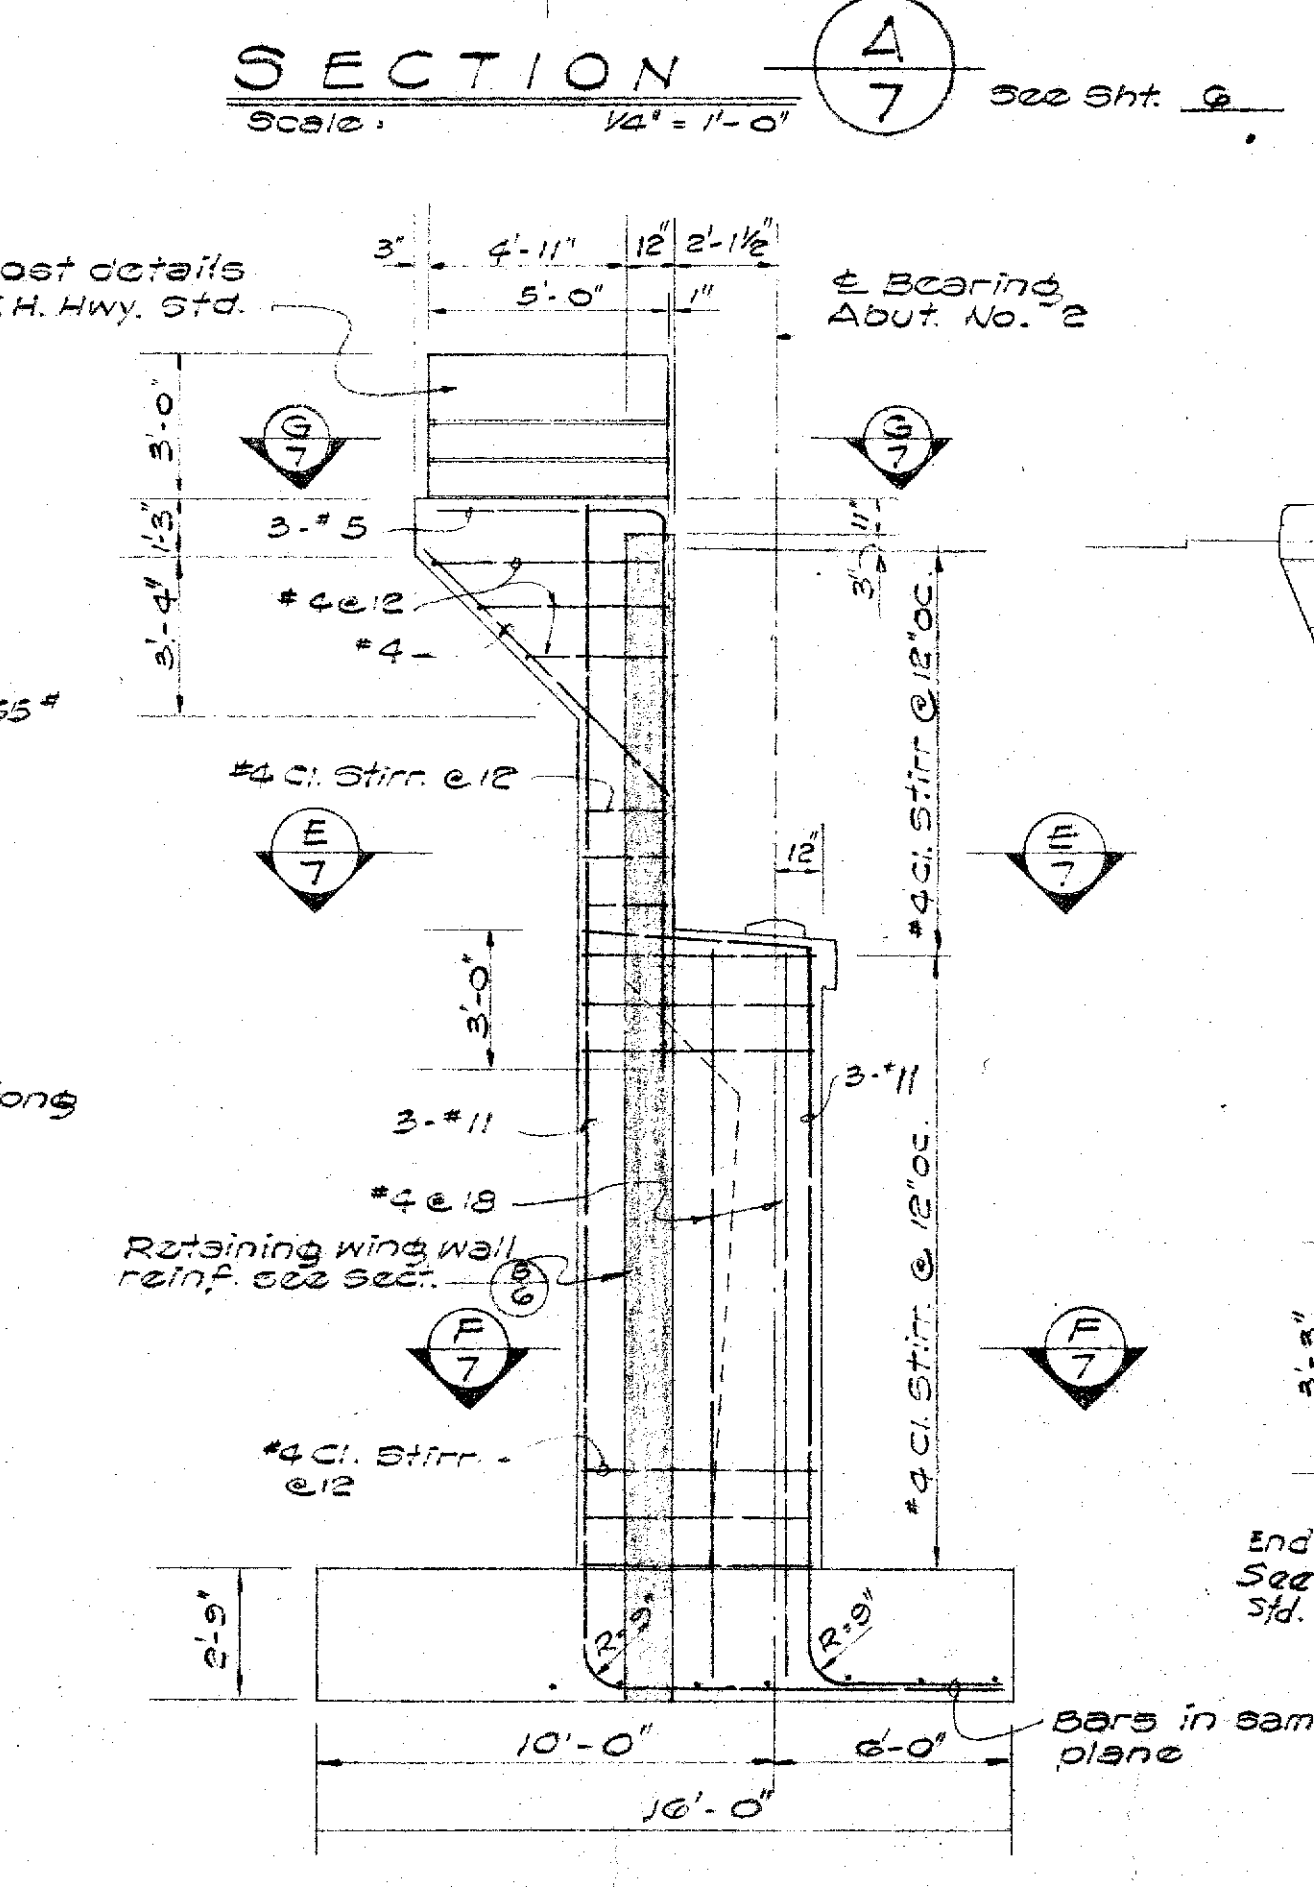
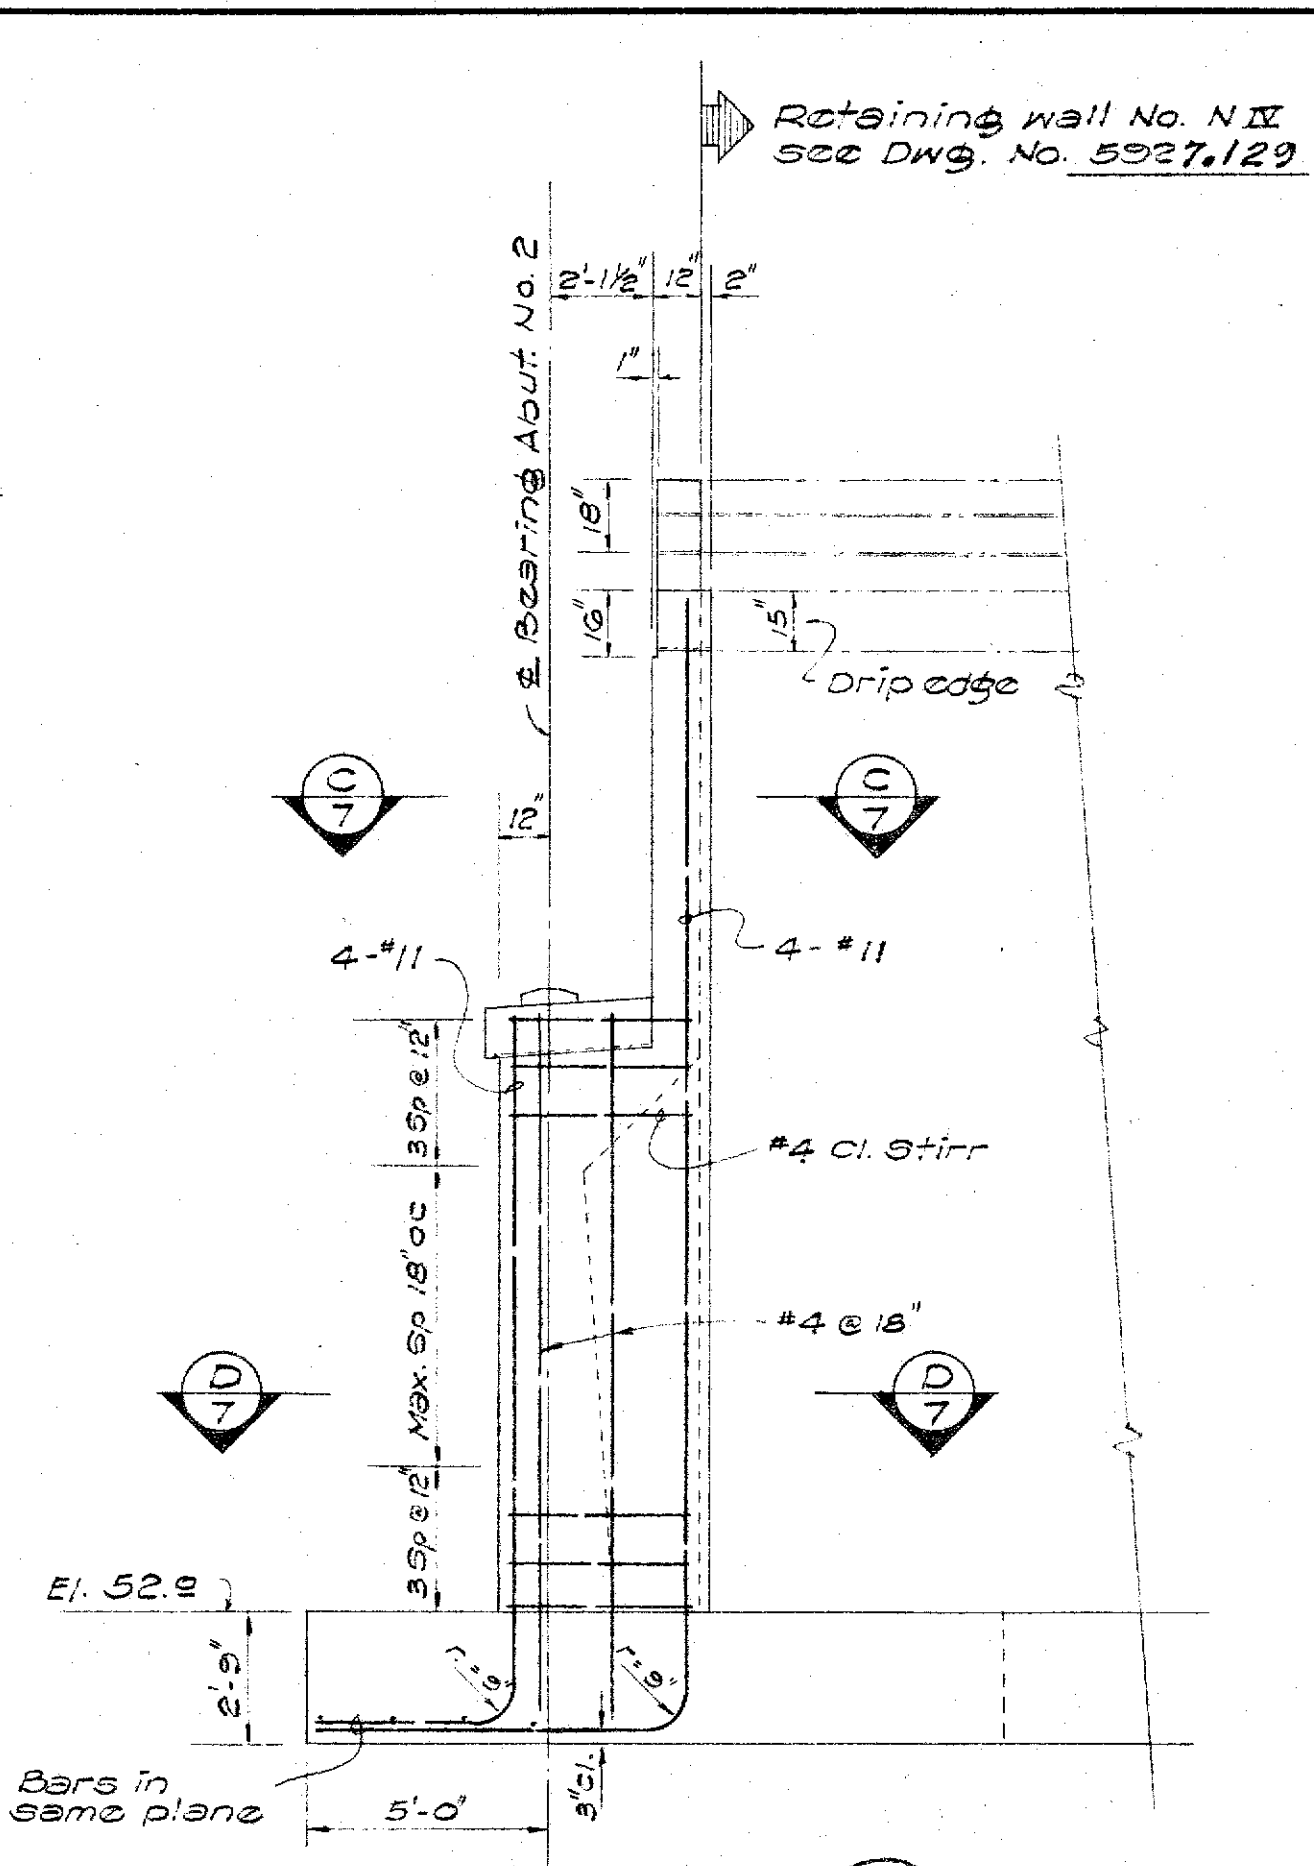
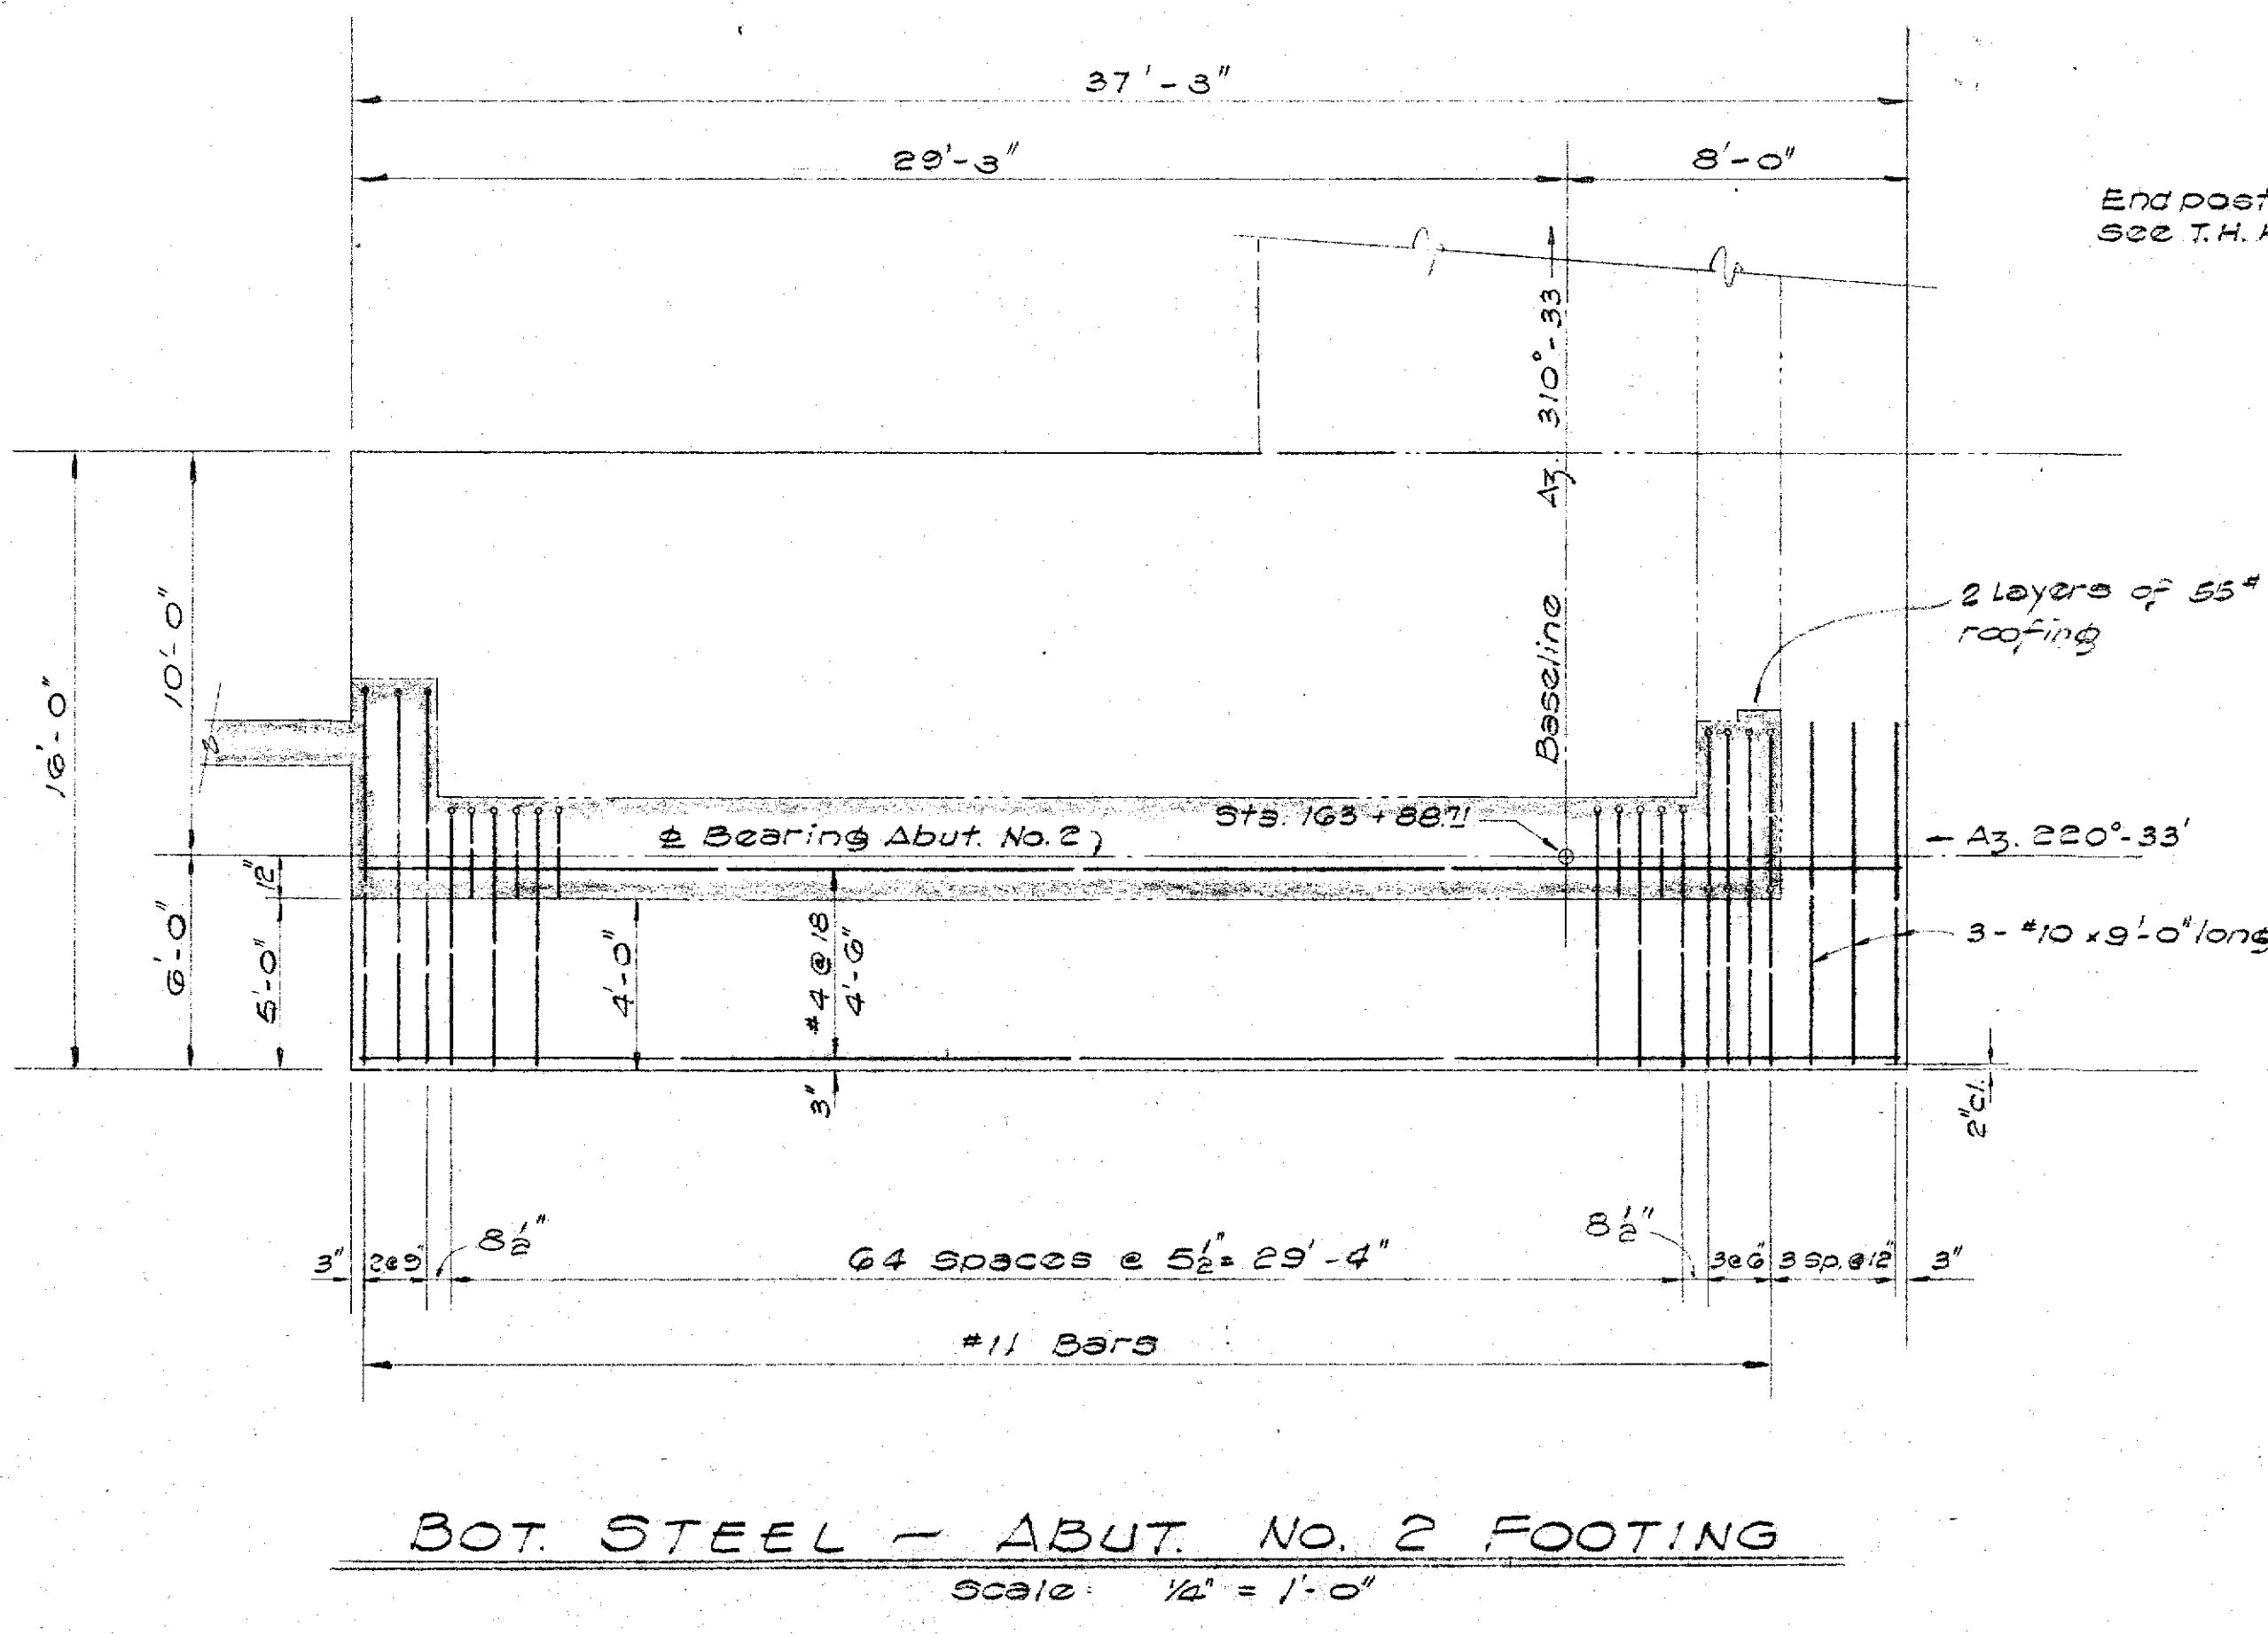
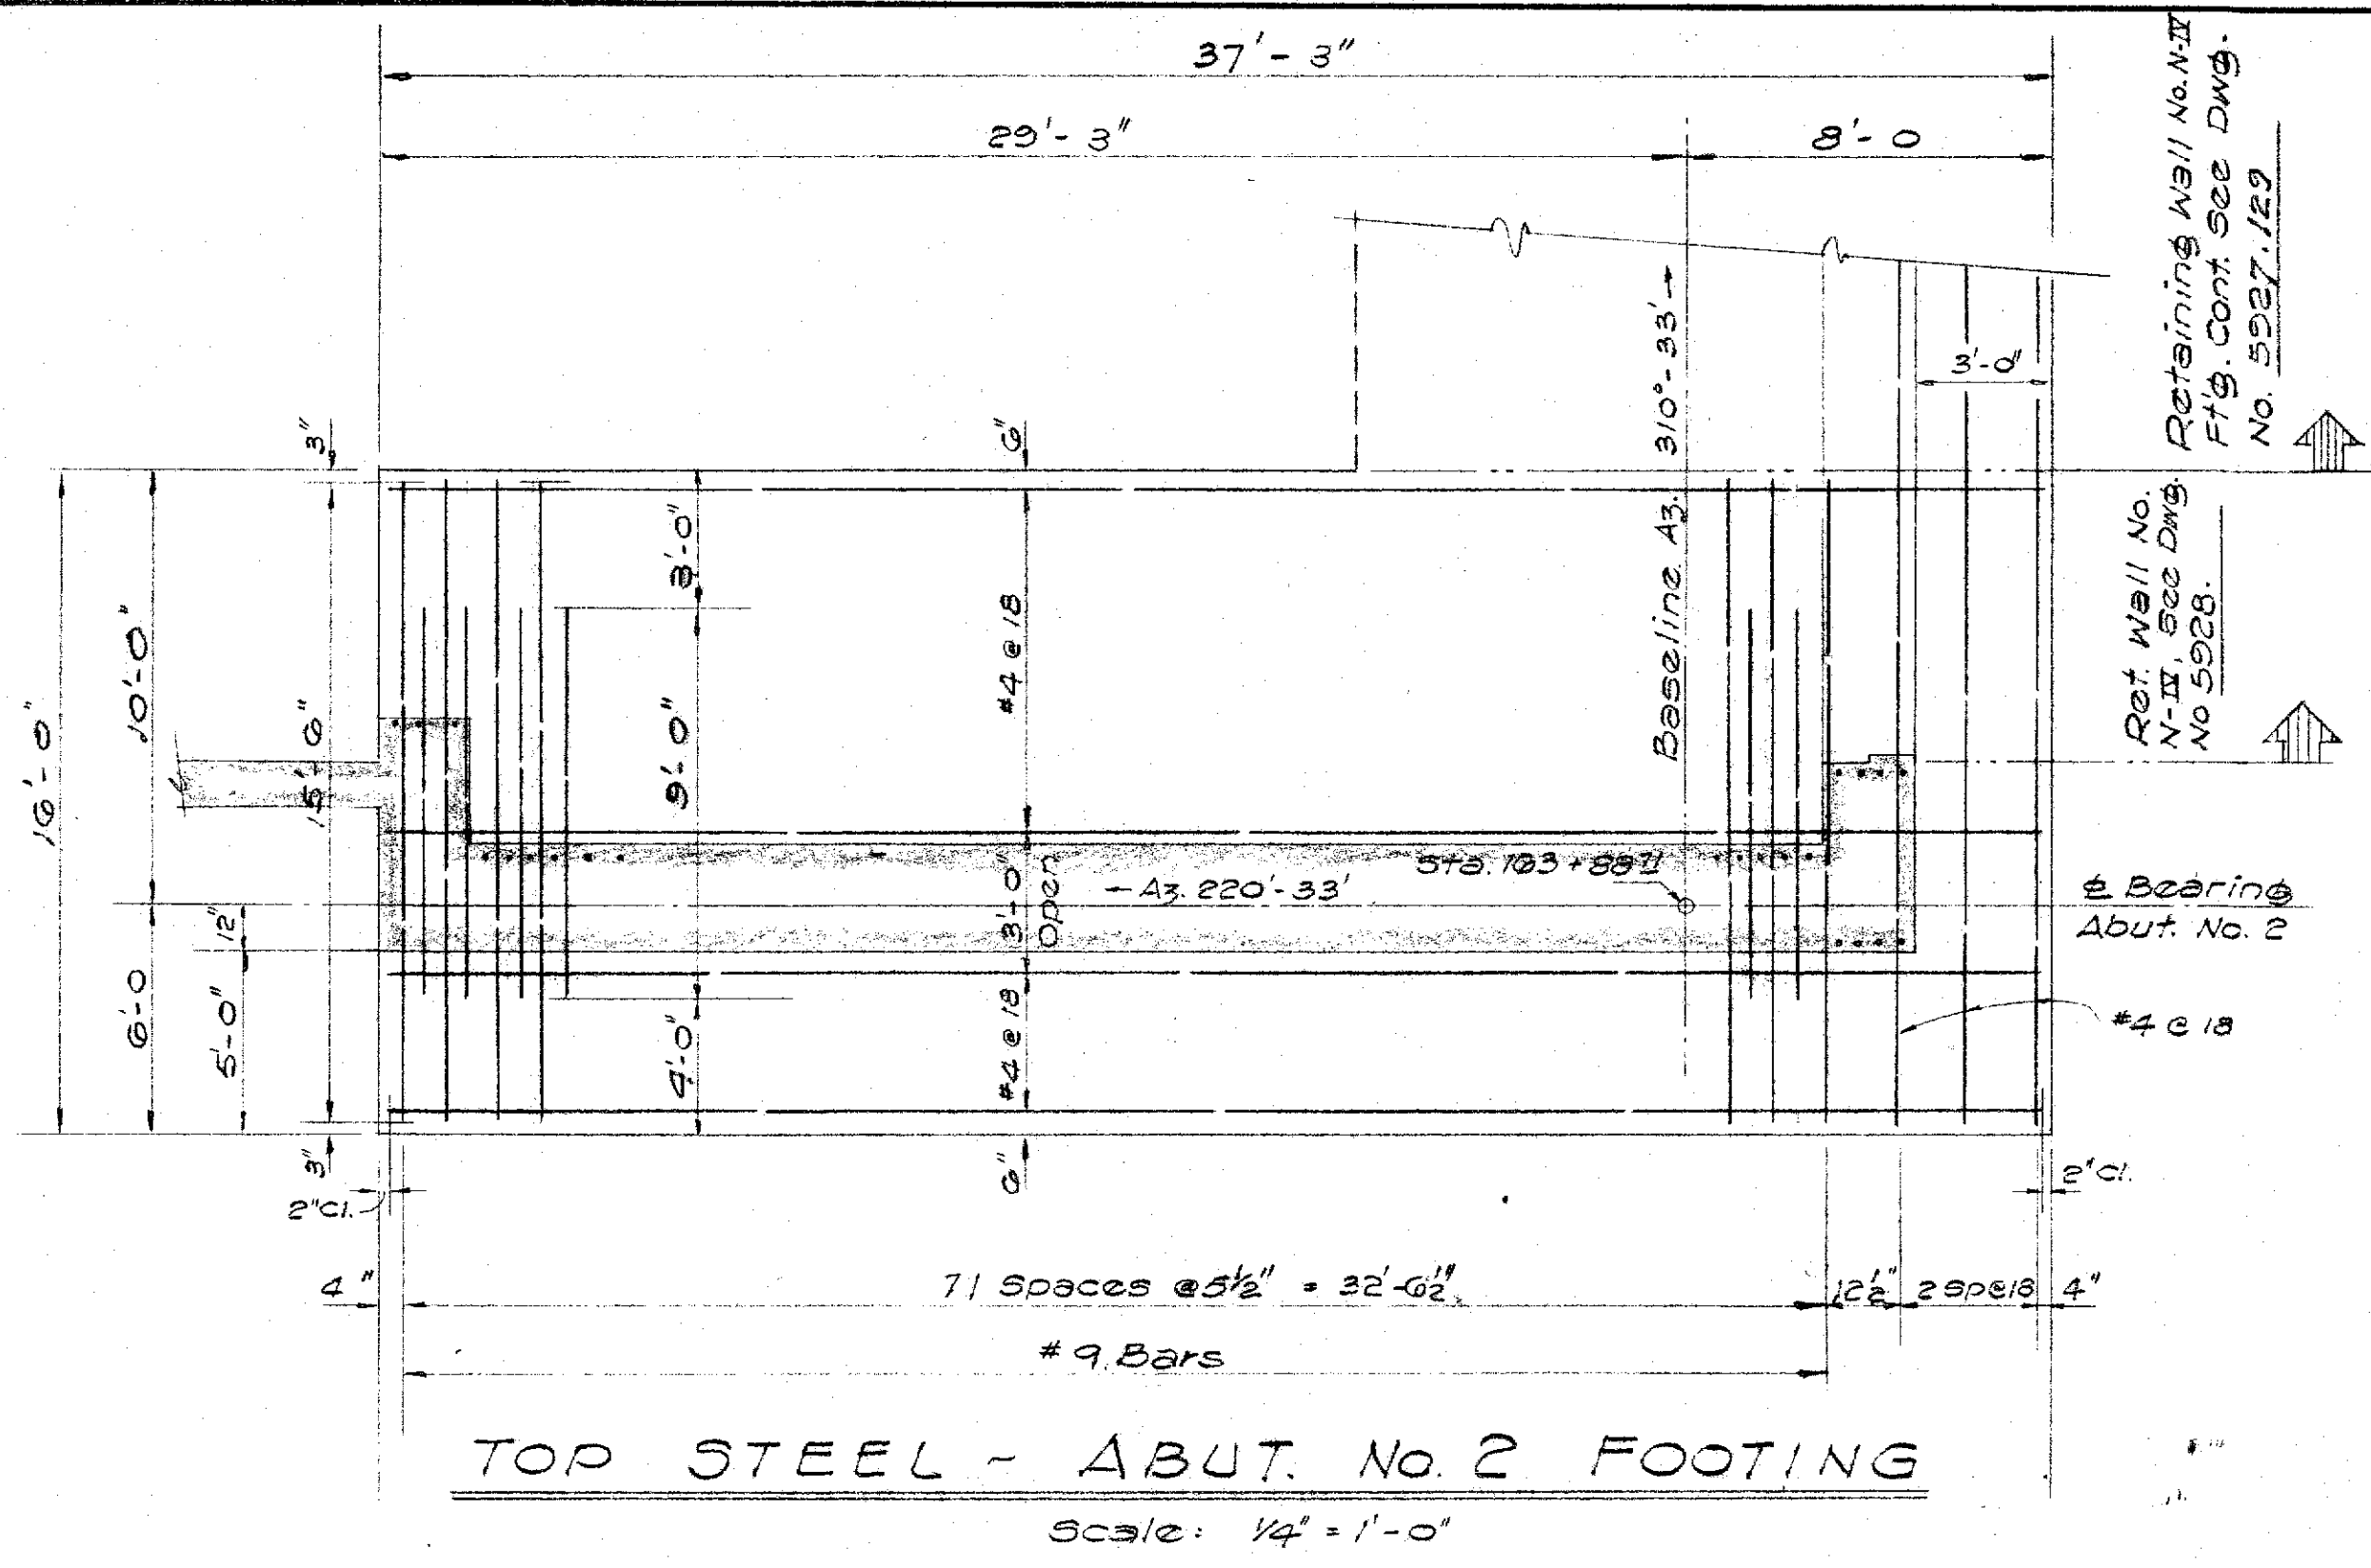


STATE OF HAWAII
 DEPARTMENT OF TRANSPORTATION
 HIGHWAYS DIVISION
BRIDGE No. 1
 Base Line Sta. 152+38.59 to Sta. 163+91.82
 VINEYARD BOULEVARD
 PROJECT NO. F-038-1-(3)
 SHEET No. 7 OF 22 SHEETS

ALFRED A. YEE
 REGISTERED
 STRUCTURAL
 ENGINEER
 No. 718
 HAWAII, U.S.A.

SATOSHI DON SHIMAZU
 REGISTERED
 PROFESSIONAL
 ENGINEER
 No. 710
 HAWAII, U.S.A.

FED. ROAD DIST. NO.	STATE	FED. AID PROJ. NO.	FISCAL YEAR	SHEET NO.	TOTAL SHEETS

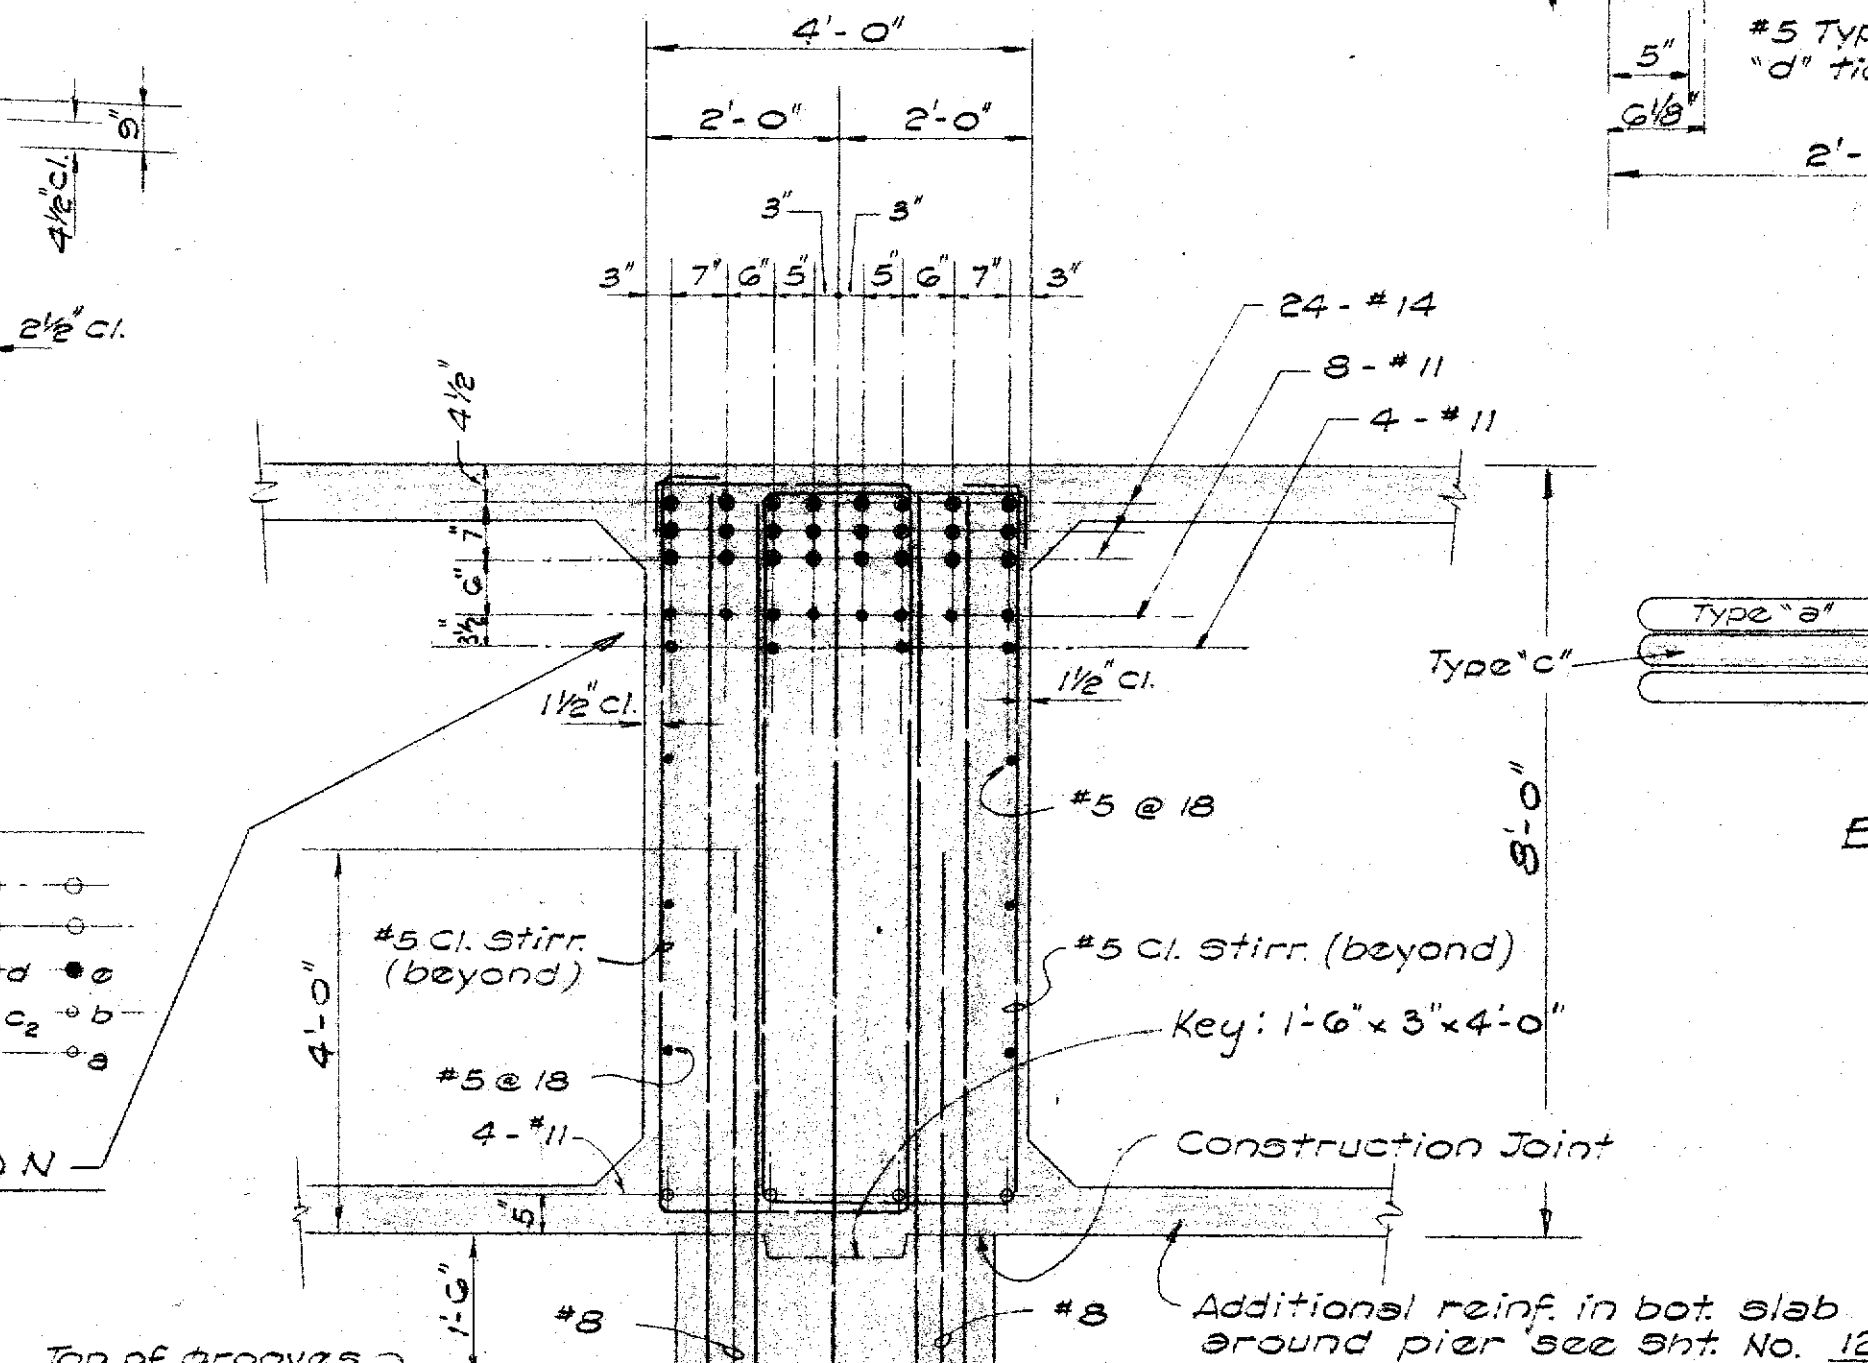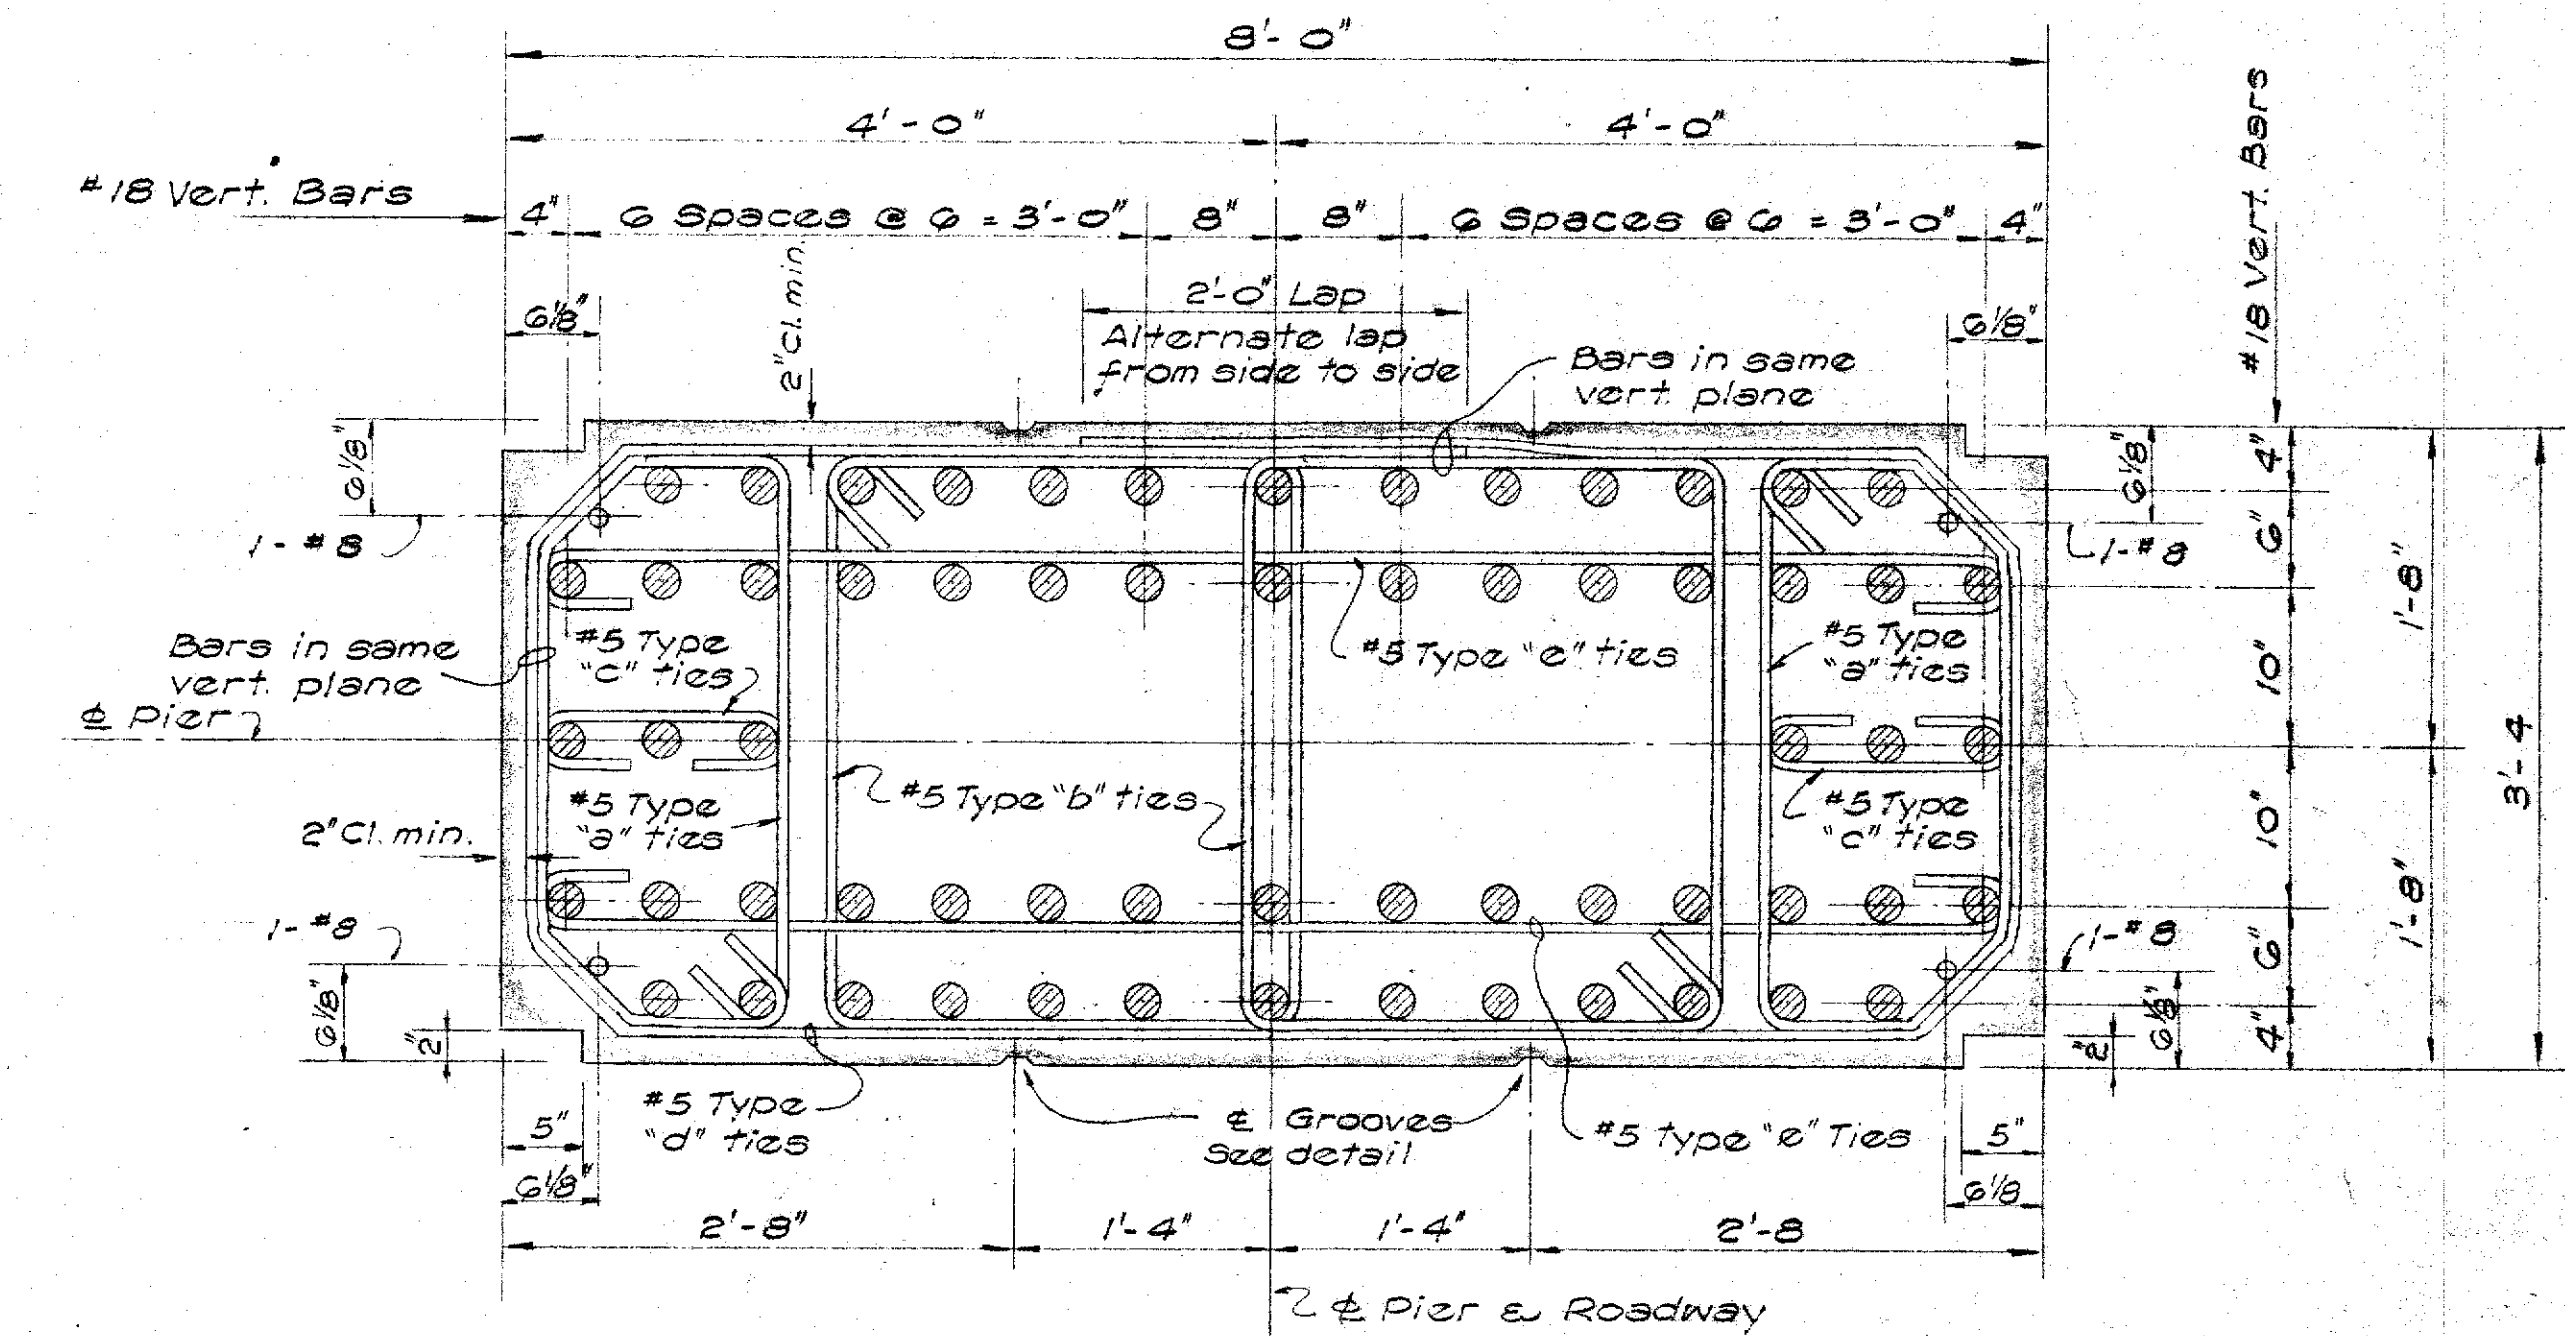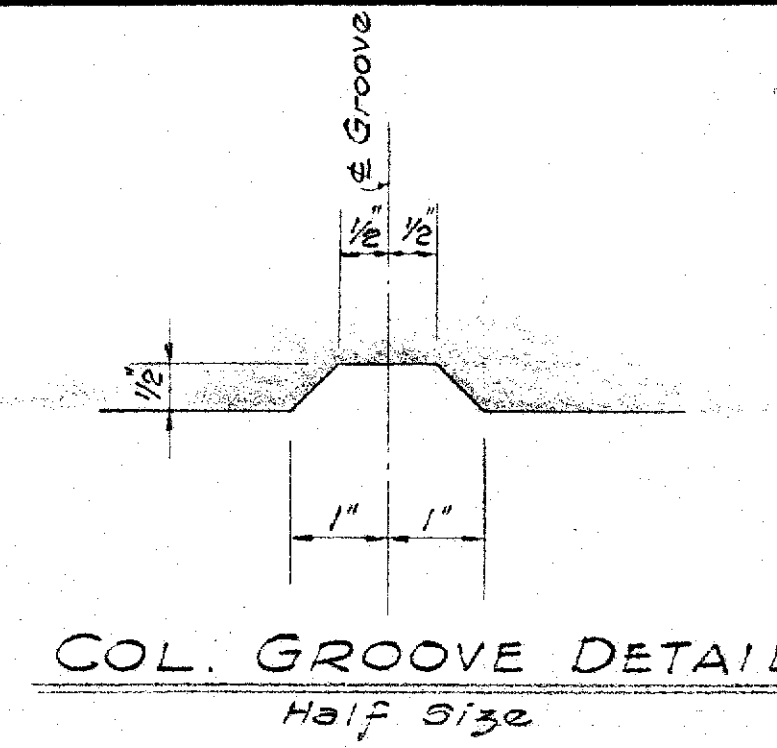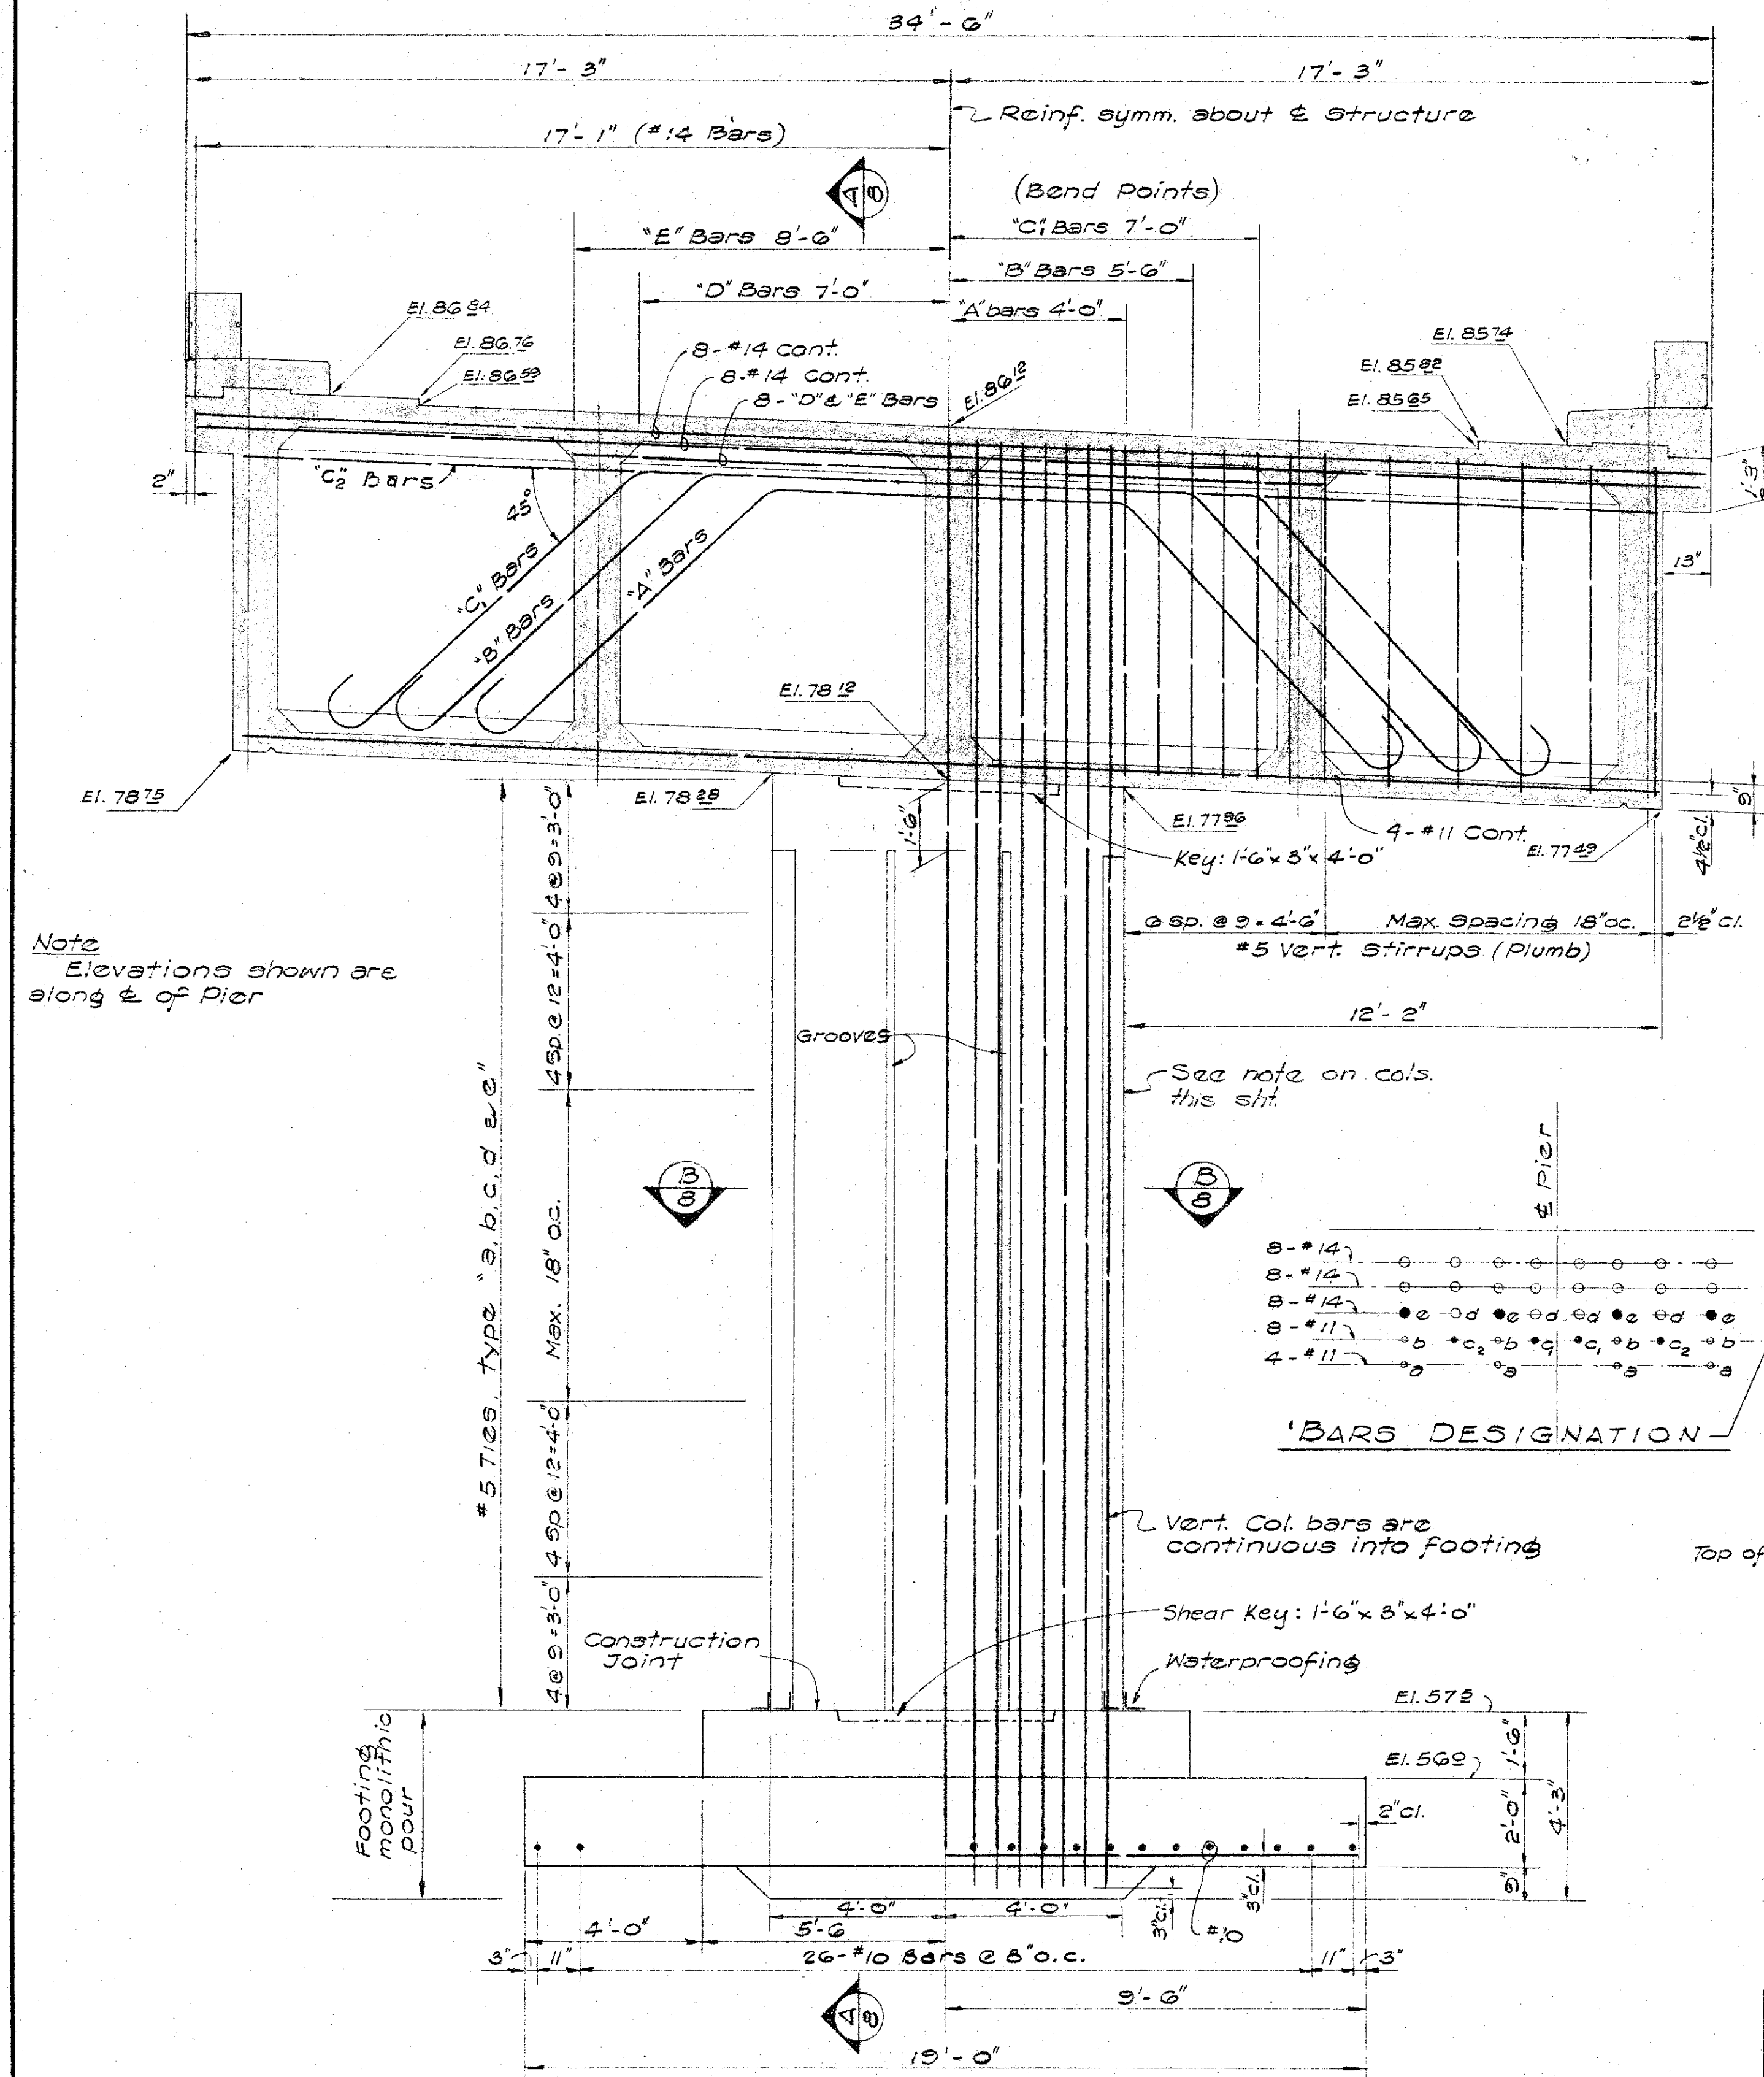

NOTES:
CONCRETE FOR COLUMNS
Quality — 4,000 Psi. (T.H. C/35 F.)
Slump — 3 1/2" Maximum


DESIGNED BY	DATE
DRAWN BY	
CHECKED BY	
QUANTITIES CHECKED BY	
NOTE BOOK NO.	

STATE OF HAWAII
DEPARTMENT OF TRANSPORTATION
HIGHWAYS DIVISION

BRIDGE No 1

Base Line Sta. 152 + 38.22 to Sta. 163 + 21.23

VINEYARD BOULEVARD
PROJECT No F-098-1-(3)


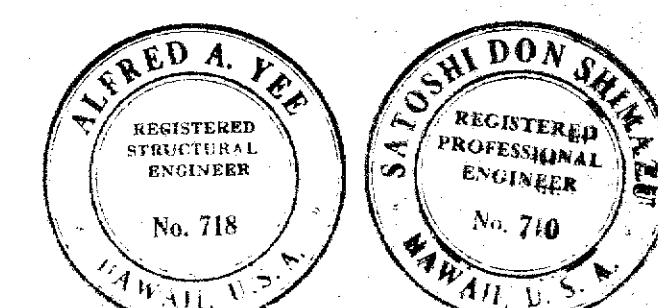


SHEET No. 8 OF 22 SHEETS

CONSULTANT SUBMISSION

5928.65

ORIGINAL	SURVEY PLOTTED BY _____	DATE _____
PLAN	DESIGNED BY _____	" _____
	DRAWN BY _____	" _____
NOTE BOOK	TRACED BY _____	" _____
	QUANTITIES BY _____	" _____
	QUANTITIES CHECKED BY _____	" _____
No. _____	CHECKED BY _____	" _____

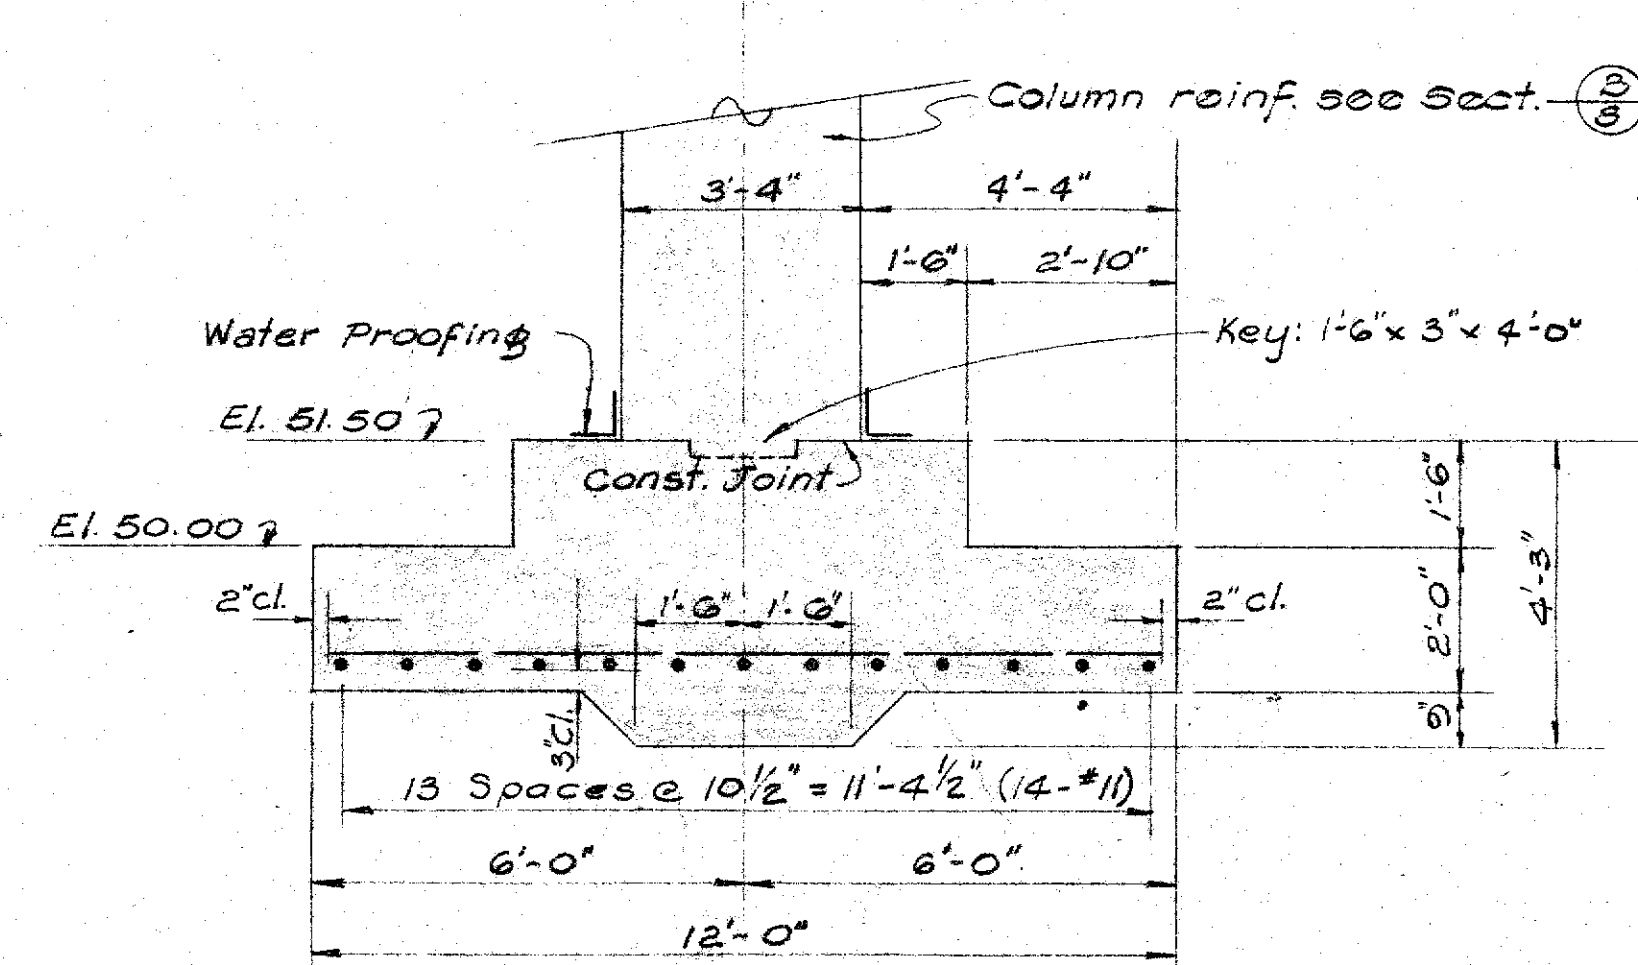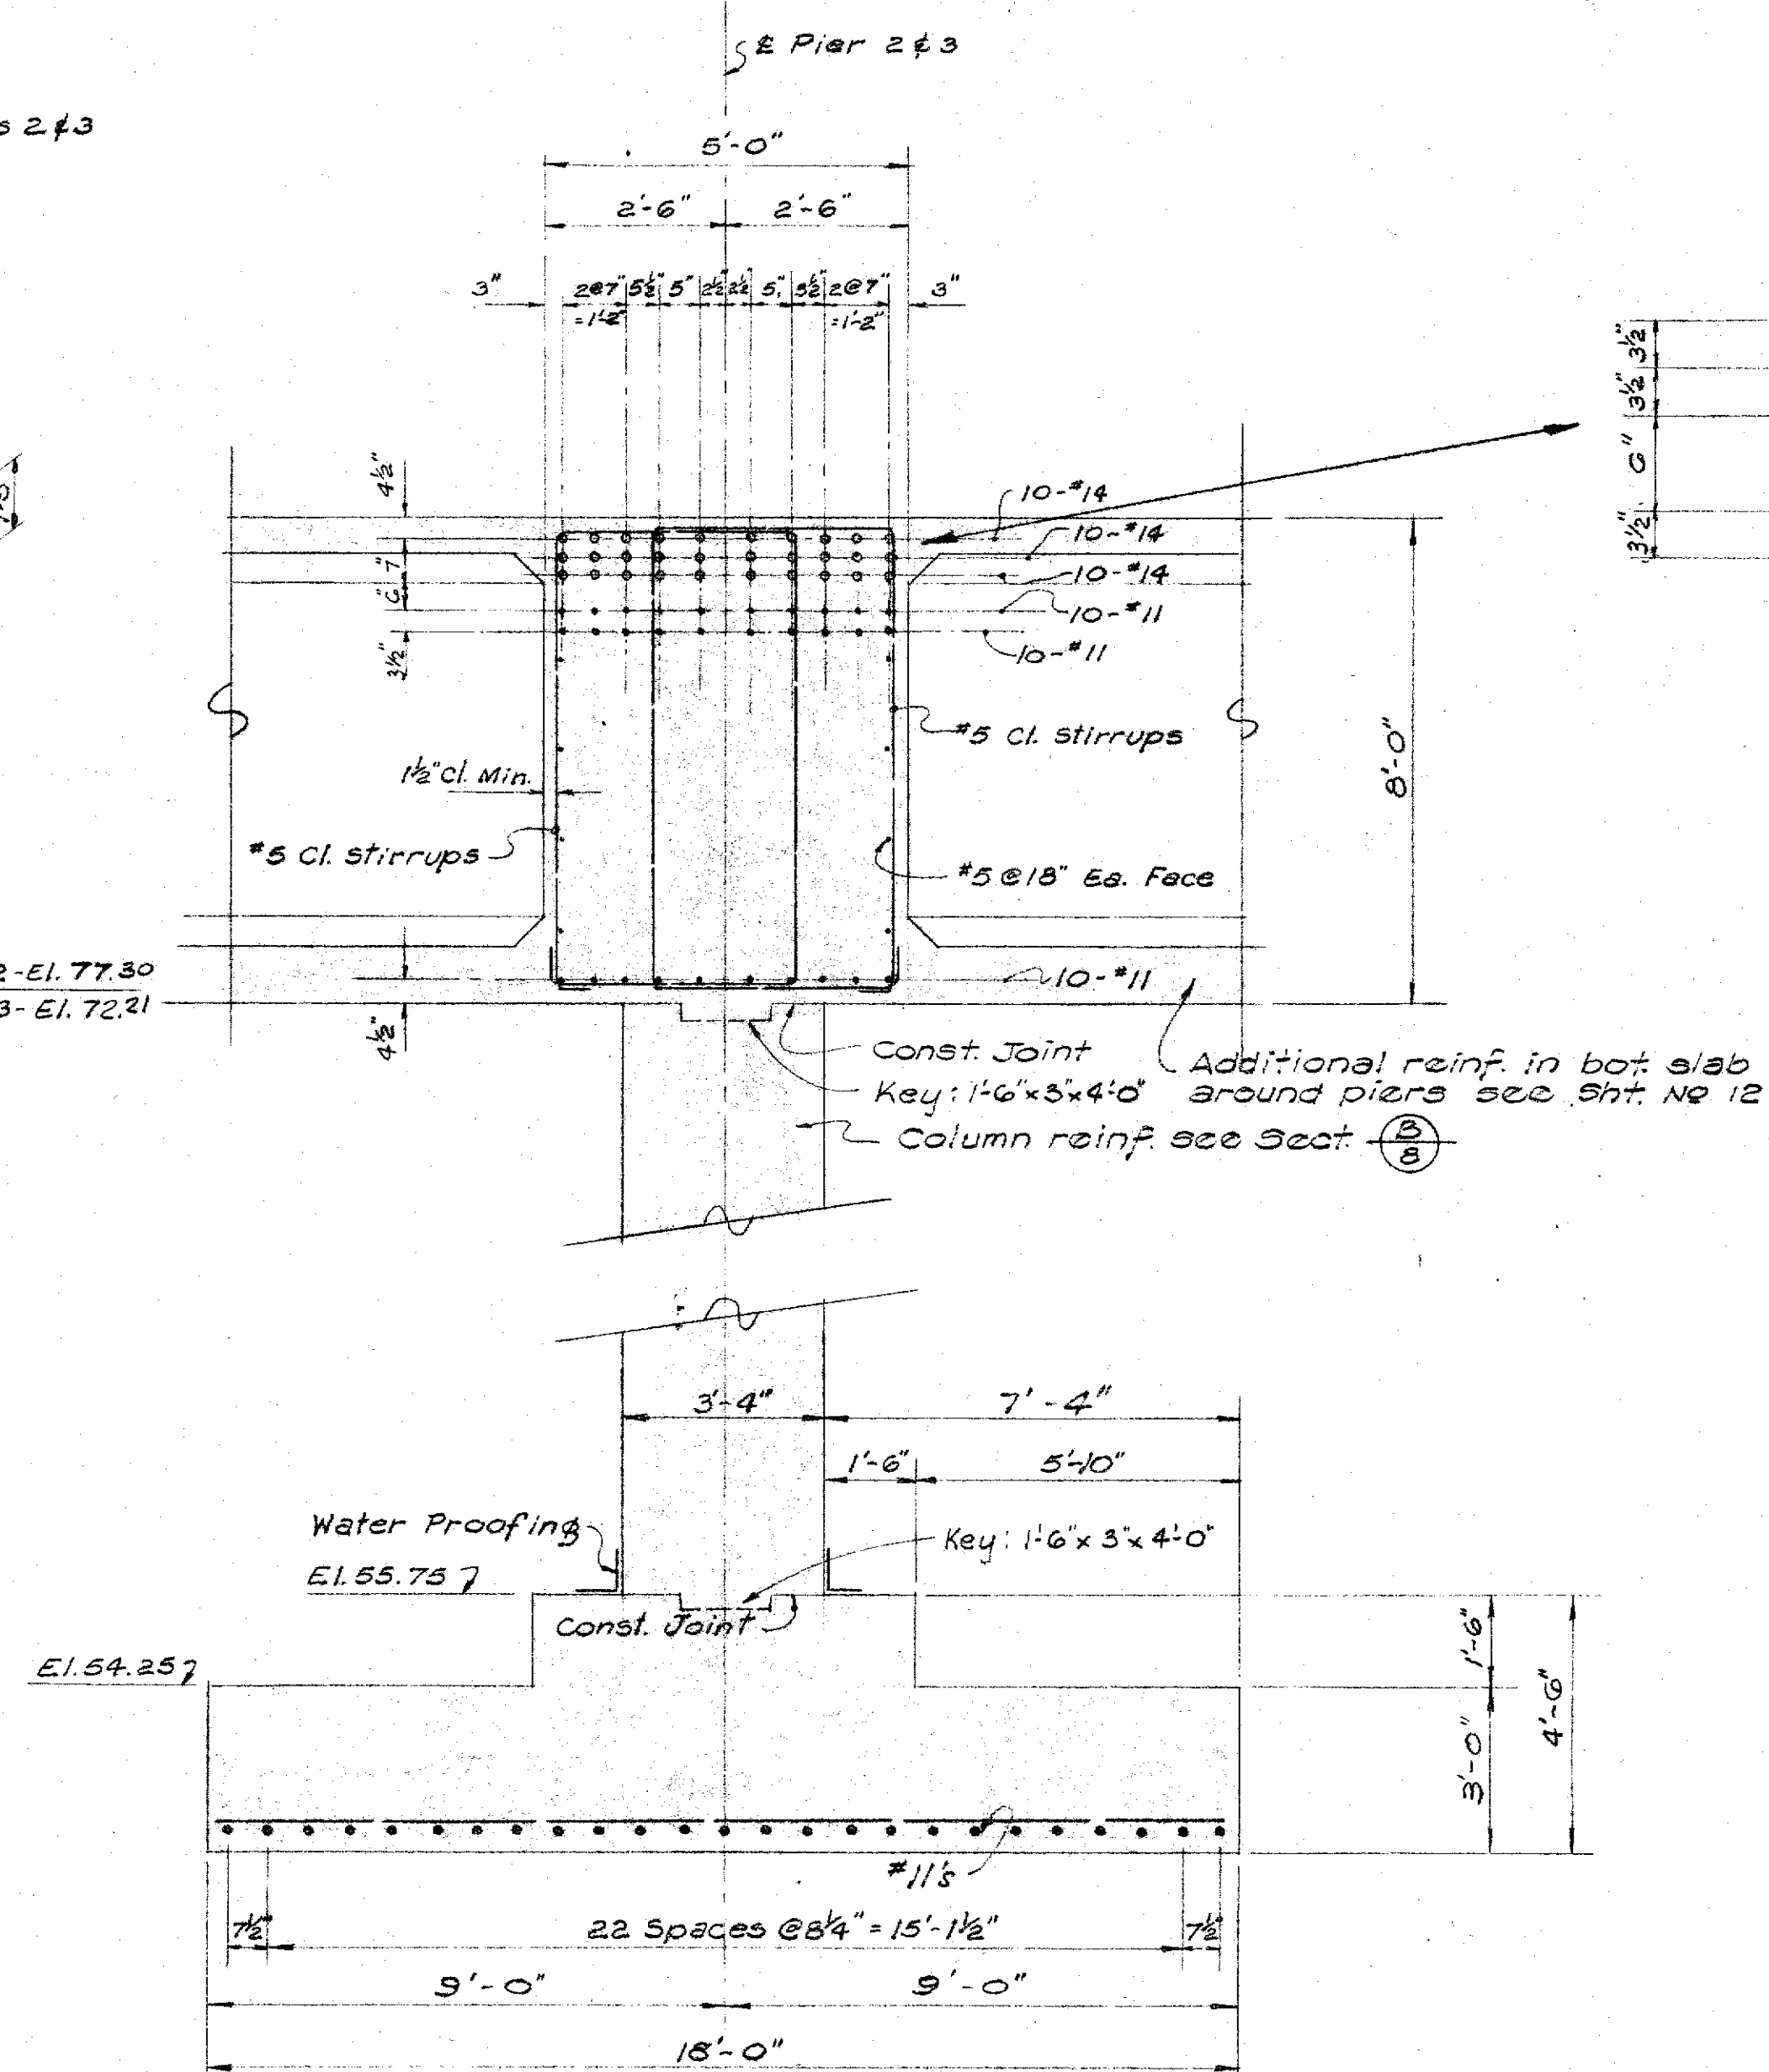


FOOTING - PIER 3

SECTION — (A)
9

Scale: $\frac{3}{8}" = 1'-0"$



SHEET No. 9 OF 22 SHEETS

5928.66

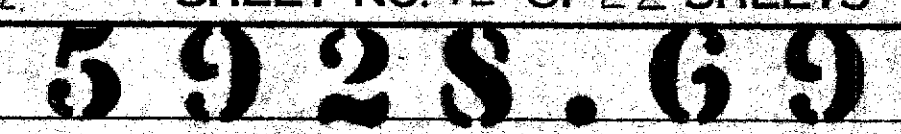

FED. ROAD DIST. NO.	STATE	FED. AID PROJ. NO.	FISCAL YEAR	SHEET NO.	TOTAL SHEETS


NOTE!
Gutters on each side of bridge shall be sloped parallel to Super-elevation of deck.

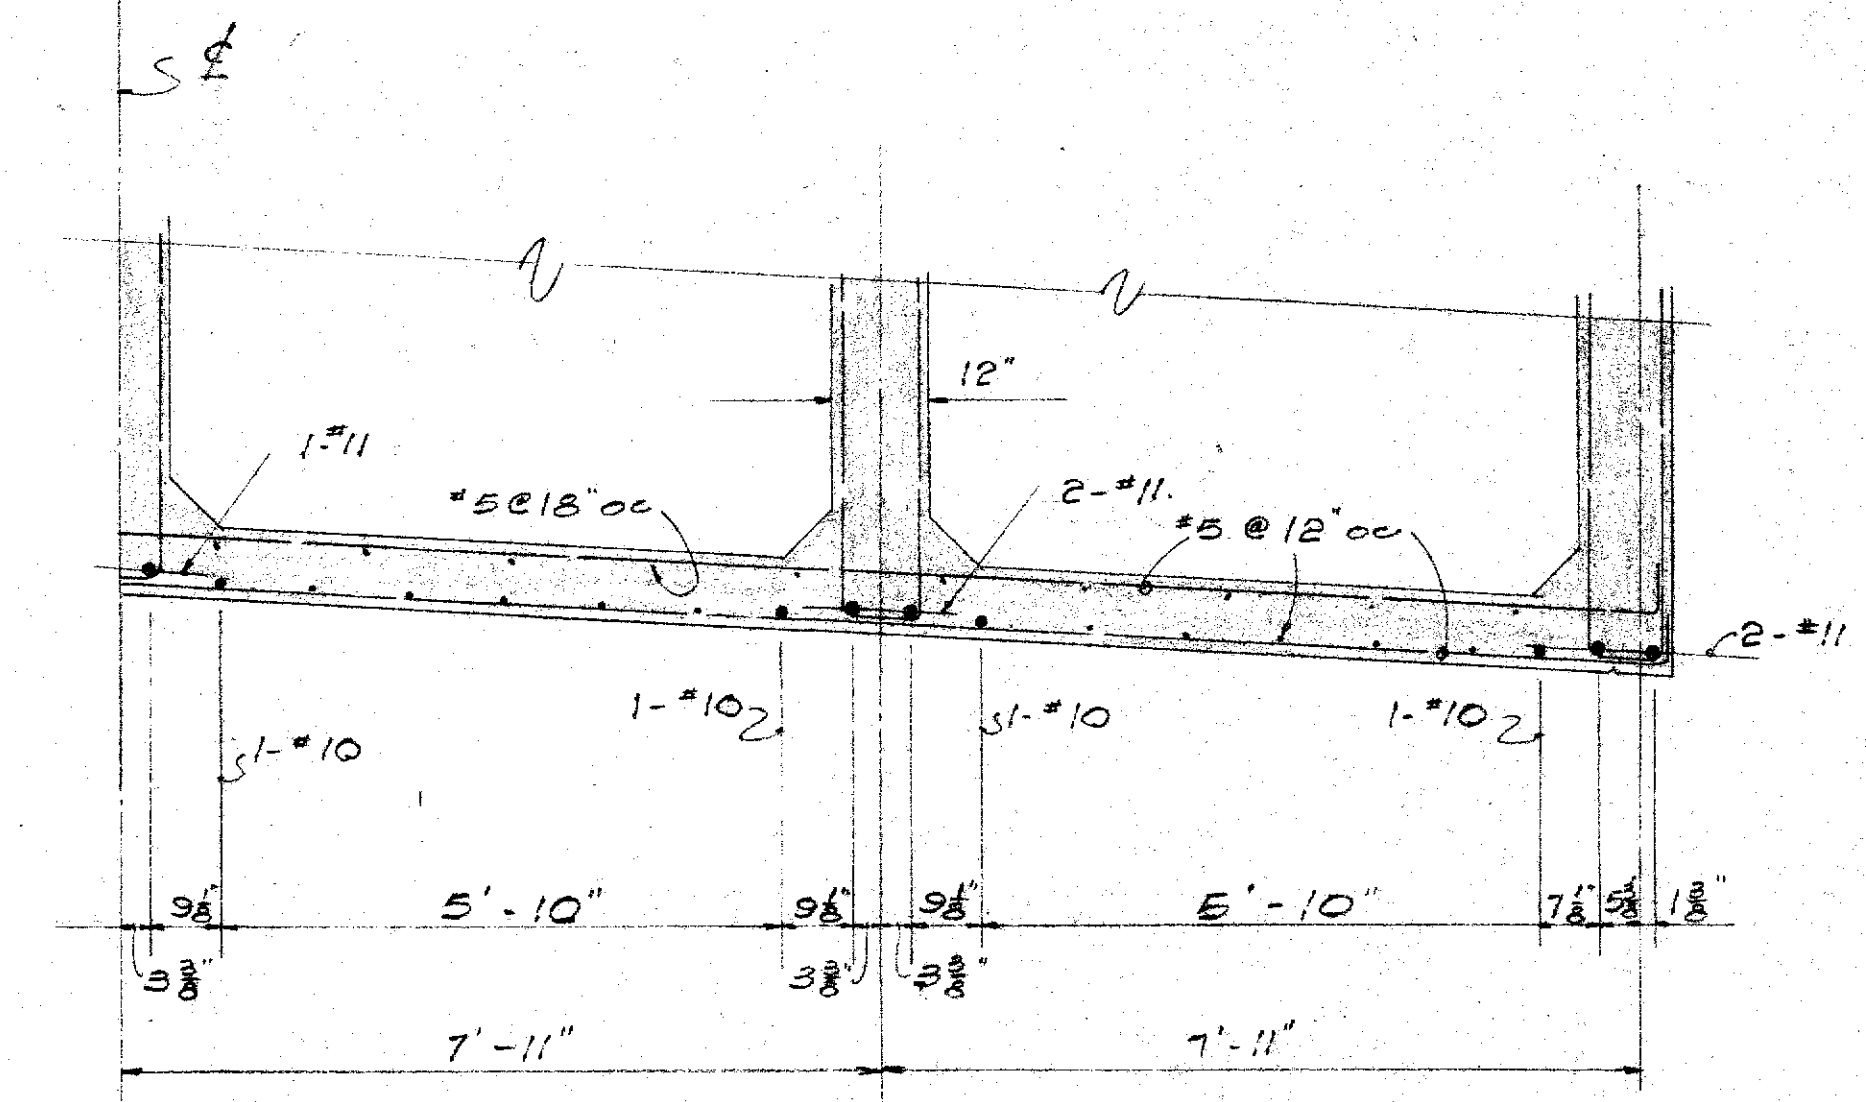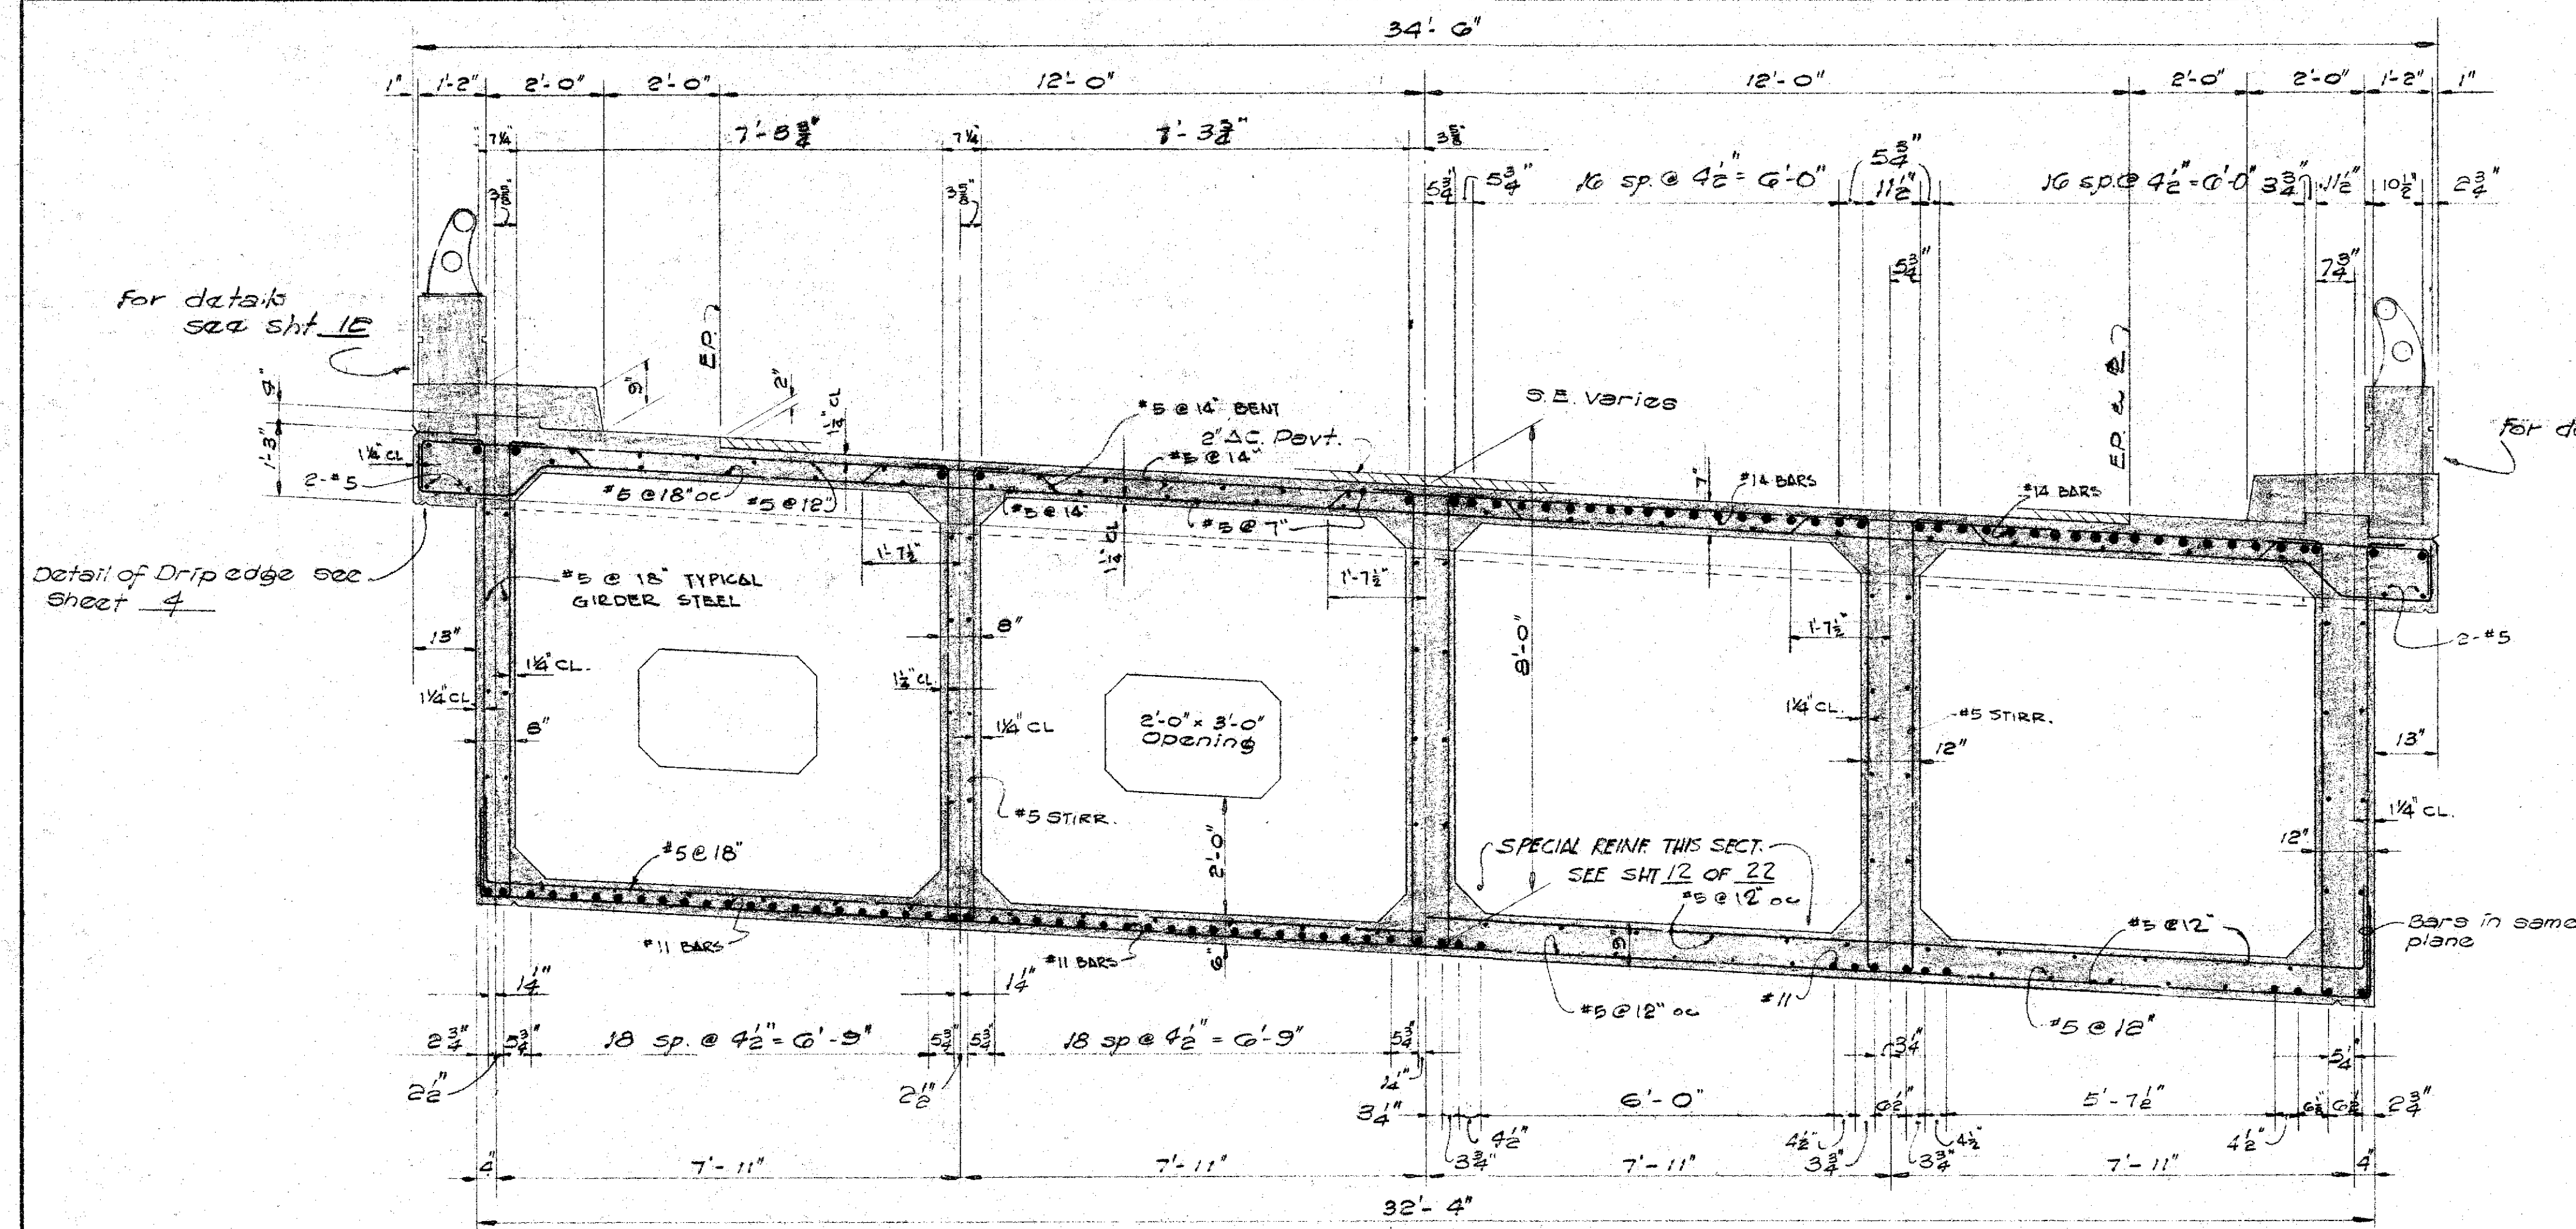


SECTION NEAR MIDSPAN - SPAN NO. 3

SECTION NEAR PIER NO. 3
SPAN NO. 3

QUARTER SECTION NEAR PIER NO. 3
SPAN NO. 4
SCALE: 1/2" = 1'-0"

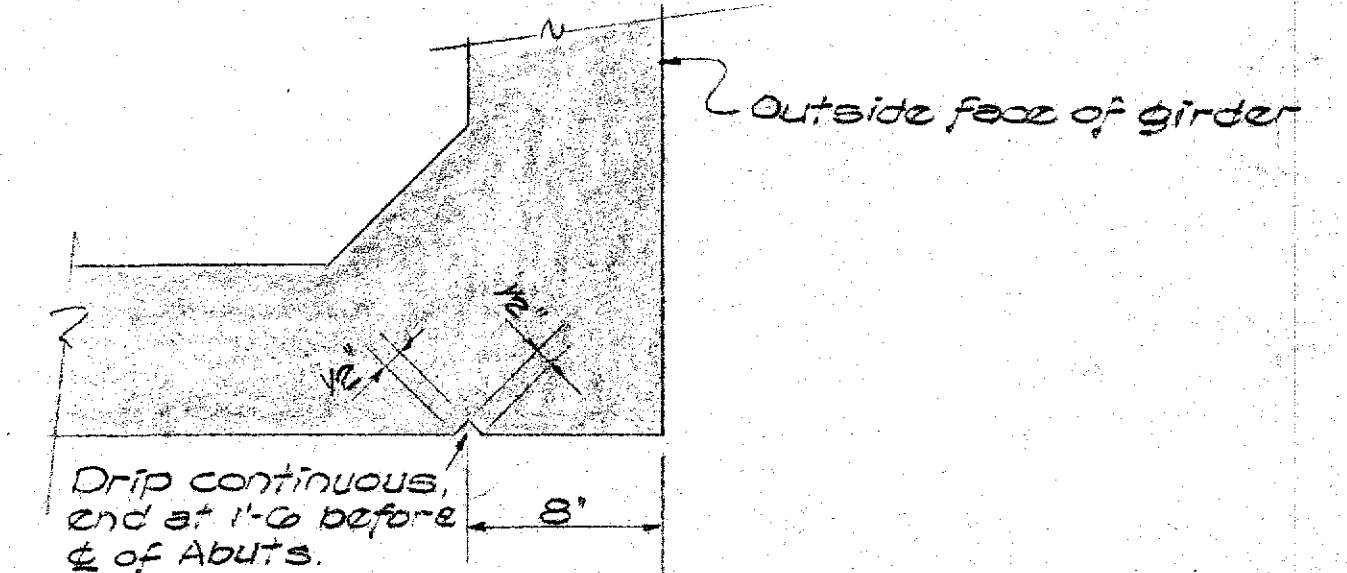


TYPICAL BOTTOM FLANG DRIP DETAIL
SCALE: 1/2" = 1'-0"

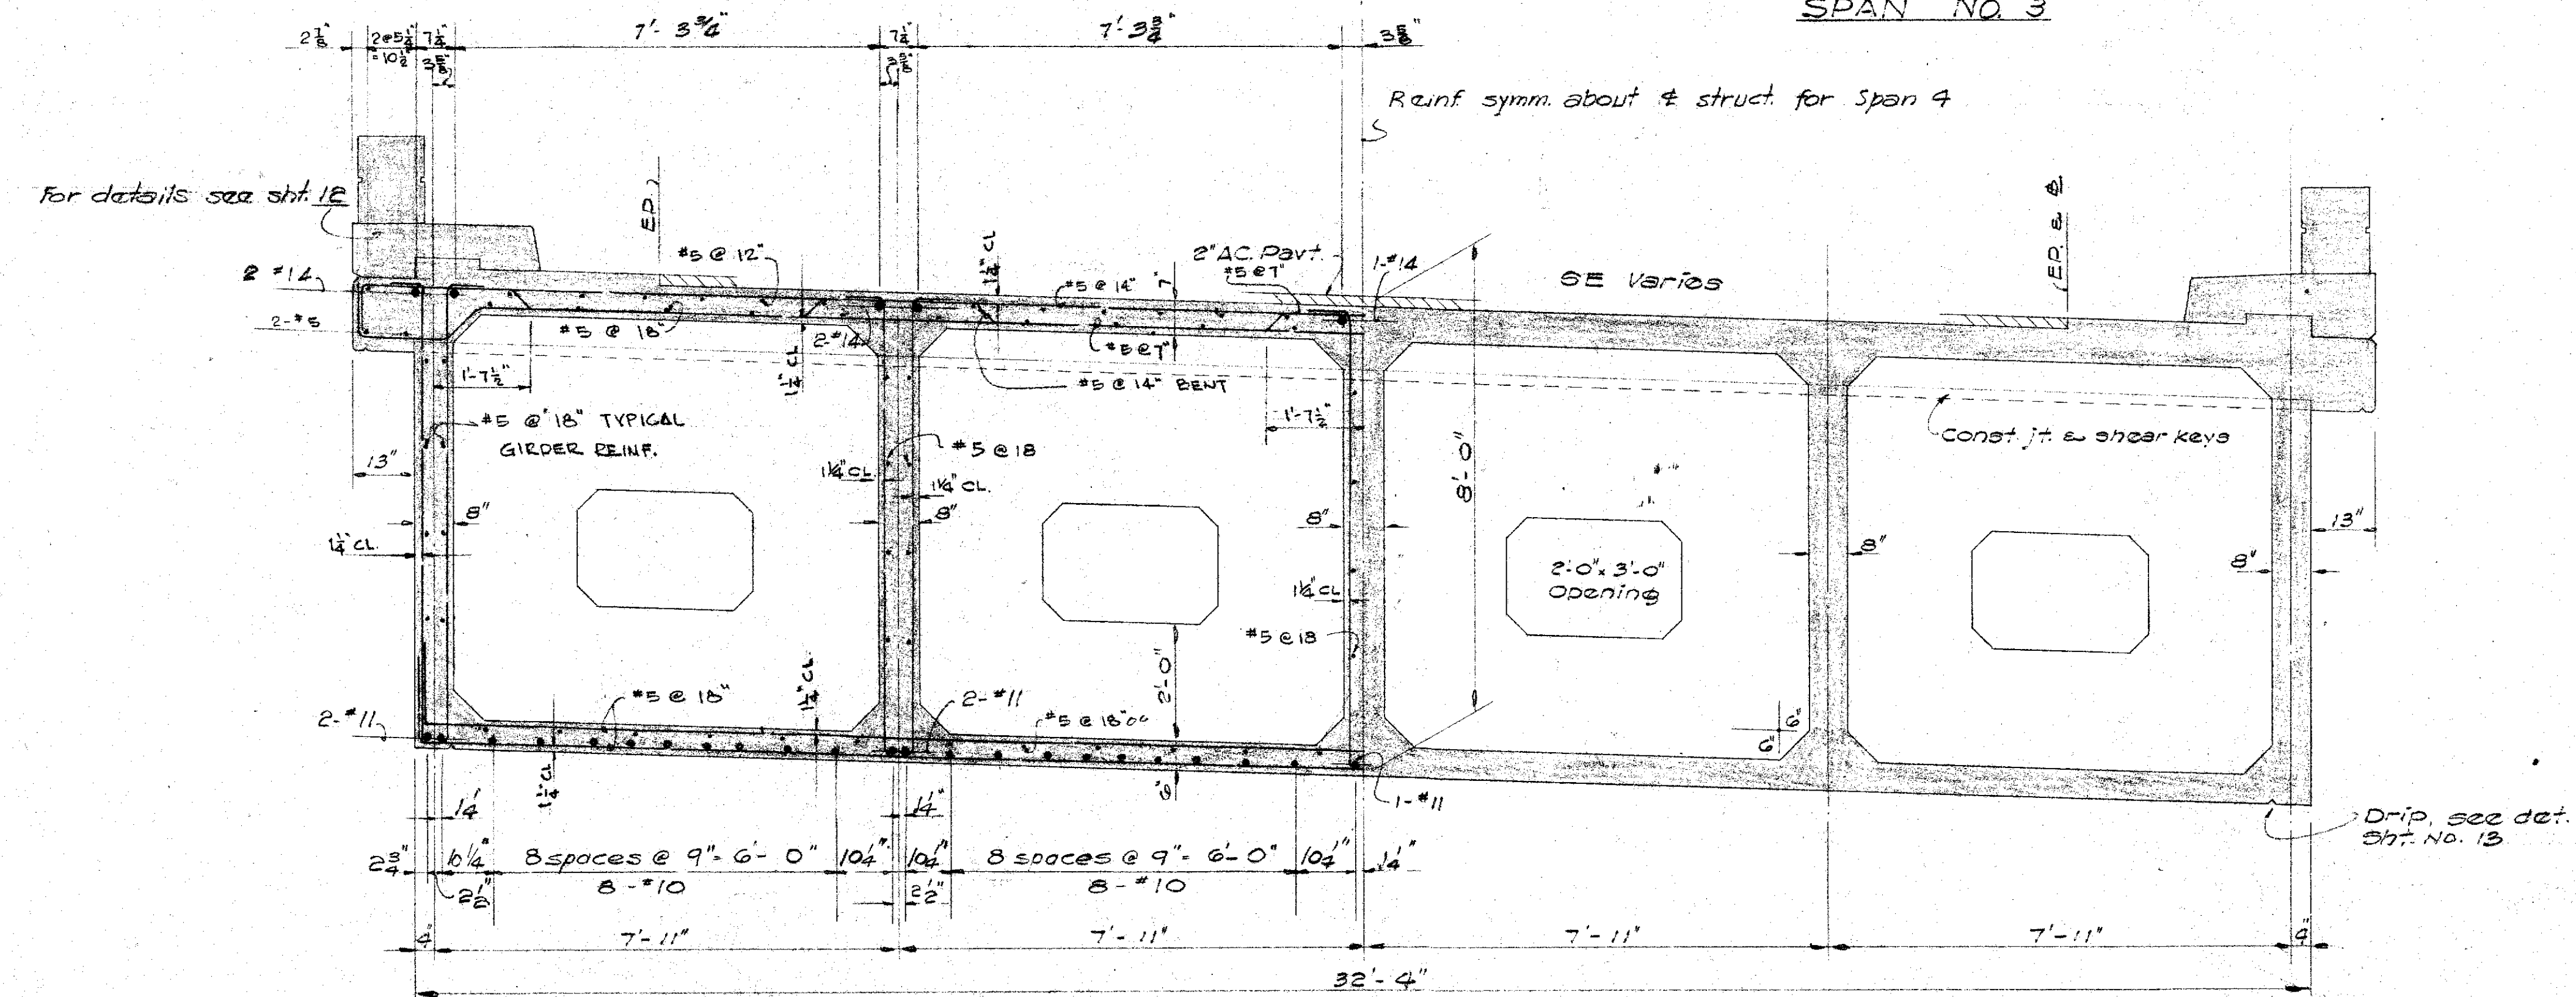

SECTION NEAR MIDSPAN - SPAN NO. 4
NORMAL SECTIONS
SCALE: 1/2" = 1'-0"

ORIGINAL PLAN	DATE
DESIGNED BY	
DRAWN BY	
CHECKED BY	
NOTED BY	
NO.	

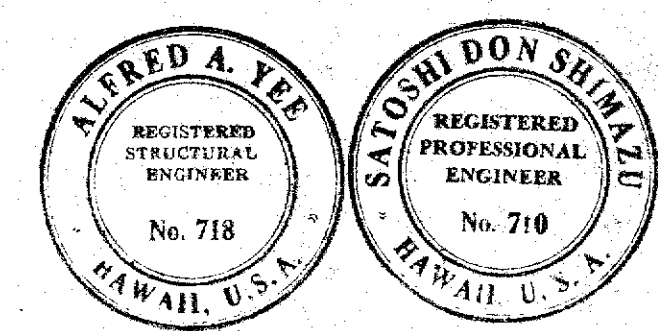


STATE OF HAWAII
DEPARTMENT OF TRANSPORTATION
HIGHWAYS DIVISION

BRIDGE No. 1
Base Line Sta. 159+35.22 to Sta. 163+21.22


VINEYARD BOULEVARD
PROJECT NO. F-035-1-(3)

CONSULTANT SUBMISSION


FED. ROAD DIST. NO.	STATE	FED. AID PROJ. NO.	FISCAL YEAR	SHEET NO.	TOTAL SHEETS
				17	28

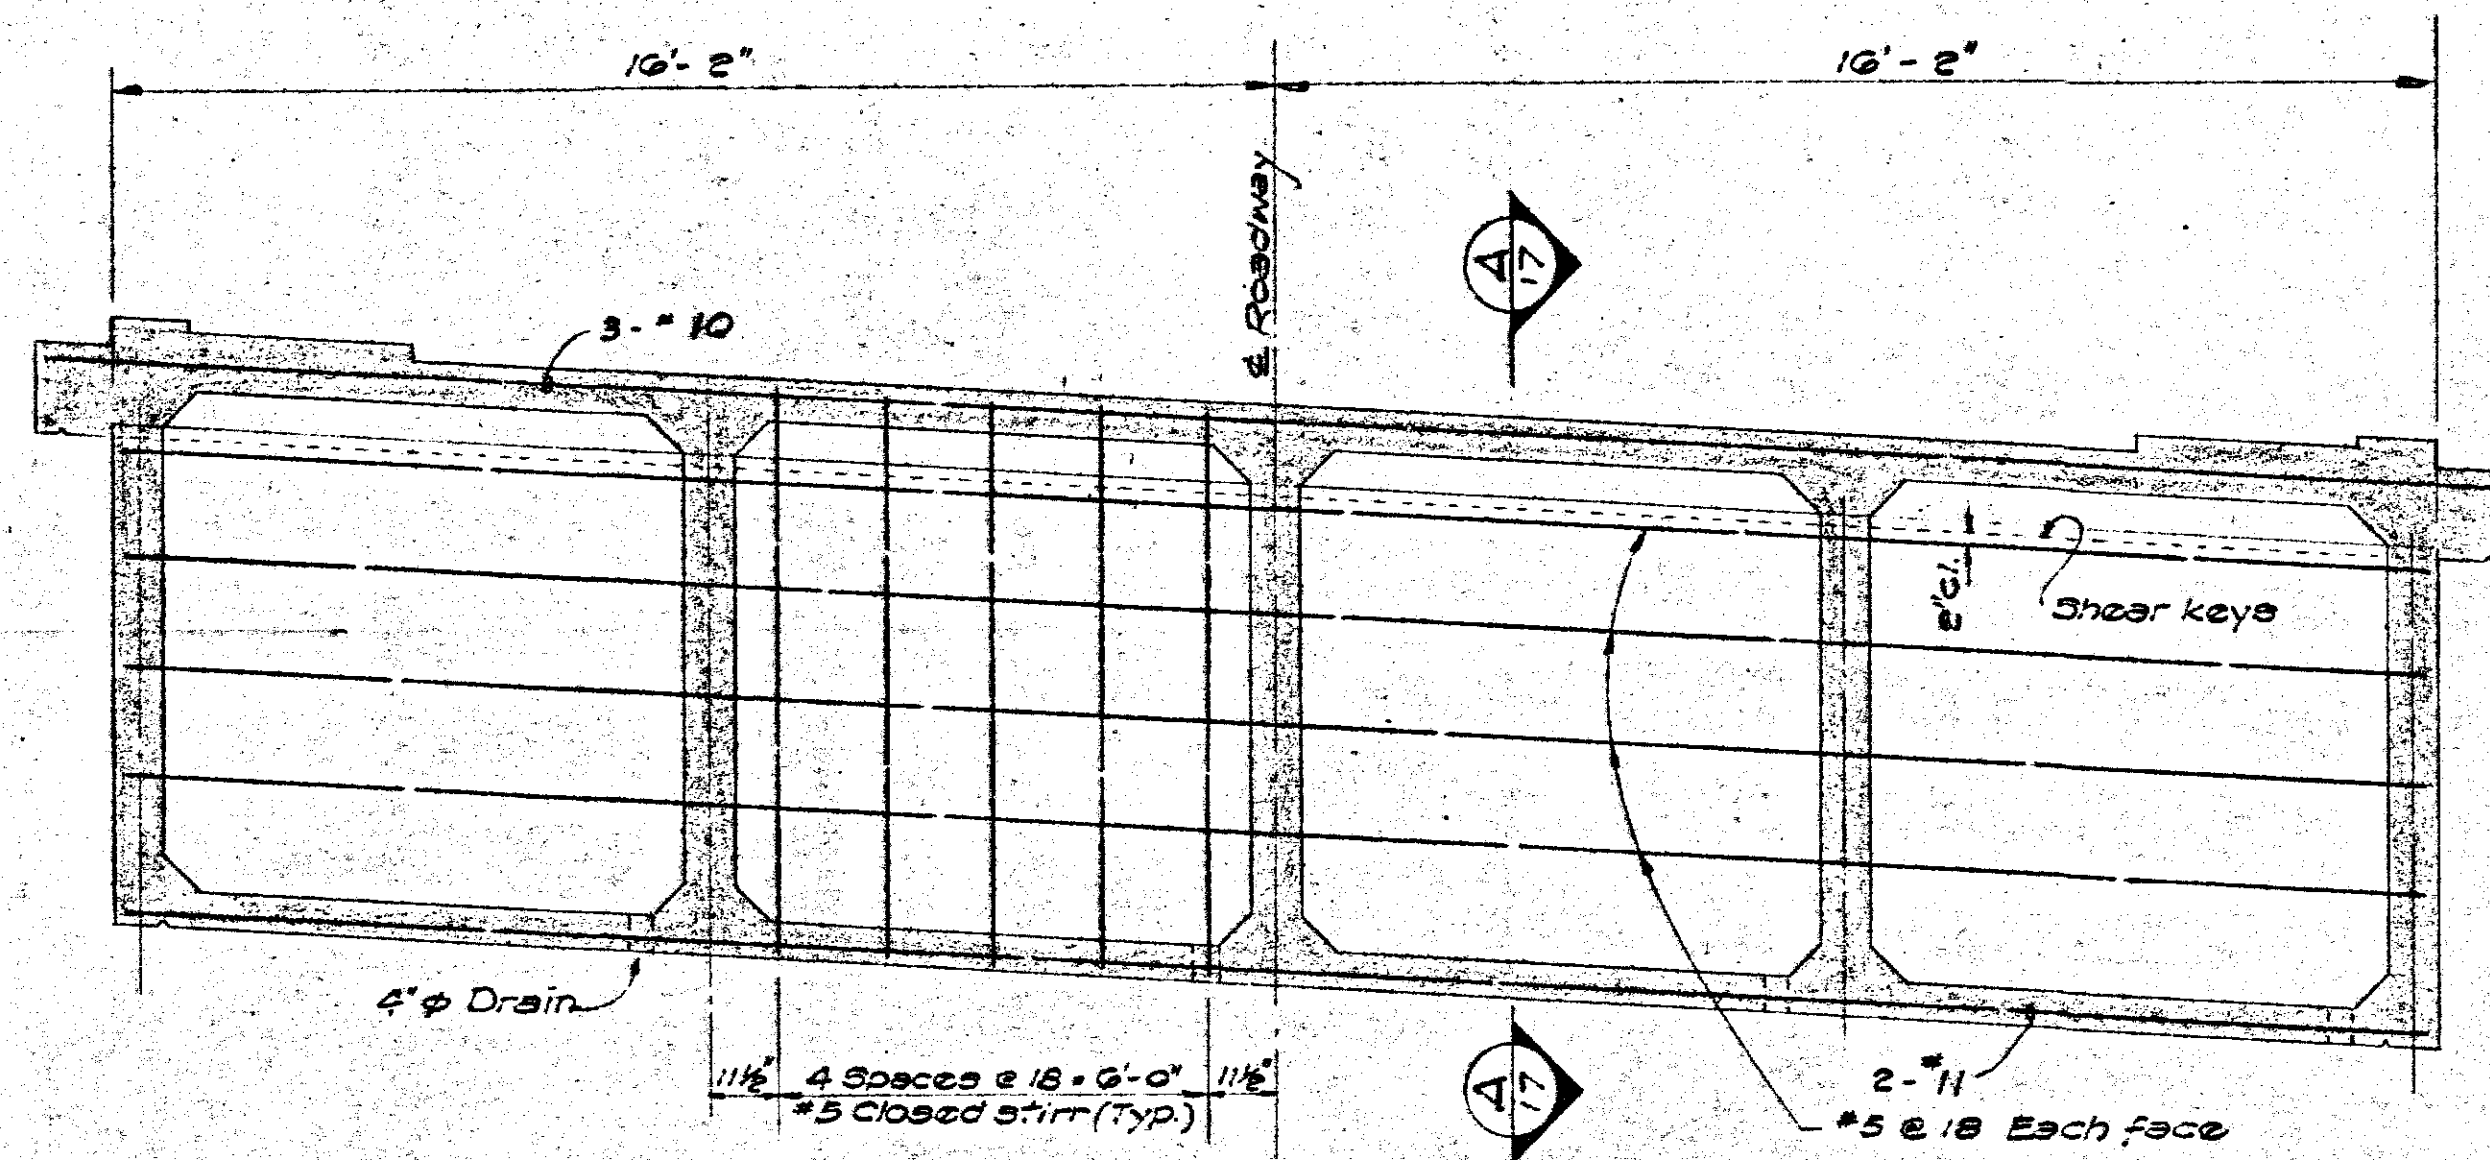


BEAM "A"
Scale: 3/8" = 1'-0"

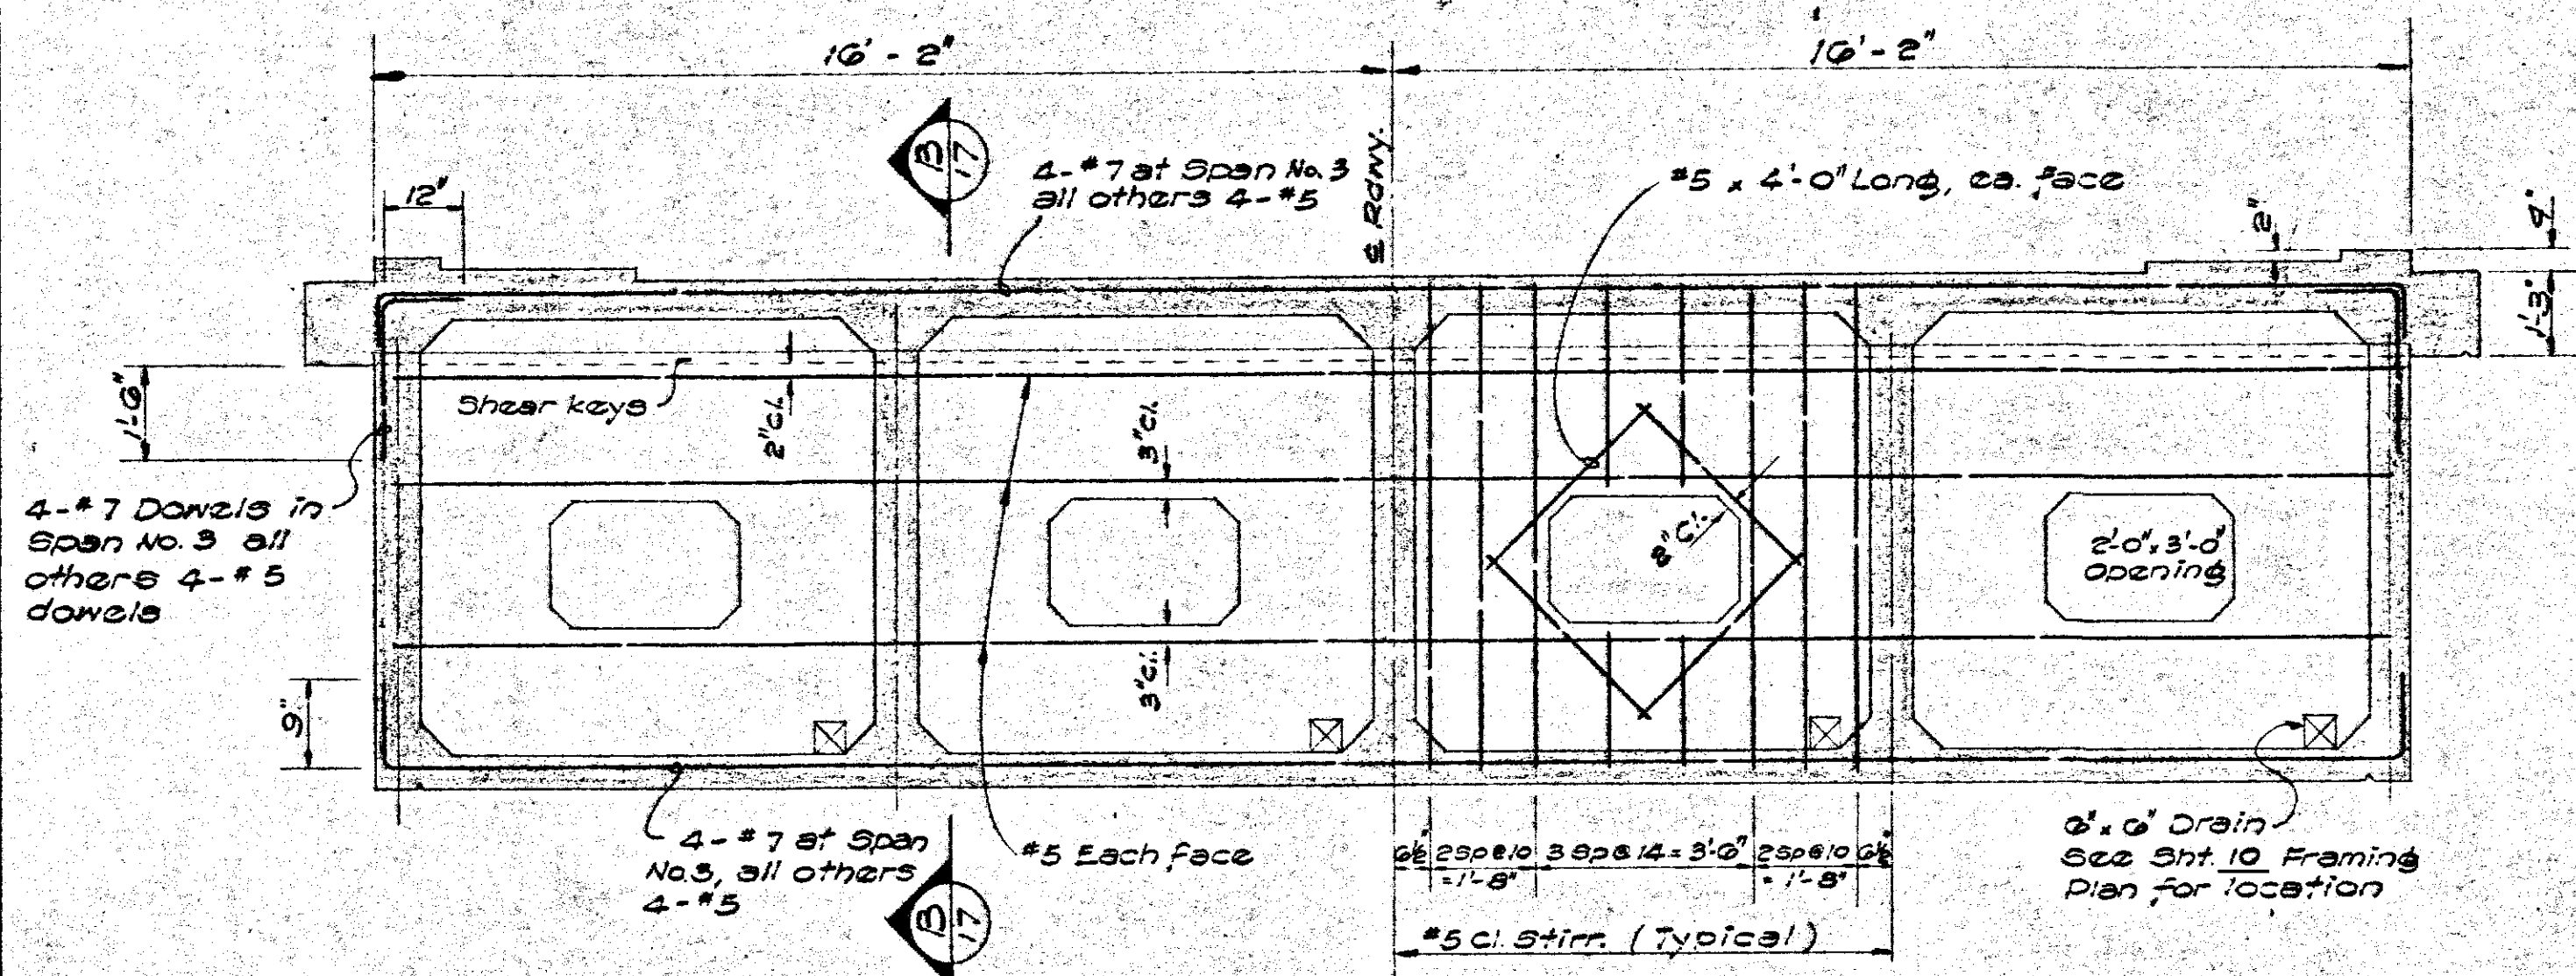


BEAM "B"
Scale: 3/8" = 1'-0"

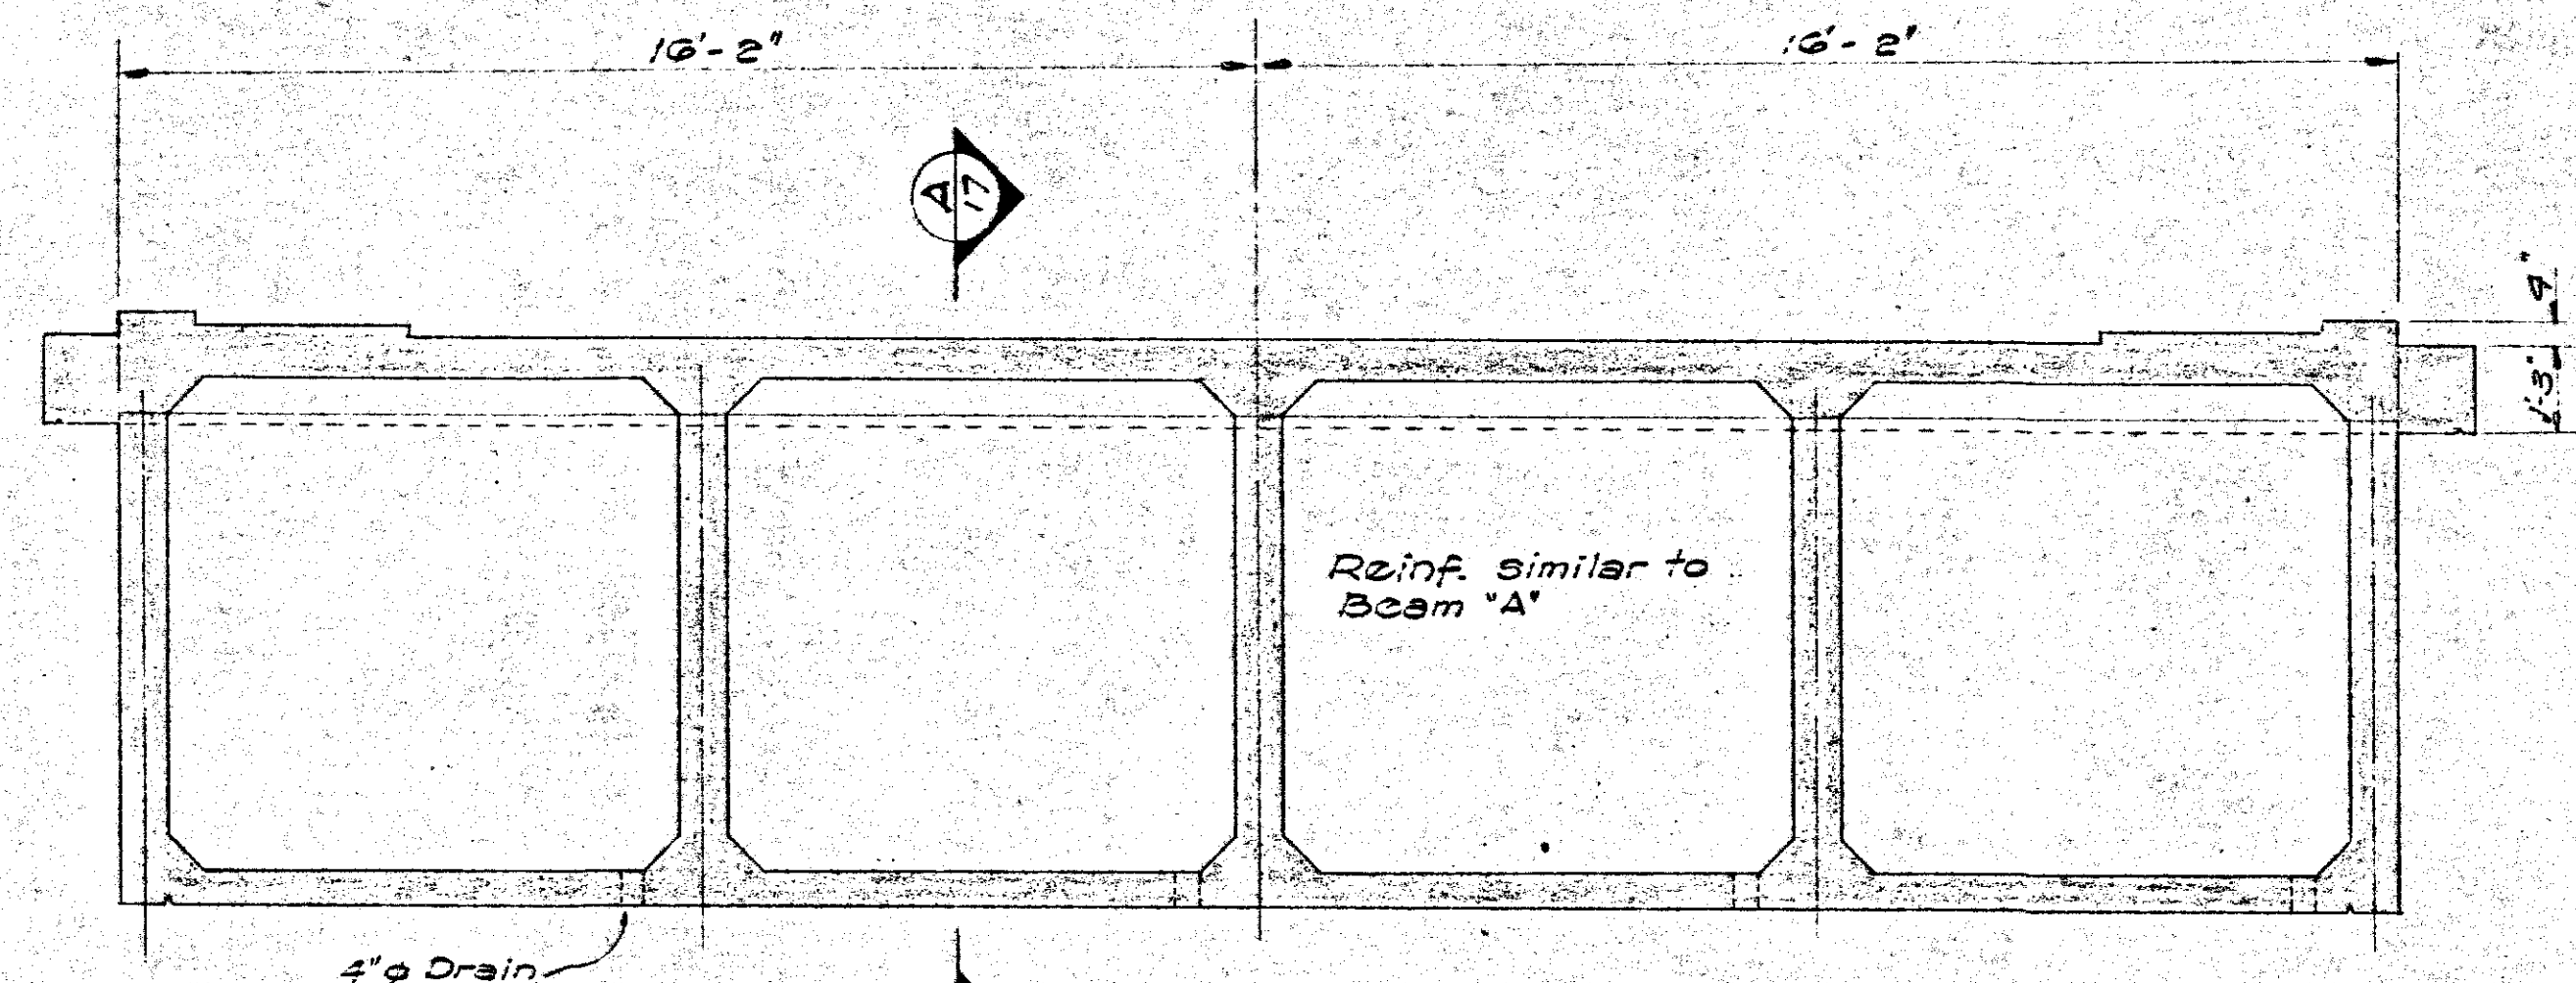


BEAM "H"
Scale: 3/8" = 1'-0"

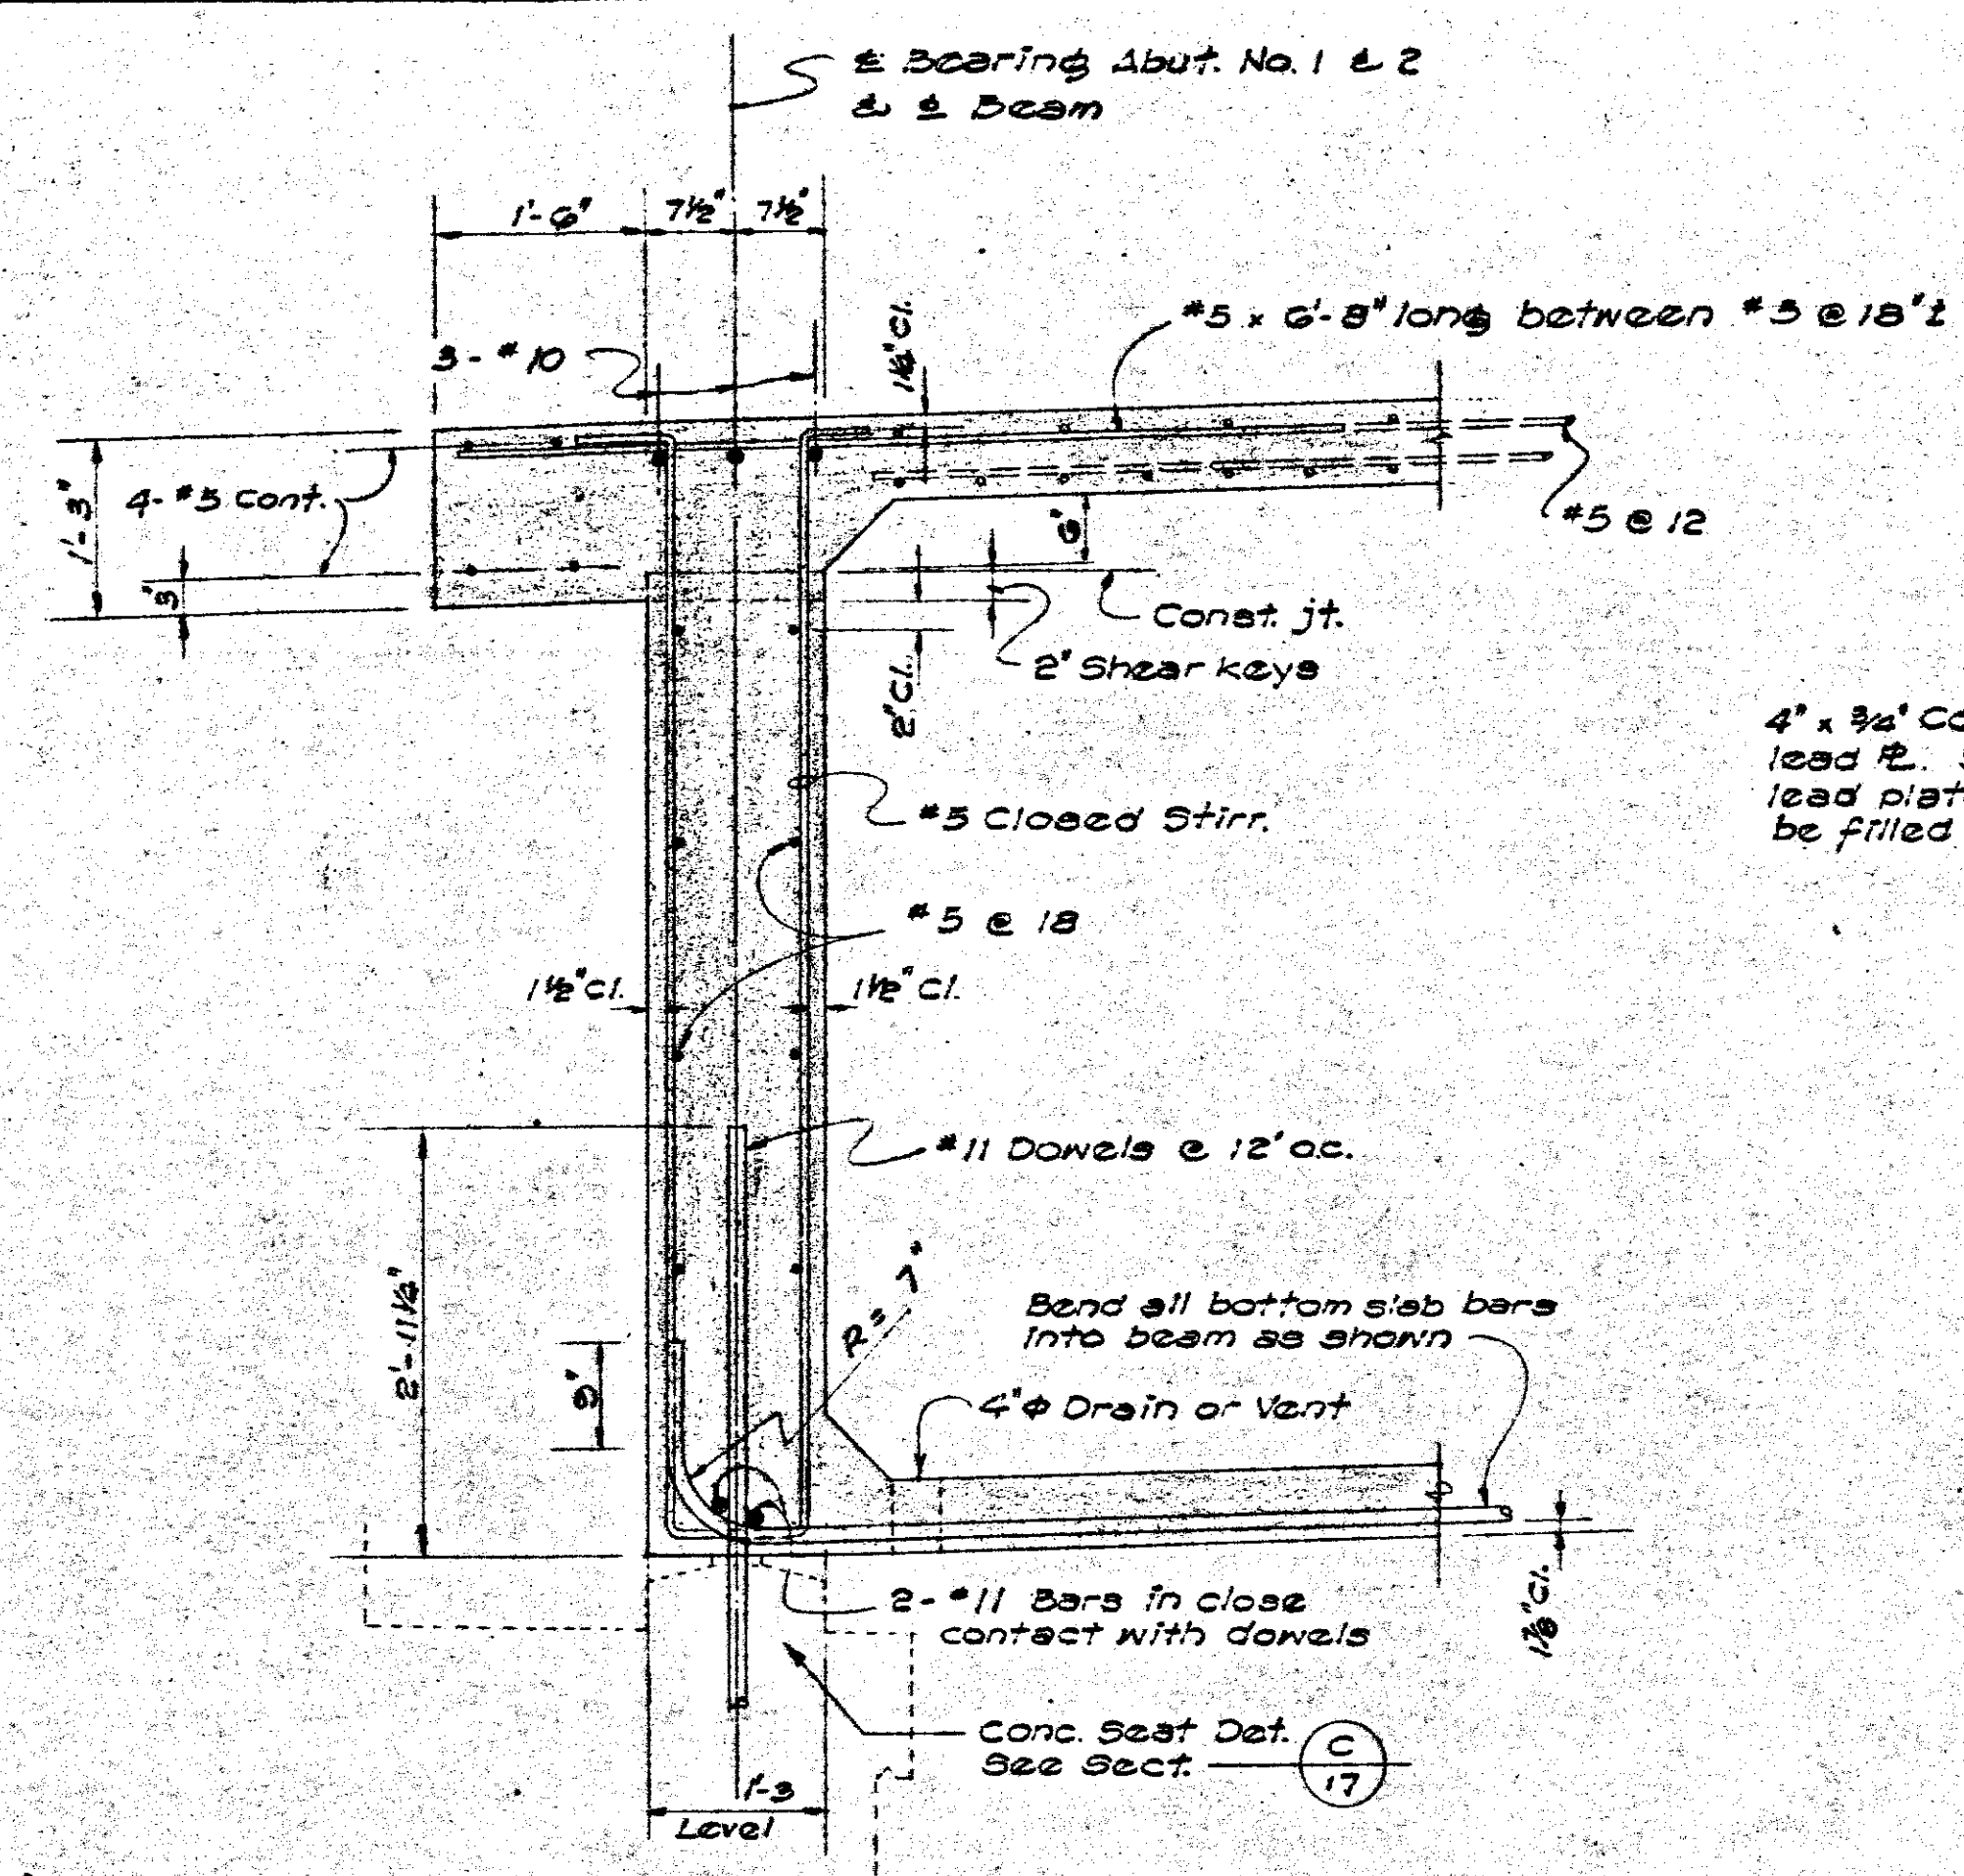

SECTION A-A
Scale: 3/4" = 1'-0"

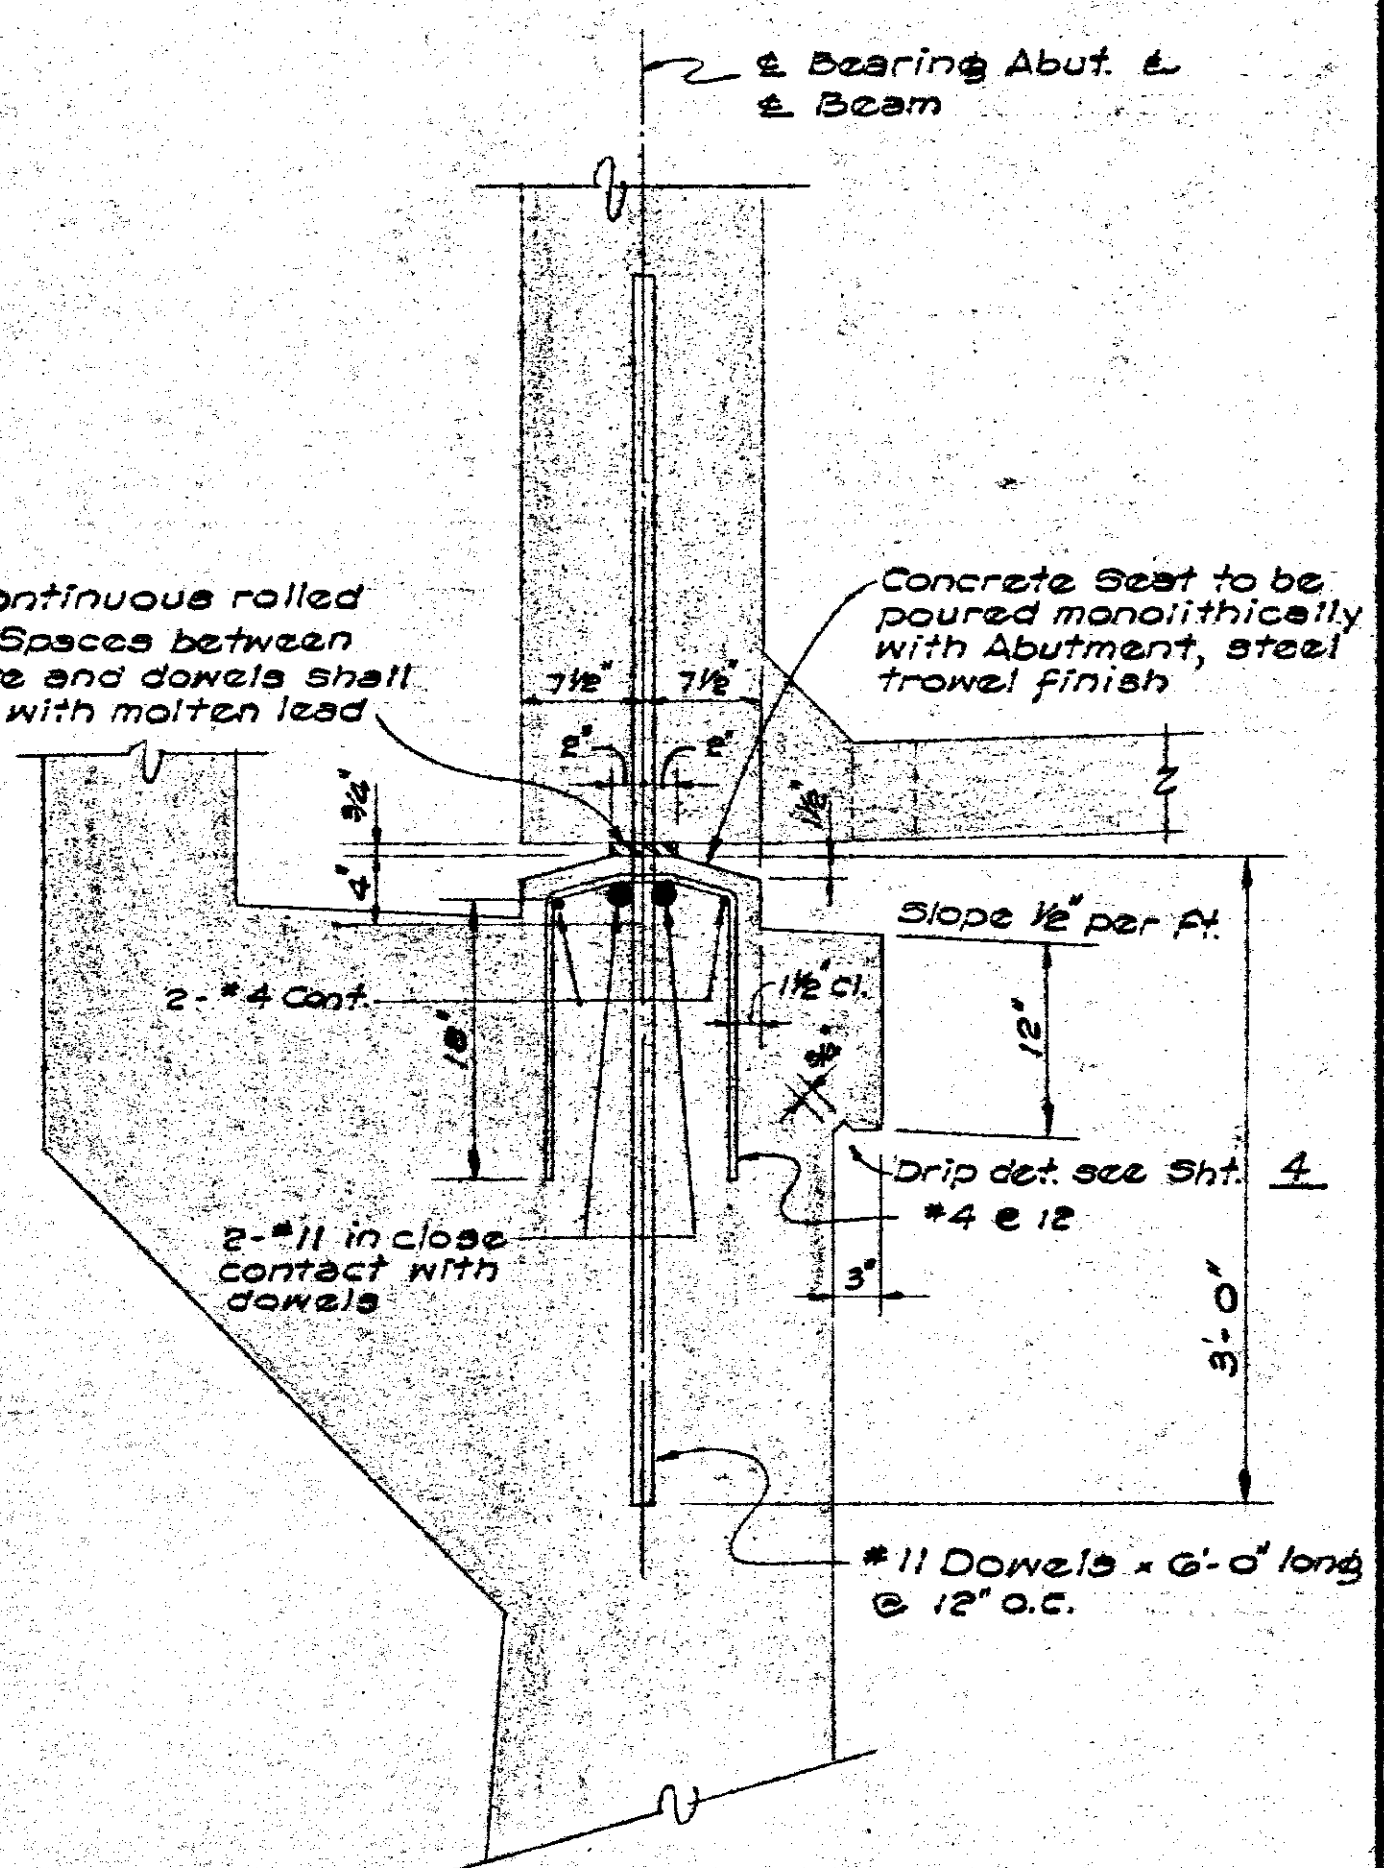


SECTION C-C
Scale: 1" = 1'-0"

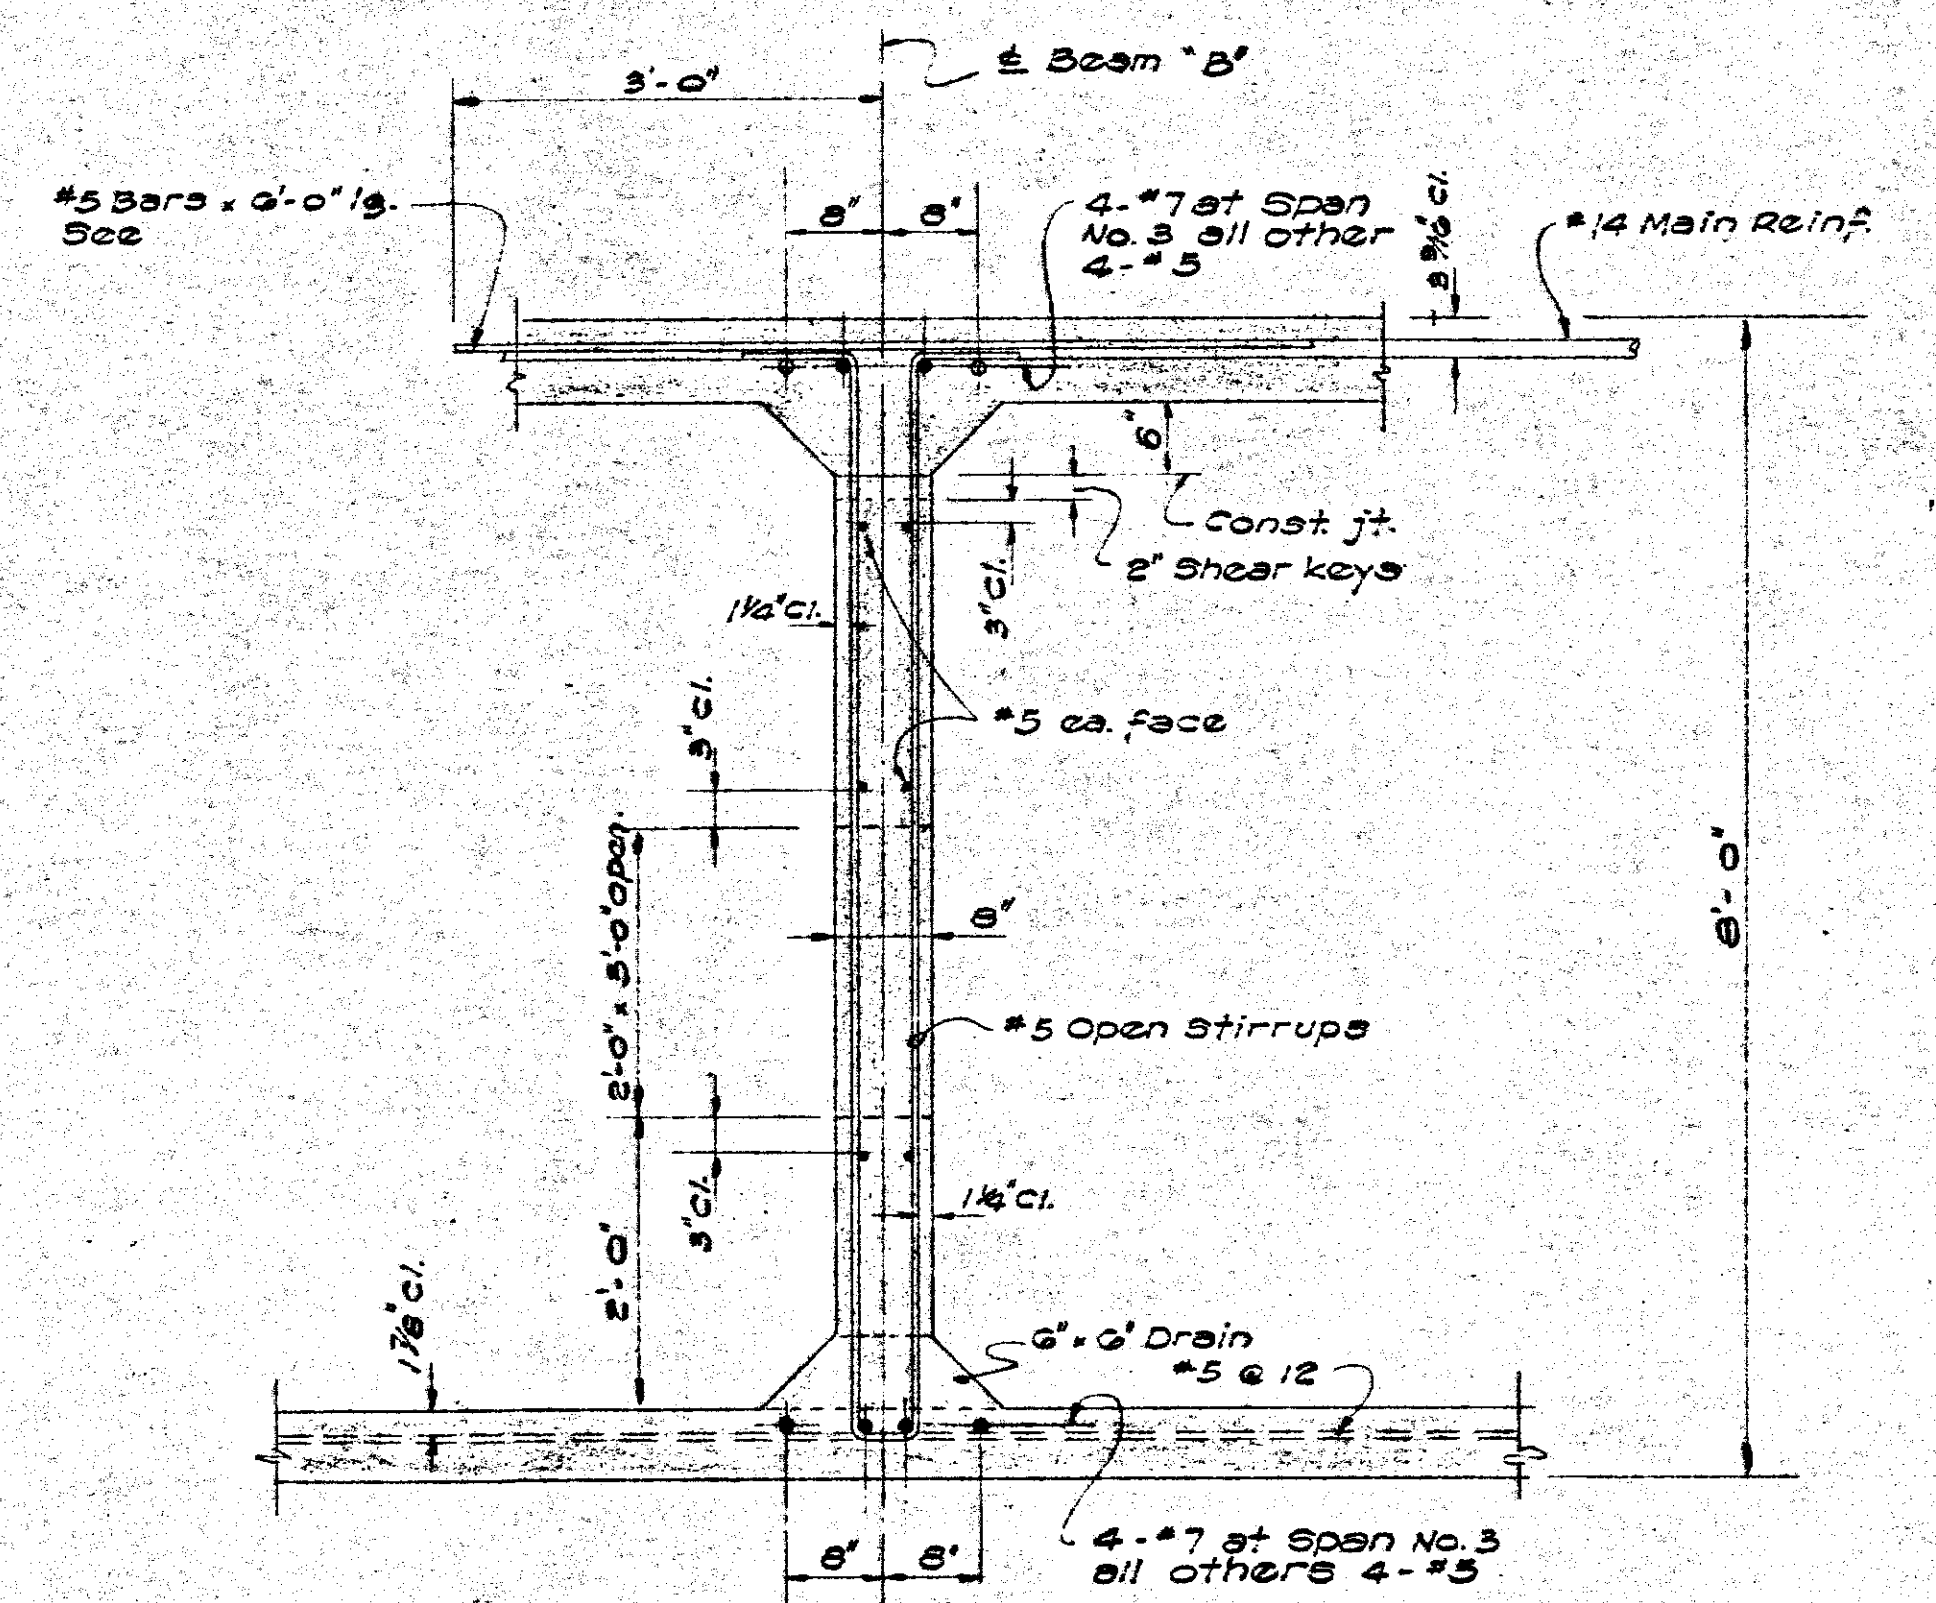

SECTION B-B
Scale: 3/4" = 1'-0"

SURVEY PLOTTED BY	DATE
DESIGNED BY	
TRACED BY	
QUANTITIES BY	
CHECKED BY	
NOTE BOOK No.	

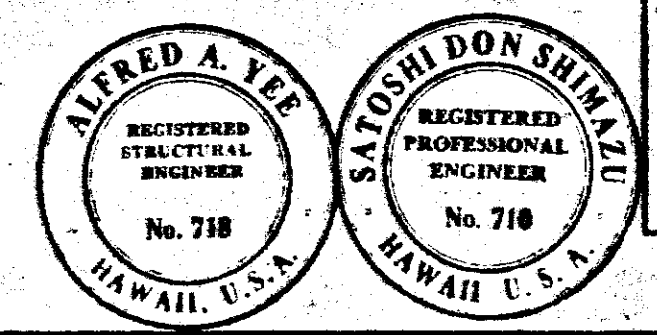


STATE OF HAWAII
DEPARTMENT OF TRANSPORTATION
HIGHWAYS DIVISION
BRIDGE No. 1
Base Line Sta 159+38.53 to Sta. 163+91.83
VINEYARD BOULEVARD
PROJECT NO F-058-1-(3)

SHEET No. 17 OF 28 SHEETS

CONSULTANT SUBMISSION


5928.74

FED. ROAD DIST. NO.	STATE	FED. AID PROJ. NO.	FISCAL YEAR	SHEET NO.	TOTAL SHEETS

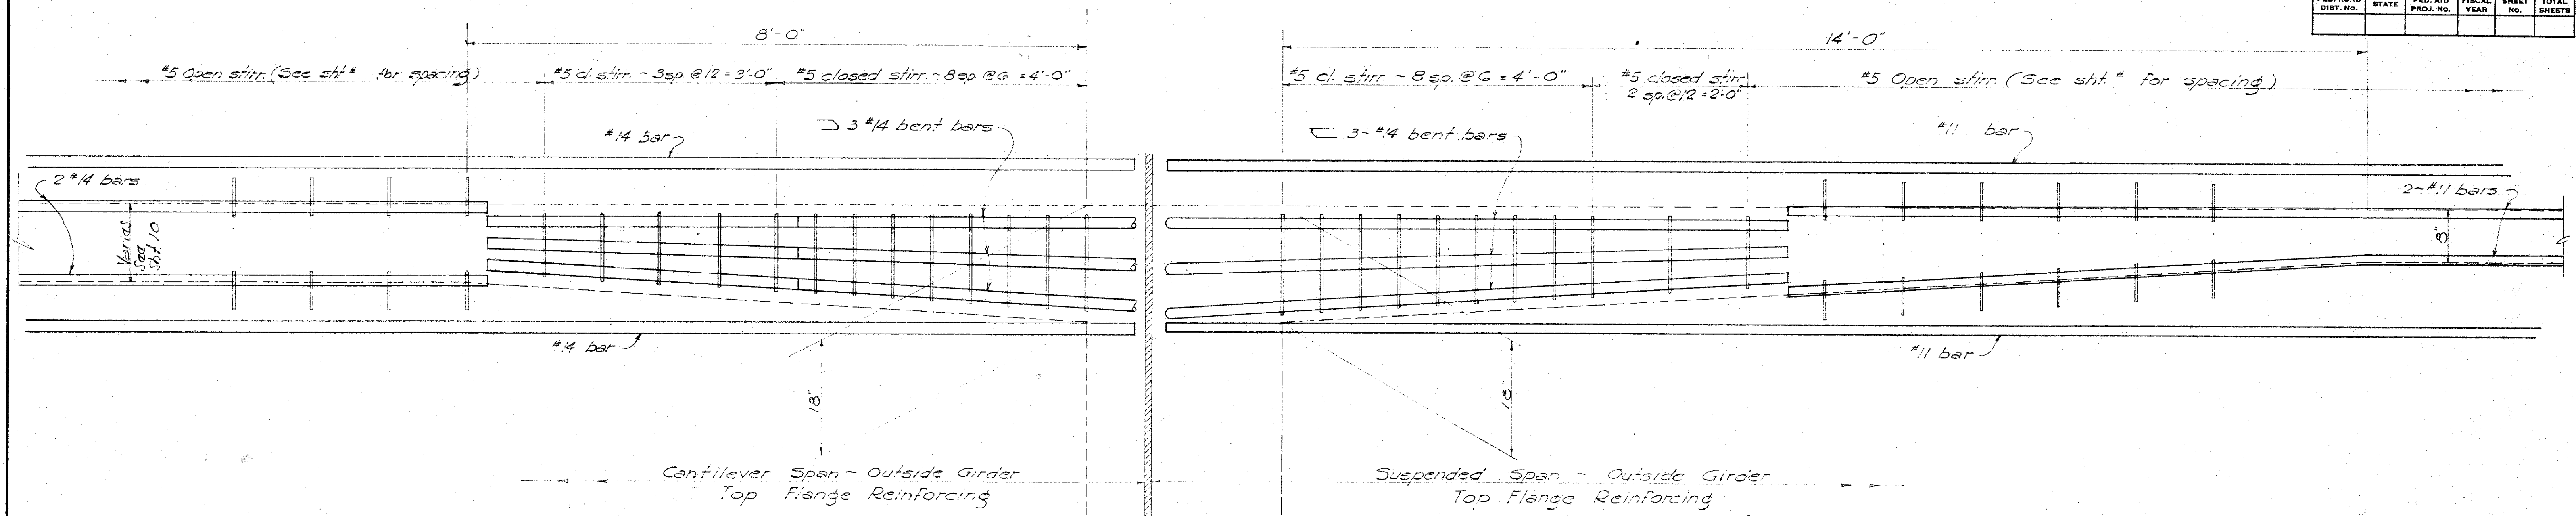


PLAN ~ OUTSIDE GIRDER ~ TOP FLANGE REINFORCING

Scale 1" = 1'-0"

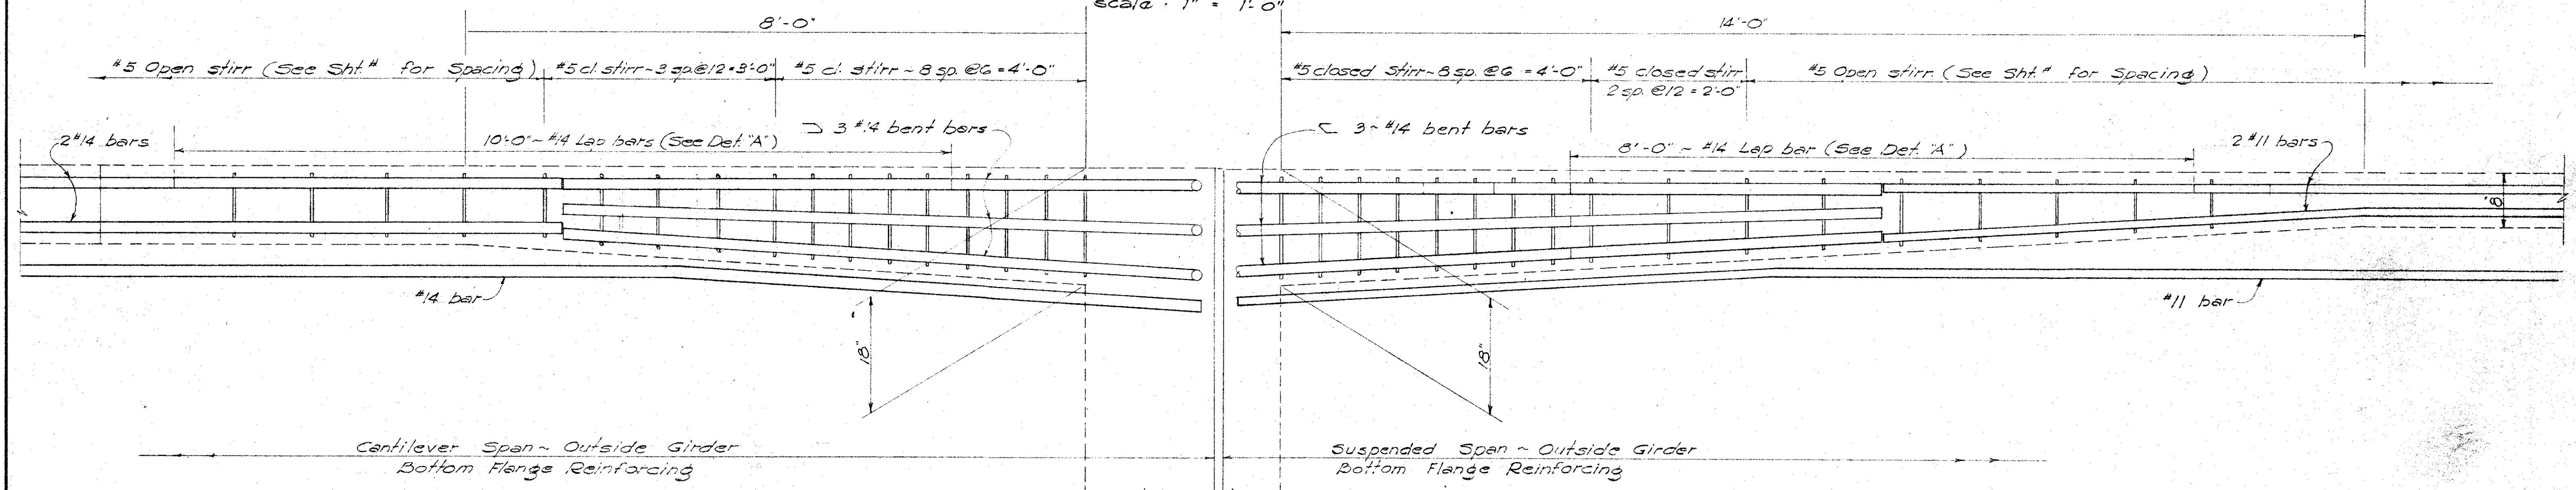


PLAN ~ OUTSIDE GIRDER ~ BOTTOM FLANGE REINFORCING

Scale 1" = 1'-0"

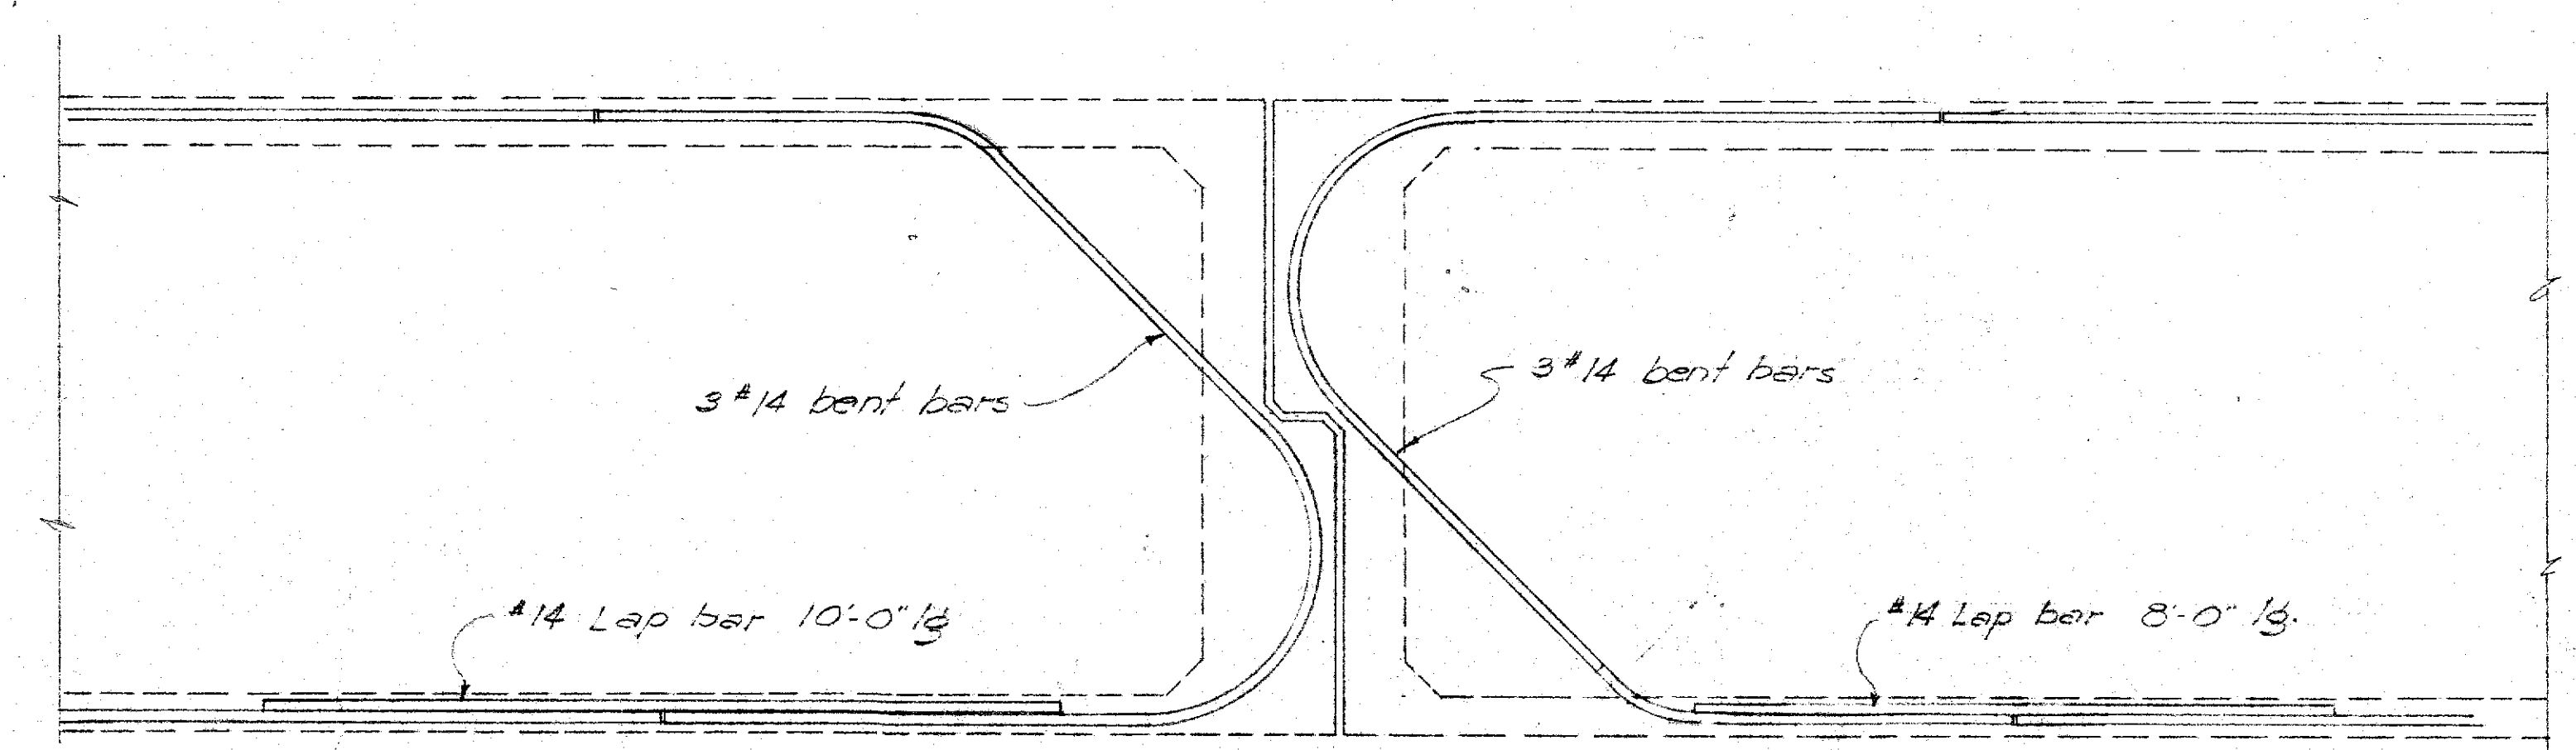

DETAIL "A"

SURVEY PLOTTED BY	DATE
DESIGNED BY	
DRAWN BY	
NOTE BOOK	
QUANTITIES CHECKED BY	
CHECKED BY	
NO.	

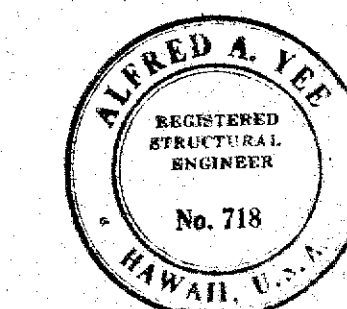


STATE OF HAWAII
DEPARTMENT OF TRANSPORTATION
HIGHWAYS DIVISION
BRIDGE #1
Base Line Sta. 159+38.38 to Sta. 163+21.23
VINEYARD BOULEVARD
PROJECT No. F-058-1-(3)

SHEET No. 19 OF 22 SHEETS

CONSULTANT SUBMISSION



5928.76

ORIGINAL	SURVEY PLOTTED BY	DATE
PLAN	DESIGNED BY	"
	DRAWN BY	"
	TRACED BY	"
NOTE BOOK	QUANTITIES BY	"
	QUANTITIES CHECKED BY	"
No.	CHECKED BY	"

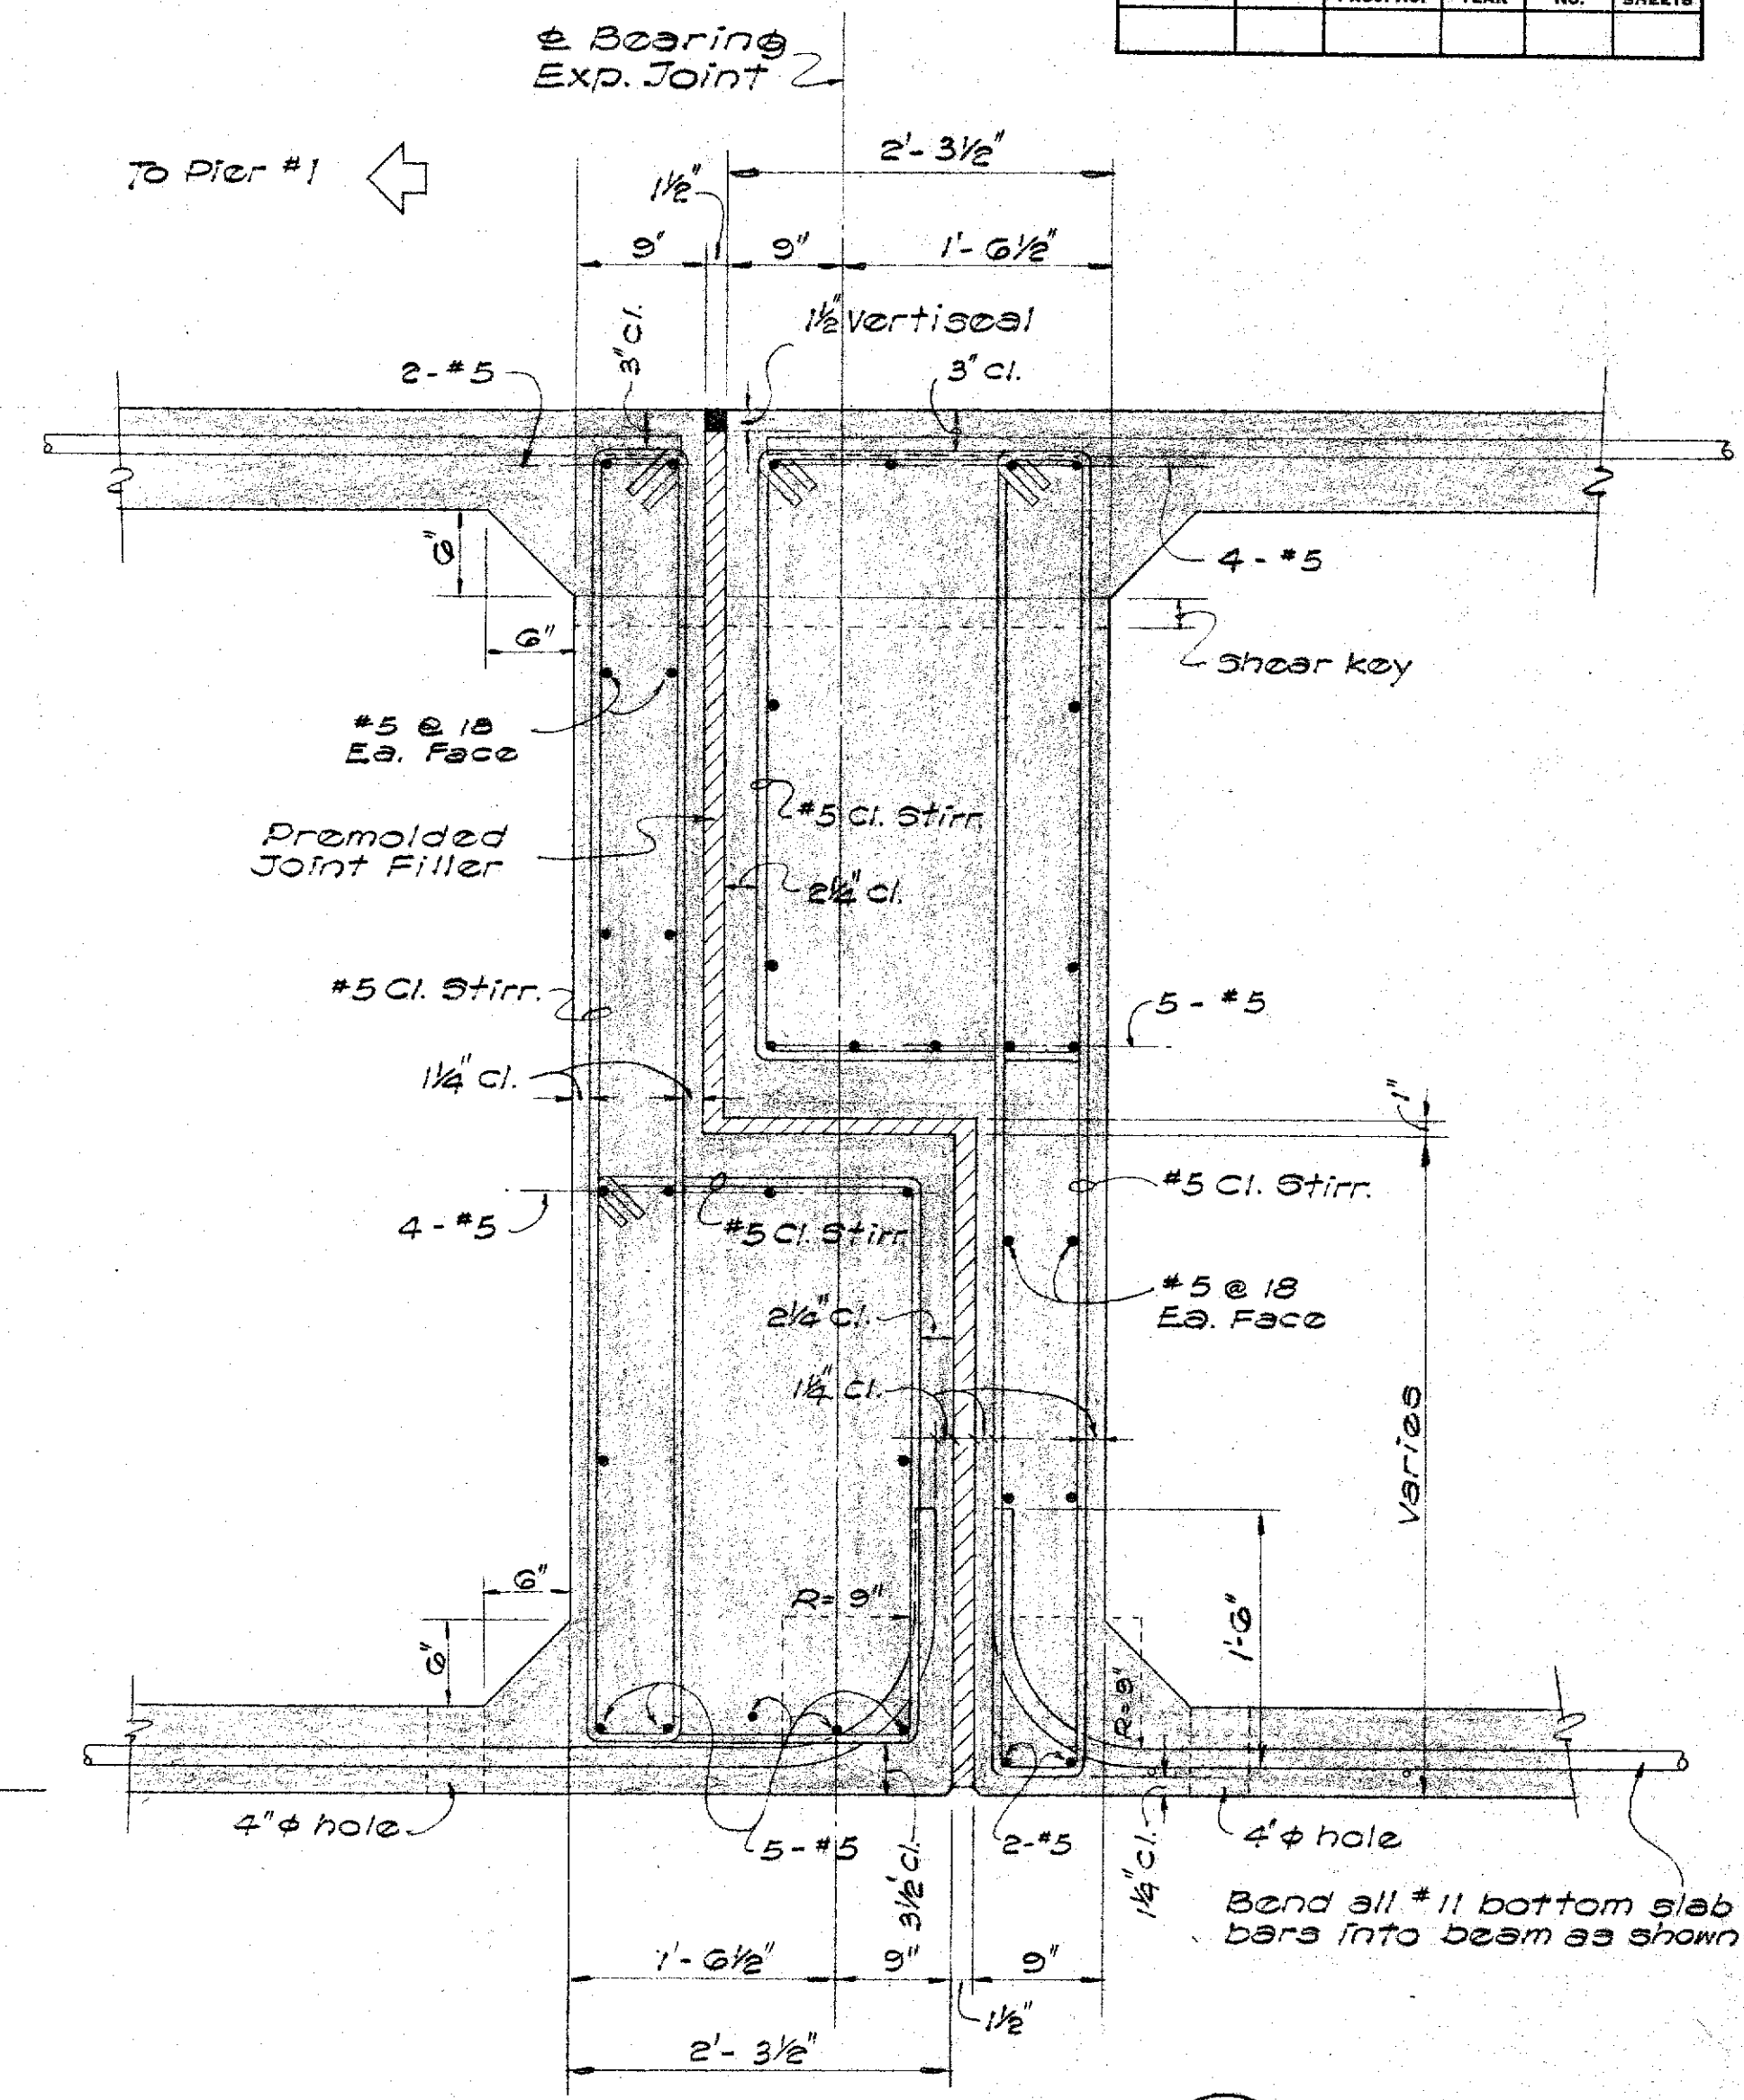

SECTION — B
20

Scale: $1" = 1' - 0"$

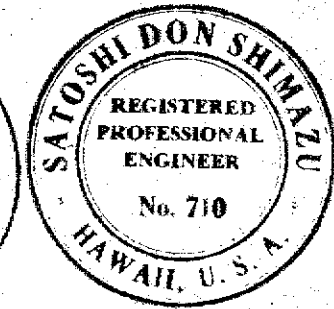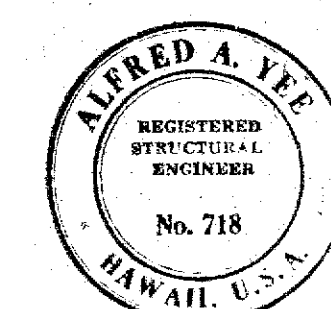

SHEET No. 20 OF 22 SHEETS

Technical drawing of a bearing assembly showing a cross-section of a shaft with a bearing, sole plate, and masonry plate. Dimensions include 1 1/2 inch, 3 inch, 10 inch, 4 1/2 inch, 1 inch, 8 inch, 3 1/2 inch R, 1 1/2 inch, 1 inch, 12 inch, 3 inch, and 1 1/2 inch. Labels include 'Lubrite or equal', 'Finish ASA 250', 'Grout Pad monolithic pour', 'Pt. of Elev.', 'Masonry Plate (Bronze)', 'Sole Plate (steel)', and 'Bearing'.

Technical drawing of a window sill assembly, showing a cross-section with various components and dimensions. The drawing includes the following labels and dimensions:

- Top Dimensions:**
 - Overall width: $1'-3\frac{1}{8}"$
 - Left side offset: $1" - \frac{1}{16}"$
 - Right side offset: $1" - \frac{1}{16}"$
- Internal Components and Dimensions:**
 - #11 Anchors x 15" long:** Indicated by a dashed line and dimension $15\frac{3}{16}"$.
 - Bearing 12:** Indicated by a dashed line.
 - Sole Plate (Steel):** The main horizontal component, with a thickness of $\frac{1}{2}"$.
 - Masonry Plate (Bronze):** A central plate with a width of $1'-4\frac{1}{2}"$.
 - Grout Pad:** Located at the bottom center.
 - Shear Pin:** A $1\frac{1}{4}"$ shear pin x $1'-3"$ is shown on the left side.
- Other Dimensions:**
 - Left side vertical offset: $1" - \frac{1}{4}"$
 - Right side vertical offset: $1" - \frac{1}{4}"$
 - Bottom vertical offset: $1" - 2"$
 - Bottom overall width: $1'-10"$
- Notes:**
 - "Lubrite or equal." is written near the top left.

A diagram of a rectangular plate. The top edge is dimensioned as 1'-1" with two 6 1/2" segments. The right edge is dimensioned as 4" with two 4" segments. The left edge is labeled "± bearing" with an arrow pointing to it. The bottom edge is labeled "→ ± bearing" with an arrow pointing to it.

1' - 3 1/8"

1' - 1 1/8"

1'

5"

5 1/4"

1' 0"

#11 Anchors

PLAN - SOLE PLATE





Scale: 1/2" = 1' 0"

Hand-drawn technical drawing of a rectangular plate with dimensions and annotations:


- Overall Dimensions:**
 - Width: $1'-1\frac{1}{8}"$
 - Height: $10"$
- Internal Dimensions and Spacing:**
 - Top edge: $3\frac{7}{8}"$ from left and right edges.
 - Bottom edge: $3\frac{7}{8}"$ from left and right edges.
 - Left edge: $1\frac{1}{4}"$ from top and bottom edges.
 - Right edge: $1\frac{1}{4}"$ from top and bottom edges.
 - Horizontal spacing between vertical lines: $6\frac{9}{16}"$ (twice).
 - Vertical spacing between horizontal lines: $4"$ (twice).
- Annotations:**
 - Top right: $1\frac{3}{8}"$ Holes for $1\frac{1}{4}" \phi$ Shear pin.
 - Bottom left: ϕ Bearing
 - Bottom right: ϕ Bearing
 - Bottom center: Provide 4 Taps for placing

5928.78

FED. ROAD DIST. NO.	STATE	FED. AID PROJ. NO.	FISCAL YEAR	SHEET NO.	TOTAL SHEETS
				22	62

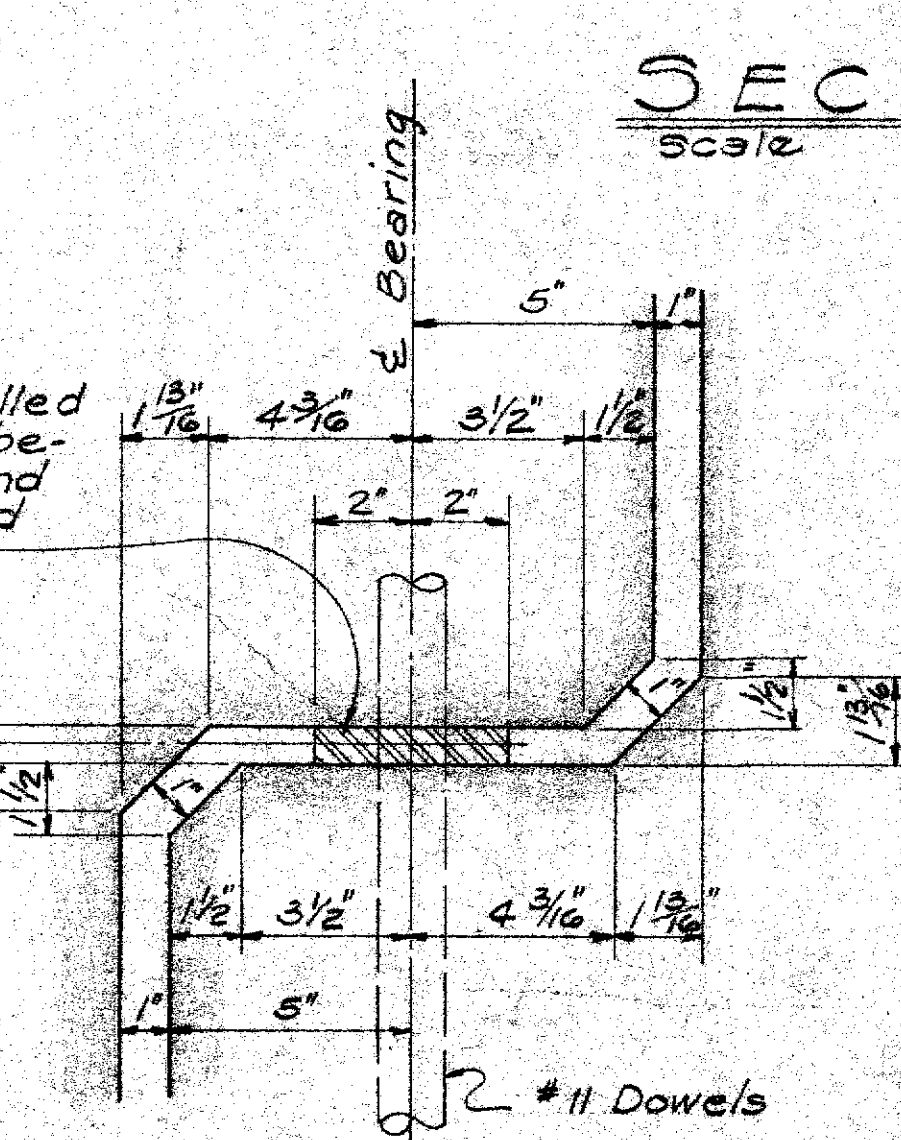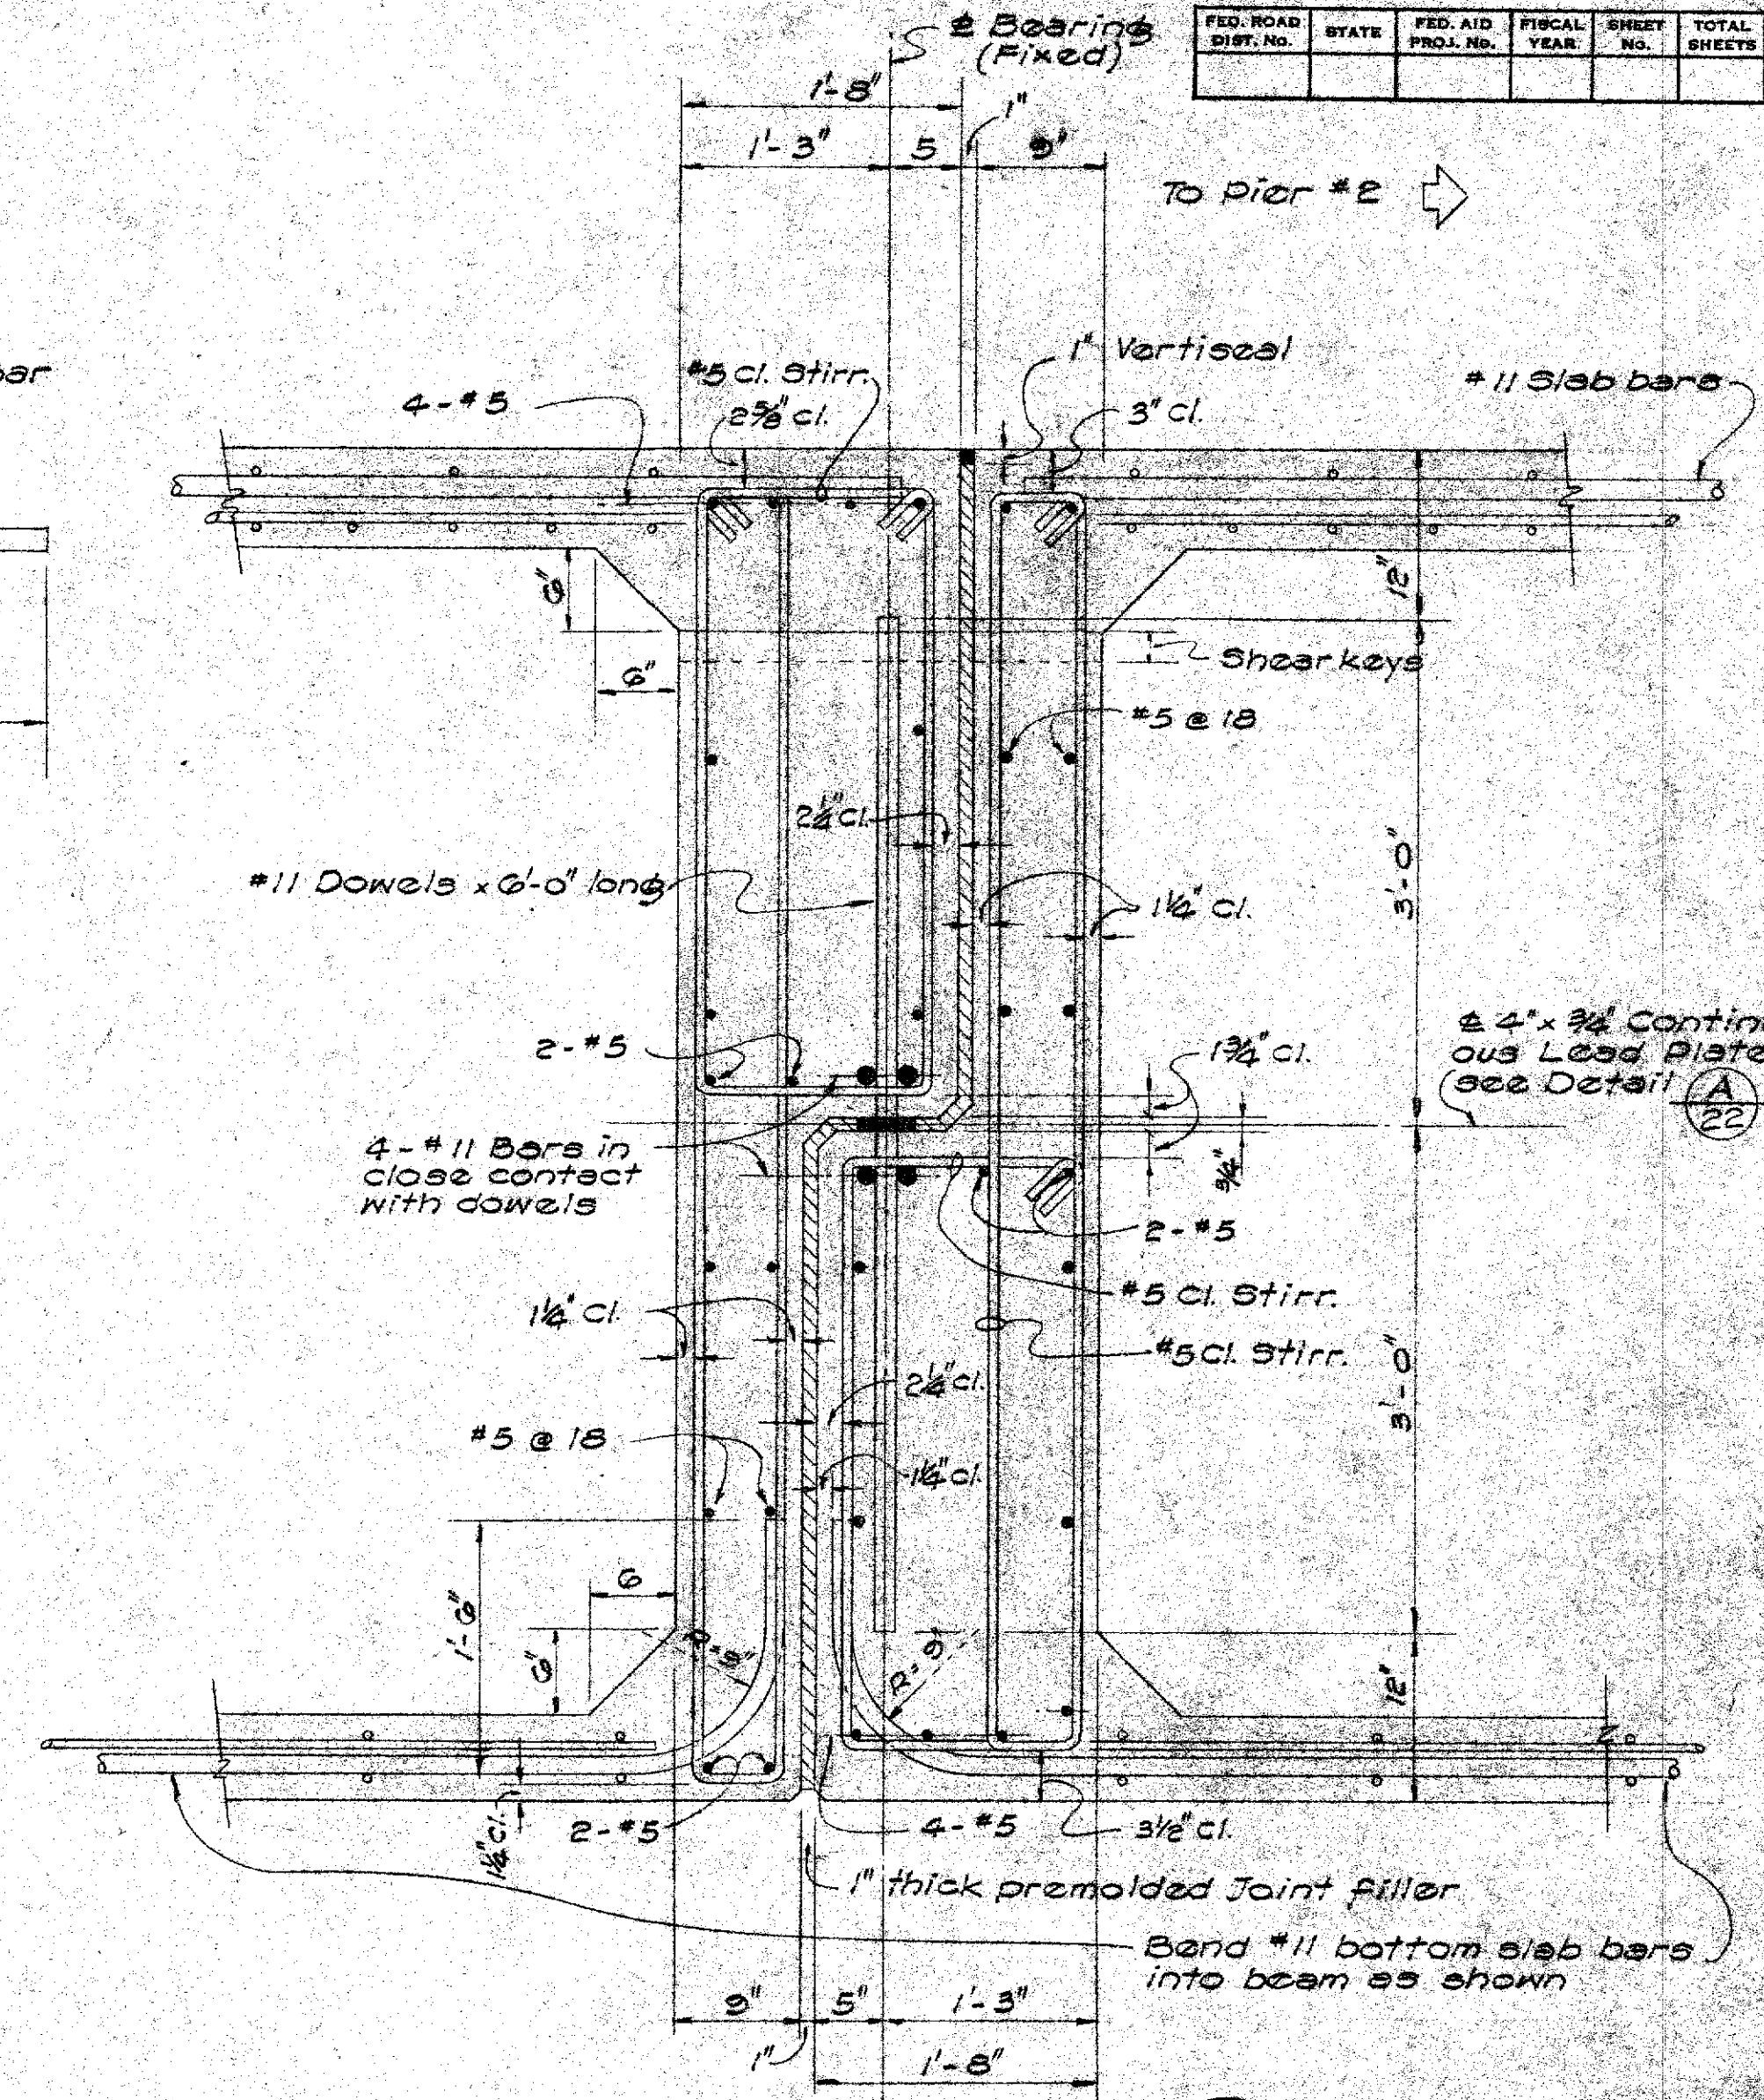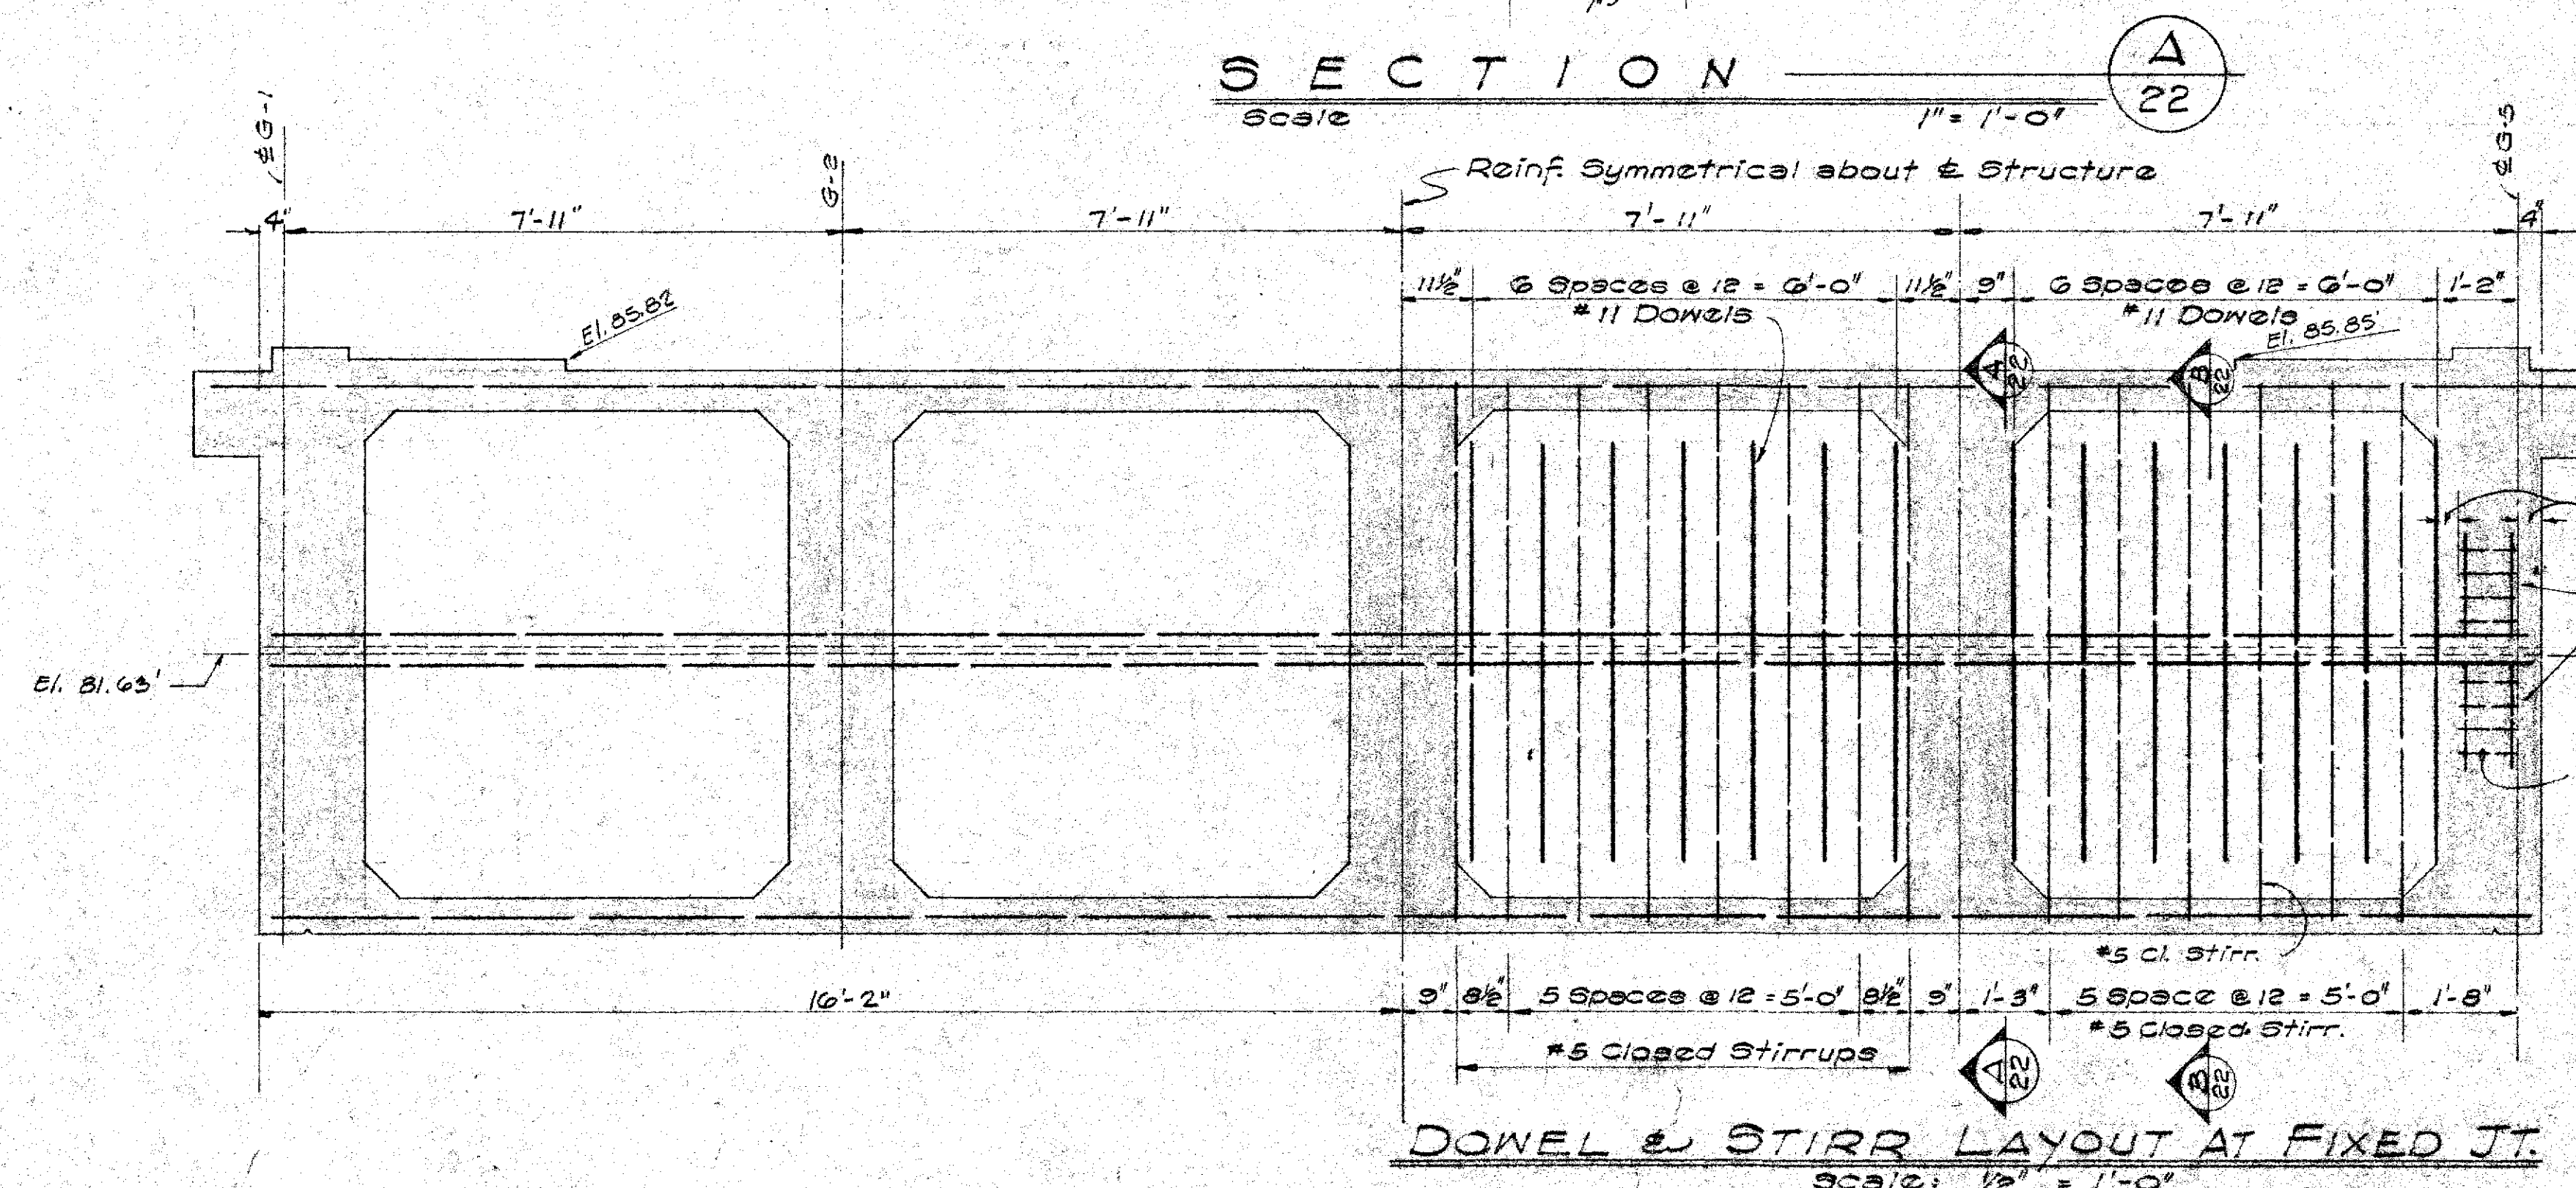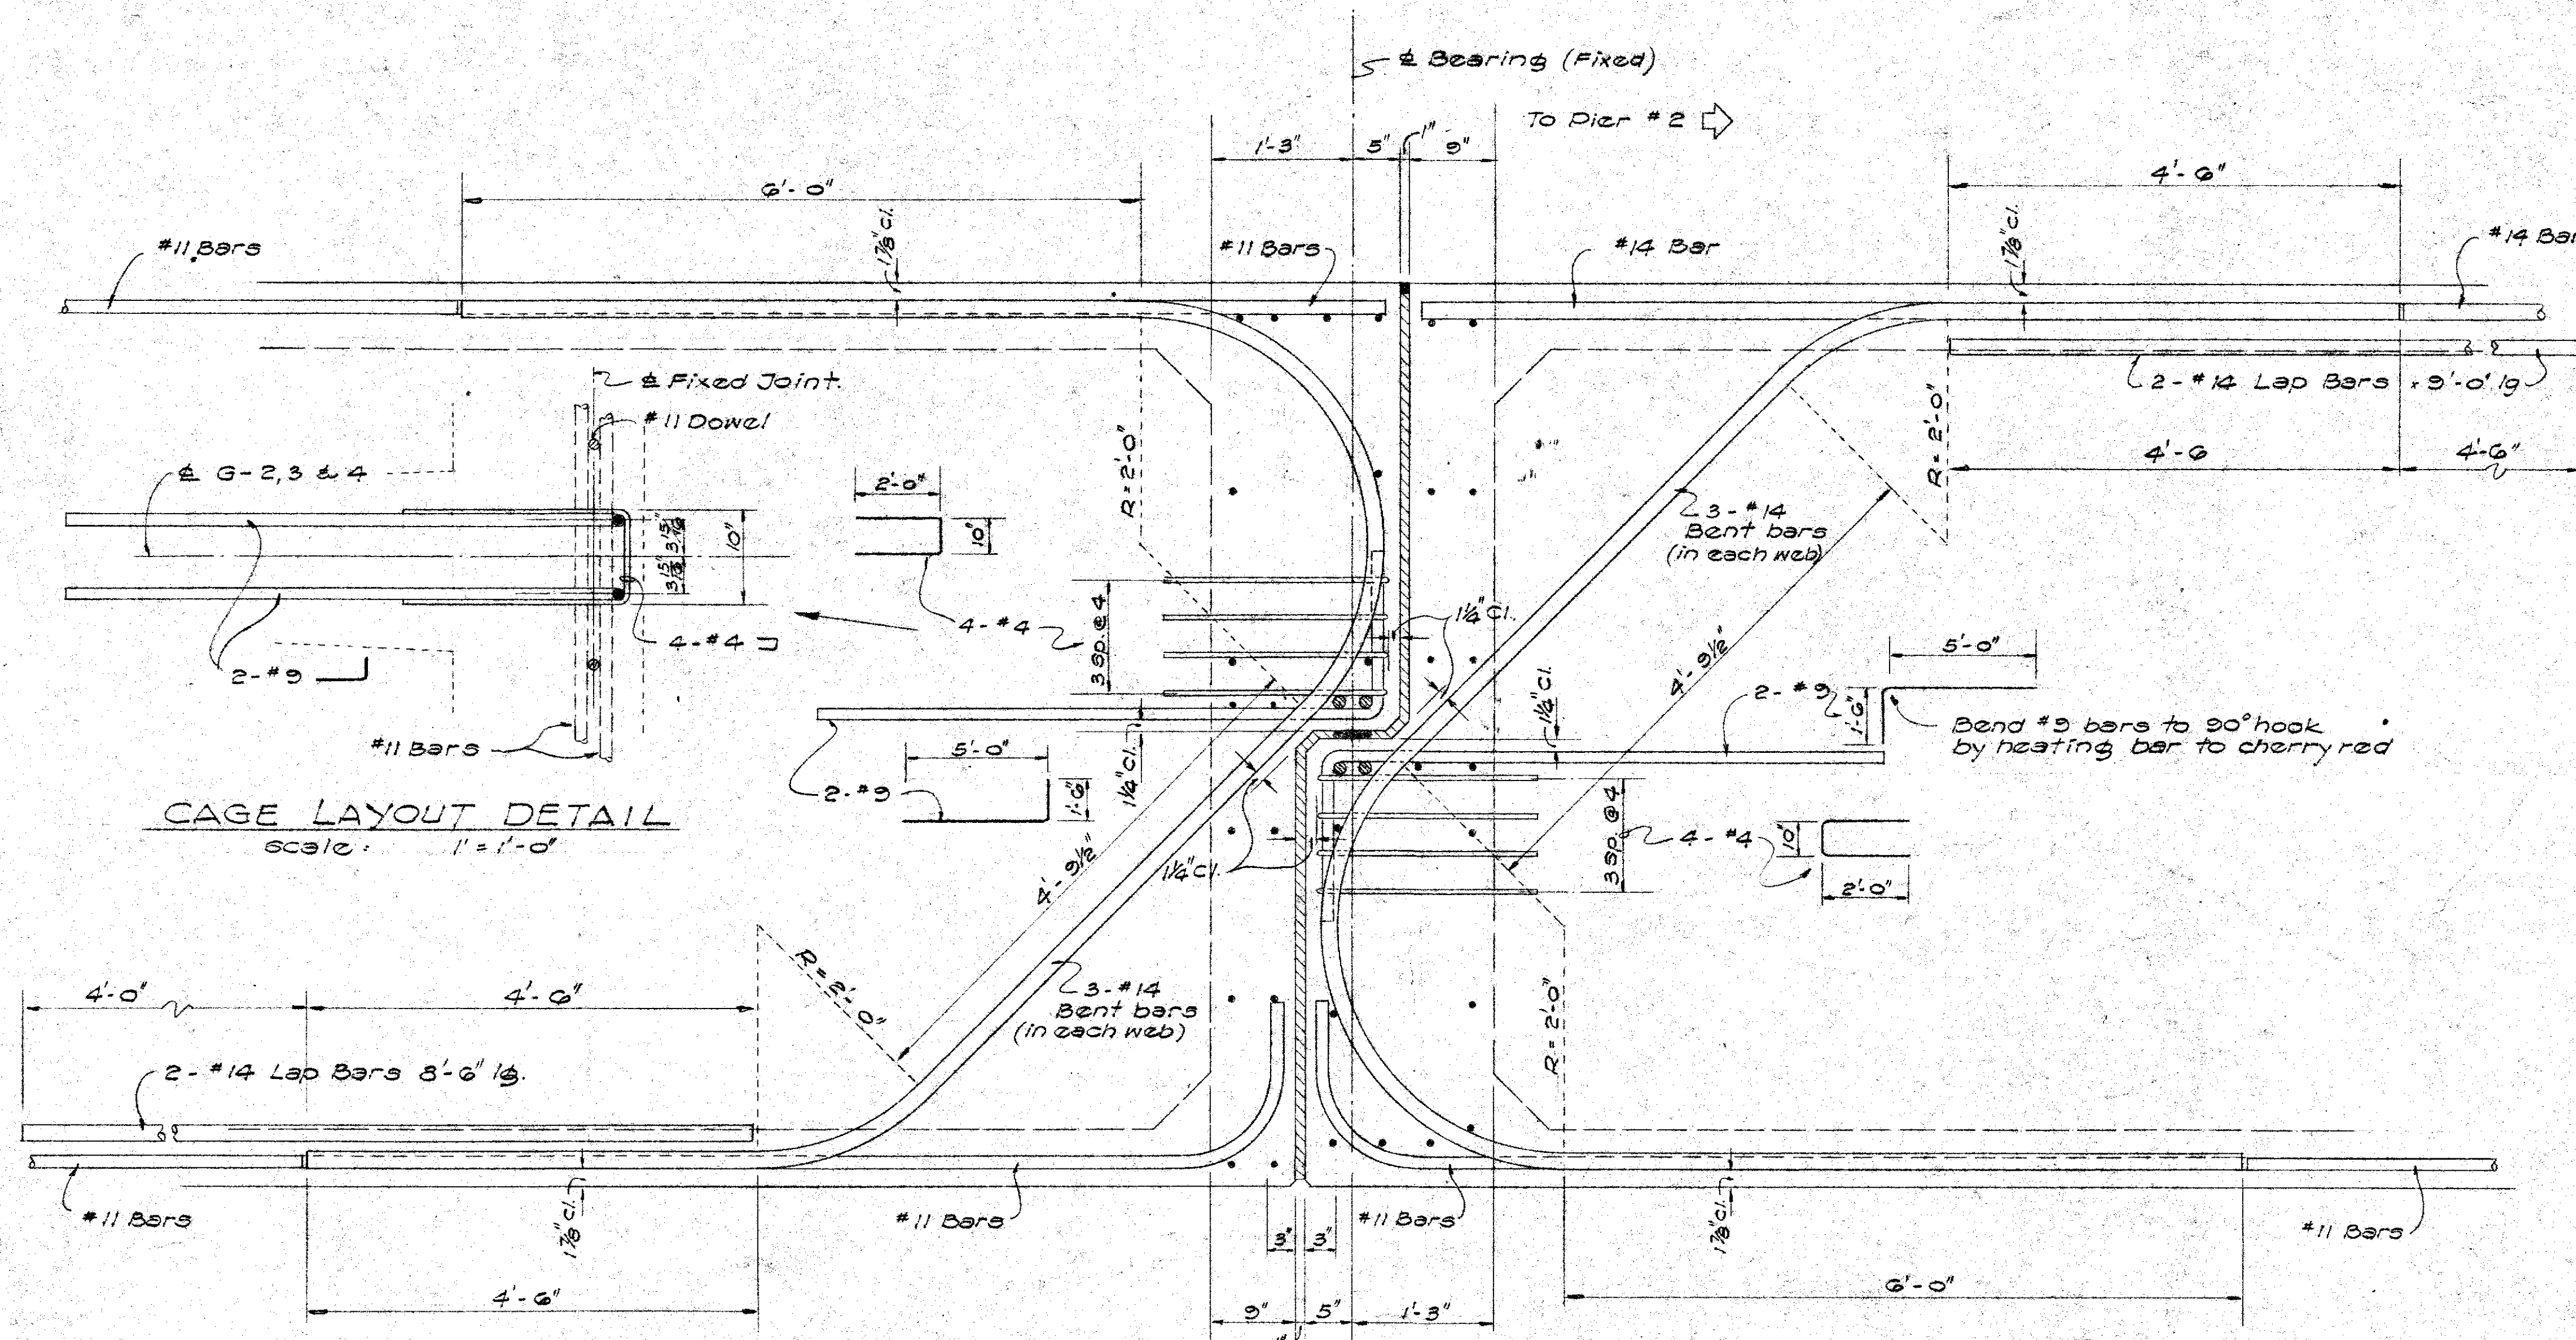


DOWEL & STIRR LAYOUT AT FIXED JT.
Scale: 1/2" = 1'-0"

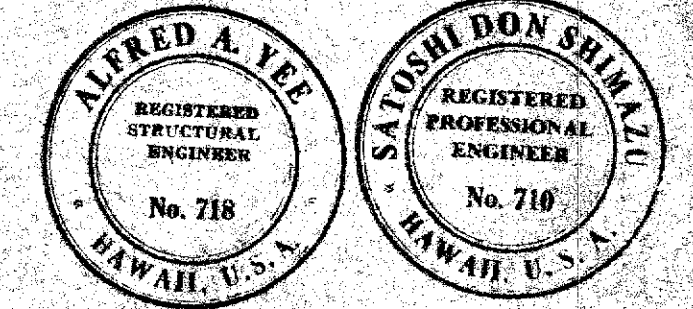

STATE OF HAWAII
DEPARTMENT OF TRANSPORTATION
HIGHWAYS DIVISION
BRIDGE No. 1
Base Line Sta. 159+38.50 to Sta. 163+91.25
VINEYARD BOULEVARD
PROJECT NO. F-098-1-(3)

SURVEY PLOTTED BY	DATE
ORIGINAL PLAN	
TRACED BY	
NOTE BOOK	
CHECKED BY	
NO.	



FED. ROAD DIST. NO.	STATE	FED. AID PROJ. NO.	FISCAL YEAR	SHEET NO.	TOTAL SHEETS

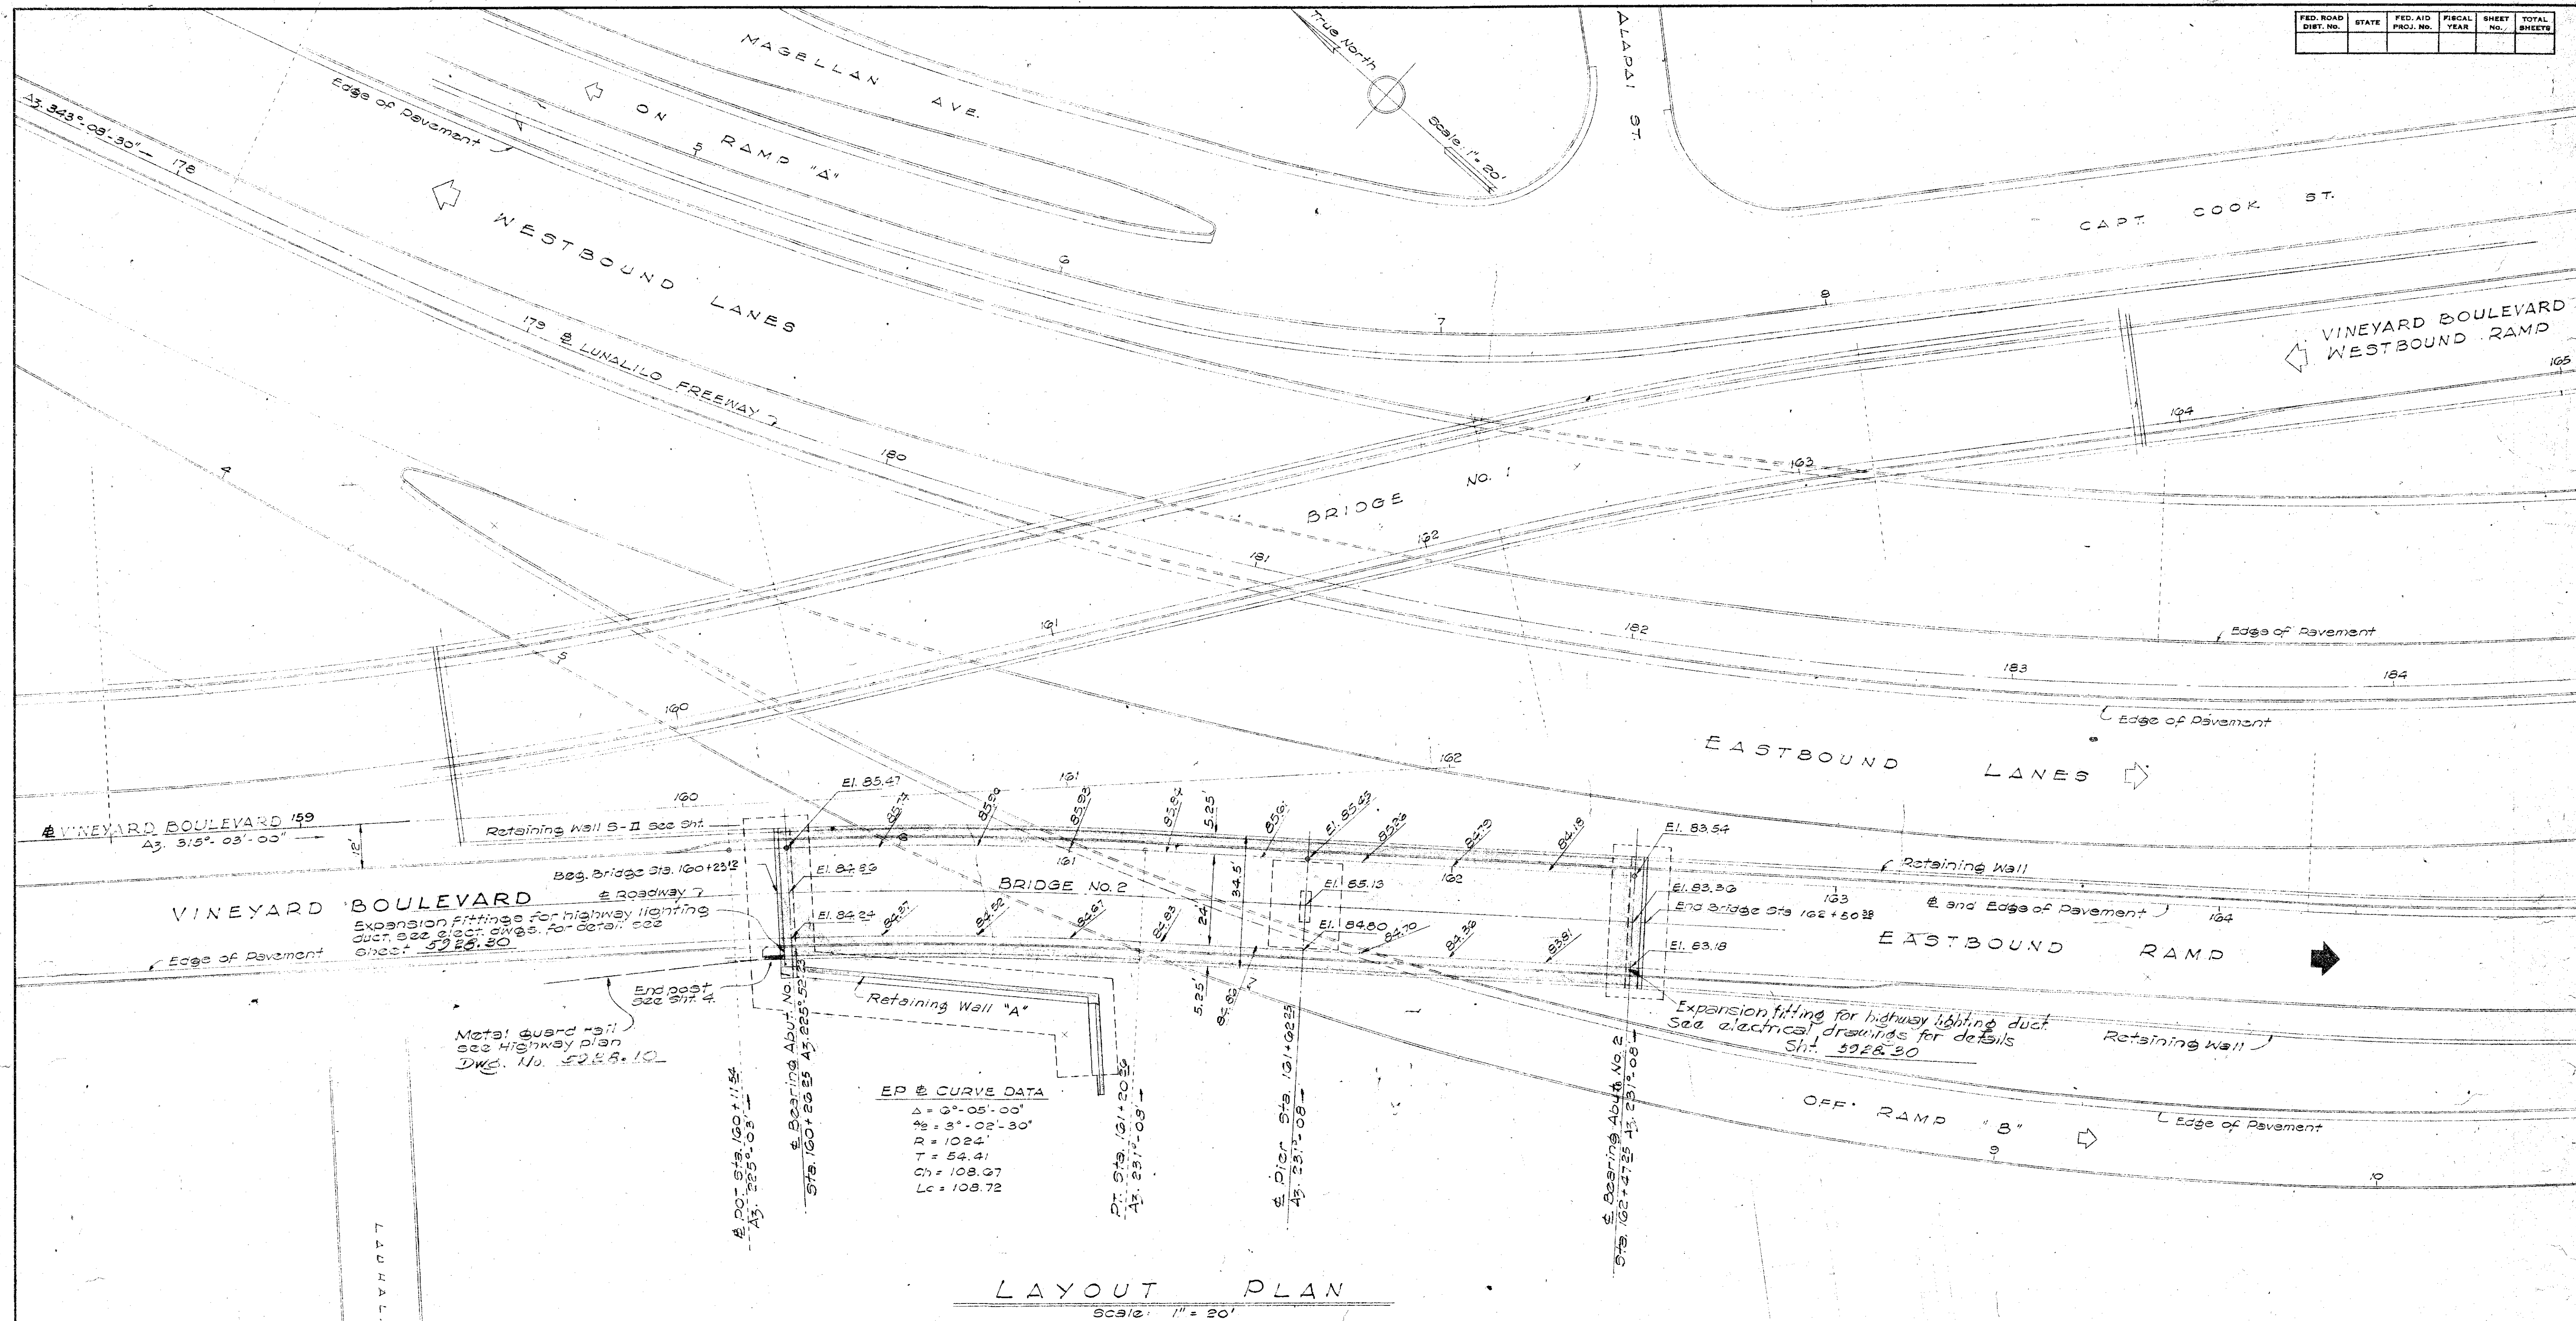

SURVEY PLOTTED BY	DATE
DESIGNED BY	
DRAWN BY	
QUANTITIES BY	
CHECKED BY	
NOTE BOOK	
No.	

NOTE:
All elevations are finish pav't. elevations
at 25 ft. intervals.



STATE OF HAWAII
DEPARTMENT OF TRANSPORTATION
HIGHWAYS DIVISION
BRIDGE No. 2
Base Line Sta. 160+23.12 To Sta. 162+50.28
VINEYARD BOULEVARD
PROJECT No. F-098-1-(3)

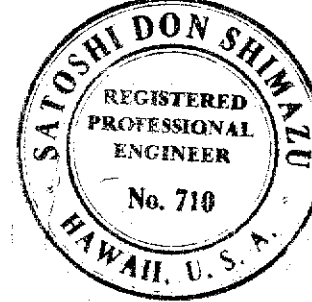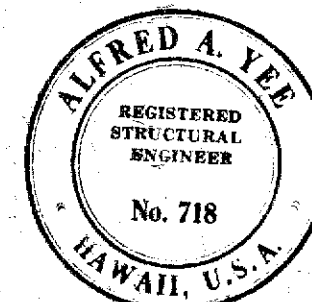

SHEET No. 1 OF 16 SHEETS

CONSULTANT SUBMISSION

5928.80

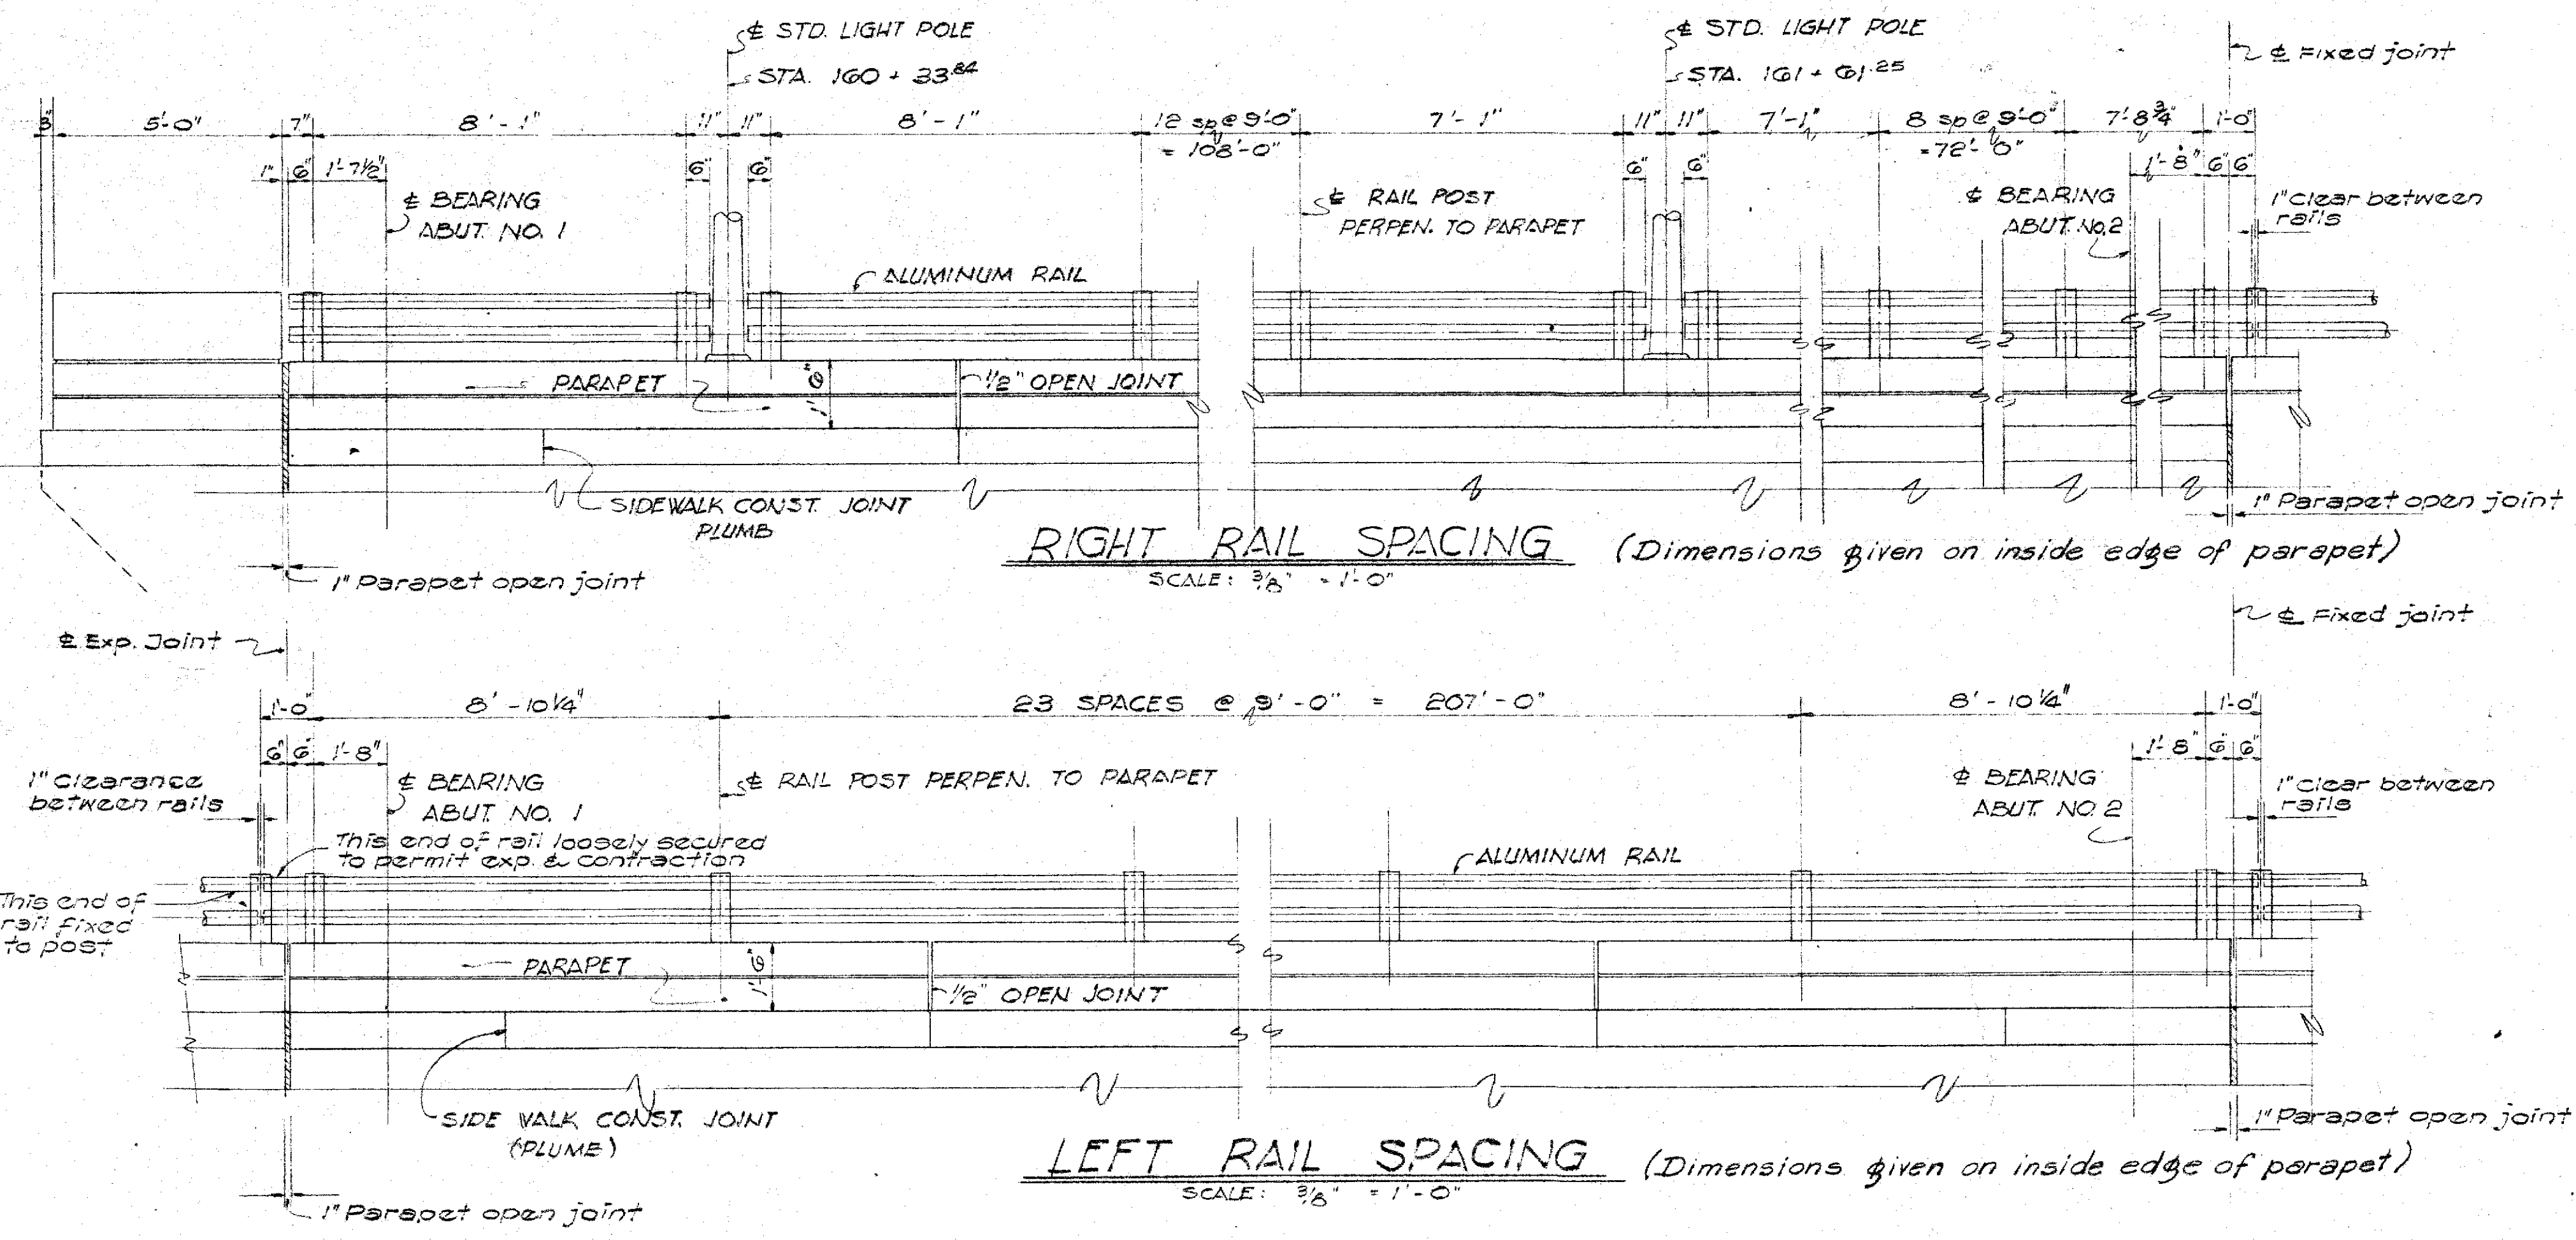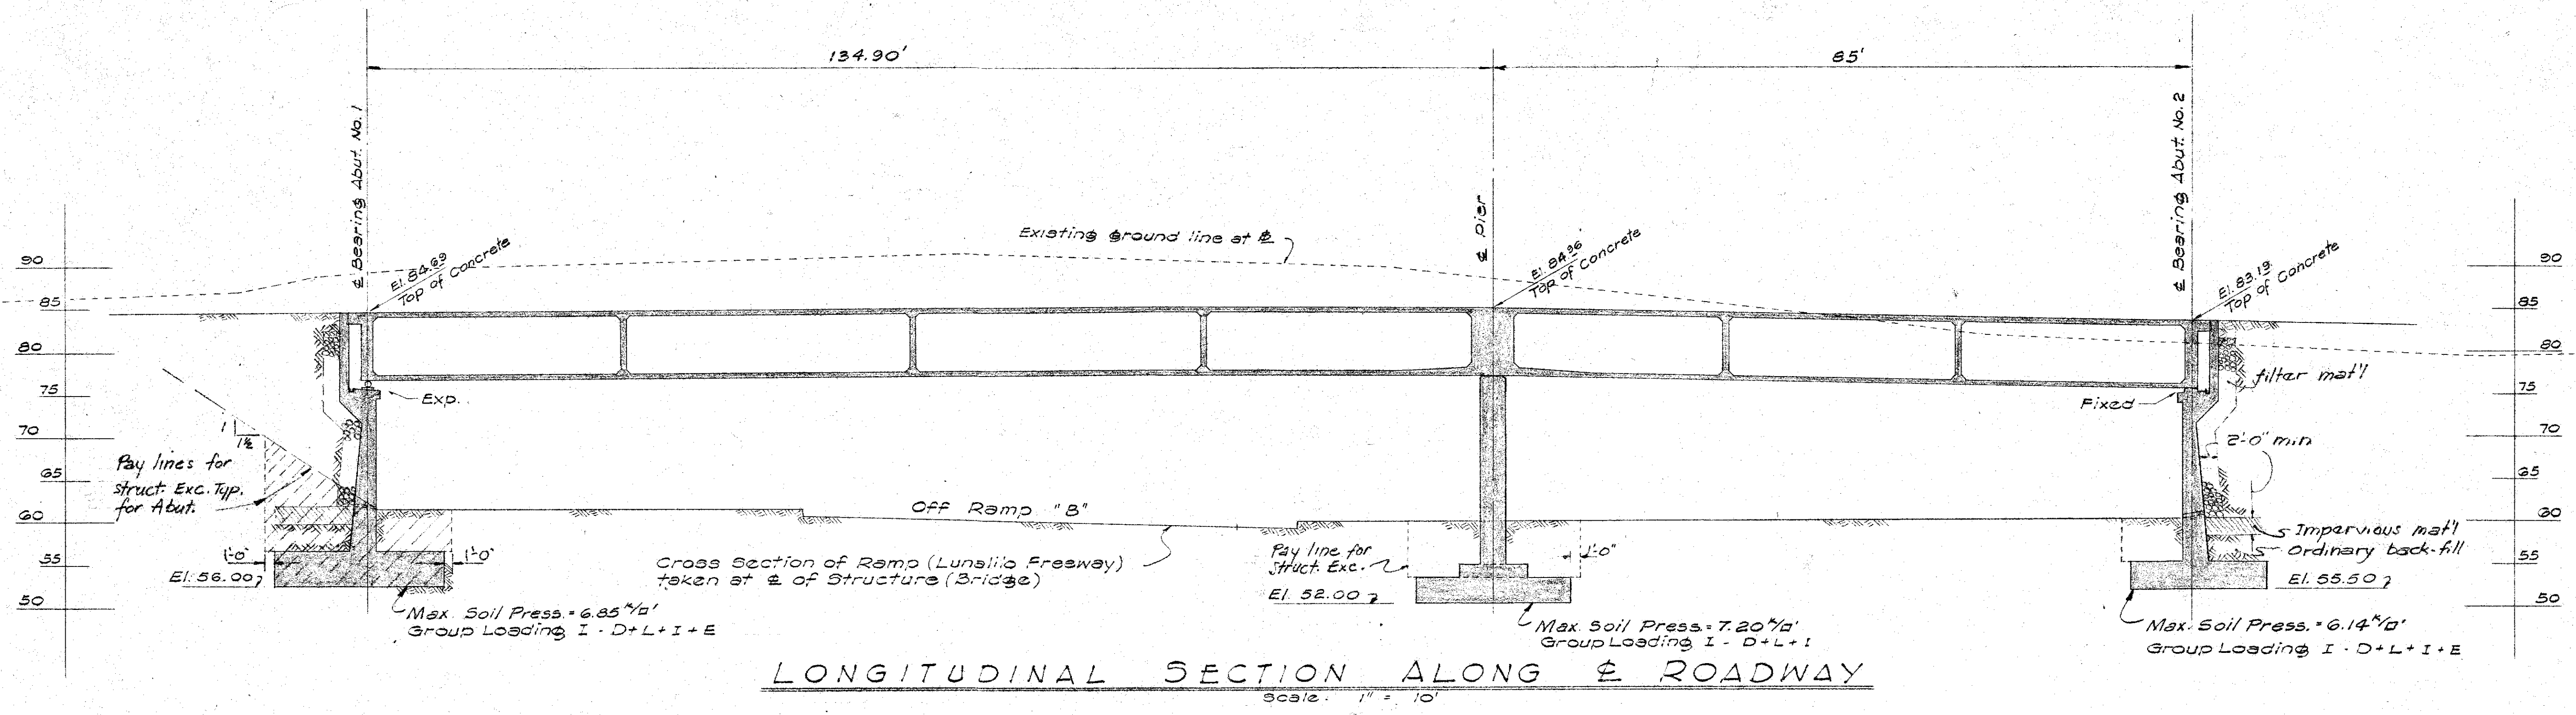

GENERAL NOTES:

- I. Design Data
 - (1) H 20-5-16-44 Loading
 - (2) $f_s = 20,000 \text{ psi}$
 - (3) $f_c = 1200 \text{ psi}$
 - (4) $n = 10$
- II. Construction Methods
 - (1) Backfill behind abutments & wingwalls shall be complete in place before pouring concrete for the superstructure
 - (2) Curbs and parapets shall not be poured until after release of false work.
 - (3) Finish - See Standard Specifications.
 - (4) Forms - Forms for bottom slab of box girders shall be 5 ply panel board.
 - (5) Foundations to be poured next against soil.
- III. Materials
 - (1) Concrete - Class A-1
Except Pier Column - Class F-1

DATE: _____
 SURVEY PLOTTED BY: _____
 DESIGNED BY: _____
 TRACED BY: _____
 QUANTITIES BY: _____
 CHECKED BY: _____
 ORIGINAL PLAN NO. _____

ALFRED A. YEE
 REGISTERED
 STRUCTURAL
 ENGINEER
 No. 718
 HAWAII, U.S.A.

SATOSHI DON SHIMAZU
 REGISTERED
 PROFESSIONAL
 ENGINEER
 No. 710
 HAWAII, U.S.A.


STATE OF HAWAII
 DEPARTMENT OF TRANSPORTATION
 HIGHWAYS DIVISION
BRIDGE No. 2
 Base Line Sta. 160+23.12 To Sta. 162+50.28
 VINEYARD BOULEVARD
 PROJECT No. F-098-1(3)

SHEET NO. 2 OF 16 SHEETS

CONSULTANT SUBMISSION

5928.81


FED. ROAD DIST. NO.	STATE	FED. AID PROJ. NO.	FISCAL YEAR	SHEET No.	TOTAL SHEETS

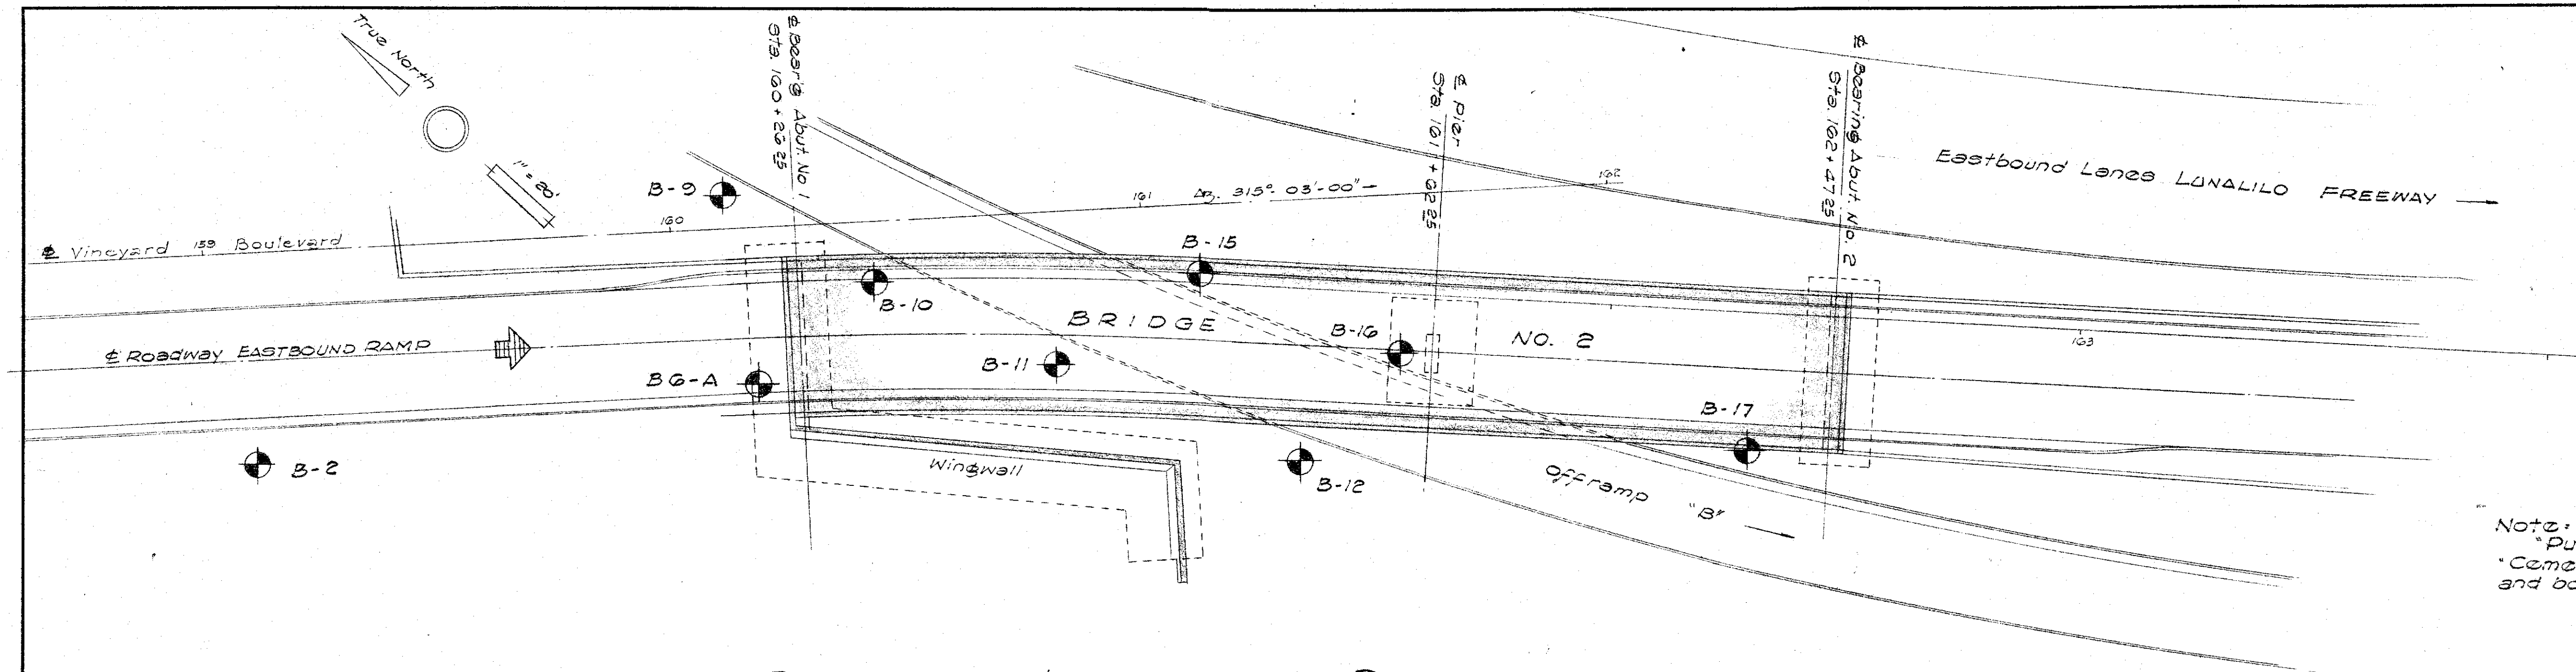


Note: "Punchbowl tuff" as used here stands for "Cemented volcanic ejecta" containing fines and boulders

BORING LOCATION PLAN


Scale: 1" = 20'

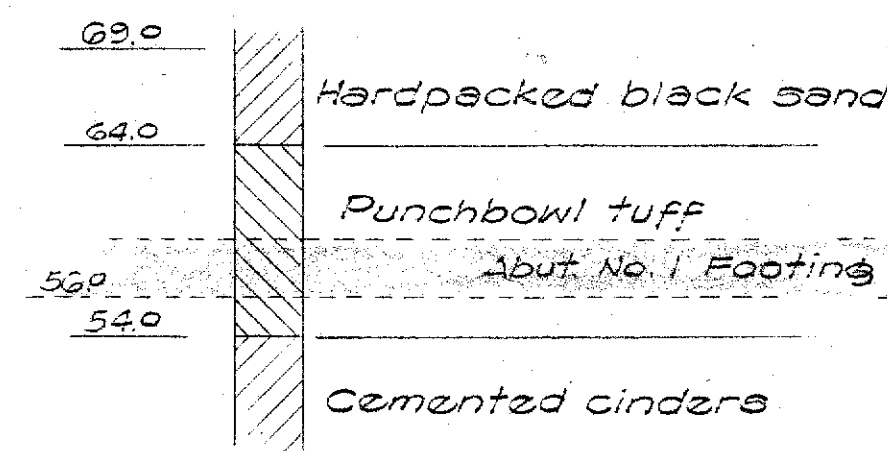


BORING No. B-2

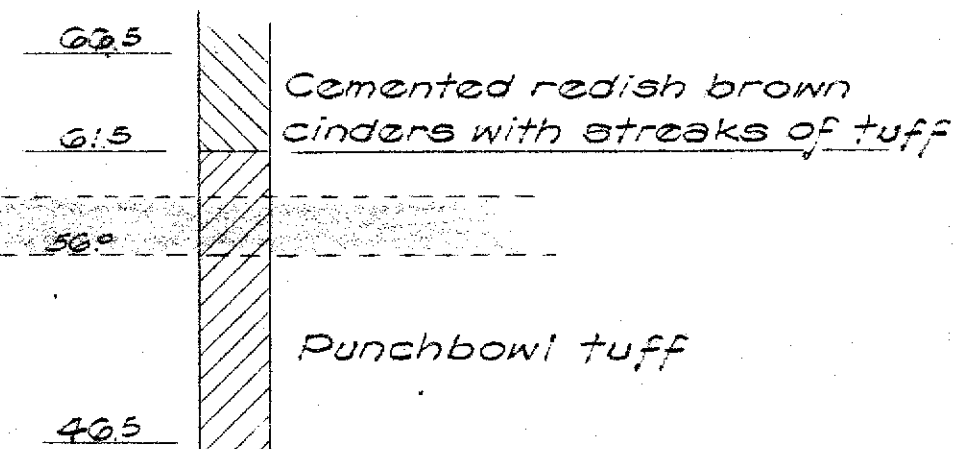


BORING No. B-9

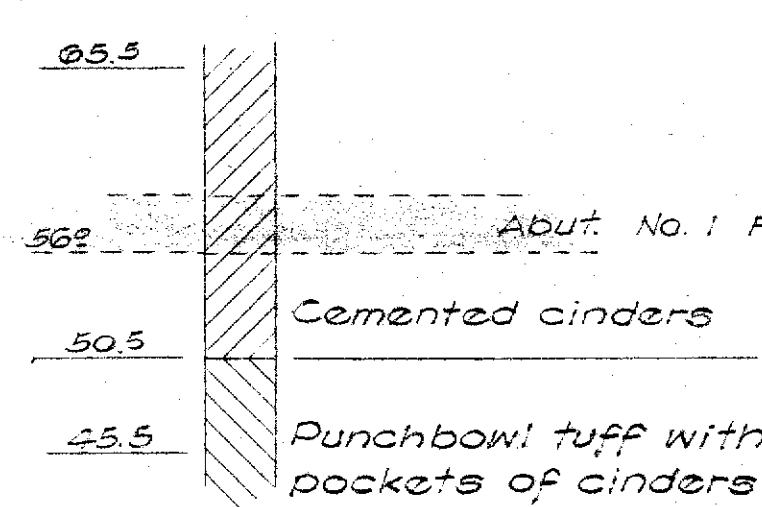


BORING No. B-10

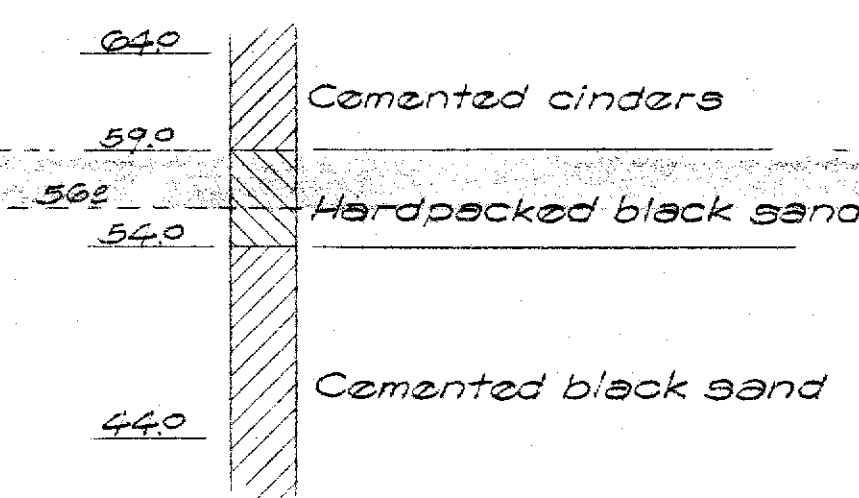


BORING No. B-11

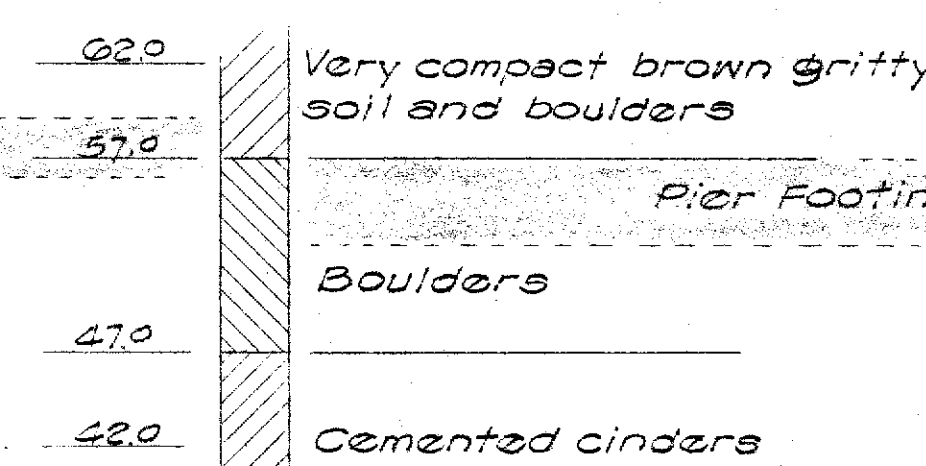


BORING No. B-12

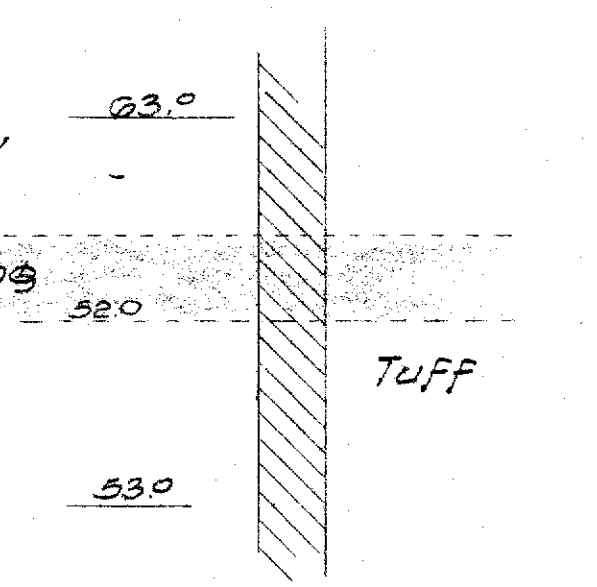


BORING No. B-15

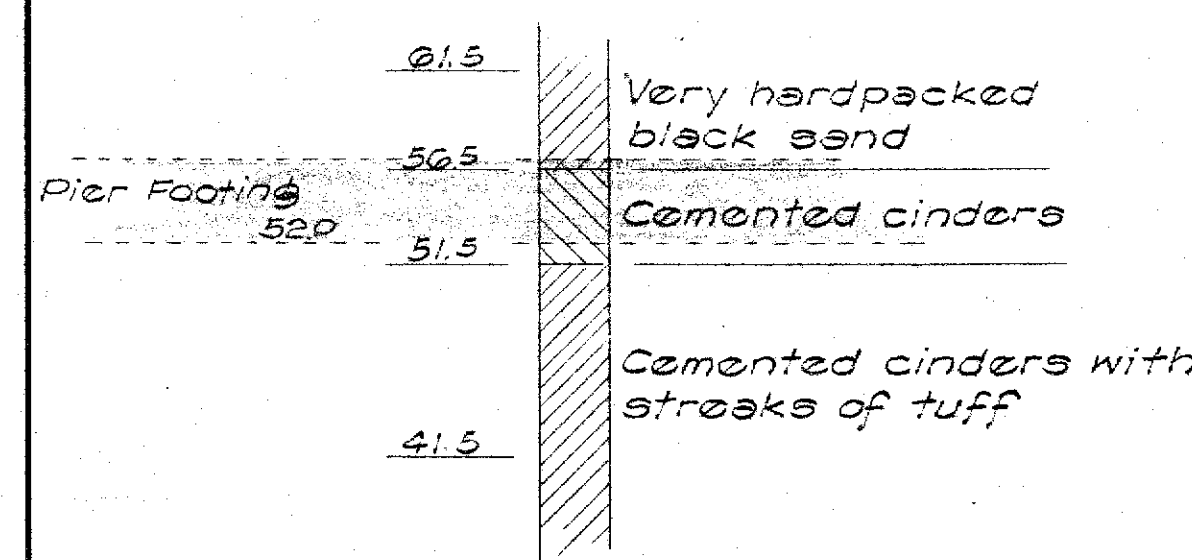

BORING No. B-16

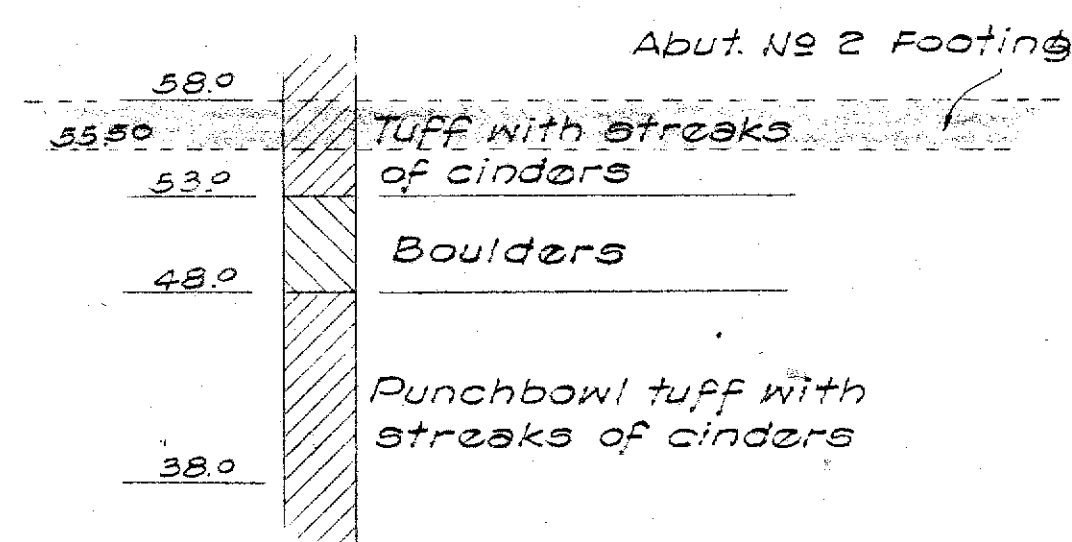

BORING No. B-17

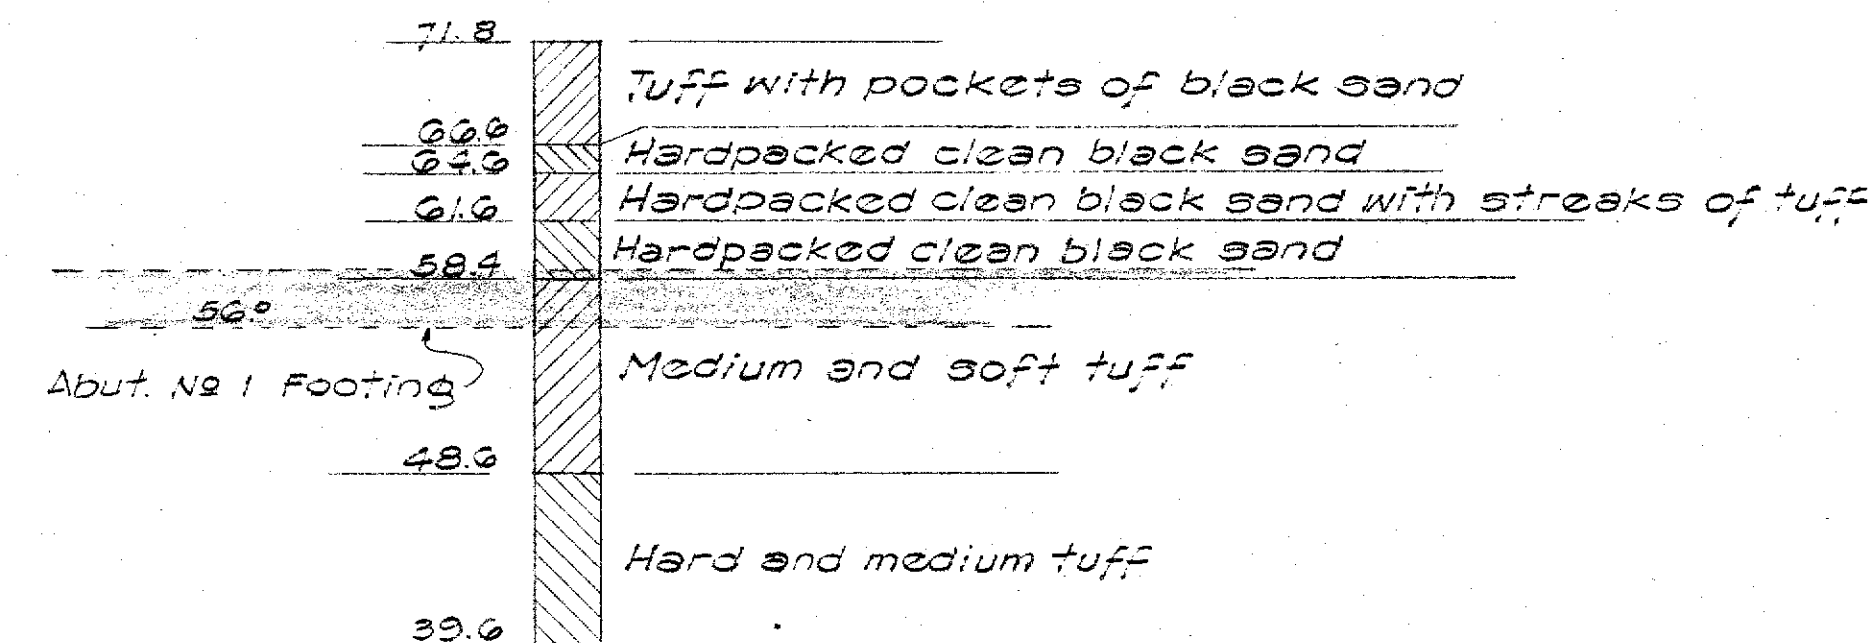

BORING No. BG-A

BORING DATA

Scale: 1" = 10'



DATE	
SURVEY PLOTTED BY	
DESIGNED BY	
DRAWN BY	
CHECKED BY	
NOTE BOOK NO.	

STATE OF HAWAII
DEPARTMENT OF TRANSPORTATION
HIGHWAYS DIVISION

BRIDGE No. 2

Base Line Sta. 160+23.12 To Sta. 162+50.28

VINEYARD BOULEVARD
PROJECT No. F-028-1-(3)

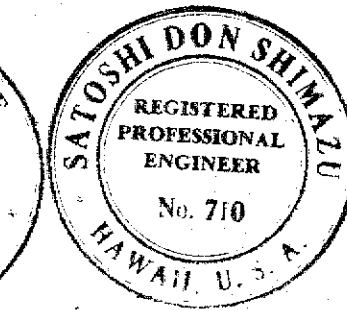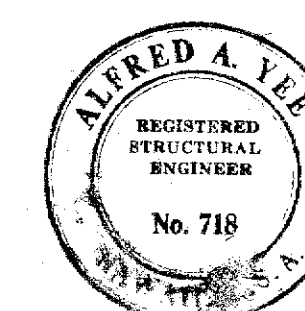


SHEET No. 3 OF 16 SHEETS


CONSULTANT SUBMISSION

5928.82


FED. ROAD DIST. NO.	STATE	FED. AID PROJ. NO.	FISCAL YEAR	SHEET NO.	TOTAL SHEETS

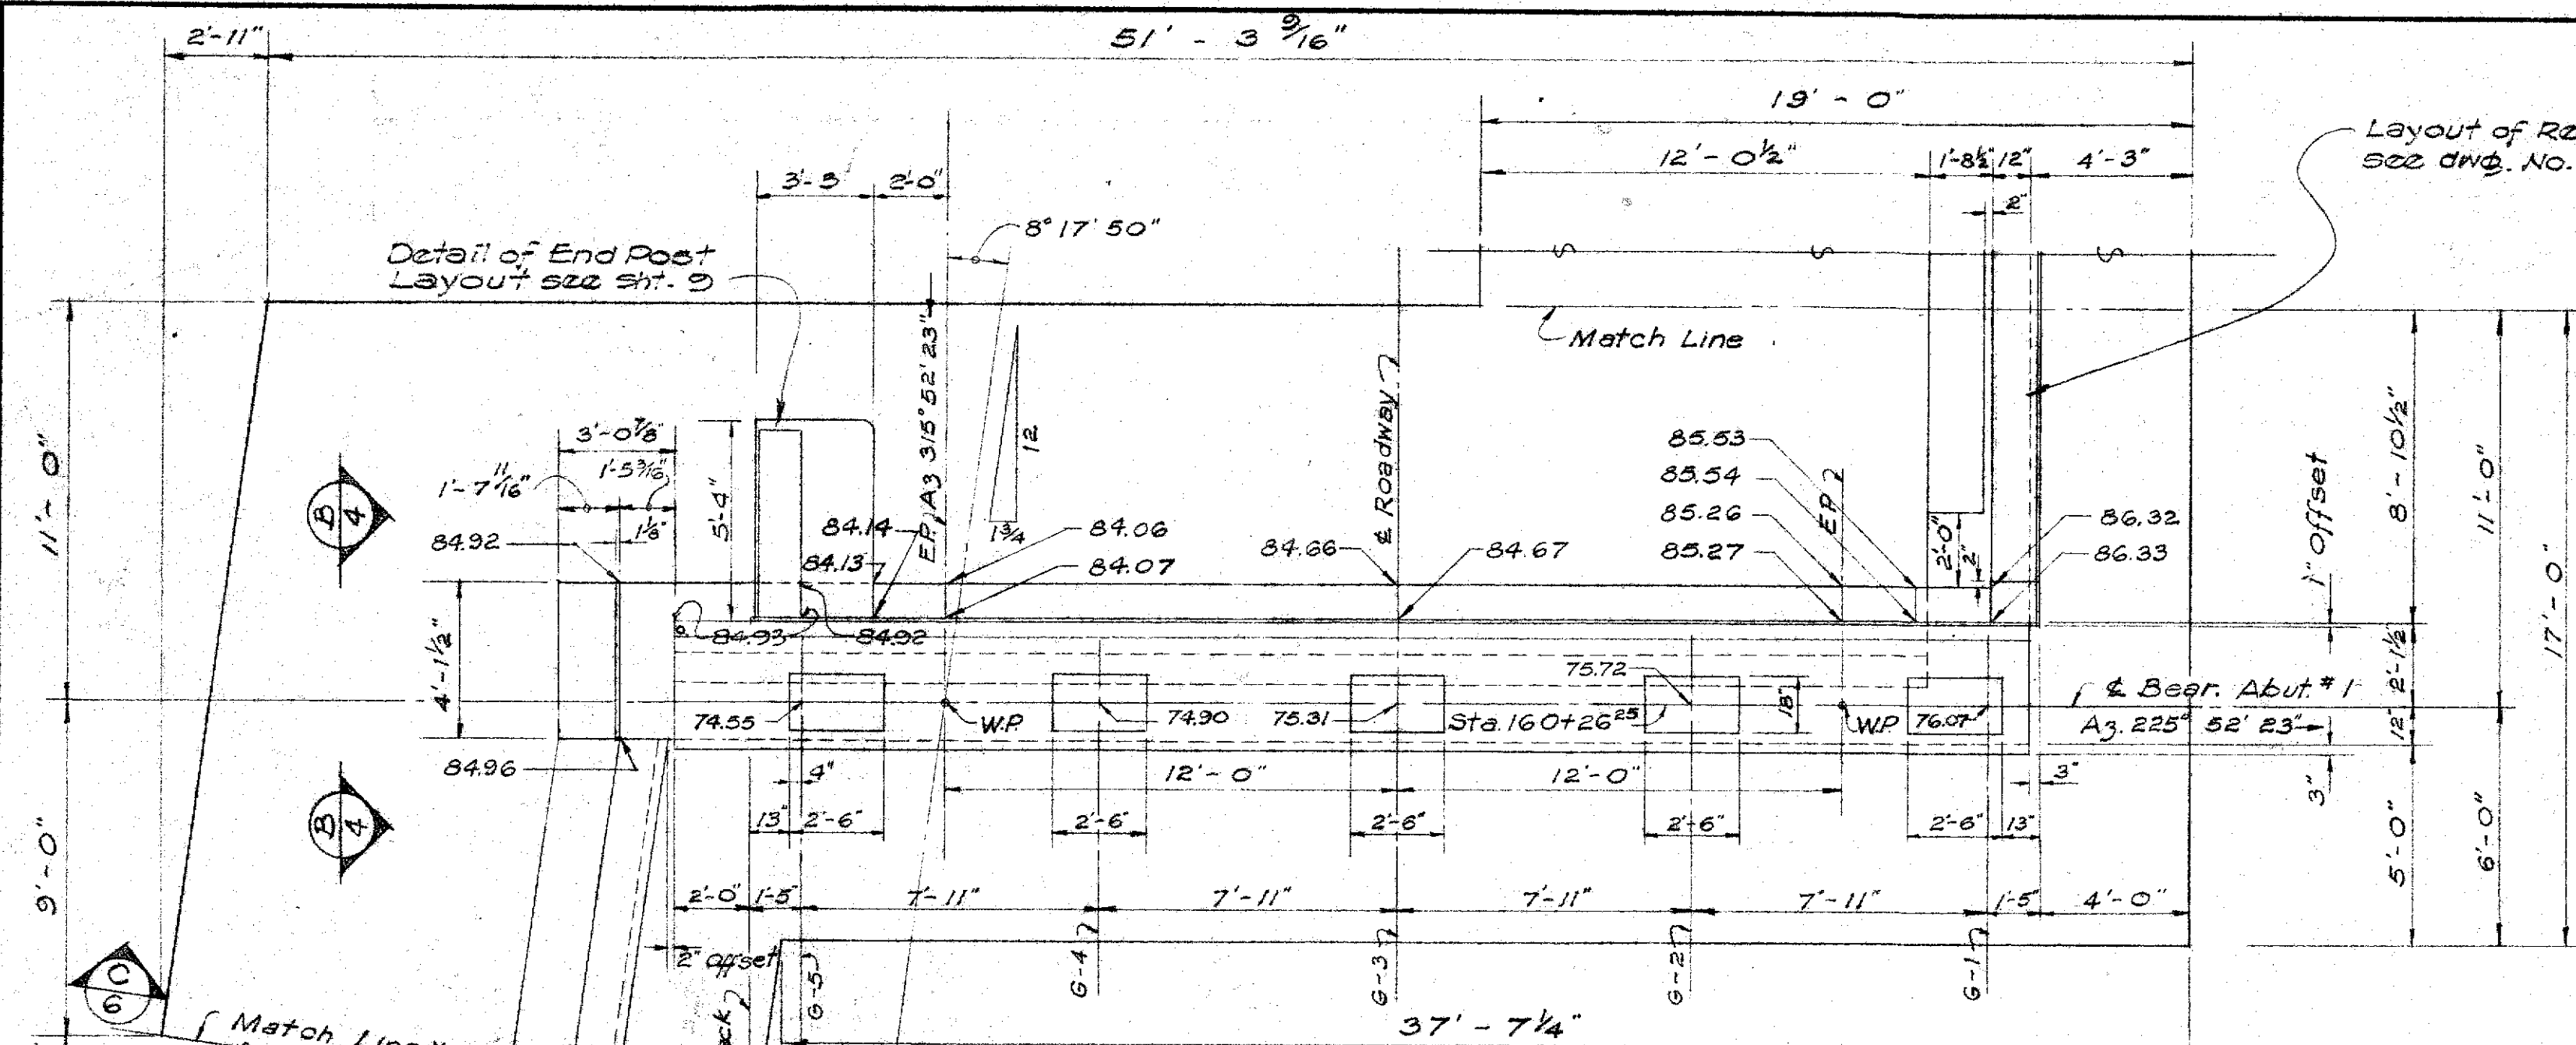


PLAN - ABUT. No. 1
Scale: 1/4" = 1'-0"

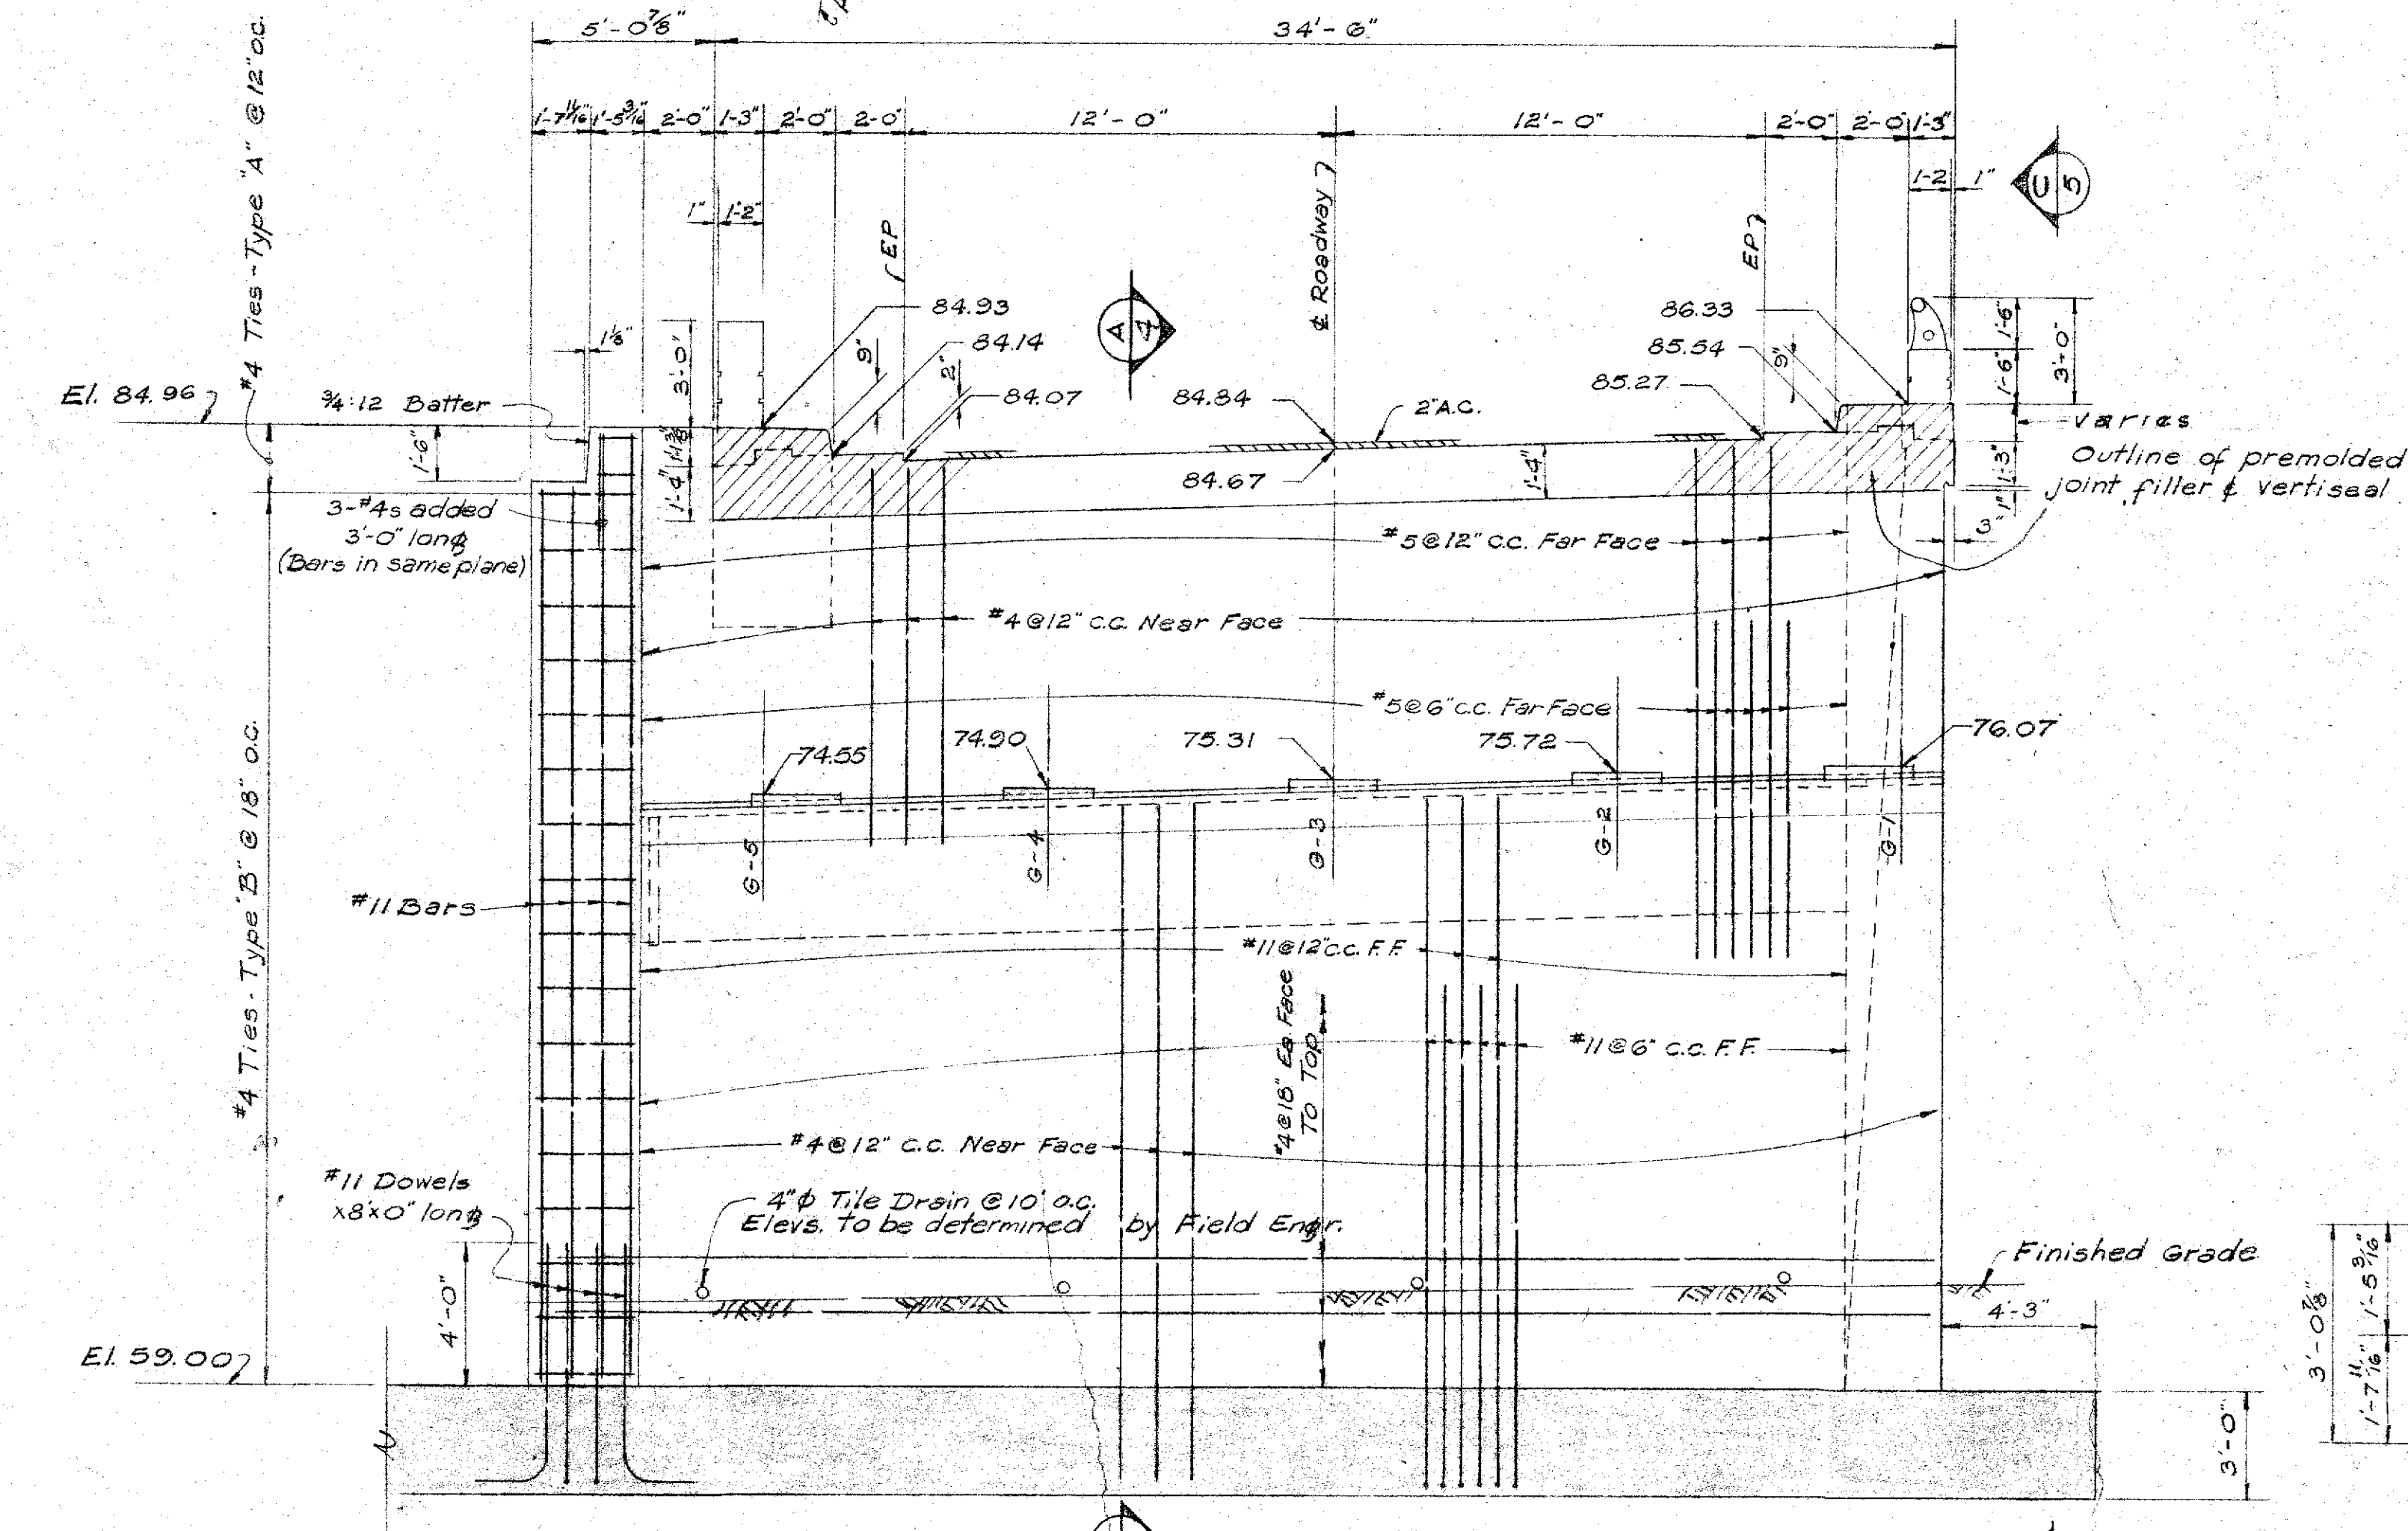


ELEVATION - ABUT. No. 1
Scale: 1/4" = 1'-0"

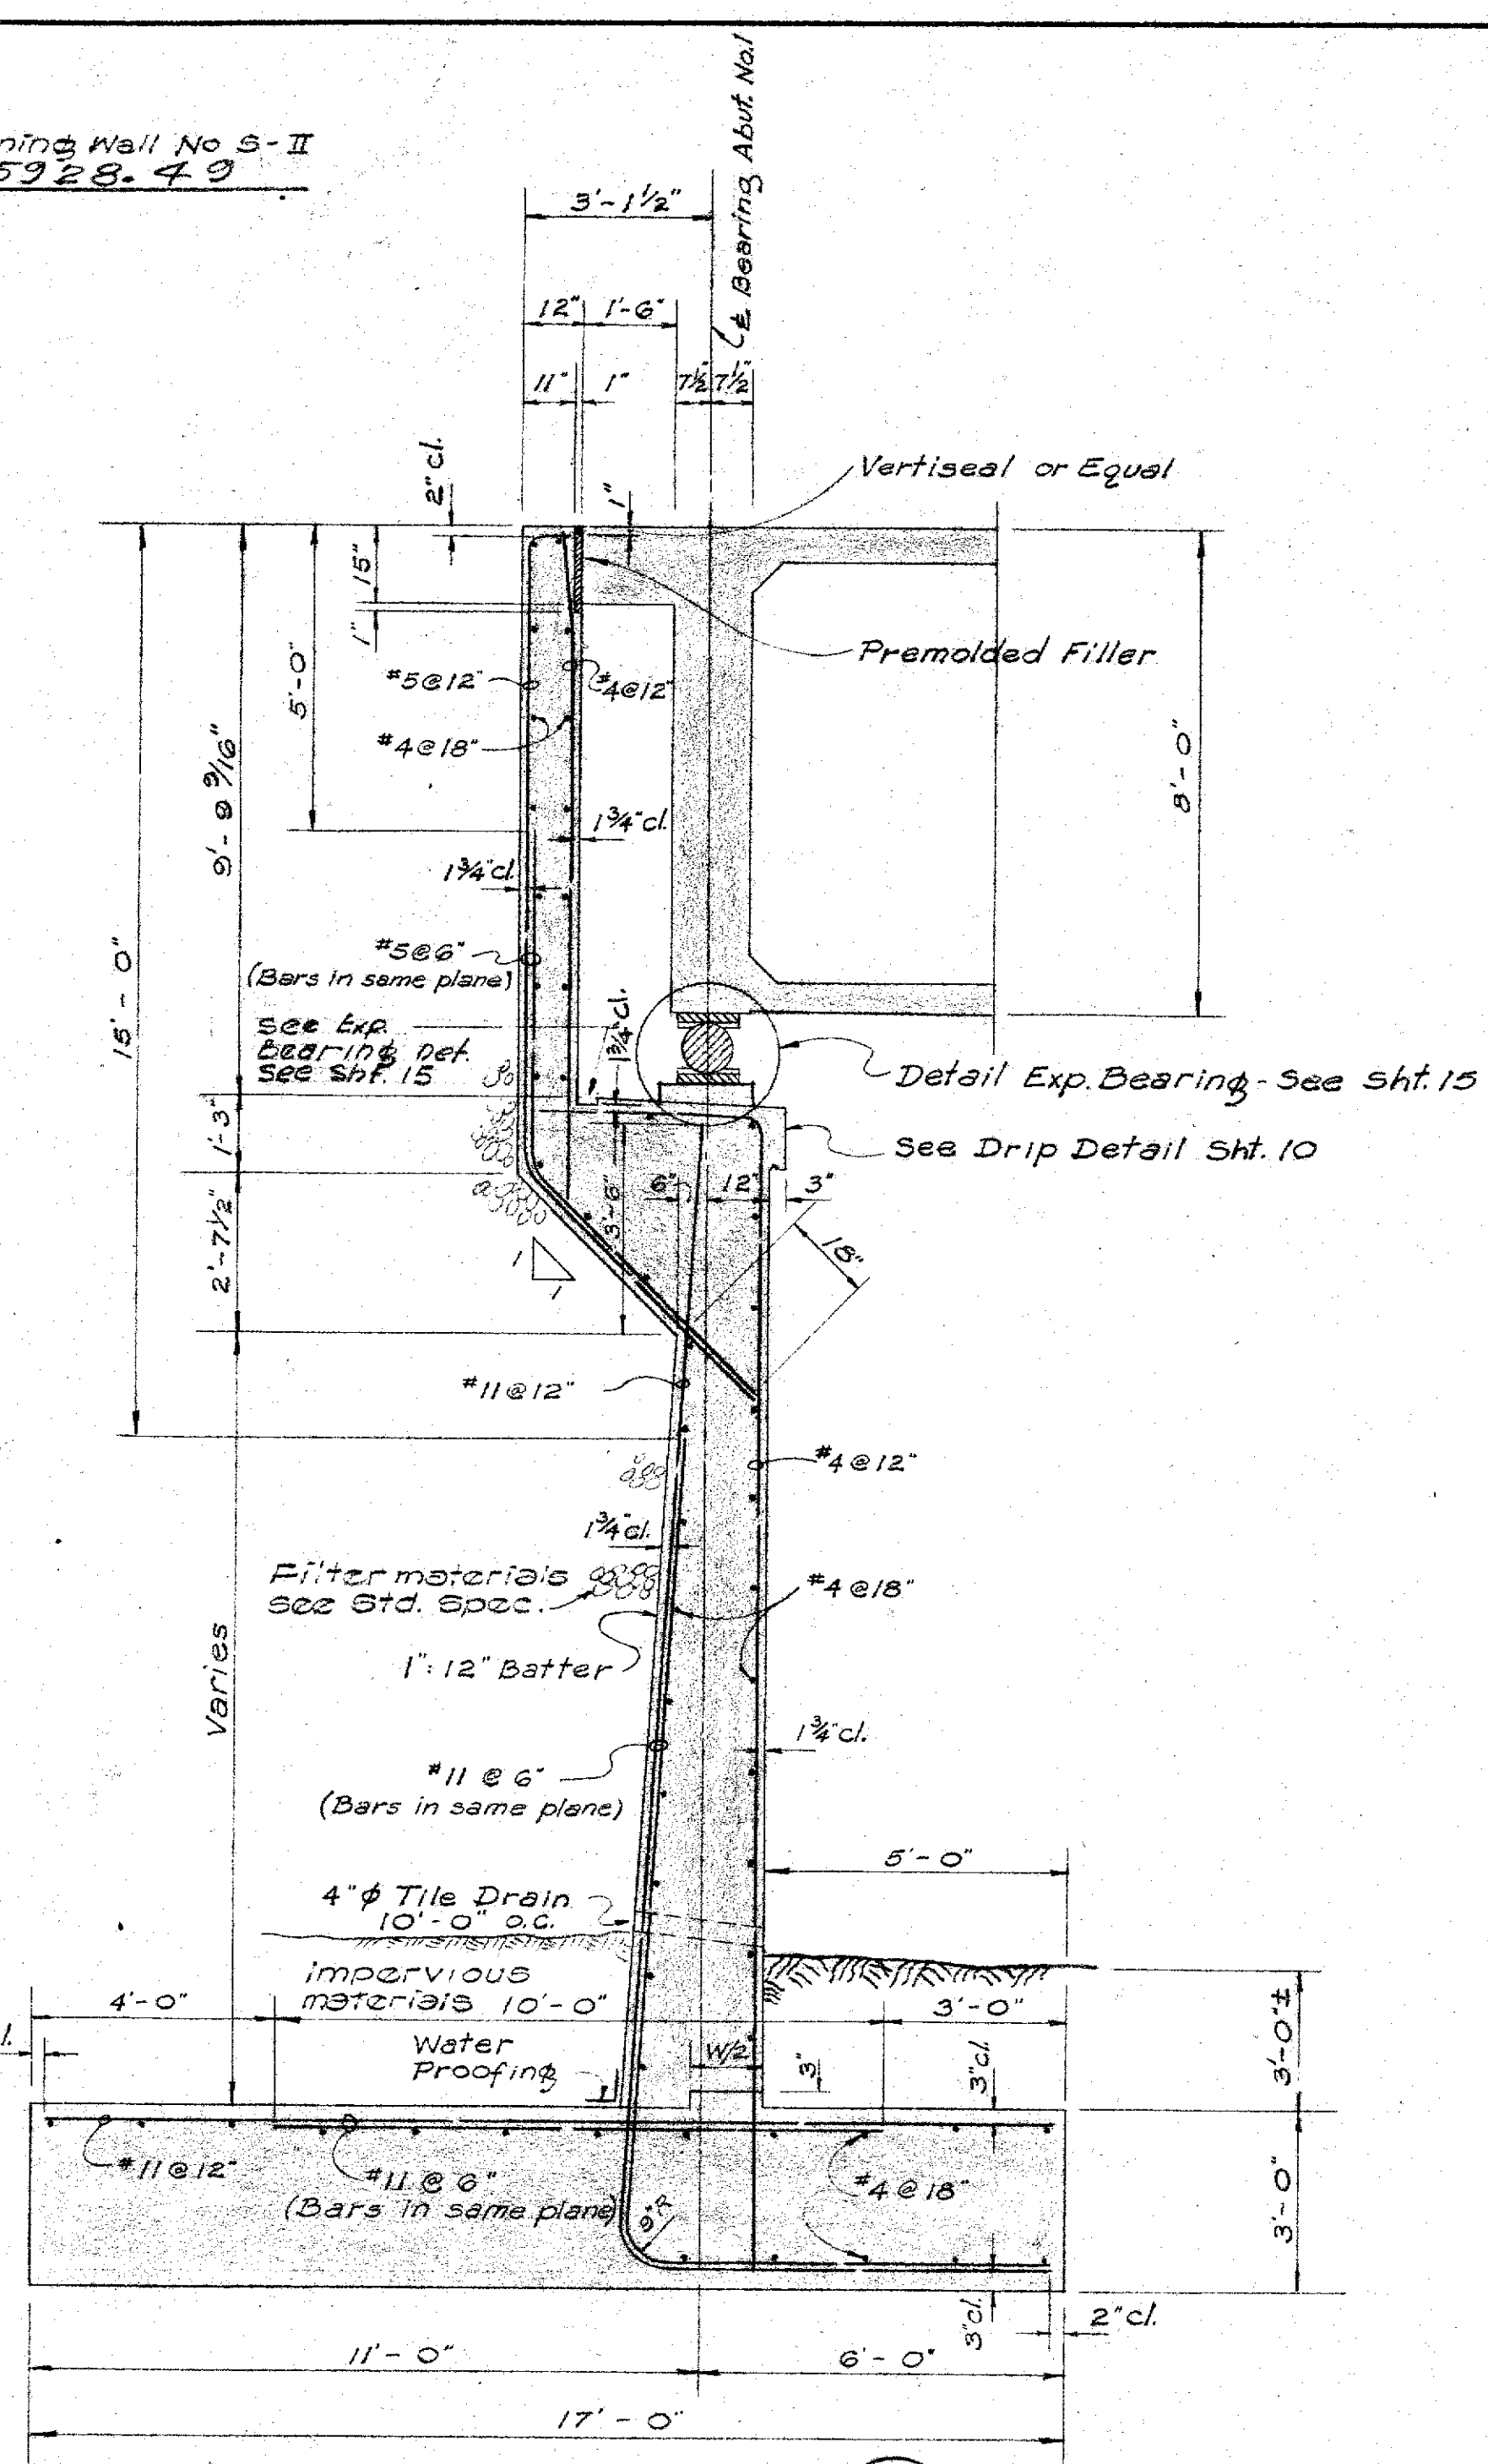


SECTION A
Scale: 3/8" = 1'-0"

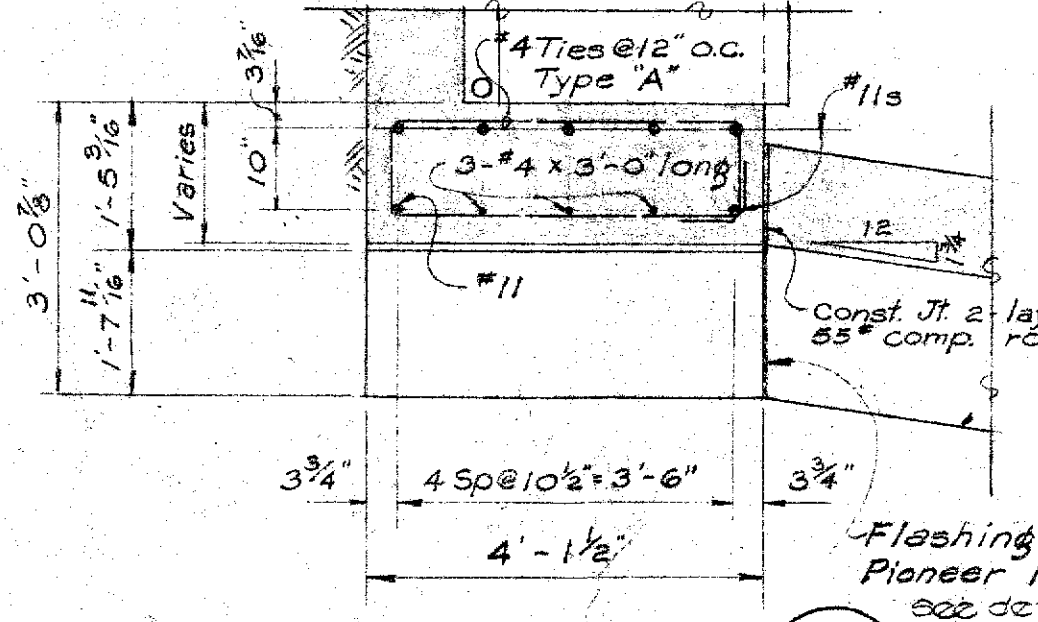


SECTION C
Scale: 1/2" = 1'-0"

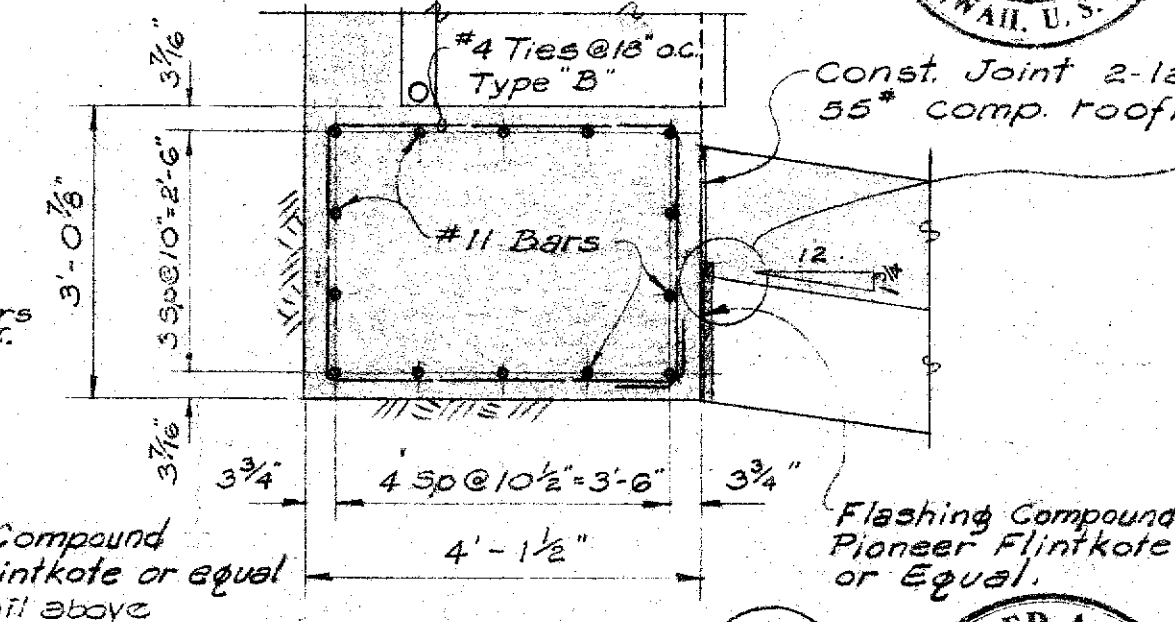

SECTION D
Scale: 1/2" = 1'-0"

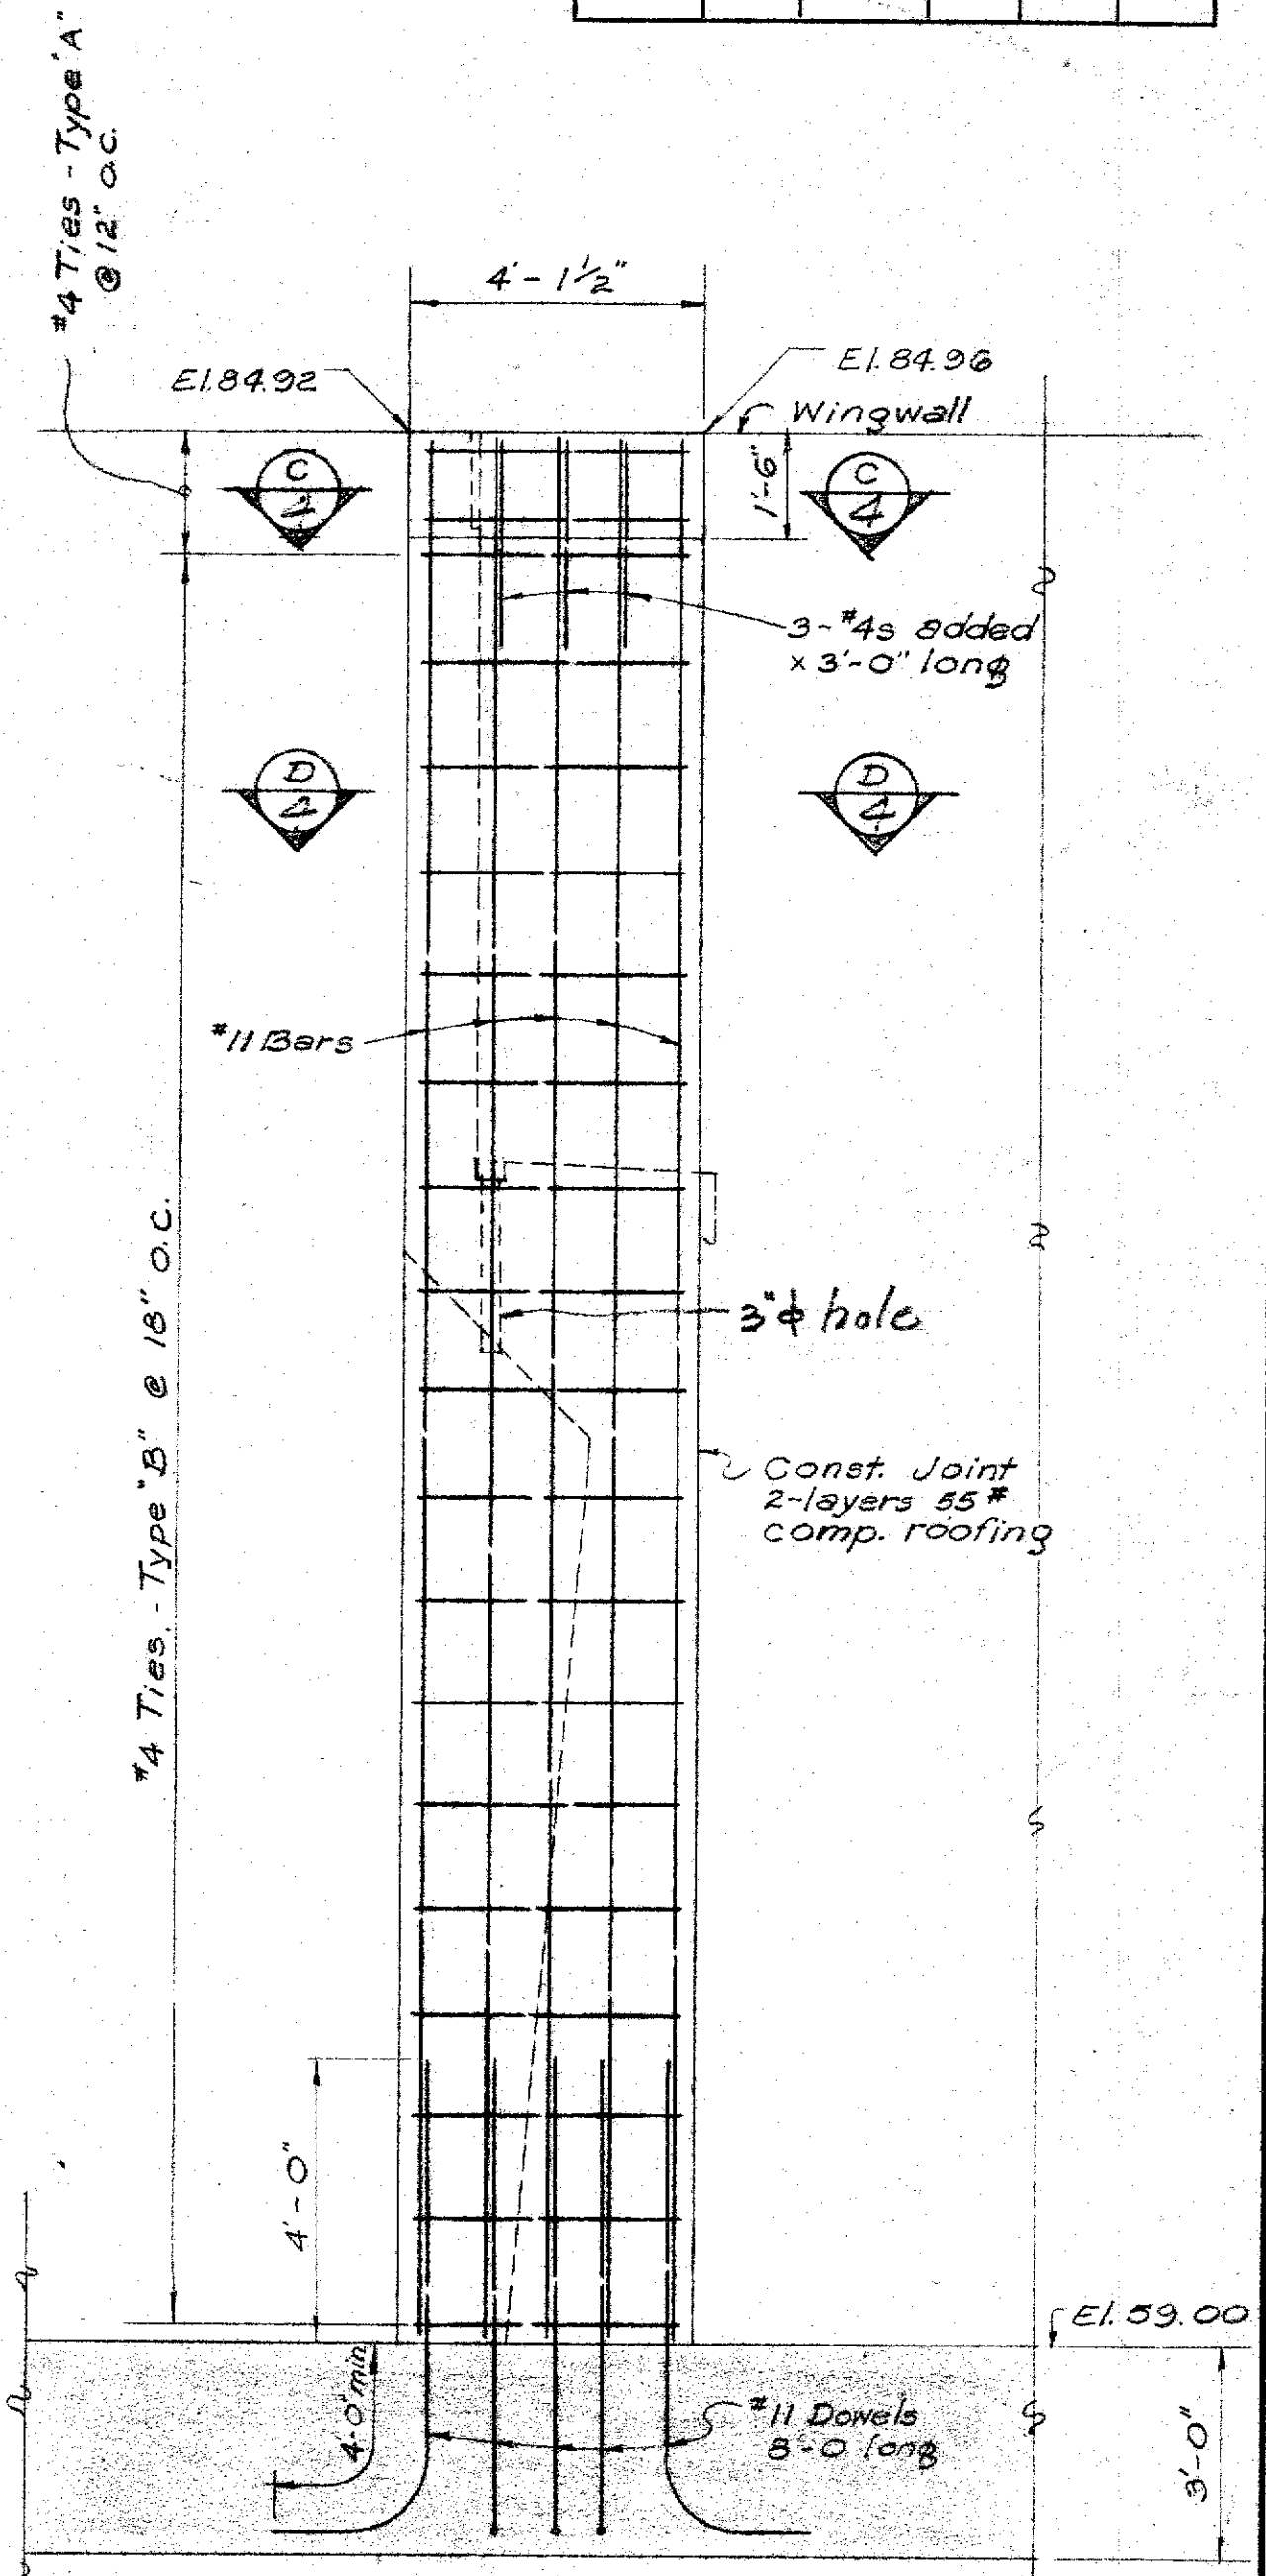

ELEVATION B
Scale: 3/8" = 1'-0"

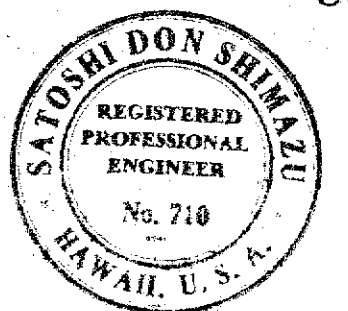


STATE OF HAWAII
DEPARTMENT OF TRANSPORTATION
HIGHWAYS DIVISION
BRIDGE No. 2
Base Line Sta. 160+23 1/2 TO Sta. 162+50.35
VINEYARD BOULEVARD
PROJECT NO F-098-1-(3)

SHEET NO. 4 OF 16 SHEETS


5928.83

CONSULTANT SUBMISSION

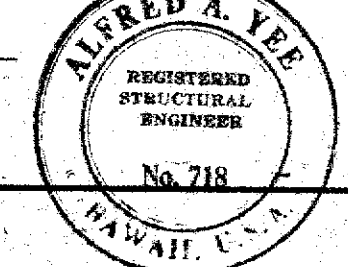


SURVEY PLOTTED BY	DATE
DRAWN BY	
TRACED BY	
QUANTITIES CHECKED BY	
NO. 1	


FED. ROAD DIST. NO.	STATE	FED. AID PROJ. NO.	FISCAL YEAR	SHEET NO.	TOTAL SHEETS
				5	16

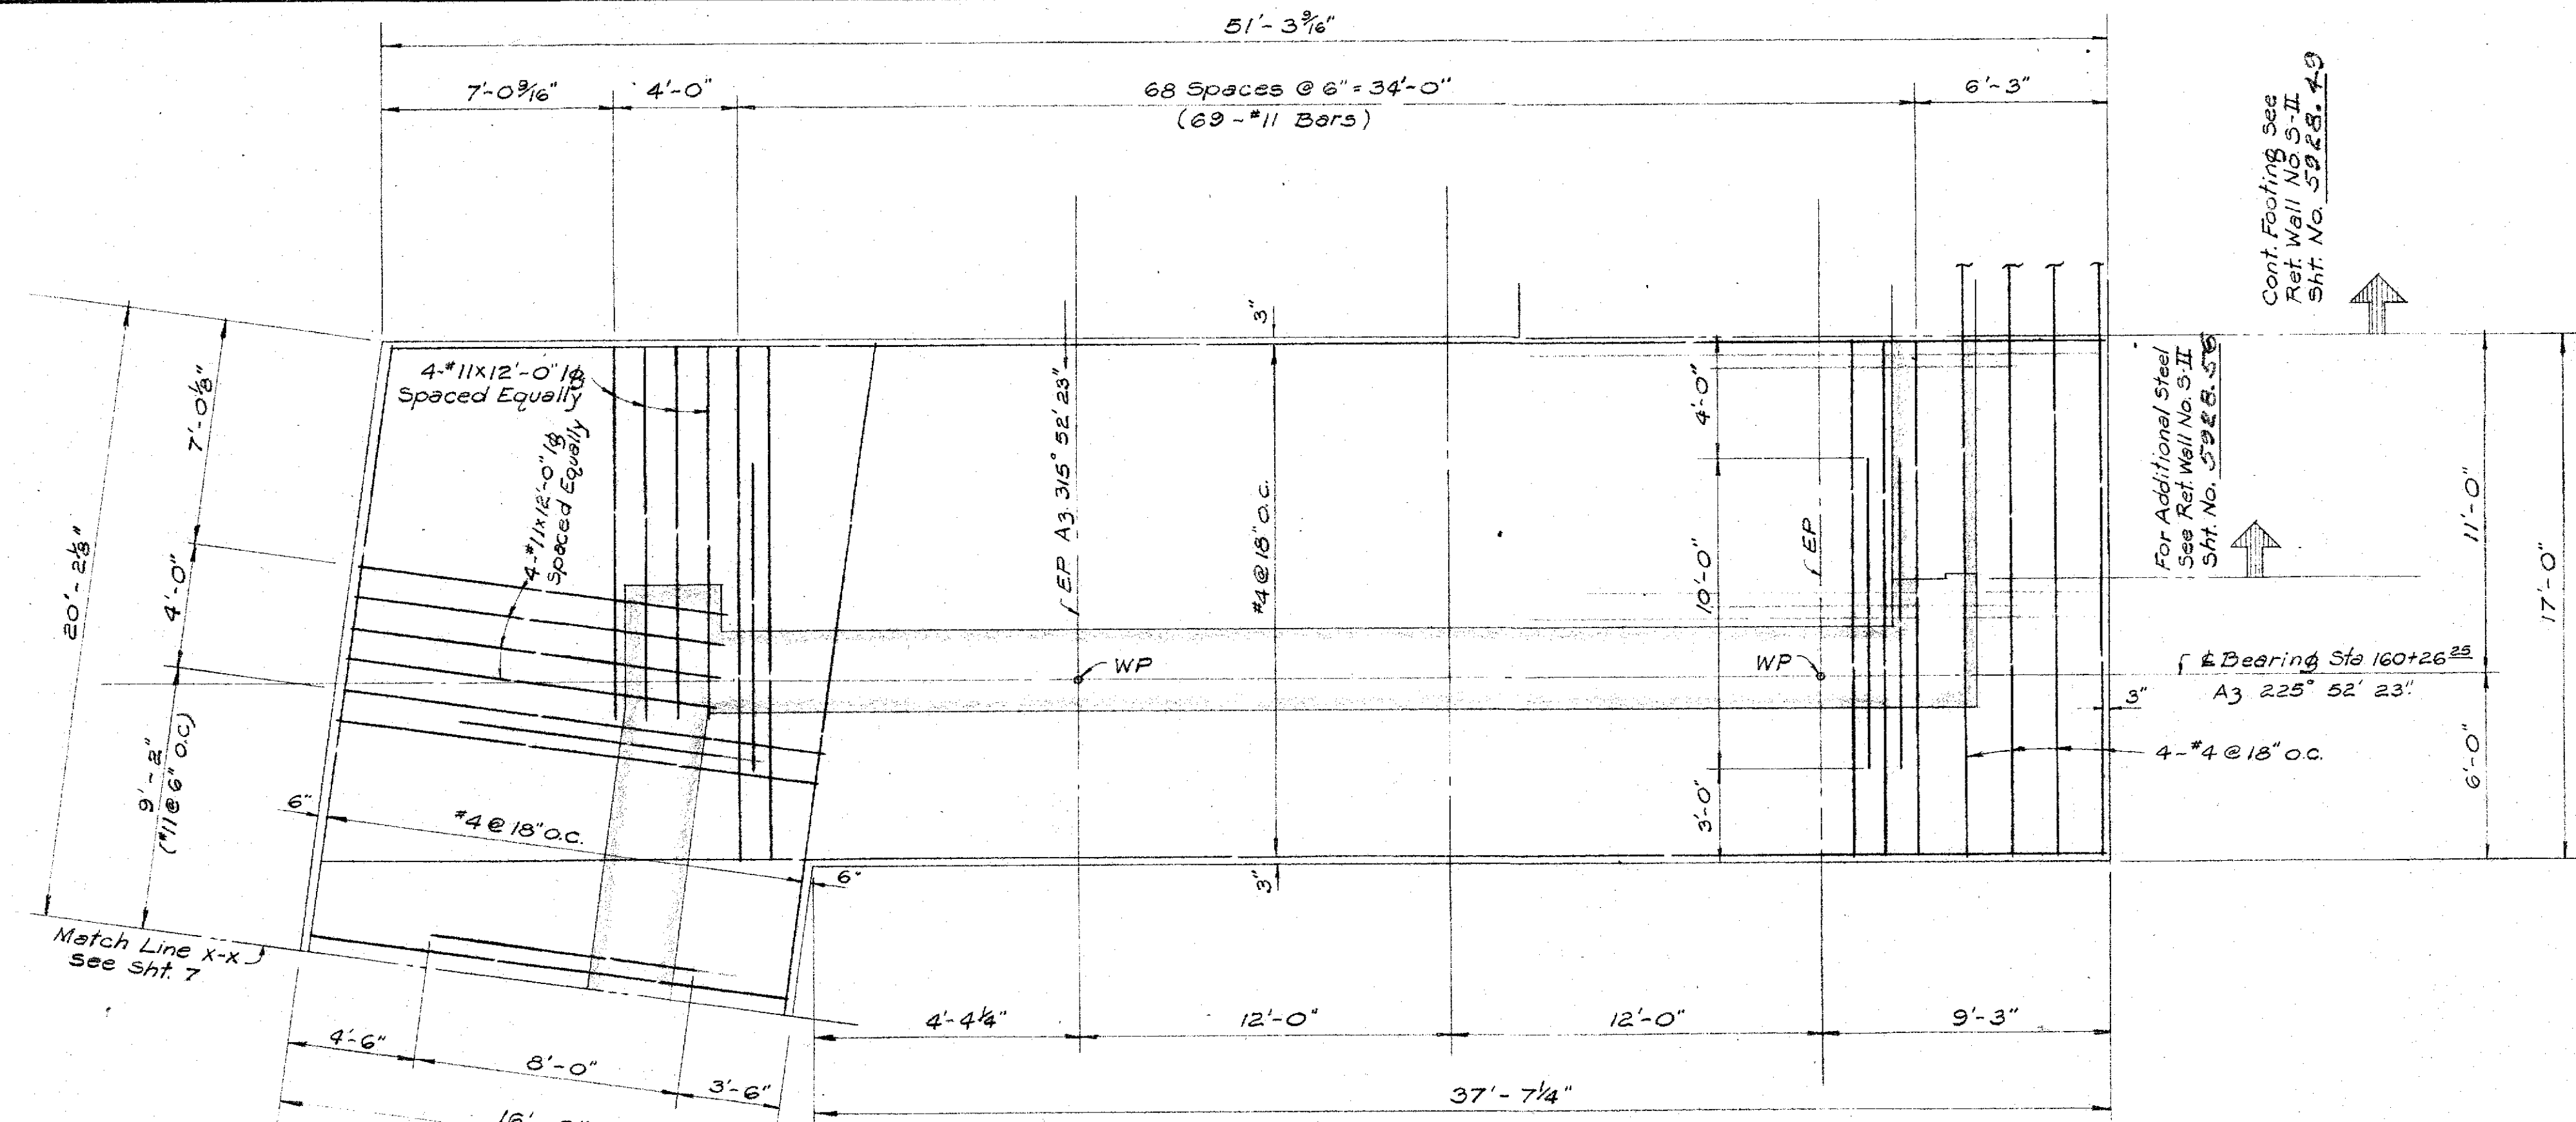


TOP STEEL FOOTING PLAN ABUT. NO. 1
Scale: 1/4\" = 1'-0"

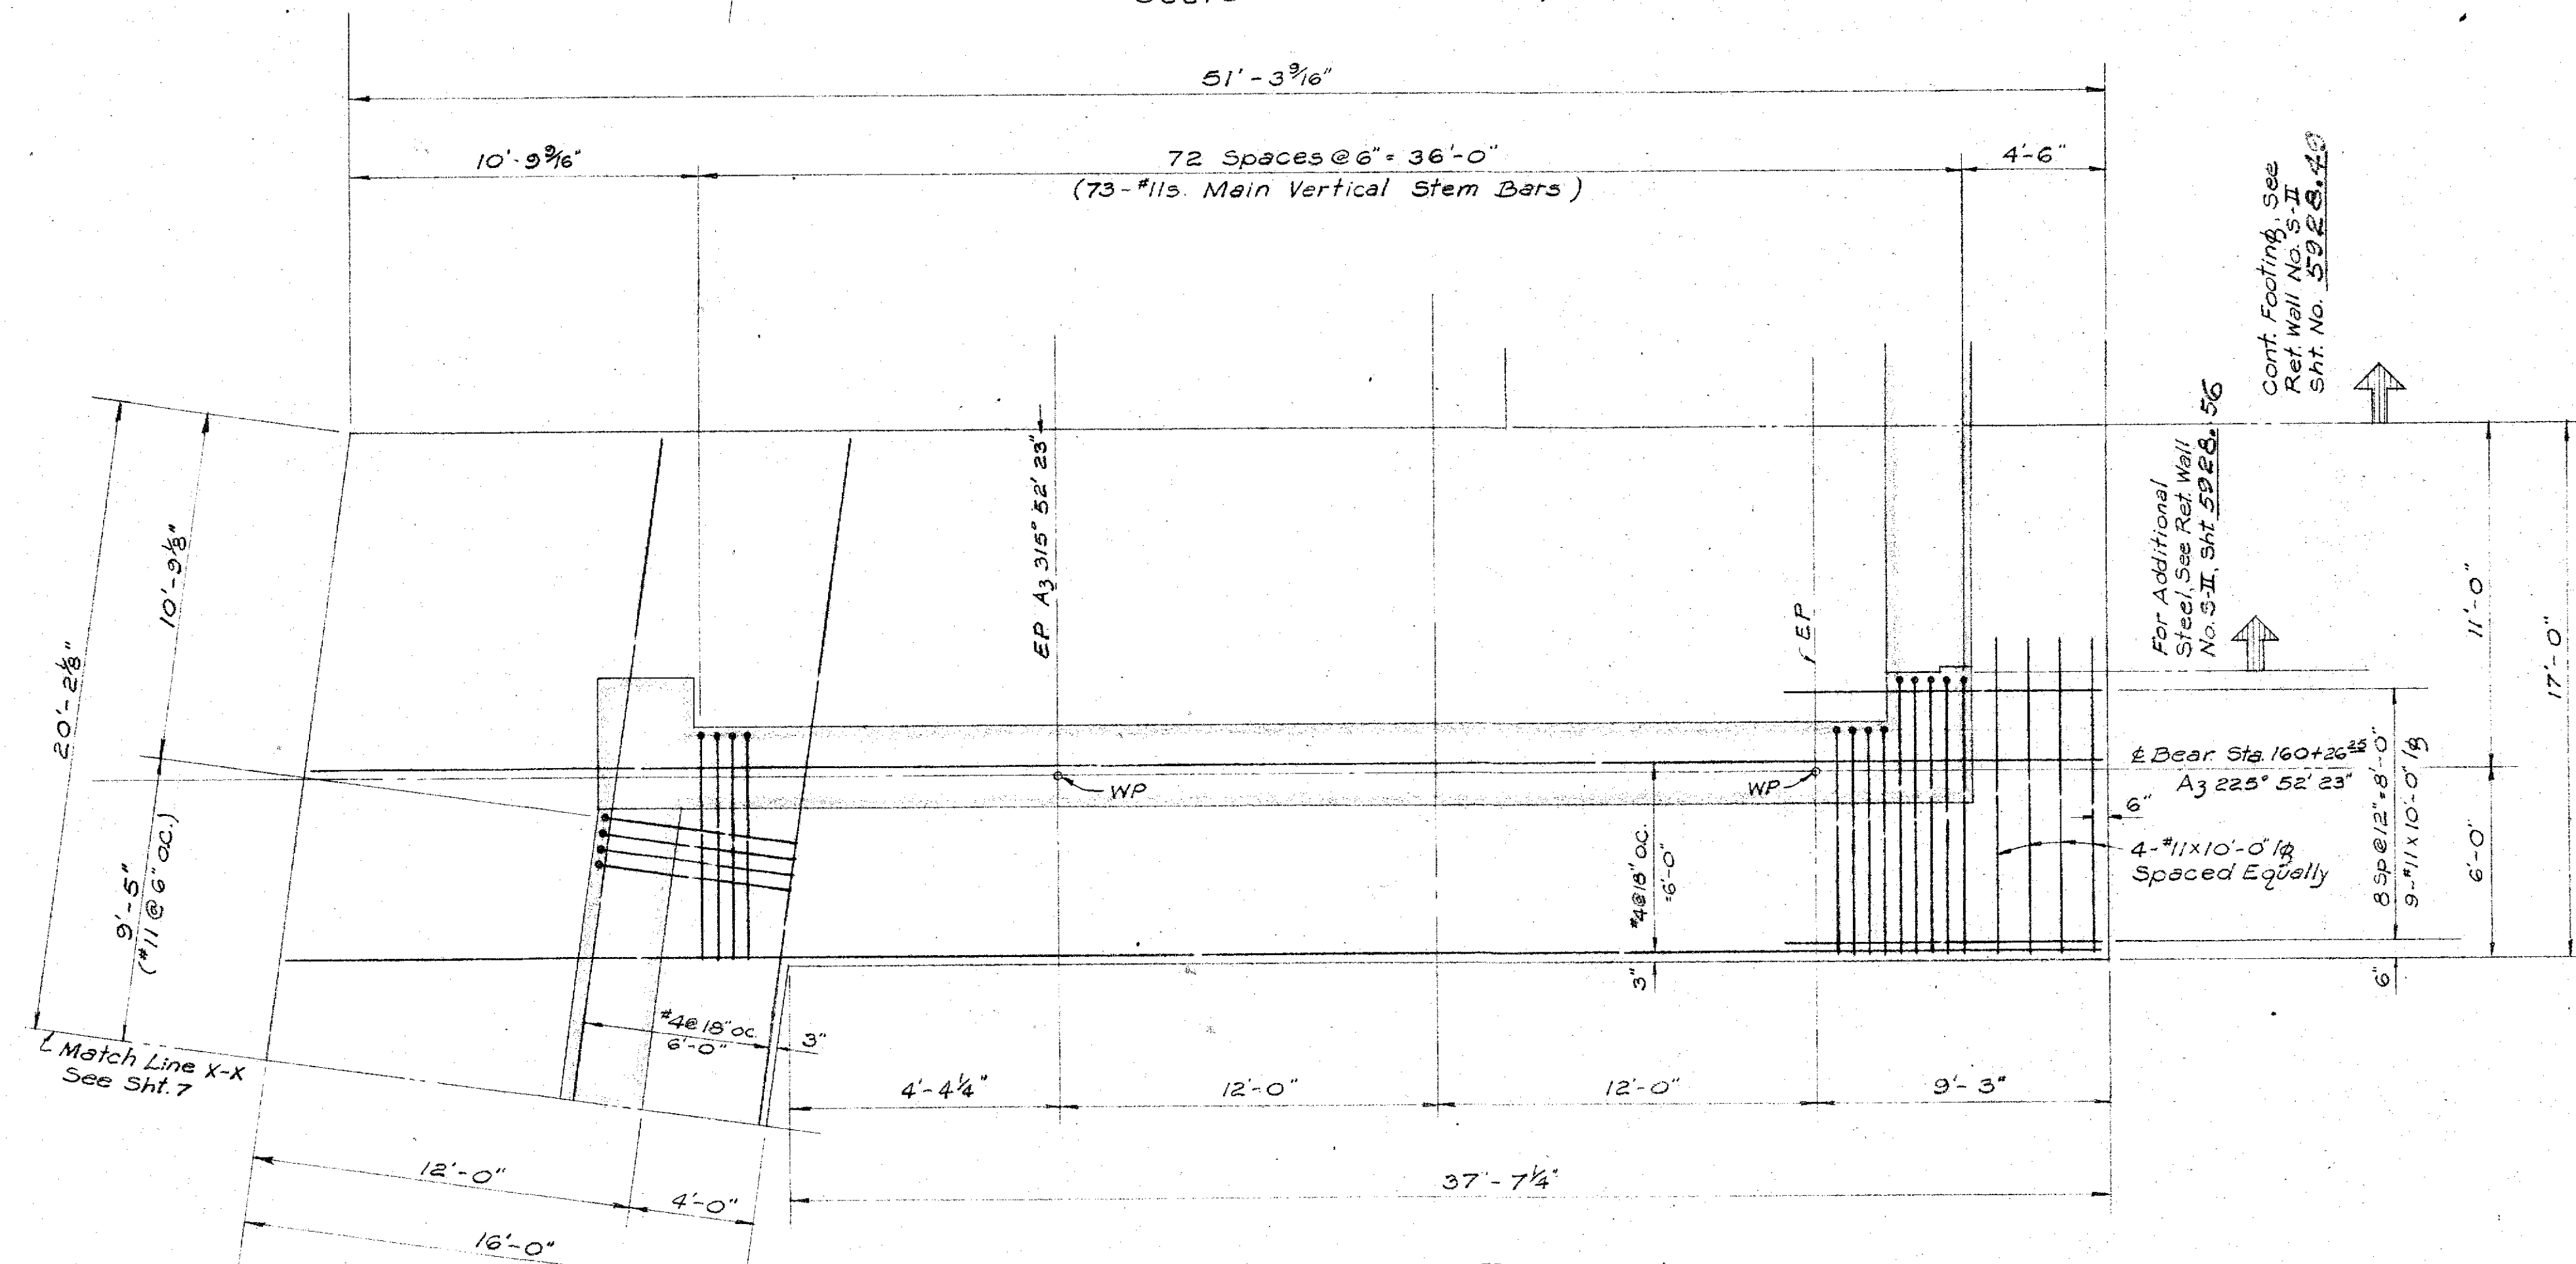


BOTTOM STEEL FOOTING PLAN ABUT. NO. 1
Scale: 1/4\" = 1'-0"

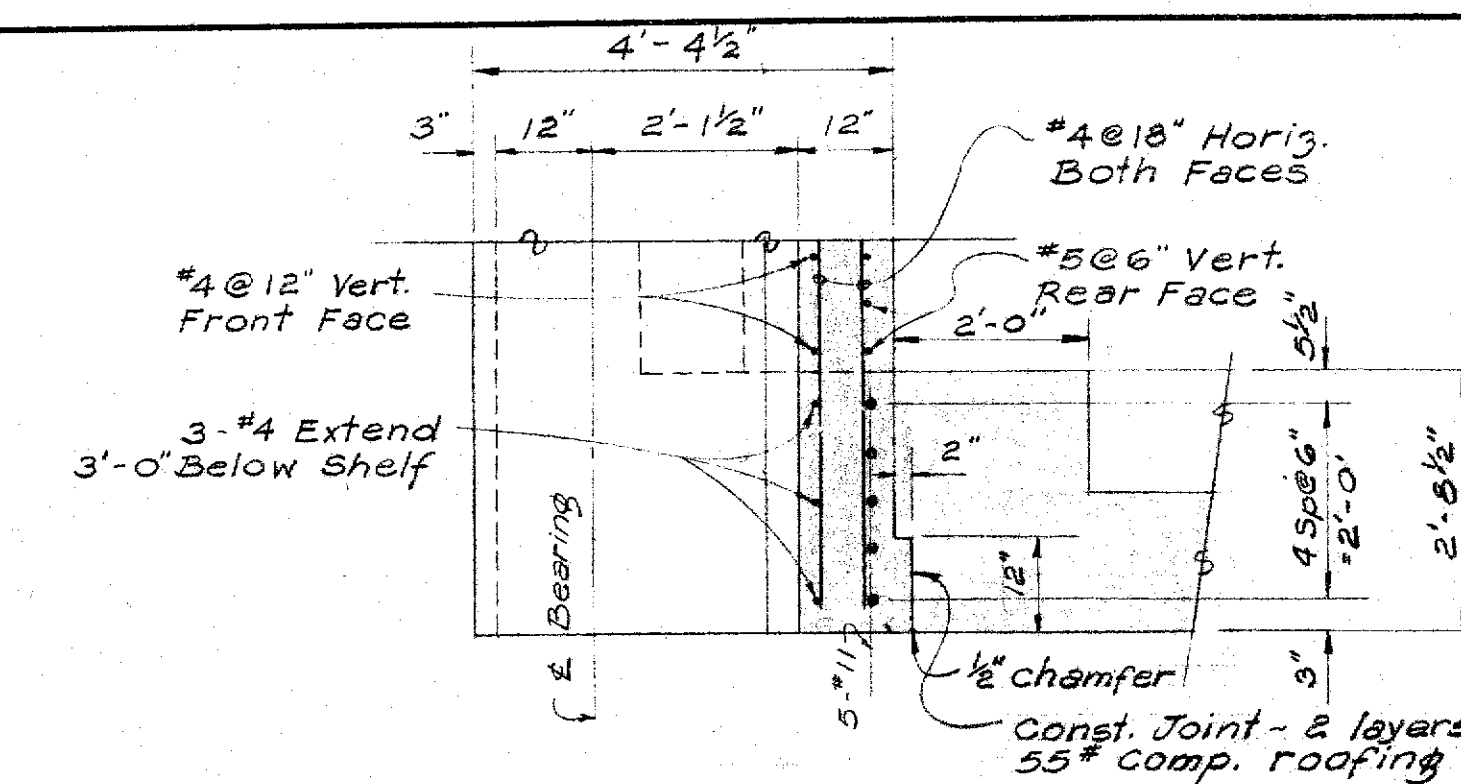


SECTION A-A
Scale: 1/2\" = 1'-0"

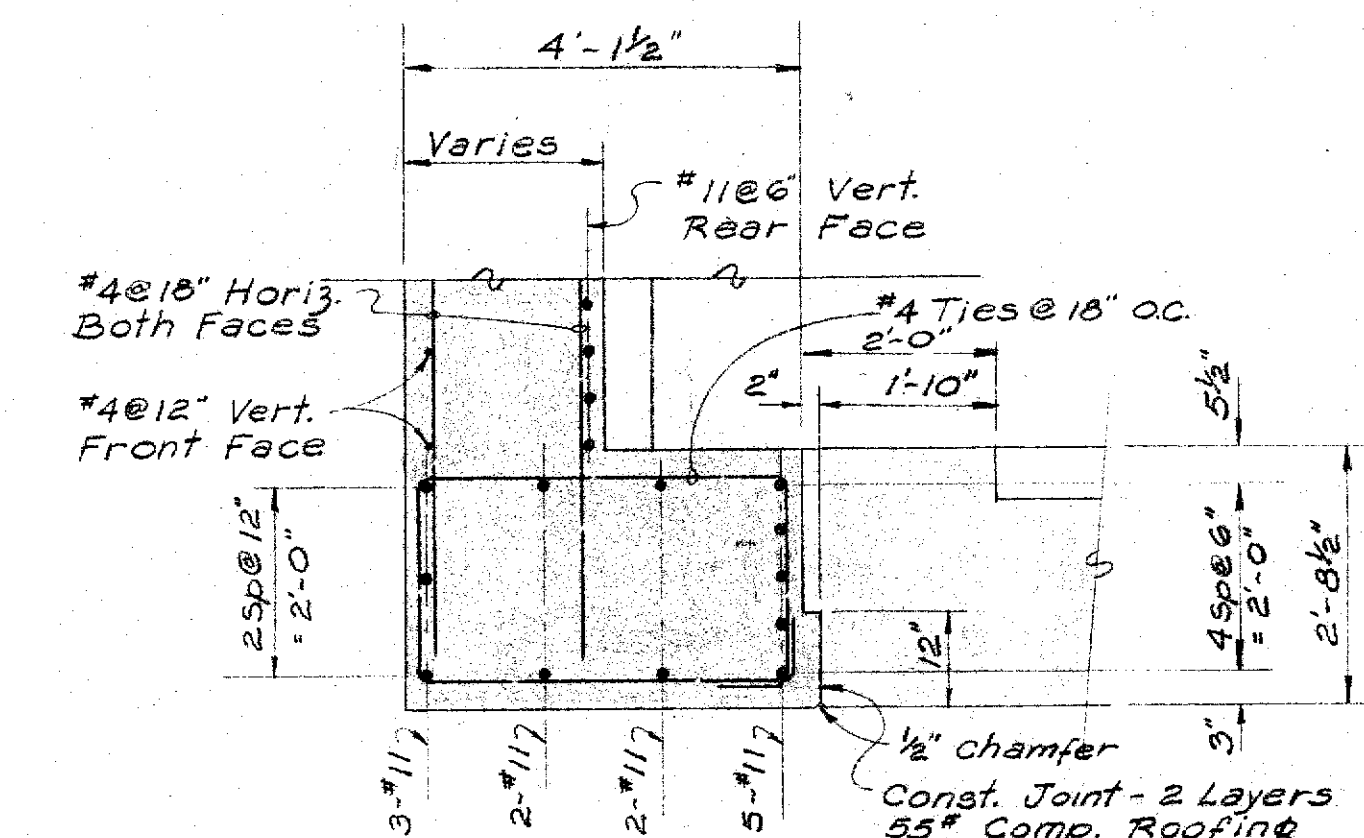

SECTION B-B
Scale: 1/2\" = 1'-0"

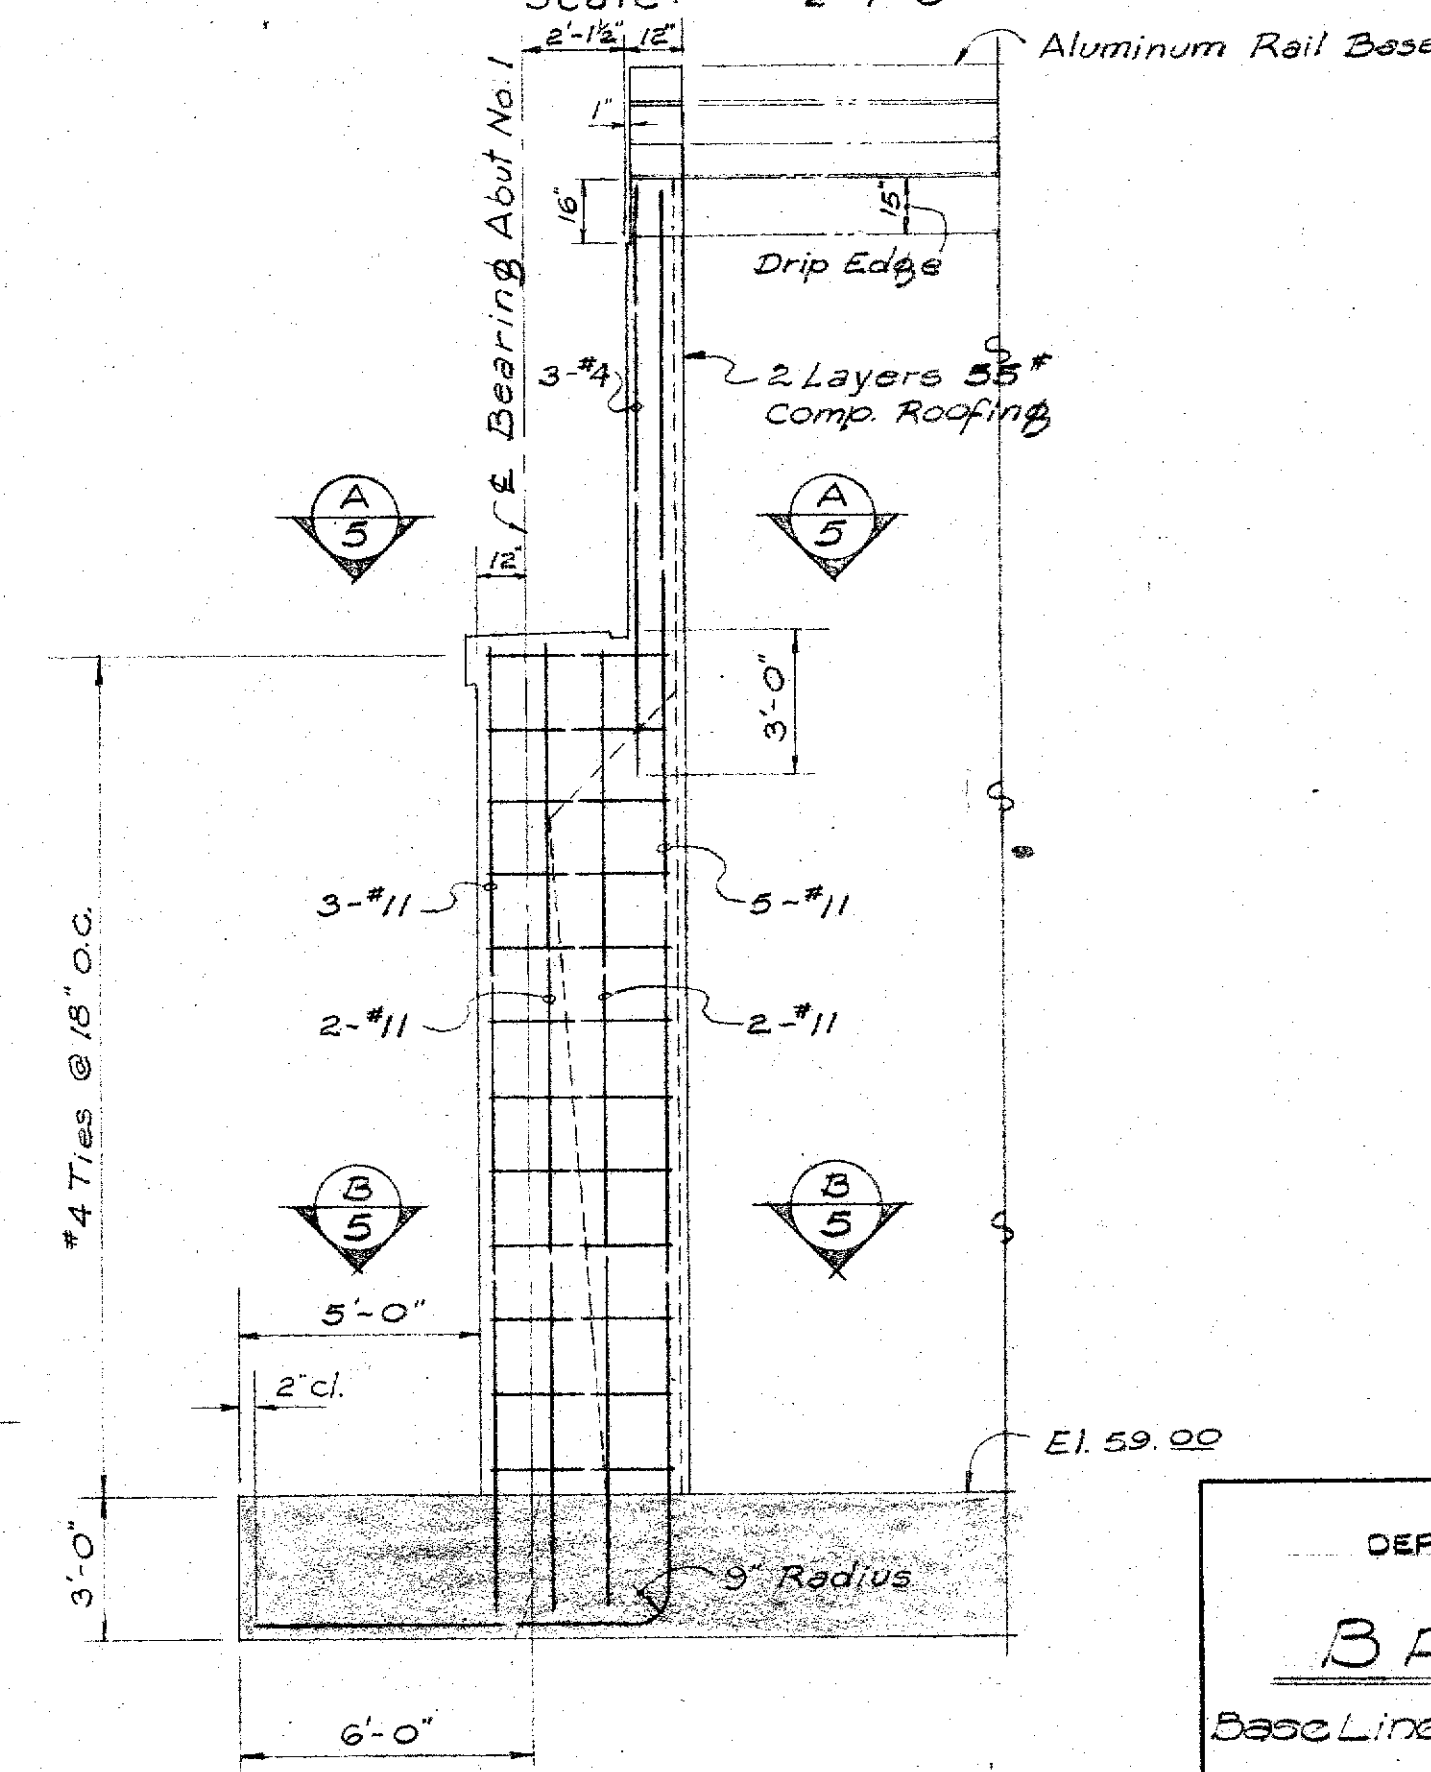

ELEVATION C-C
Scale: 1/4\" = 1'-0"
See Sht. No. 4

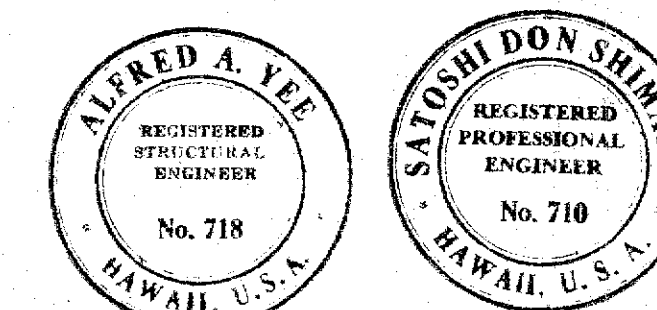

STATE OF HAWAII
DEPARTMENT OF TRANSPORTATION
HIGHWAYS DIVISION
BRIDGE No. 2
Base Line Sta. 100+23.15 To Sta. 102+50.20
VINEYARD BOULEVARD
PROJECT NO. F-098-1-(3)


SHEET No. 5 OF 16 SHEETS

CONSULTANT SUBMISSION

5928.84


SURVEY PLOTTED BY	DATE
DESIGNED BY	
DRAWN BY	
CHECKED BY	
NOTE BOOK	
NO.	

ORIGINAL PLAN	SURVEY PLOTTED BY _____	DATE _____
	DESIGNED BY _____	" _____
	DRAWN BY _____	" _____
	TRACED BY _____	" _____
NOTE BOOK	QUANTITIES BY _____	" _____
No. _____	QUANTITIES CHECKED BY _____	" _____
	CHECKED BY _____	" _____

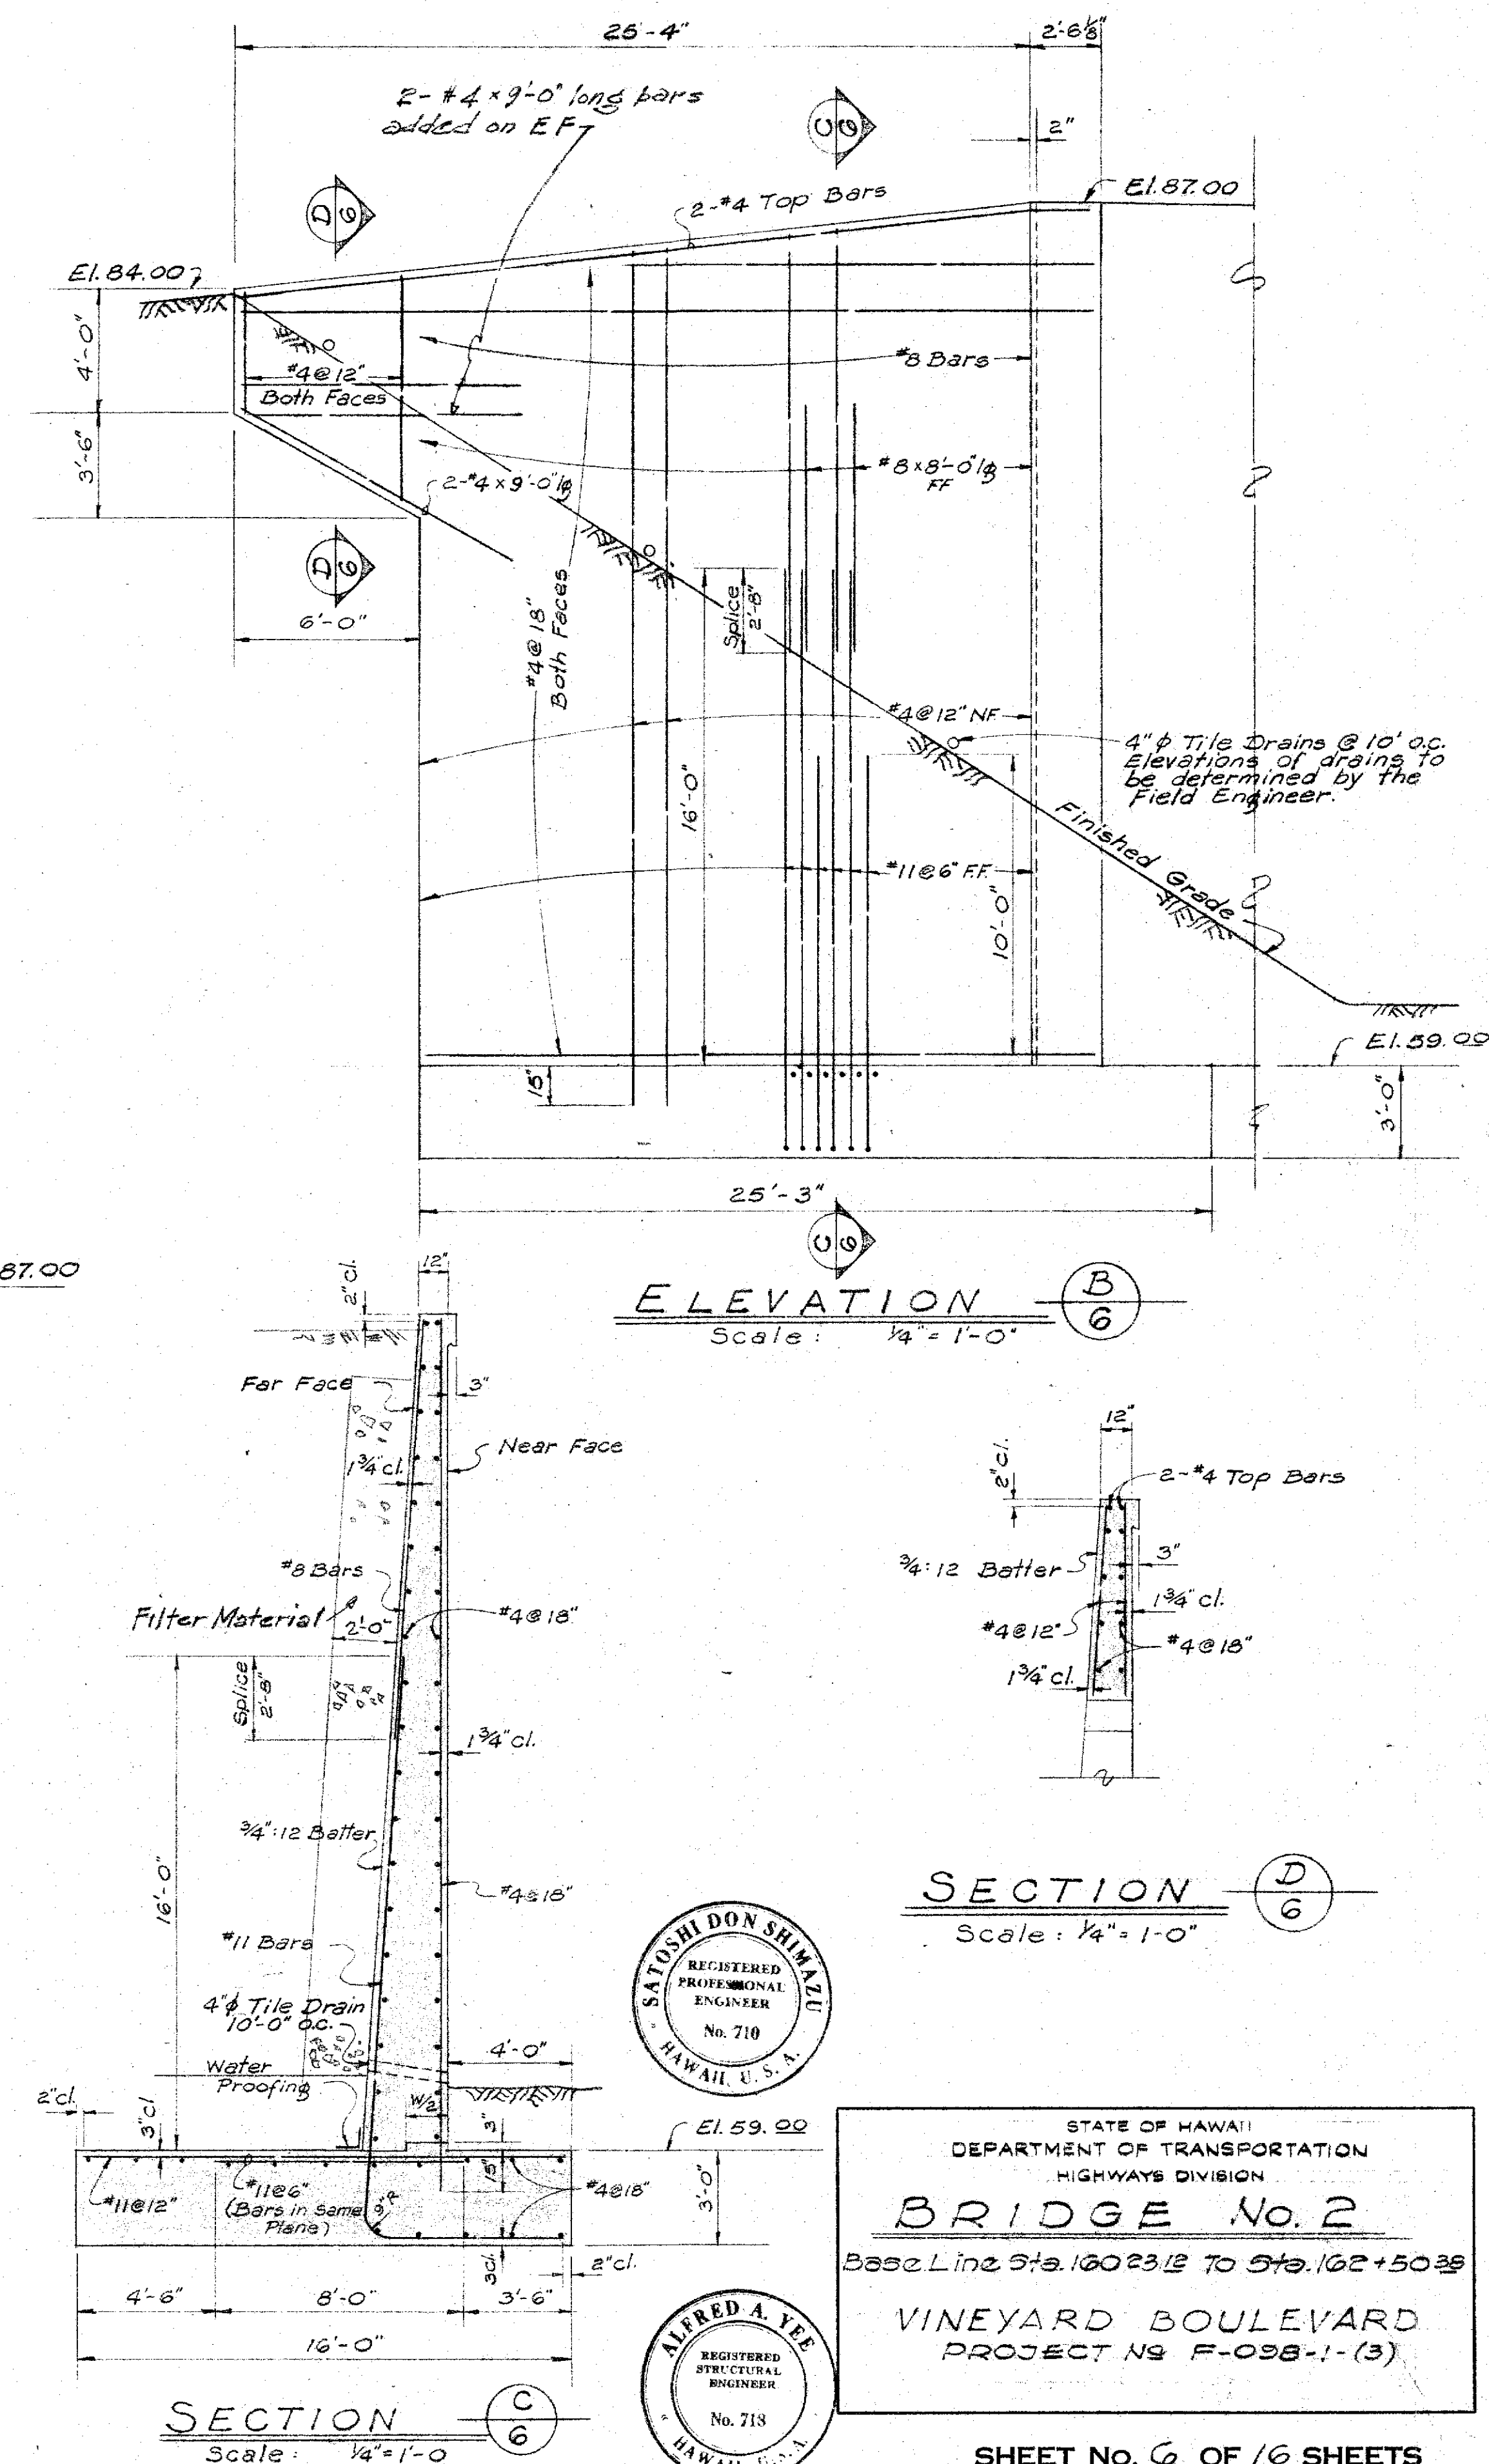


5928.85


SURVEY PLOTTED BY	DATE
DESIGNED BY	
TRACED BY	
QUANTITIES CHECKED BY	
CHECKED BY	
NOTE BOOK No.	

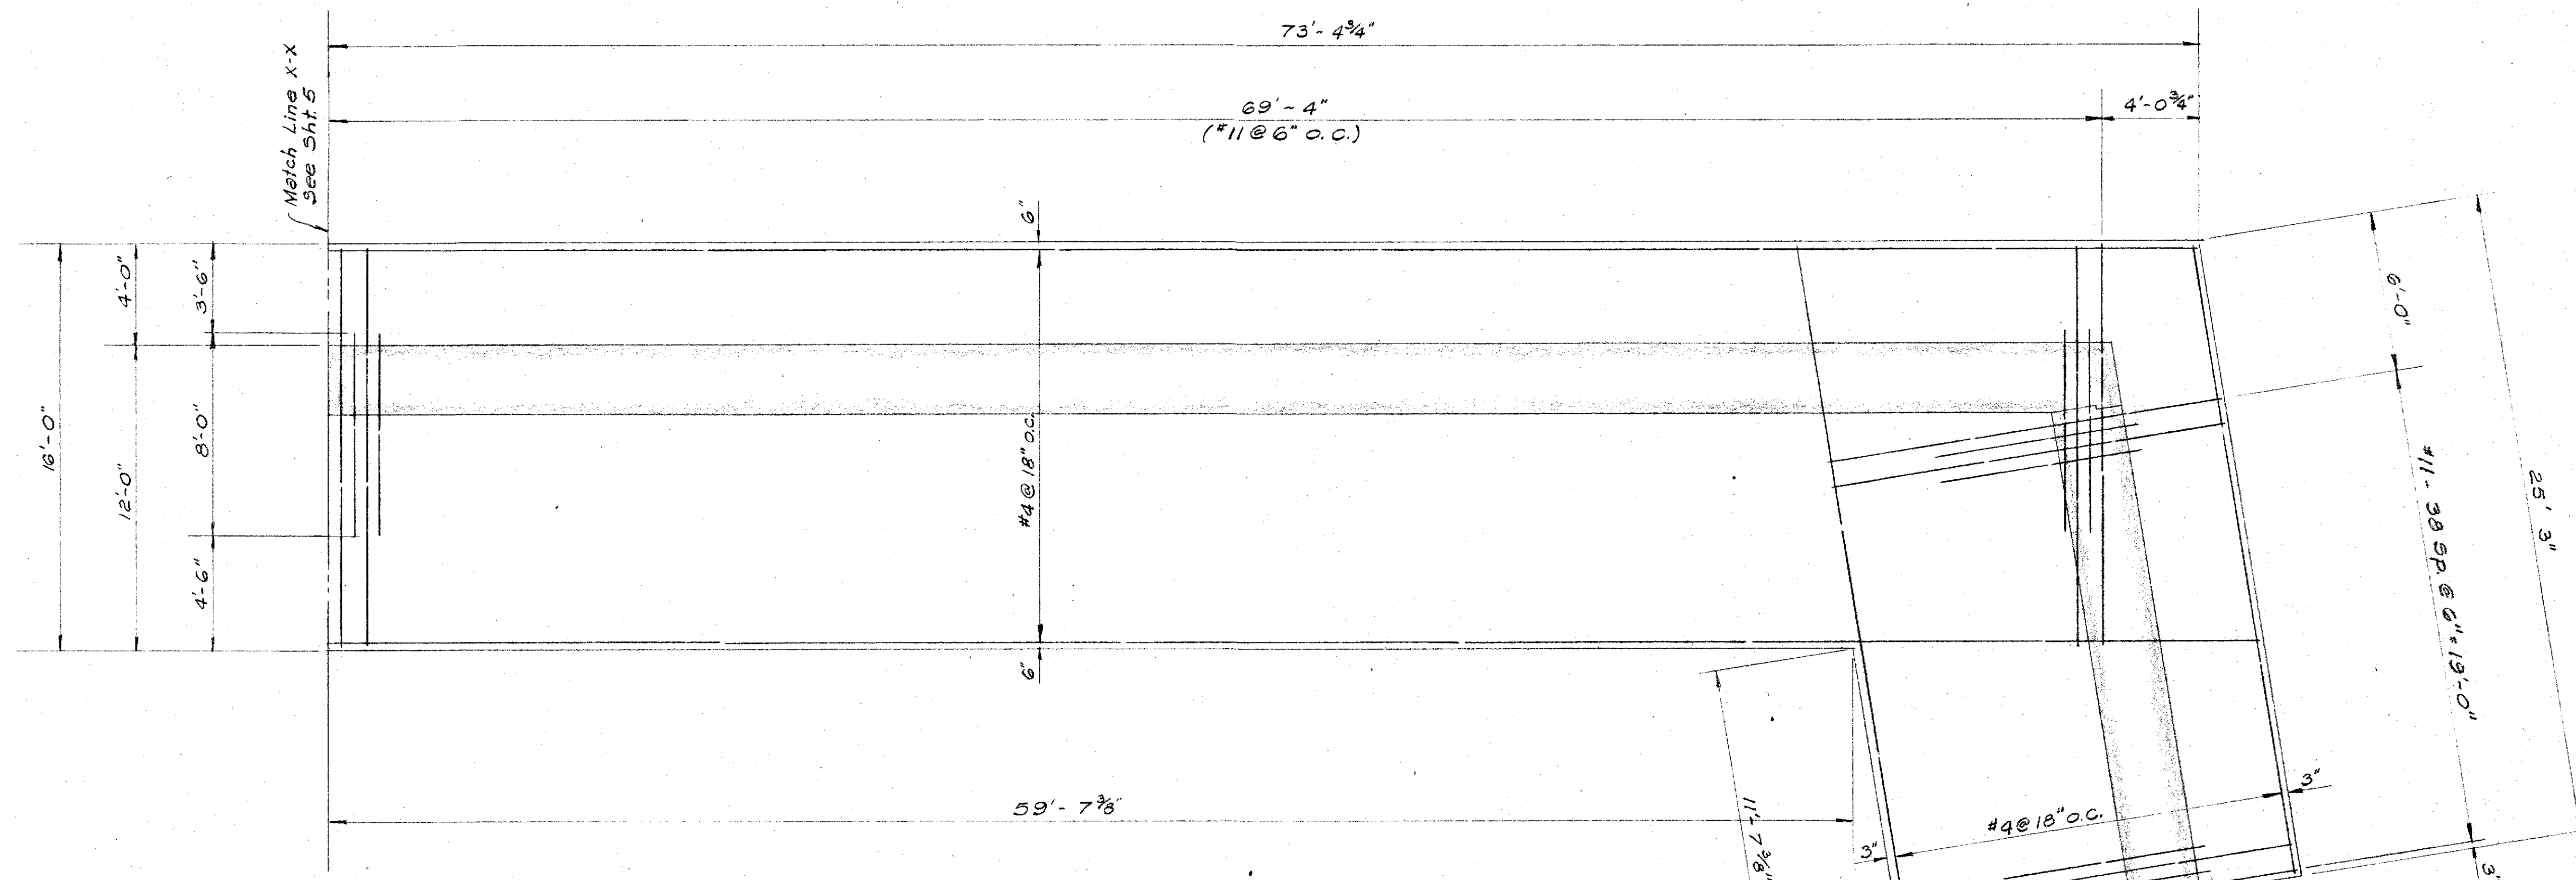

TOP STEEL - FOOTING PLAN - RET. WALL "A"
Scale: 1/4" = 1'-0"


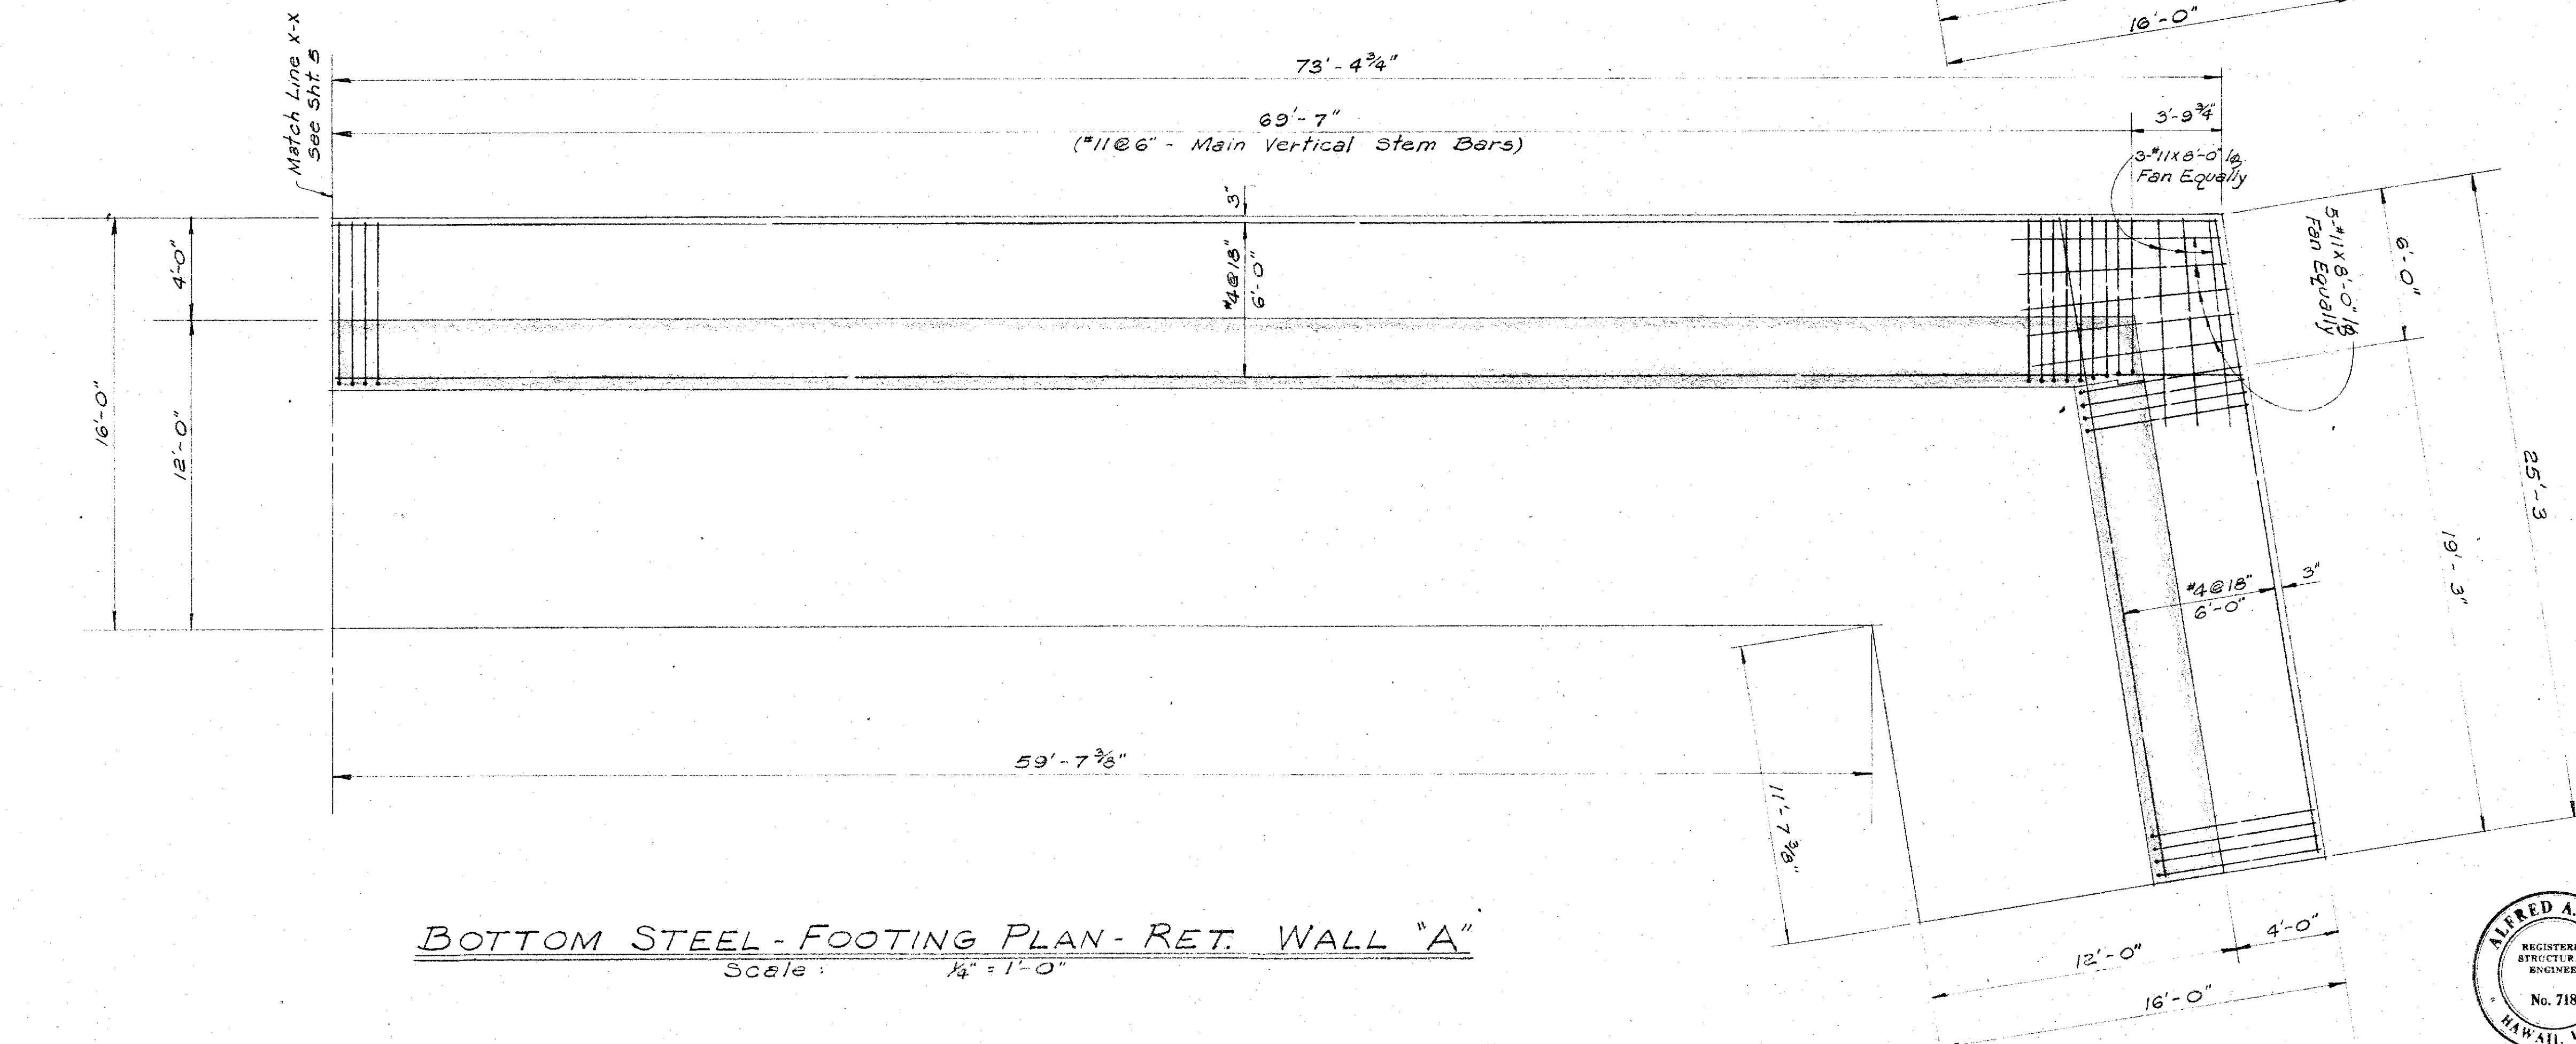


BOTTOM STEEL - FOOTING PLAN - RET. WALL "A"
Scale: 1/4" = 1'-0"

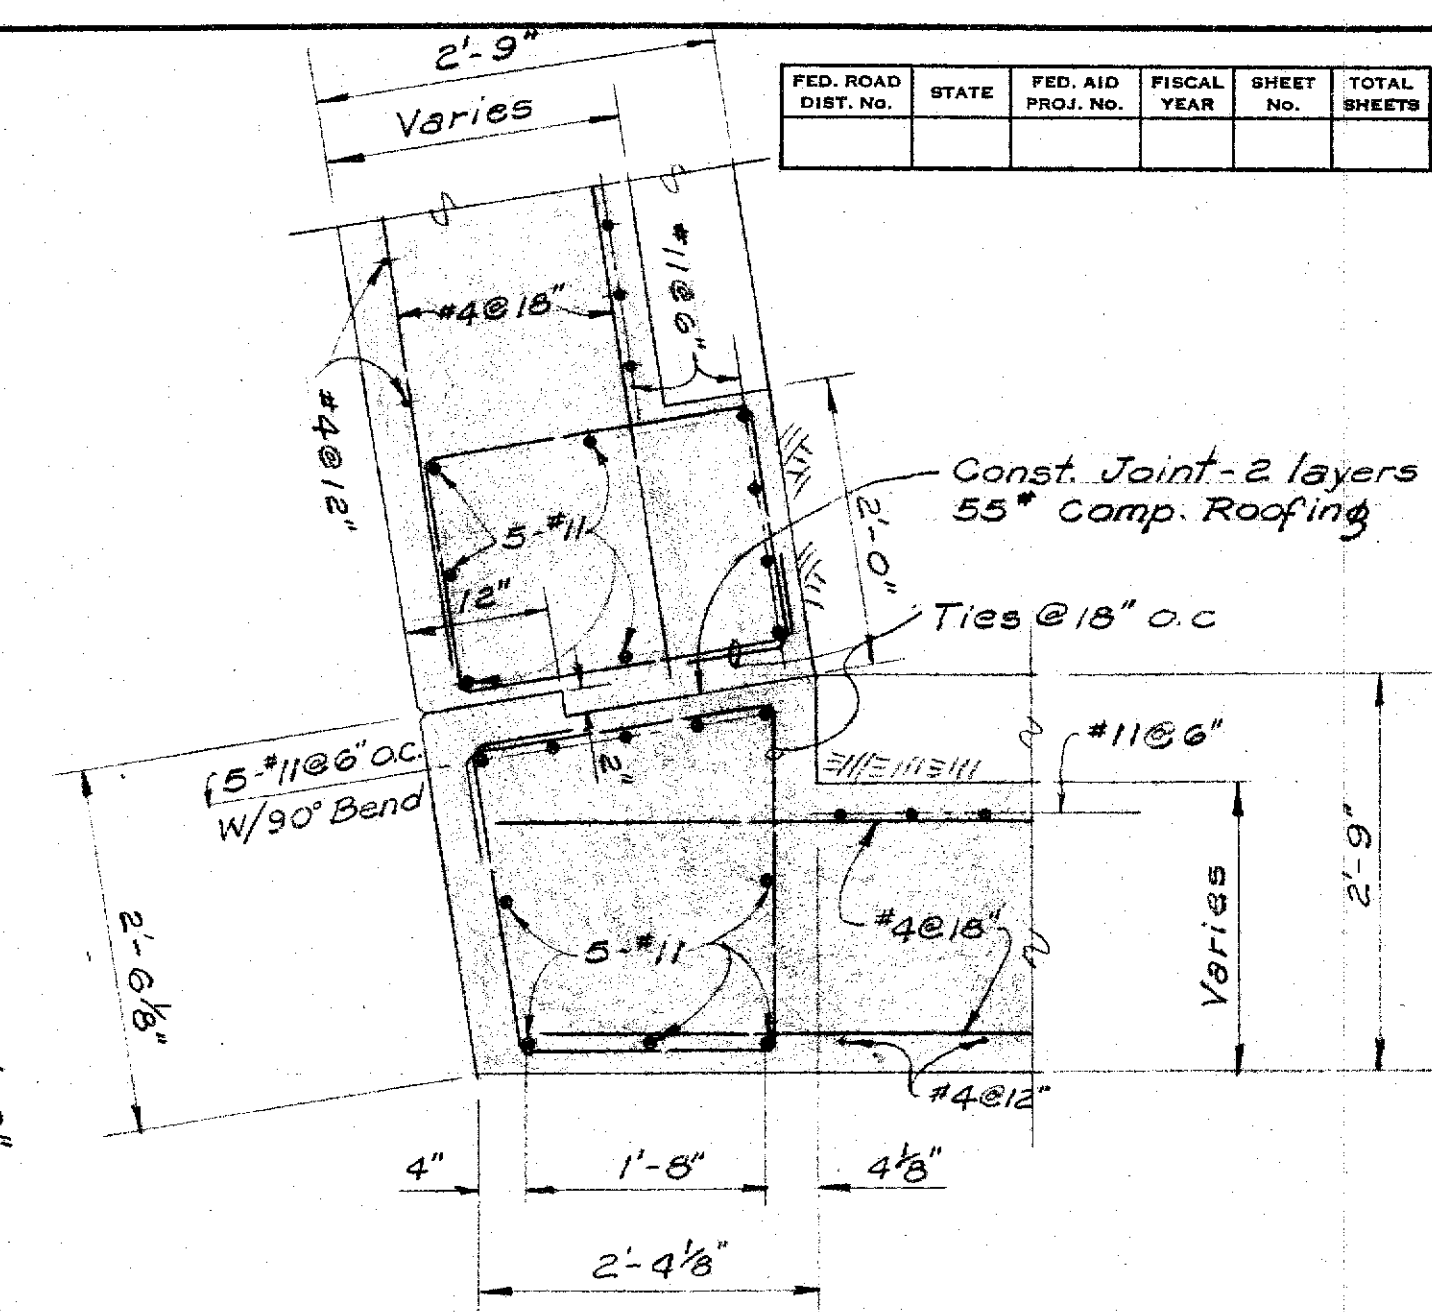

SECTION A-7
Scale: 3/4" = 1'-0"
See Sht. No. 6

STATE OF HAWAII
DEPARTMENT OF TRANSPORTATION
HIGHWAYS DIVISION
BRIDGE No. 2
Base Line Sts 120+23.12 TO Sts. 122+50.28
VINEYARD BOULEVARD
PROJECT No. F-038-1-(3)

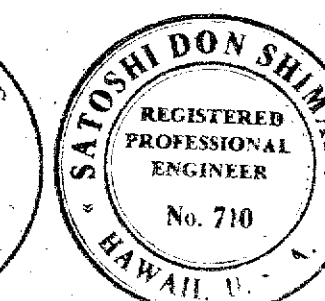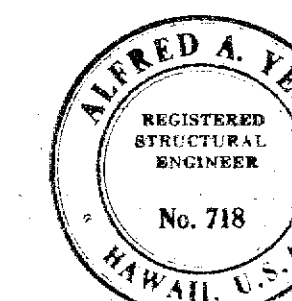








SHEET No. 7 OF 16 SHEETS

CONSULTANT SUBMISSION

5928.86

5928.87

FED. ROAD DIST. NO.	STATE	FED. AID PROJ. NO.	FISCAL YEAR	SHEET NO.	TOTAL SHEETS
				10	16

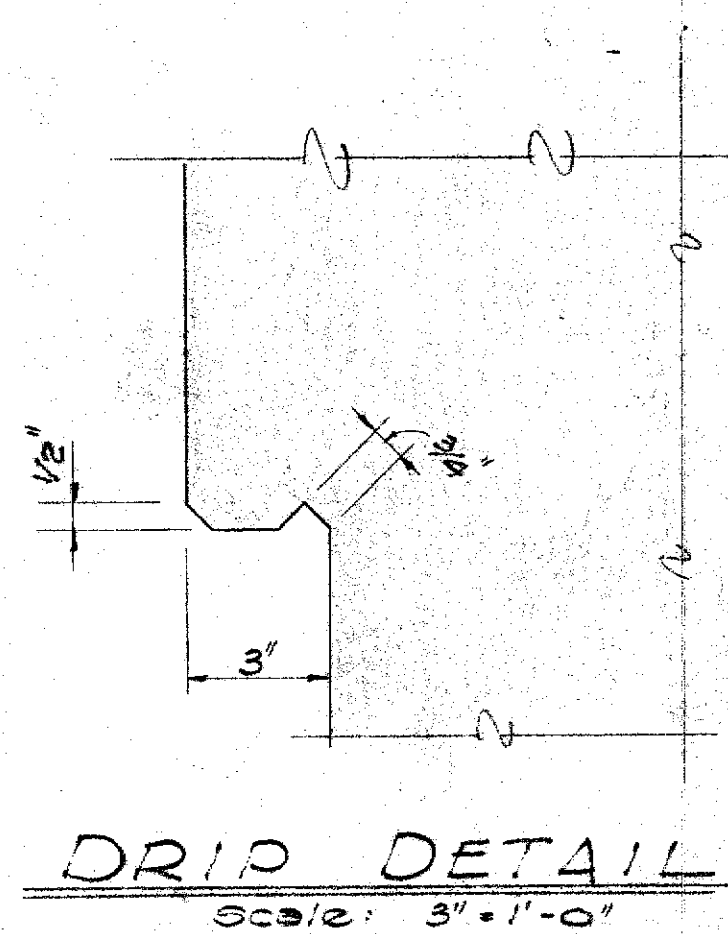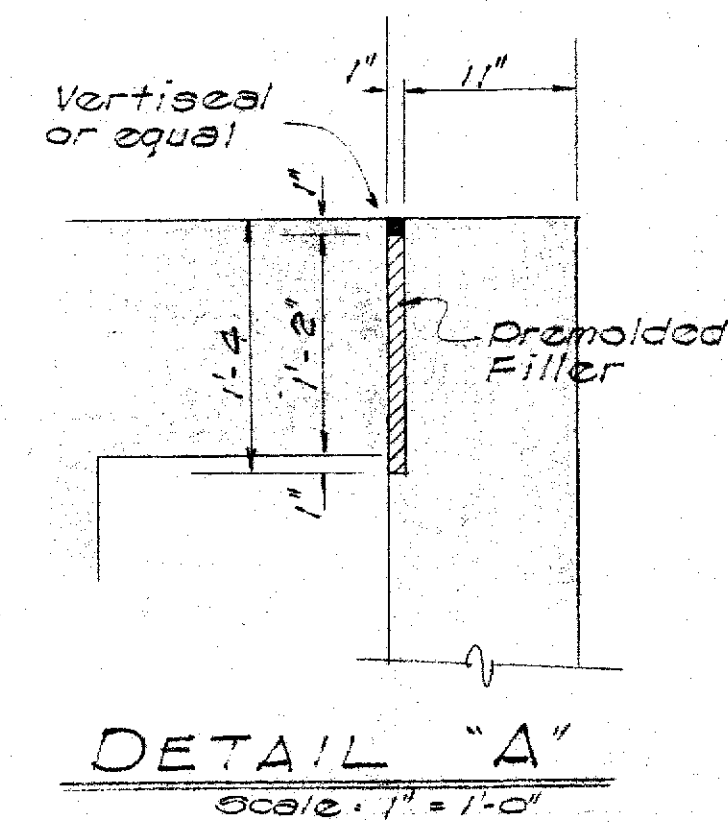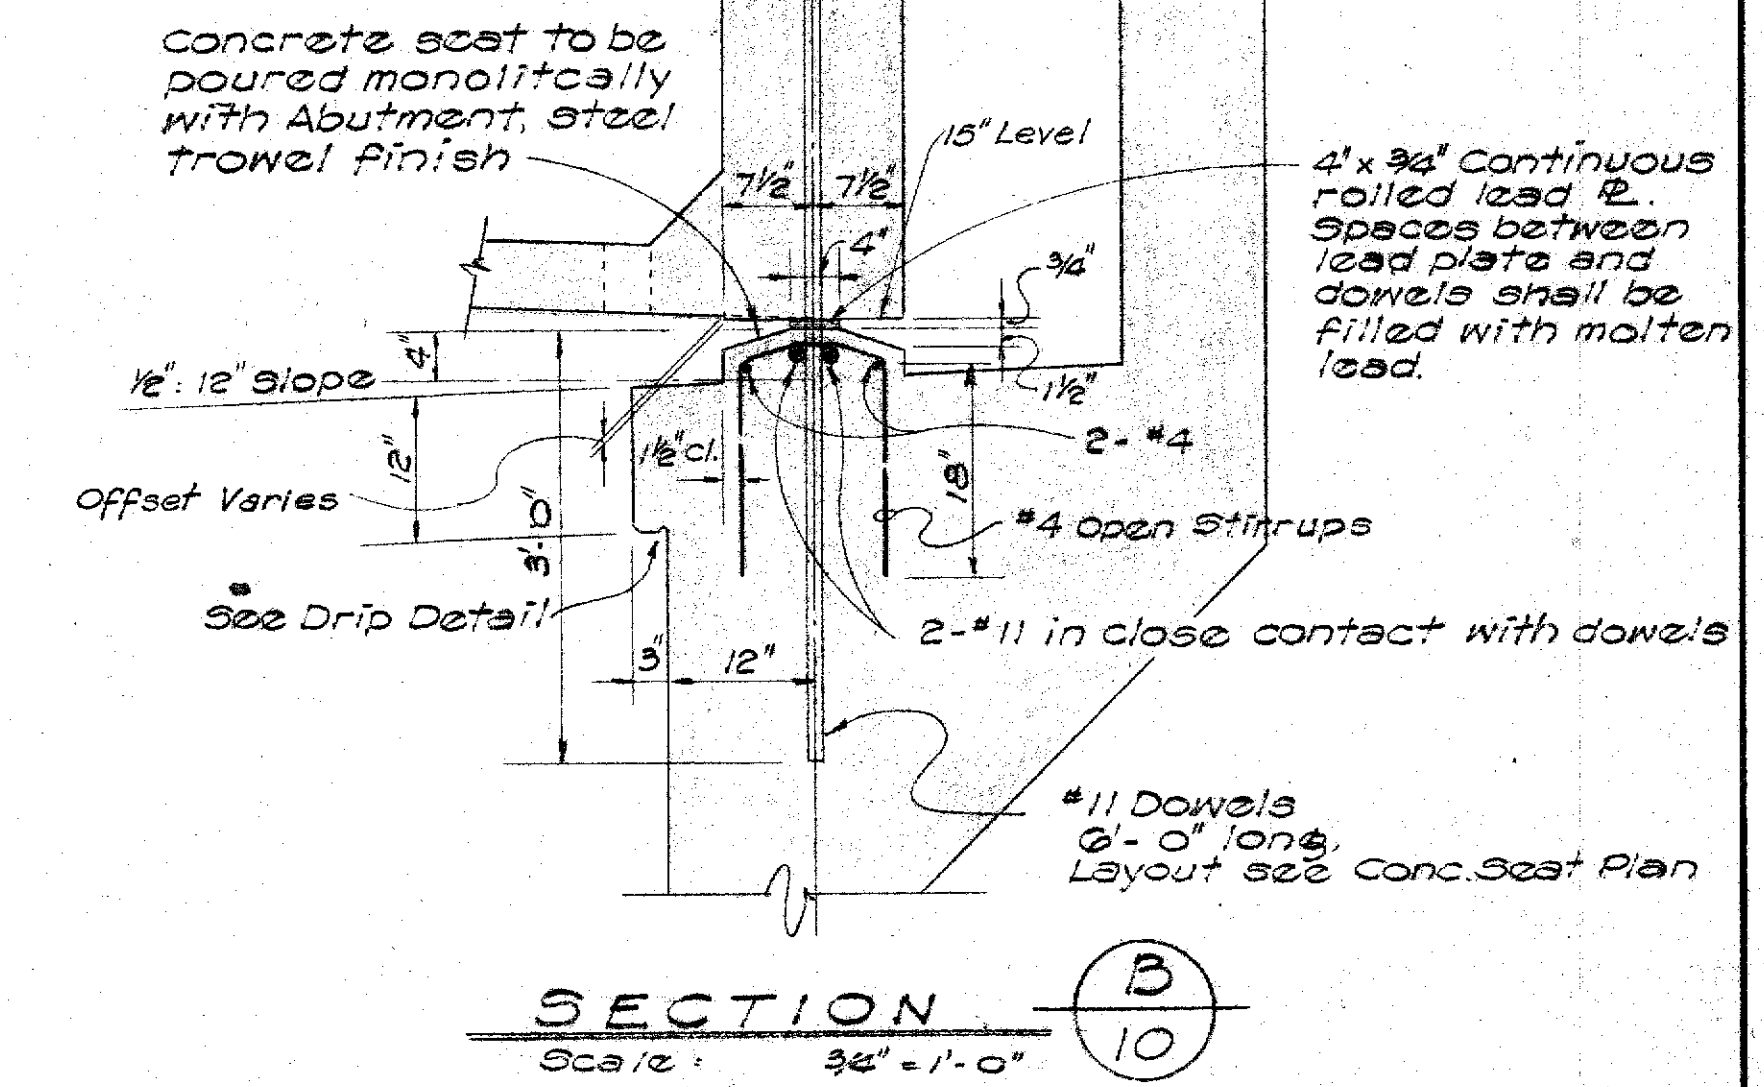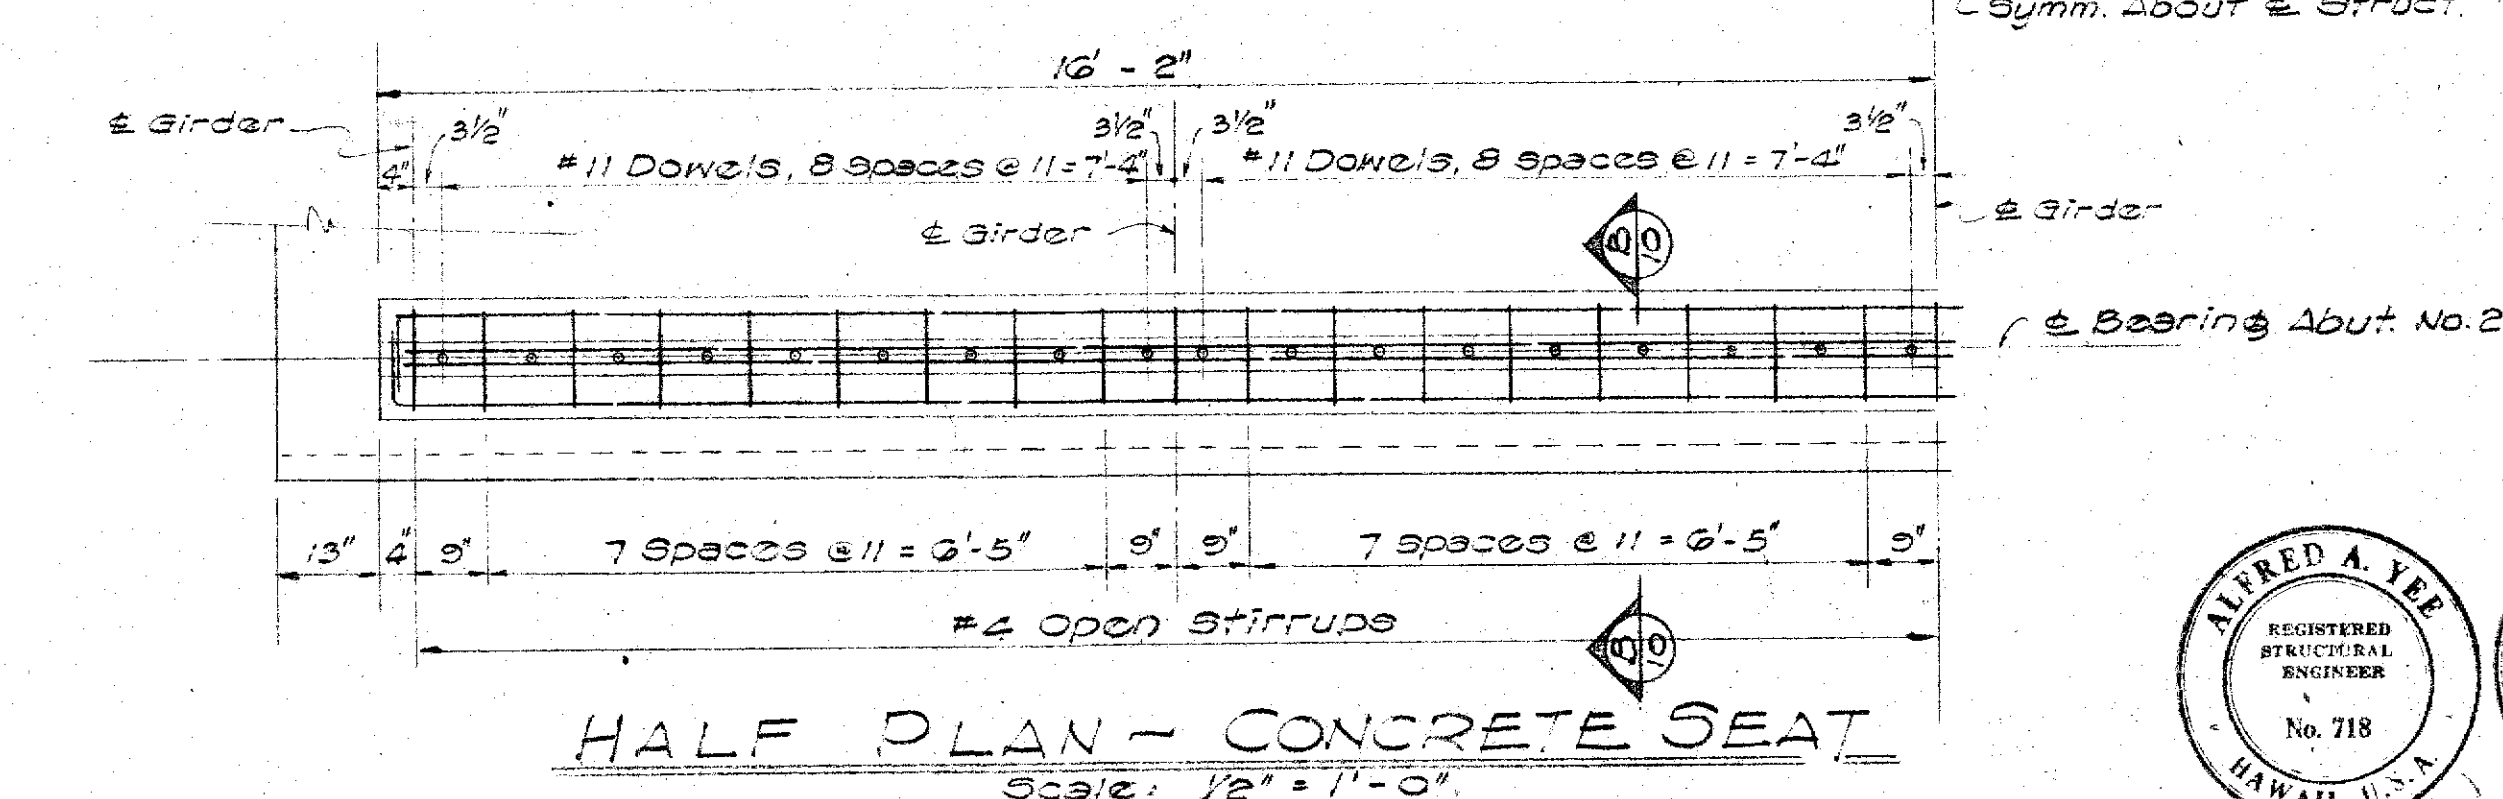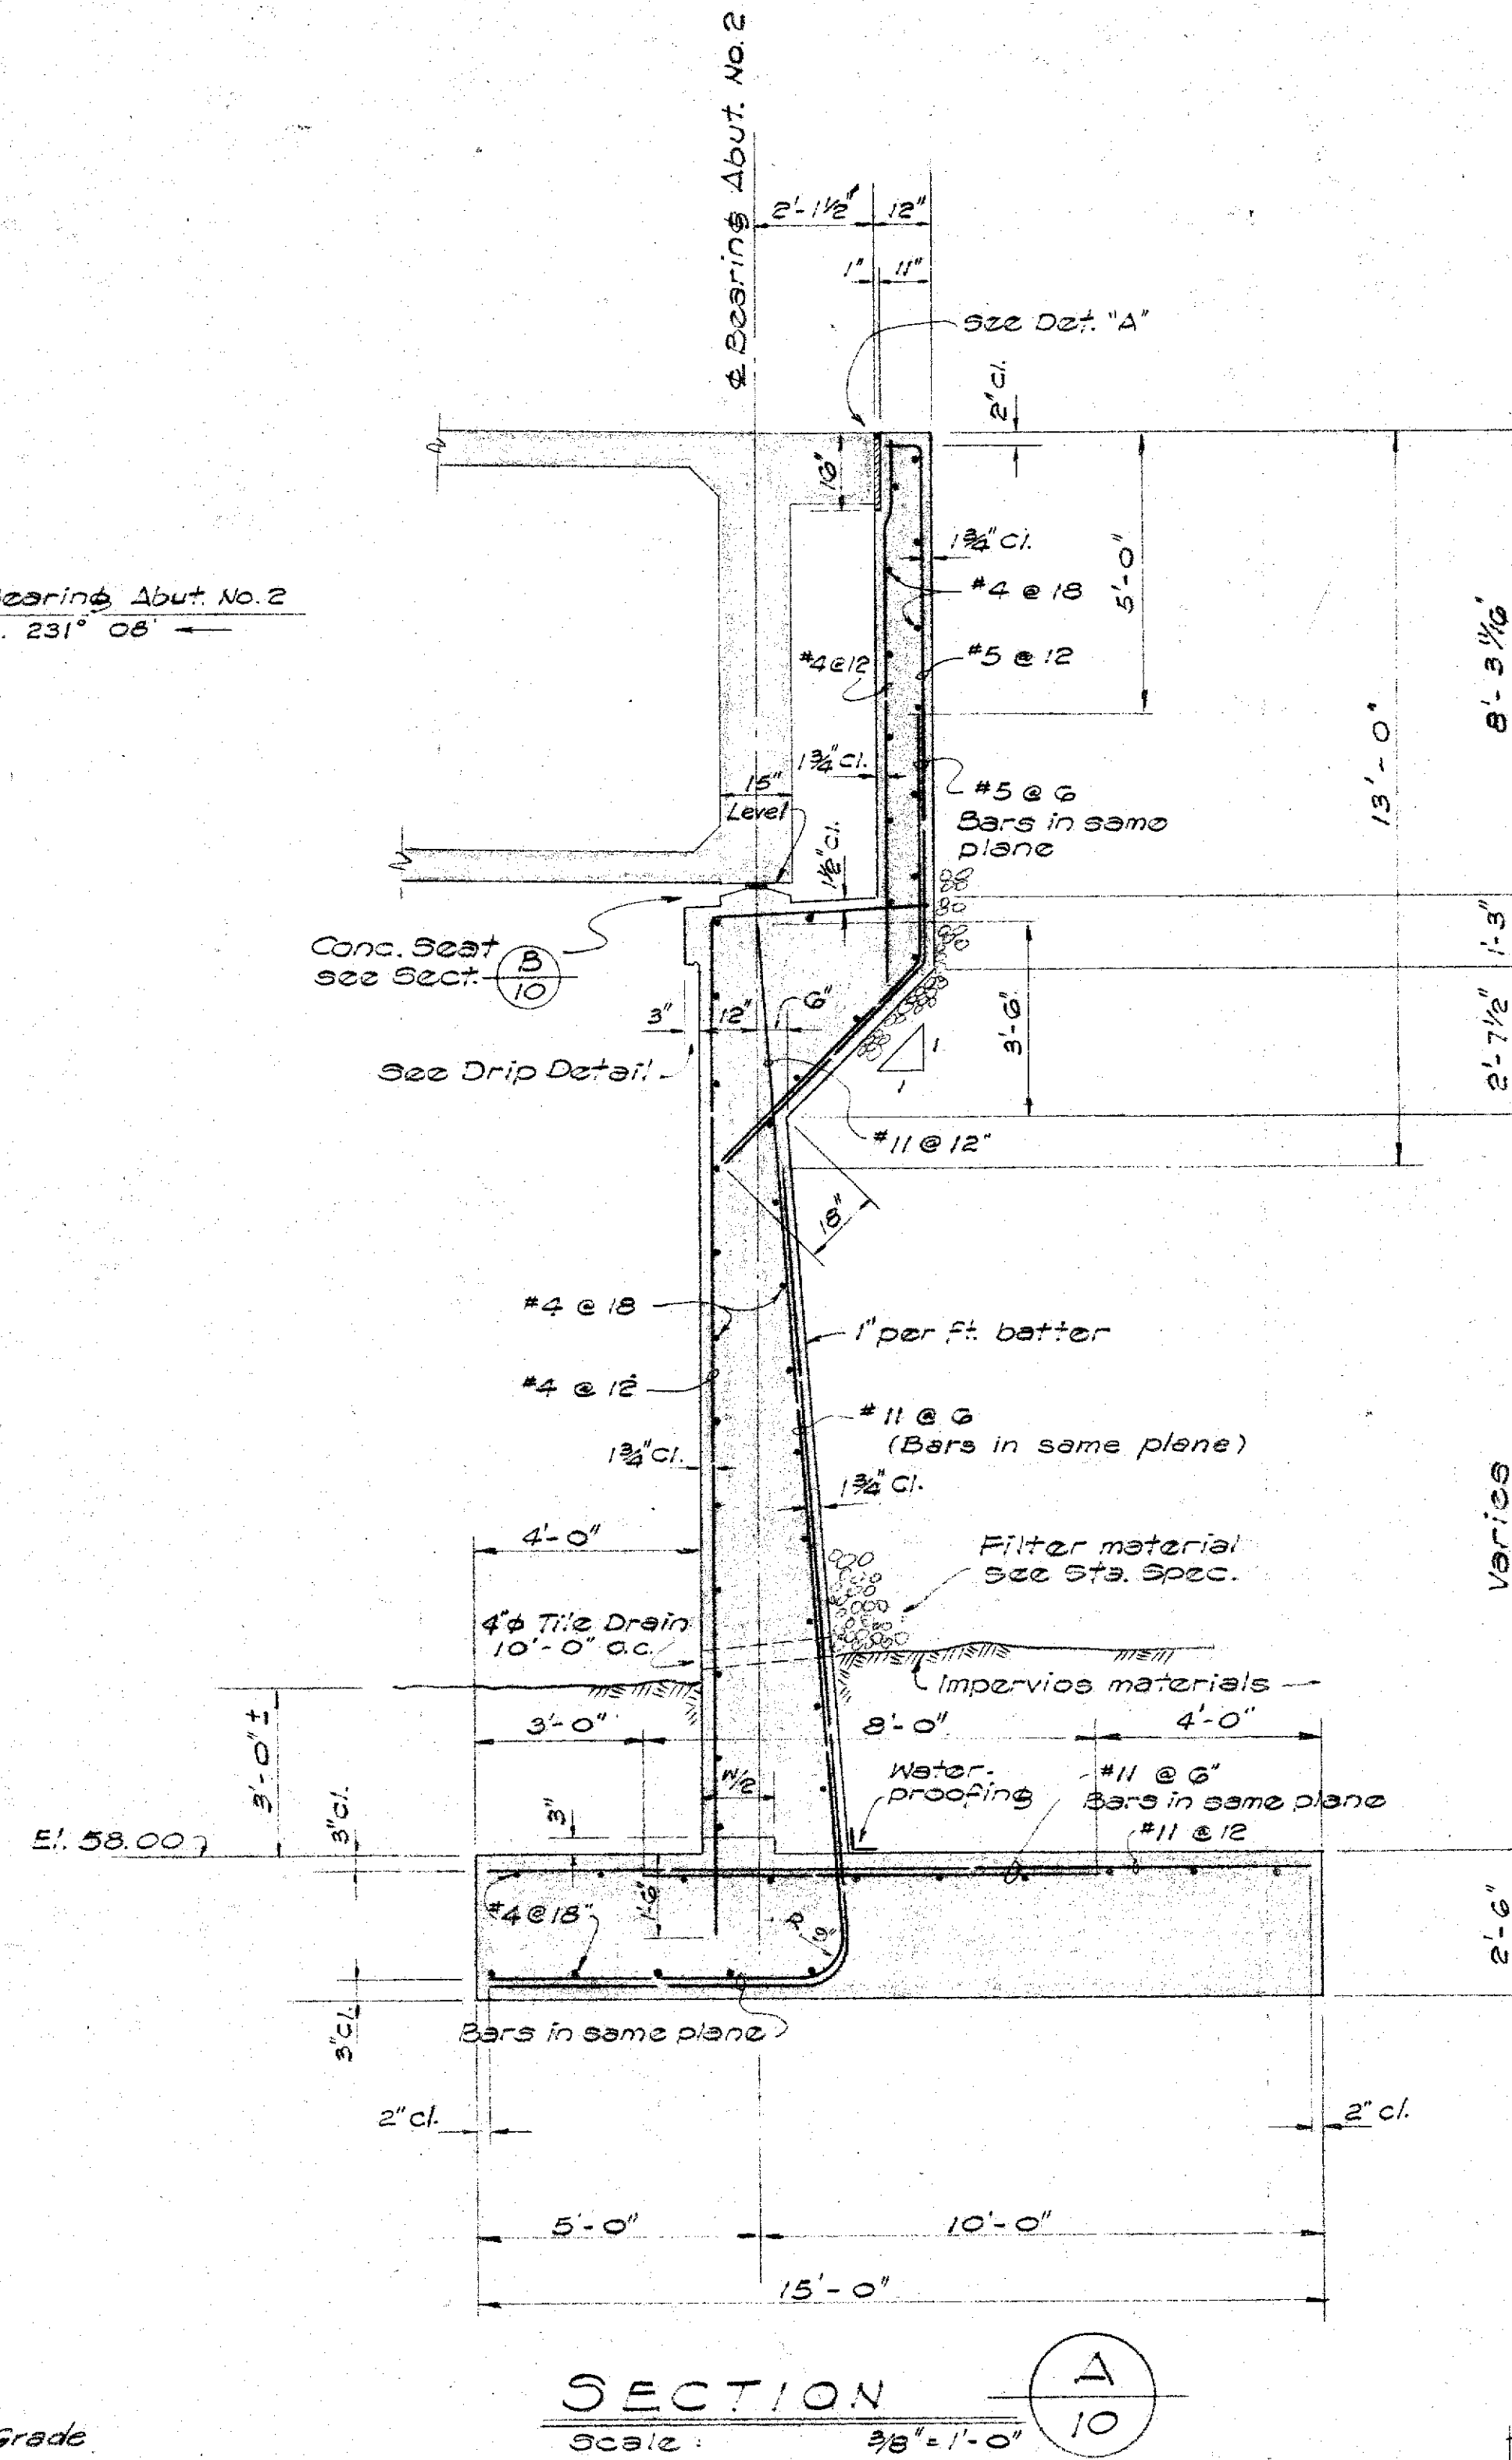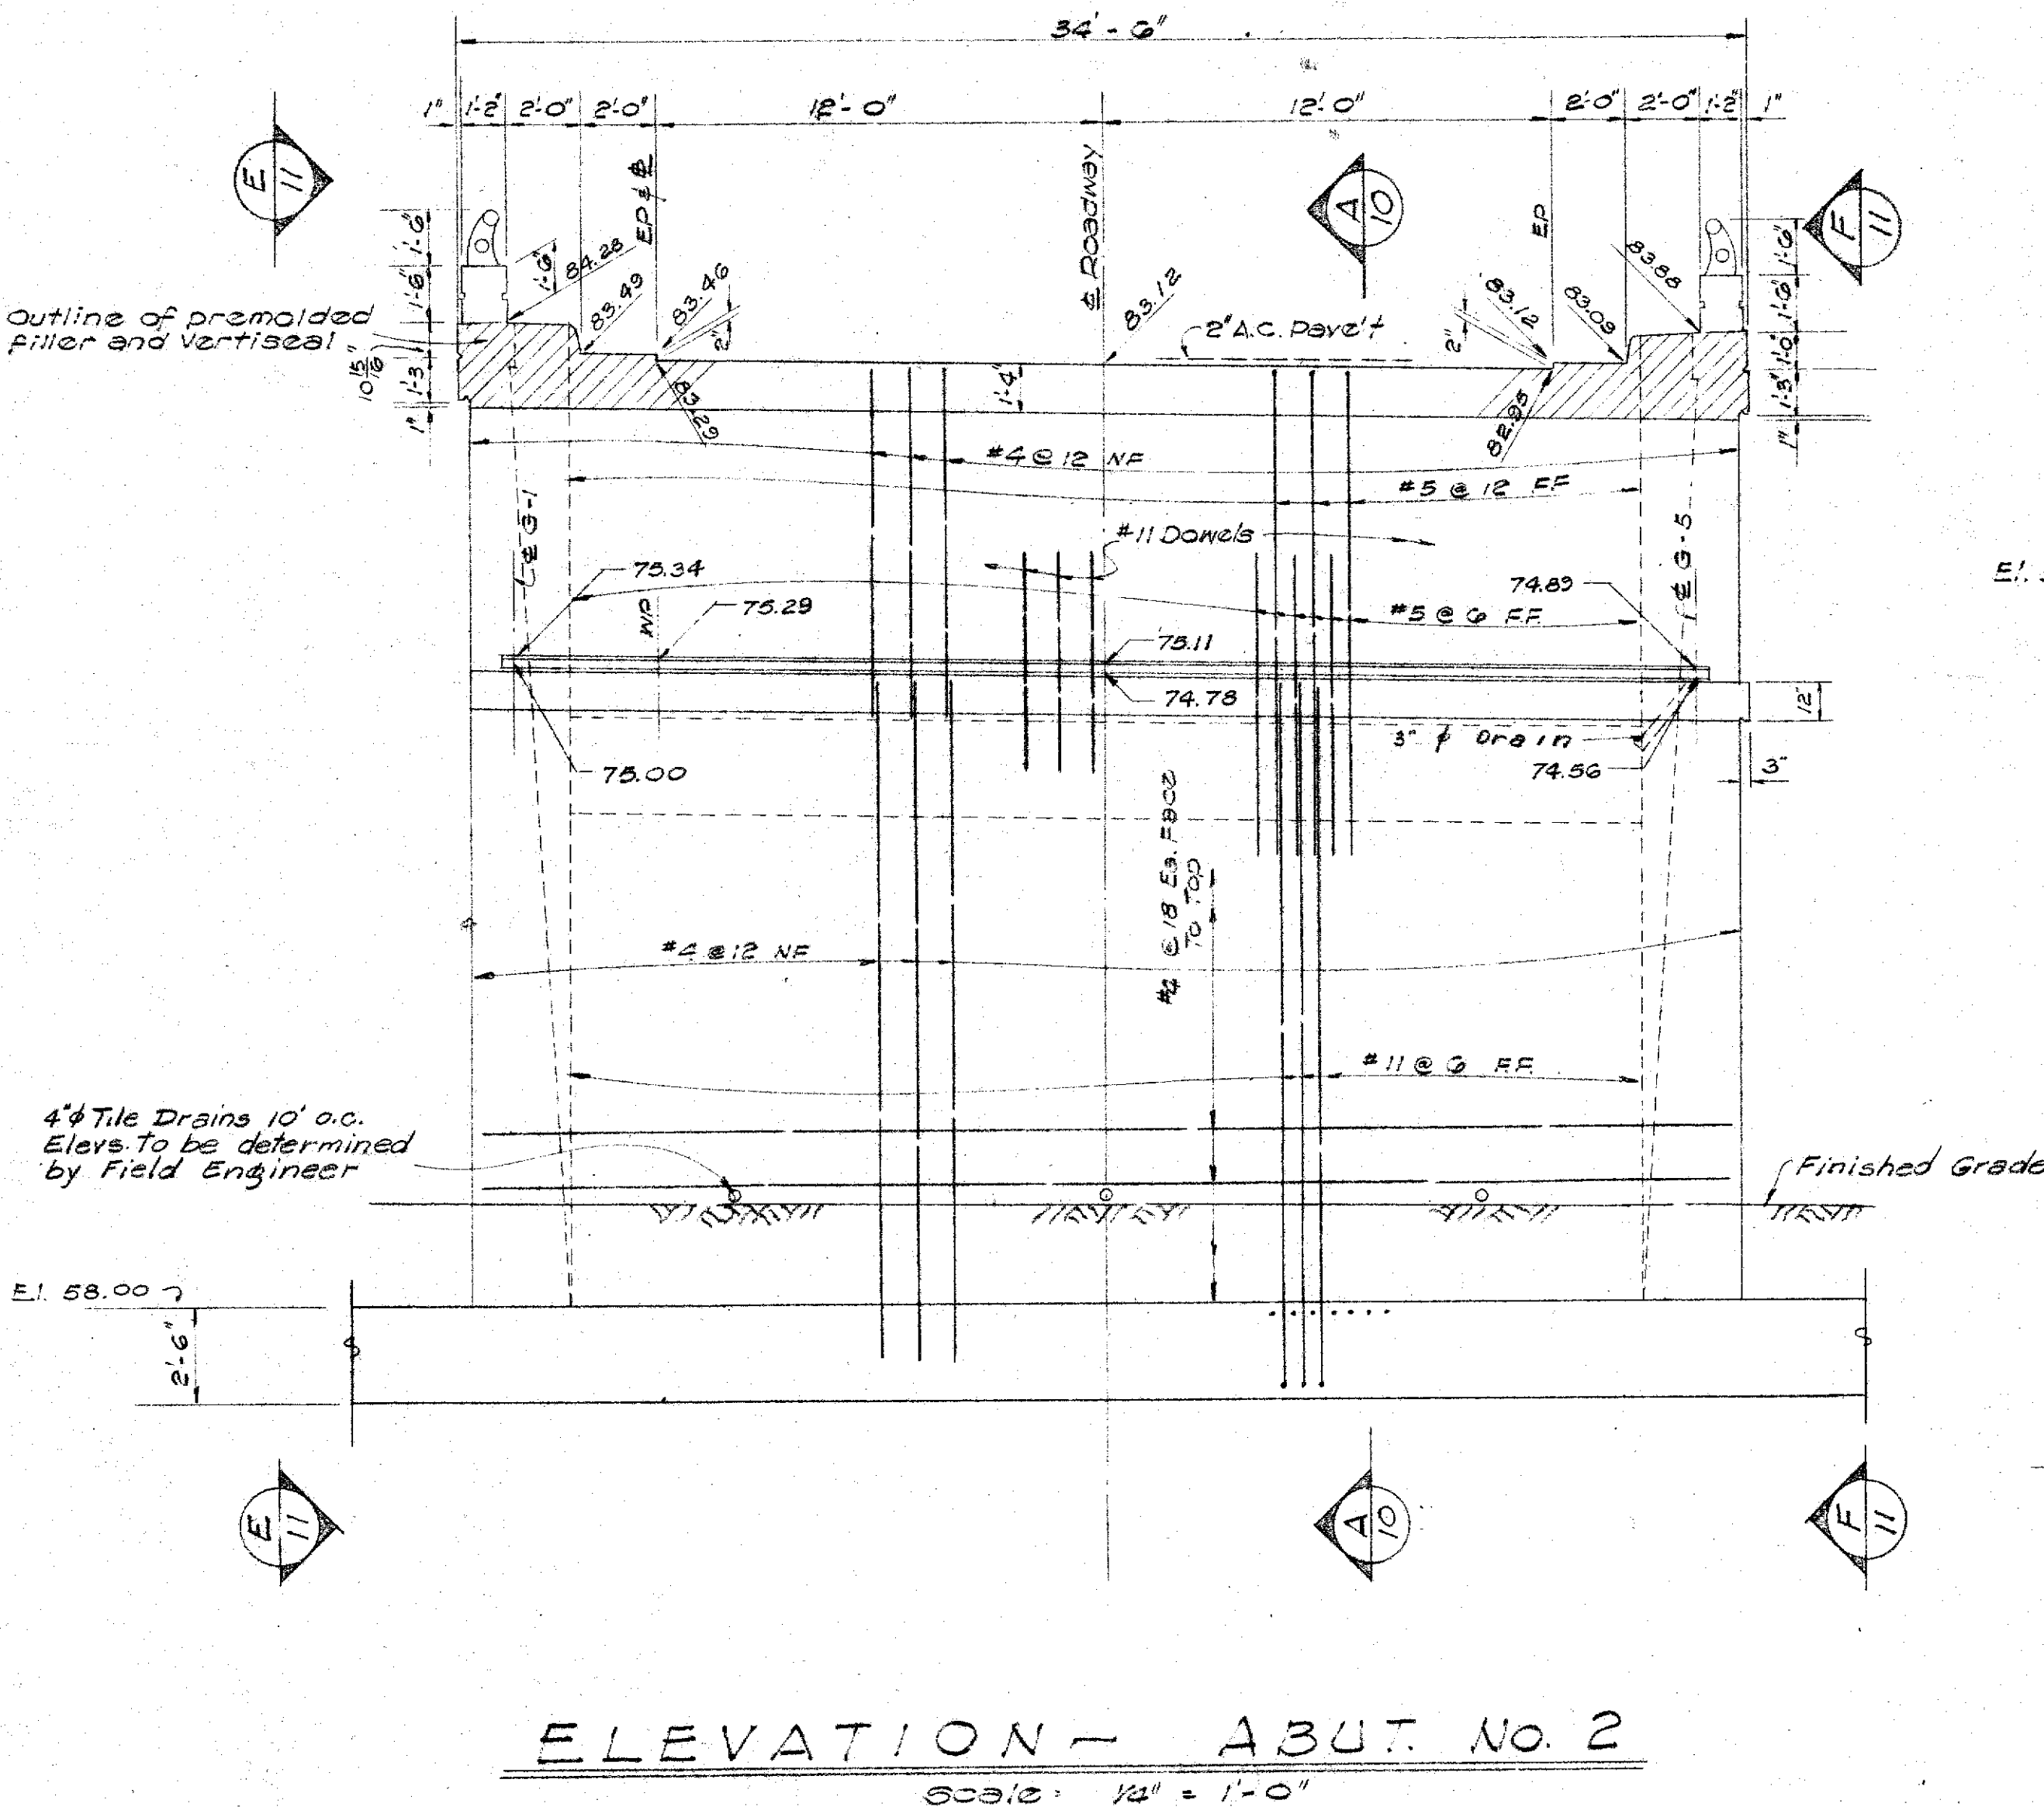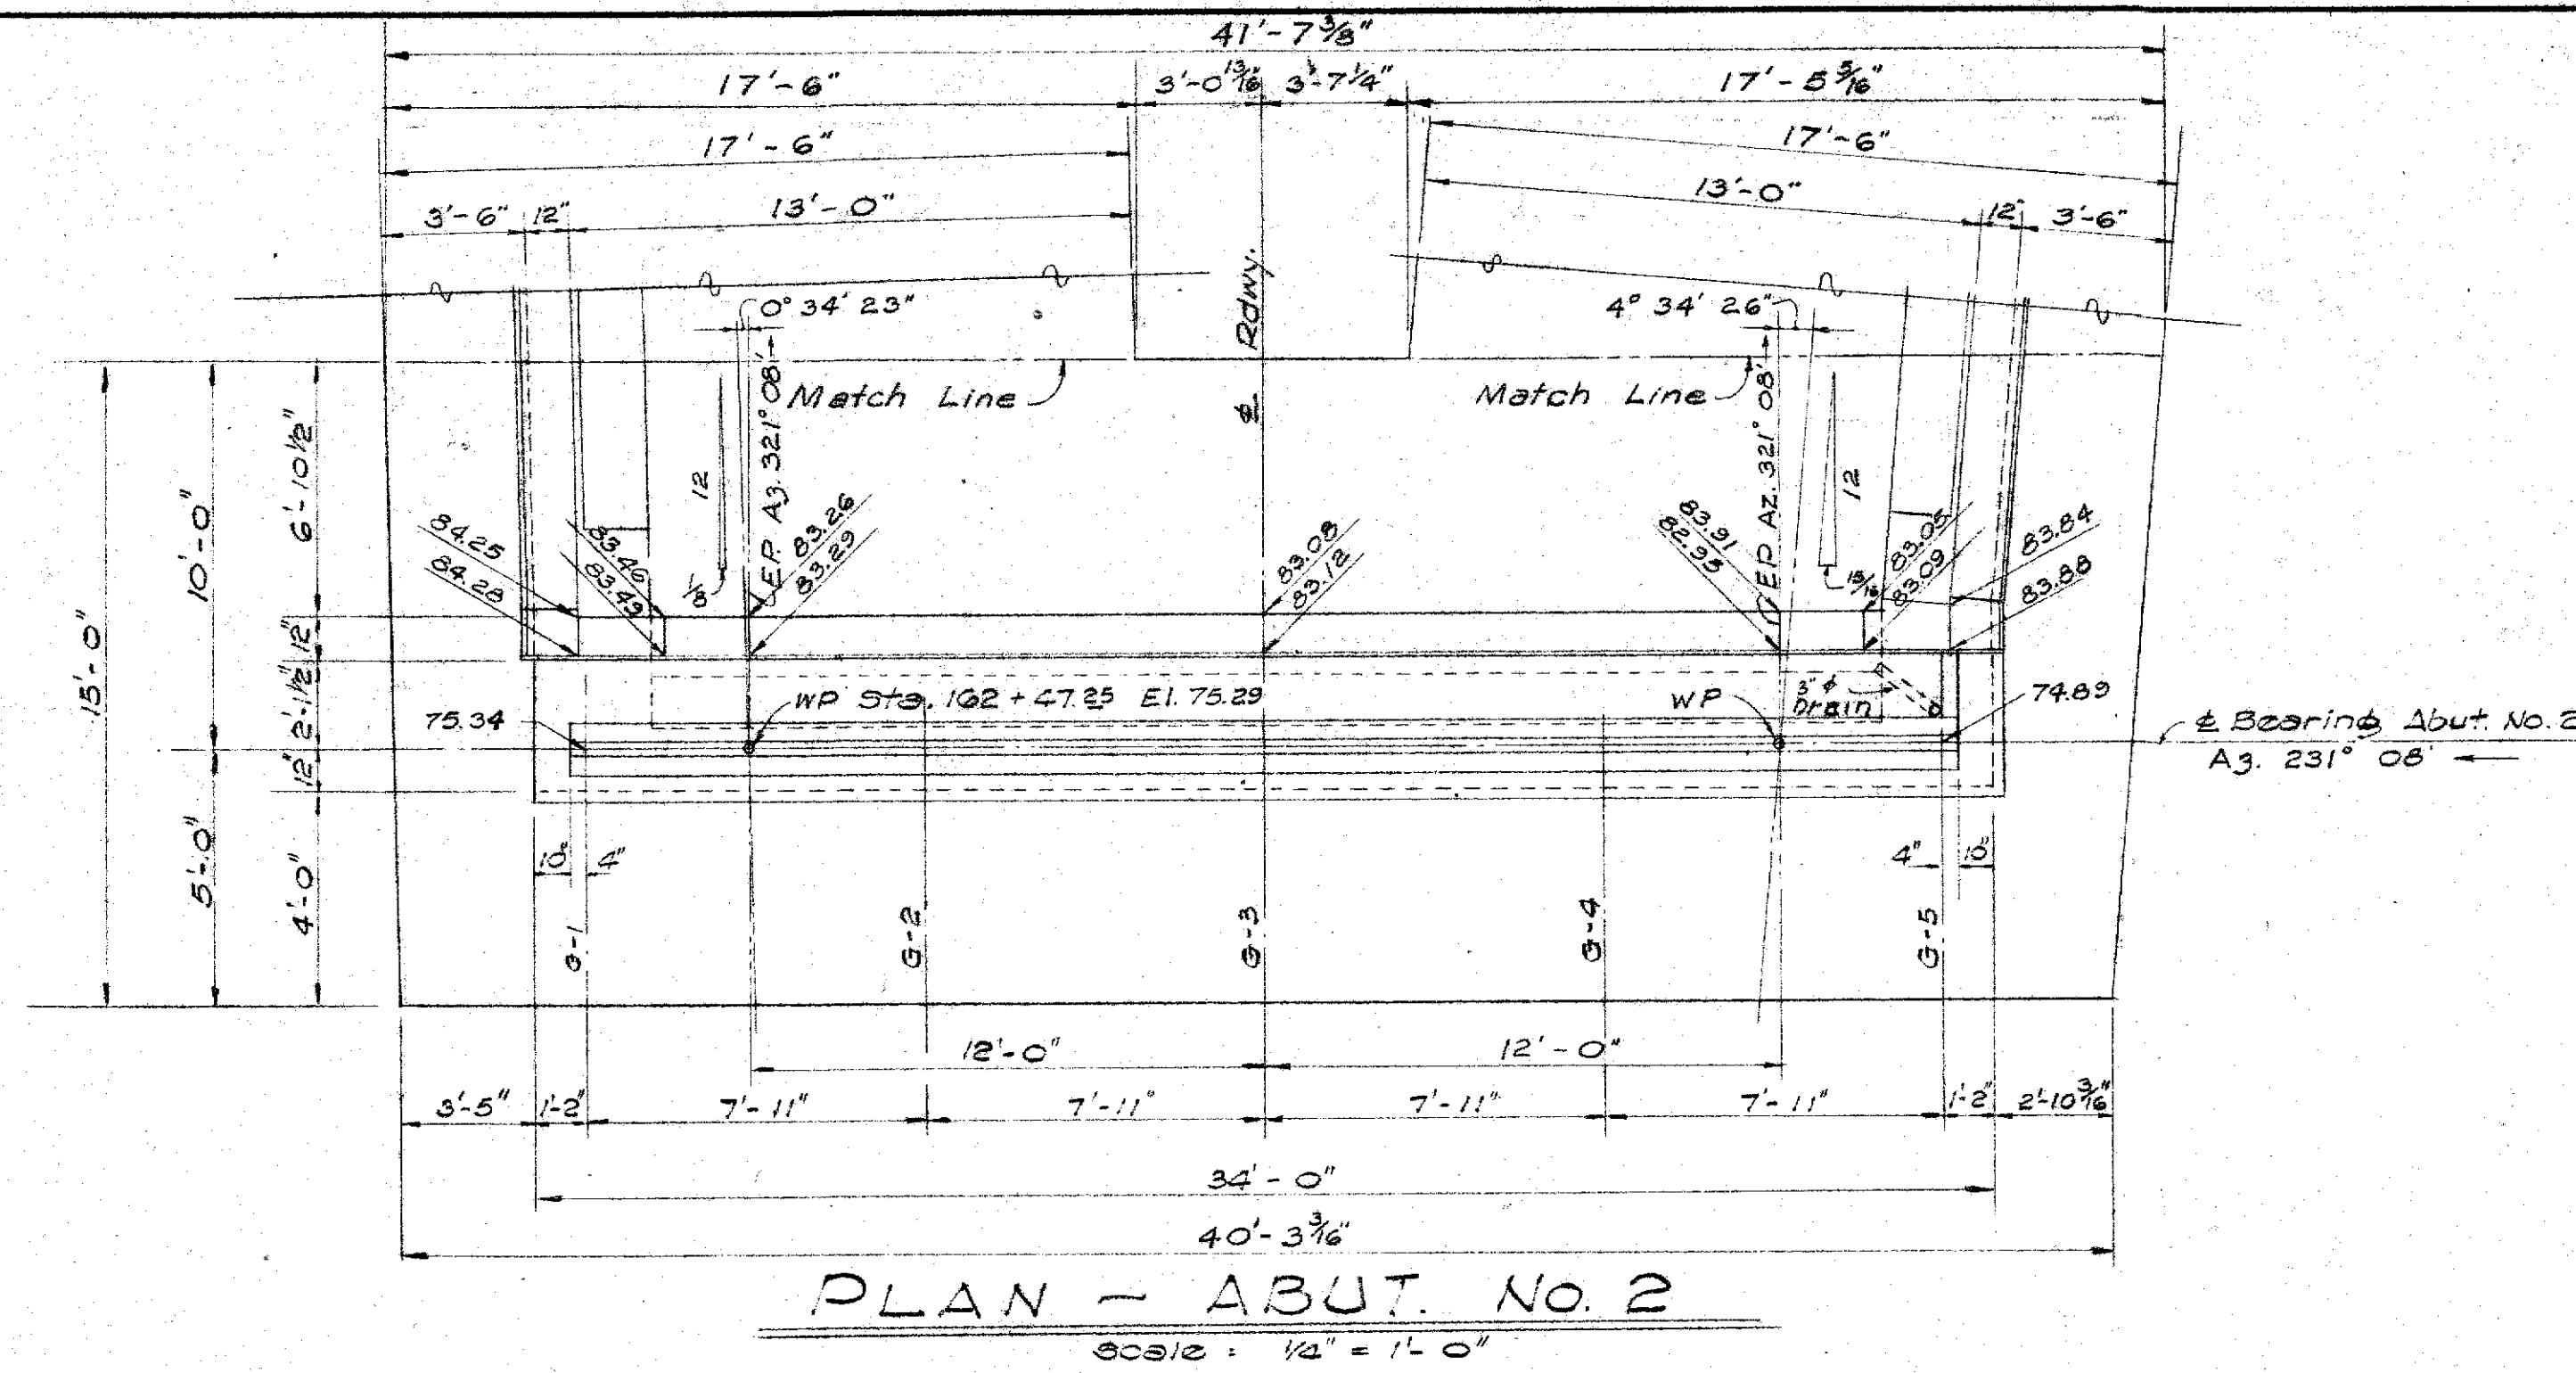

STATE OF HAWAII
DEPARTMENT OF TRANSPORTATION
HIGHWAYS DIVISION
BRIDGE No. 2
Base Line Sta. 100+23.12 To Sta. 102+50.38
VINEYARD BOULEVARD
PROJECT NO. F-098-1-(3)

ALFRED A. YEE
REGISTERED PROFESSIONAL ENGINEER
No. 718
HAWAII, U.S.A.


SATOSHI DON SHIMIZU
REGISTERED PROFESSIONAL ENGINEER
No. 710
HAWAII, U.S.A.

SHEET No. 10 OF 16 SHEETS


5928.89

CONSULTANT SUBMISSION


FED. ROAD DIST. NO.	STATE	FED. AID PROJ. NO.	FISCAL YEAR	SHEET NO.	TOTAL SHEETS
				11	16

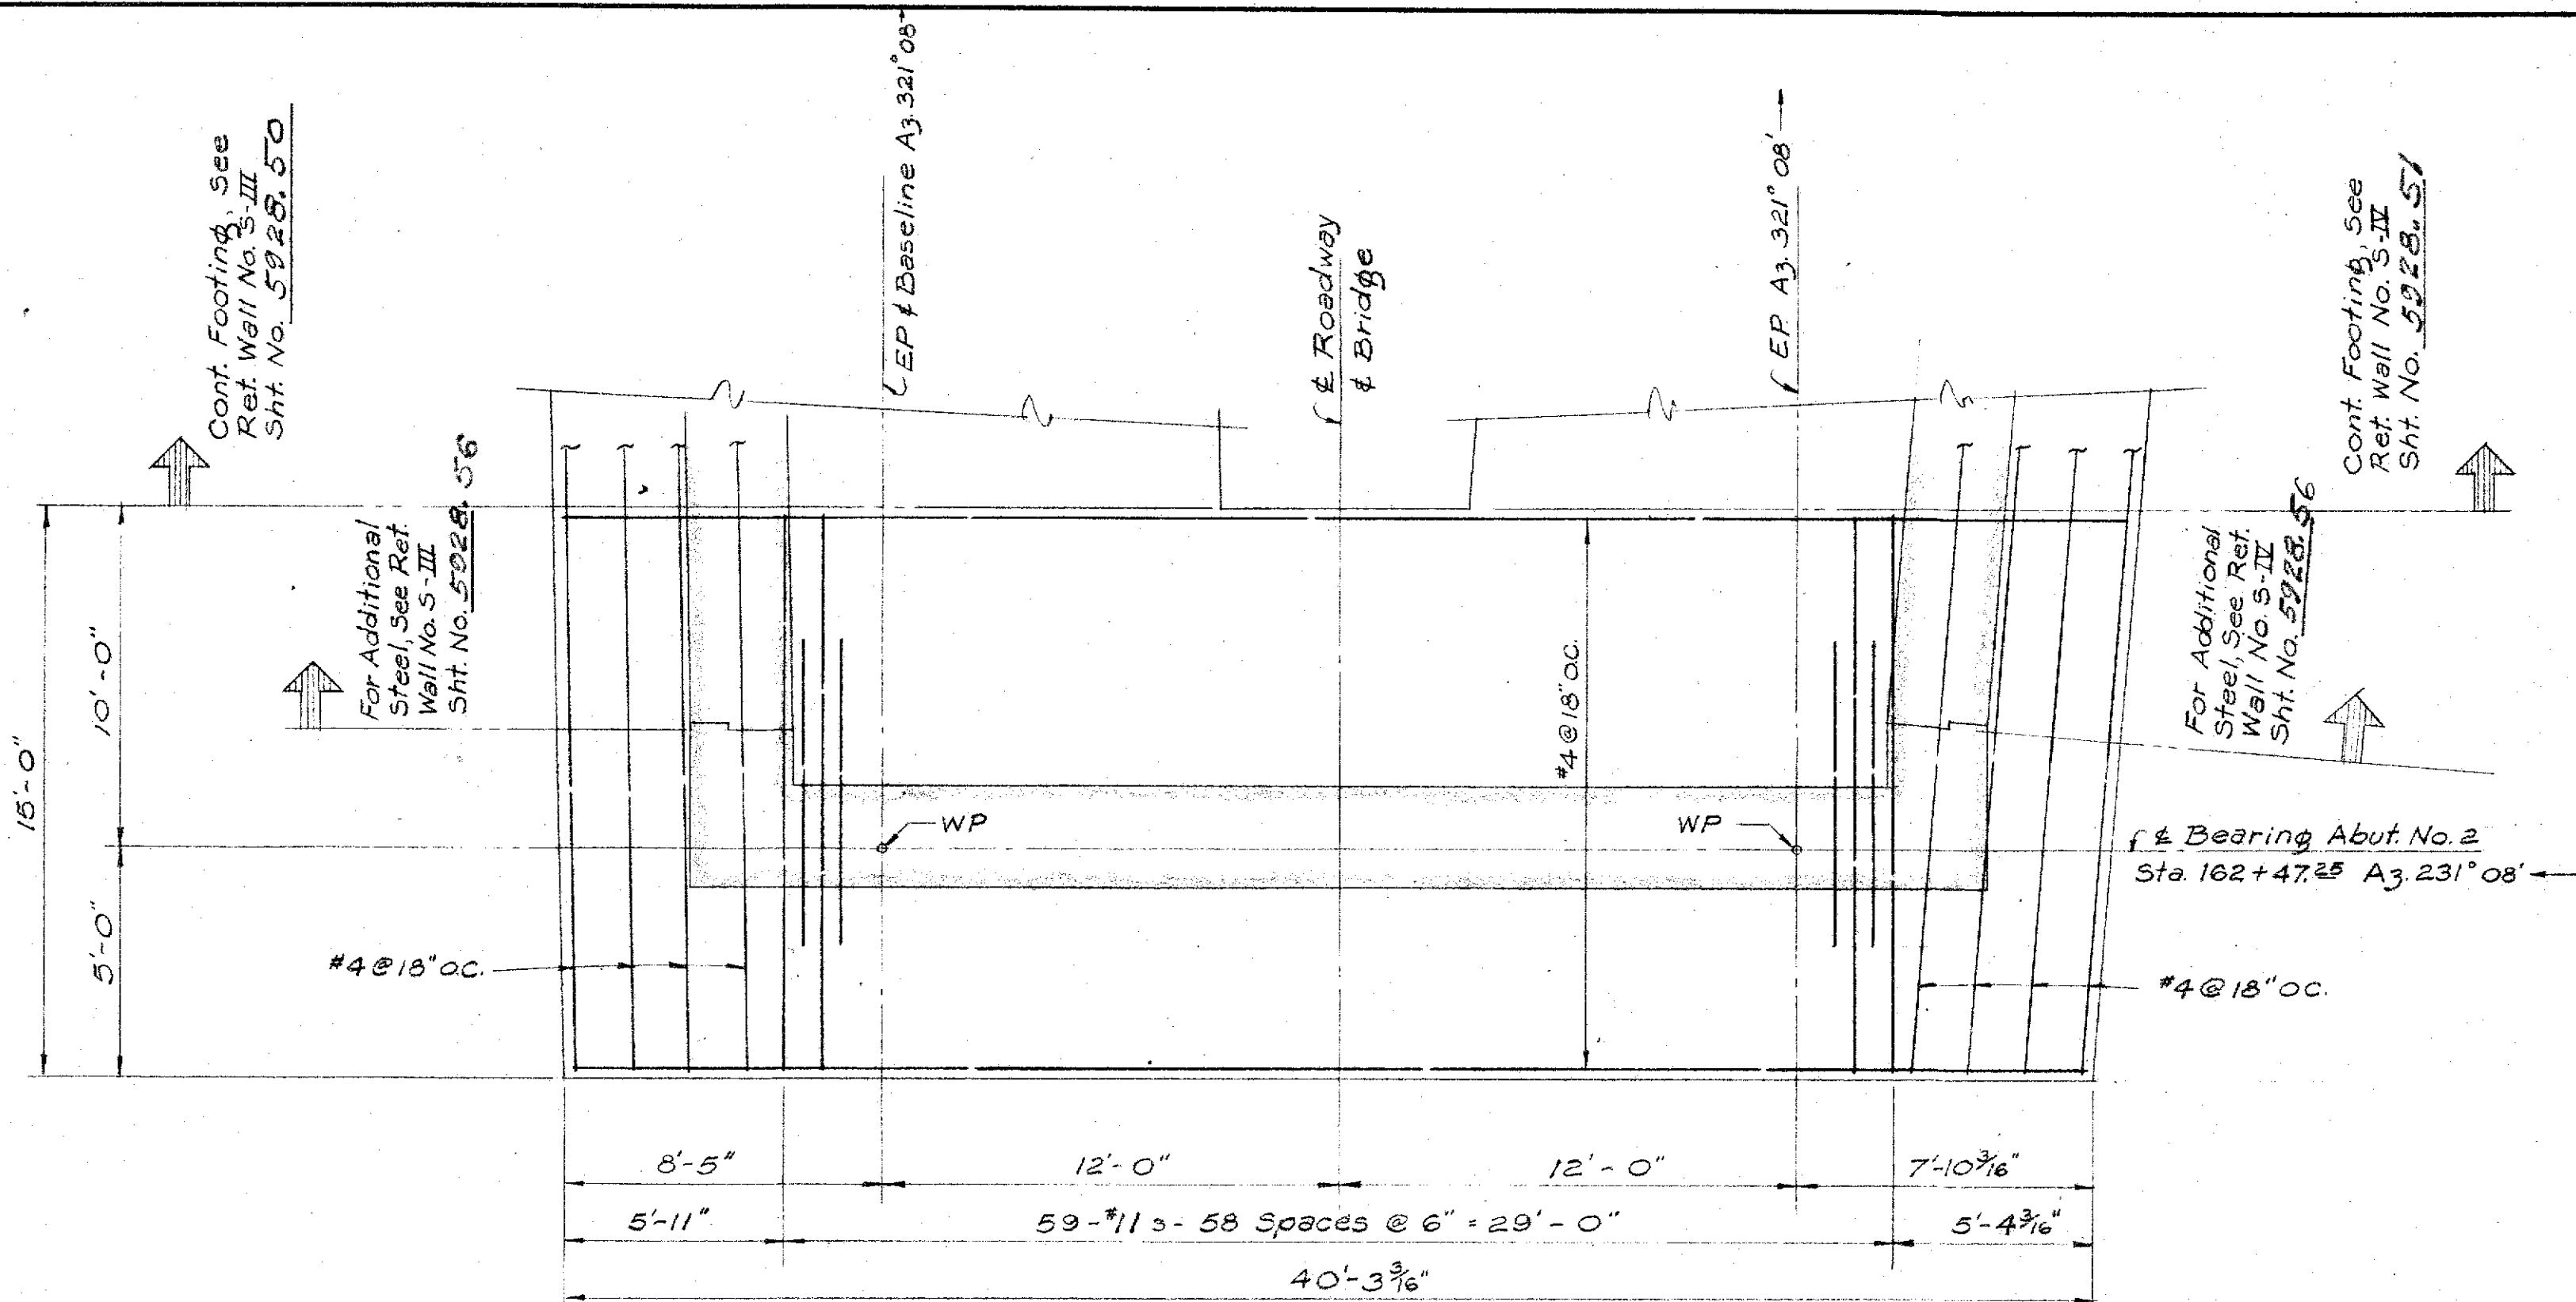

TOP STEEL FOOTING PLAN ABUT. NO. 2
Scale: 1/4" = 1'-0"

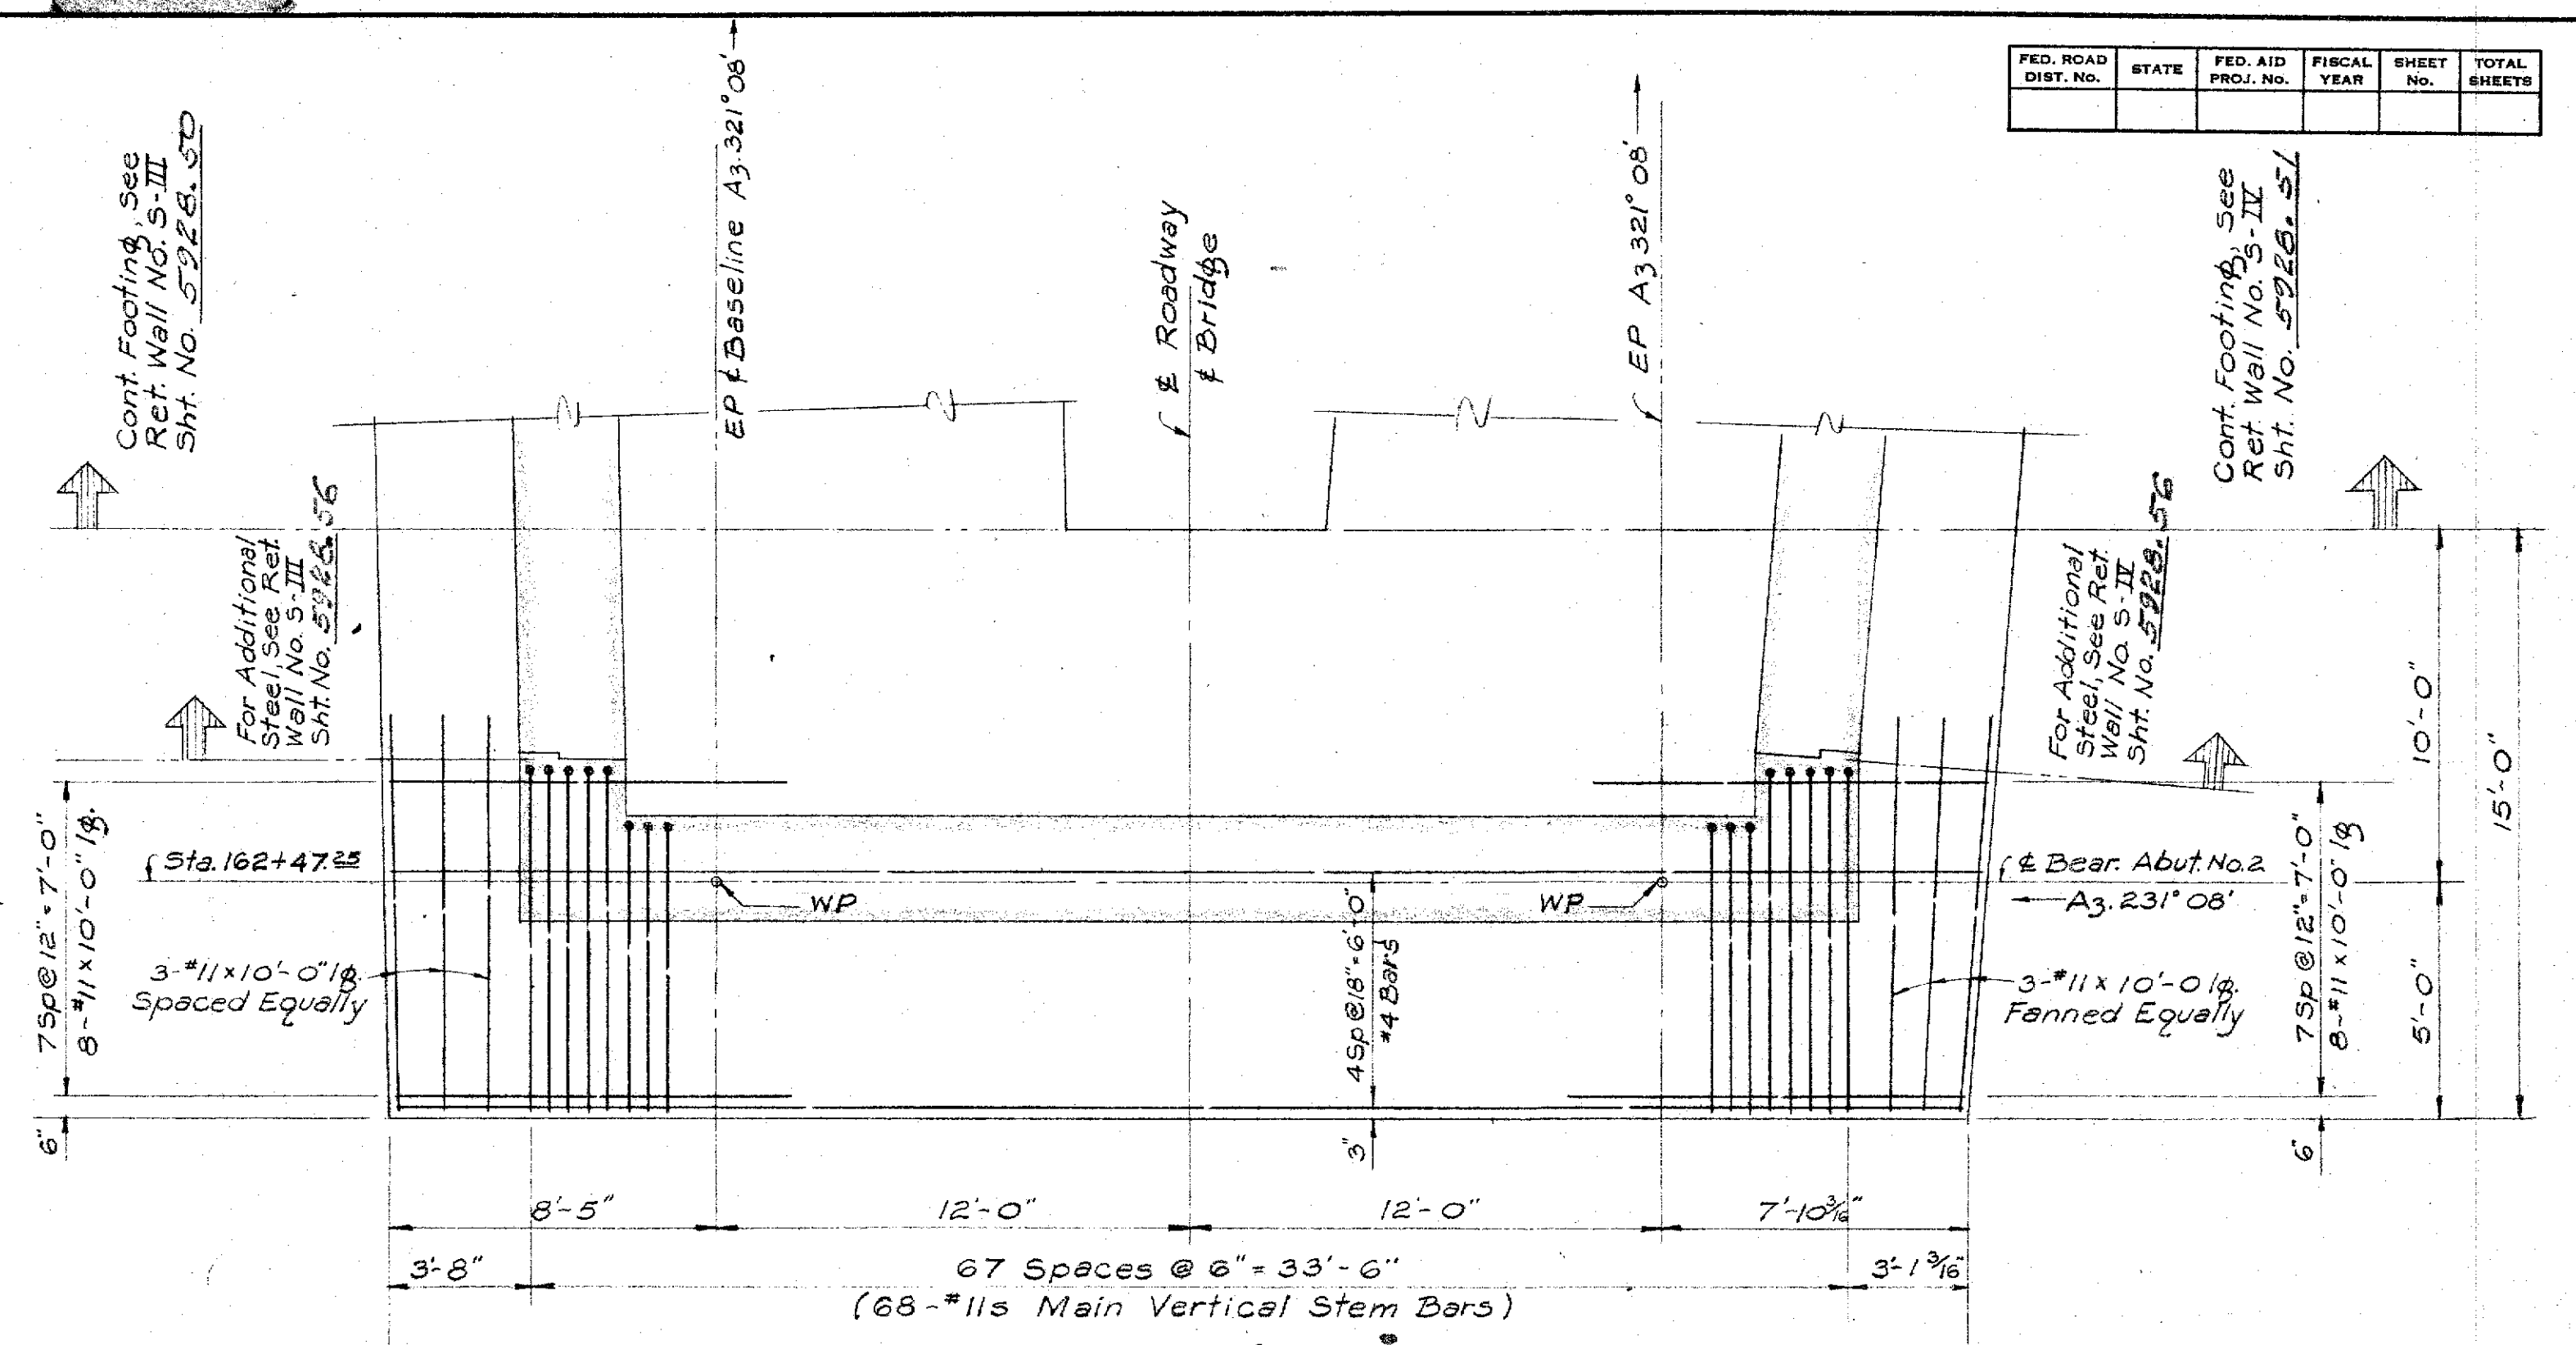


BOTTOM STEEL FOOTING PLAN ABUT. NO. 2
Scale: 1/4" = 1'-0"

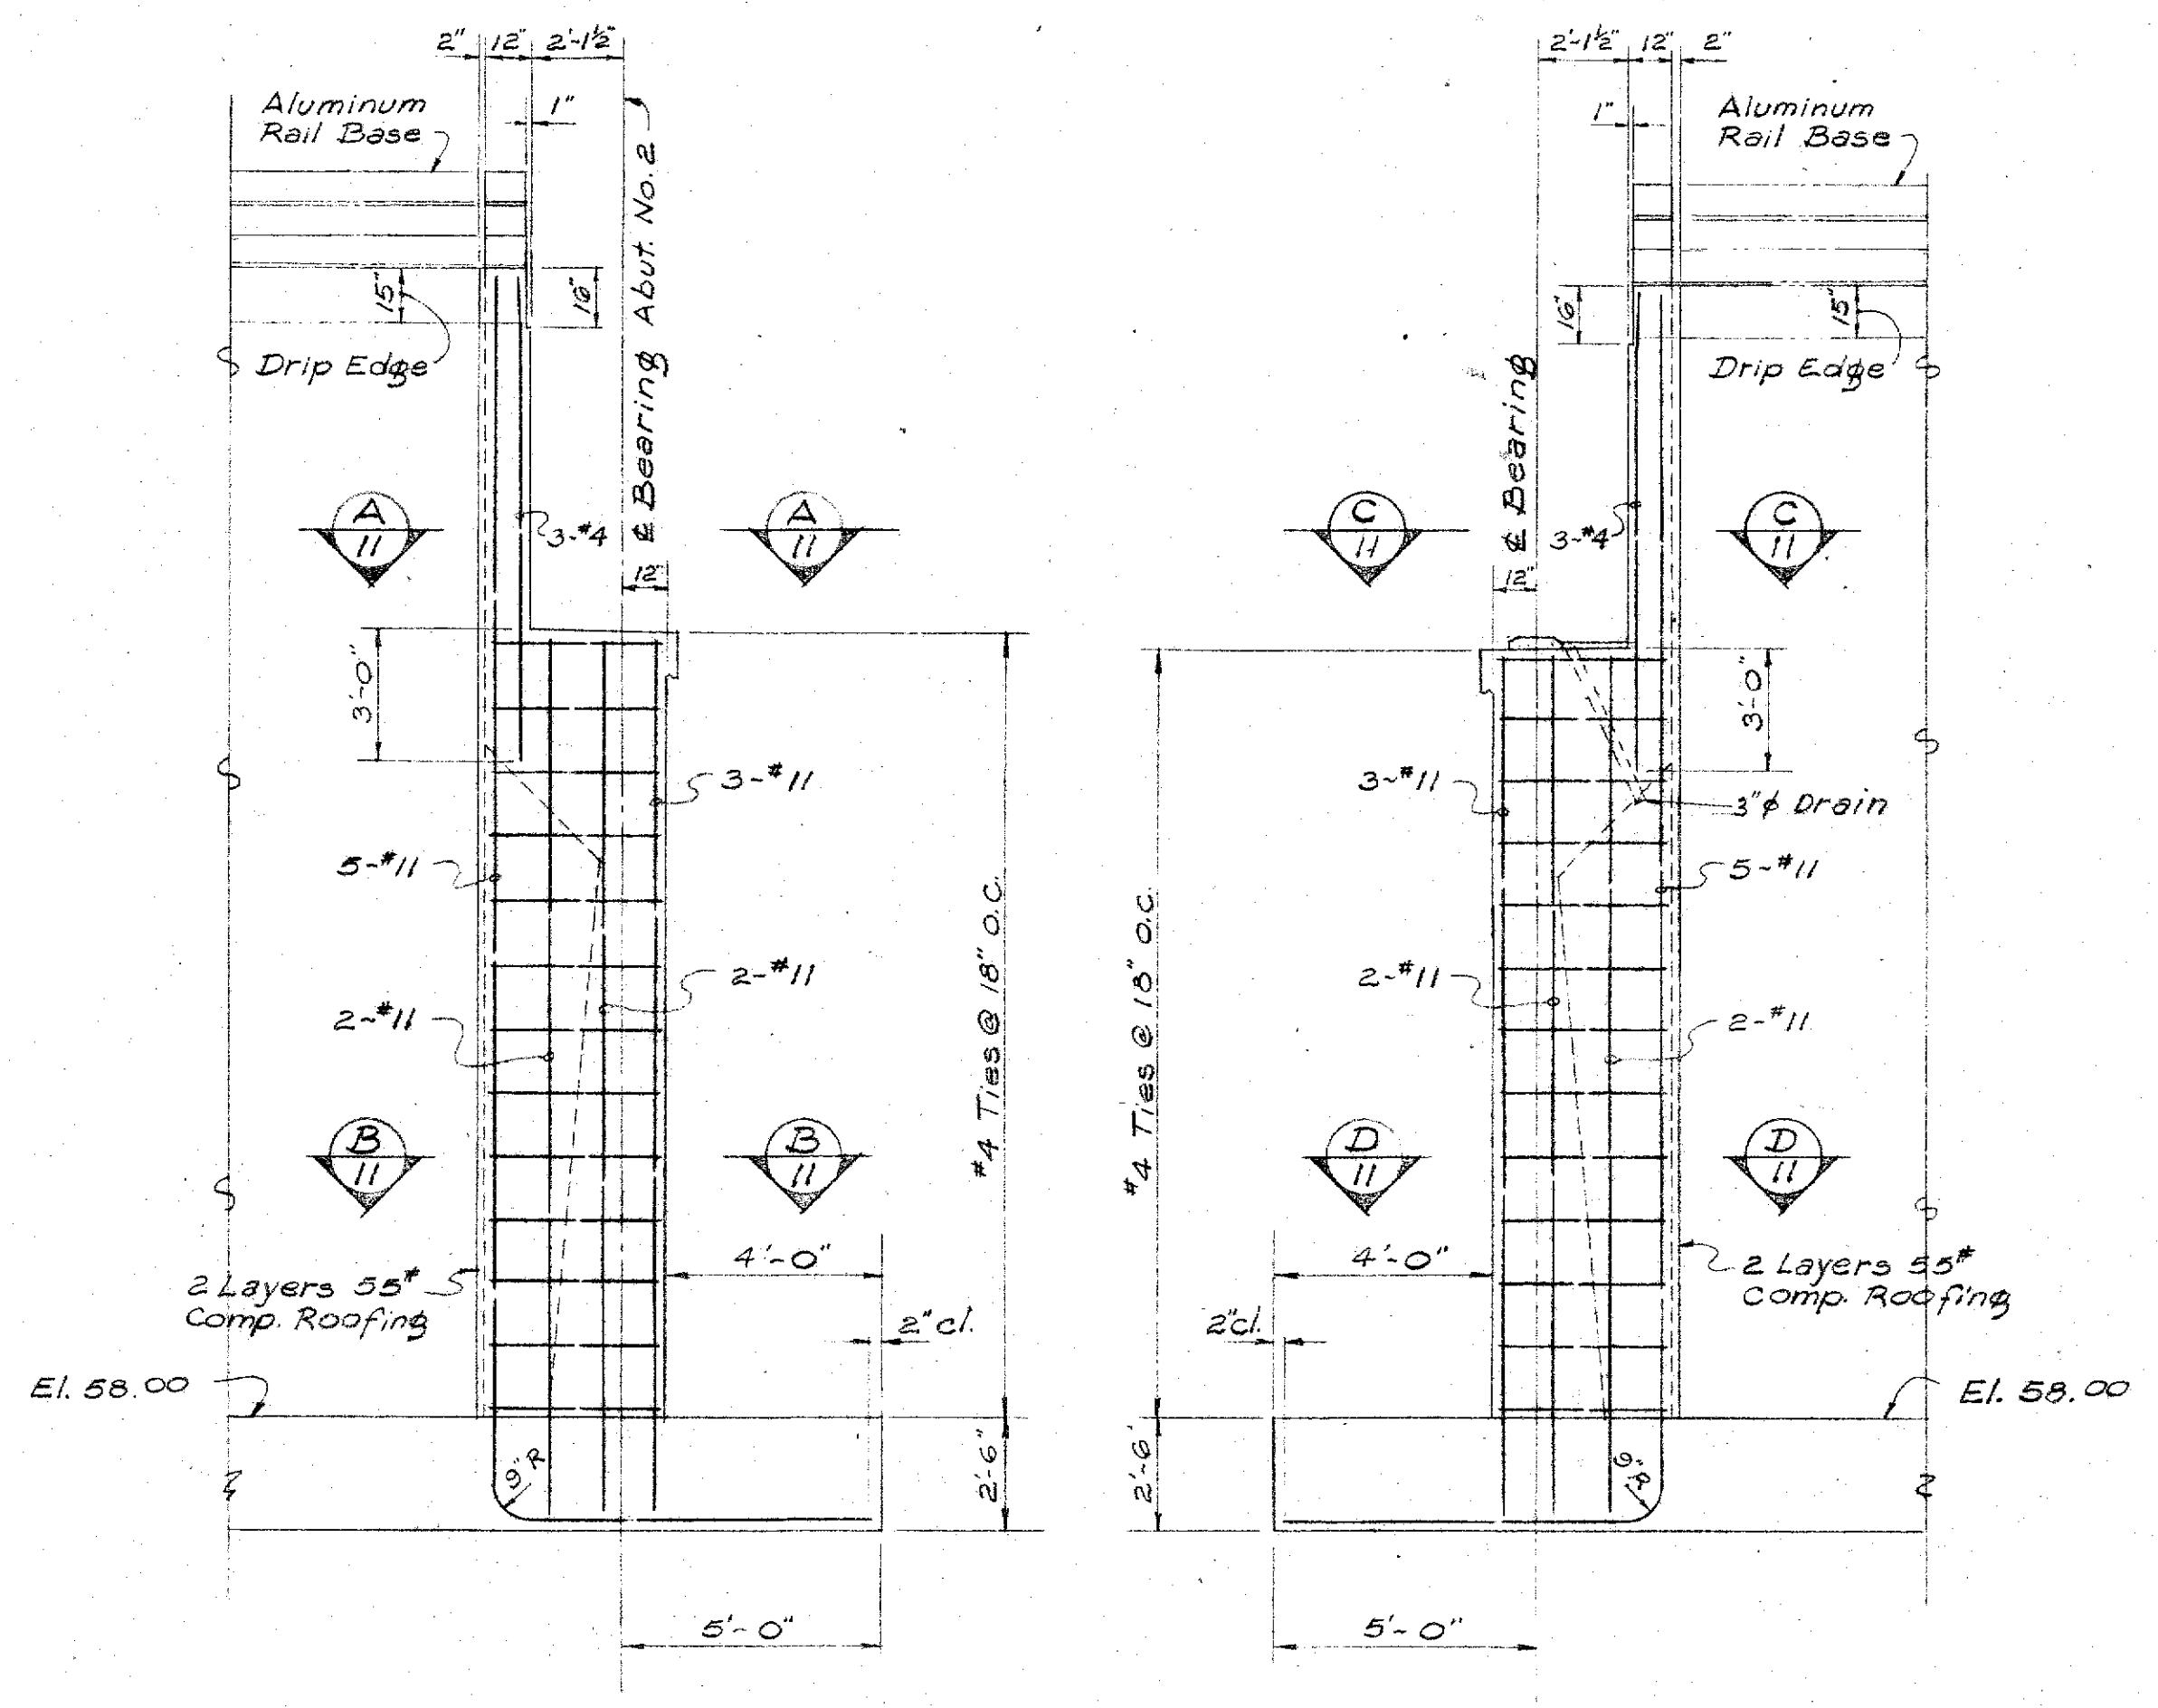


ELEVATION E
Scale: 1/4" = 1'-0"
See Sht. No. 10


ELEVATION F
Scale: 1/4" = 1'-0"
See Sht. No. 10

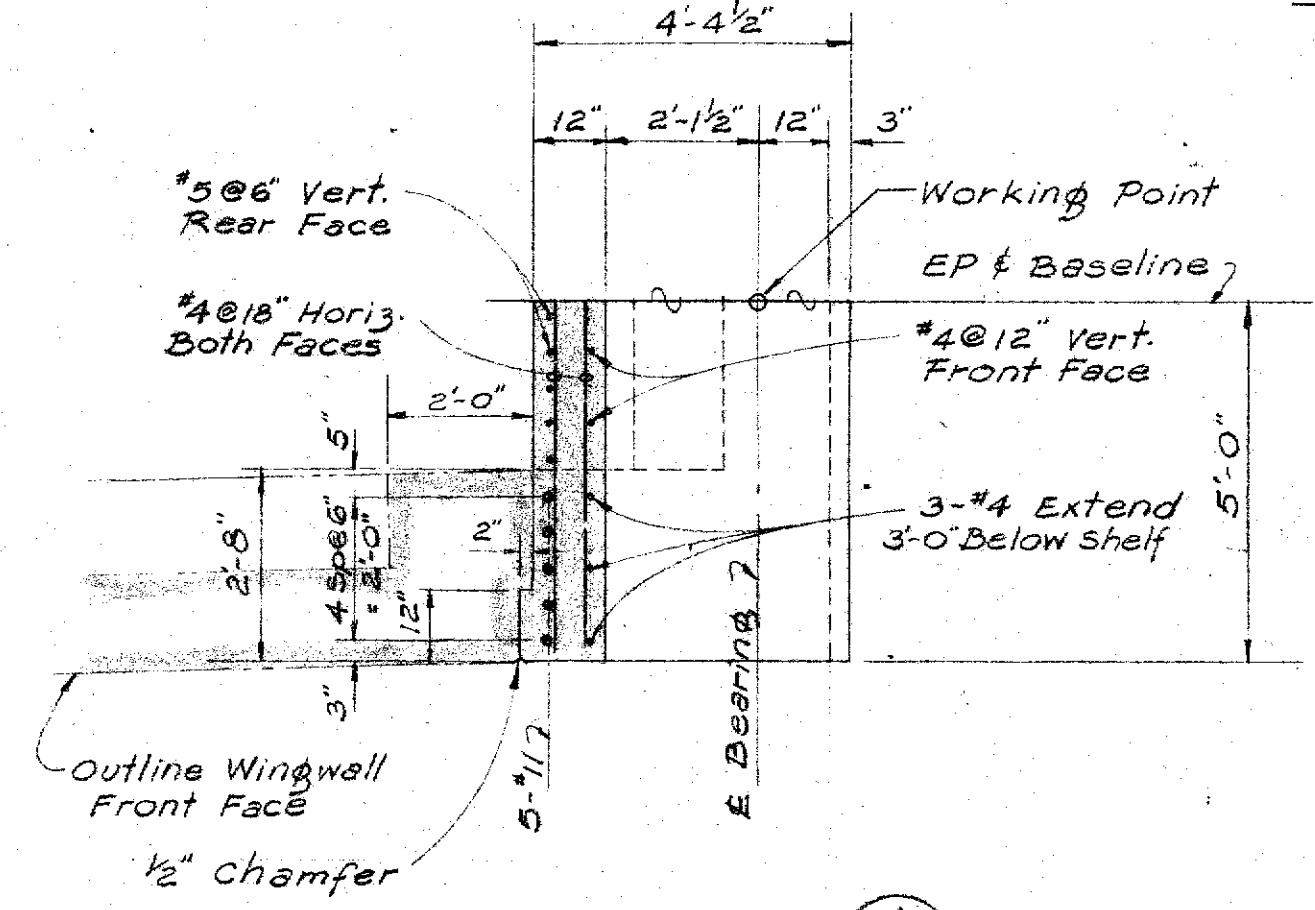


SECTION A
Scale: 3/8" = 1'-0"

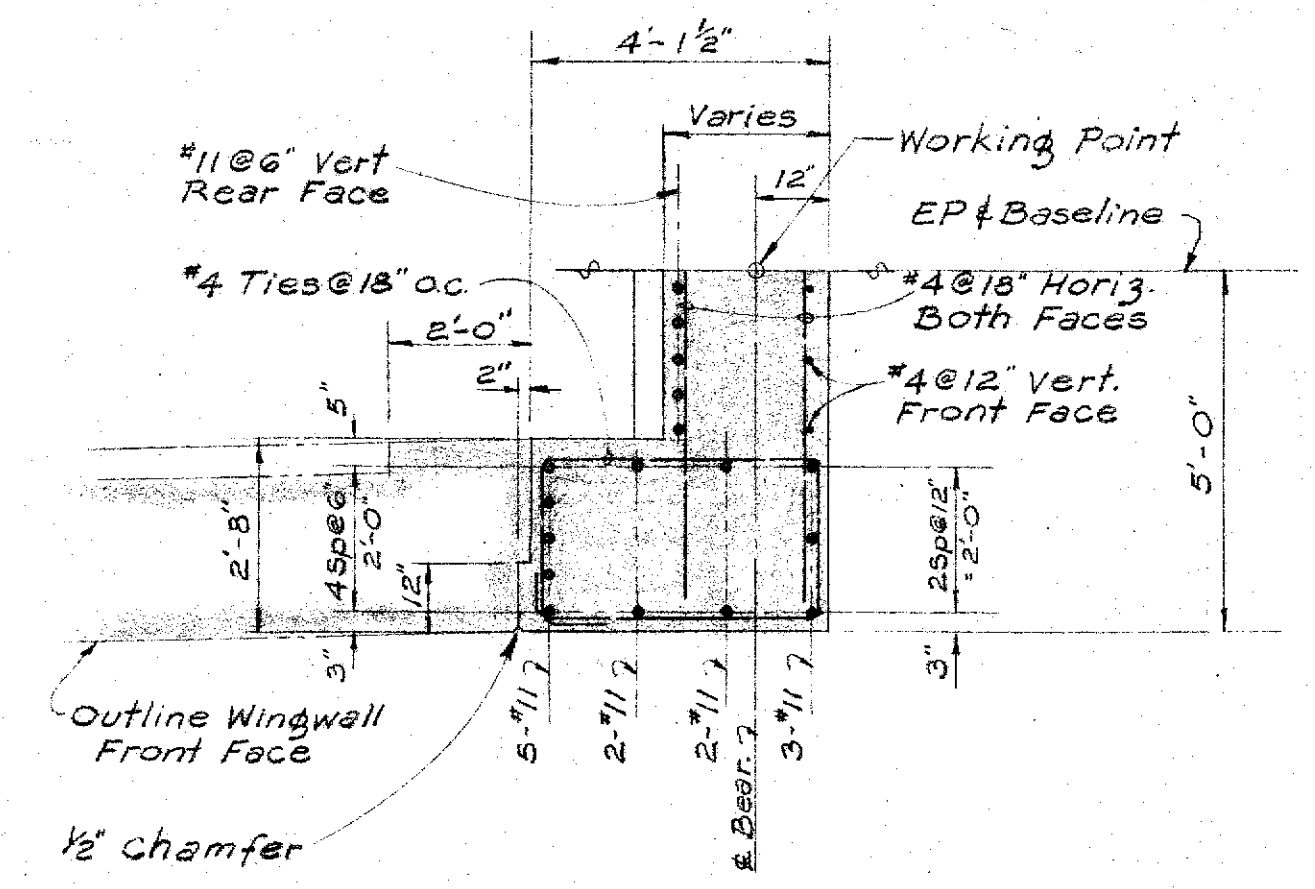

SECTION B
Scale: 3/8" = 1'-0"

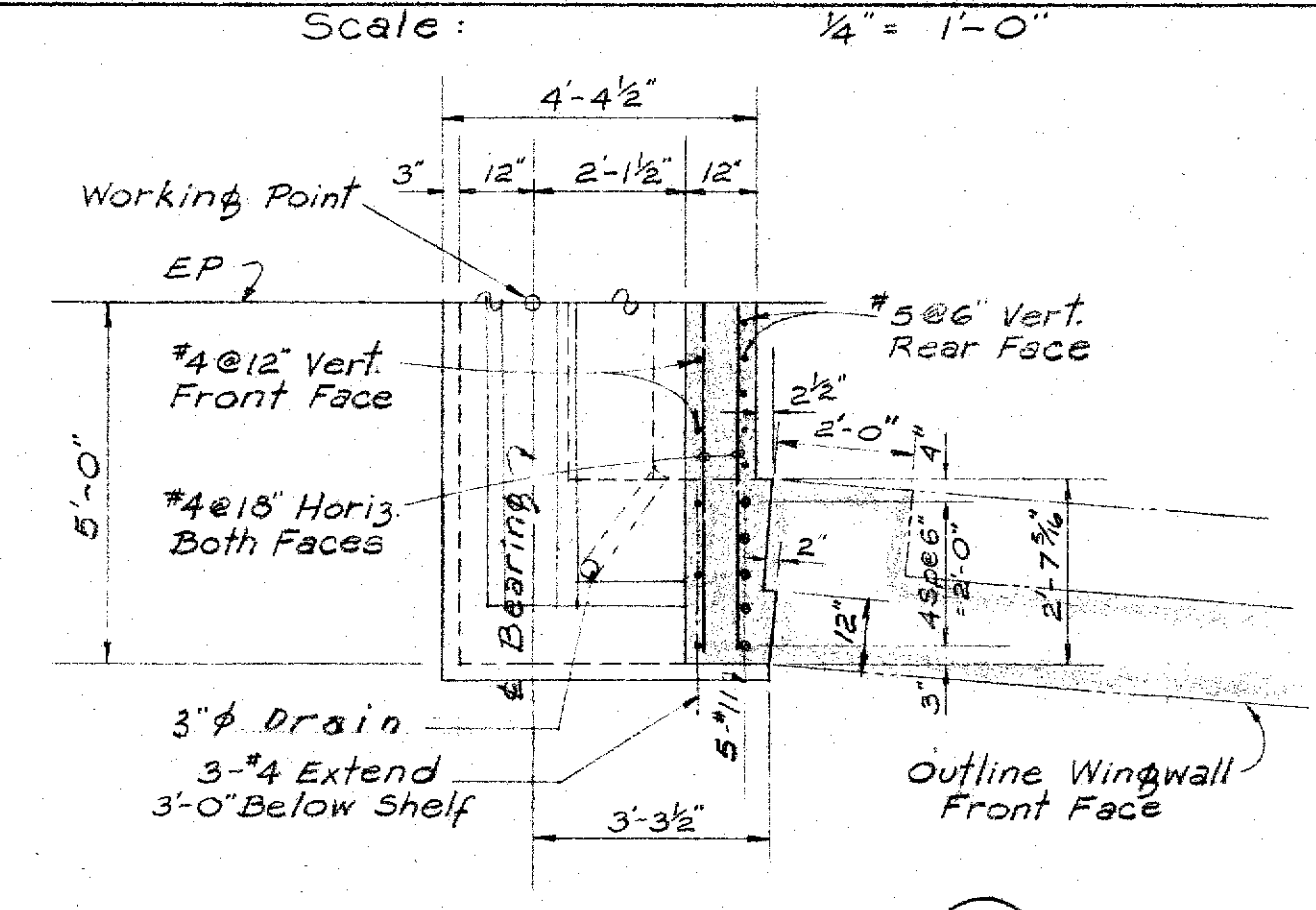


SECTION C
Scale: 3/8" = 1'-0"

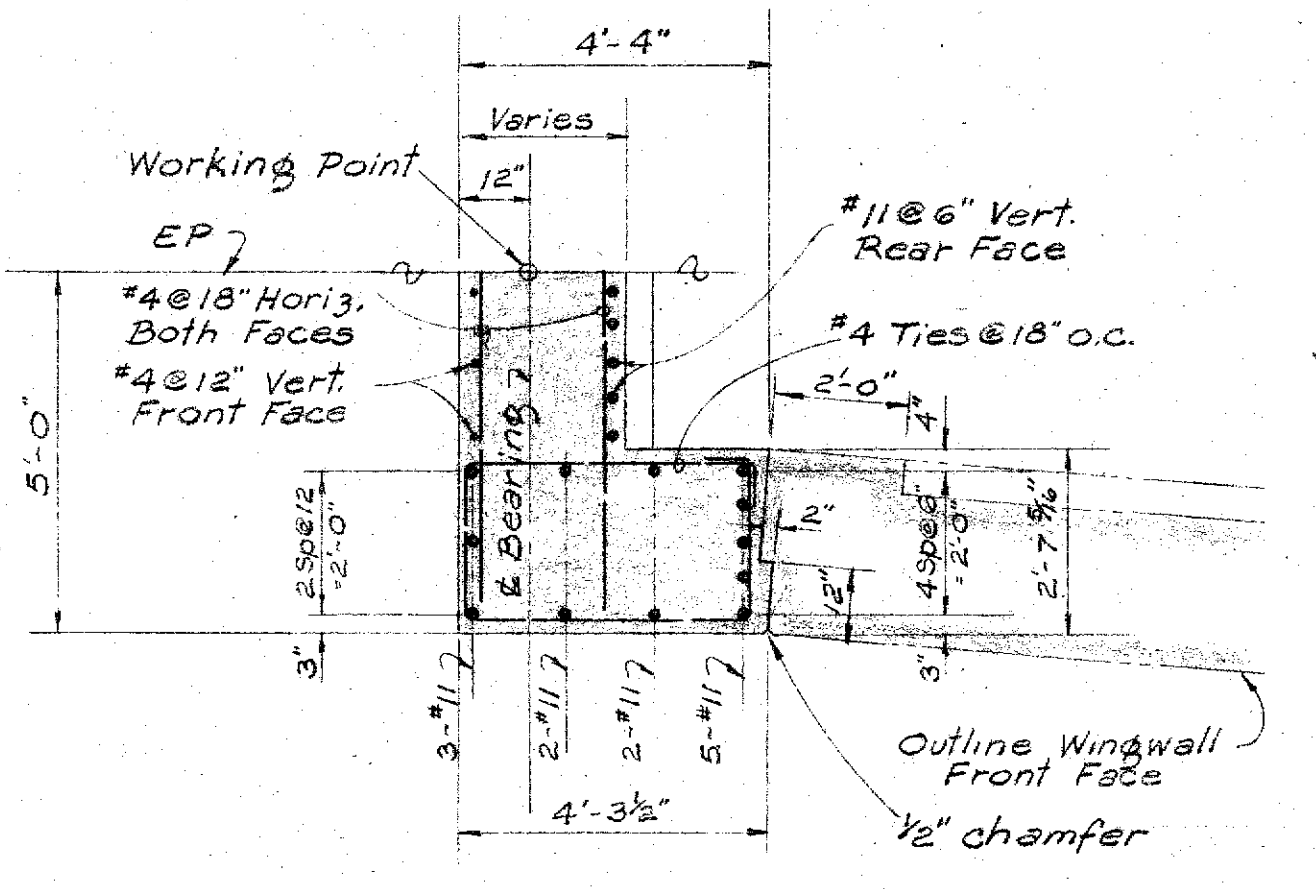





SECTION D
Scale: 3/8" = 1'-0"

DATE	
SURVEY PLOTTED BY	
DESIGNED BY	
DRAWN BY	
QUANTITIES CHECKED BY	
NOTE BOOK NO.	

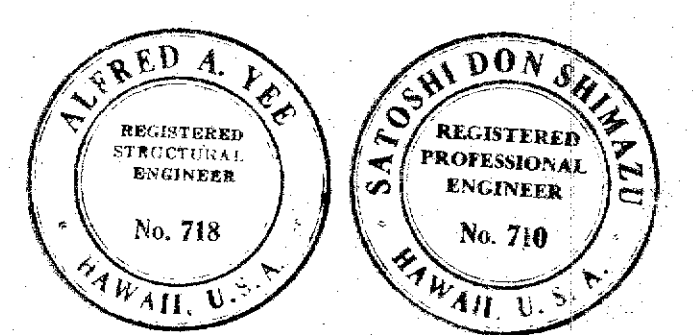


STATE OF HAWAII
DEPARTMENT OF TRANSPORTATION
HIGHWAYS DIVISION
BRIDGE No. 2
Base Line Sta. 100+23.13 To Sta. 102+50.35
VINEYARD BOULEVARD
PROJECT NO. F-098-1-(3)

FED. ROAD DIST. NO.	STATE	FED. AID PROJ. NO.	FISCAL YEAR	SHEET NO.	TOTAL SHEETS

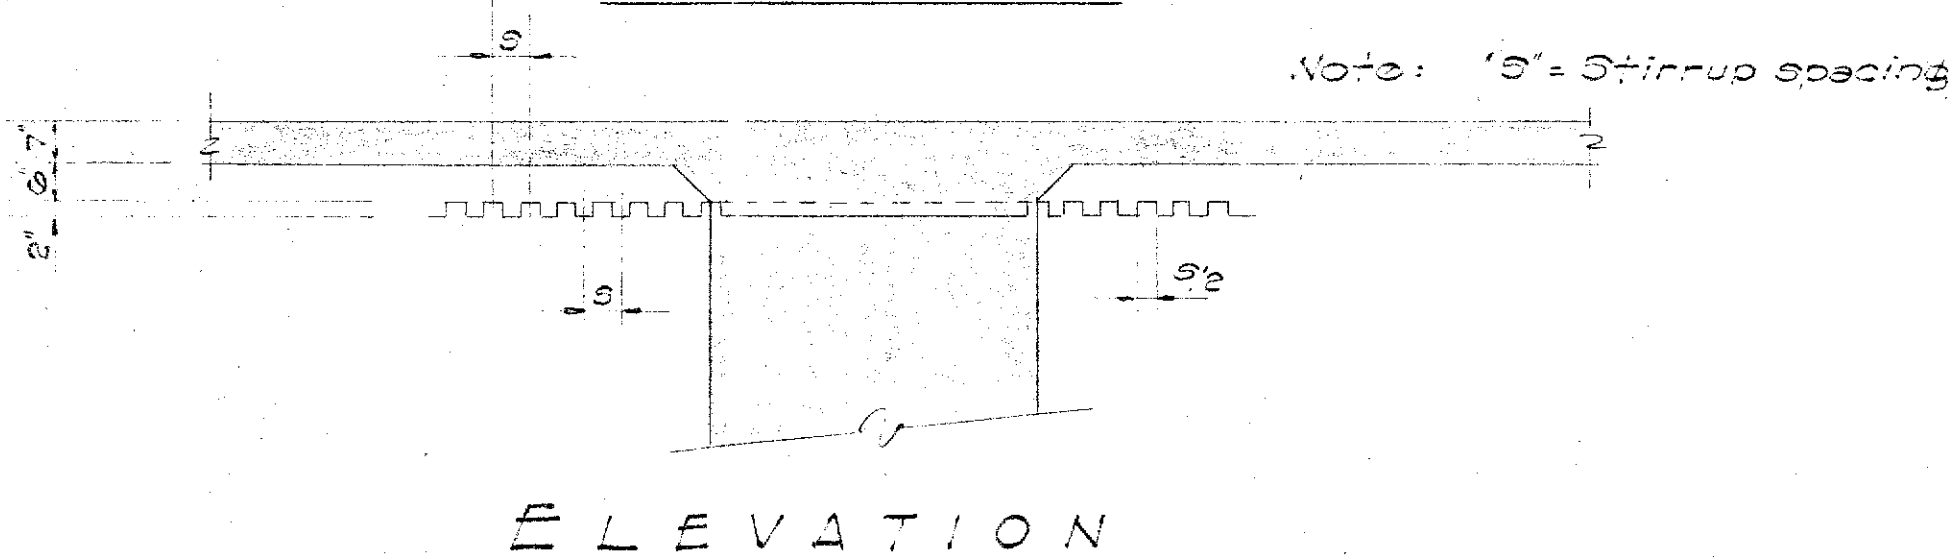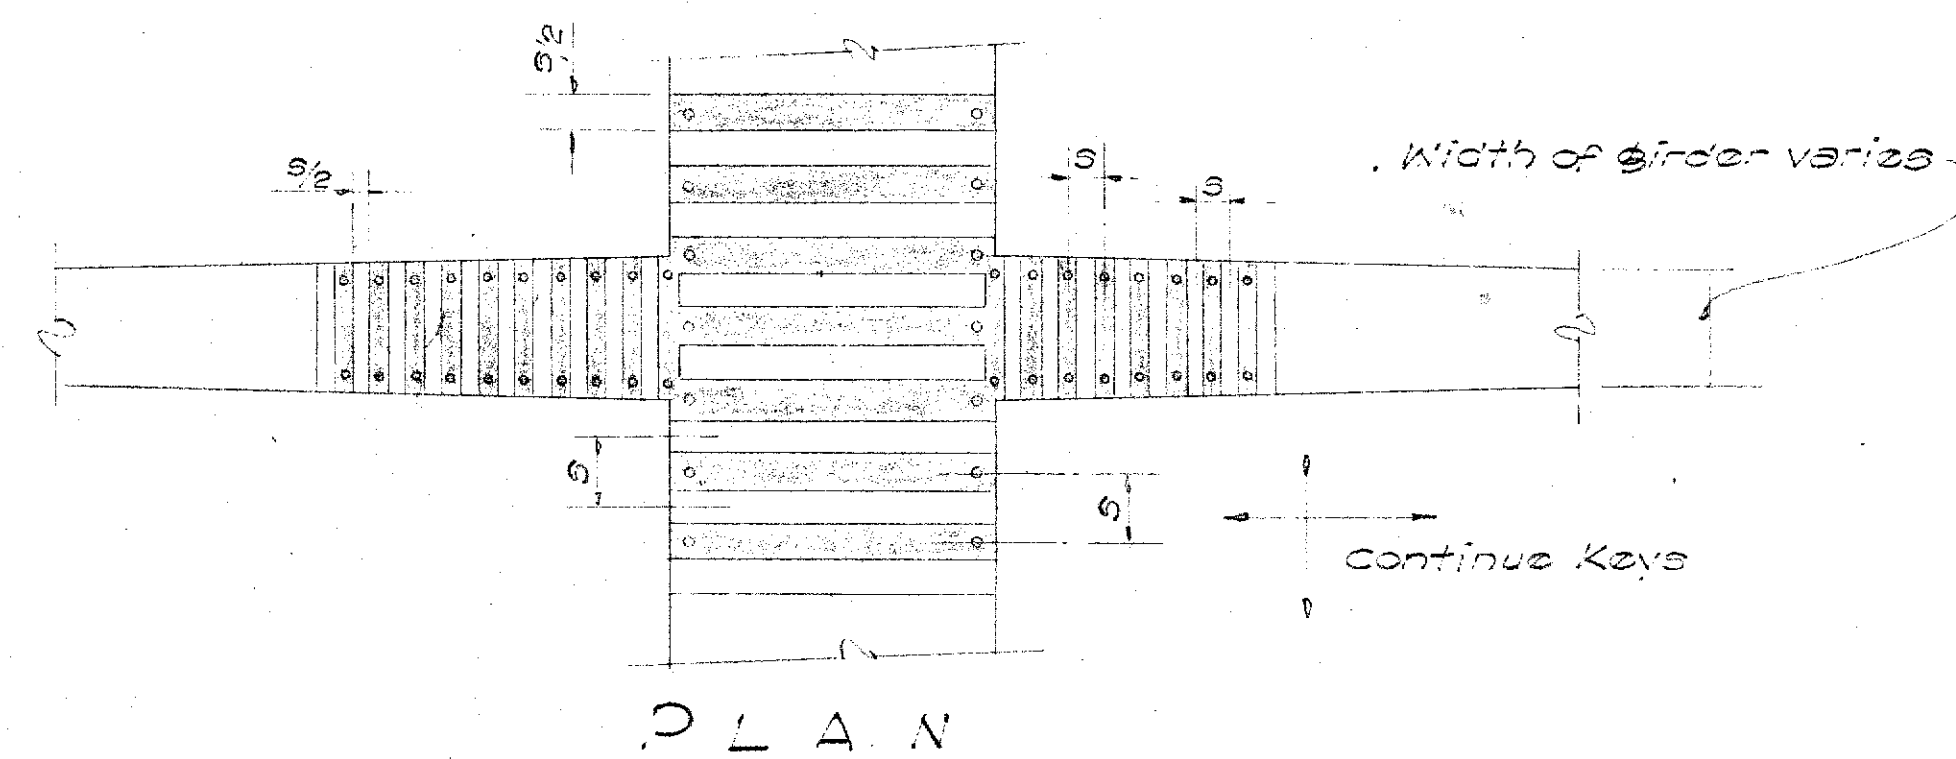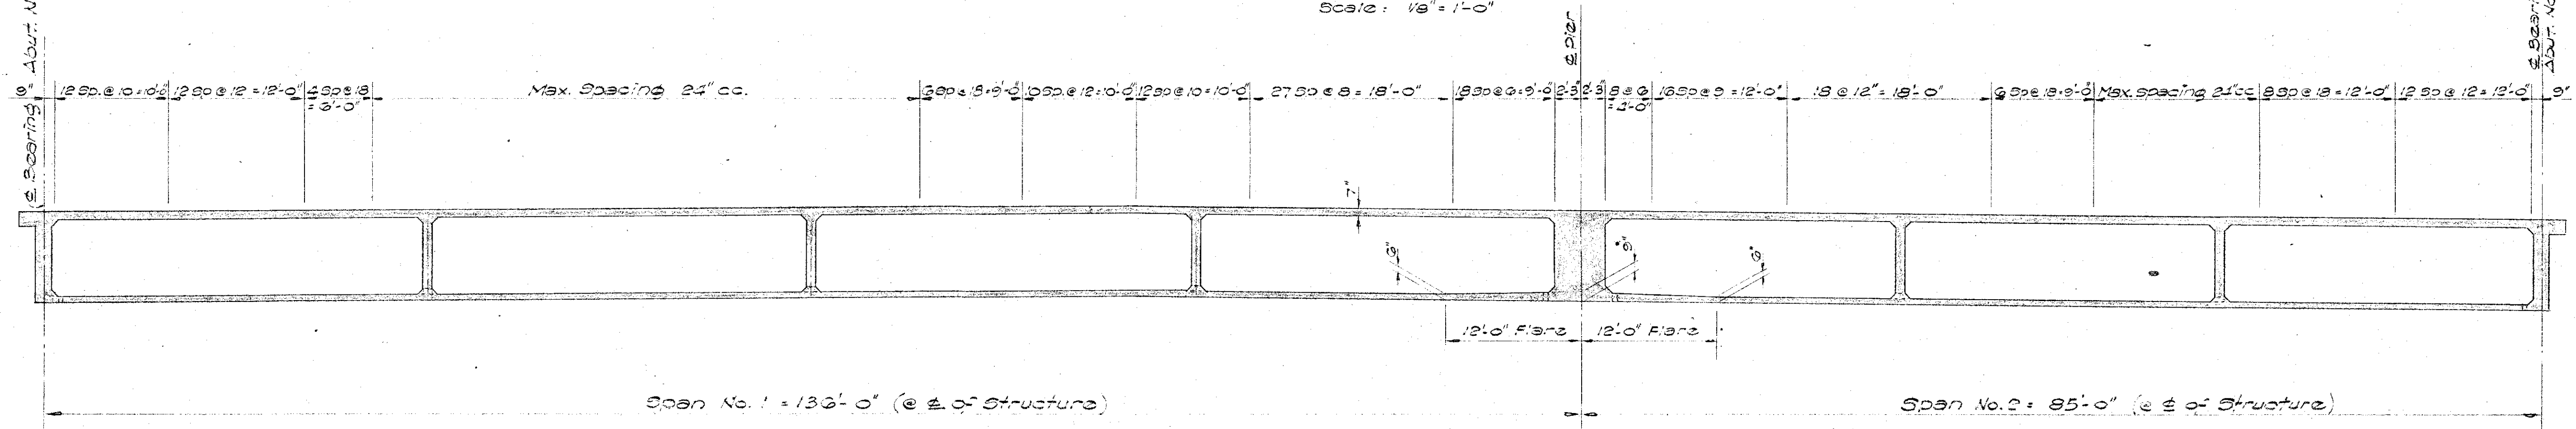
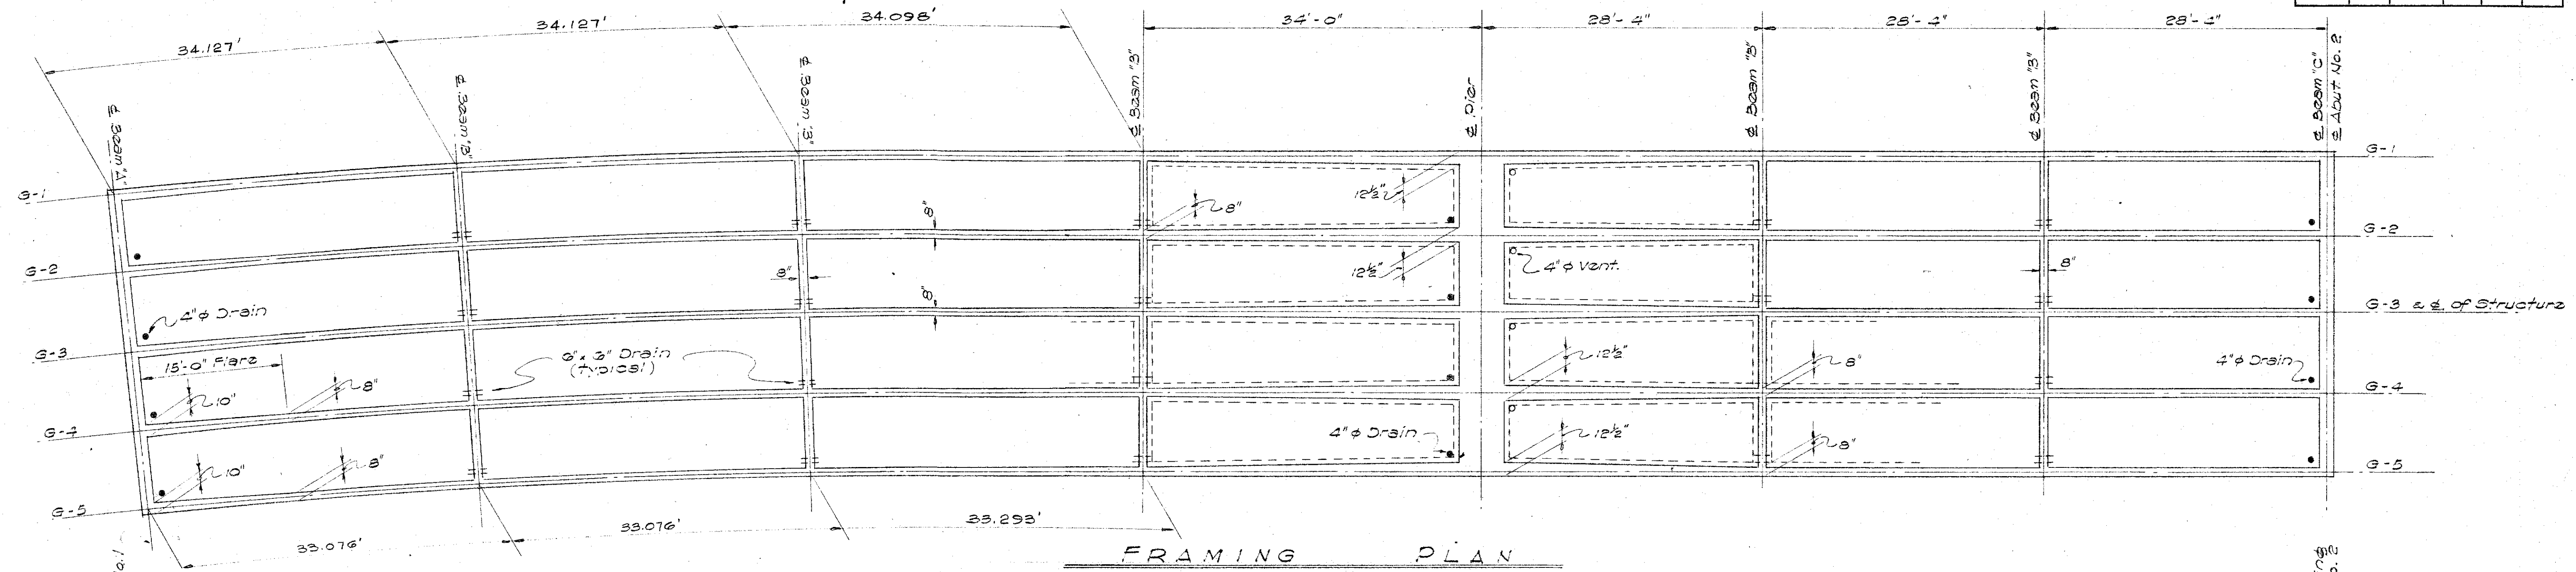


SHEAR KEYS DETAIL
Scale: 3/8" = 1'-0"

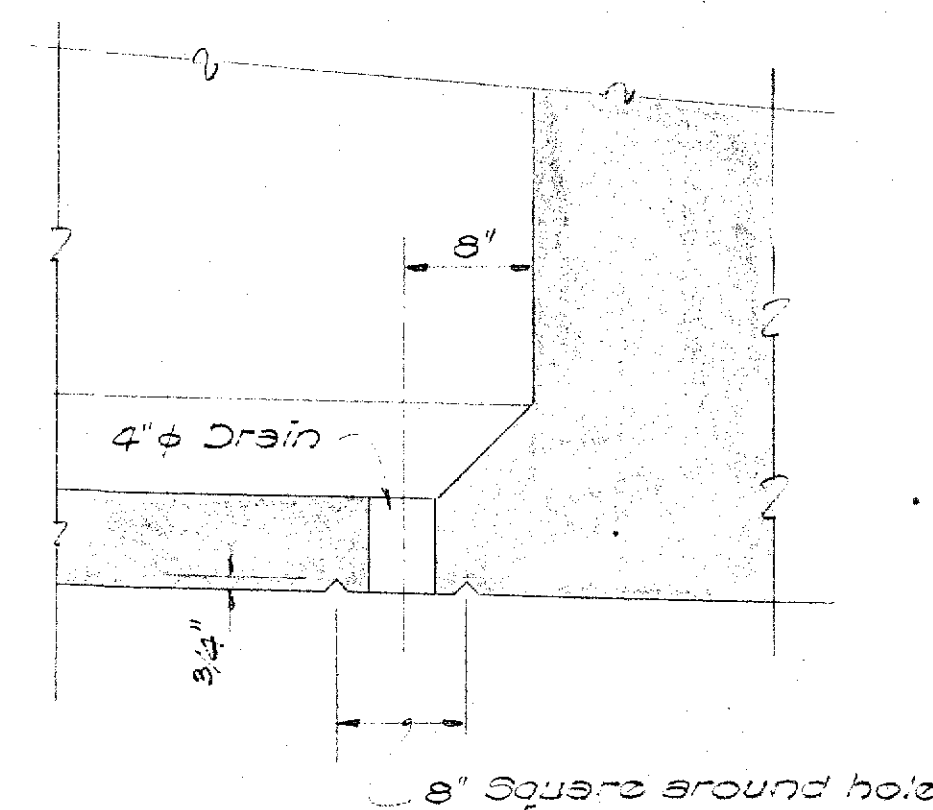

TYPICAL 4 IN. DRAIN DET.
Scale: 1" = 1'-0"

SURVEY PLOTTED BY	DATE
DESIGNED BY	
DRAWN BY	
CHECKED BY	
NOTE BOOK	
NO.	

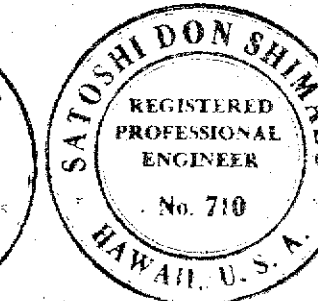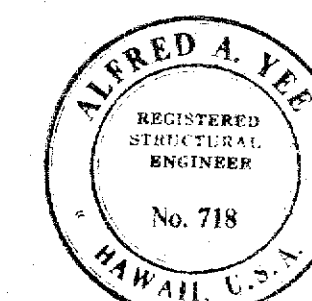


STATE OF HAWAII
DEPARTMENT OF TRANSPORTATION
HIGHWAYS DIVISION
BRIDGE No. 2
Base Line Sta 9+100+23.12 To Sta 102+50.39
VINEYARD BOULEVARD
PROJECT No F-038-1-(3)

SHEET No. 12 OF 16 SHEETS


CONSULTANT SUBMISSION

5928.91

FED. ROAD DIST. No.	STATE	FED. AID PROJ. No.	FISCAL YEAR	SHEET No.	TOTAL SHEETS

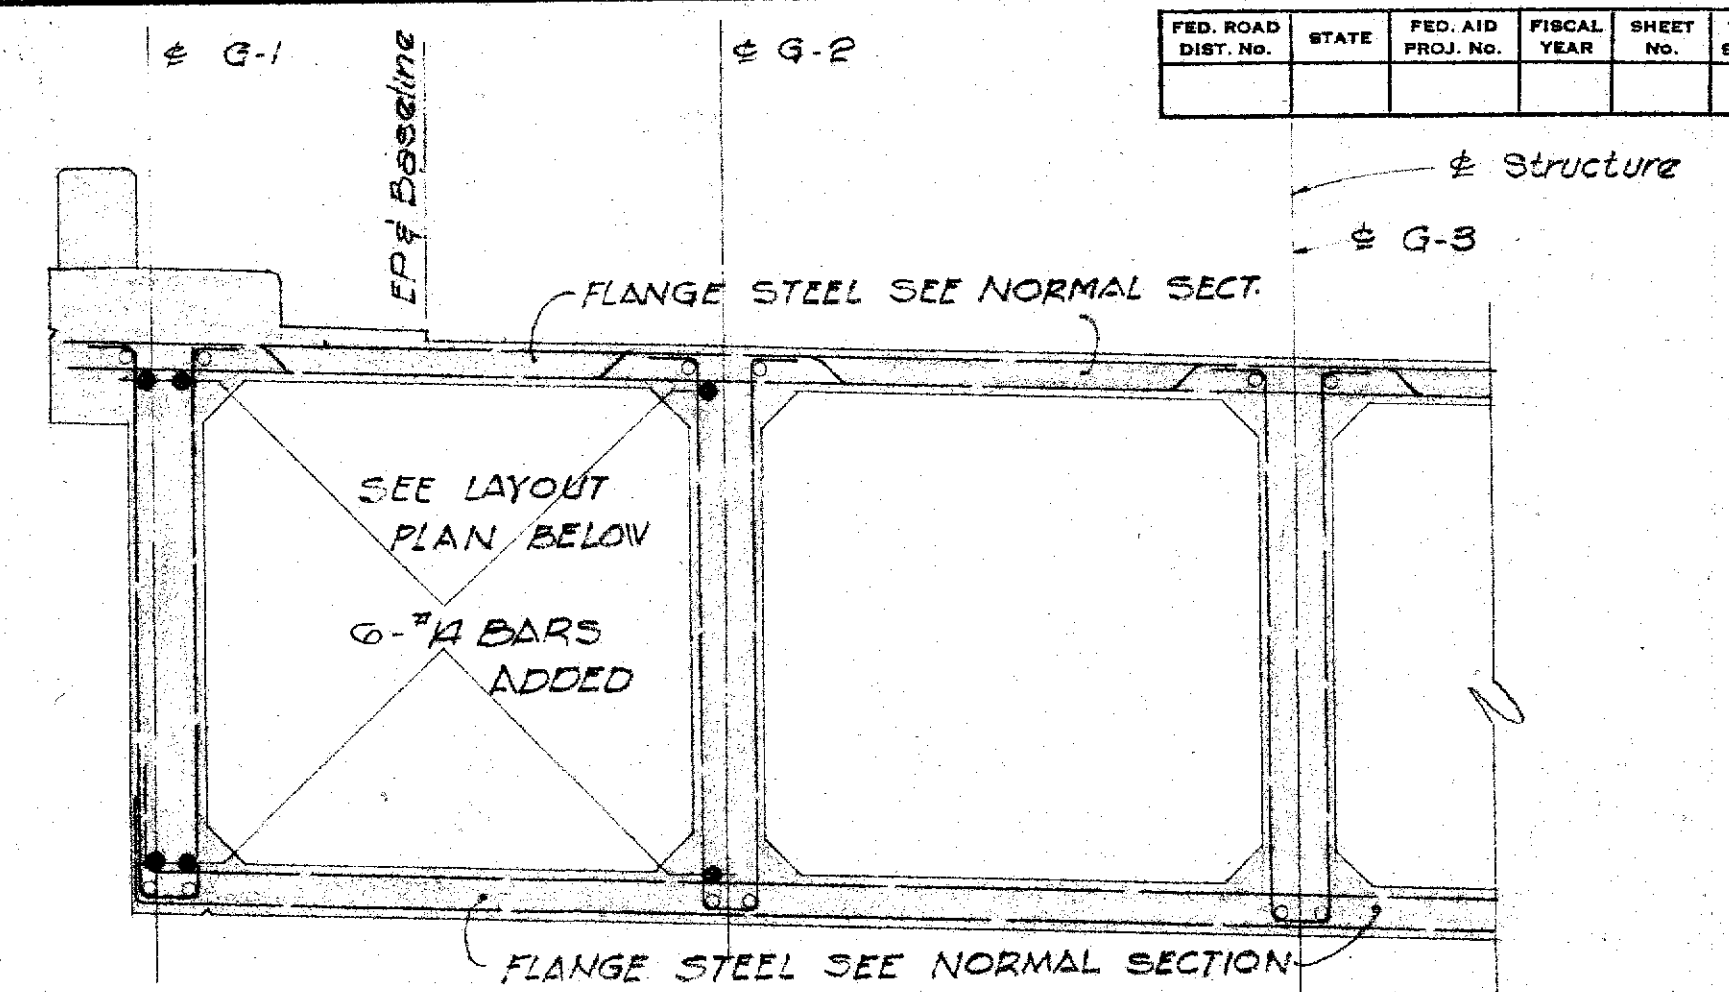

LOCATION OF ADDED #14 BARS
scale: $\frac{3}{8}" = 1'-0"$

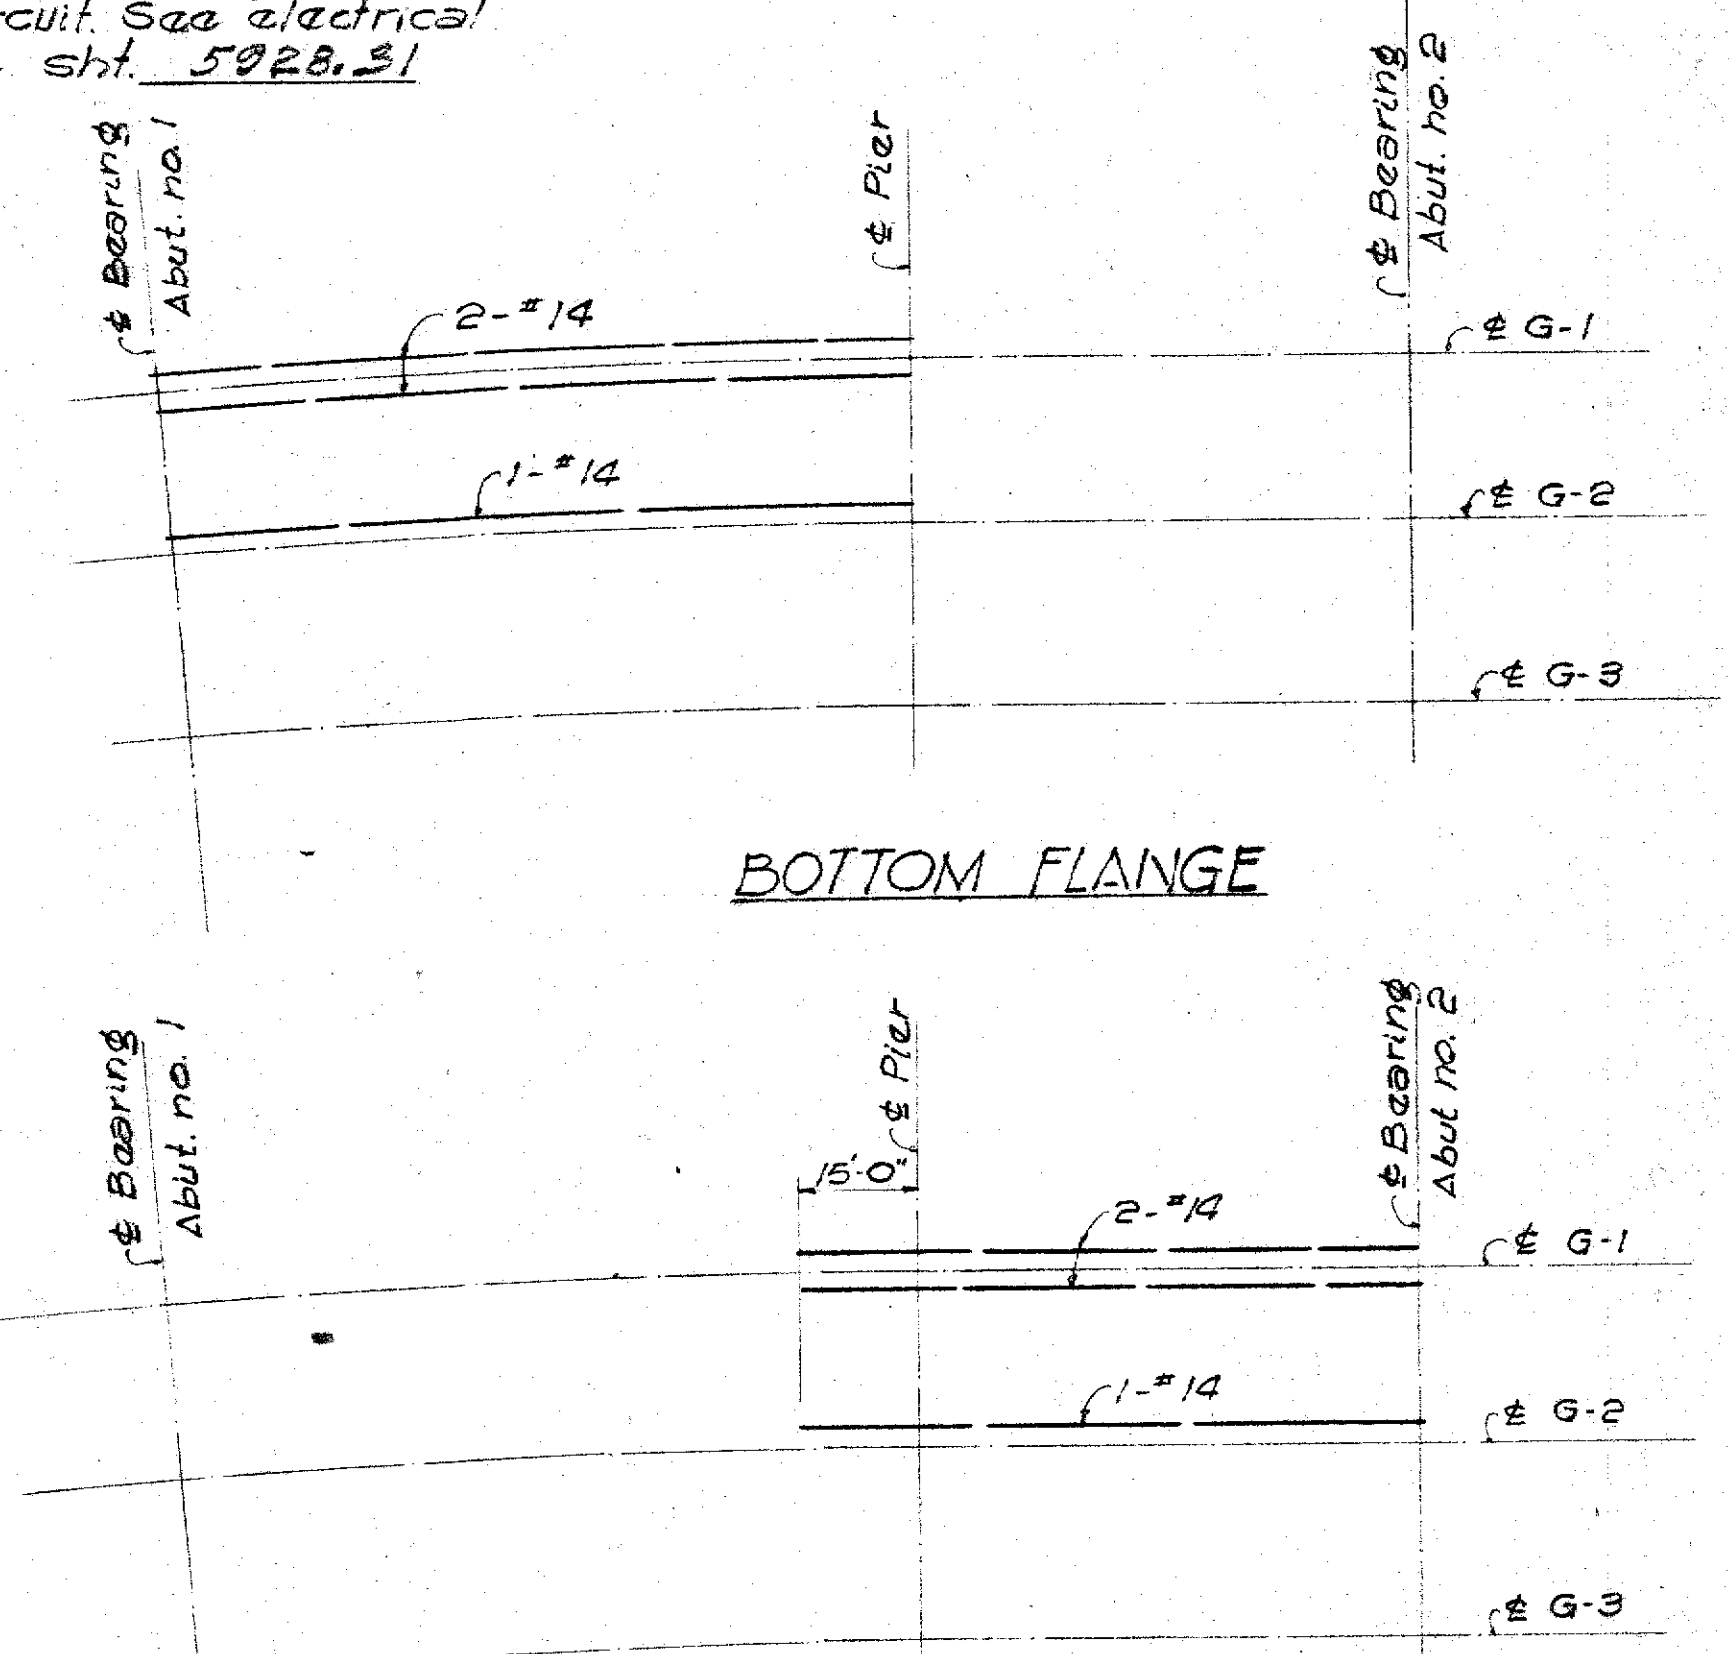


BOTTOM FLANGE

TOP FLANGE

LAYOUT OF ADDED #14 BARS

No Scale

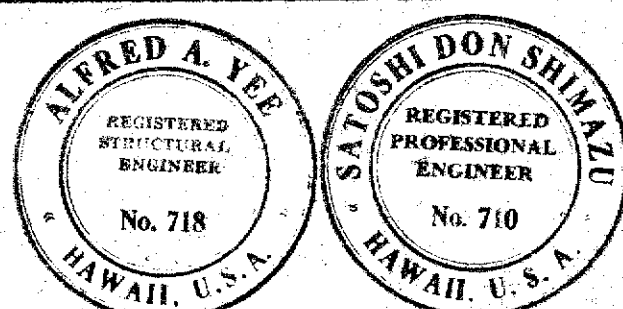


STATE OF HAWAII
DEPARTMENT OF TRANSPORTATION
HIGHWAYS DIVISION

BRIDGE No. 2

Base Line Sta 160+23.12 To Sta. 162+50.28

VINEYARD BOULEVARD
PROJECT No F-098-1-(3)

SHEET No. 13 OF 16 SHEETS

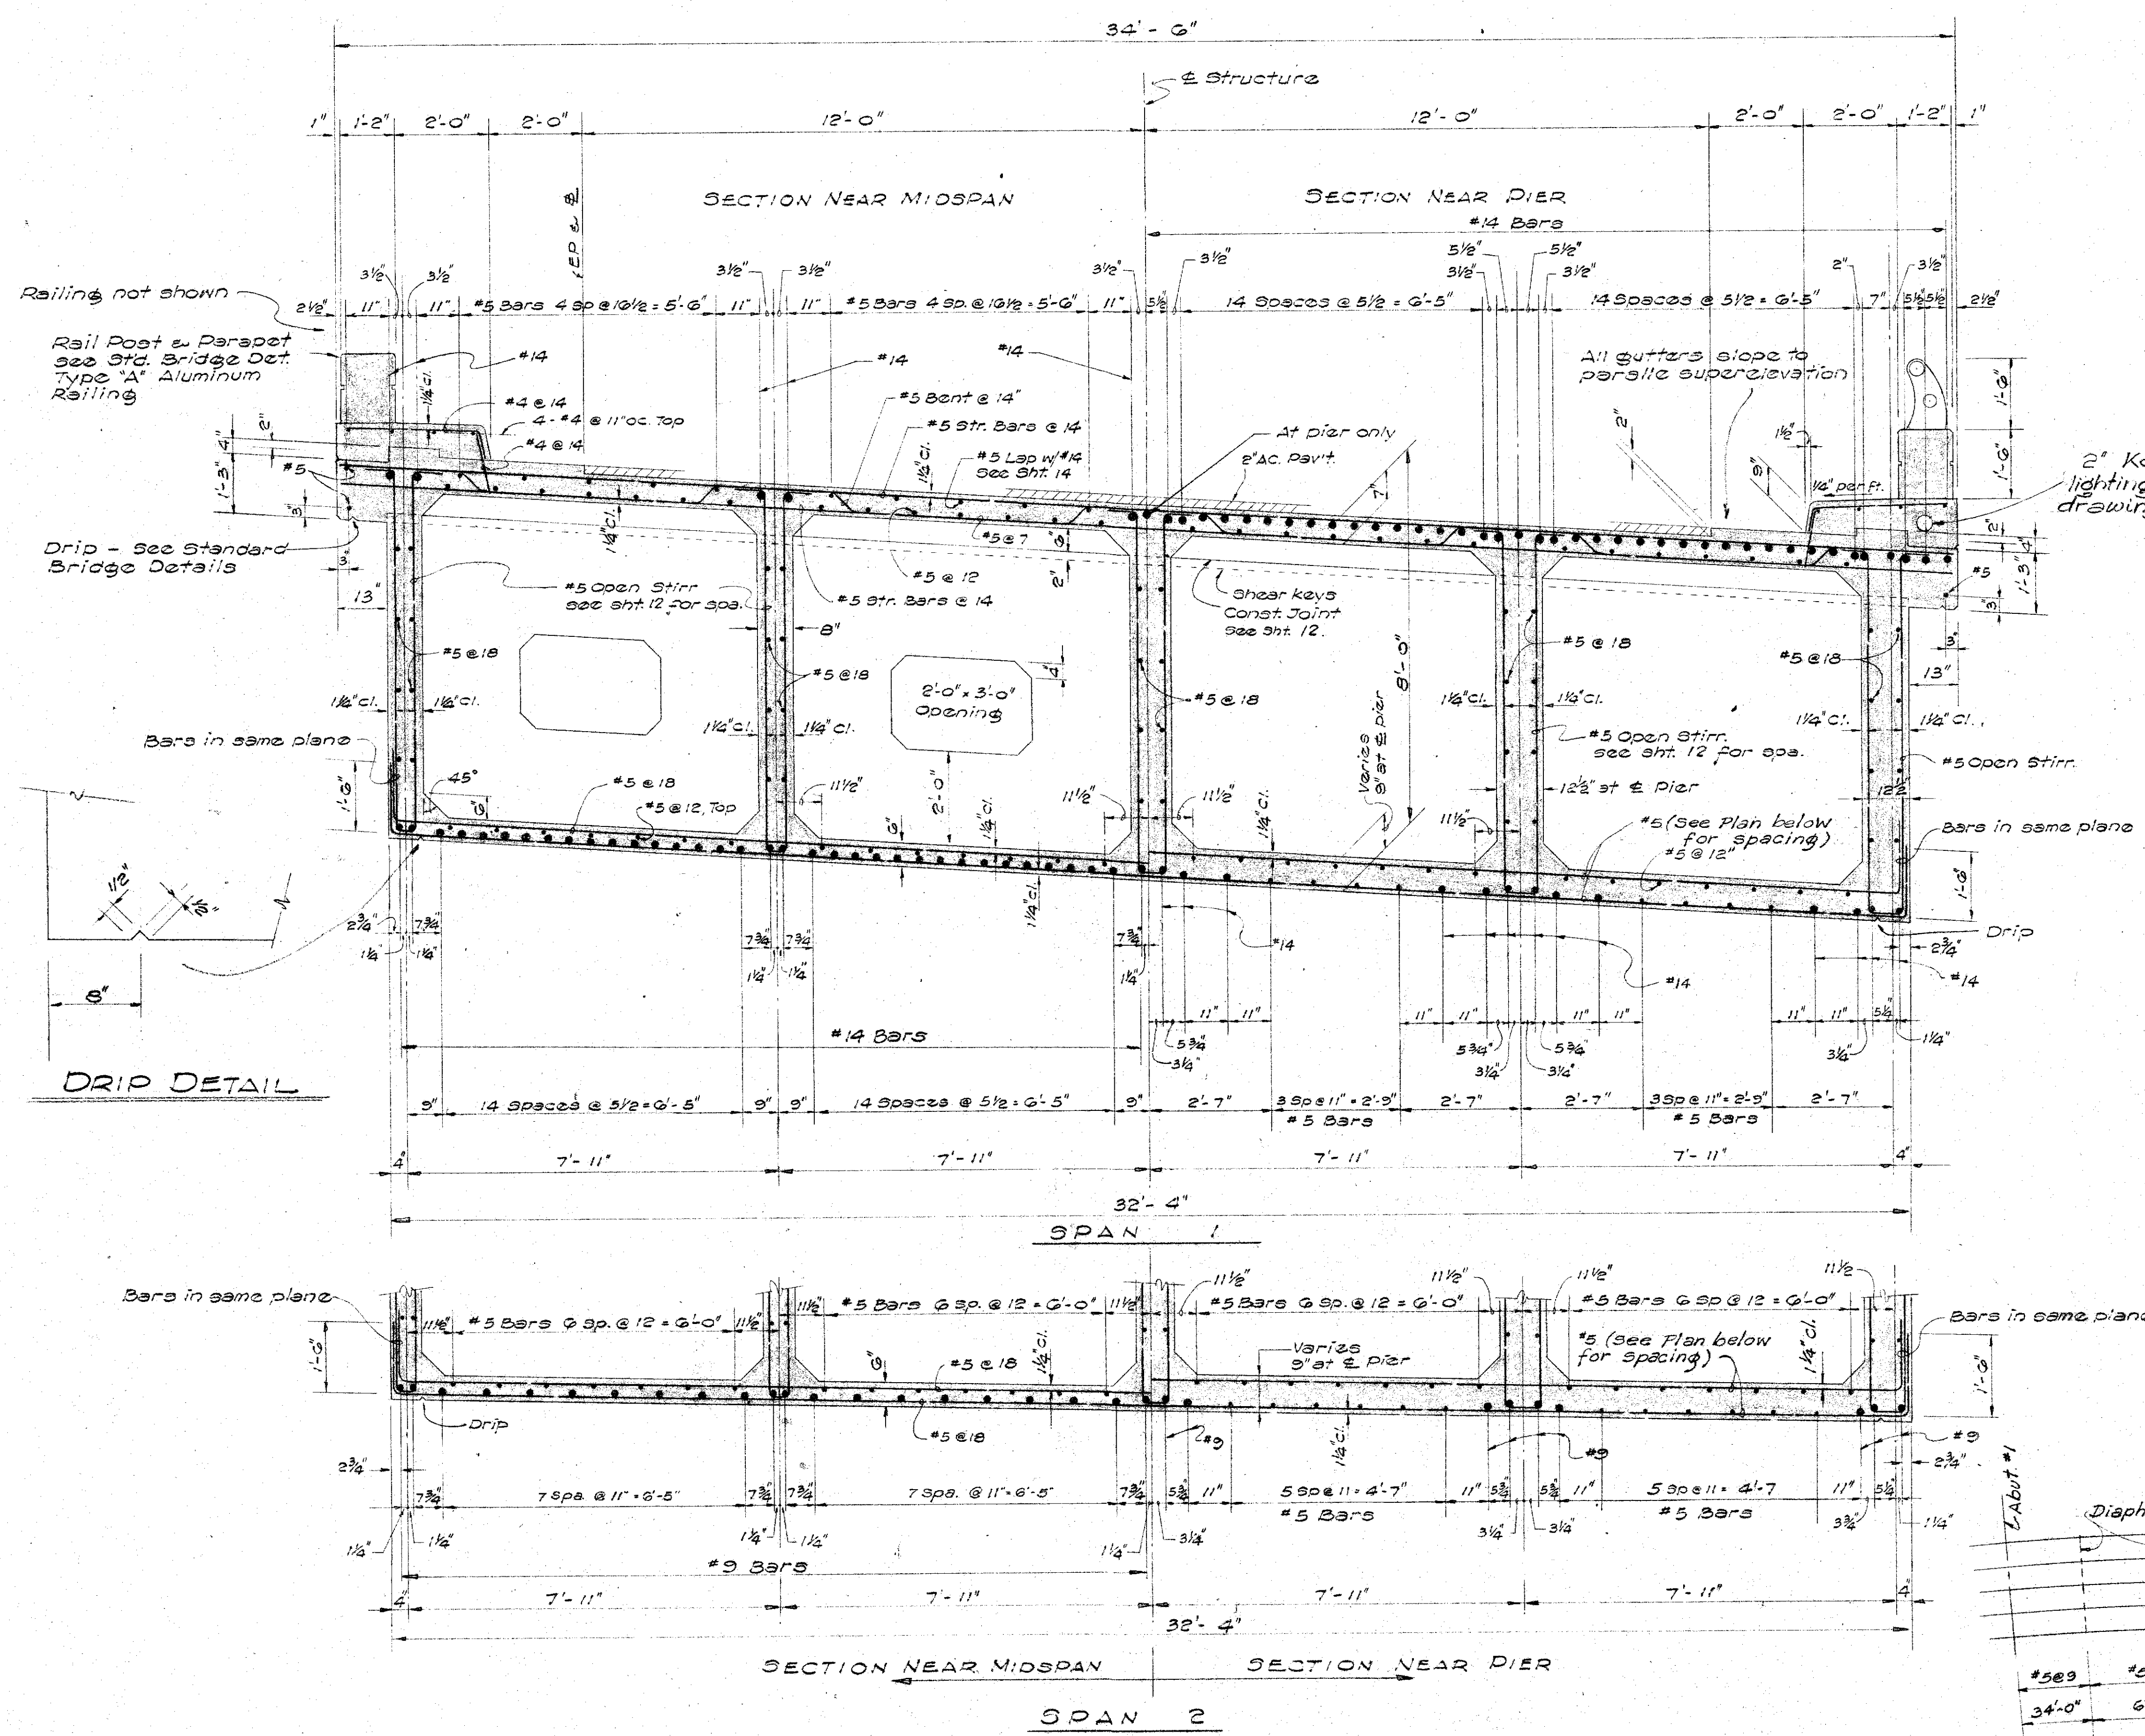

NORMAL SECTION

Scale : $1/2" = 1'-0"$

PLAN-BOTTOM SLAB
TRANSVERSE REINF. LAYOUT

No Scale


A hand-drawn sketch of a road layout. The sketch shows a horizontal road with several segments. Above the road, there are labels for stationing: #509, #5@18", #509", #509", and #5@18". Below the road, there are labels for segment lengths: 34'-0", 68'-0", 34'-0", 28'-4", and 56'-8". The road is drawn with dashed lines, and the labels are written in a handwritten style.

CONSULTANT SUBMISSION

5928.92


ORIGINAL PLAN	SURVEY PLOTTED BY _____	DATE _____
	DESIGNED BY _____	" _____
NOTE BOOK No. _____	DRAWN BY _____	" _____
	TRACED BY _____	" _____
	QUANTITIES CHECKED BY _____	" _____
	CHECKED BY _____	" _____

FED. ROAD DIST. NO.	STATE	FED. AID PROJ. NO.	FISCAL YEAR	SHEET NO.	TOTAL SHEETS

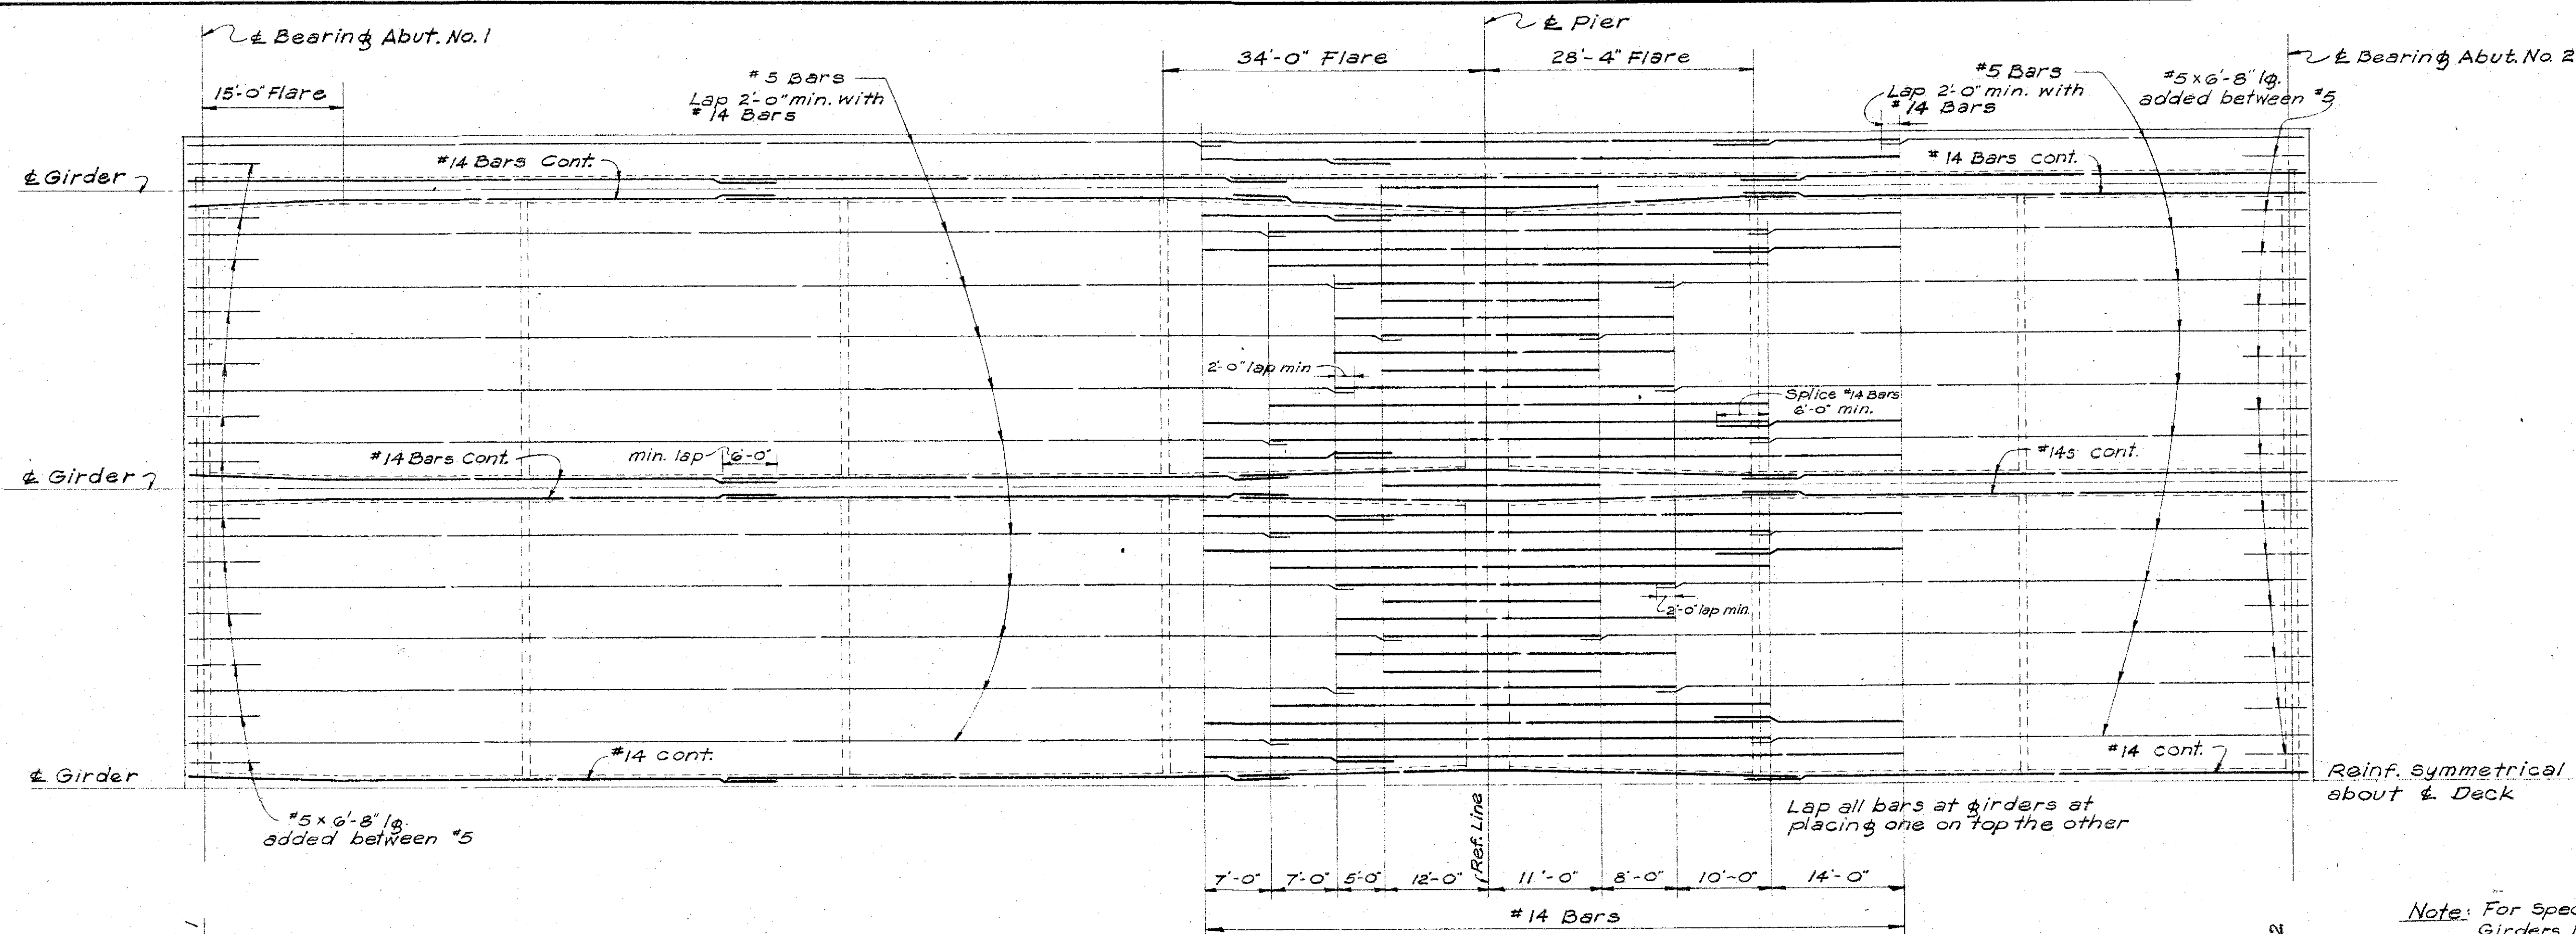


MAIN TOP FLANGE REINF. PLAN
Schematic Layout - scale: Length $\frac{3}{32}'' = 1'-0''$
Width $\frac{3}{8}'' = 1'-0''$

Note: For Special Added Reinf. in Girders 1 & 2, See Sht. 13

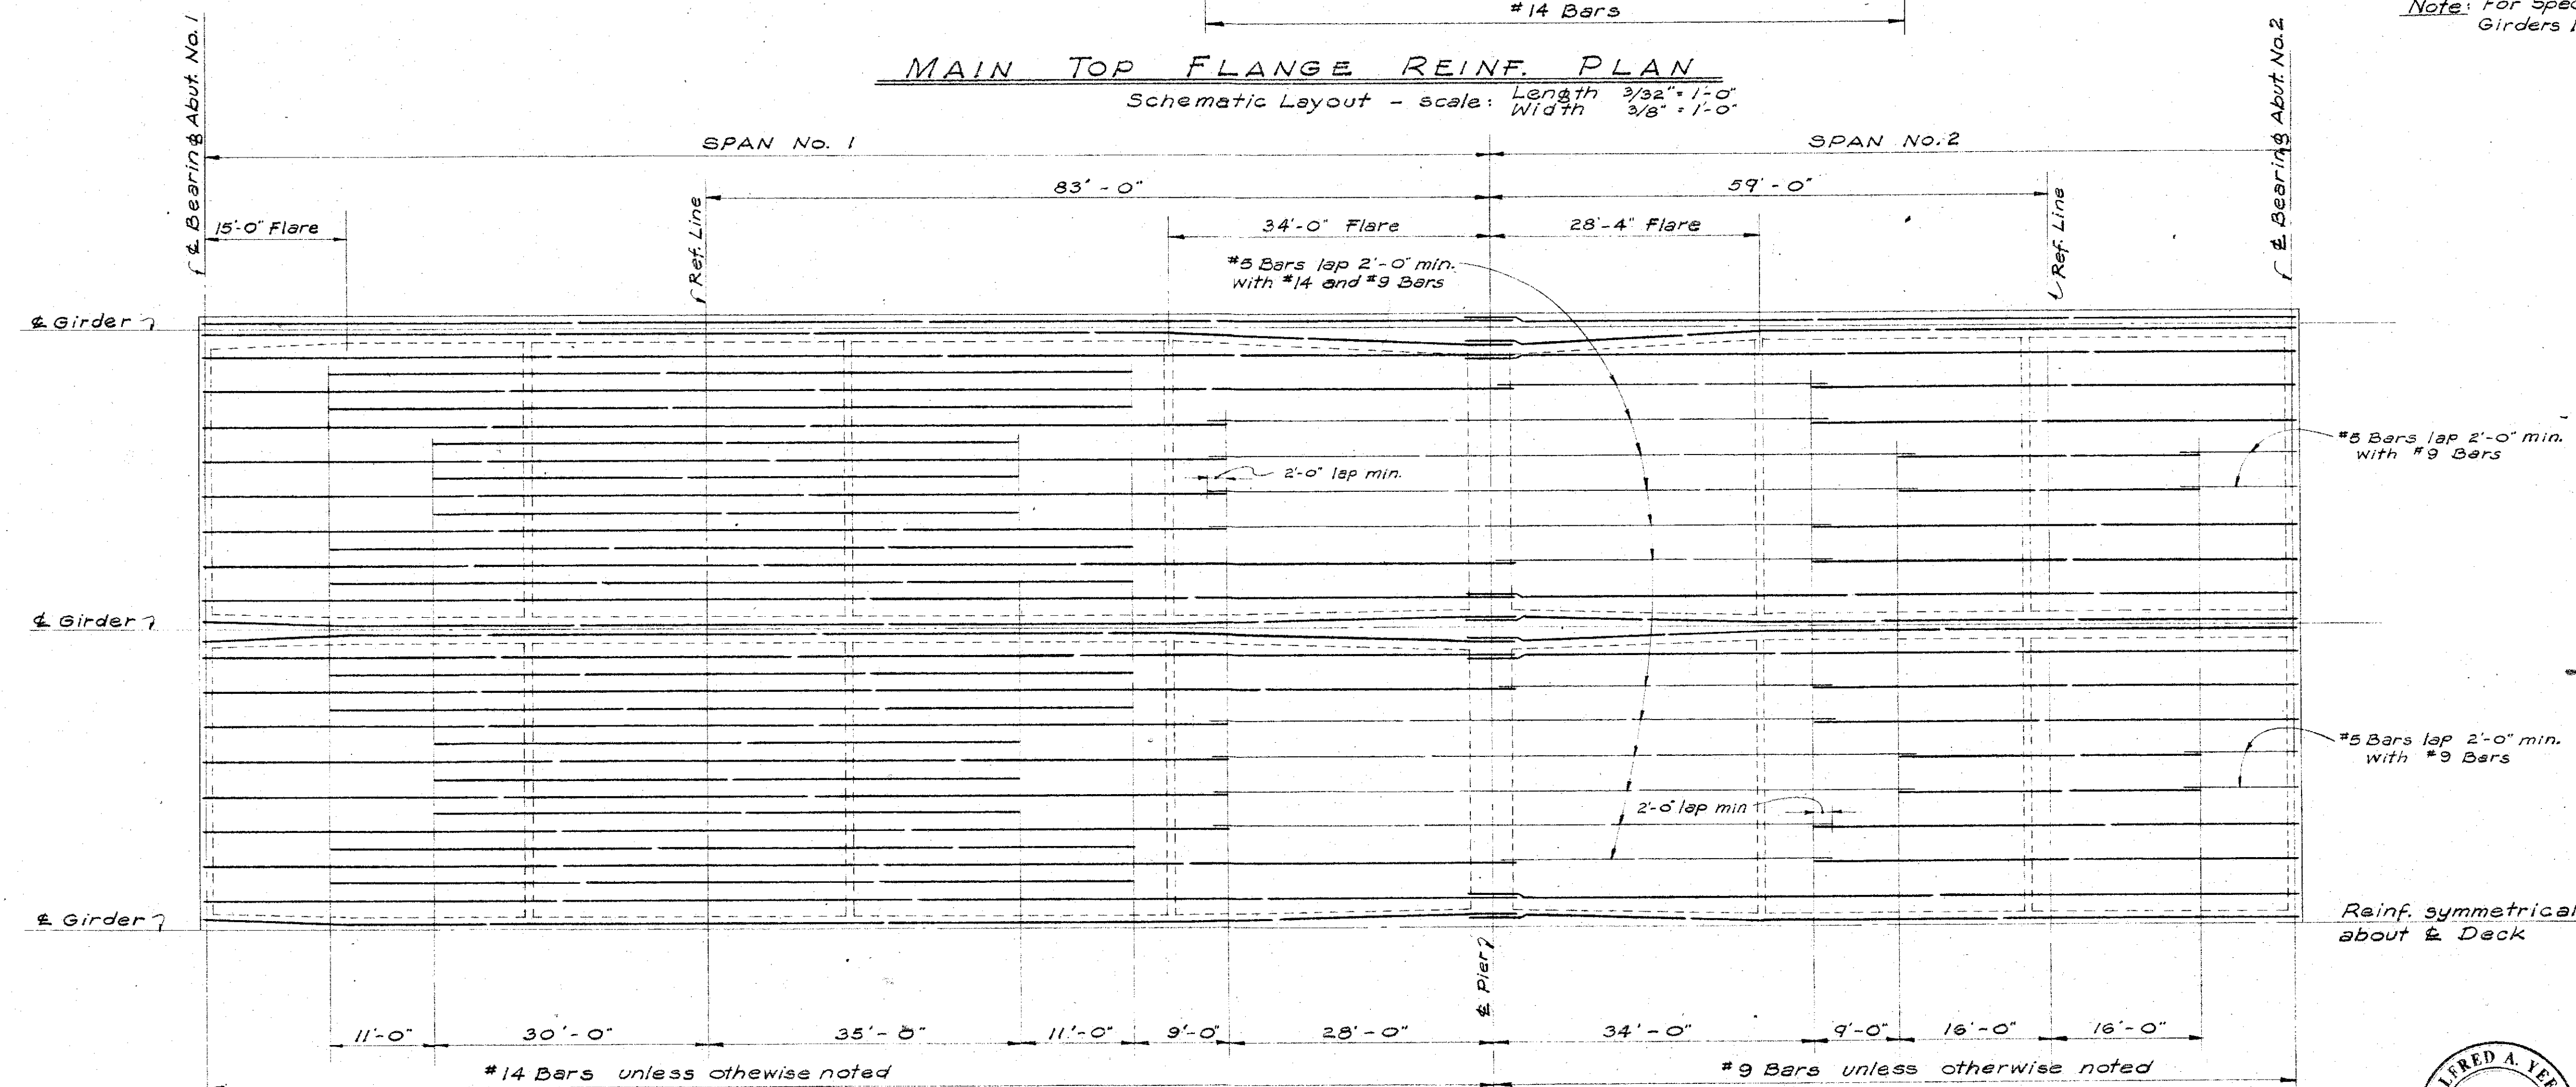

MAIN BOT. FLANGE REINF. PLAN
Schematic Layout Scale: Length $\frac{3}{32}'' = 1'-0''$
Width $\frac{3}{8}'' = 1'-0''$


Reinf. symmetrical about $\pm$ Deck

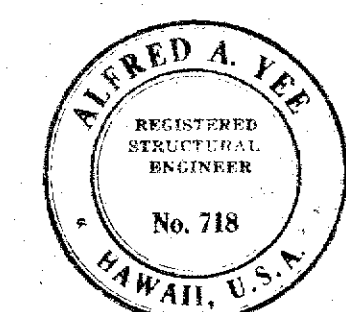


STATE OF HAWAII
DEPARTMENT OF TRANSPORTATION
HIGHWAYS DIVISION
BRIDGE No. 2
Base Line Sta. 160+23.12 To Sta. 162+50.39
VINEYARD BOULEVARD
PROJECT No. F-026-1-(3)

ORIGINAL PLAN	DATE
NO.	
SURVEY PLOTTED BY	
DRAWN BY	
TRACED BY	
QUANTITIES CHECKED BY	
CHECKED BY	


FED. ROAD DIST. NO.	STATE	FED. AID PROJ. NO.	FISCAL YEAR	SHEET NO.	TOTAL SHEETS

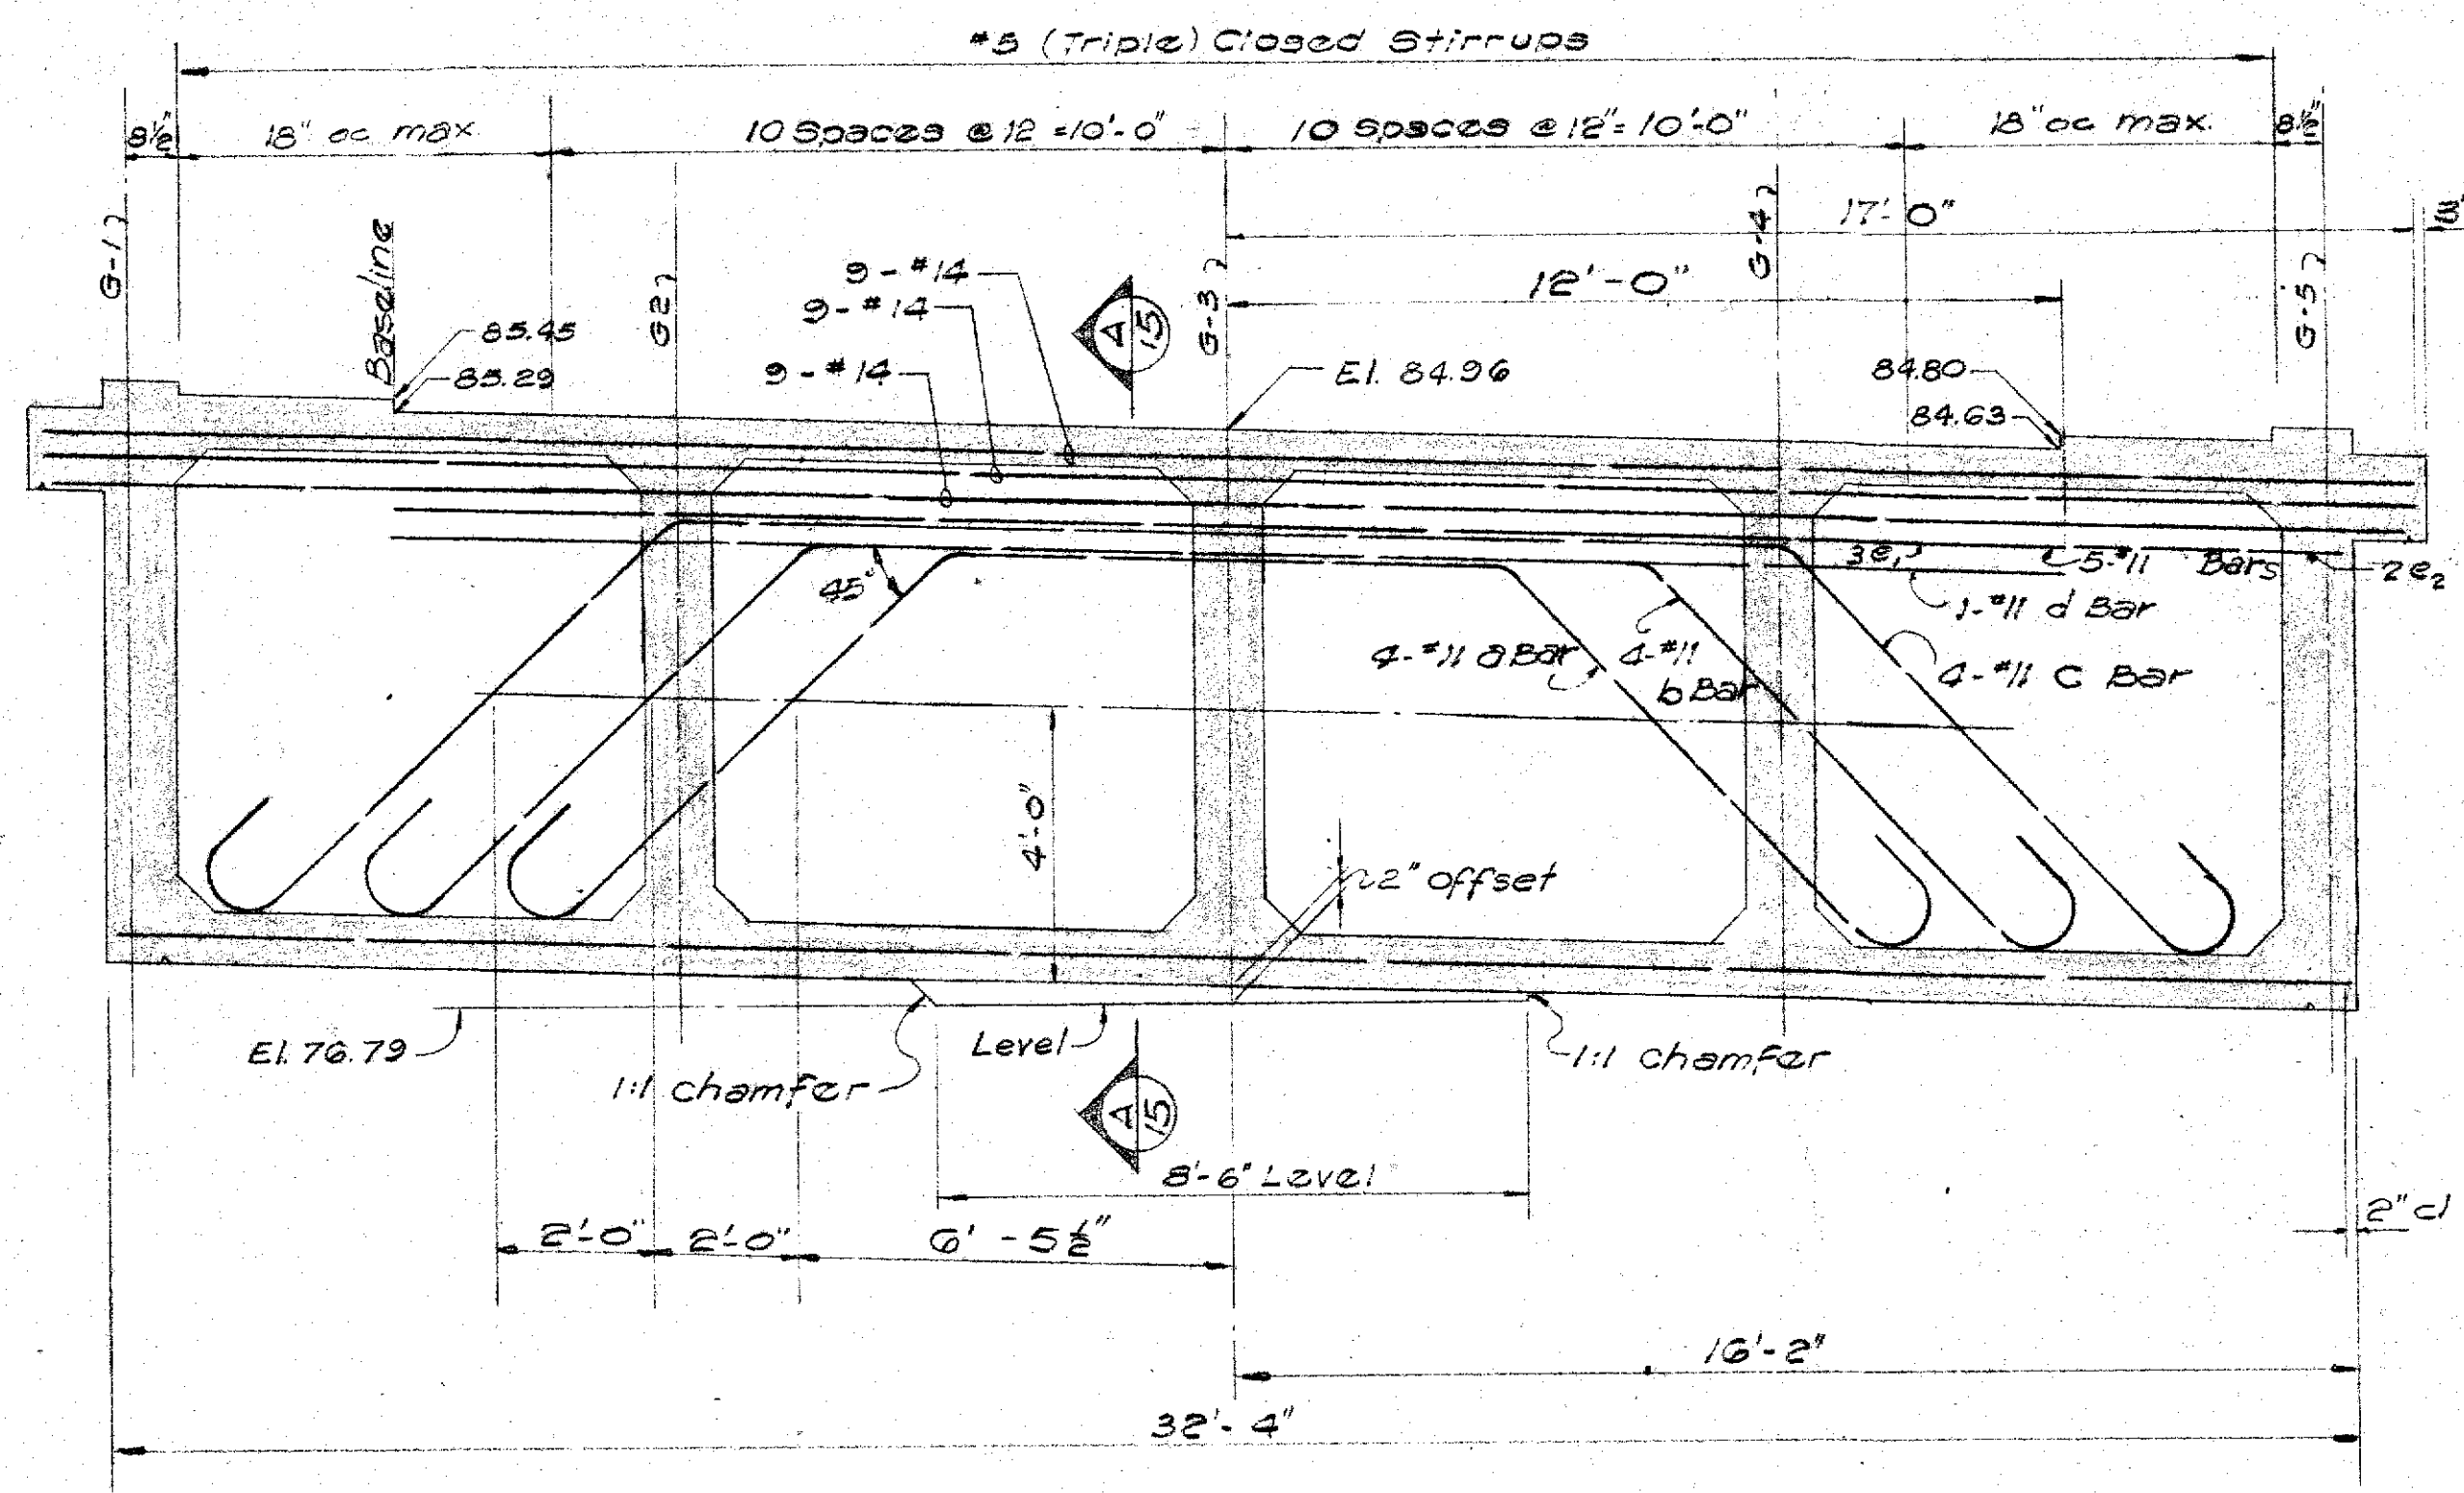


BEAM "D" (OVER PIER)
Scale: 3/8" = 1'-0"

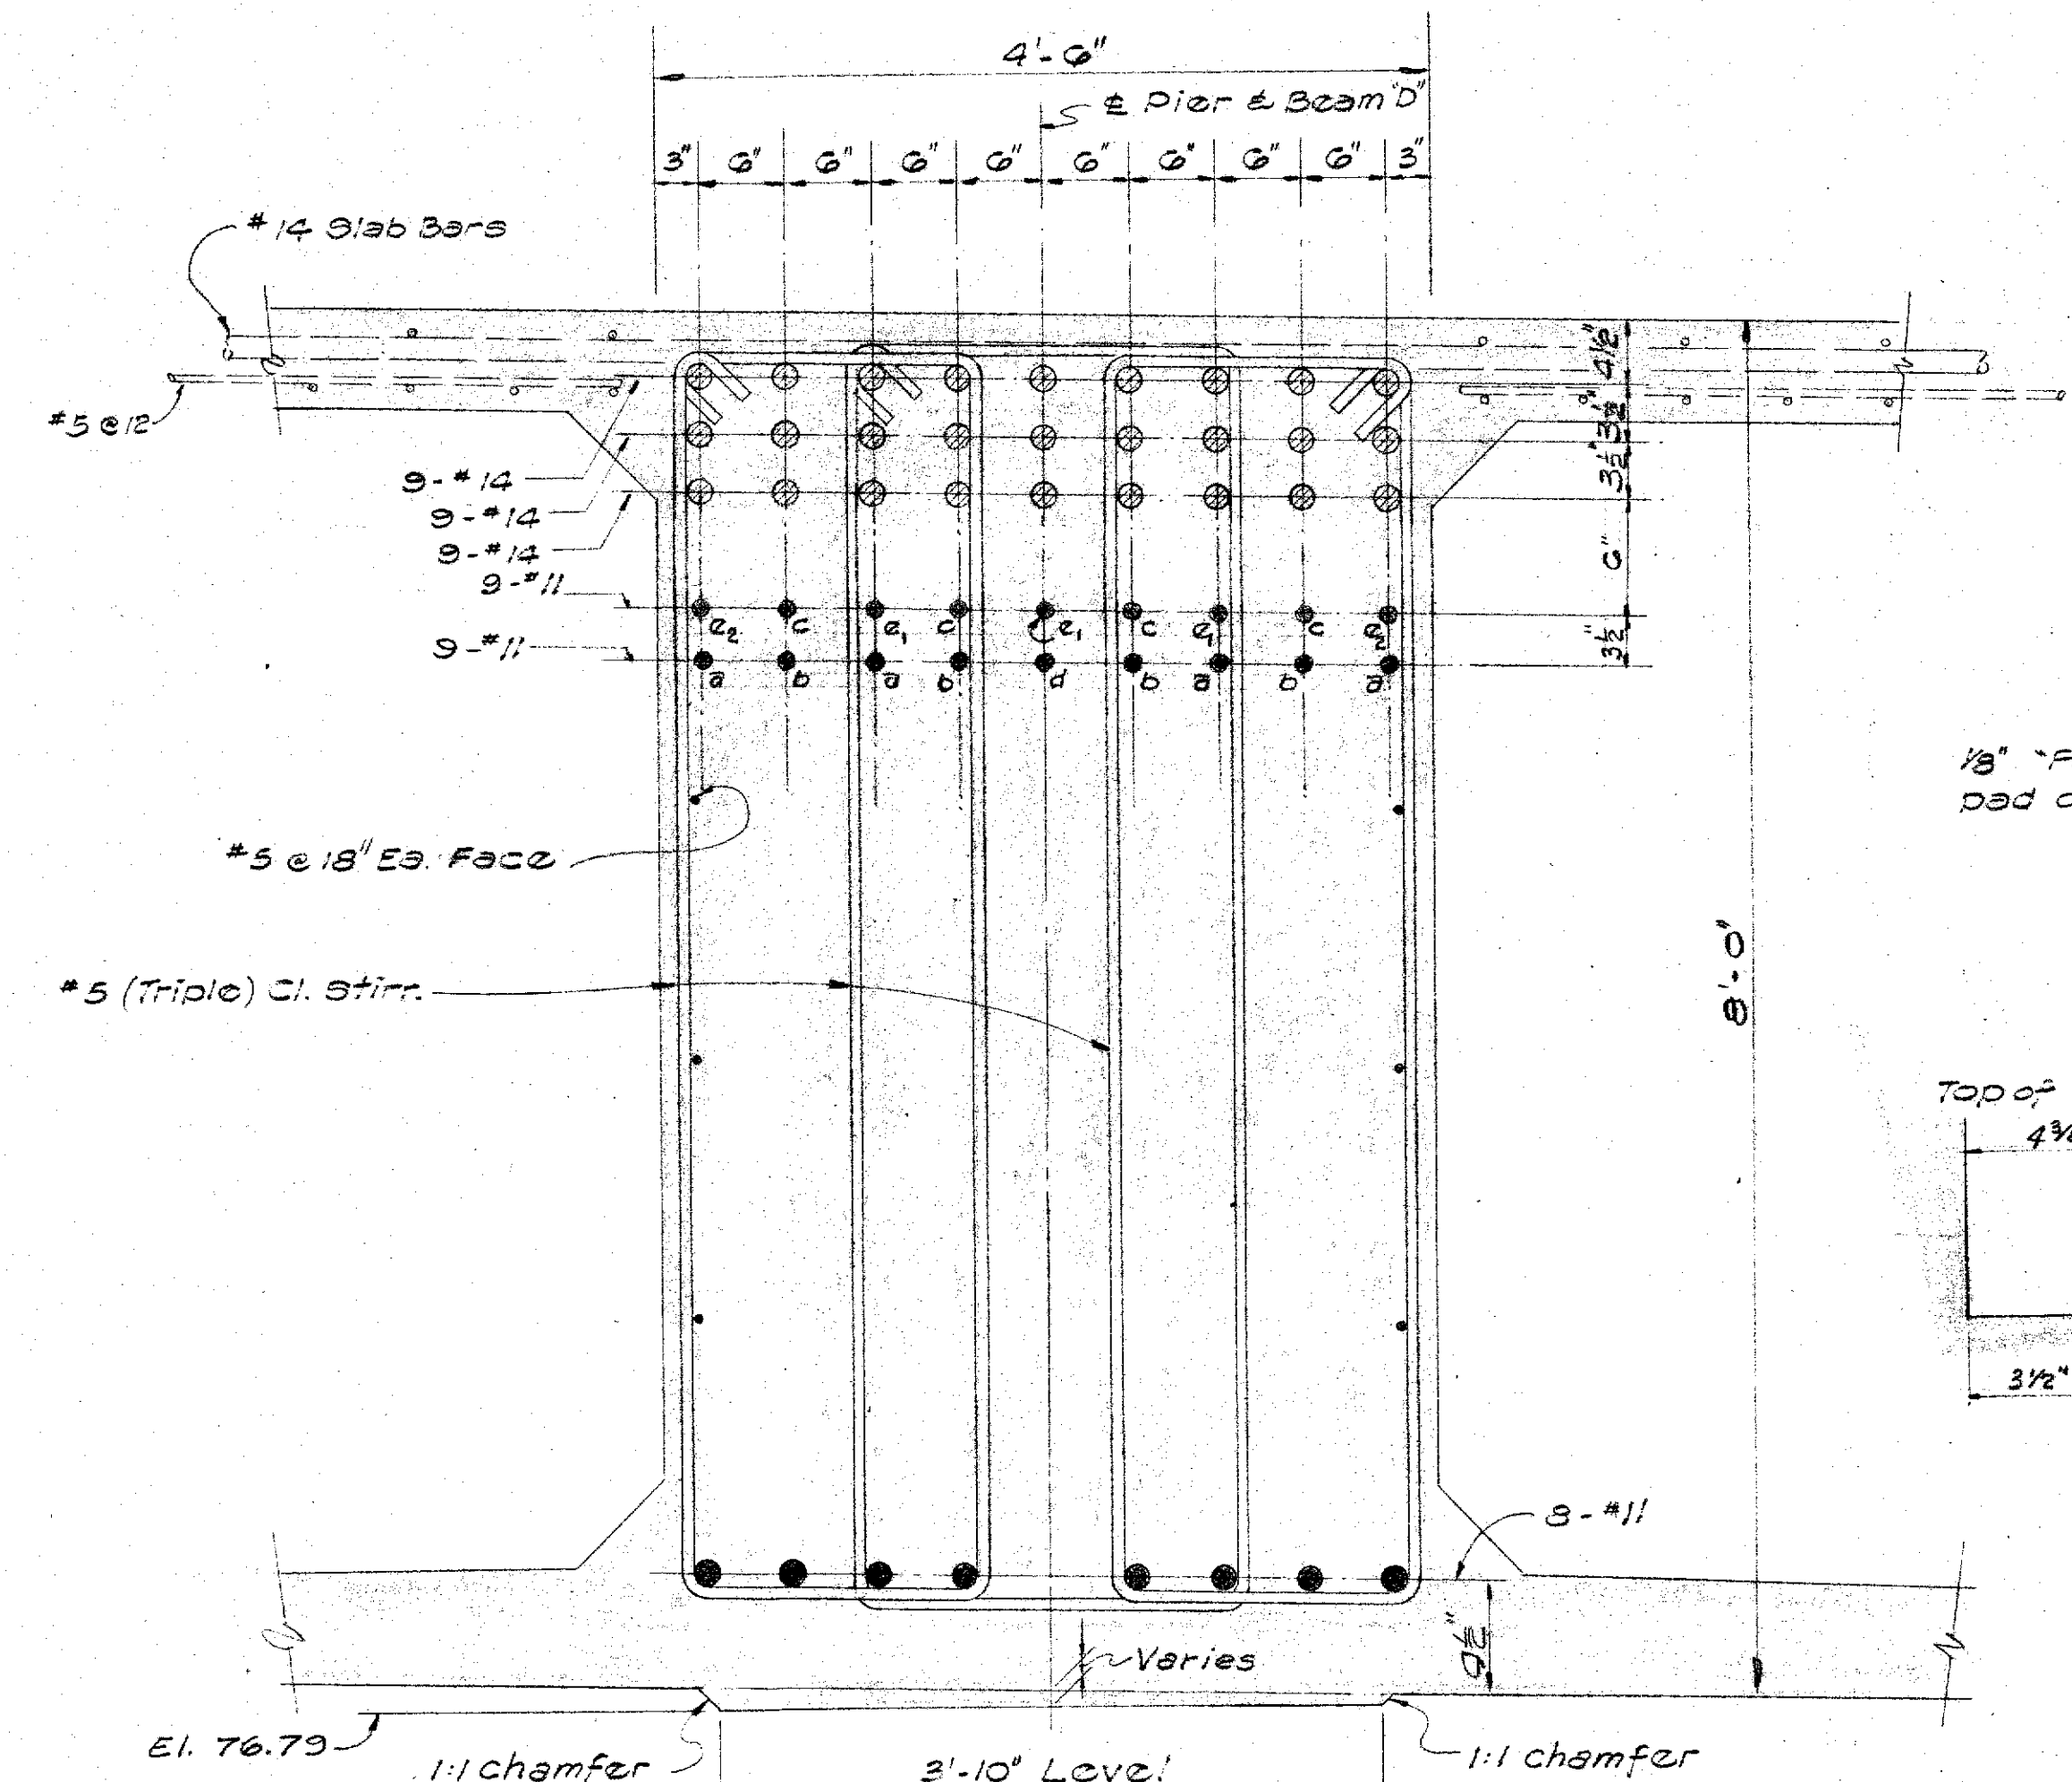


SECTION A-A
Scale: 1" = 1'-0"

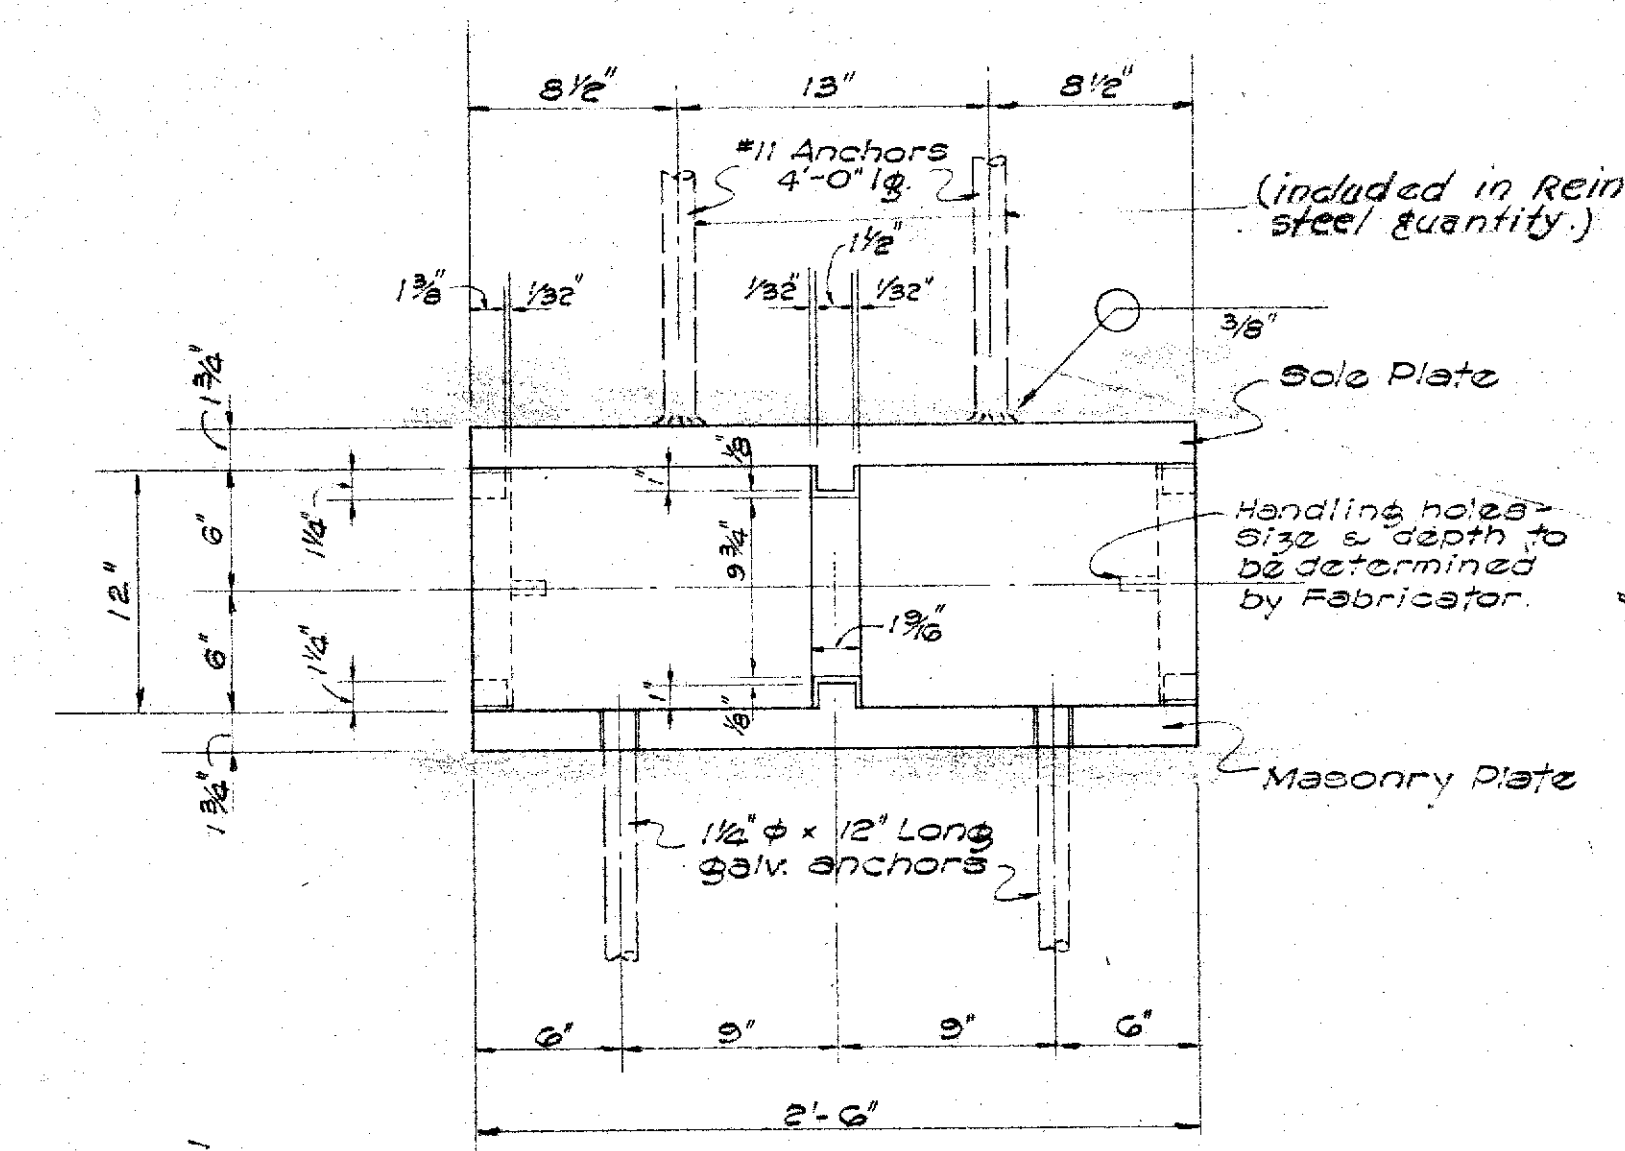


END ELEVATION
Scale: 1/8" = 1'-0"

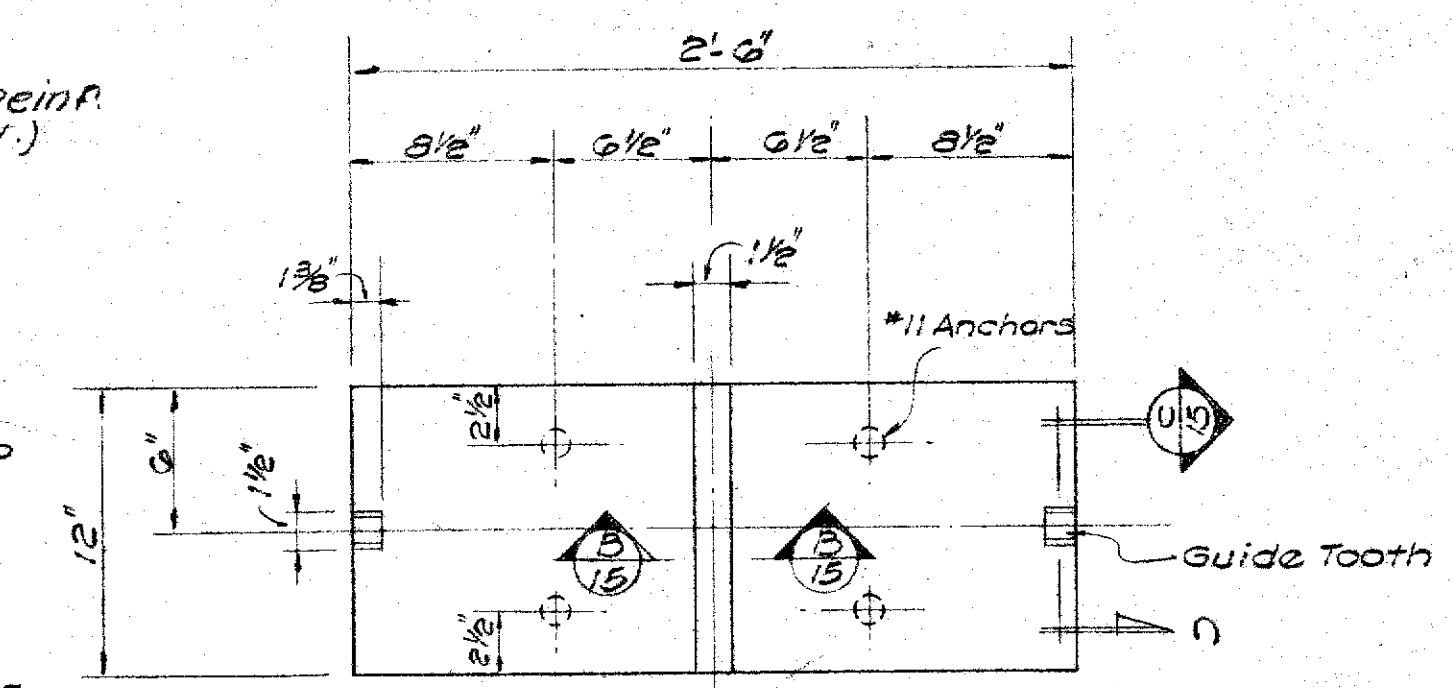

PLAN - SOLE PLATE
Scale: 1/8" = 1'-0"


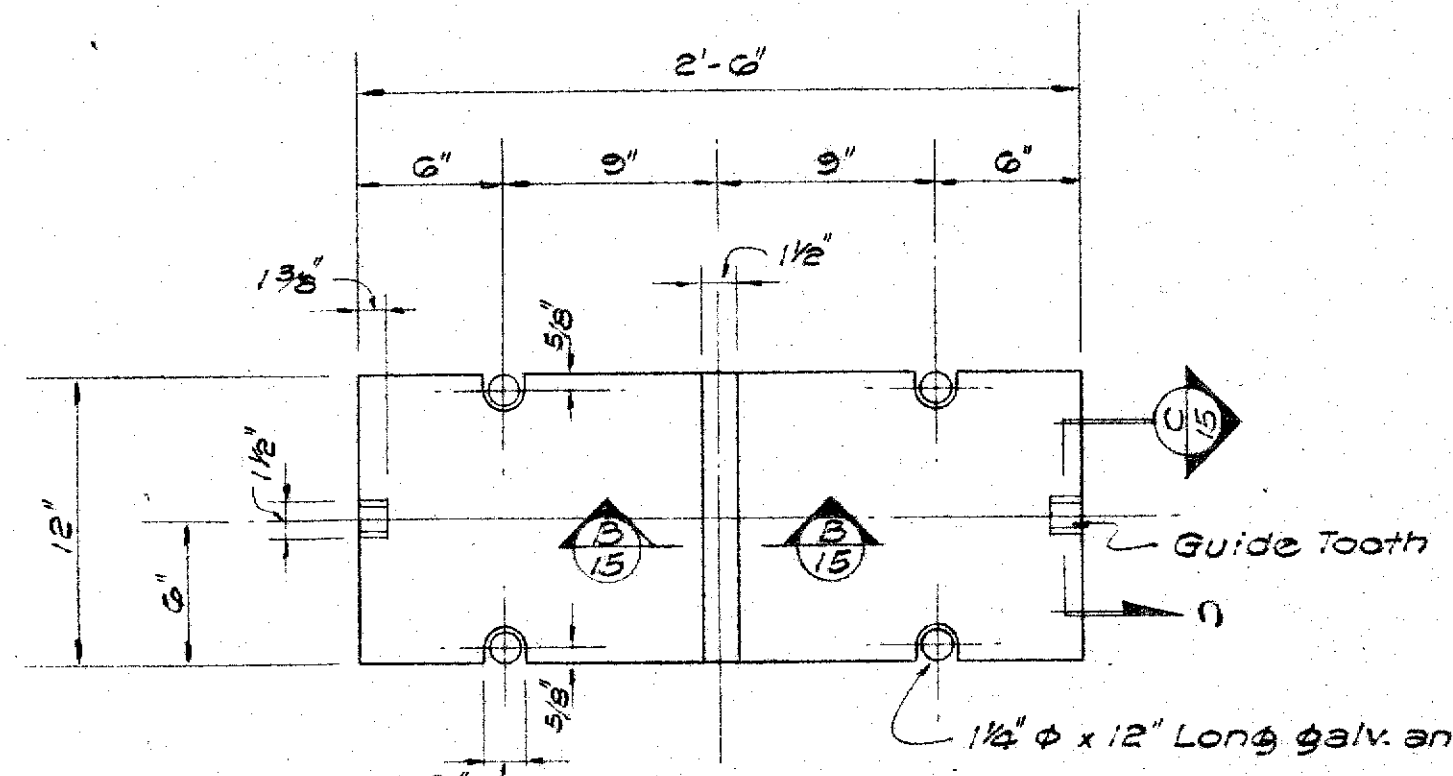


PLAN - MASONRY PLATE
Scale: 1/8" = 1'-0"


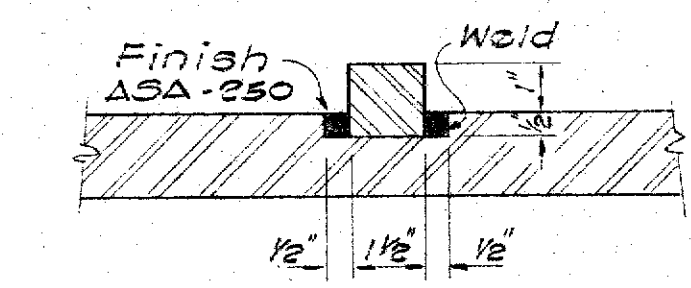


SECTION B-B
Scale: 3/8" = 1'-0"


Shape of guide tooth to be such as to allow a free movement of not less than one inch.

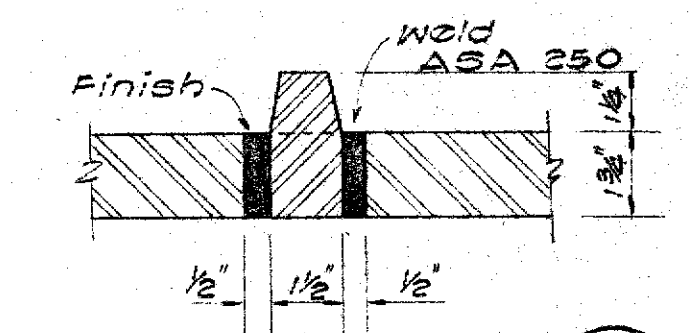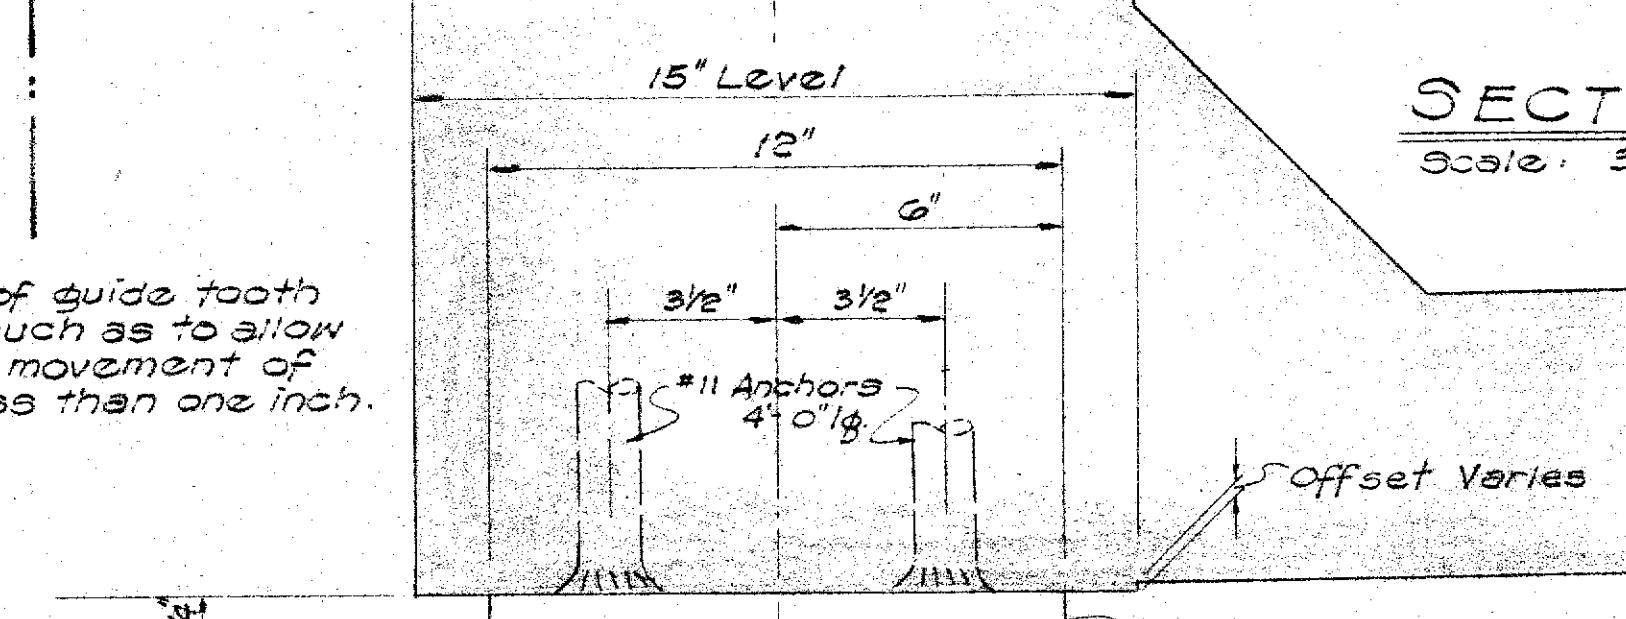


SECTION C-C
Scale: 3/8" = 1'-0"

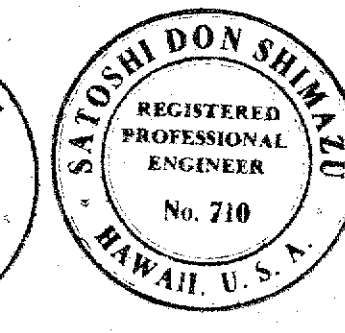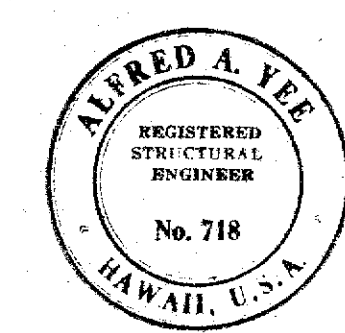

NOTES:
All plates for bearing shall be Structural Carbon Steel ASTM Designation A-7. Rollers shall be Structural Carbon Steel ASTM Designation A235 (Class C-1). They shall be accurately turned to the dimension shown on the drawings and shall be straight, smooth and free from flaws. They shall be forged and annealed prior to machining. The Contractor shall order forgings that are straight and of sufficient size so that the finished roller will be free of flaws and forge marks. Any rollers showing forge marks or flaws shall be rejected. (See Special Provisions) Sole Pl., roller, masonry & and 1/4" x 12" anchor shall be hot-dip galvanized.

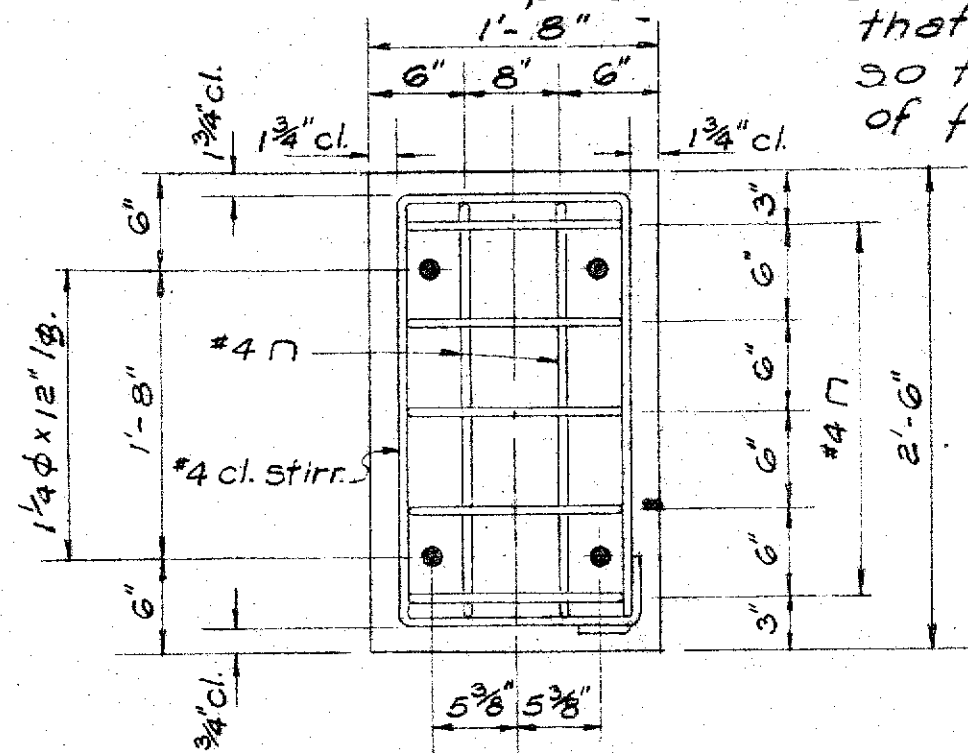

SECTION D-D
Scale: 1" = 1'-0"

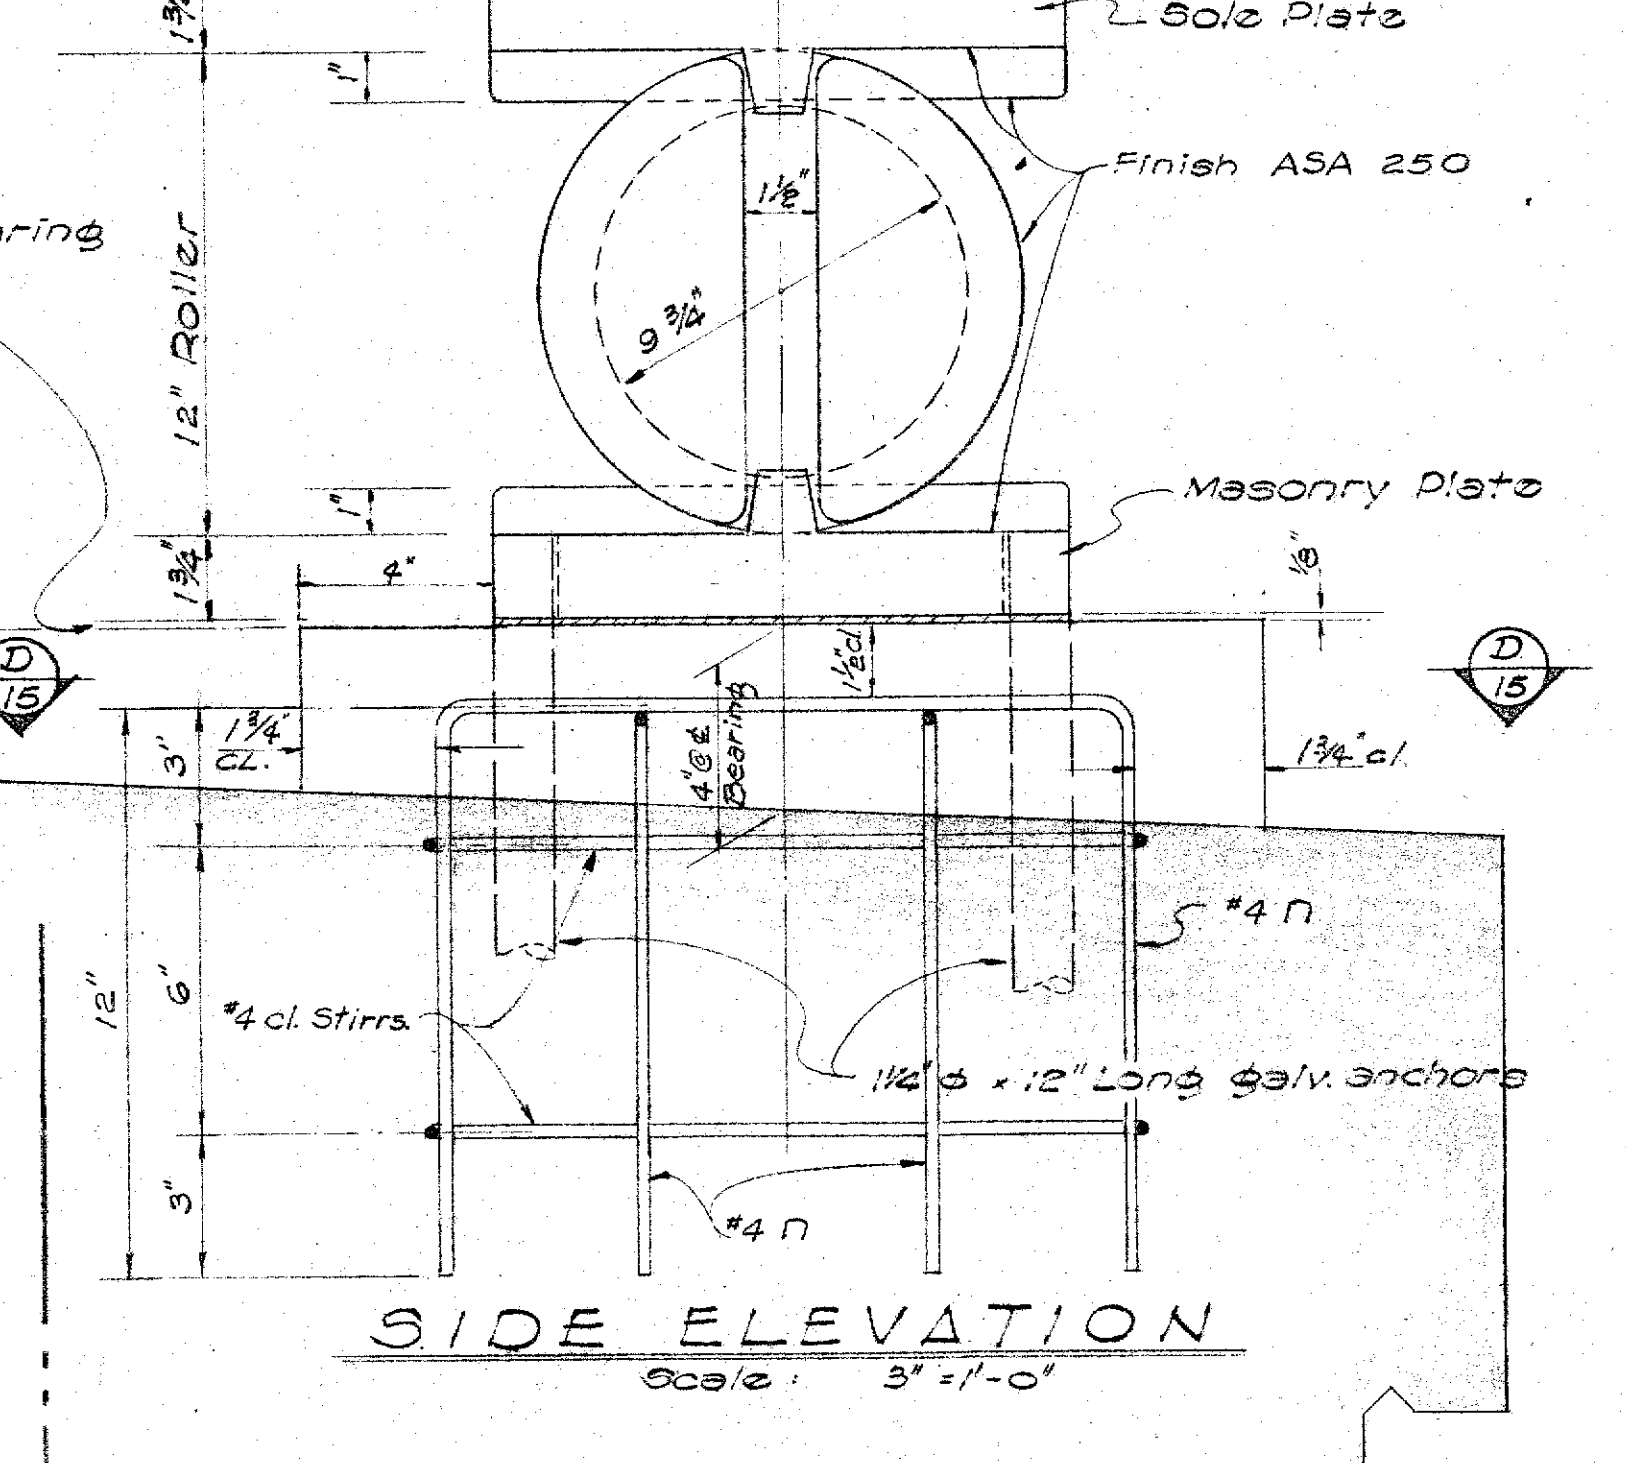

SIDE ELEVATION
Scale: 3/8" = 1'-0"

DETAILS OF EXPANSION BEARING

CONSULTANT SUBMISSION







STATE OF HAWAII
DEPARTMENT OF TRANSPORTATION
HIGHWAYS DIVISION
BRIDGE No. 2
Base Line Sta. 100+23.12 To Sta. 102+50.38
VINEYARD BOULEVARD
PROJECT NO. F-098-1-(3)

SHEET No. 15 OF 16 SHEETS


5928.94

SURVEY PLOTTED BY	DATE
DESIGNED BY	
DRAWN BY	
CHECKED BY	
NOTED BY	
NO. BOOK	
NO.	

FED. ROAD DIST. NO.	STATE	FED. AID PROJ. NO.	FISCAL YEAR	SHEET NO.	TOTAL SHEETS
				16	16

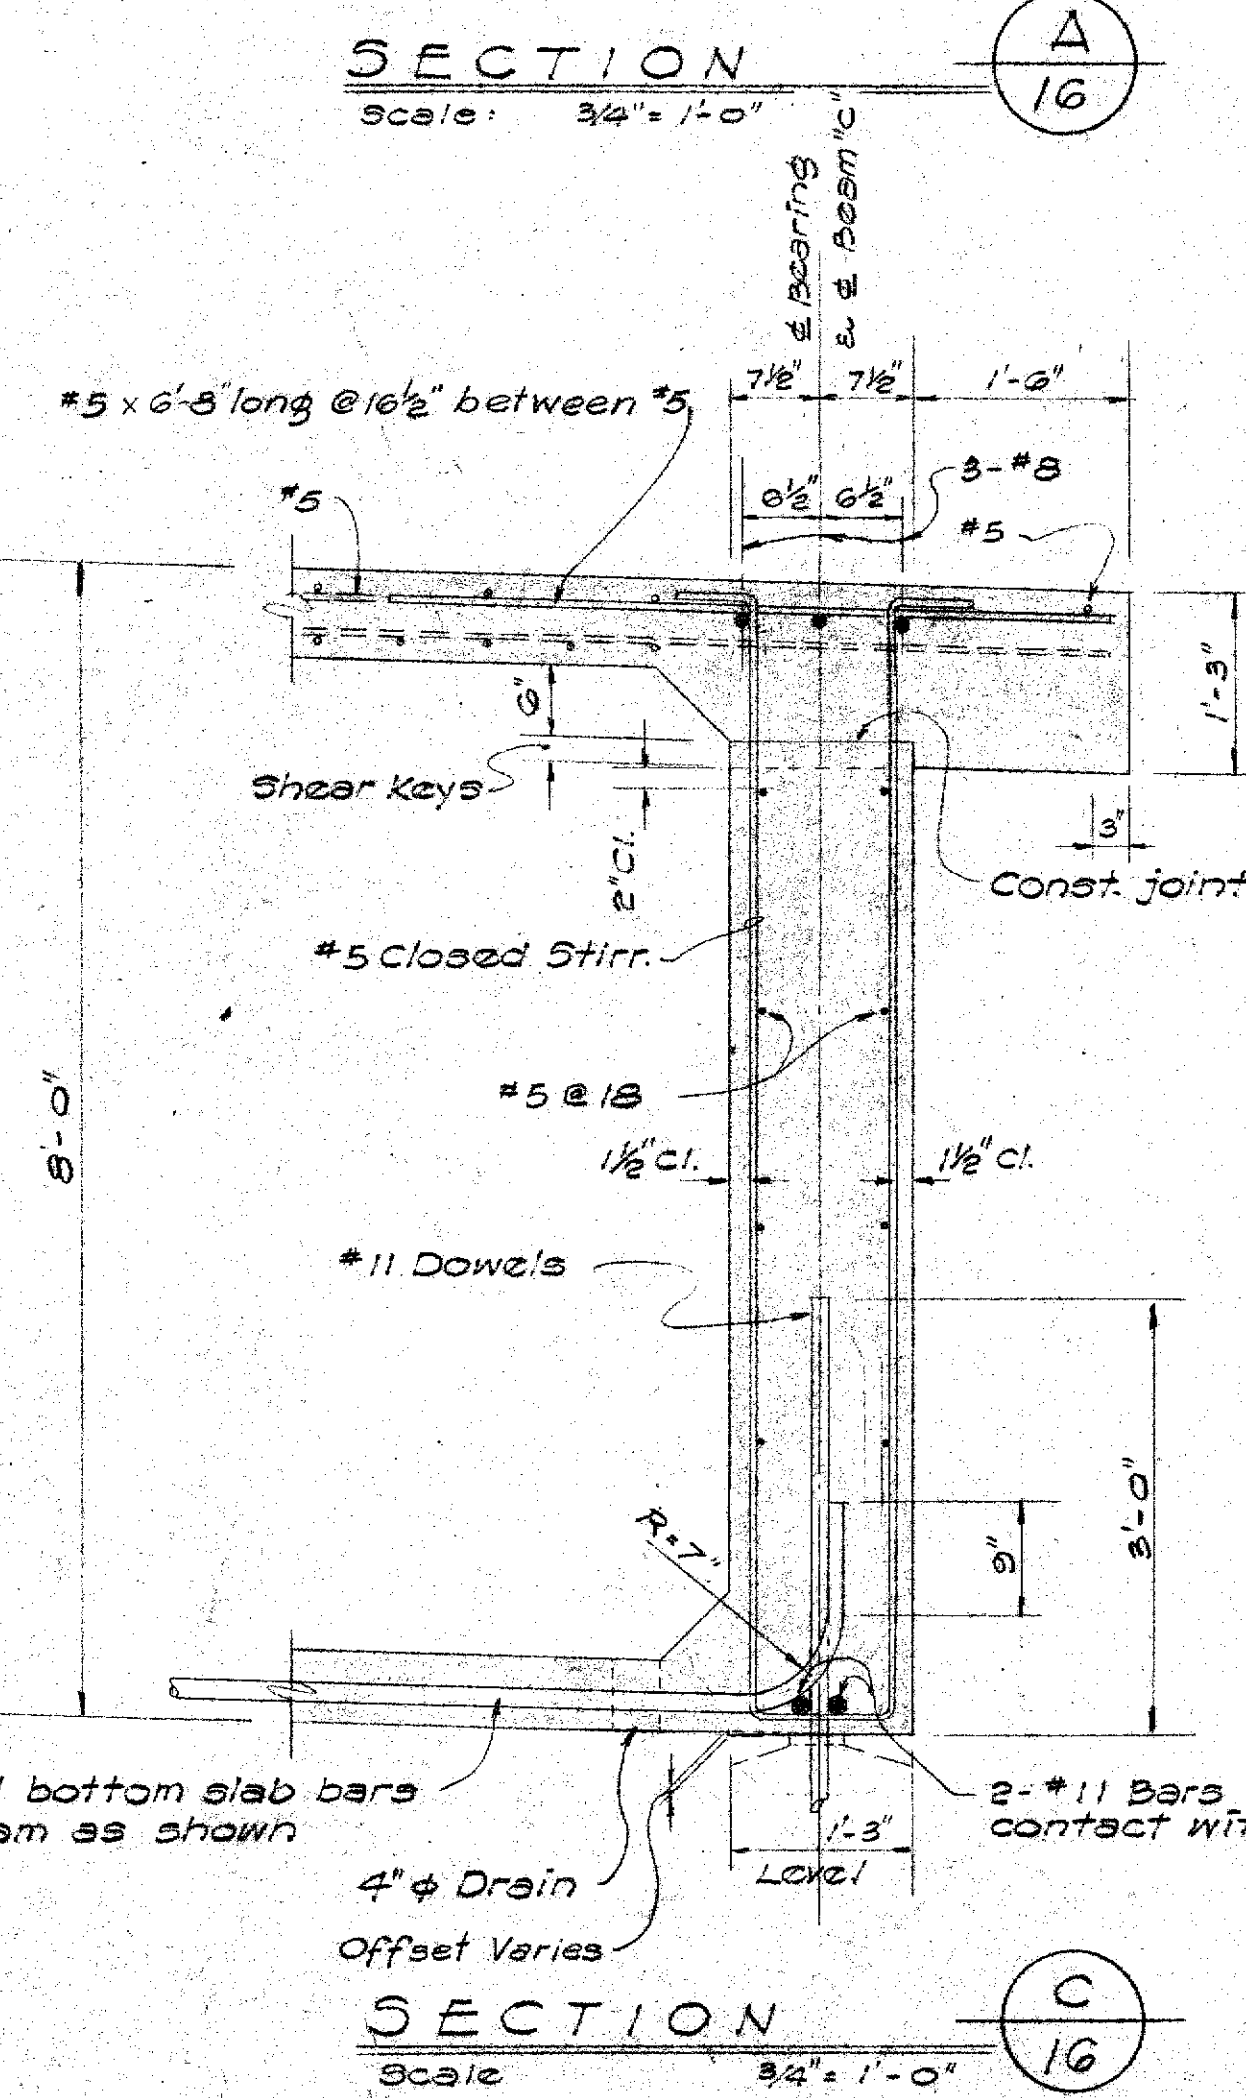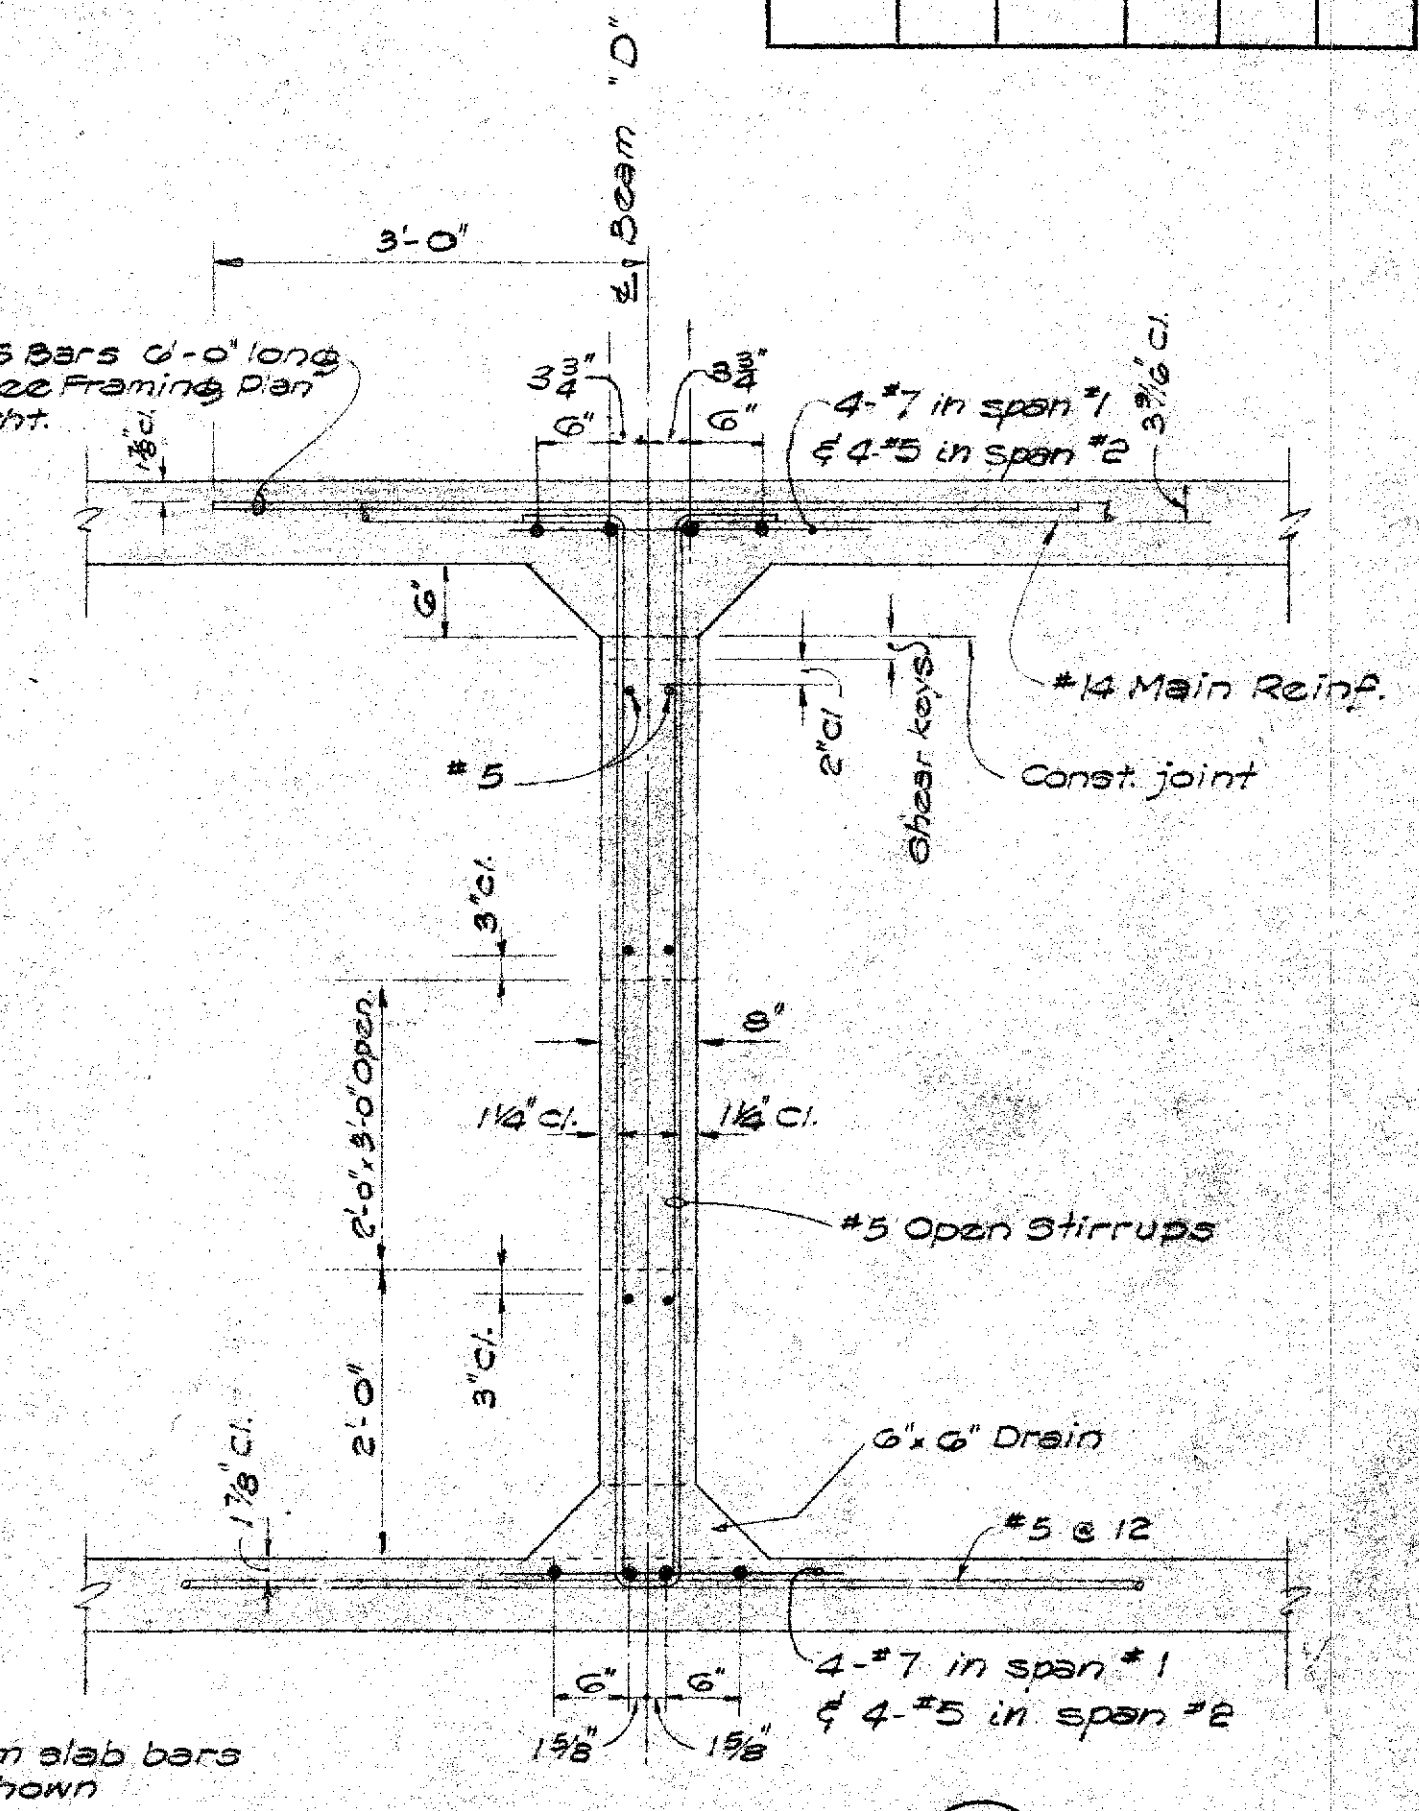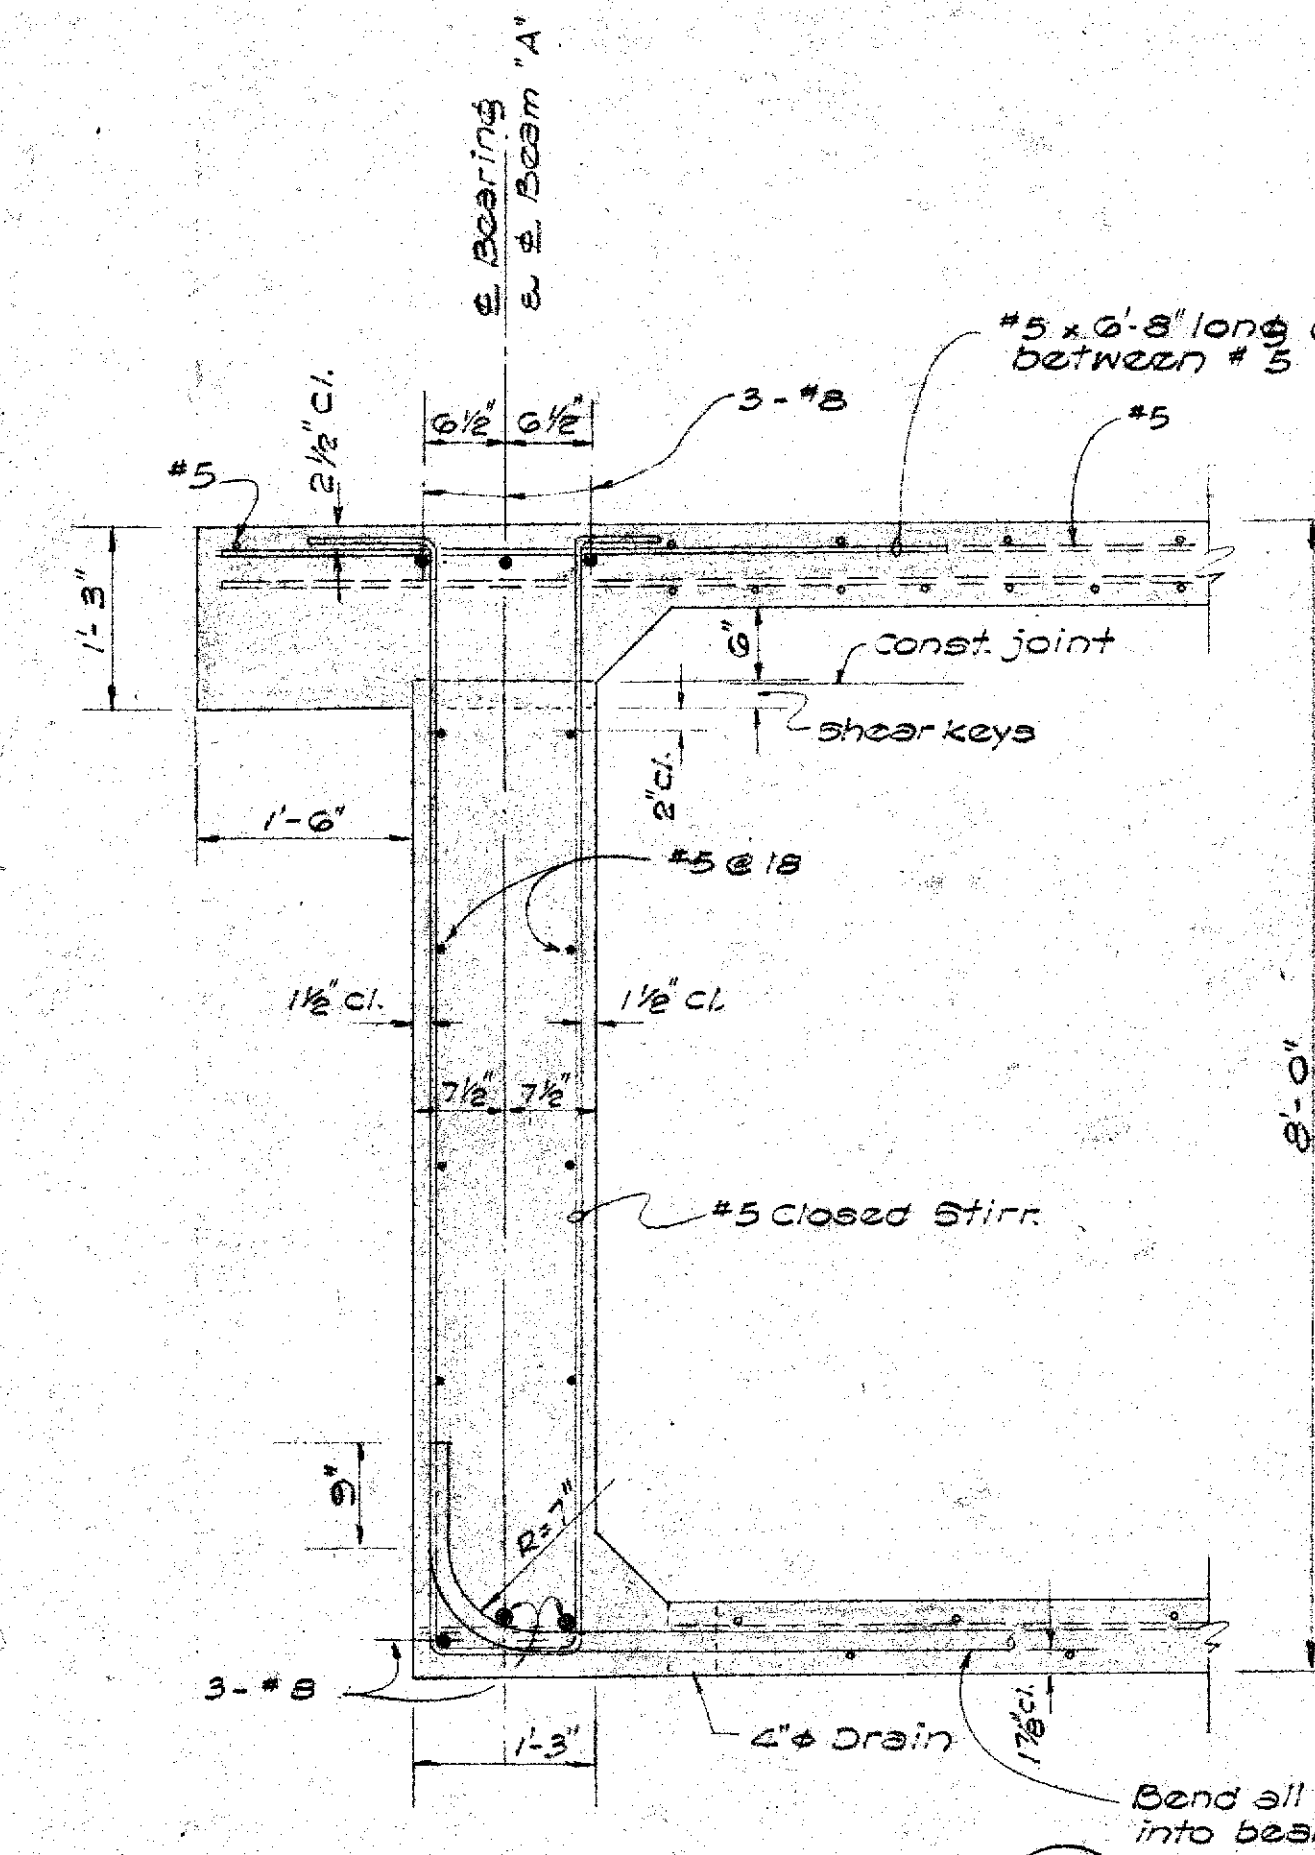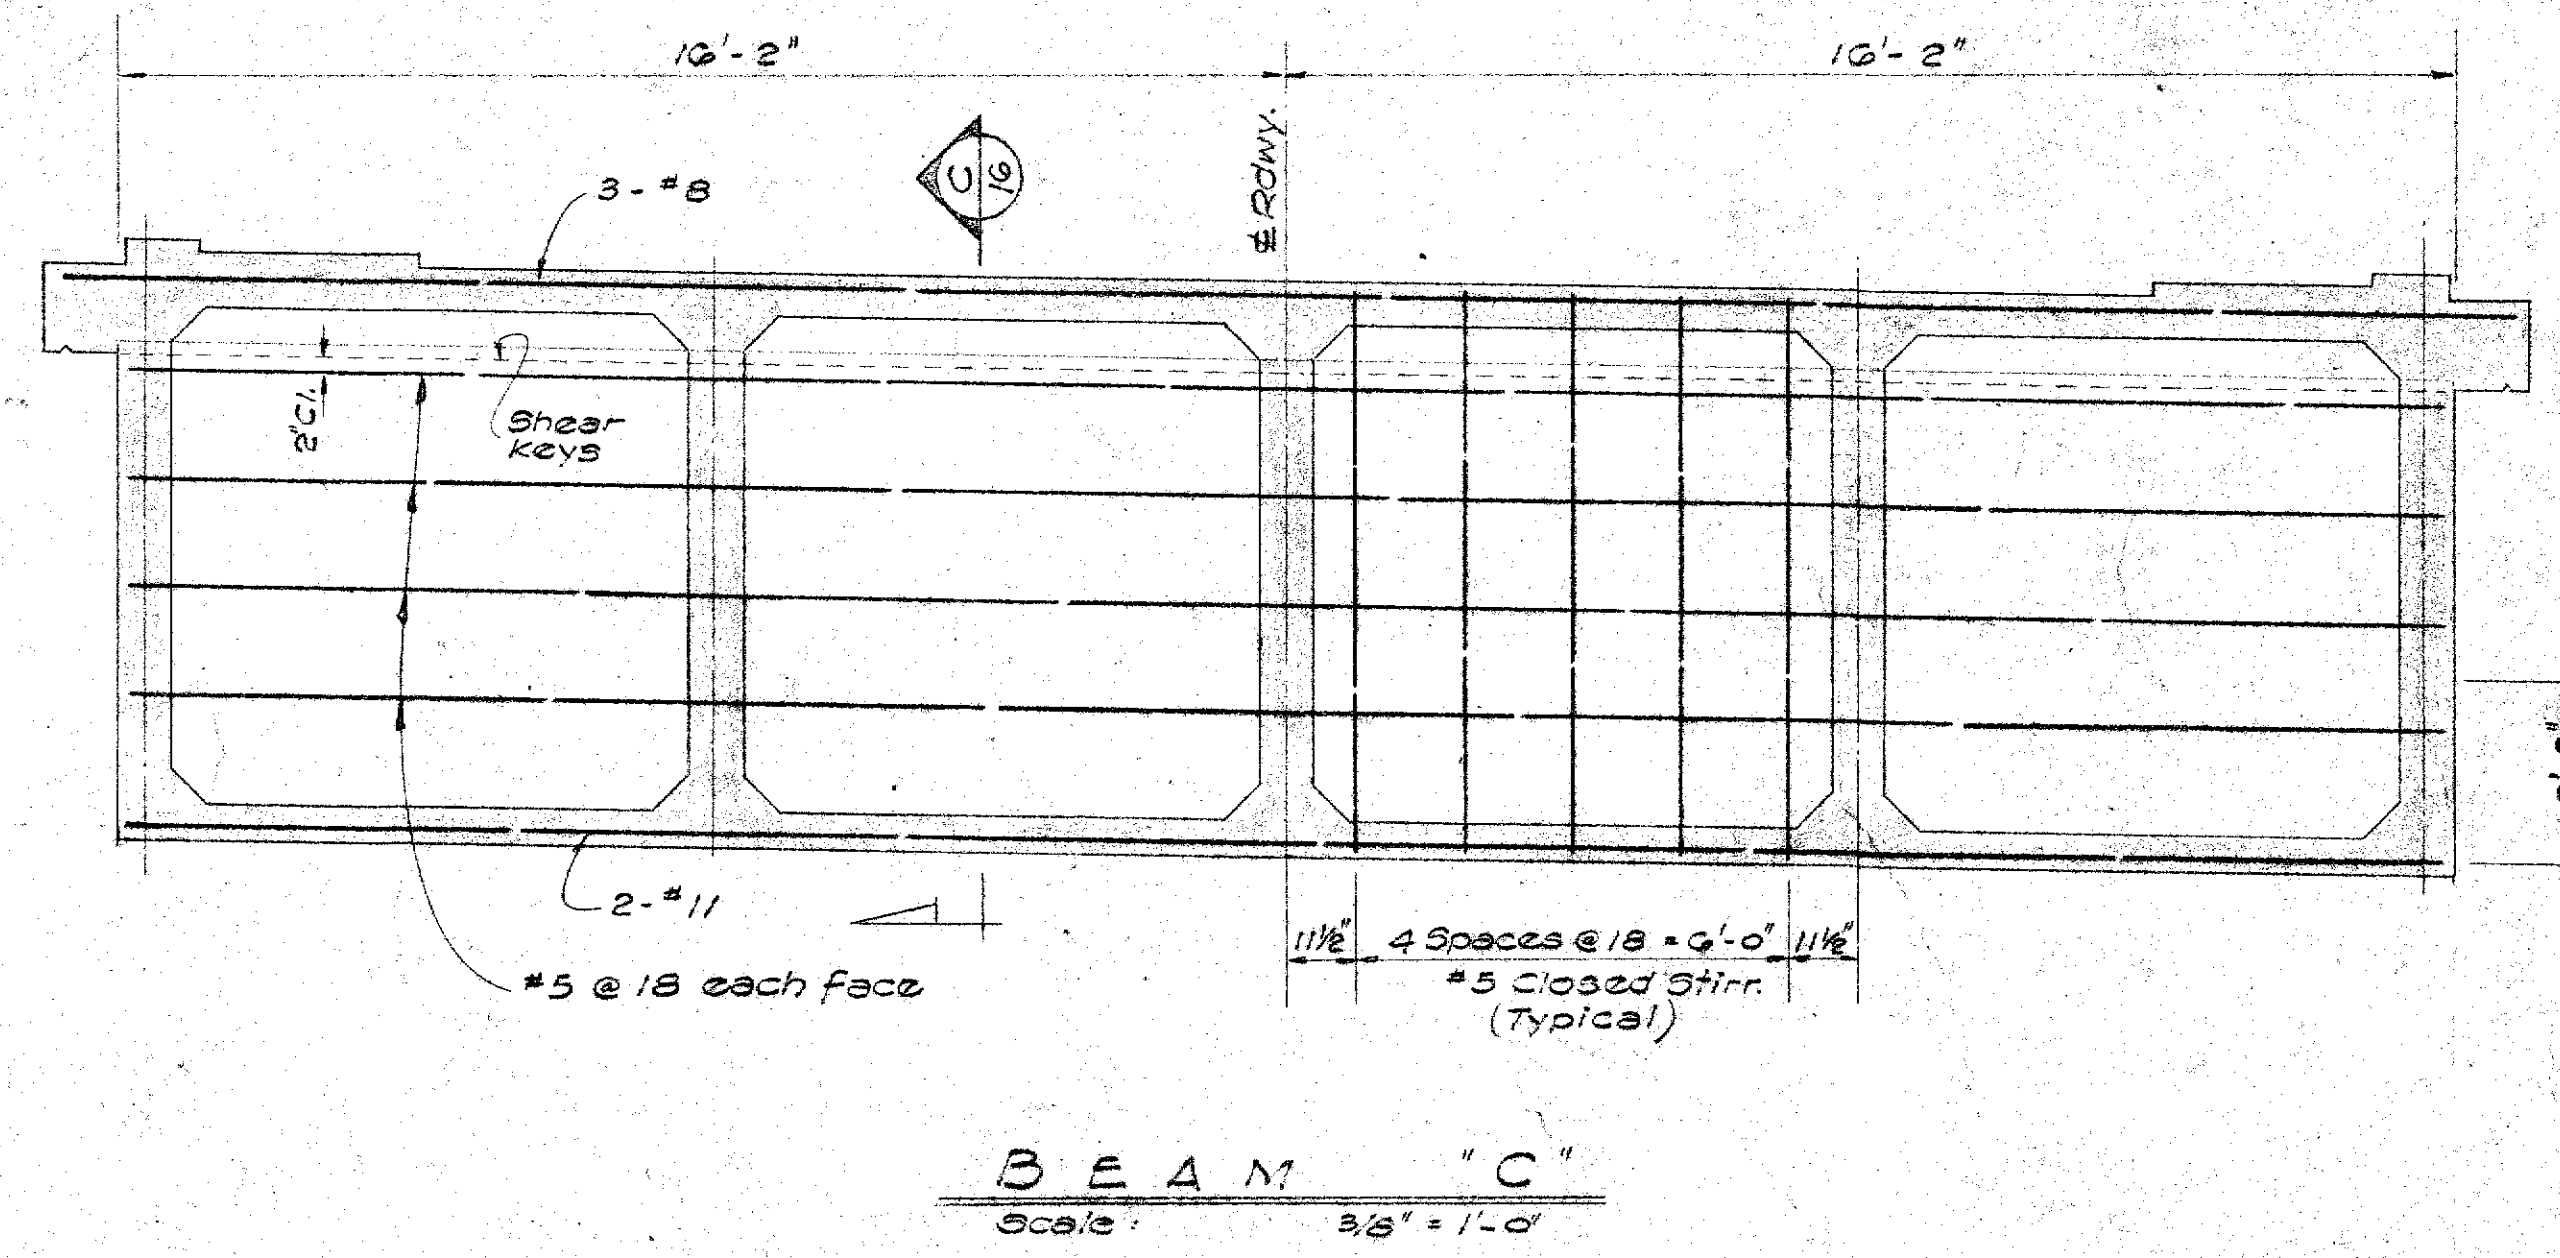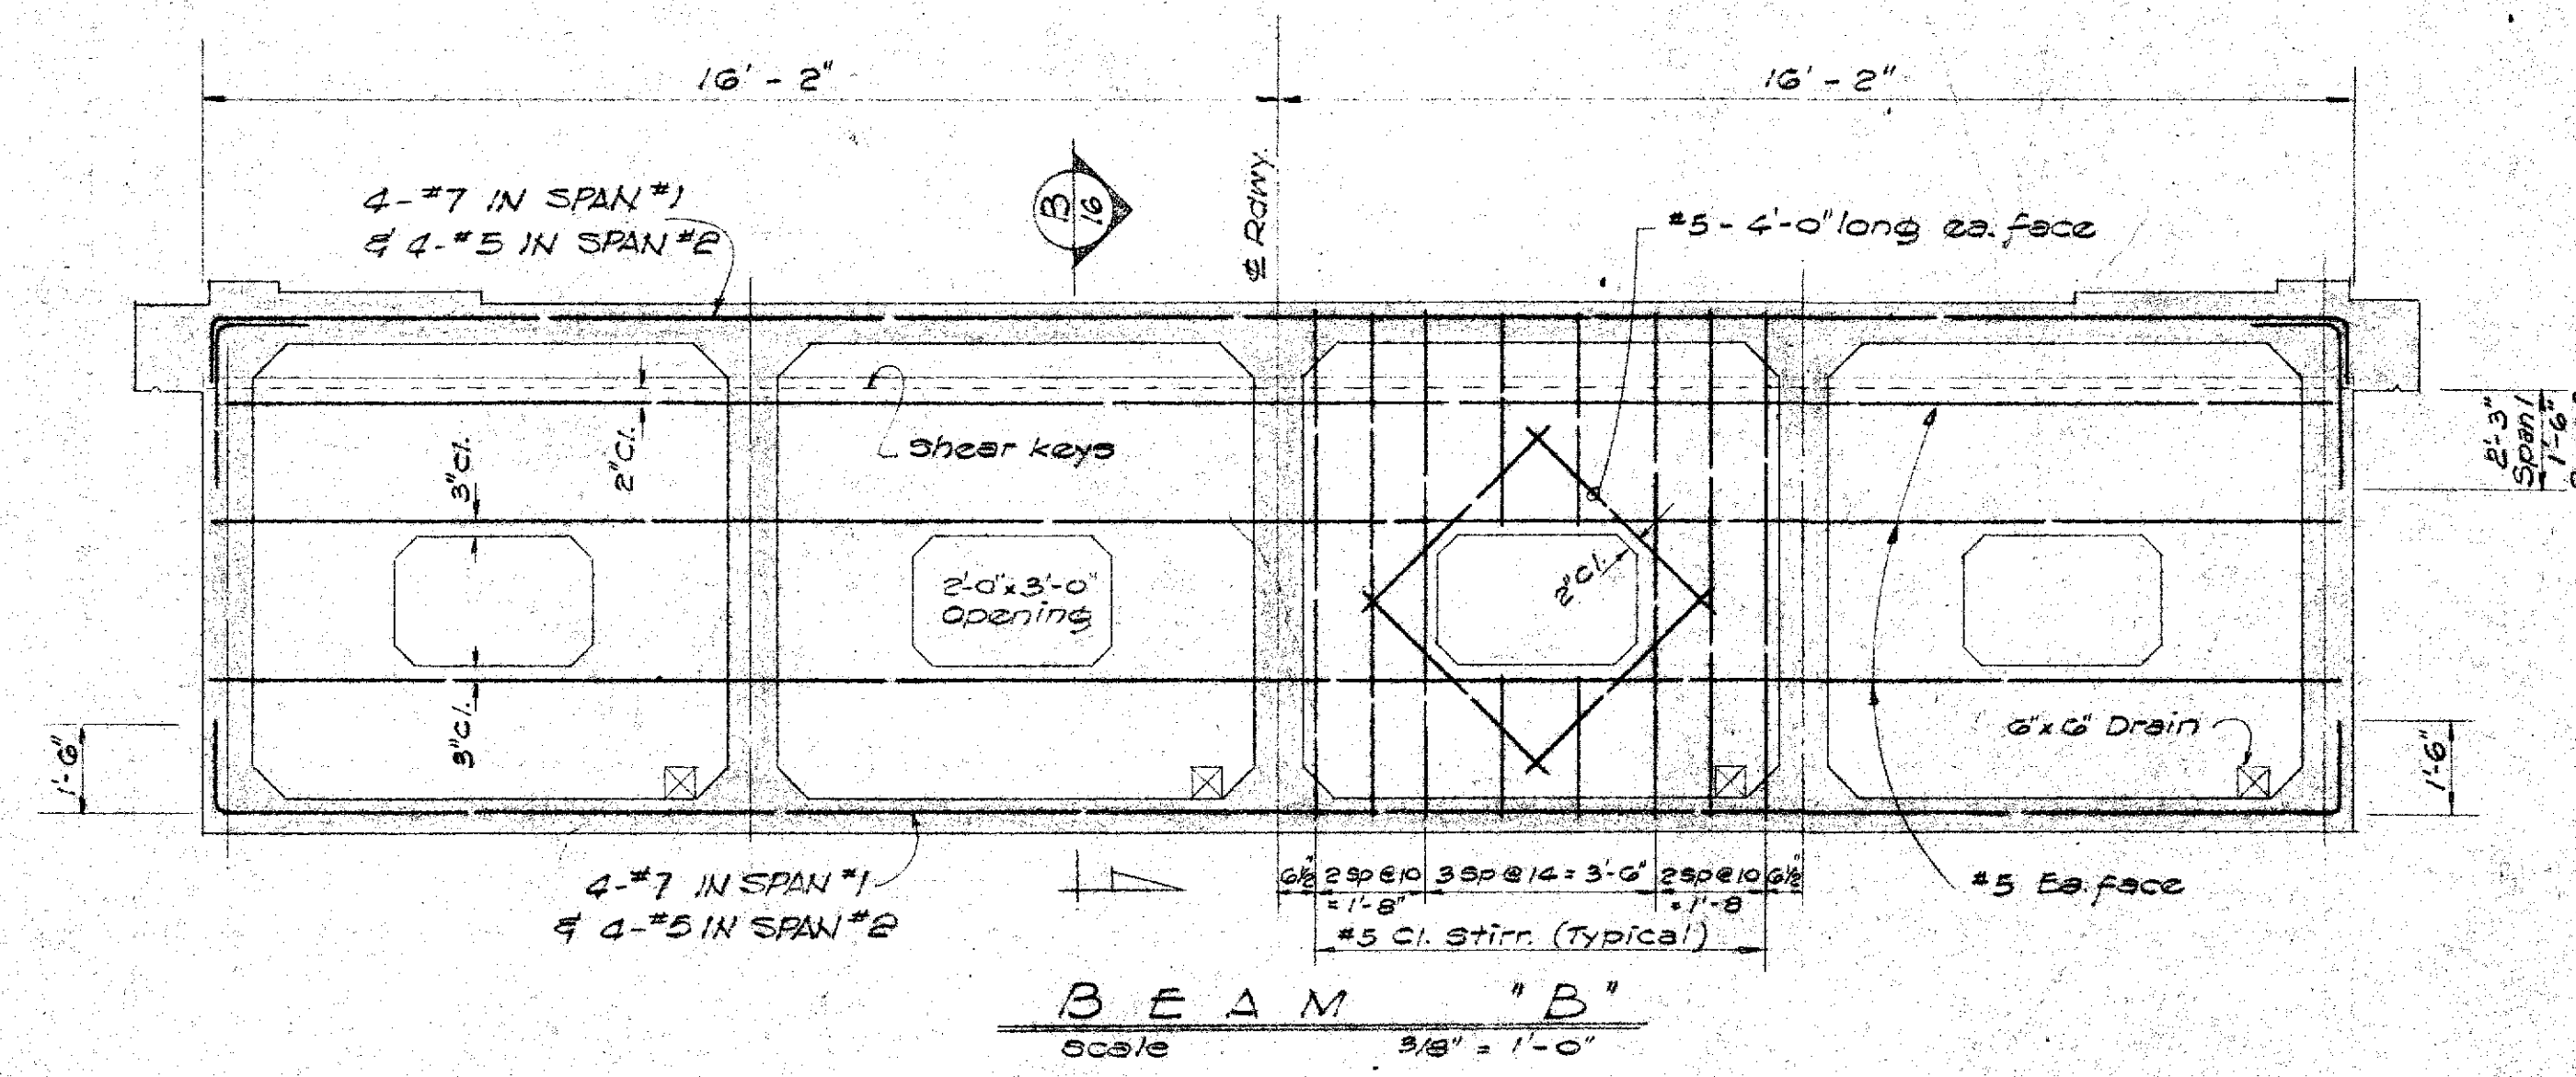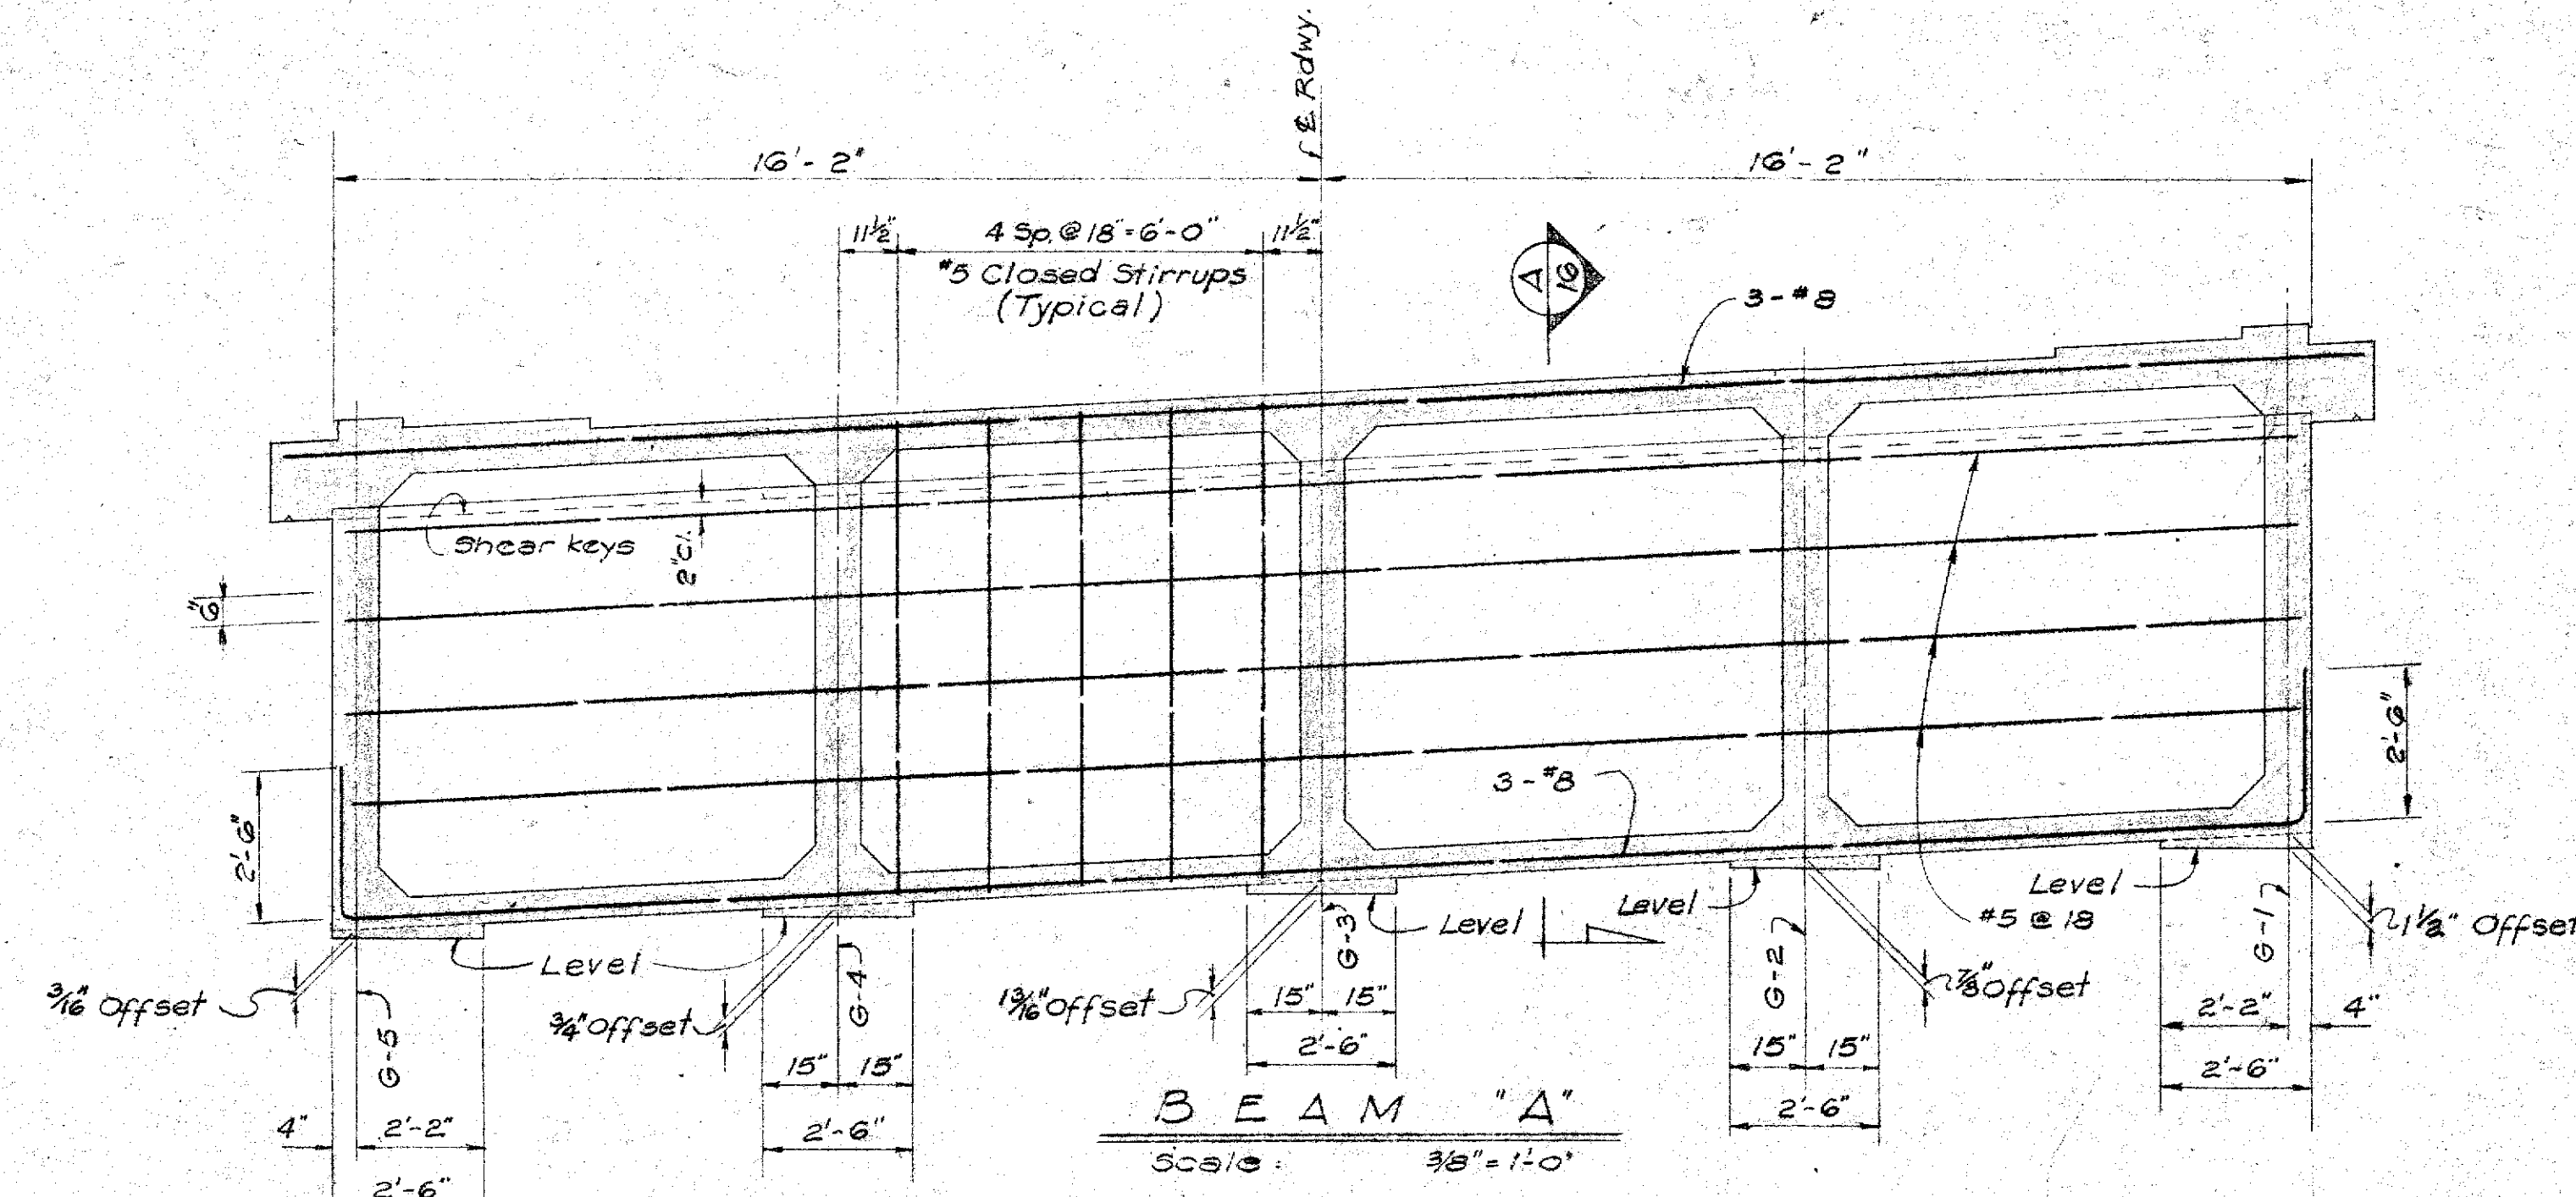

ORIGINAL PLAN	DESIGNED BY	DATE
NOTE BOOK	TRACED BY	
	QUANTITIES BY	
	CHECKED BY	
	CHECKED BY	

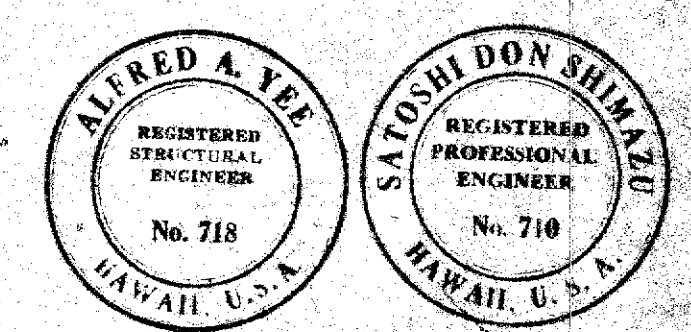

STATE OF HAWAII
DEPARTMENT OF TRANSPORTATION
HIGHWAYS DIVISION
BRIDGE No. 2
Base Line Sta. 160+23.12 to Sta. 162+50.38
VINEYARD BOULEVARD
PROJECT No. F-028-1-1(2)