


FED. ROAD DIST. NO.	STATE	FED. AID PROJ. NO.	FISCAL YEAR	SHEET NO.	TOTAL SHEETS
Hawaii	HAW.	F-098-1(3)			

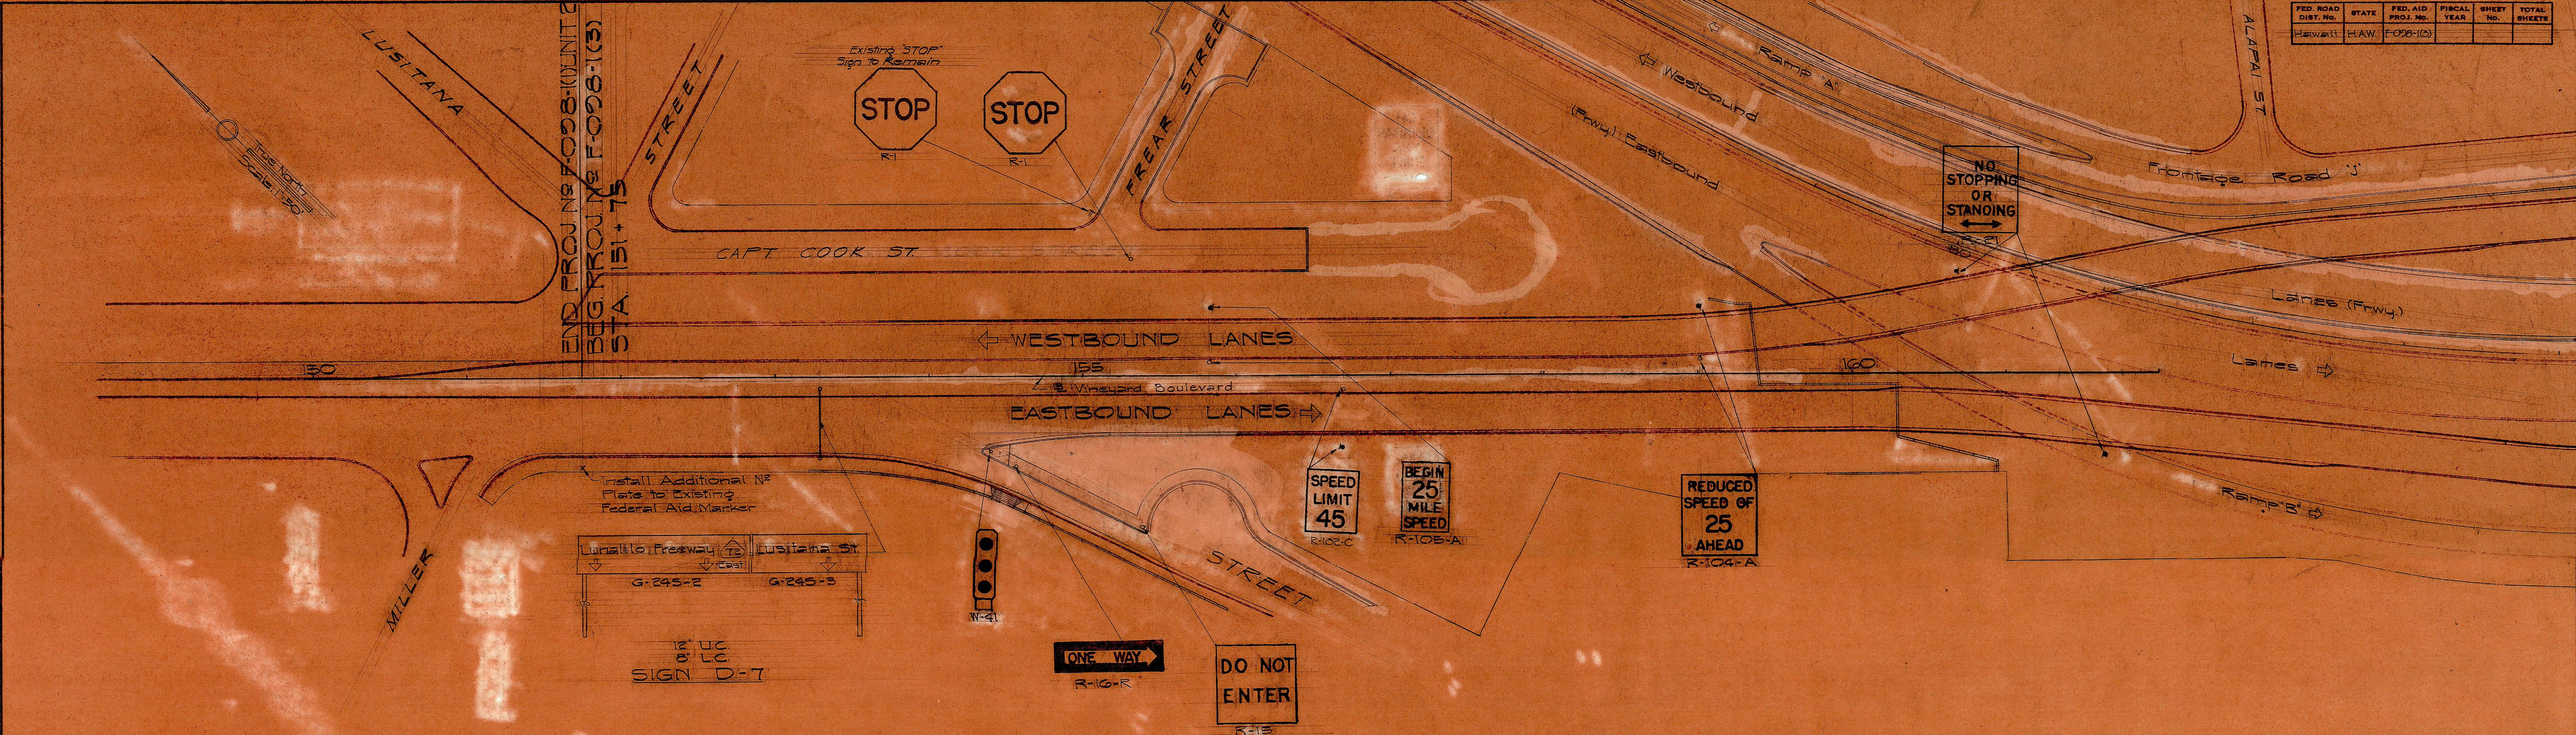

NOTE:
 1. For detail of Sign D-7 See Sheet No. 1372836a N902837
 2. Pavement markings to be by others.

- LEGEND
- b Mounted on G.I. Pipe Post (See Standard Details)
 - o Existing Signs to be relocated.
 - † Relocated Signs
 - Mounted on Highway Lighting Standard
 - Existing Signs to remain.

SUMMARY OF REGULATORY AND WARNING SIGNS

TYPE	MESSAGE	MOUNTED ON			TOTAL REQUIRED	EXIST. SIGNS TO BE RESET	NEW SIGNS REQUIRED
		Walls	G.I. Pipe Post	Highway Lighting Standard			
R-15	Do Not Enter		1		1		1
R-16-R	One Way		1		1		1
R-21	No Stopping or Standing			2	2		2
R-102-C	* Speed Limit 45		1	1	2		
R-104-A	Reduced Speed of 25 Ahead		1	1	2		2
R-105-A	Begin 25 Mile Speed		1	1	2		2
W-36	Merging Traffic		2		2		2
W-41	(Reflectors)		1		1		1
R-1	Stop					1	0

* Not in this contract

ORIGINAL PLAN	DESIGNED BY	DATE
NOTE BOOK NO.	DRAWN BY	
	QUANTITIES CHECKED BY	
	CHECKED BY	

TERRITORIAL HIGHWAY DEPARTMENT
 TERRITORY OF HAWAII
TRAFFIC SIGNS
 VINEYARD BOULEVARD
 MILLER ST. TO LUNALILO FRWY.
 PROJECT NO. F-098-1(3)