
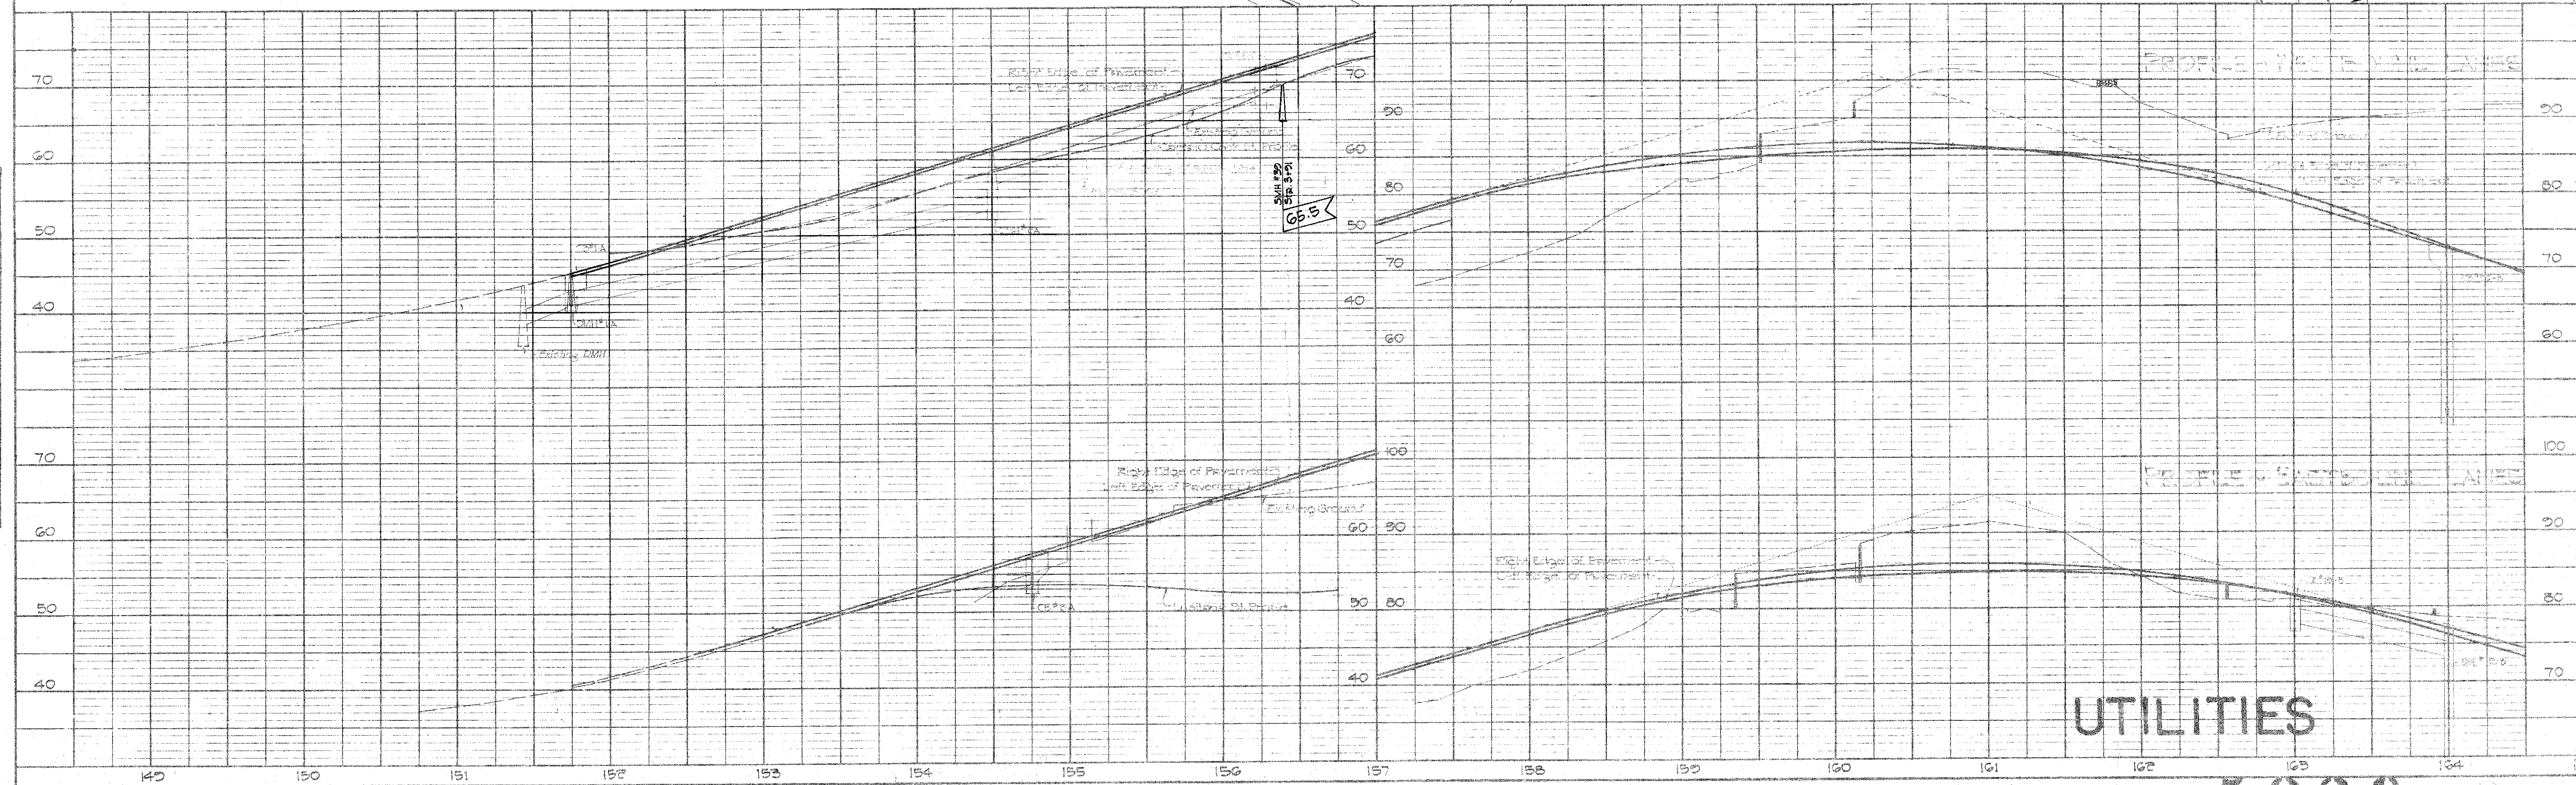


PROFILE	SURVEYED	BY	DATE
NOTE BOOK	PLOTTED		
NO.	GRAPHS CHECKED		
	B. M.'S. NOTED		
	STRUCTURE NOTATIONS CH'KD.		

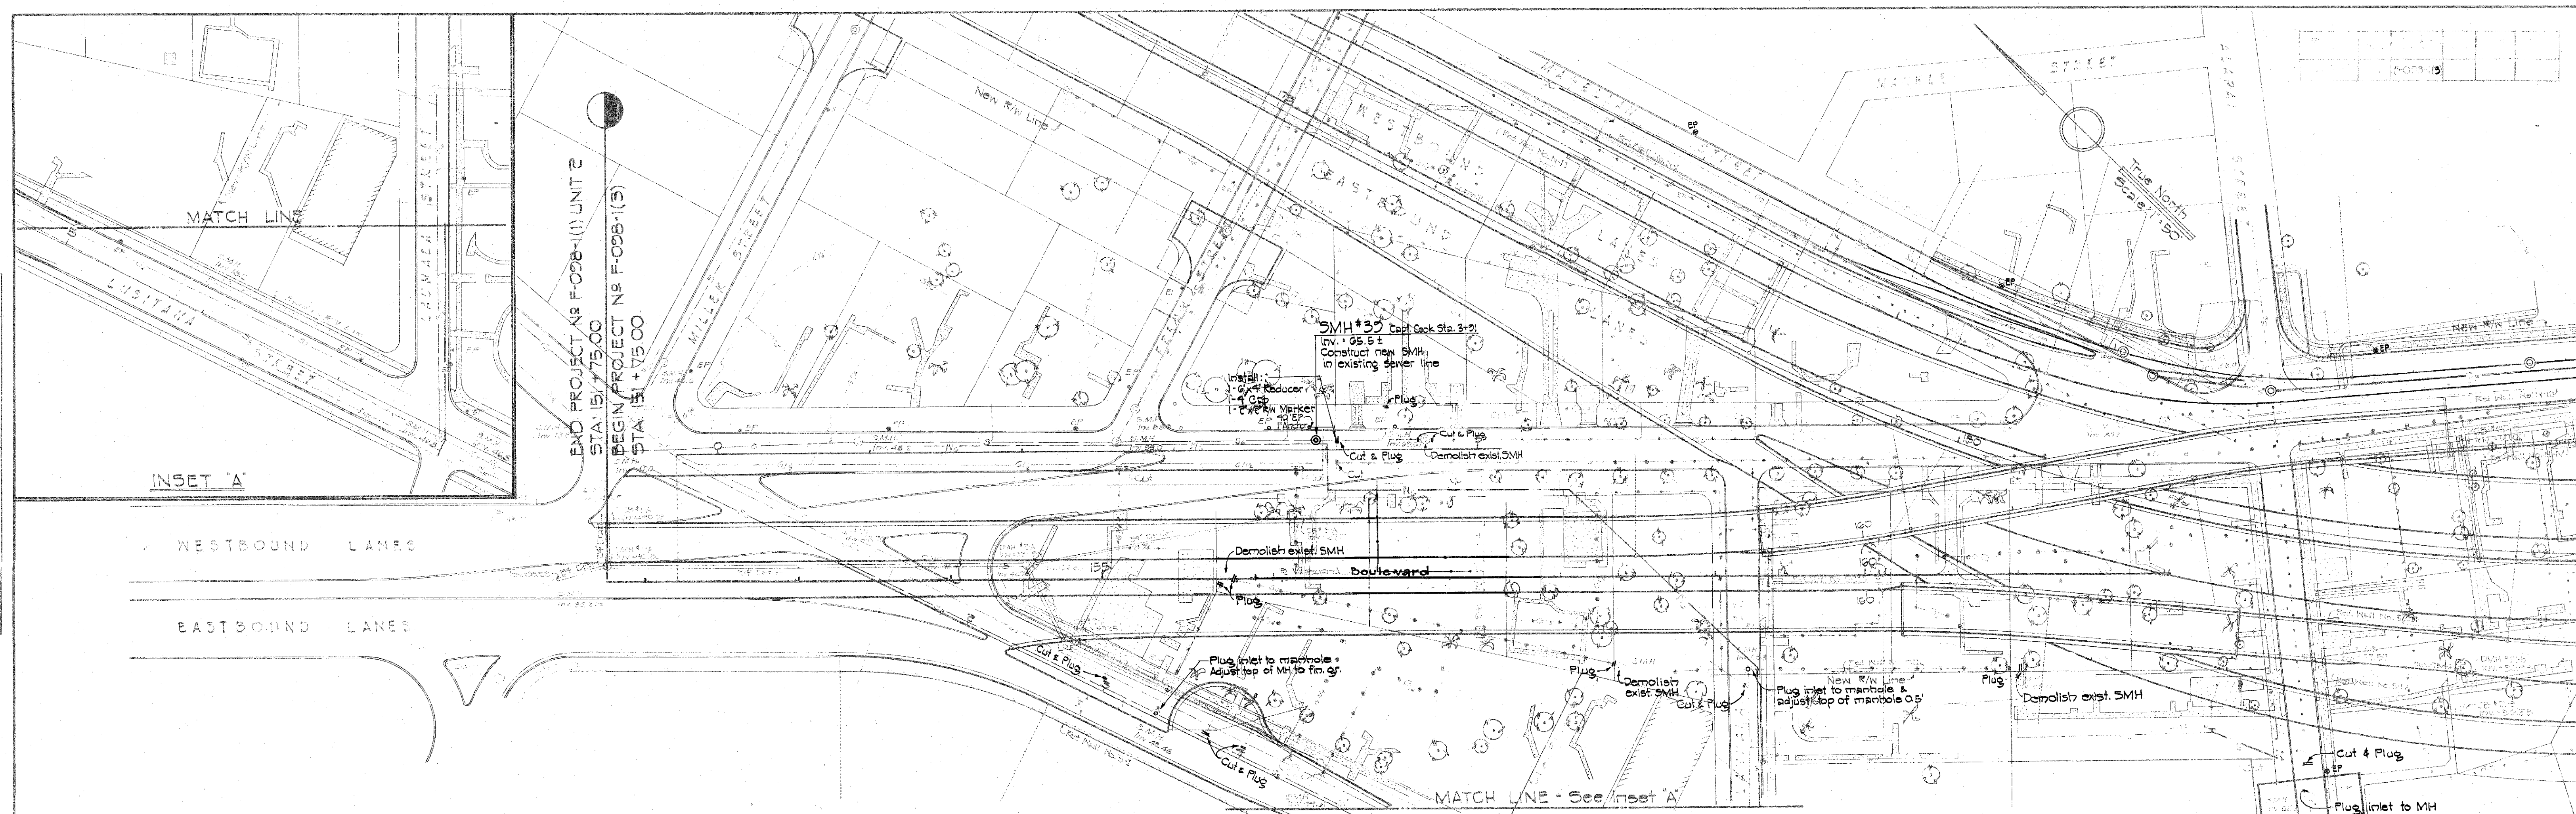

UTILITIES

5928