



Revised 3-9-32

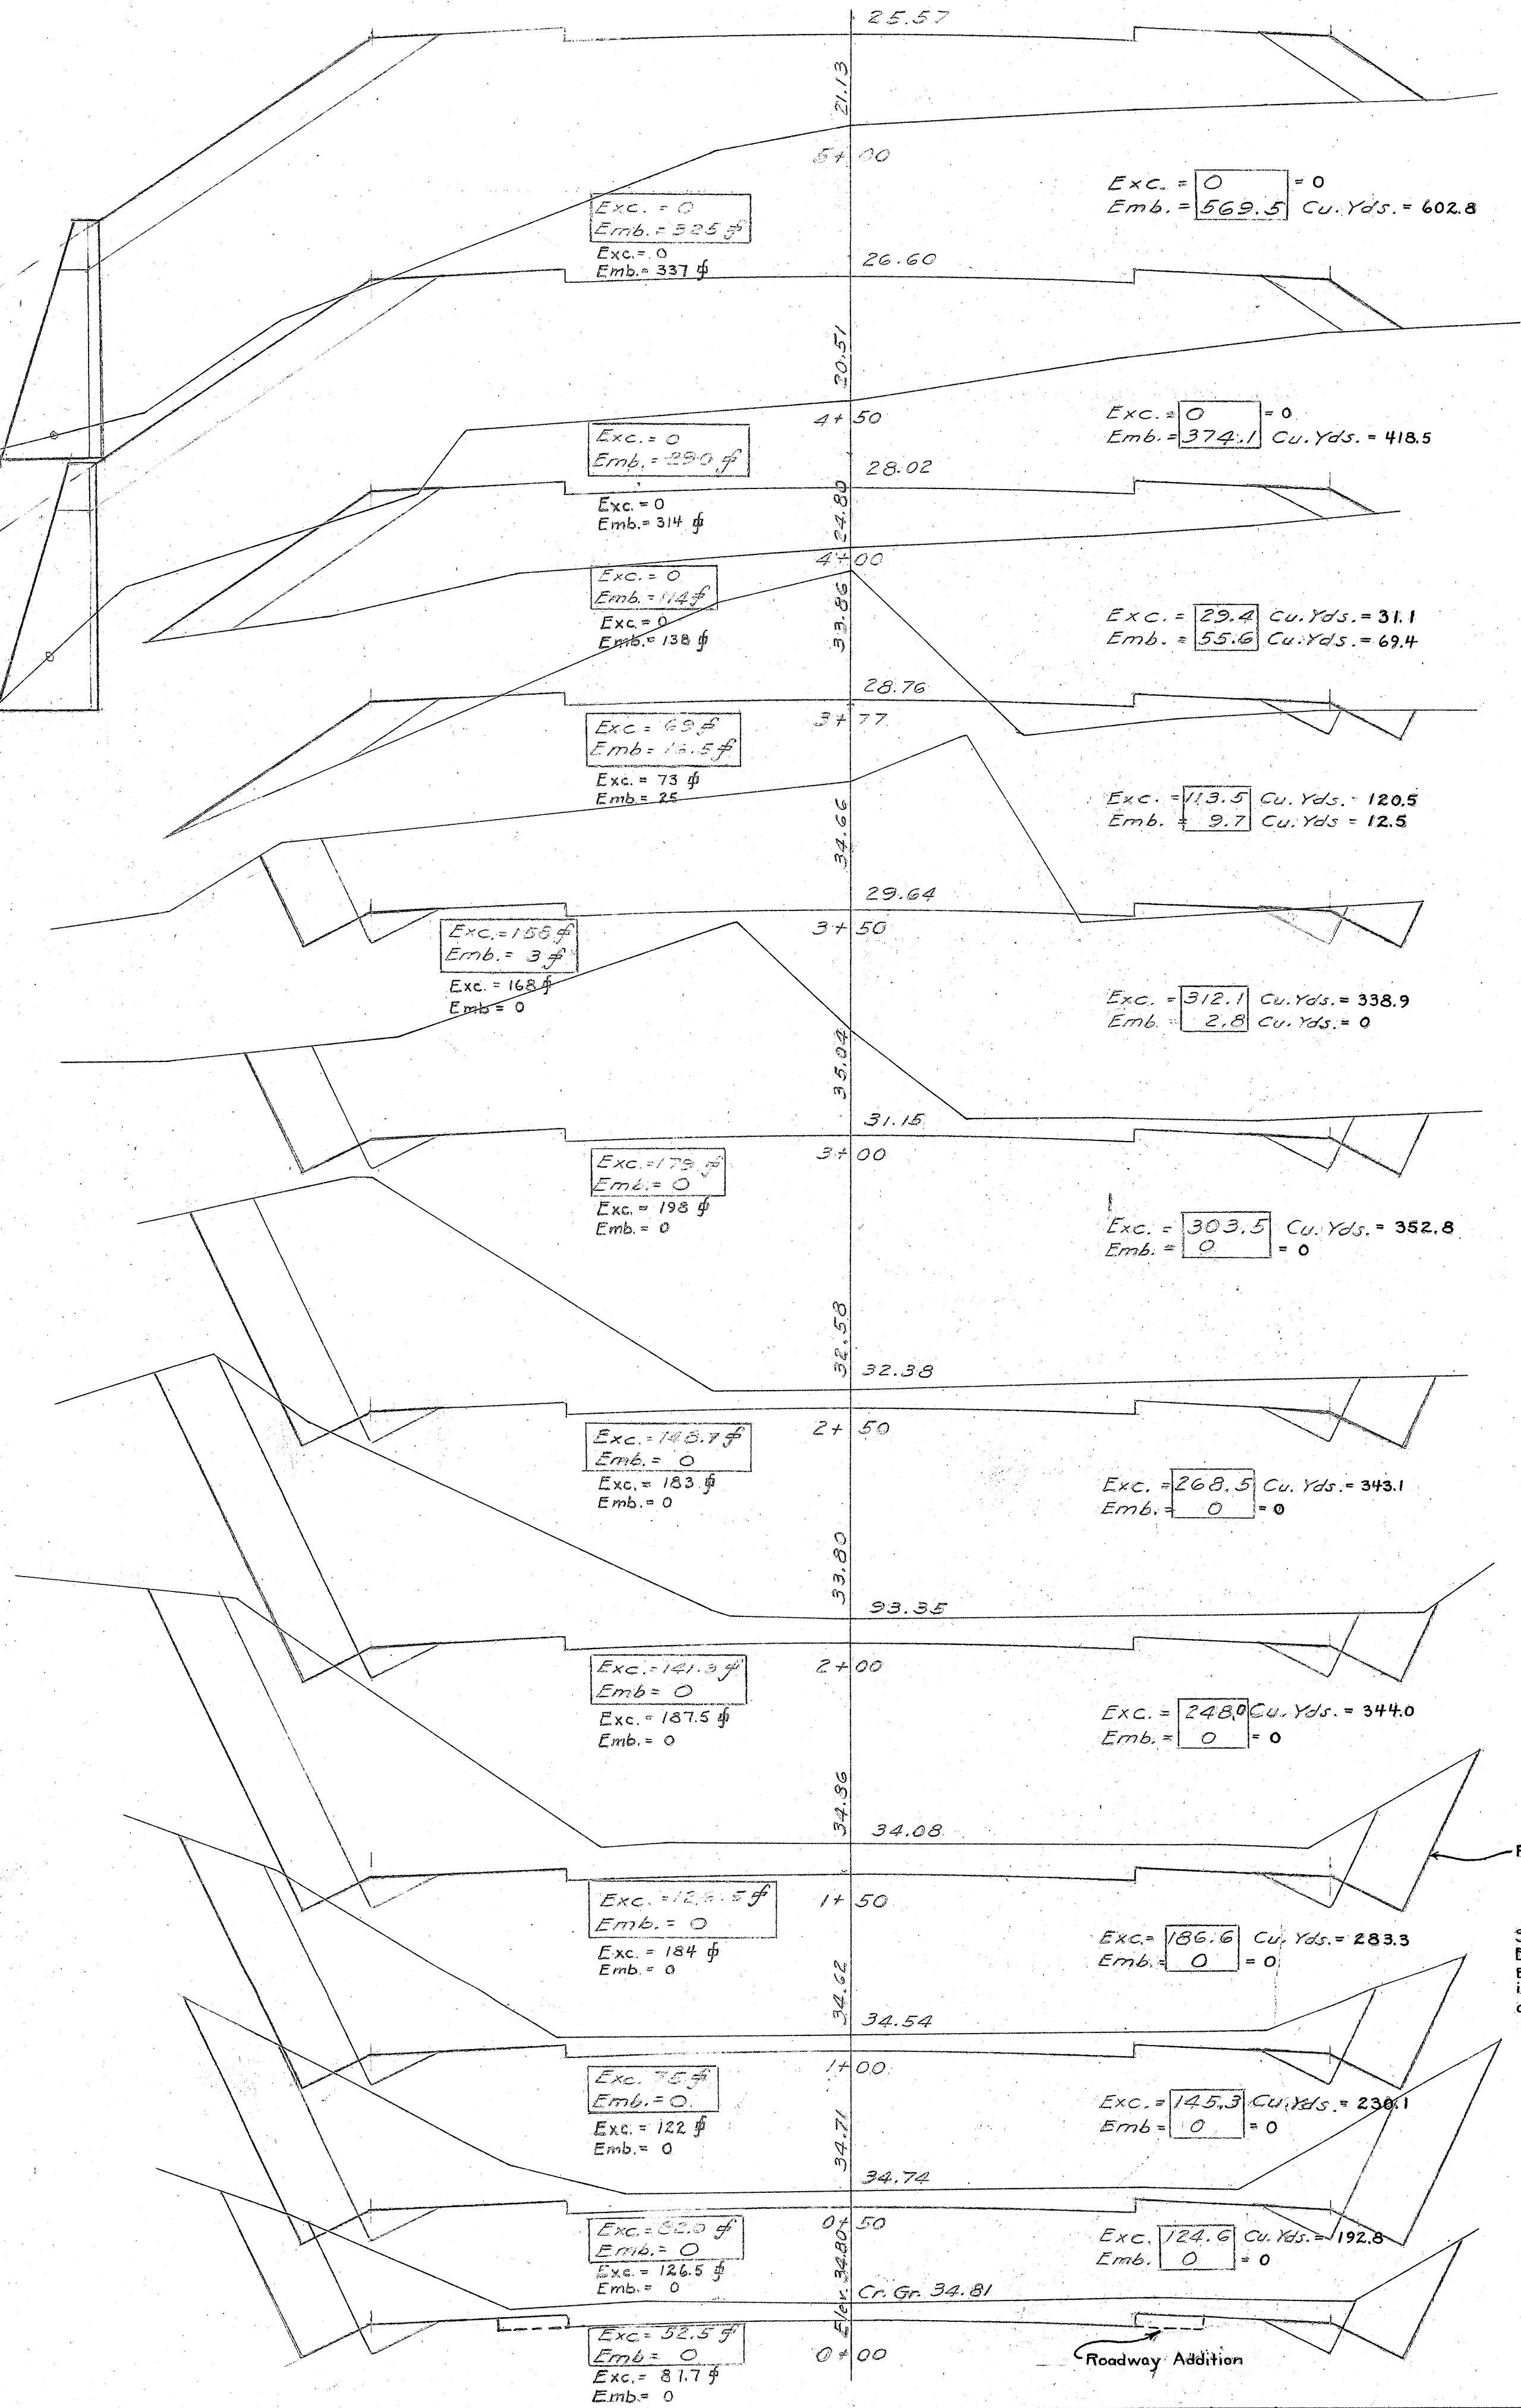

Revised section as of September 1932

Note!
 Sections revised as of September 1932.
 Enclosed figures denote original quantities.
 Broken lines indicate roadway addition. This addition is not shown on every section but is included in computations of quantities for every section.

Roadway Addition

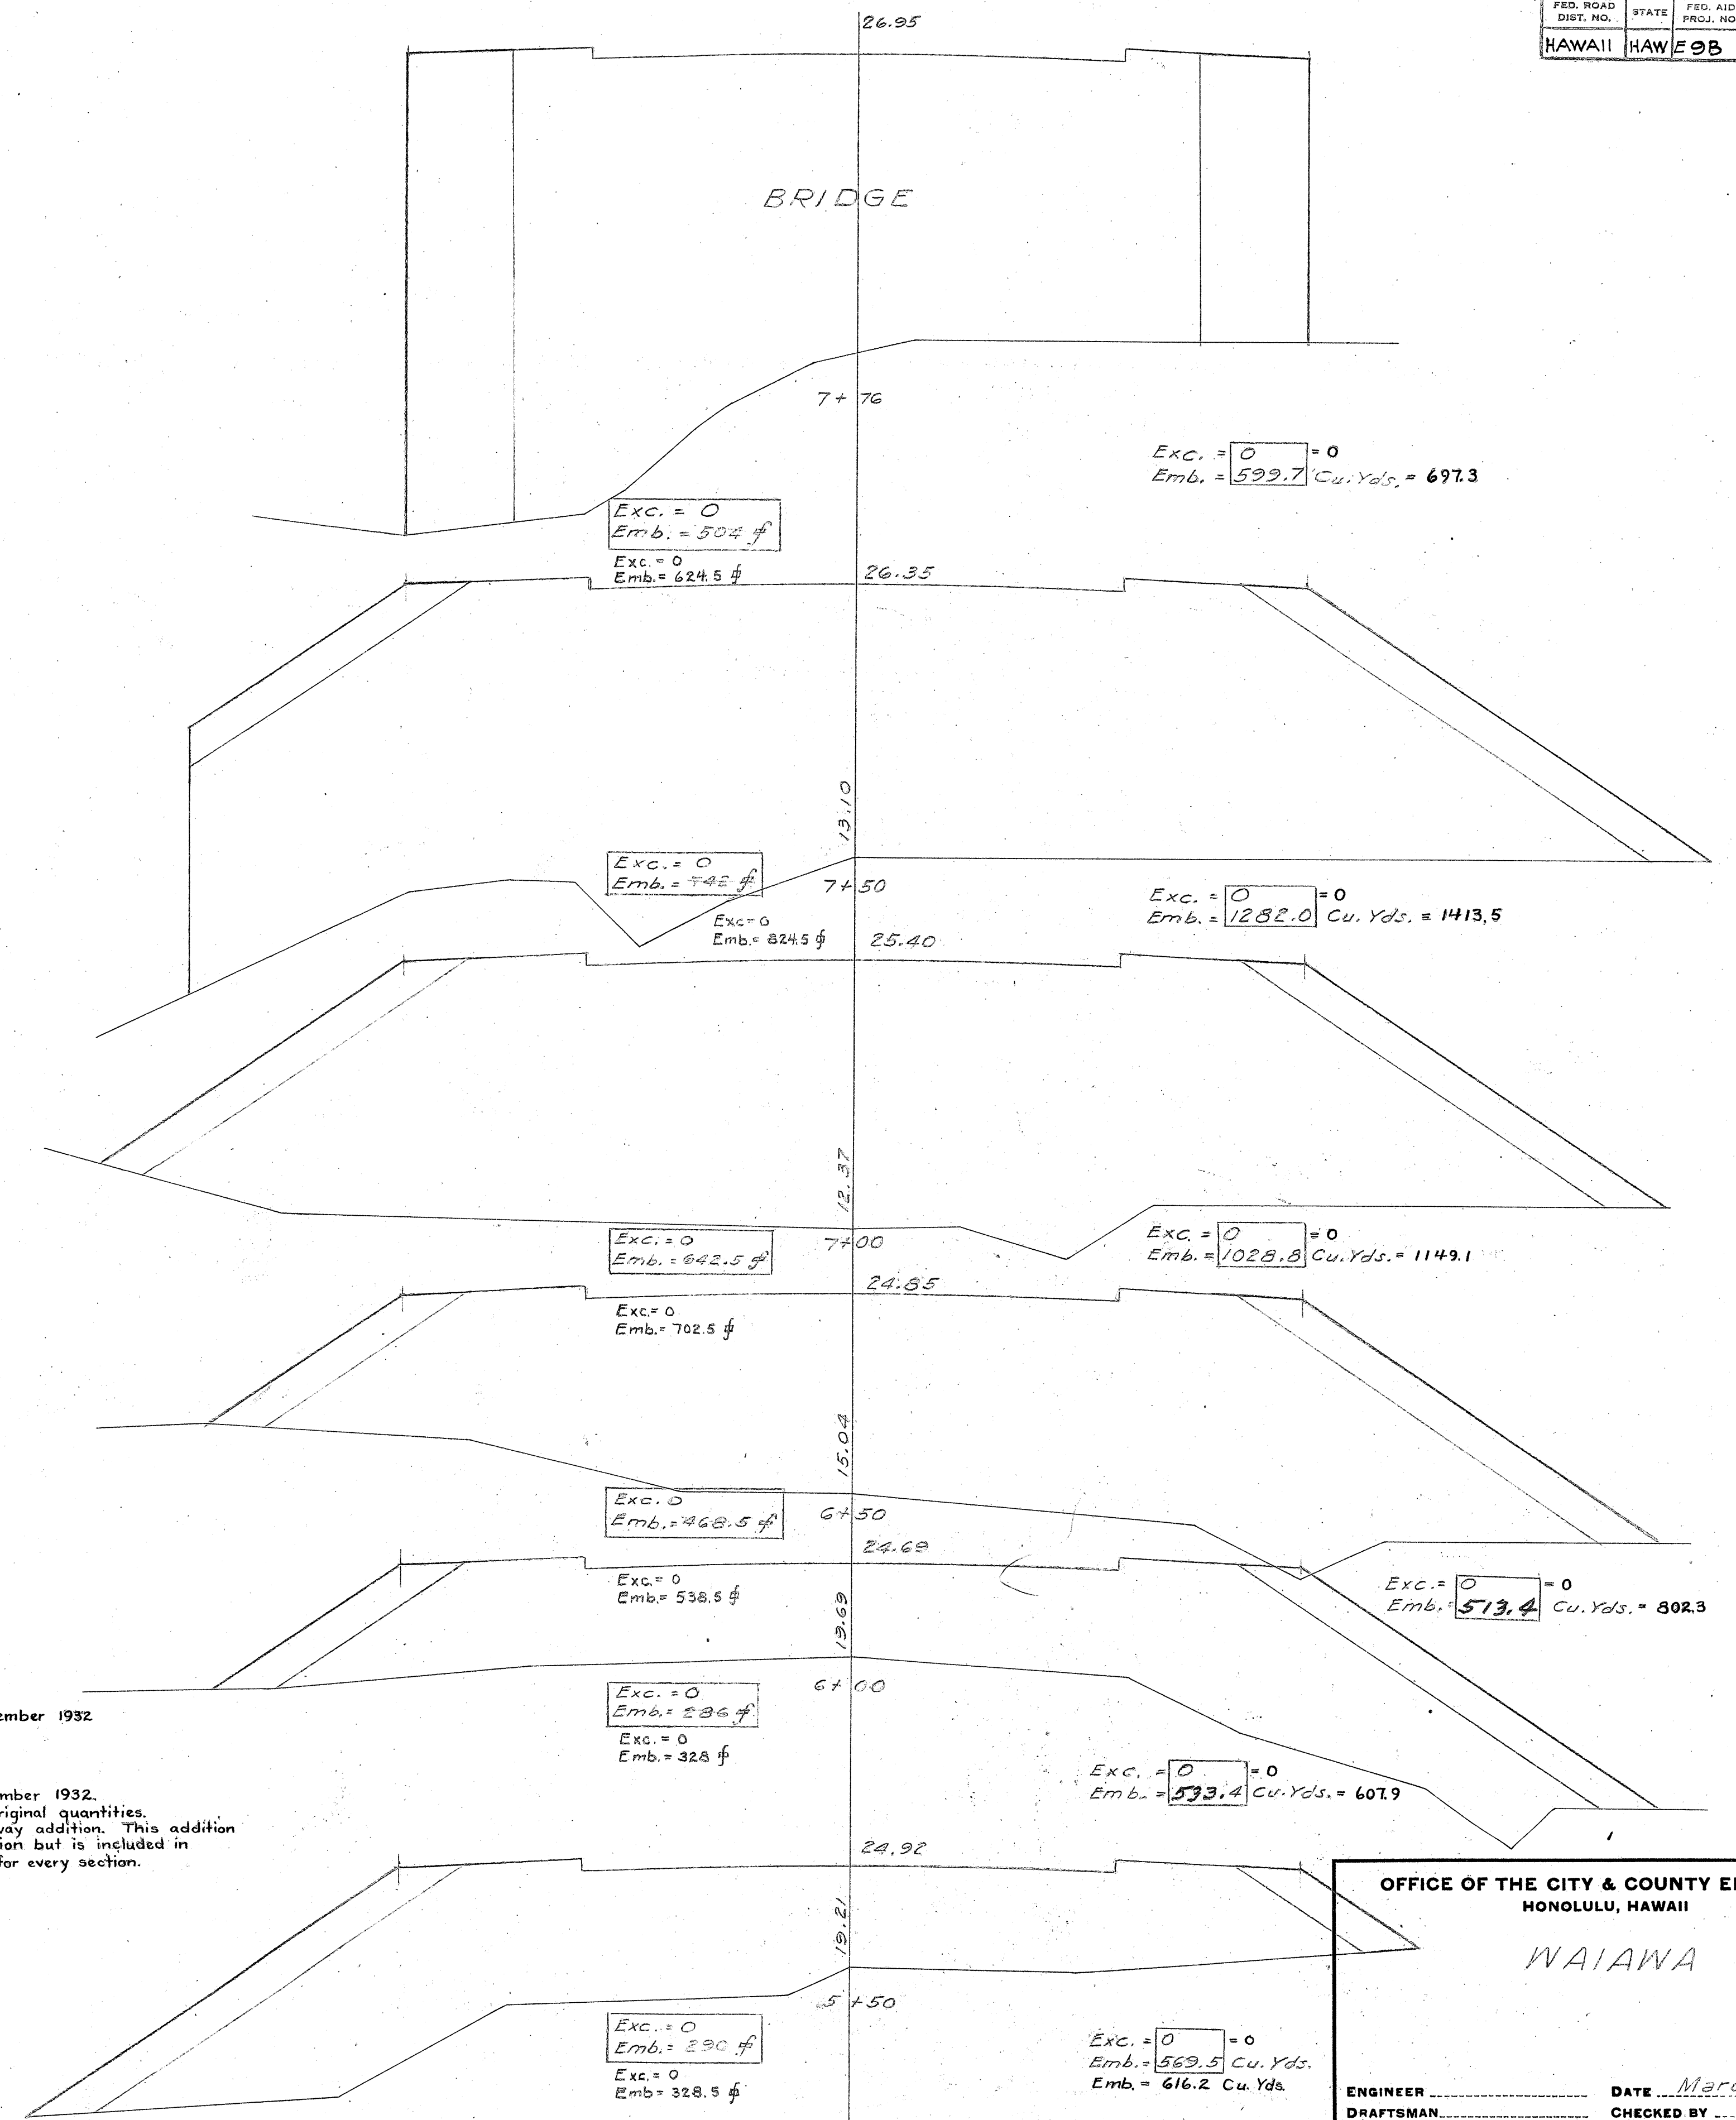


OFFICE OF THE CITY & COUNTY ENGINEER
 HONOLULU, HAWAII

WAIANA

ENGINEER _____ DATE March 1932
 DRAFTSMAN _____ CHECKED BY _____
 SCALE _____ APPROVED: _____
 CITY & COUNTY ENGINEER

4256.12

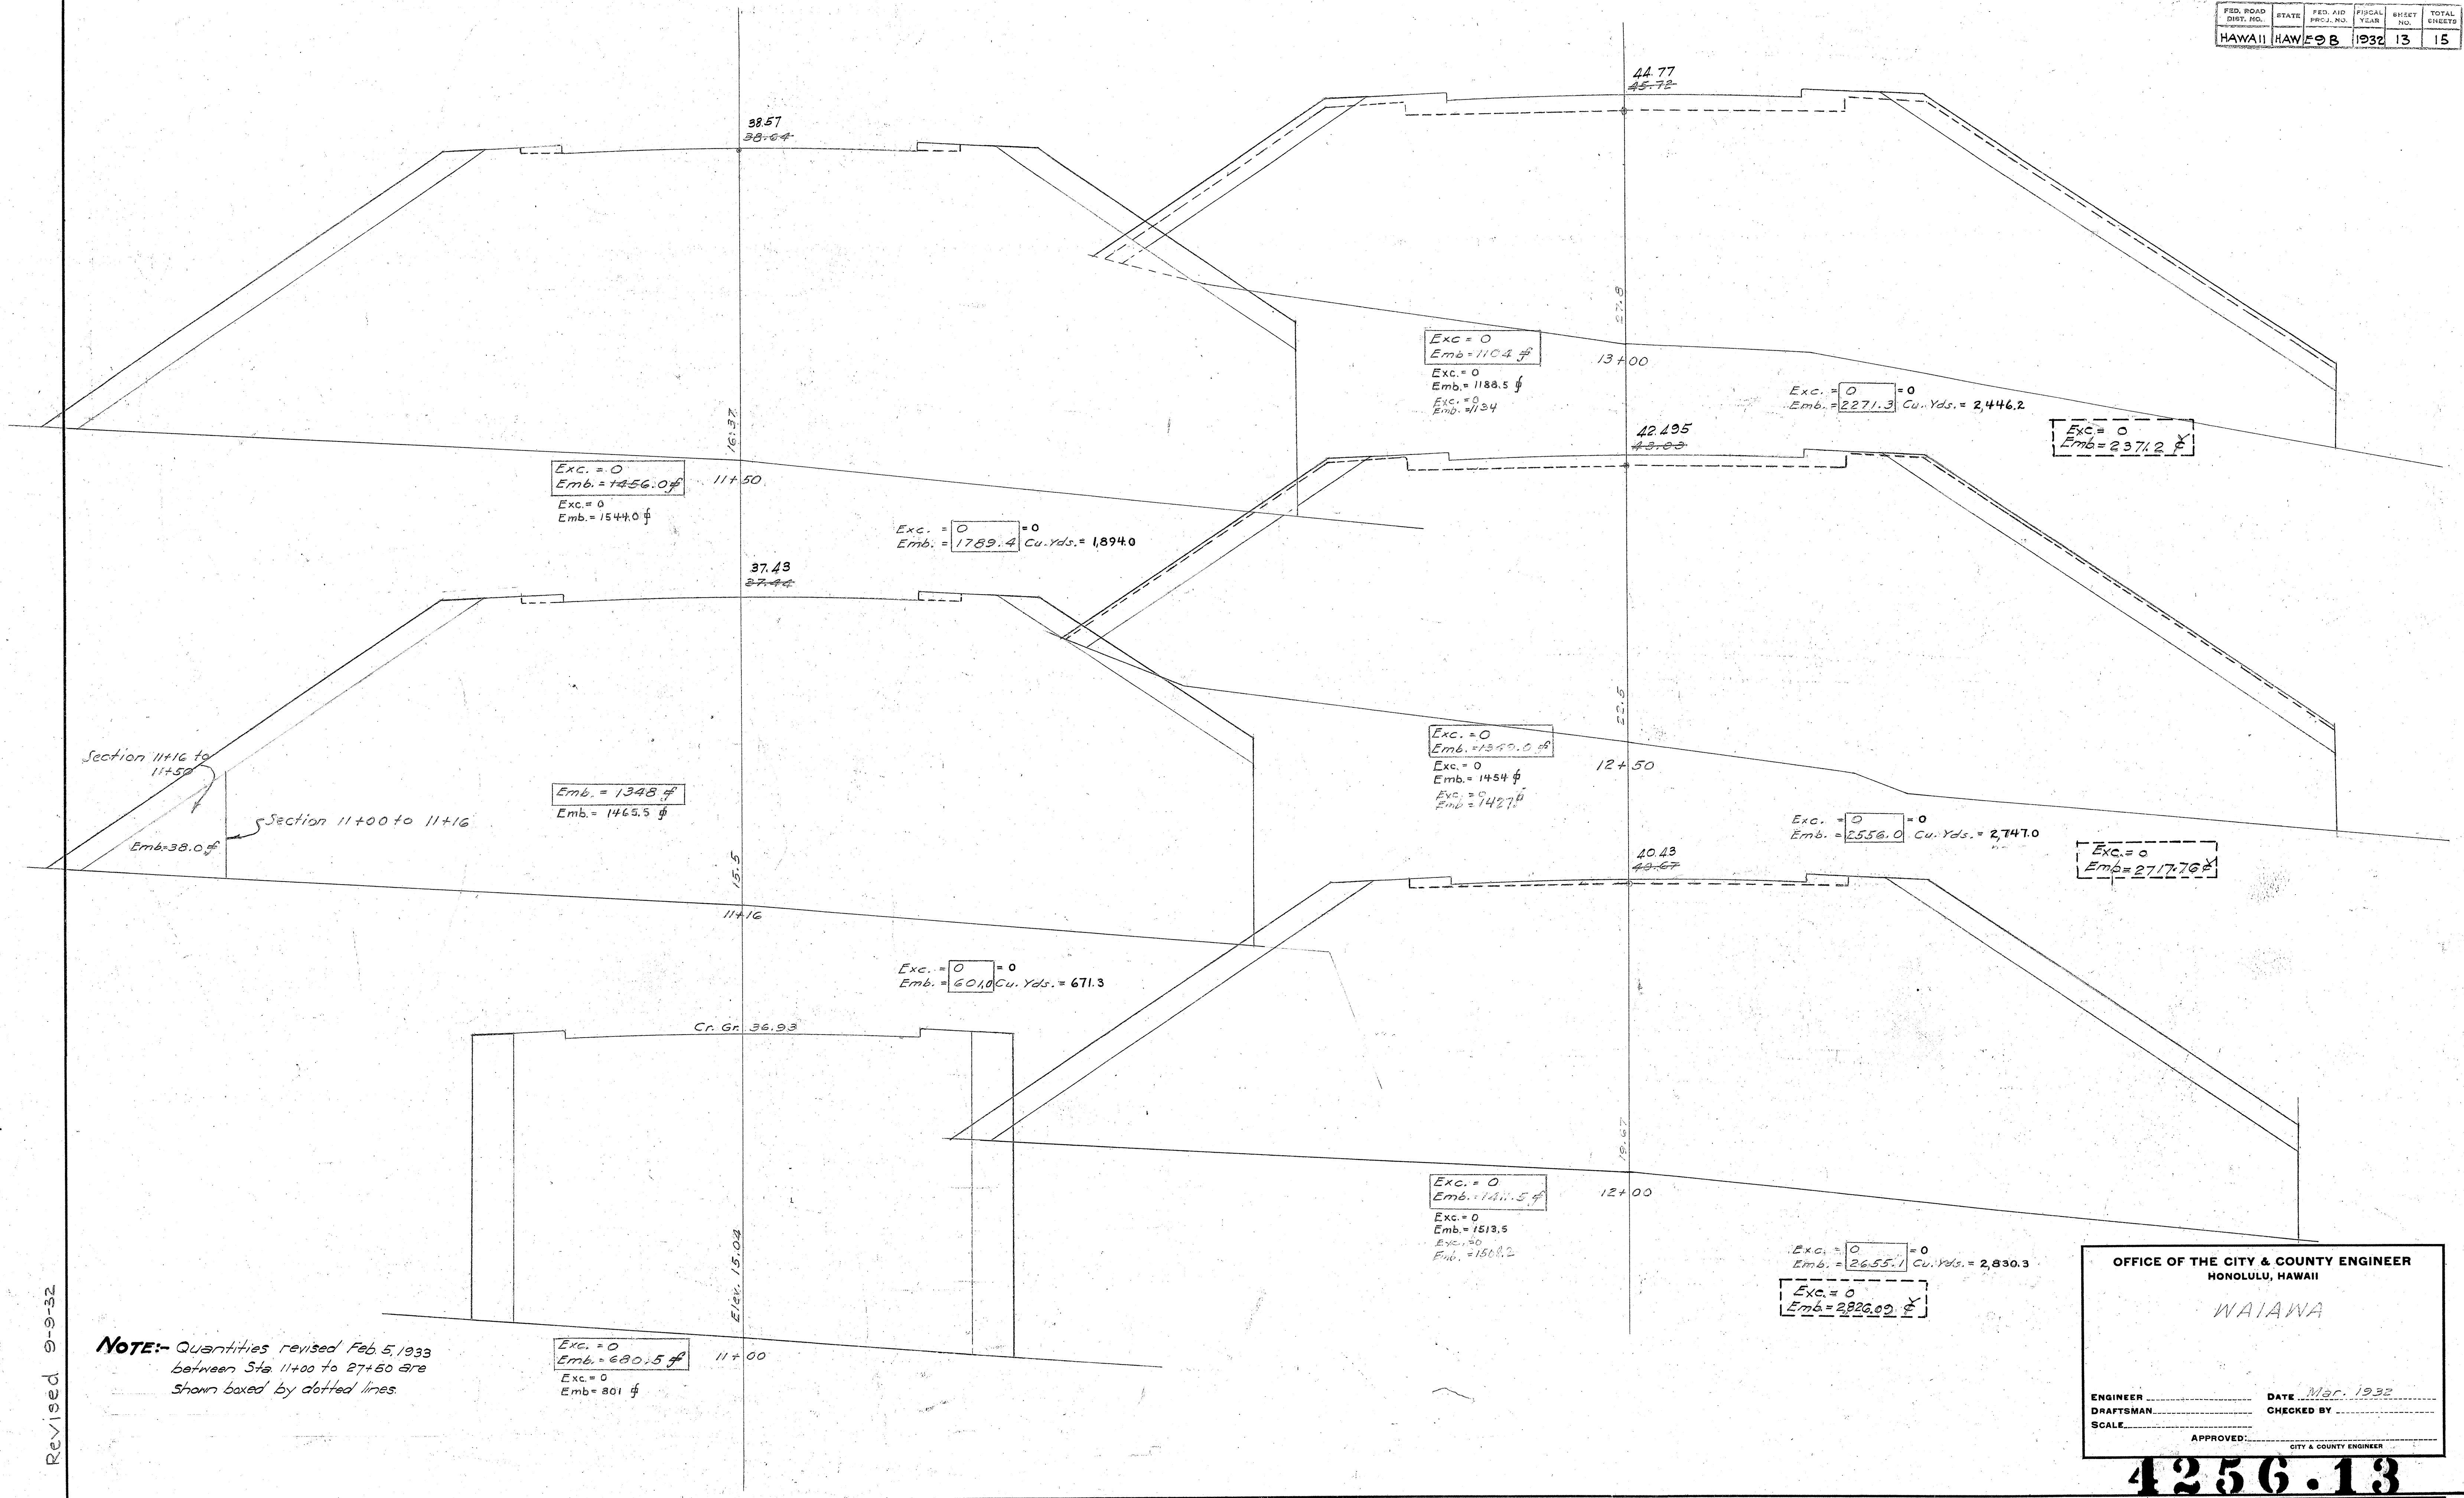


Revised 9-9-32

NOTE:- Quantities revised Feb 5, 1933 between Sta 11+00 to 27+50 are shown boxed by dotted lines.

OFFICE OF THE CITY & COUNTY ENGINEER HONOLULU, HAWAII	
WAIANA	
ENGINEER _____	DATE Mar. 1932
DRAFTSMAN _____	CHECKED BY _____
SCALE _____	APPROVED _____ CITY & COUNTY ENGINEER

4256.13

FILE	POCKET	FOLDER	NO.

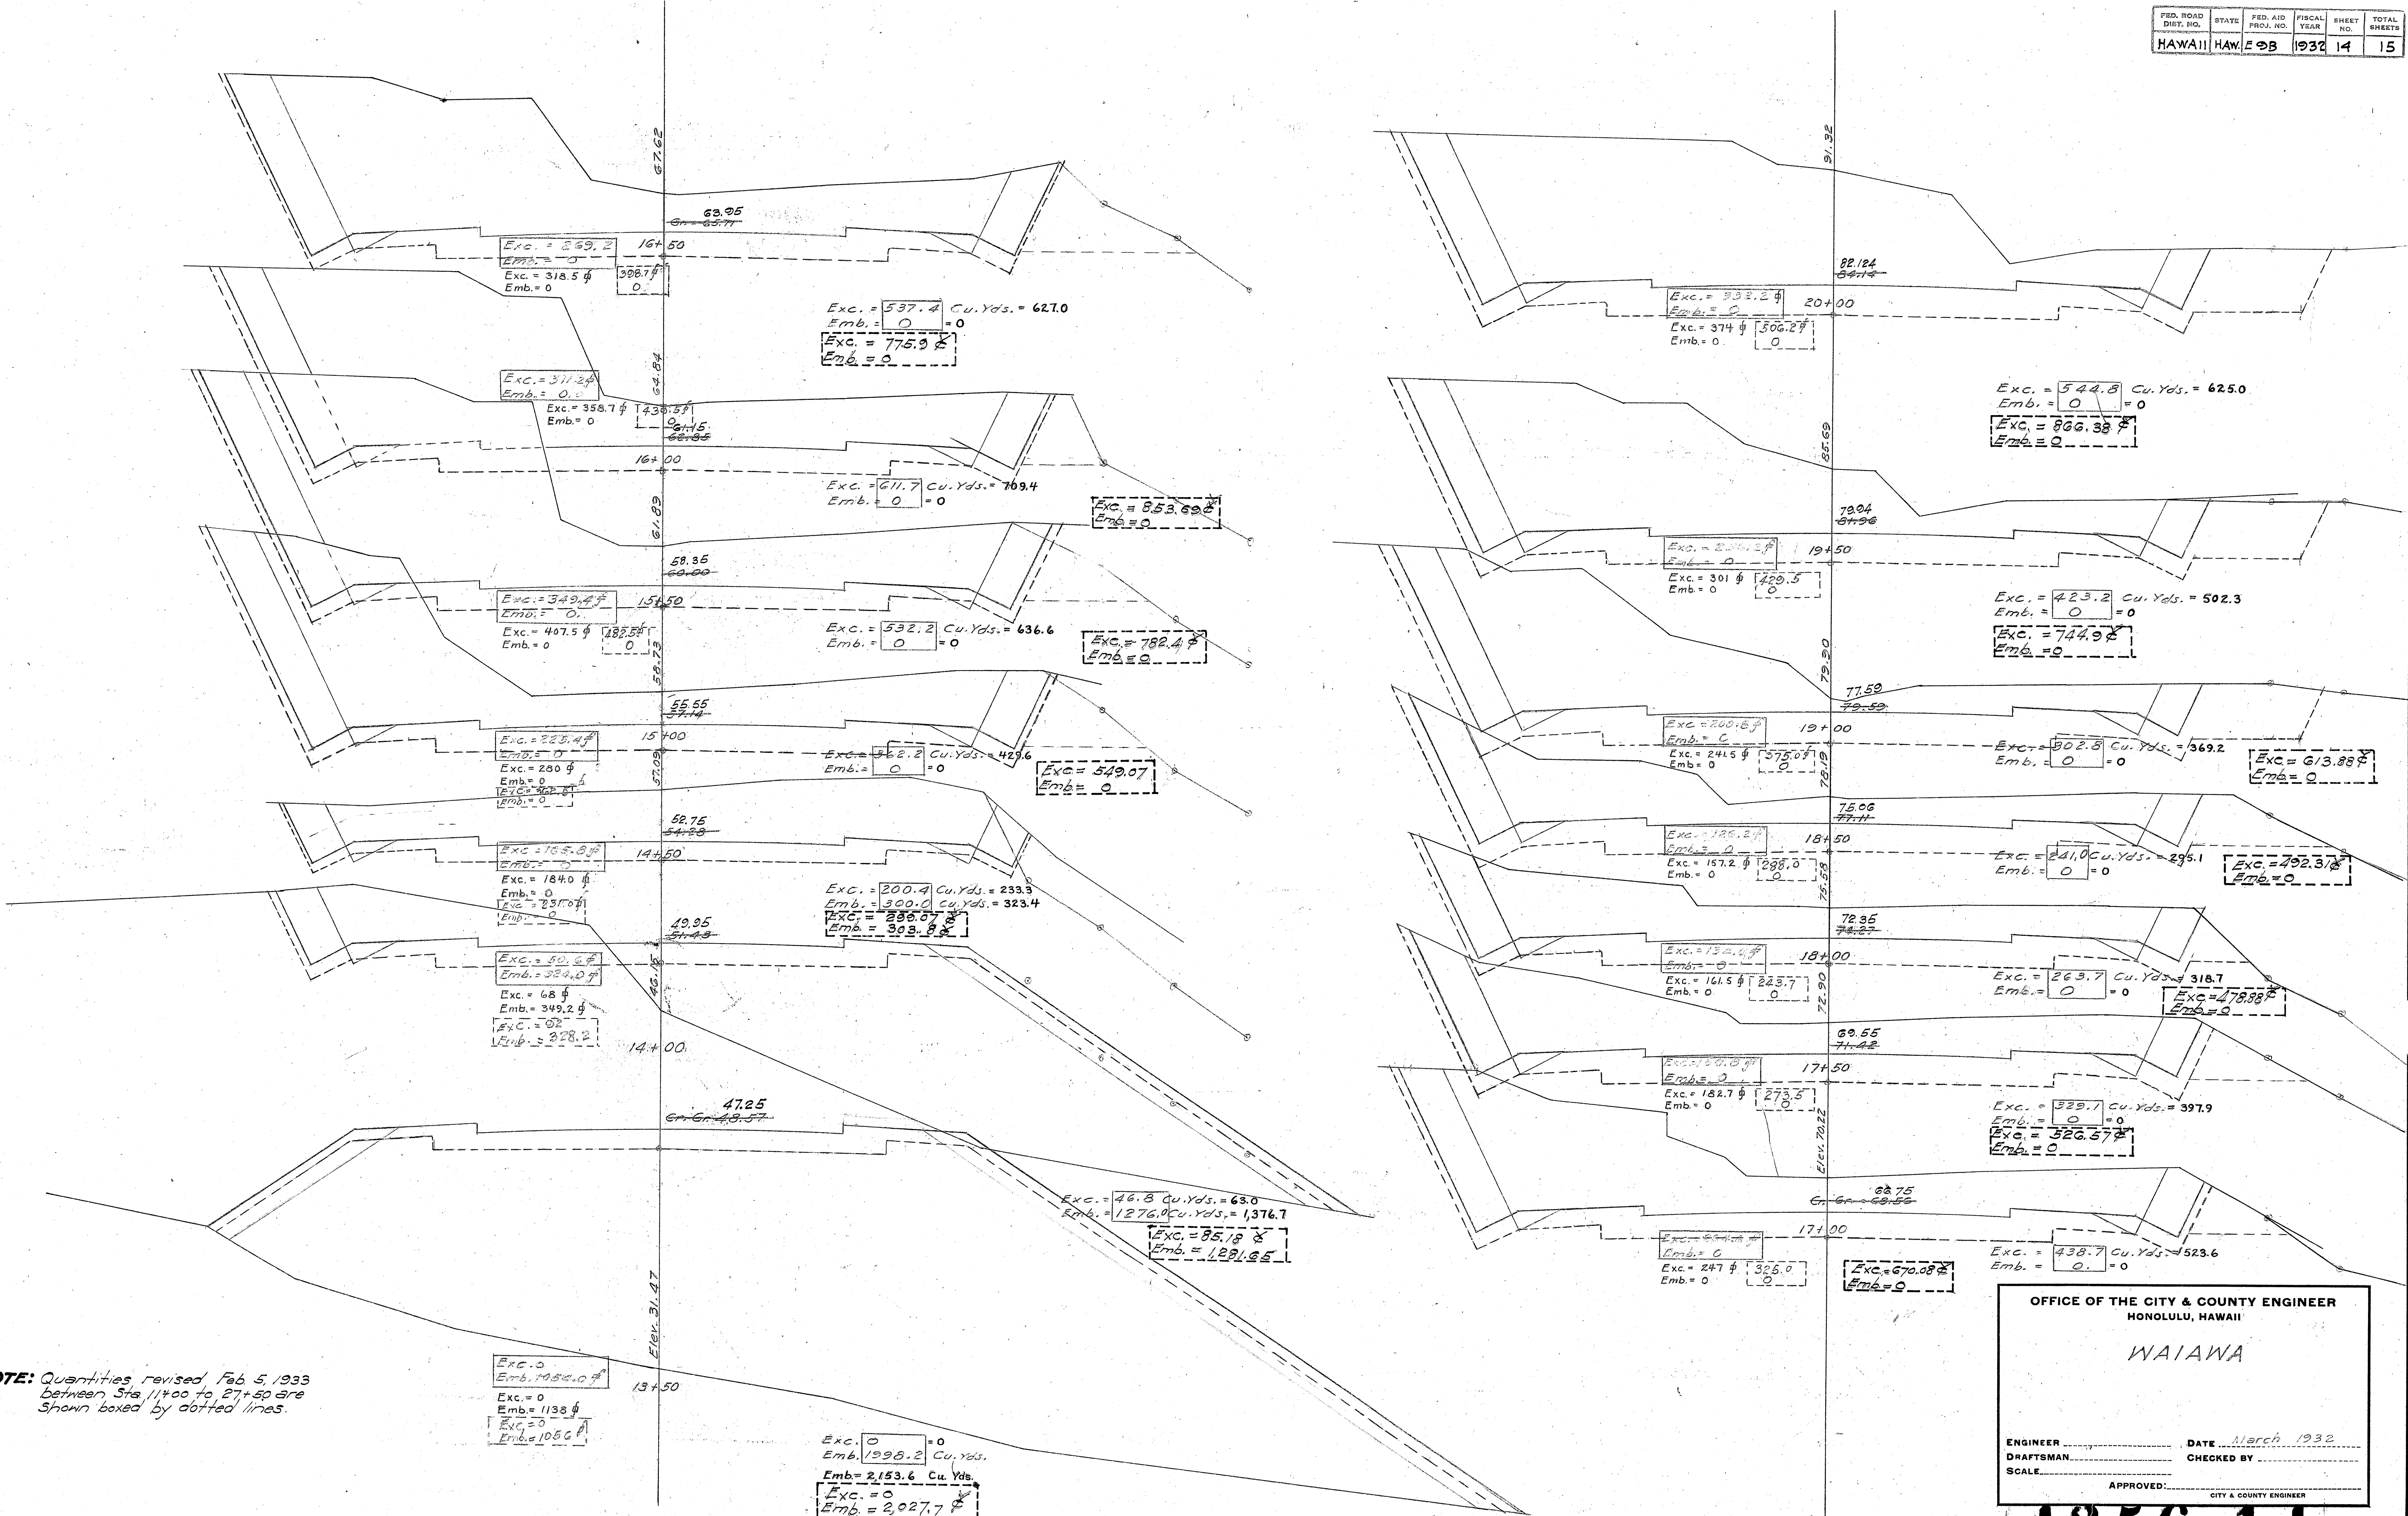


NOTE: Quantities revised Feb 5, 1933 between Sta 11+00 to 27+50 are shown boxed by dotted lines.

OFFICE OF THE CITY & COUNTY ENGINEER HONOLULU, HAWAII	
WAIAWA	
ENGINEER	DATE March 1932
DRAFTSMAN	CHECKED BY
SCALE	APPROVED
CITY & COUNTY ENGINEER	

4256.14

Revised 9-32

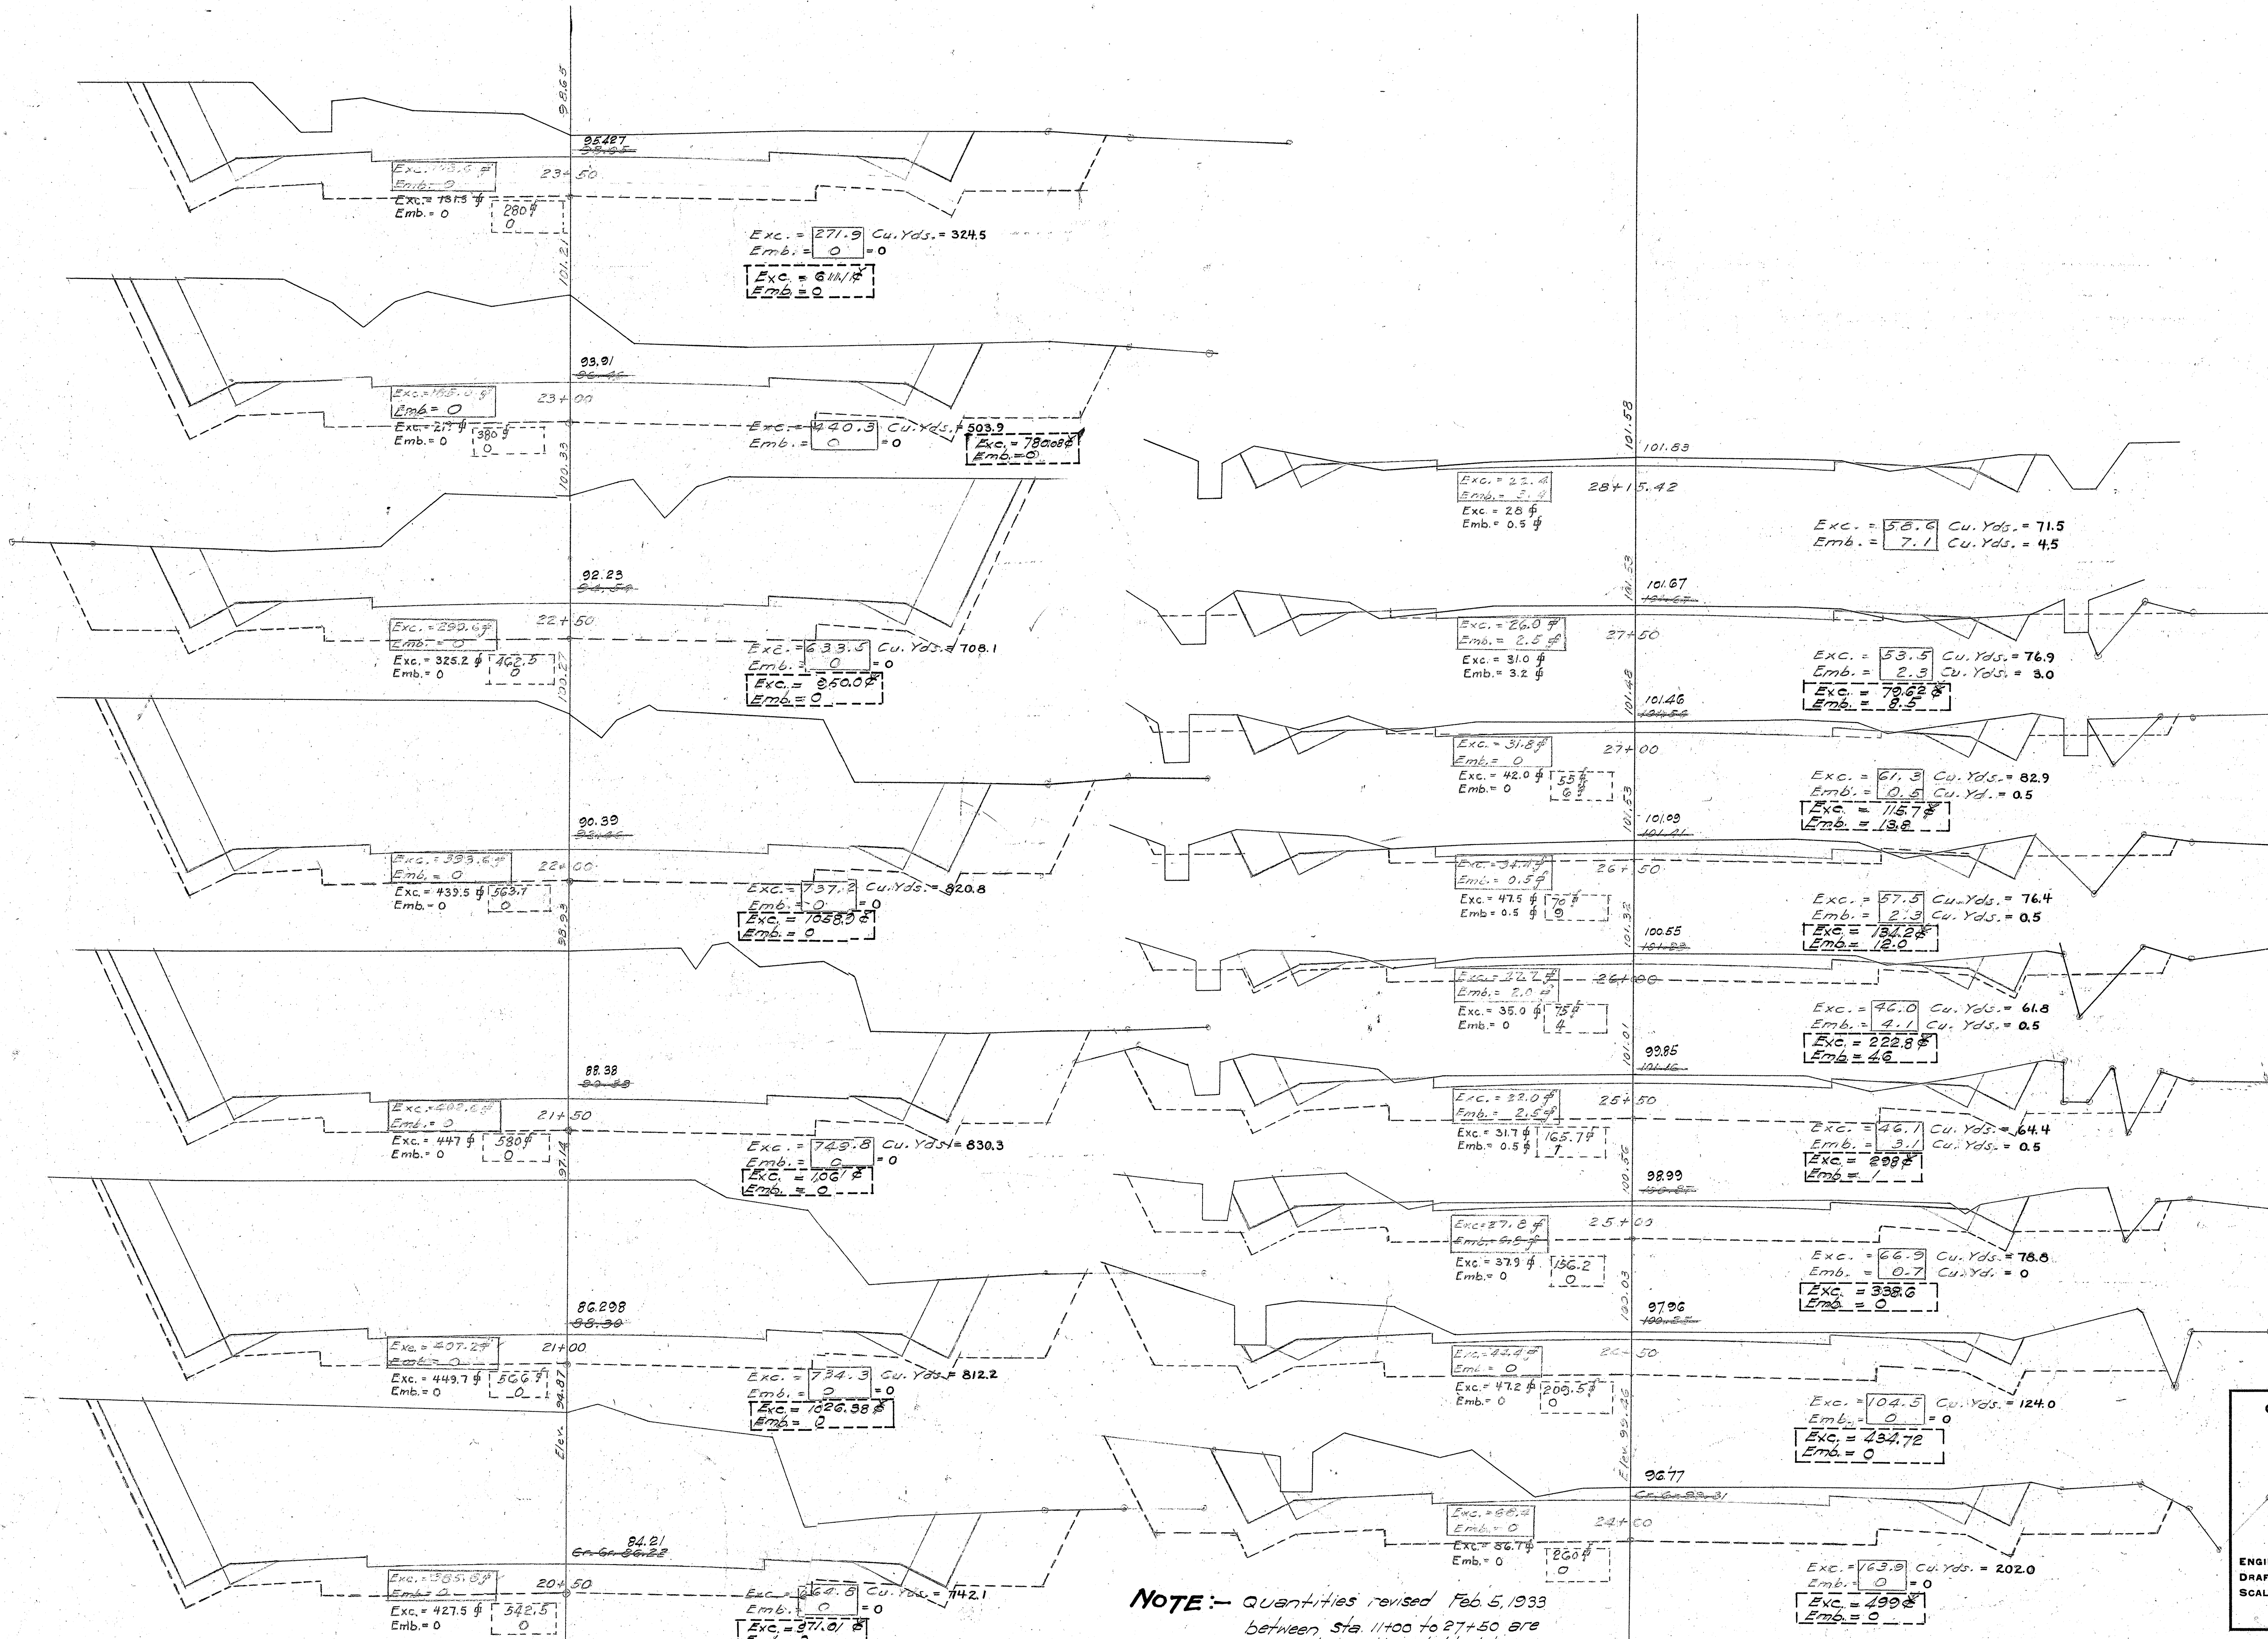

NOTE:- Quantities revised Feb 5, 1933
between sta 11+00 to 27+50 are
shown boxed by dotted lines.

OFFICE OF THE CITY & COUNTY ENGINEER
HONOLULU, HAWAII

WAIANA

ENGINEER _____ DATE Mar. 1932
DRAFTSMAN _____ CHECKED BY _____
SCALE _____ APPROVED _____ CITY & COUNTY ENGINEER

4256.15

Revised 9-9-32