

INDEX TO DRAWINGS	
SHEET NO.	DESCRIPTIONS
1	Title Sheet
2-3	Typical Road Section, Plan & Profile
4-5	Standard Details
6-11	Bridge Details
12-15	Cross Sections

TERRITORY OF HAWAII

TERRITORIAL HIGHWAY DEPARTMENT

HONOLULU T.H.

PLANS OF

KAMEHAMEHA HIGHWAY

EMERGENCY CONSTRUCTION HIGHWAY PROJECT F.A.P. E-9-B

EWA DISTRICT


OAHU T.H.

SCALE

PLAN1 INCH = 100 FEET.


PROFILEHOR. 1 INCH = 100 FEET.
VERT. 1 INCH = 10 FEET.

CROSS-SECTIONS1 INCH = 5 FEET.

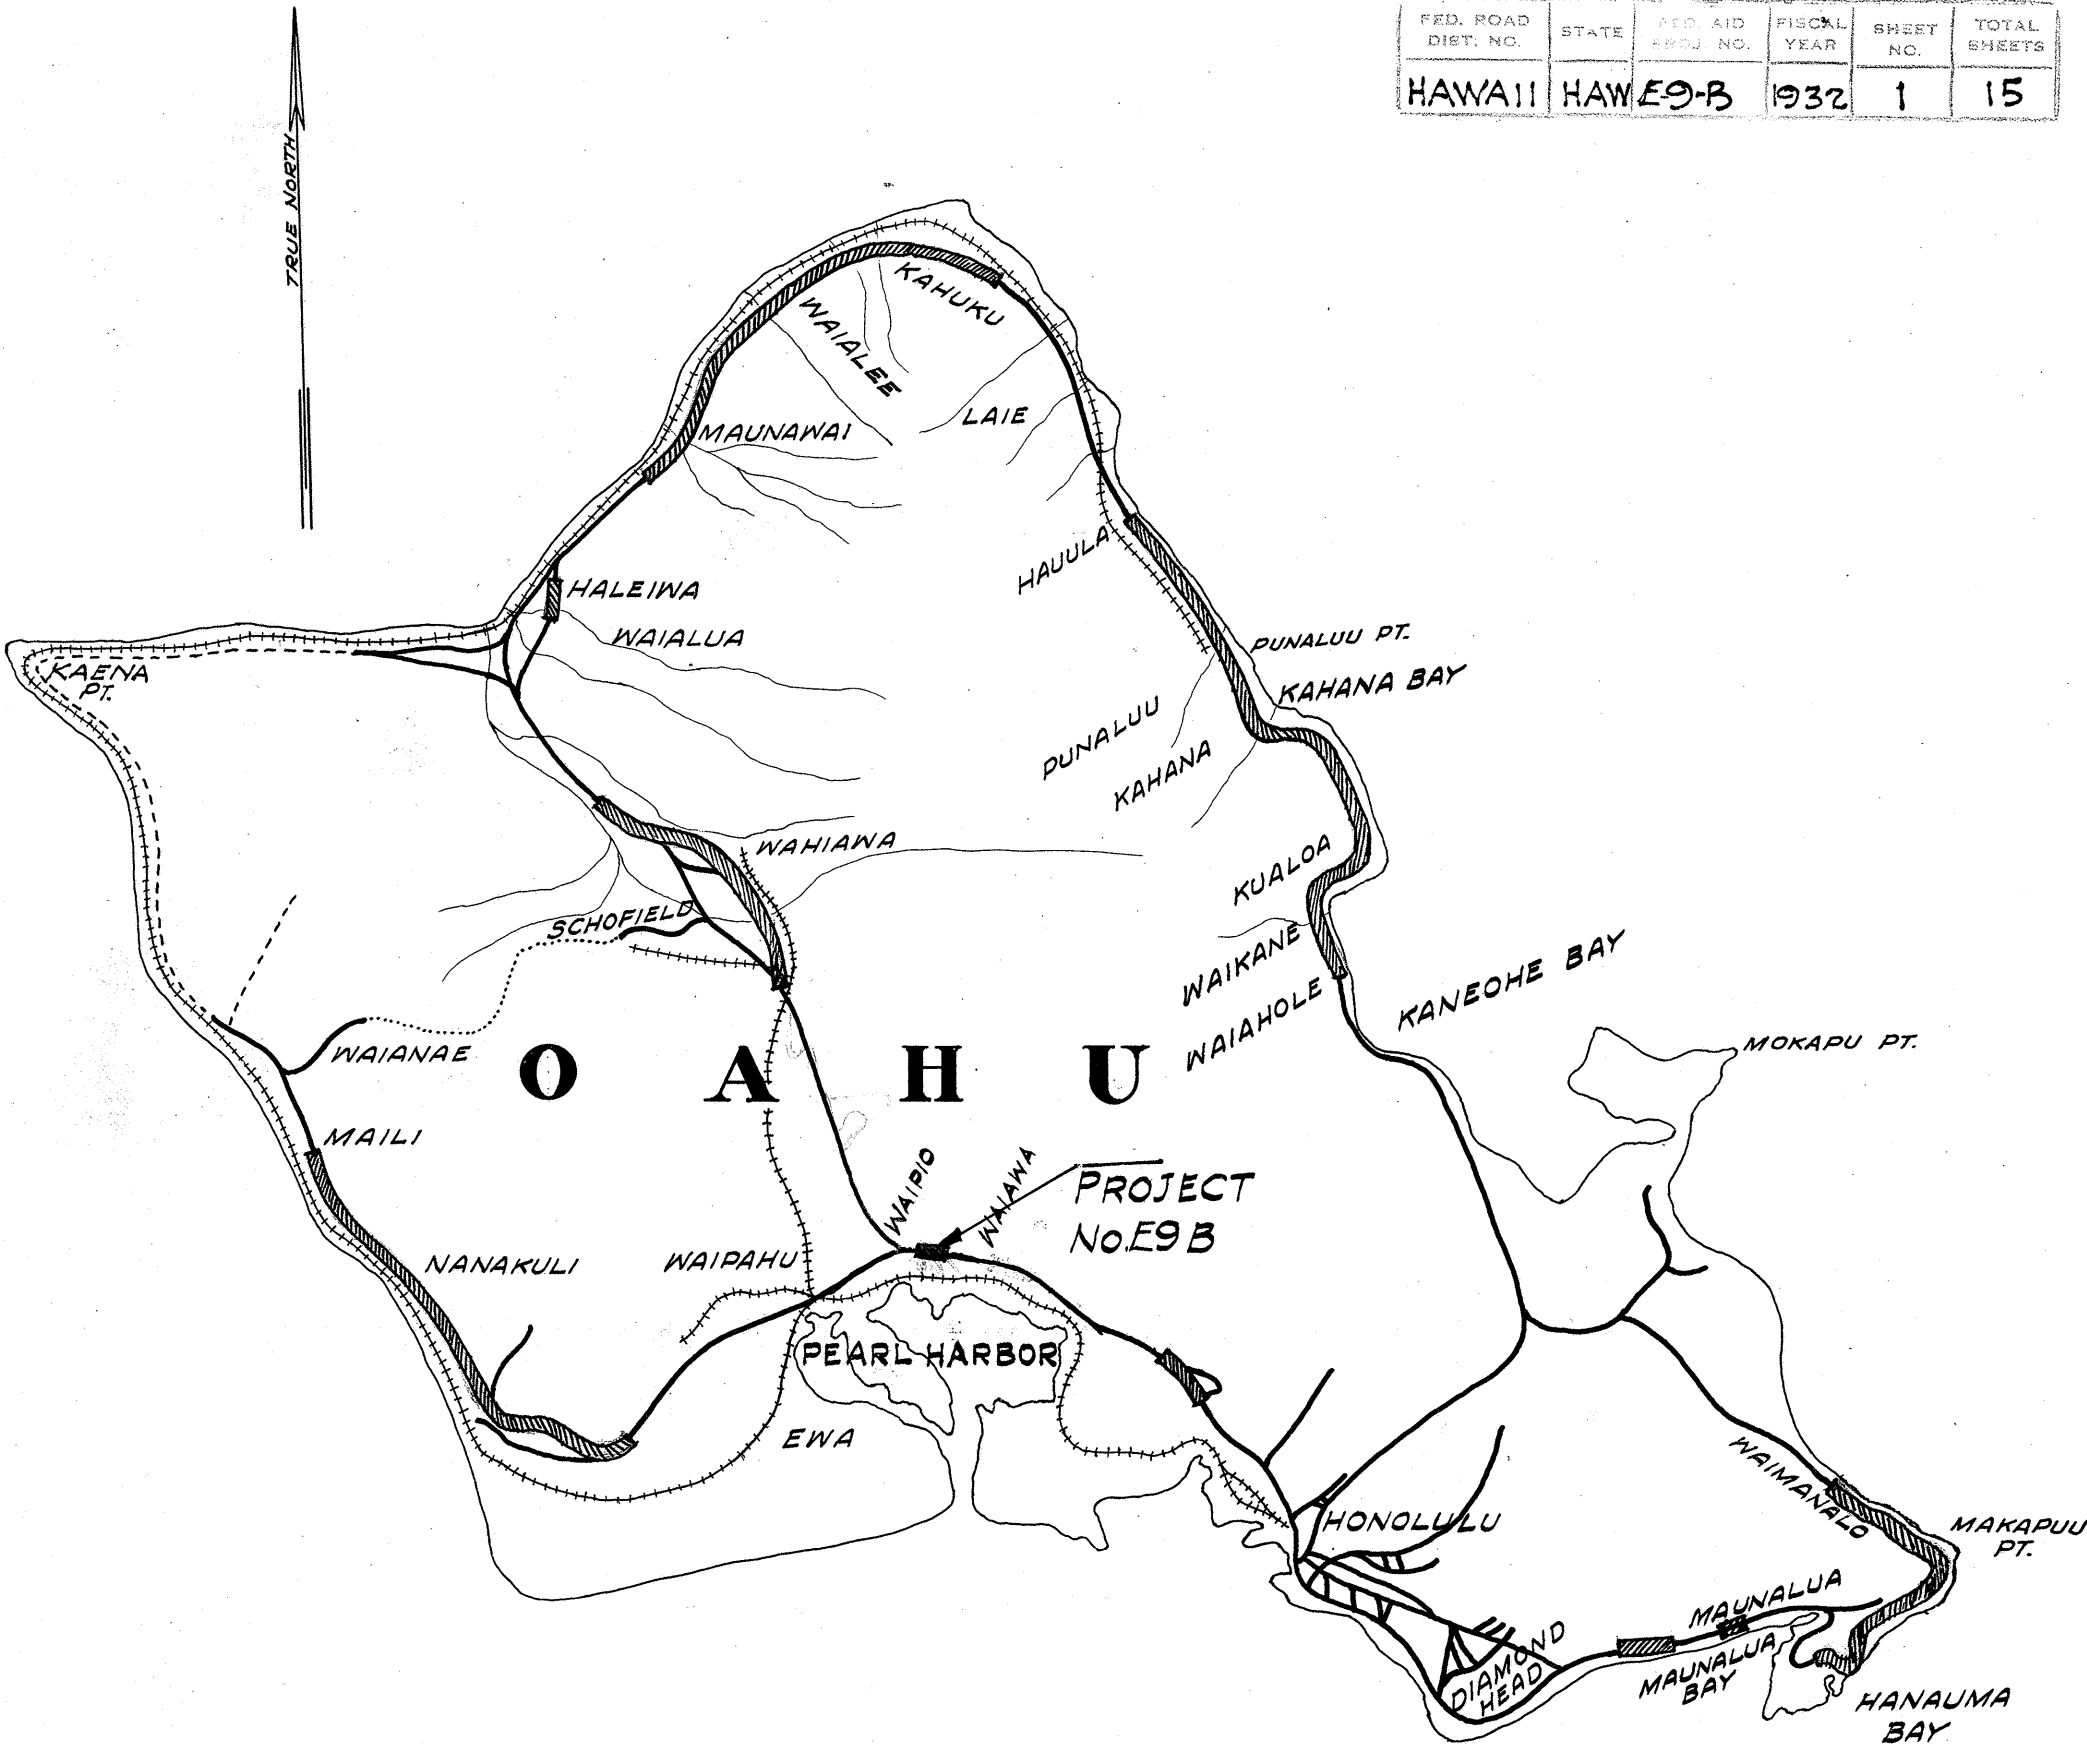

LEGEND.

Previously constructed Federal Aid Projects.

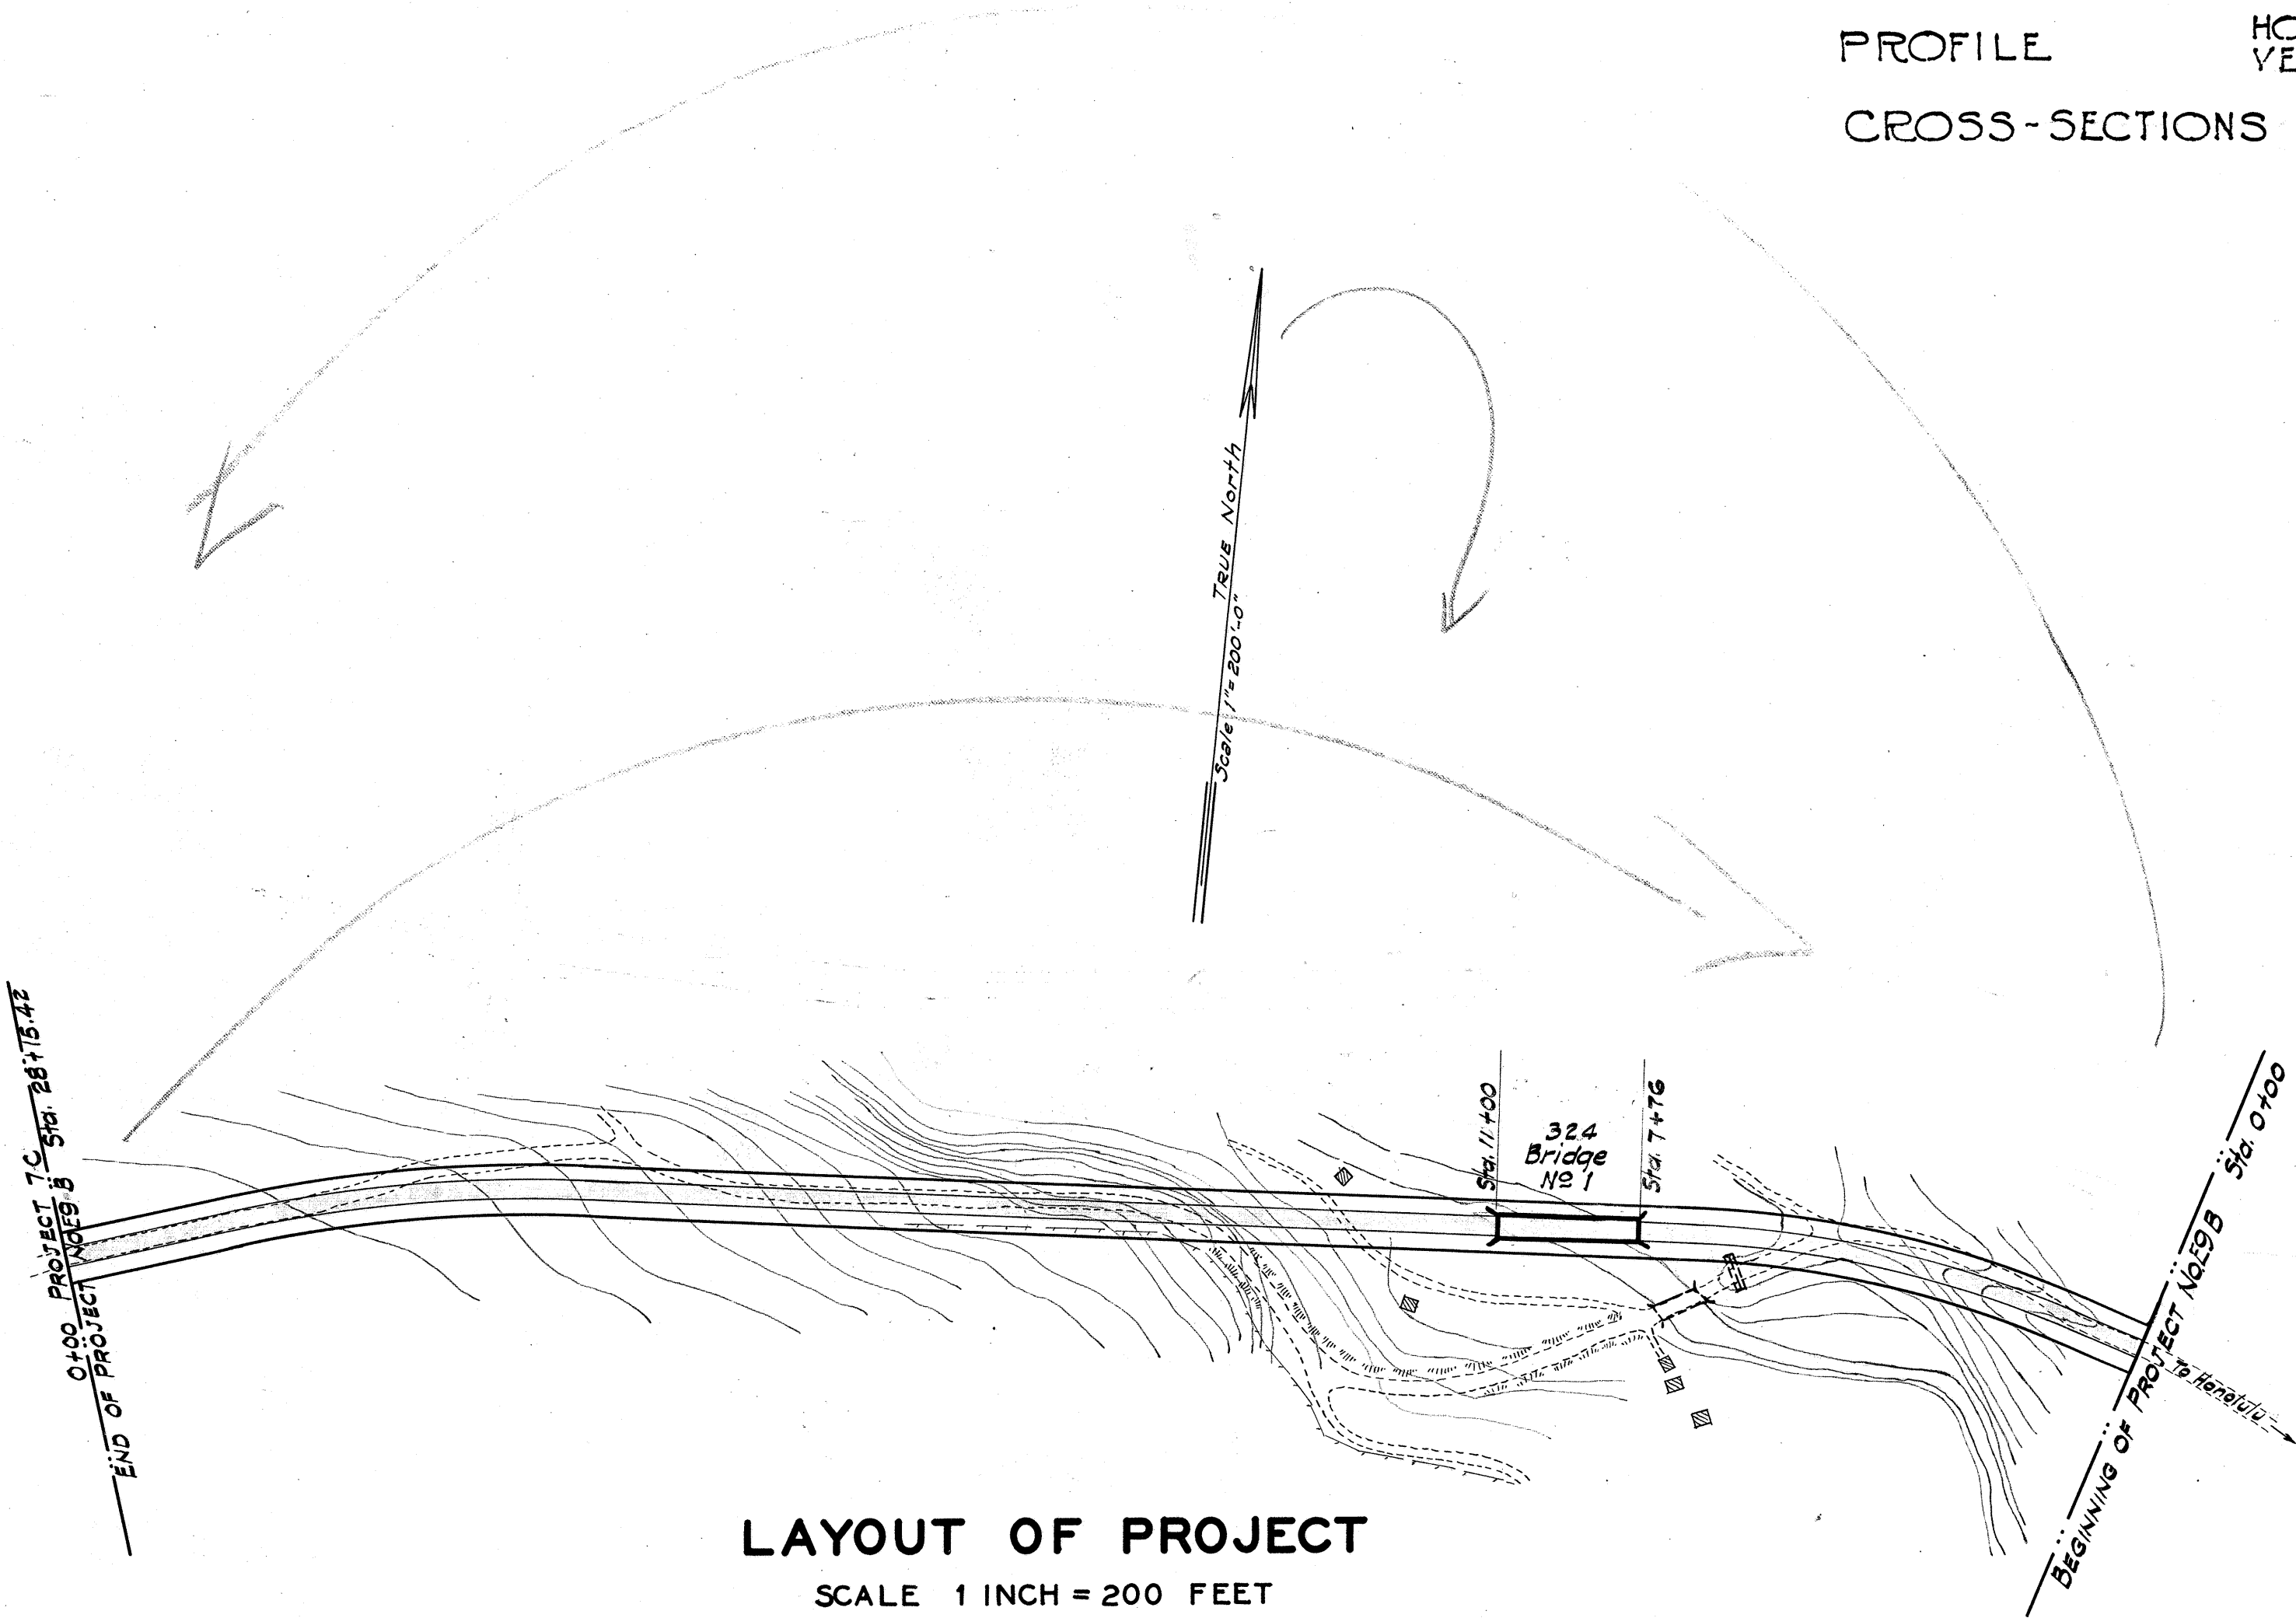

LAYOUT OF PROJECT

SCALE 1 INCH = 200 FEET

Gross & Net Length 0.533 Miles

Bridges 0.061 Miles

Roadway only 0.472 Miles

CONVENTIONAL SIGNS

New Asphalt Macadam Pavement	
Center Line	
Pipe Culverts and Box Drain	
Pipe Culvert with Head Walls	
Standard Monuments	
Bridge	
Existing Edge of Pavement	
Existing Drains and Syphon	
Existing Fence	
Railroad Track	

All Elevations are from U.S.G.S. datum 0.0 = meantide

reverse layout

make north arrow down

Make back

like this

APPROVED

E. H. Rigler

7/18/32

TERRITORIAL HIGHWAY ENGINEER

RECOMMENDED FOR APPROVAL

E. H. Rigler 8-16-32.

PRINCIPAL HIGHWAY ENGINEER

Bureau of Public Roads

RECOMMENDED FOR APPROVAL

CHIEF ENGINEER Bureau of Public Roads

APPROVED

DIRECTOR Bureau of Public Roads