


$\Delta = 14^\circ 25' 15''$
 $D = 3^\circ$
 $R = 1910.0$
 $T = 241.64$
 $E = 15.22$
 $Lc = 479.46$
 $L = 480.73$


TRUSTEES OF THE B. P. BISHOP EST. (Owner)

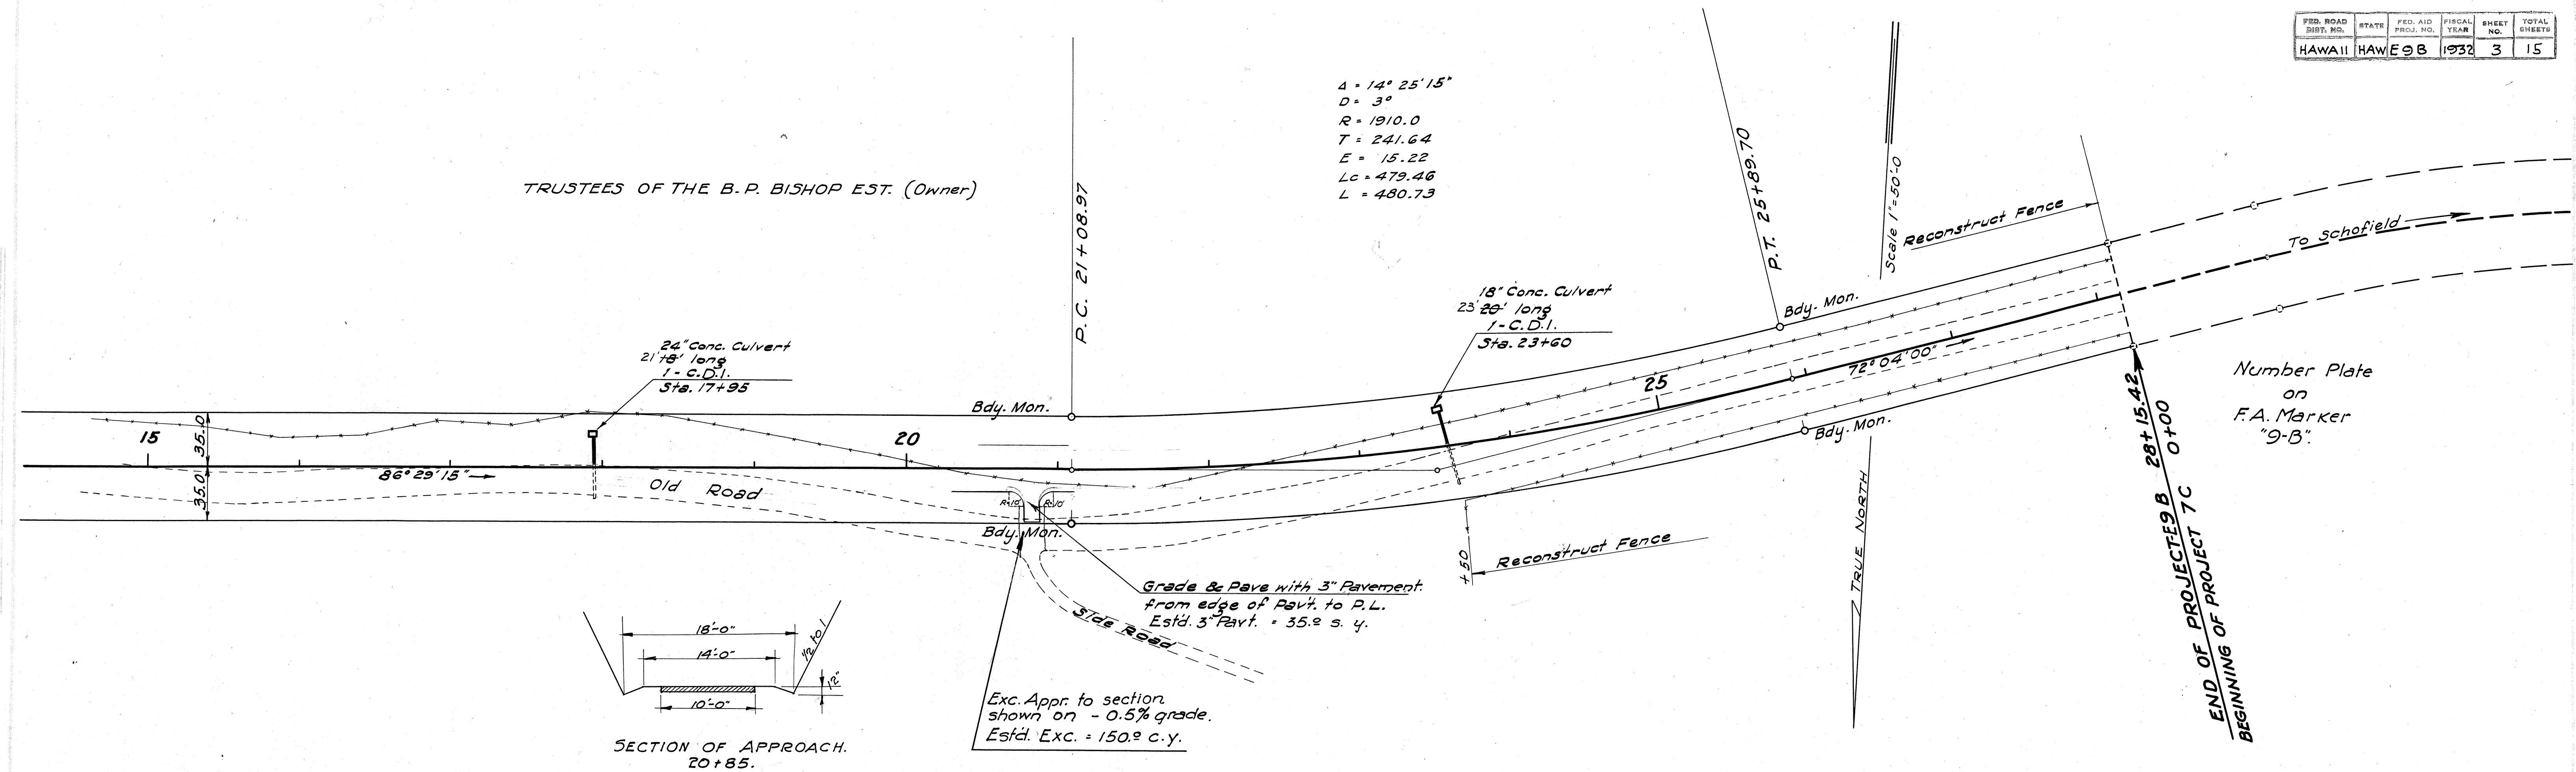

Number Plate on F.A. Marker "9-B".

END OF PROJECT 9 B 28+15.42
BEGINNING OF PROJECT 7 C 0+00

NOTE:- Grades have been revised Feb. 5, 1933 between Sta. 11+00 to 27+50. Revised grades are shown by dotted lines.

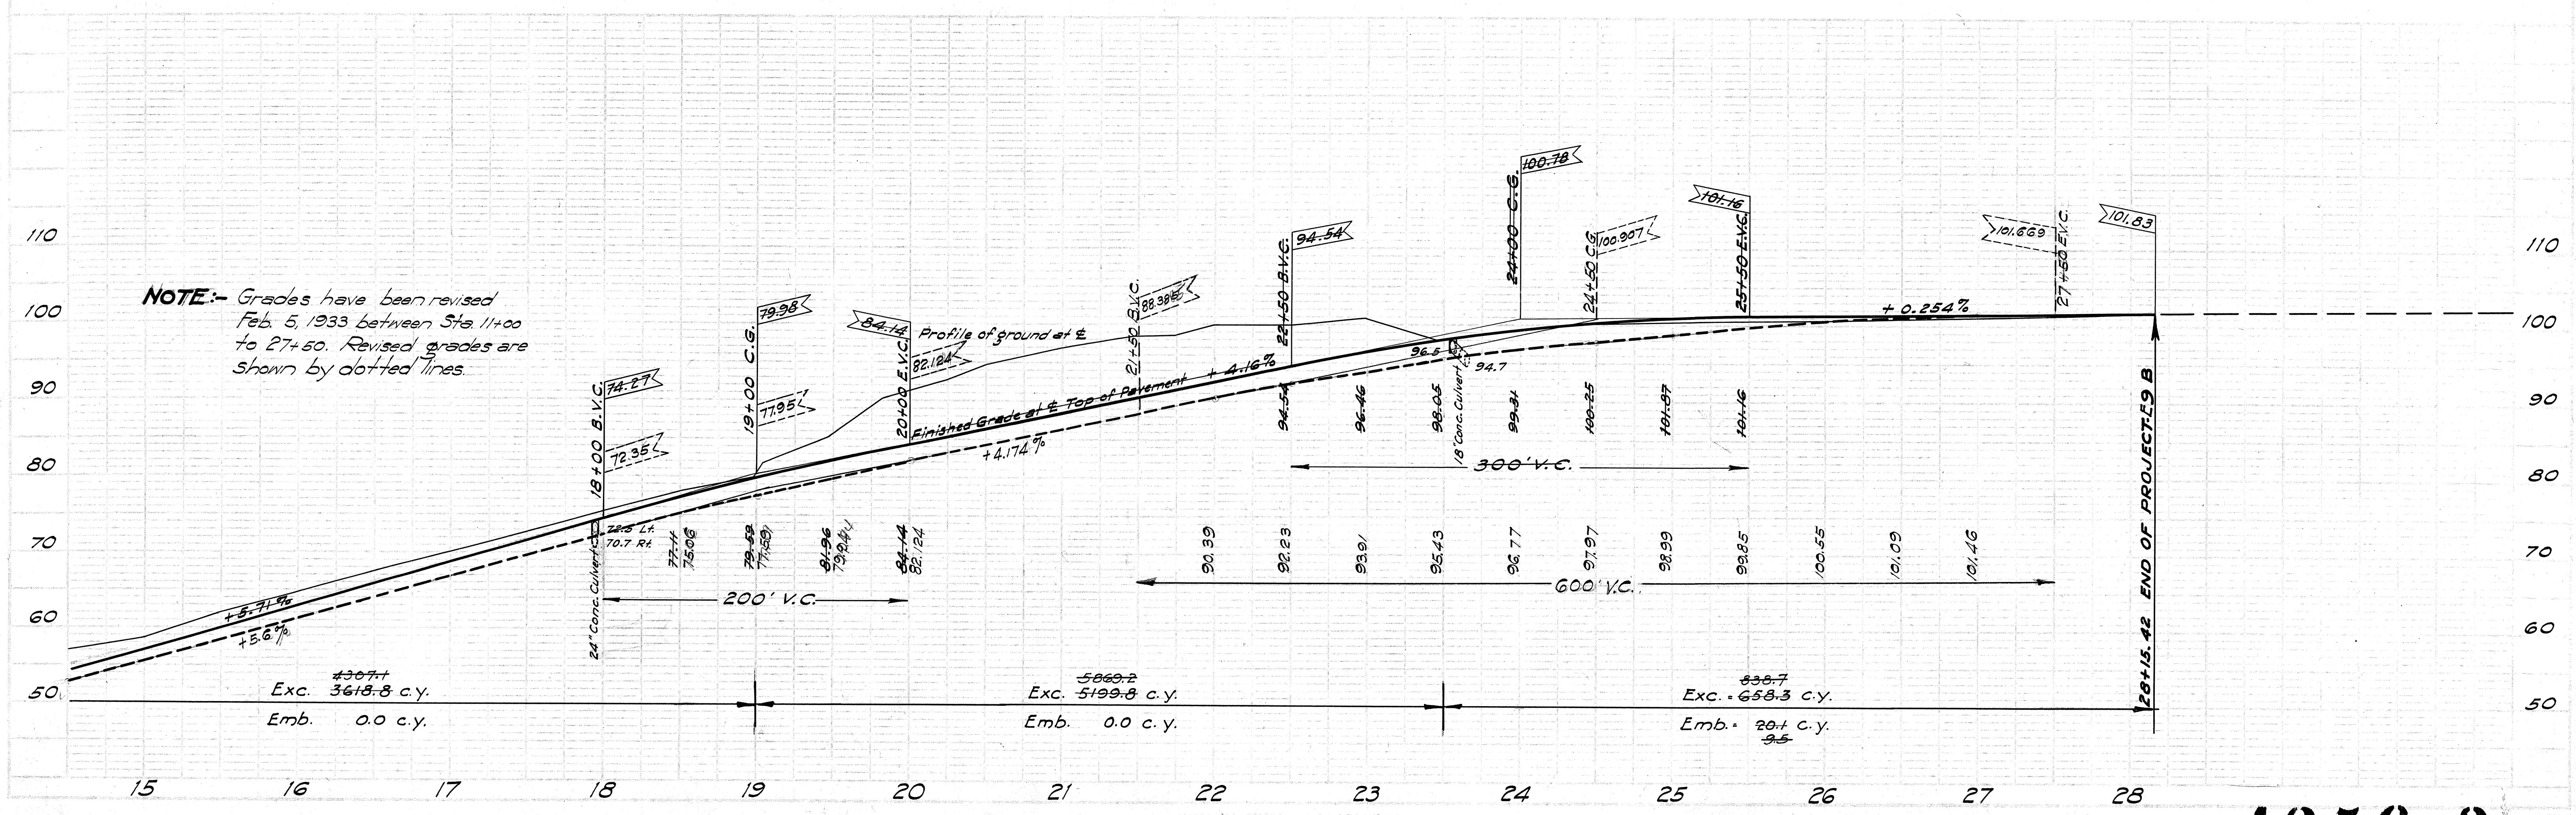

Exc. 3618.8 c.y.
 Emb. 0.0 c.y.

Exc. 5199.8 c.y.
 Emb. 0.0 c.y.

Exc. 658.3 c.y.
 Emb. 20.1 c.y.