


FINAL	SURVEYED	DATE
SURVEY	PLOTTED	1/20/33
NOTE BOOK	DATE	1/20/33
NO.	AREAS CHECKED	1/20/33


ORIGINAL	SURVEYED	DATE
SURVEY	PLOTTED	
NOTE BOOK	DATE	
NO.	AREAS CHECKED	

FED. ROAD DIST. NO.	STATE	FISCAL YEAR	SHEET NO.	TOTAL SHEETS
Hawaii	Haw.	1933	14	20

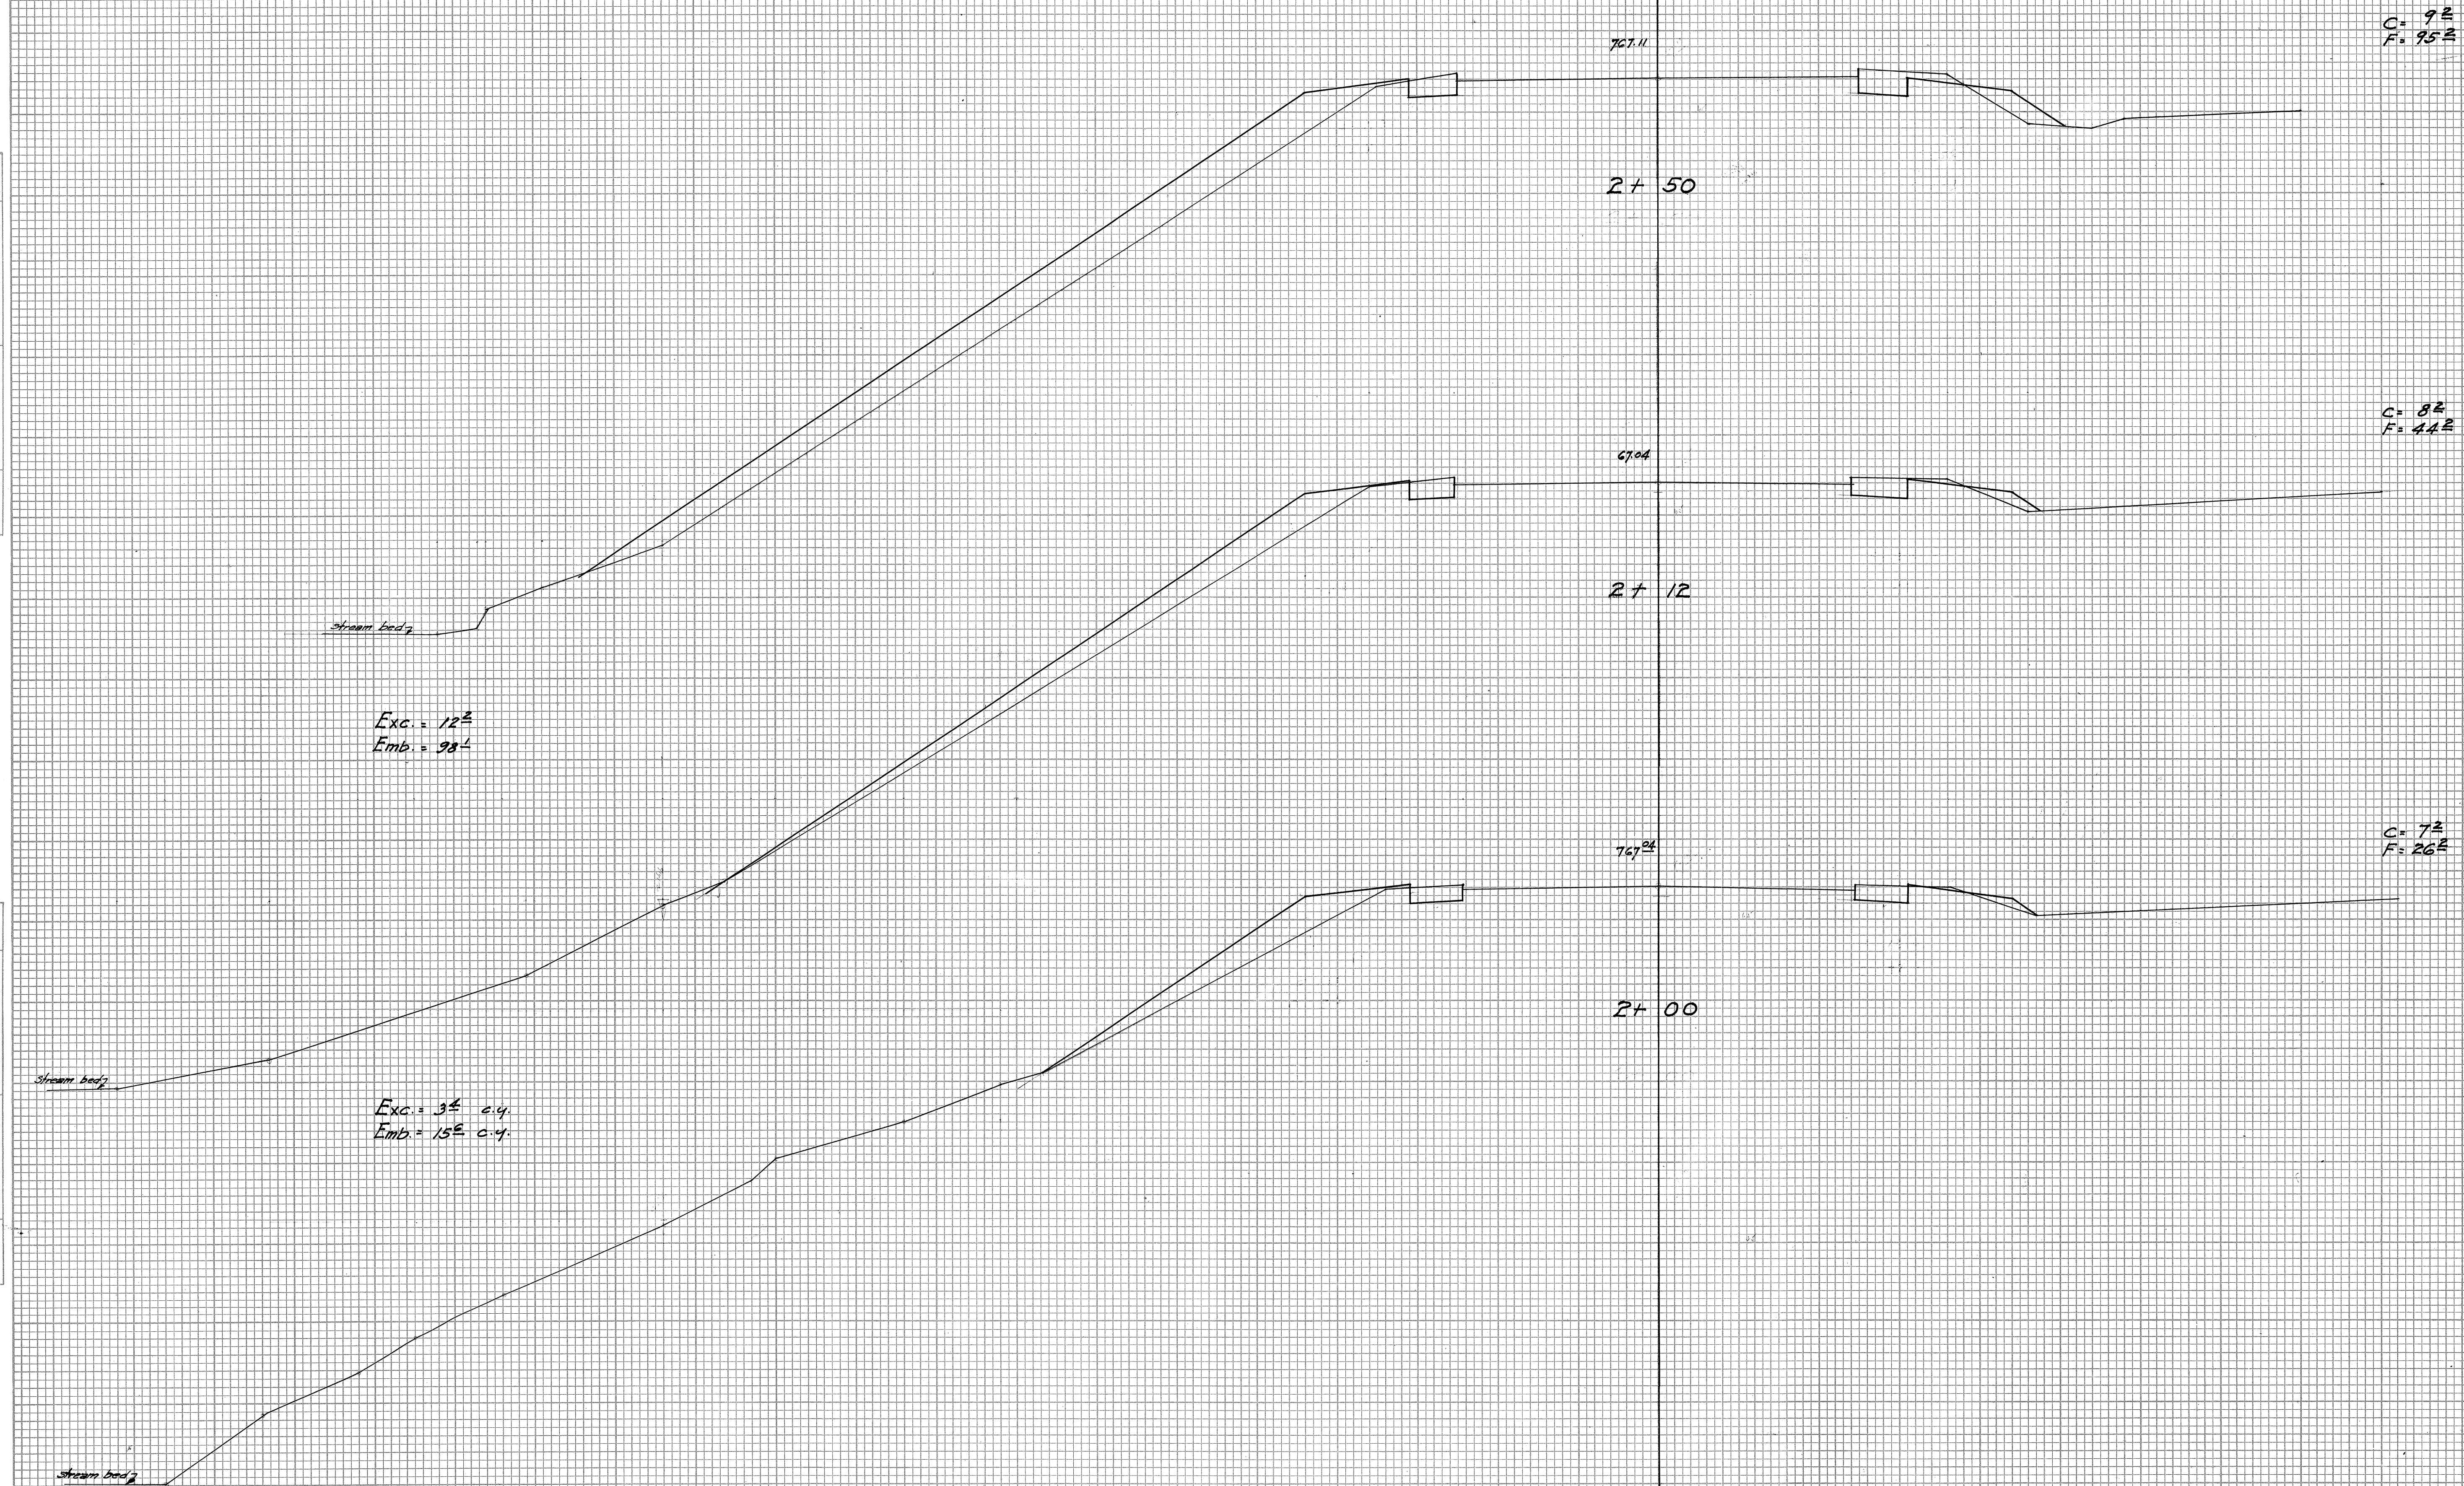


FINAL SURVEY NO.	DATE	BY
12/33	12/33	A.K.
12/33	12/33	A.K.
12/33	12/33	A.K.
12/33	12/33	C.C.H.

ORIGINAL SURVEY NO.	DATE	BY
12/33	12/33	A.K.
12/33	12/33	A.K.
12/33	12/33	A.K.
12/33	12/33	C.C.H.

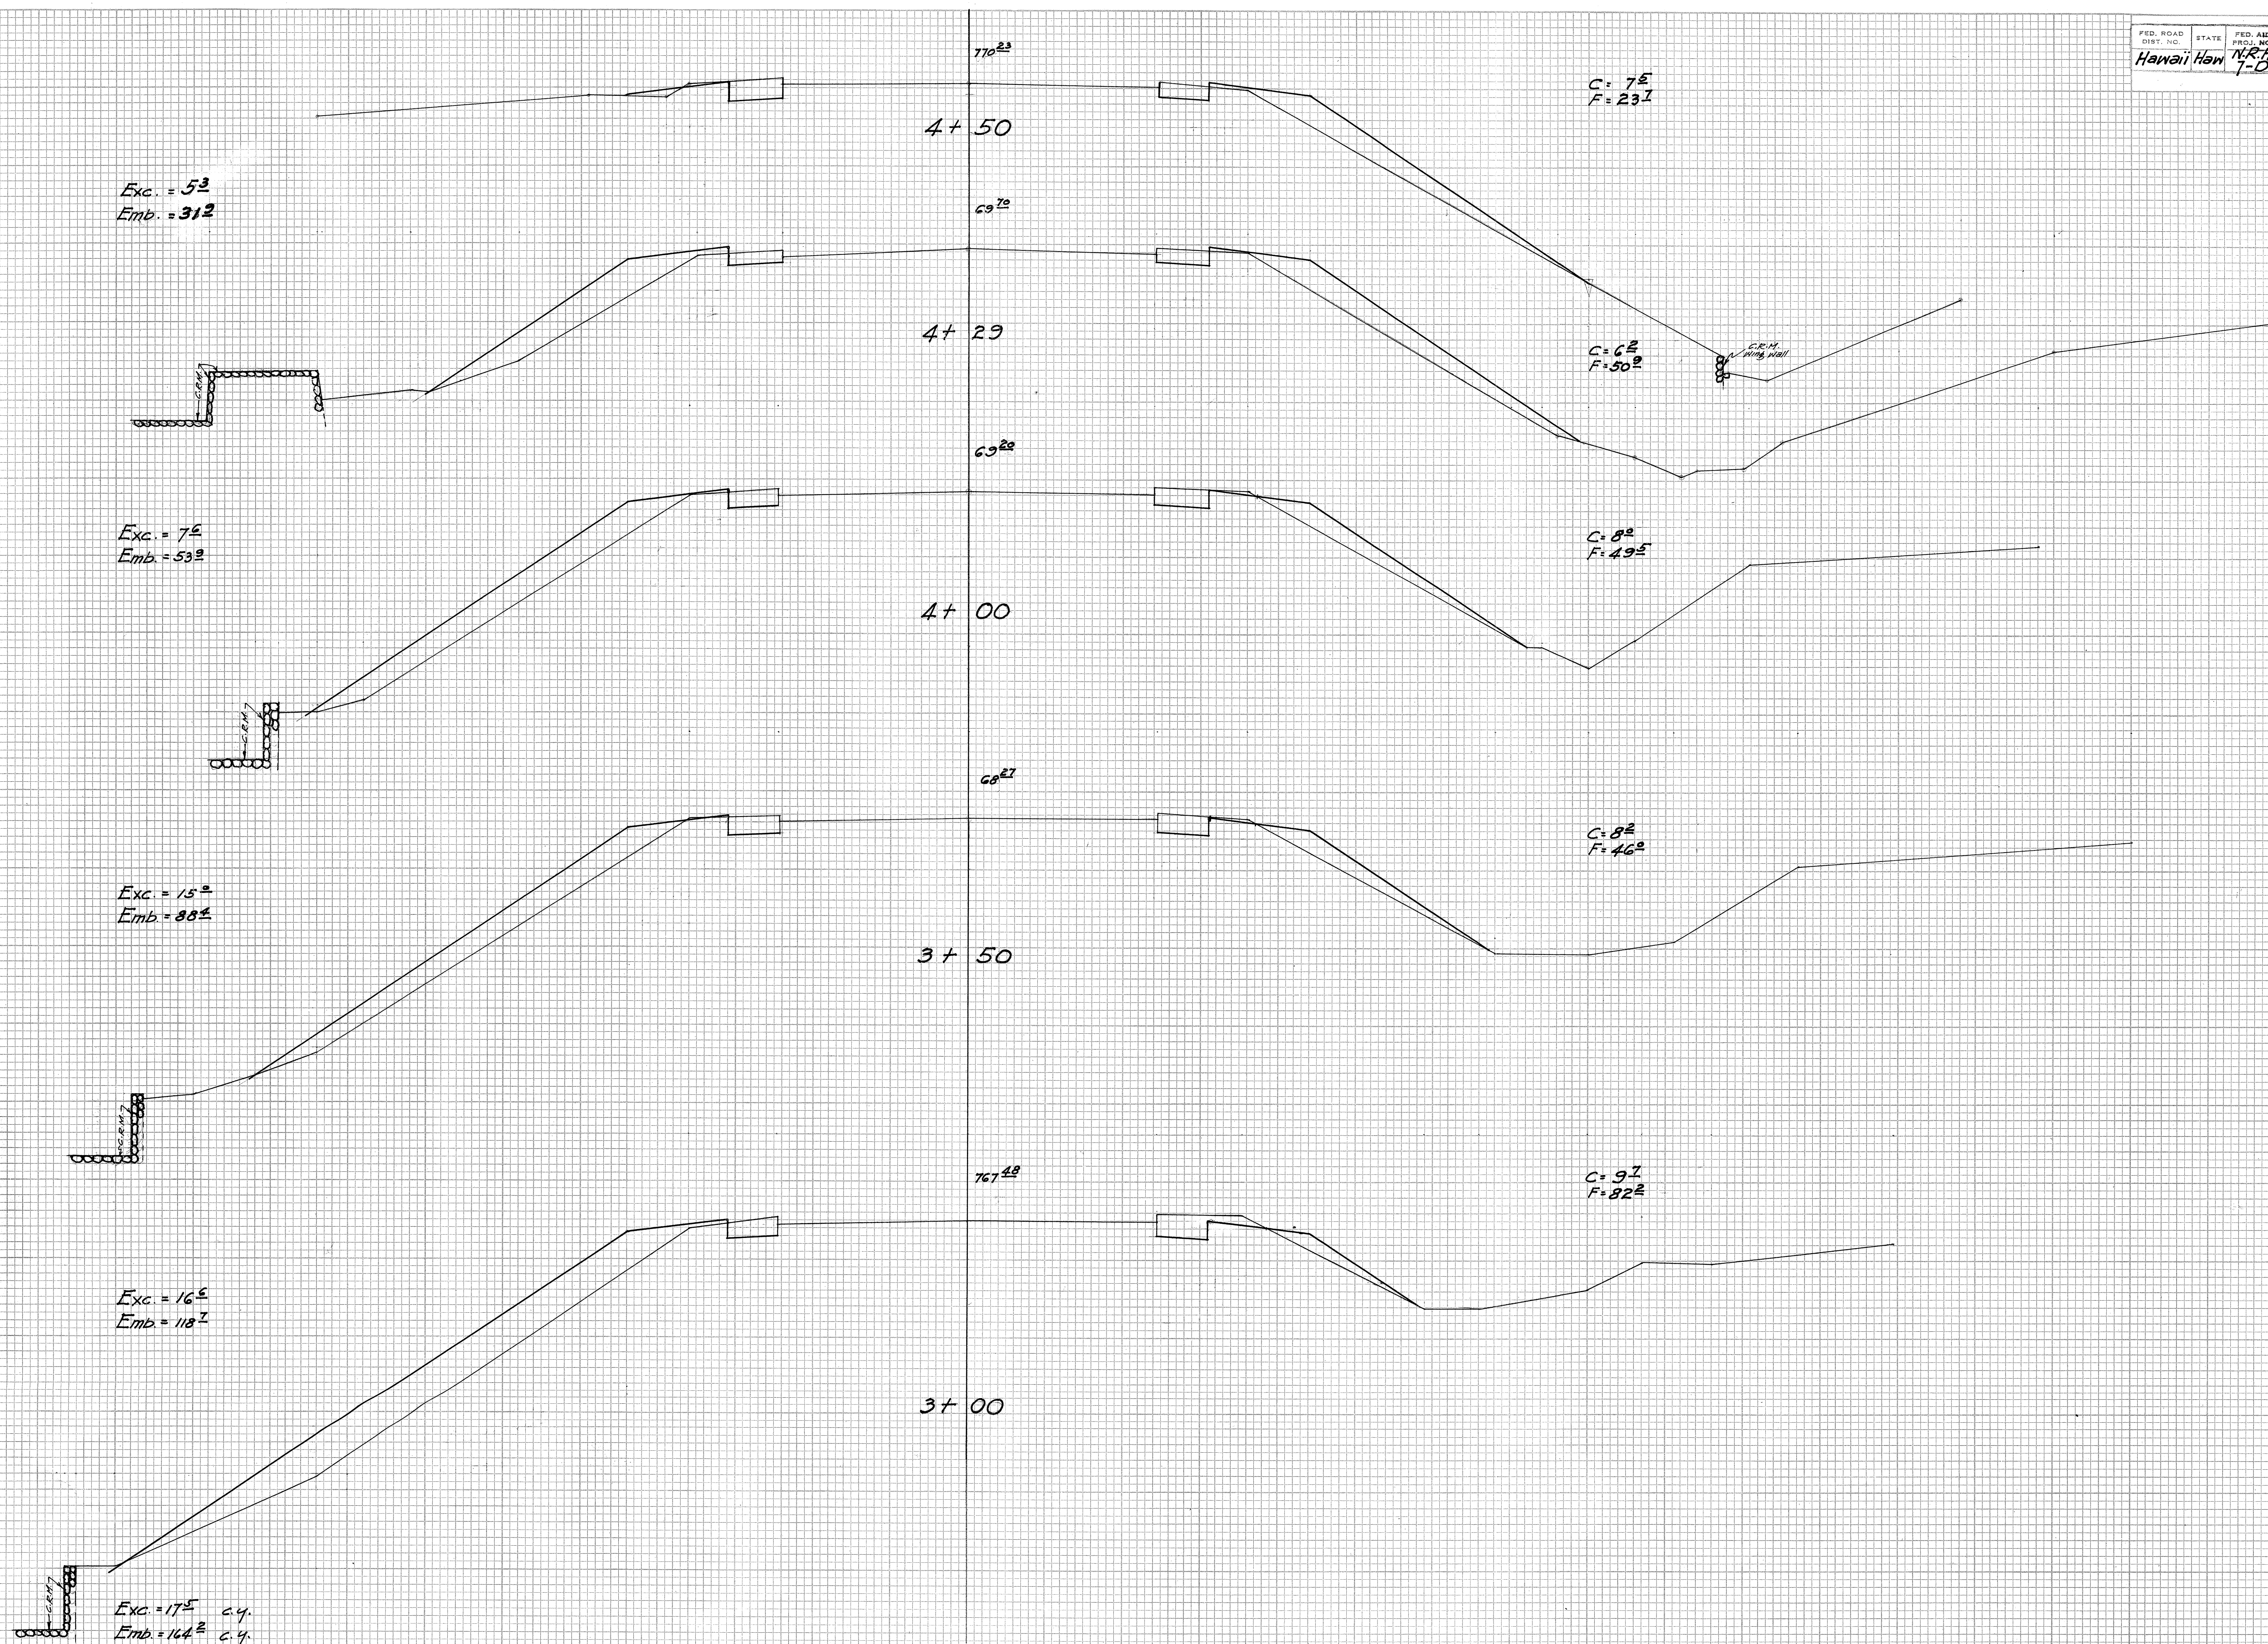


DATE: 1/13/34
BY: G.C.H.
SURVEYED: G.C.H.
PLOTTED: G.C.H.
NOTE BOOK: G.C.H.
AREAS CHECKED: G.C.H.

DATE: 1/13/34
BY: G.C.H.
SURVEYED: G.C.H.
PLOTTED: G.C.H.
NOTE BOOK: G.C.H.
AREAS CHECKED: G.C.H.

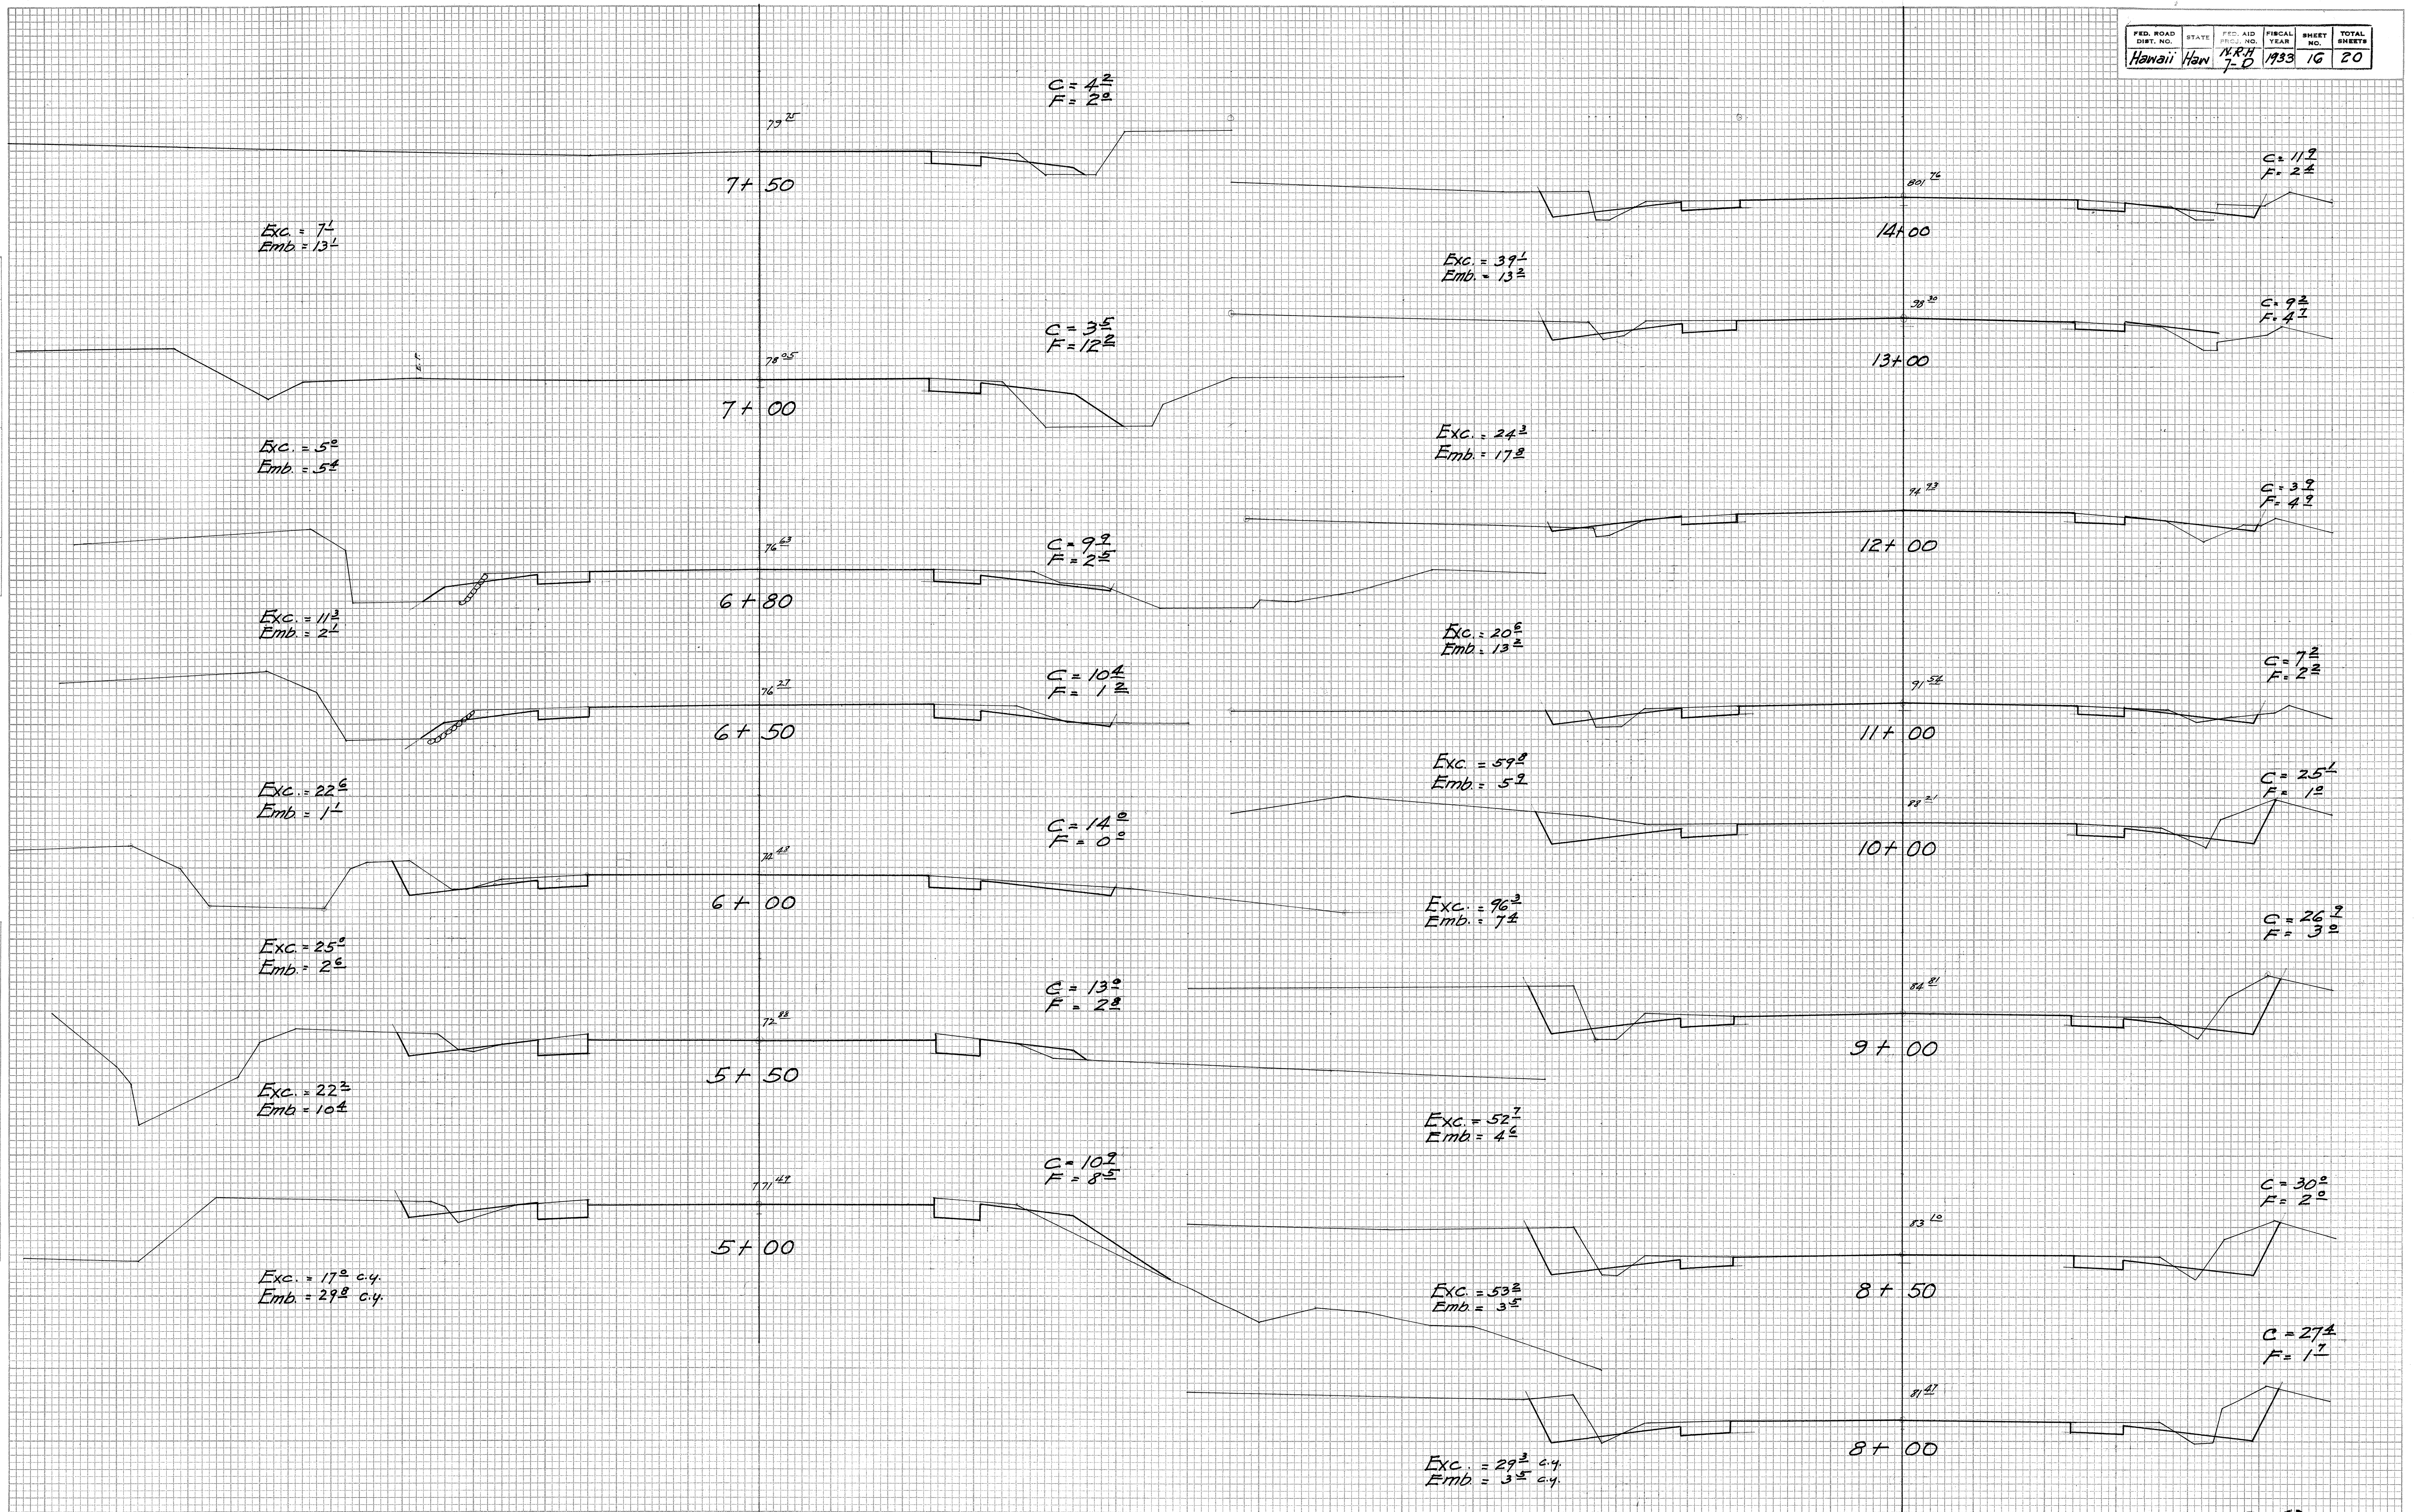

DATE: 12/15/32
BY: A.K.H.
SURVEYED: A.K.H.
NOTE BOOK: A.K.H.
TEMPLATE: A.K.H.
AREAS CHECKED: A.K.H.

DATE: 12/15/32
BY: A.K.H.
SURVEYED: A.K.H.
NOTE BOOK: A.K.H.
TEMPLATE: A.K.H.
AREAS CHECKED: A.K.H.

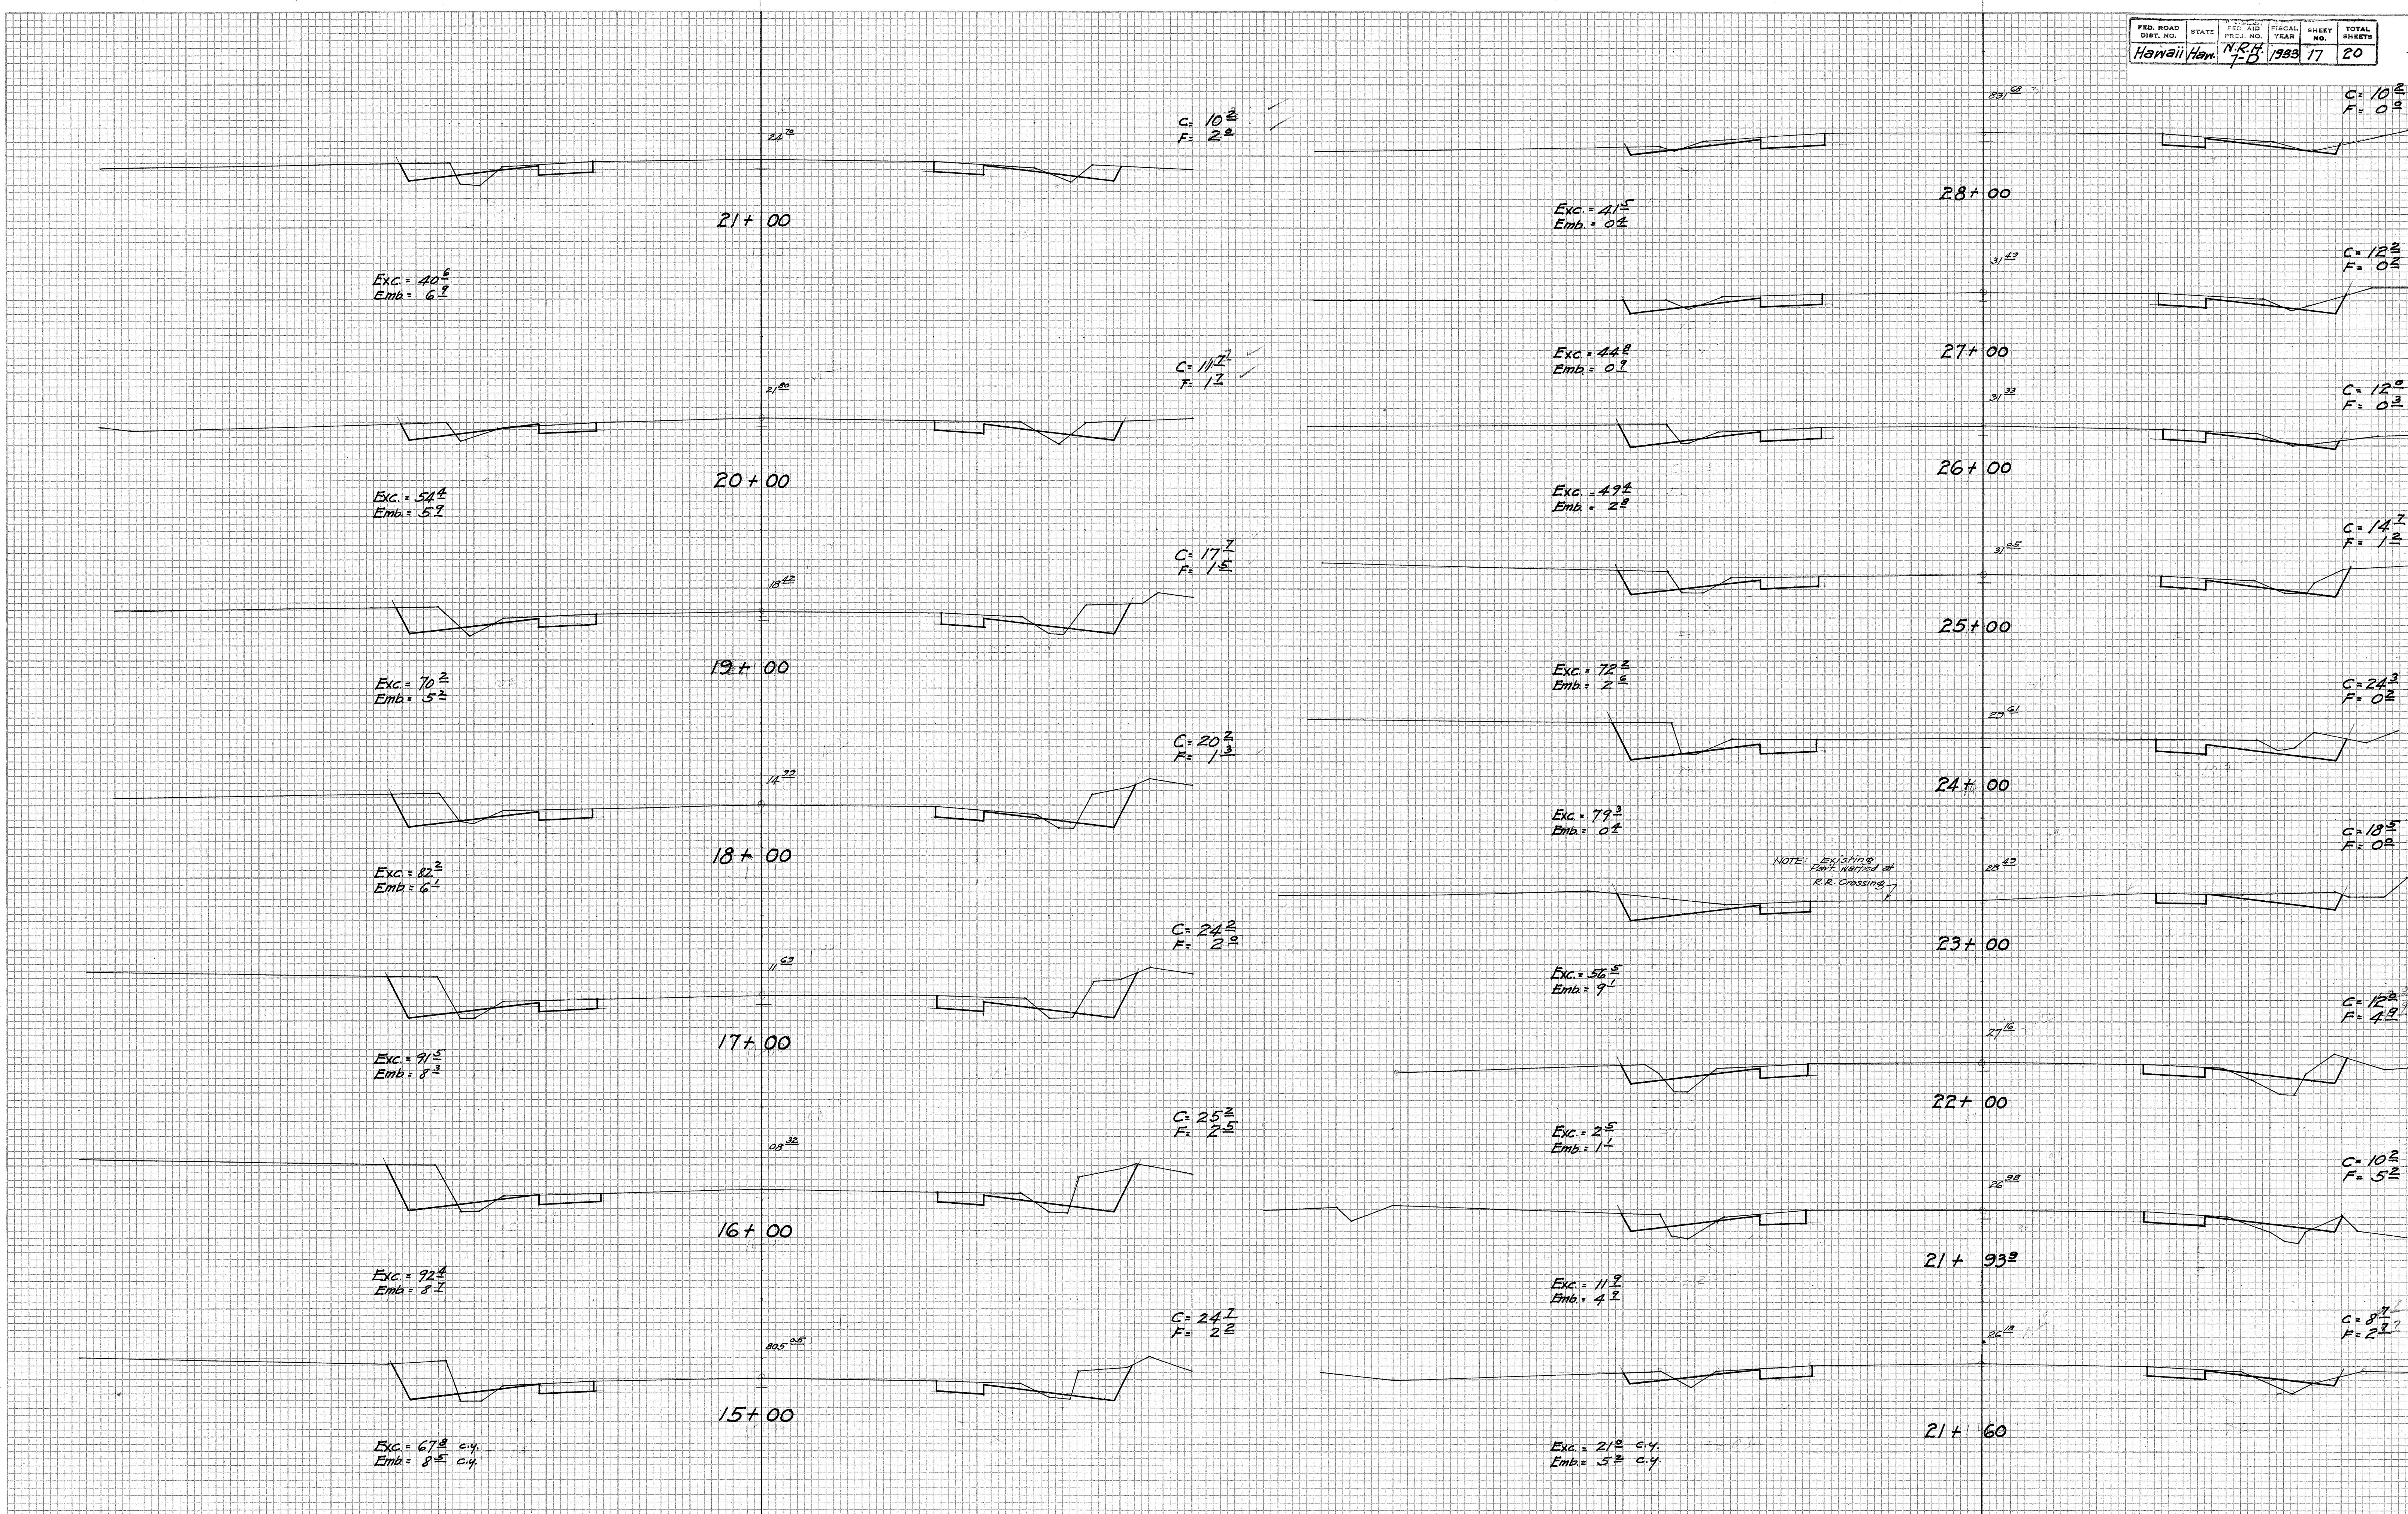

FINAL SURVEY
NOTE BOOK NO.

DATE
1/2/34

BY
A.L. & A.I.
J.L. & C.C.H.

SURVEYED
TEMP. LATE
AREAS CHECKED

ORIGINAL SURVEY
NOTE BOOK NO.

DATE

BY

SURVEYED
TEMP. LATE
AREAS CHECKED

Exc. = 50²
Emb. = 3²

37+00

C = 13⁶
F = 1⁰

Exc. = 51²
Emb. = 2⁶

36+00

C = 13⁵
F = 1⁰

Exc. = 45²
Emb. = 3³

35+00

C = 14⁵
F = 0⁴

Exc. = 35⁶
Emb. = 7⁶

34+00

C = 10²
F = 1⁴

Exc. = 35⁵
Emb. = 13²

33+00

C = 9⁰
F = 2²

Exc. = 33⁵
Emb. = 10²

32+00

C = 10²
F = 4²

Exc. = 28²
Emb. = 6²

31+00

C = 7²
F = 1²

Exc. = 27⁶
Emb. = 5²

30+00

C = 7²
F = 2⁵

Exc. = 33⁰ c.y.
Emb. = 0⁰ c.y.

29+00

C = 7⁶
F = 0²

Exc. = 25²
Emb. = 9⁶

46+00

C = 5²
F = 2²

Exc. = 38²
Emb. = 7²

45+00

C = 7²
F = 2⁵

Exc. = 55²
Emb. = 3²

44+00

C = 13⁰
F = 1²

Exc. = 53²
Emb. = 4²

43+00

C = 17¹
F = 0²

Exc. = 47⁶
Emb. = 5²

42+00

C = 13⁵
F = 1²

Exc. = 51²
Emb. = 5²

41+00

C = 14⁴
F = 1⁵

Exc. = 44²
Emb. = 6²

40+00

C = 9⁵
F = 1²

Exc. = 35²
Emb. = 7²

39+00


C = 9⁴
F = 1²

Exc. = 42⁶ c.y.
Emb. = 5⁴ c.y.

38+00

FINAL SURVEY	BY		DATE
SURVEYED	A. K.		12/33.
PLOTTED	C. A. H.		12/30/33
TEMPLATE	C. A. H.		12/26/33
AREAS			1/2/34
AREAS CHECKED	A. J.		1/3/34

ORIGINAL SURVEY	SURVEYED	BY	DATE
NOTE BOOK	PLOTTED		
	TEMPLATE		
	AREAS		
NO.	AREAS CHECKED		

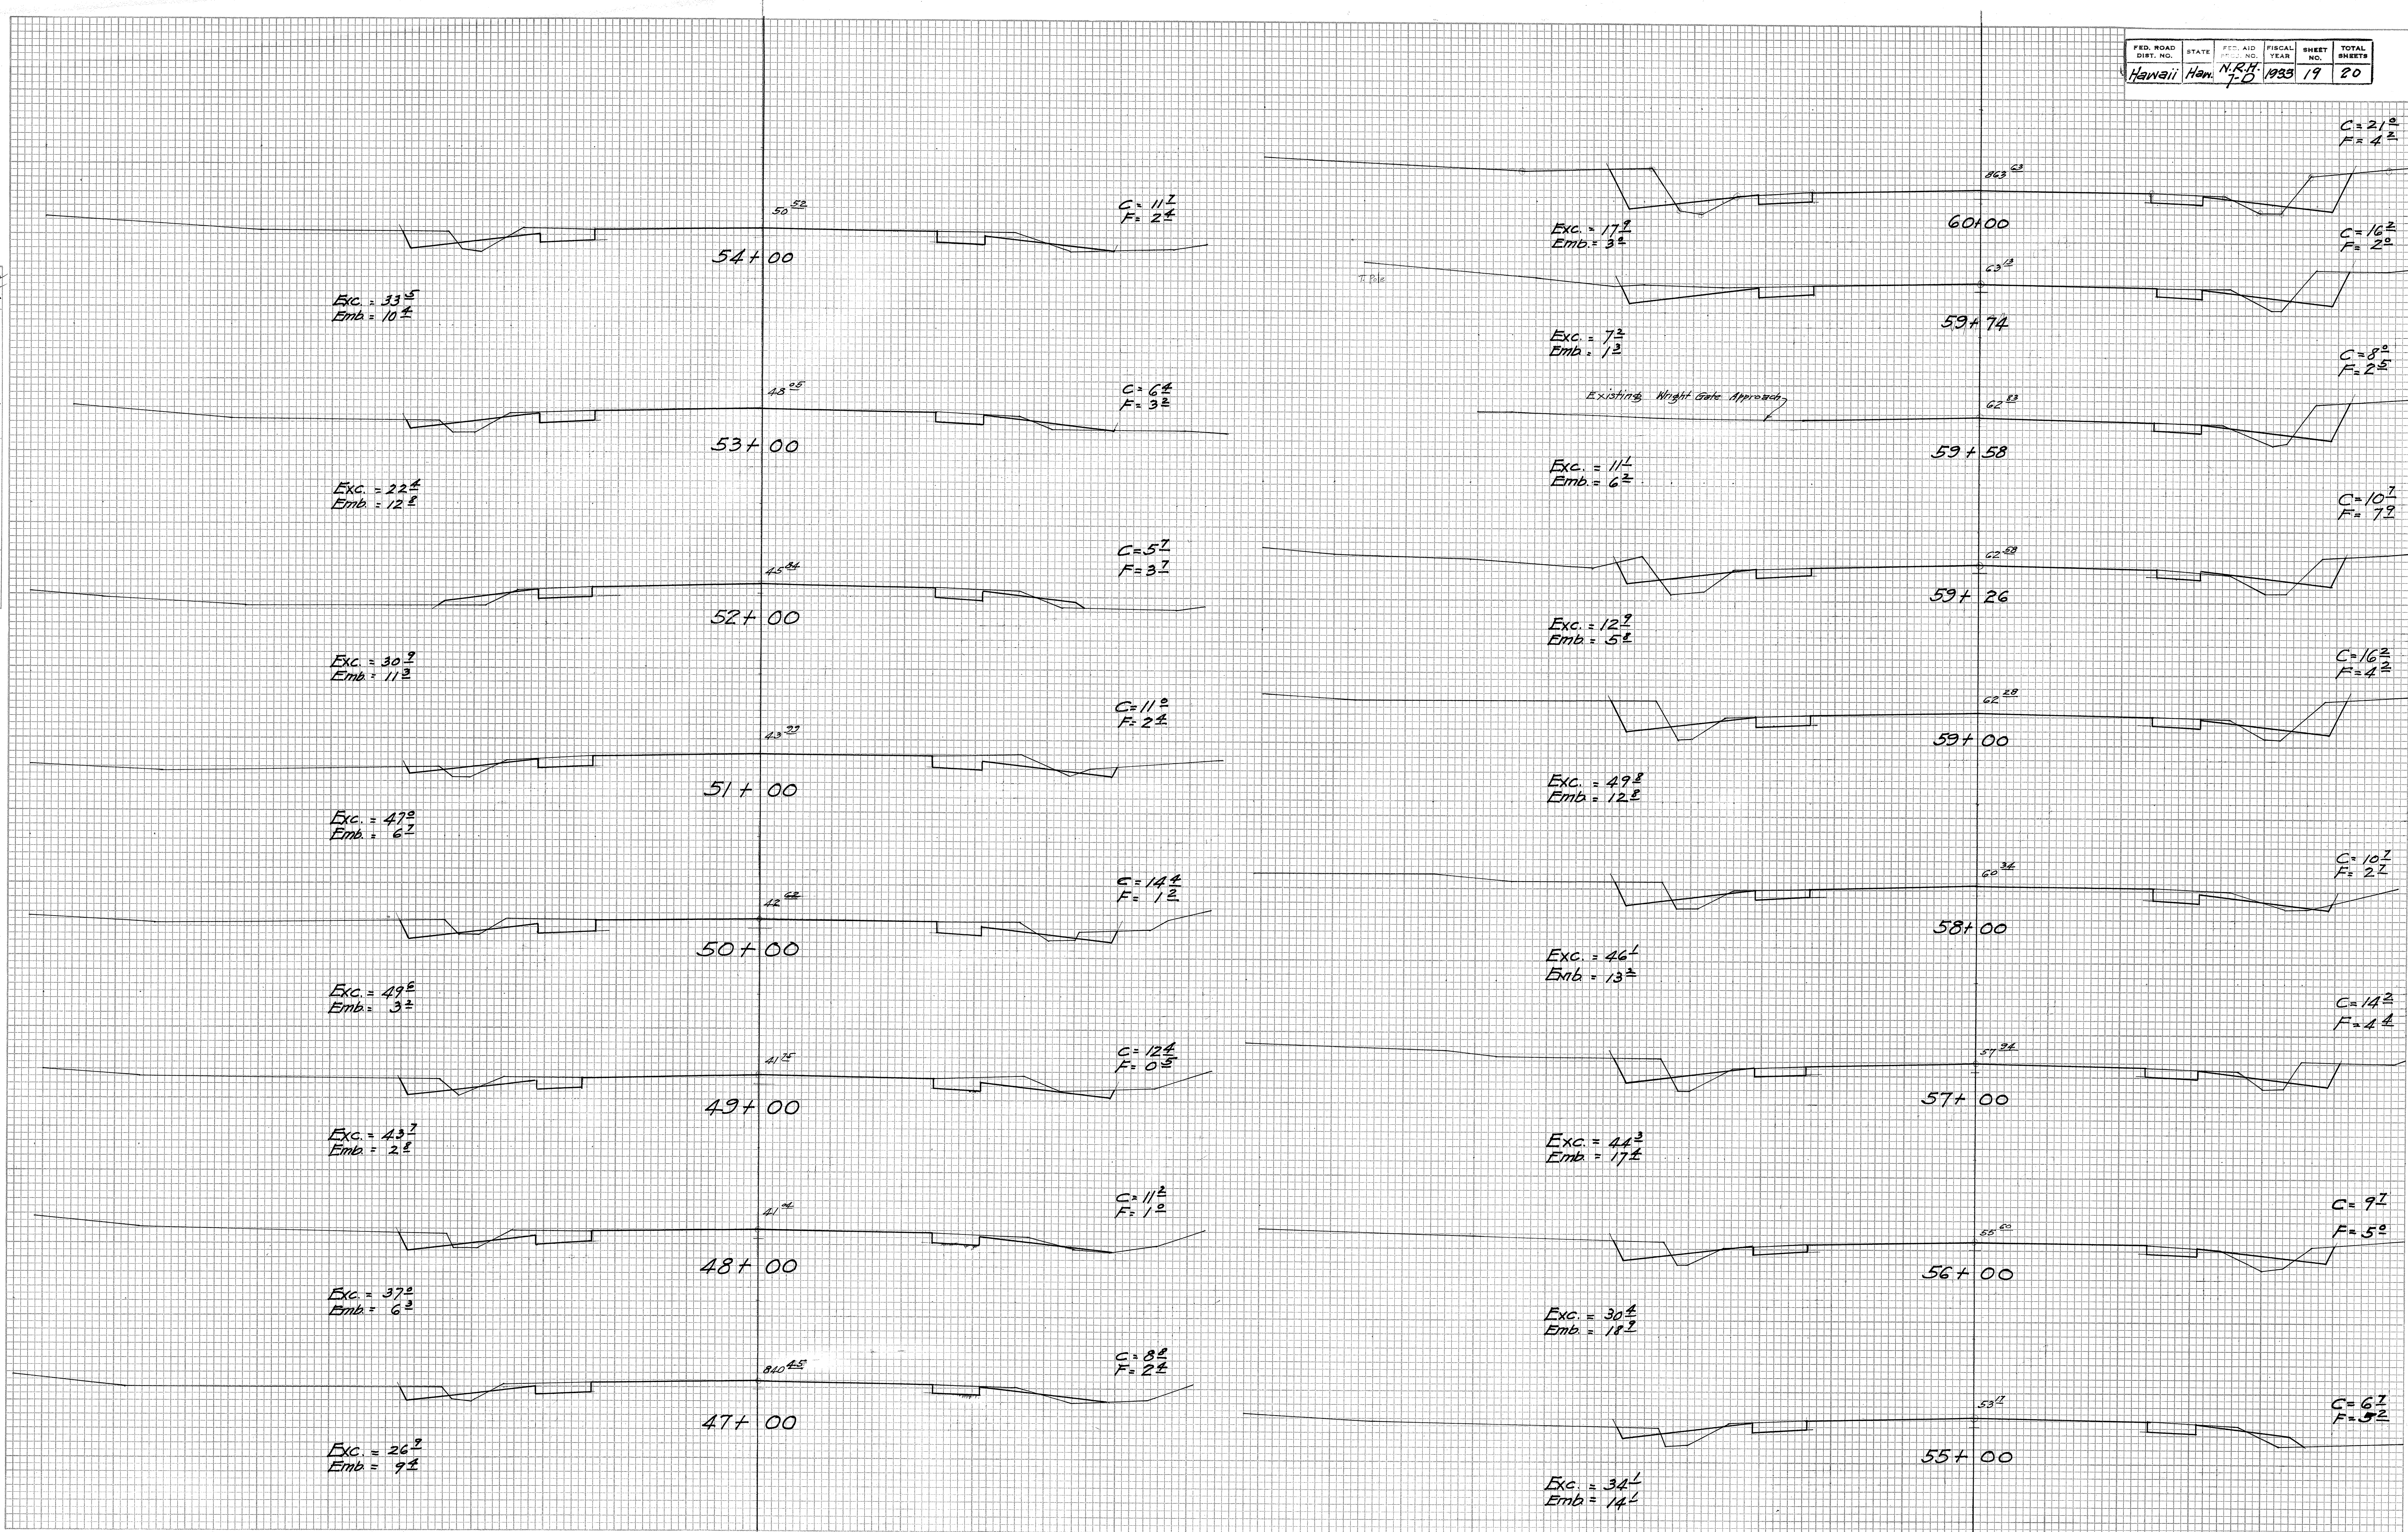

4302.19

FINAL SURVEY		BY	DATE
NOTE BOOK	SURVEYED..... PLOTTED..... TEMPLATE..... AREAS..... AREAS CHECKED.....		
NO. _____	<i>A. K. C. C. H.</i> <i>C. C. H.</i> <i>C. C. H.</i> <i>C. C. H.</i> <i>C. C. H.</i>		<i>12/23</i> <i>1/2/34</i> <i>12/34</i> <i>1/2/34</i> <i>1/3/34</i>

ORIGINAL SURVEY		BY _____	DATE _____
NOTE BOOK			
NO. _____			
	SURVEYED		
	PLOTTED		
	TEMPLATE		
	AREAS		
	AREAS CHECKED		

