


FED. ROAD DIST. NO.	STATE	FISCAL YEAR	SHEET NO.	TOTAL SHEETS
HAWAII	HAW	7F	1932	3

LIST OF COMMON ABBREVIATIONS.
 C.R.M. - Cement Rubble Masonry
 D.R.M. - Dry Rubble Masonry
 C.R.M.P. - Cement Rubble Masonry Paving
 W. - Wall
 H.L.R.R. - Hand Laid Rip-Rap
 Conc. Culvert - Means circular concrete culvert which is either a - cast in place circular concrete culvert b - concrete pipe culvert.
 Box Culvert - Various reinforced concrete box culvert as detailed.
 Metal Culvert - Corrugated galvanized metal pipe culvert.
 C.D.I. - Concrete Drop Intake
 M.D.I. - Masonry Drop Intake
 C.H.W. - Concrete Head Wall
 M.H.W. - Masonry Head Wall
 C.B. - Catch Basin
 Header - Lava Rock Header
 Curb - Lava Rock Curb
 • T.P. - Telephone Pole
 • E.P. - Electric Pole
 Ⓢ - Large Tree
Notes in Red
 AC Wheeler
 4-13-34

All privately owned structures will be moved off the Right of Way by the Gov't or E.W.O.



Concrete B. Monuments MKD. ©

Sta	27
"	28
"	29
"	29 + 50
"	31 + 16.11
"	39 + 65.23
"	41 + 50
"	44 + 82.64
"	49 + 17.08
"	55 + 13.81

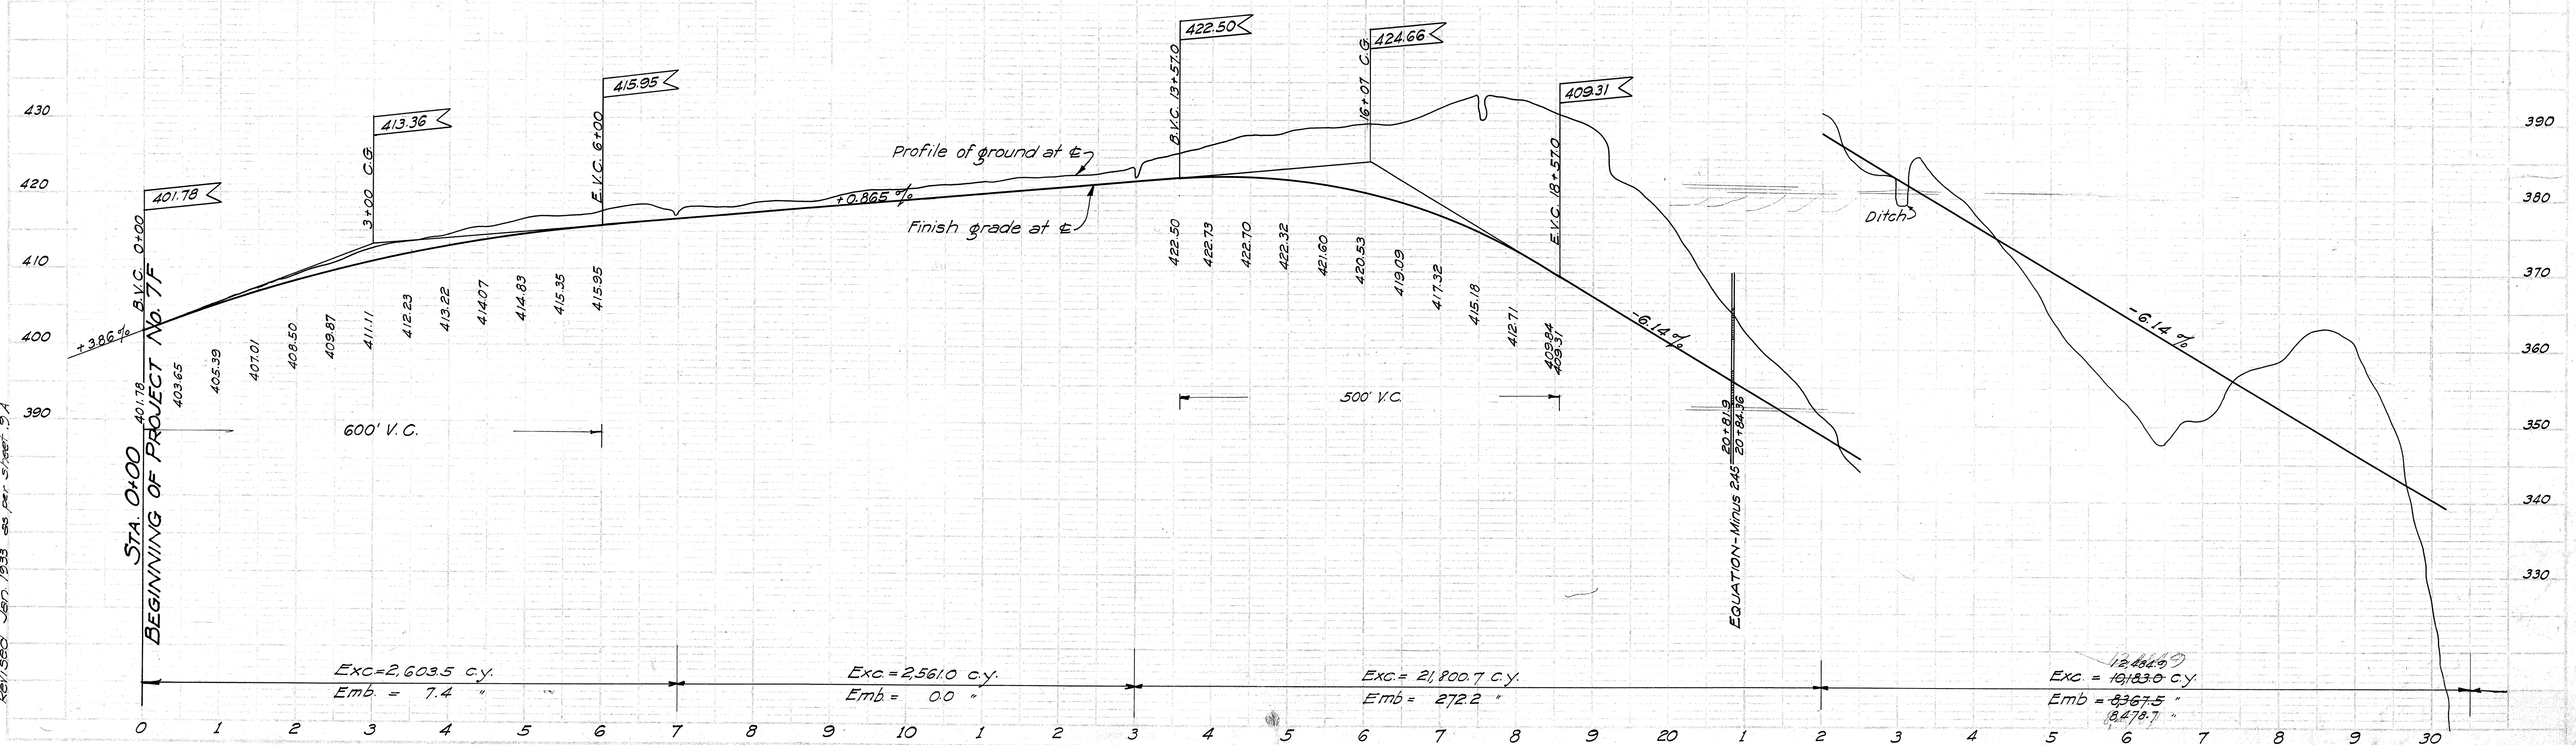



4276.3

FED. ROAD DIST. NO.	STATE	FED. AID PROJ. NO.	FISCAL YEAR	SHEET NO.	TOTAL SHEETS
HAWAII	HAW	7F	1932	5	46

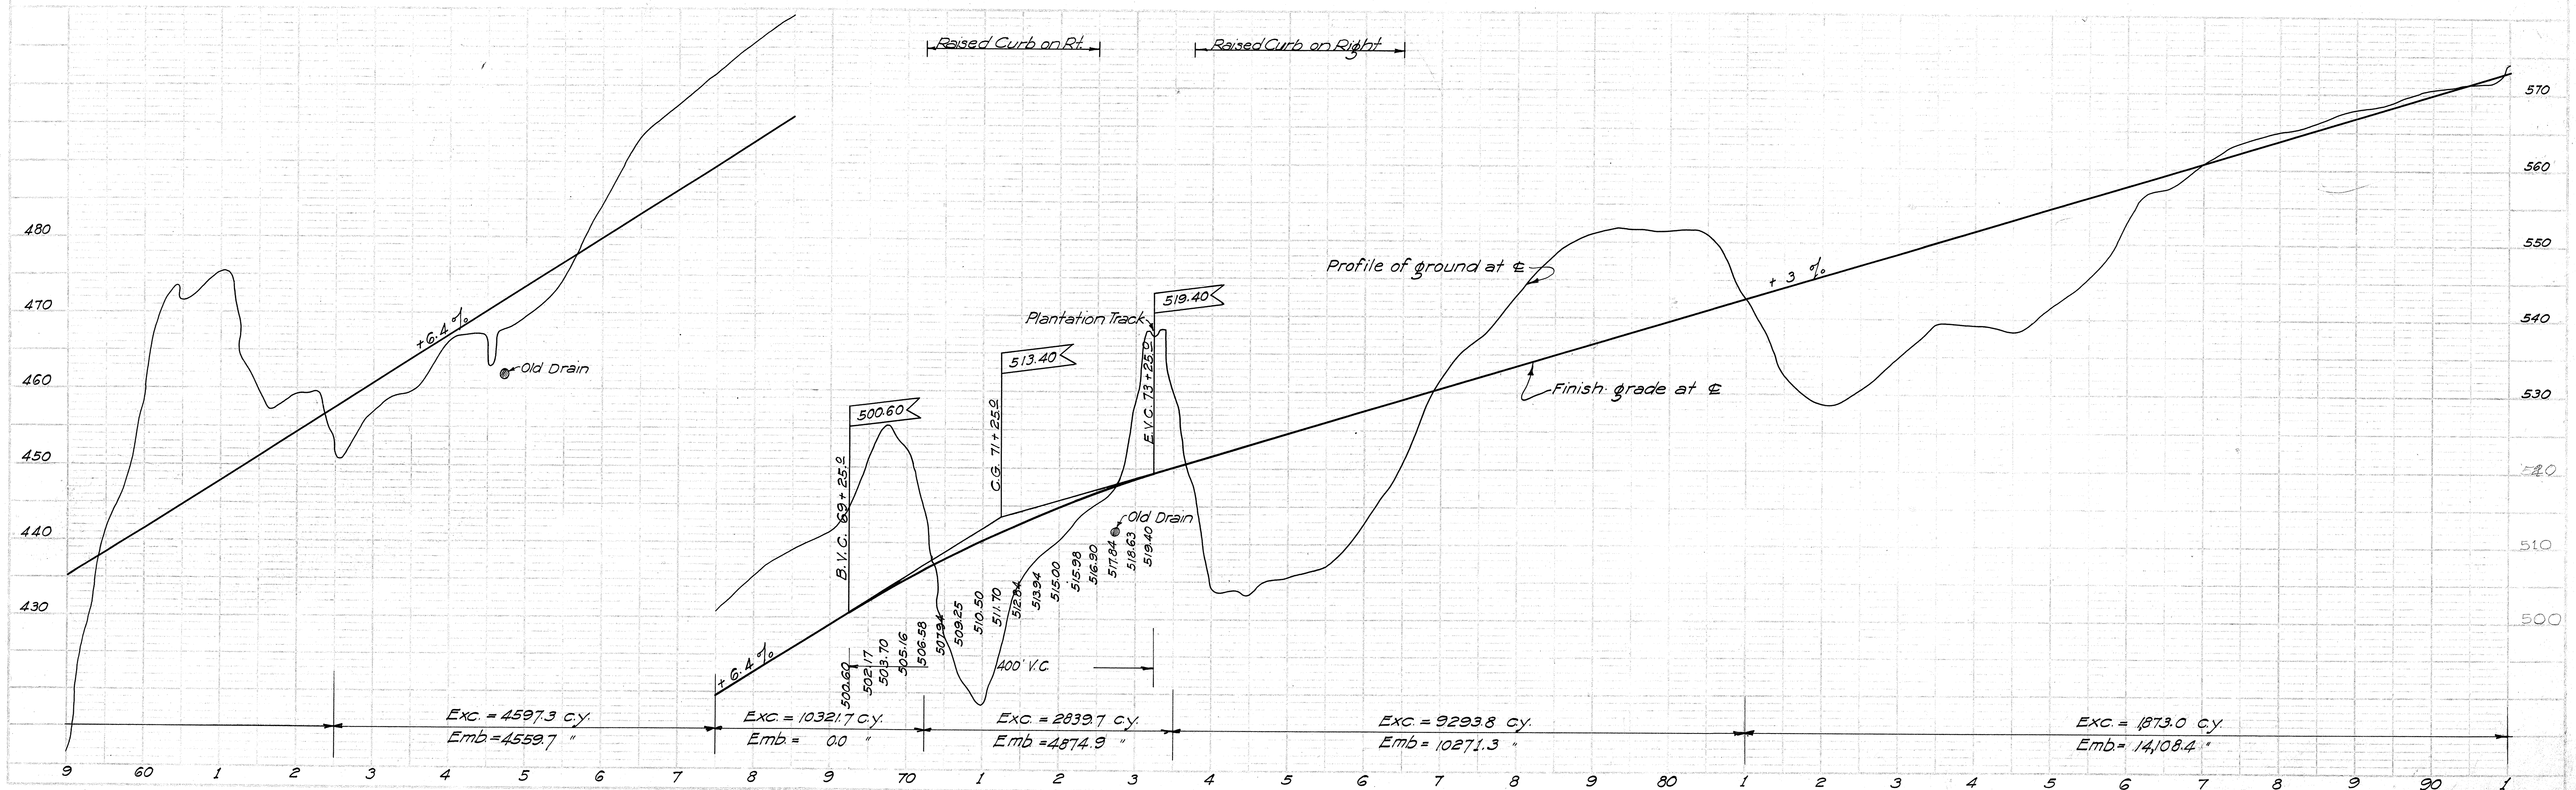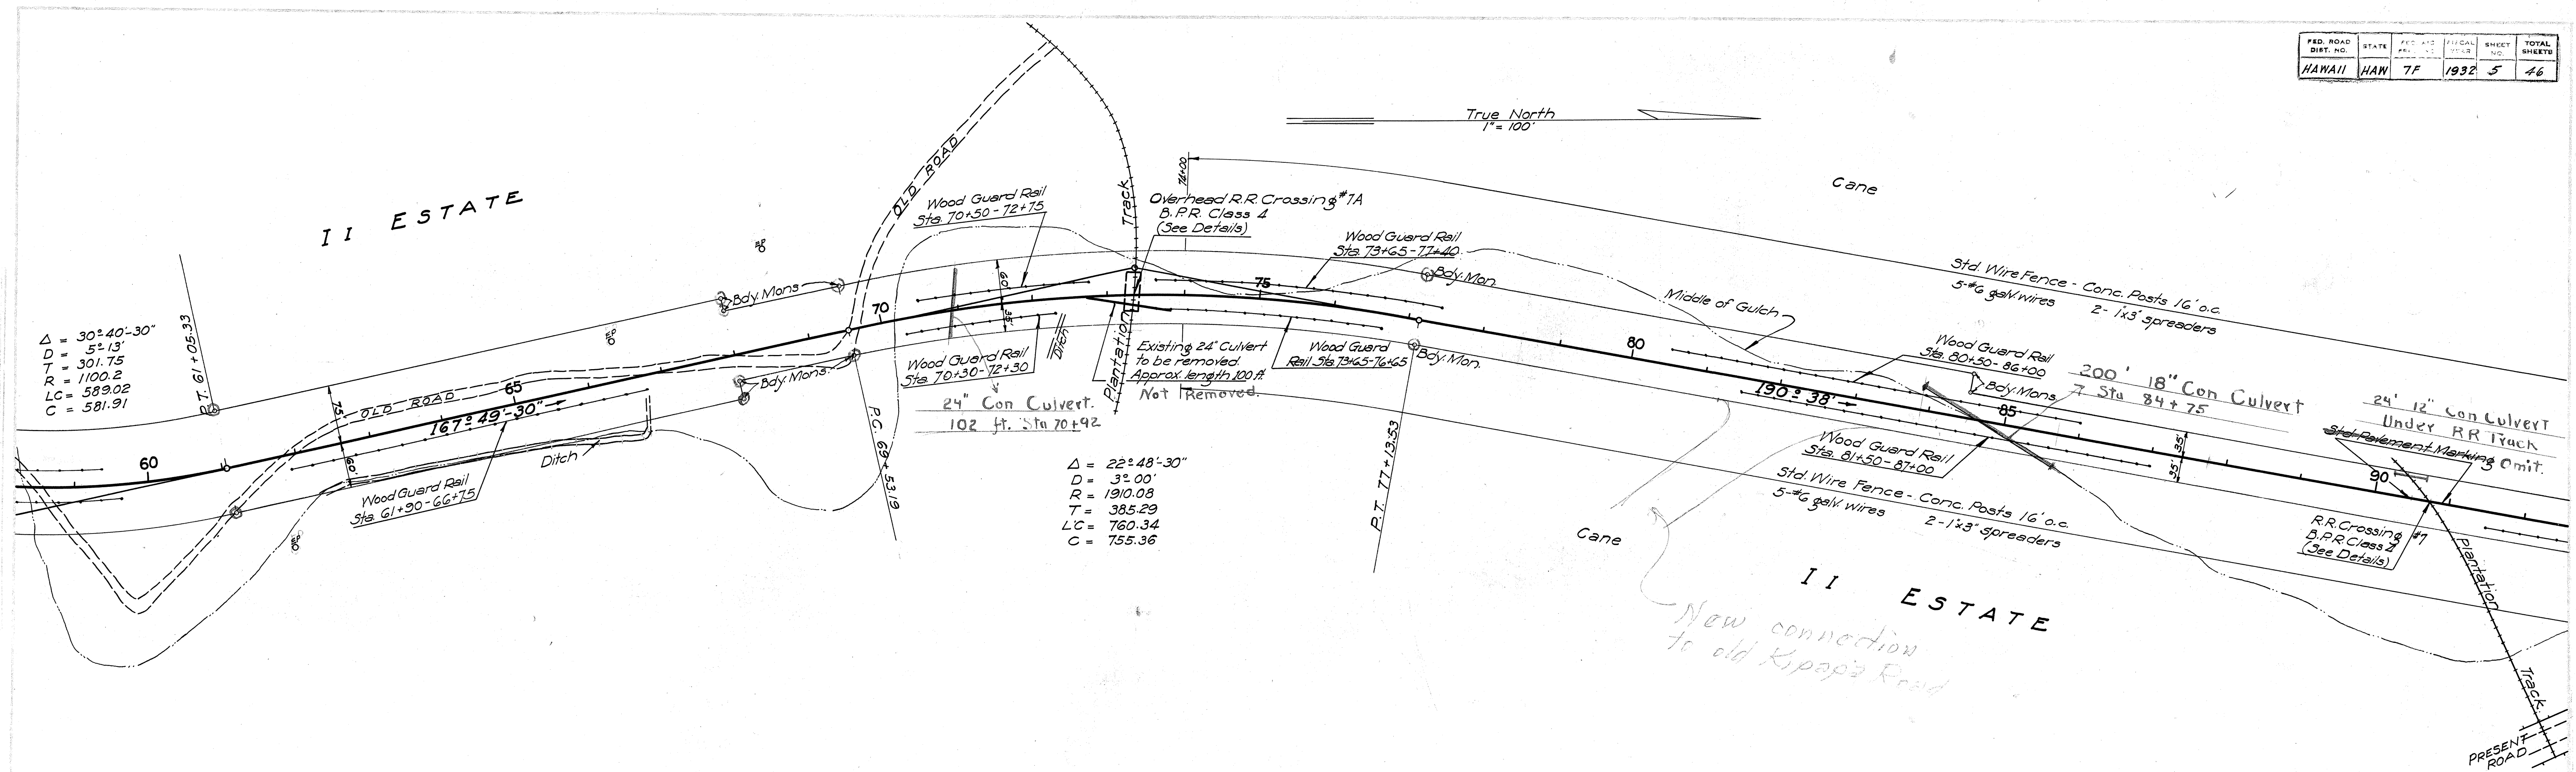




4276.5

FED. ROAD DIST. NO.	STATE	FED. AID FISC. YEAR	FISCAL YEAR	SHEET NO.	TOTAL SHEETS
HAWAII	HAW	7F	1932	6	46

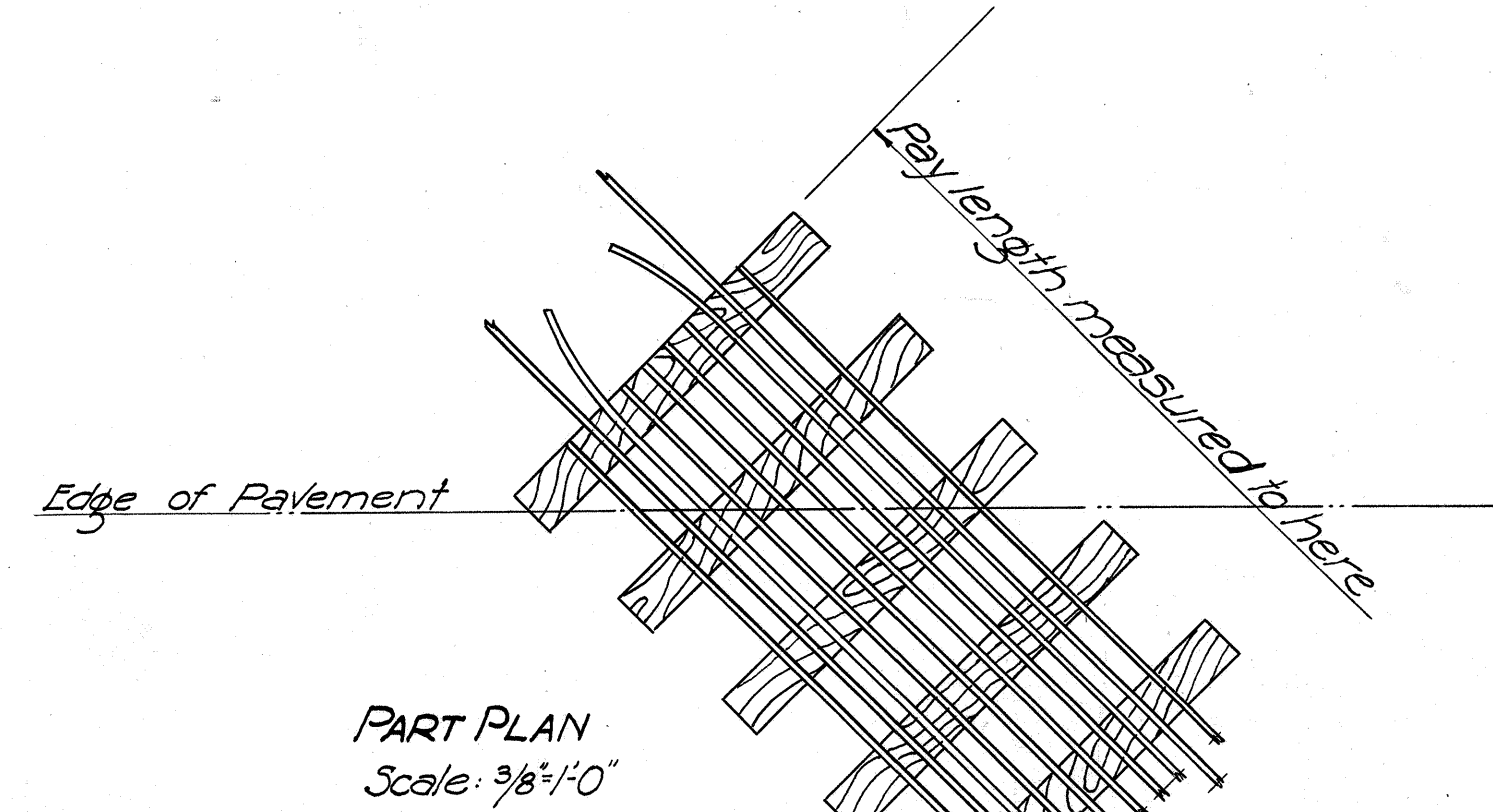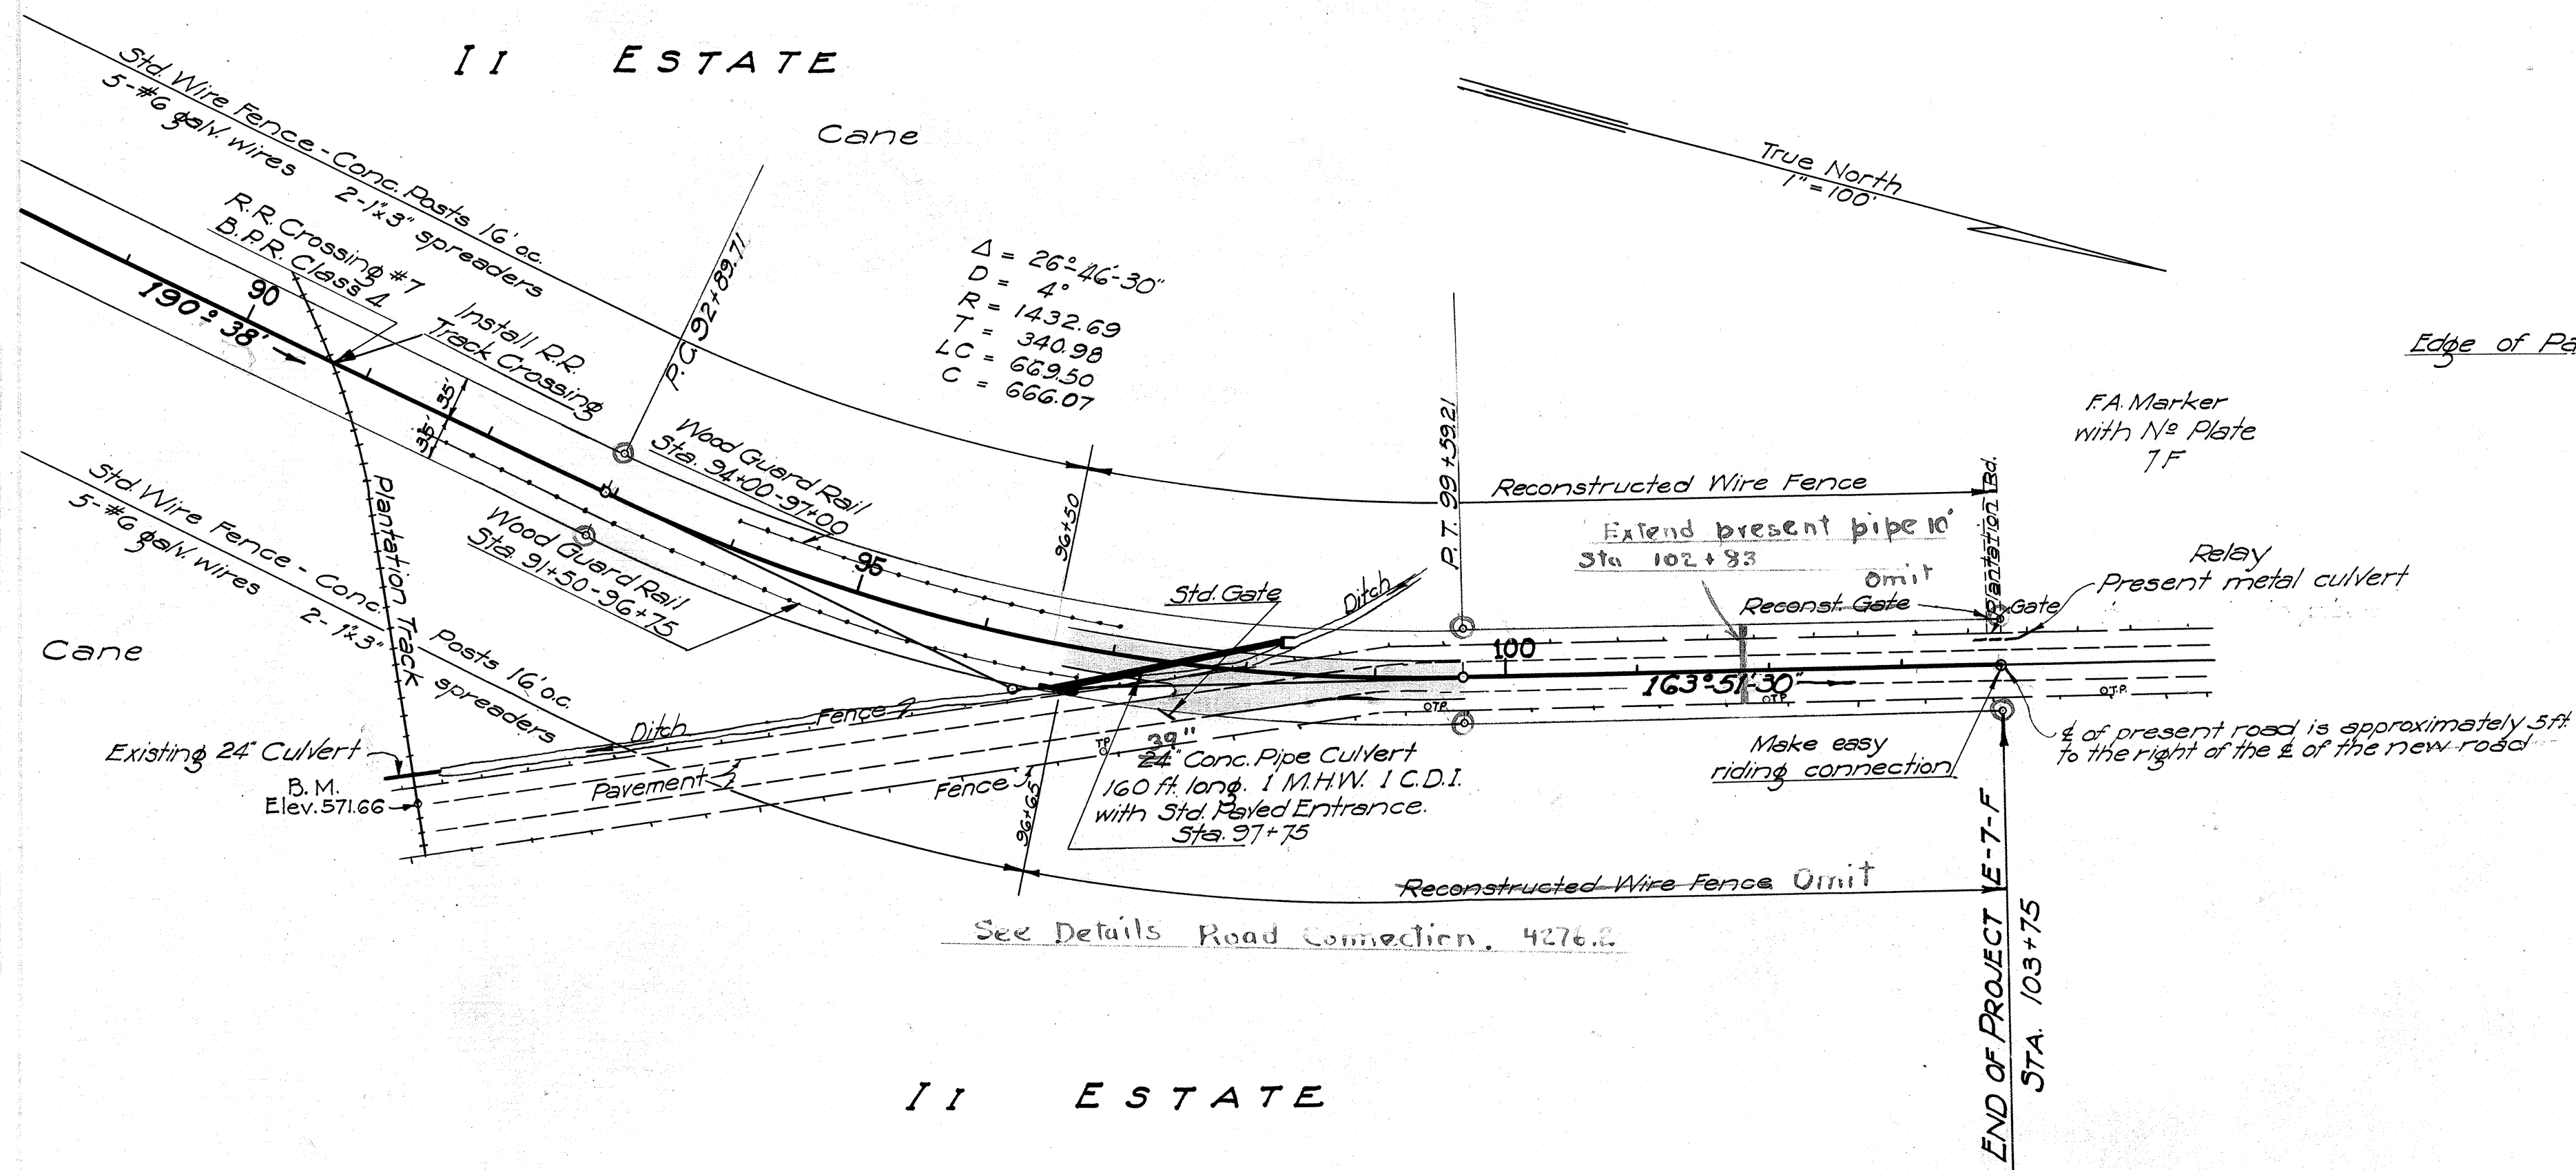

DETAILS R.R. TRACK CROSSING

Scale: As noted.

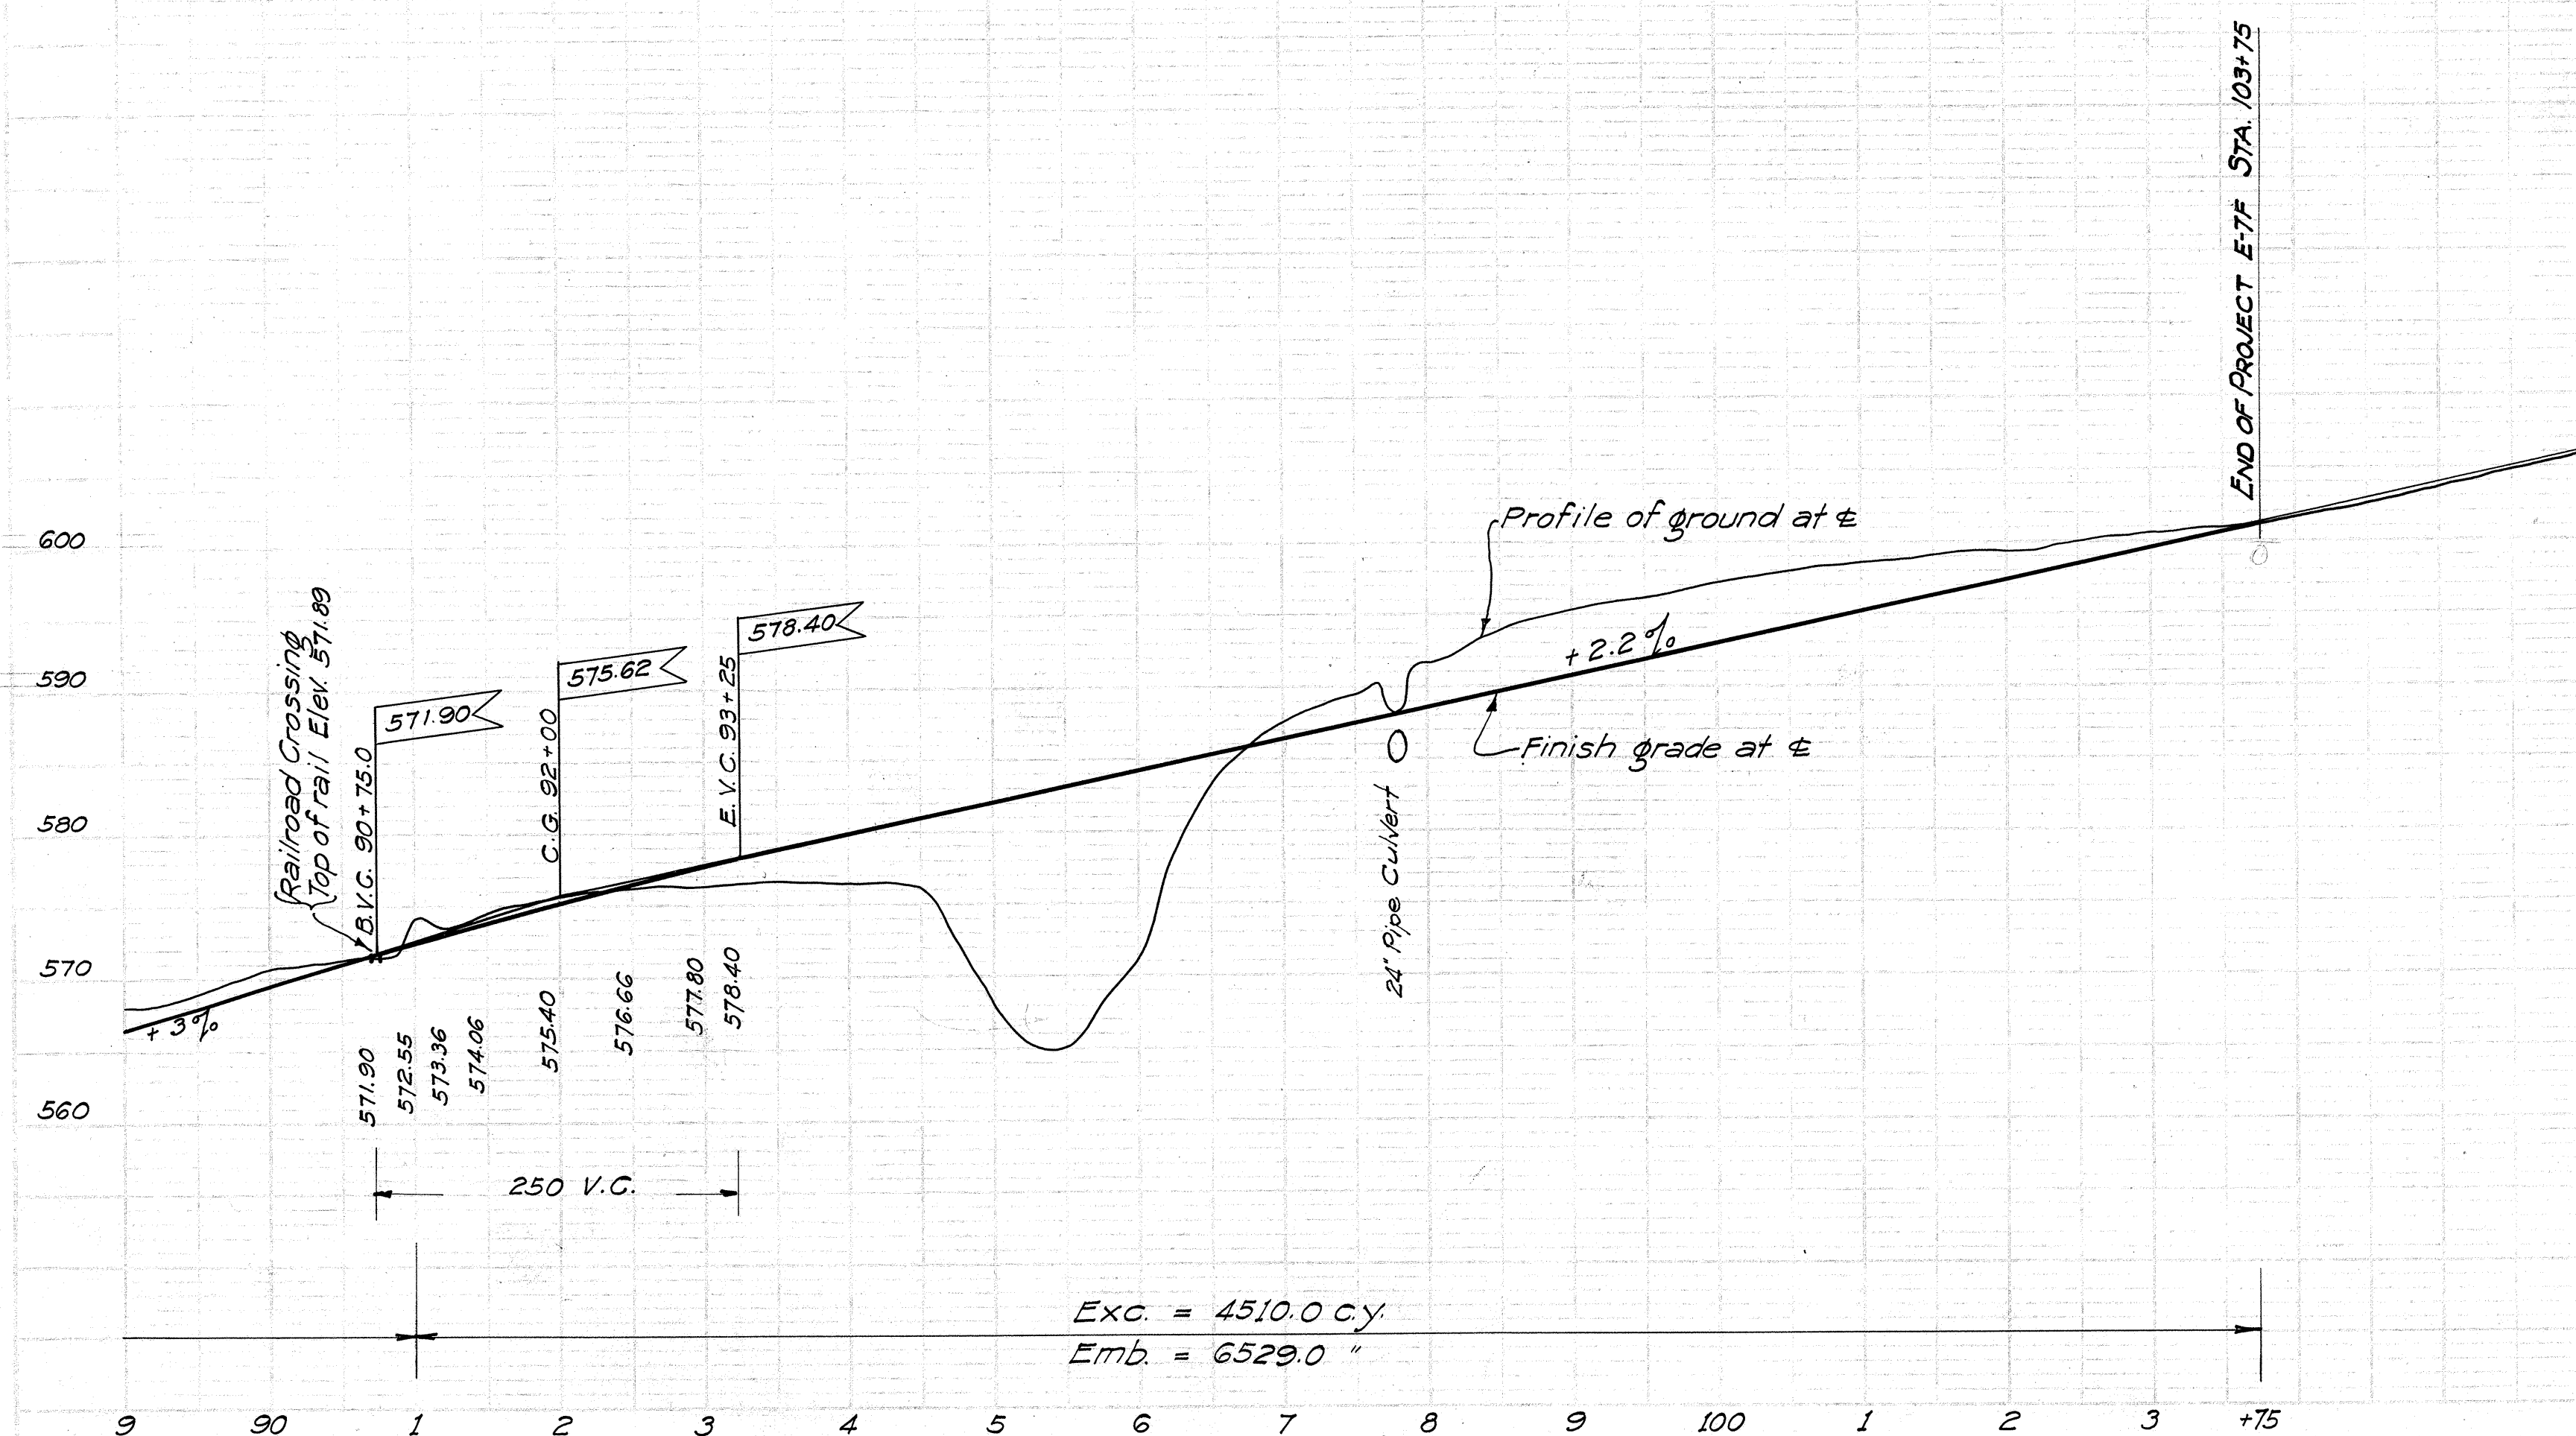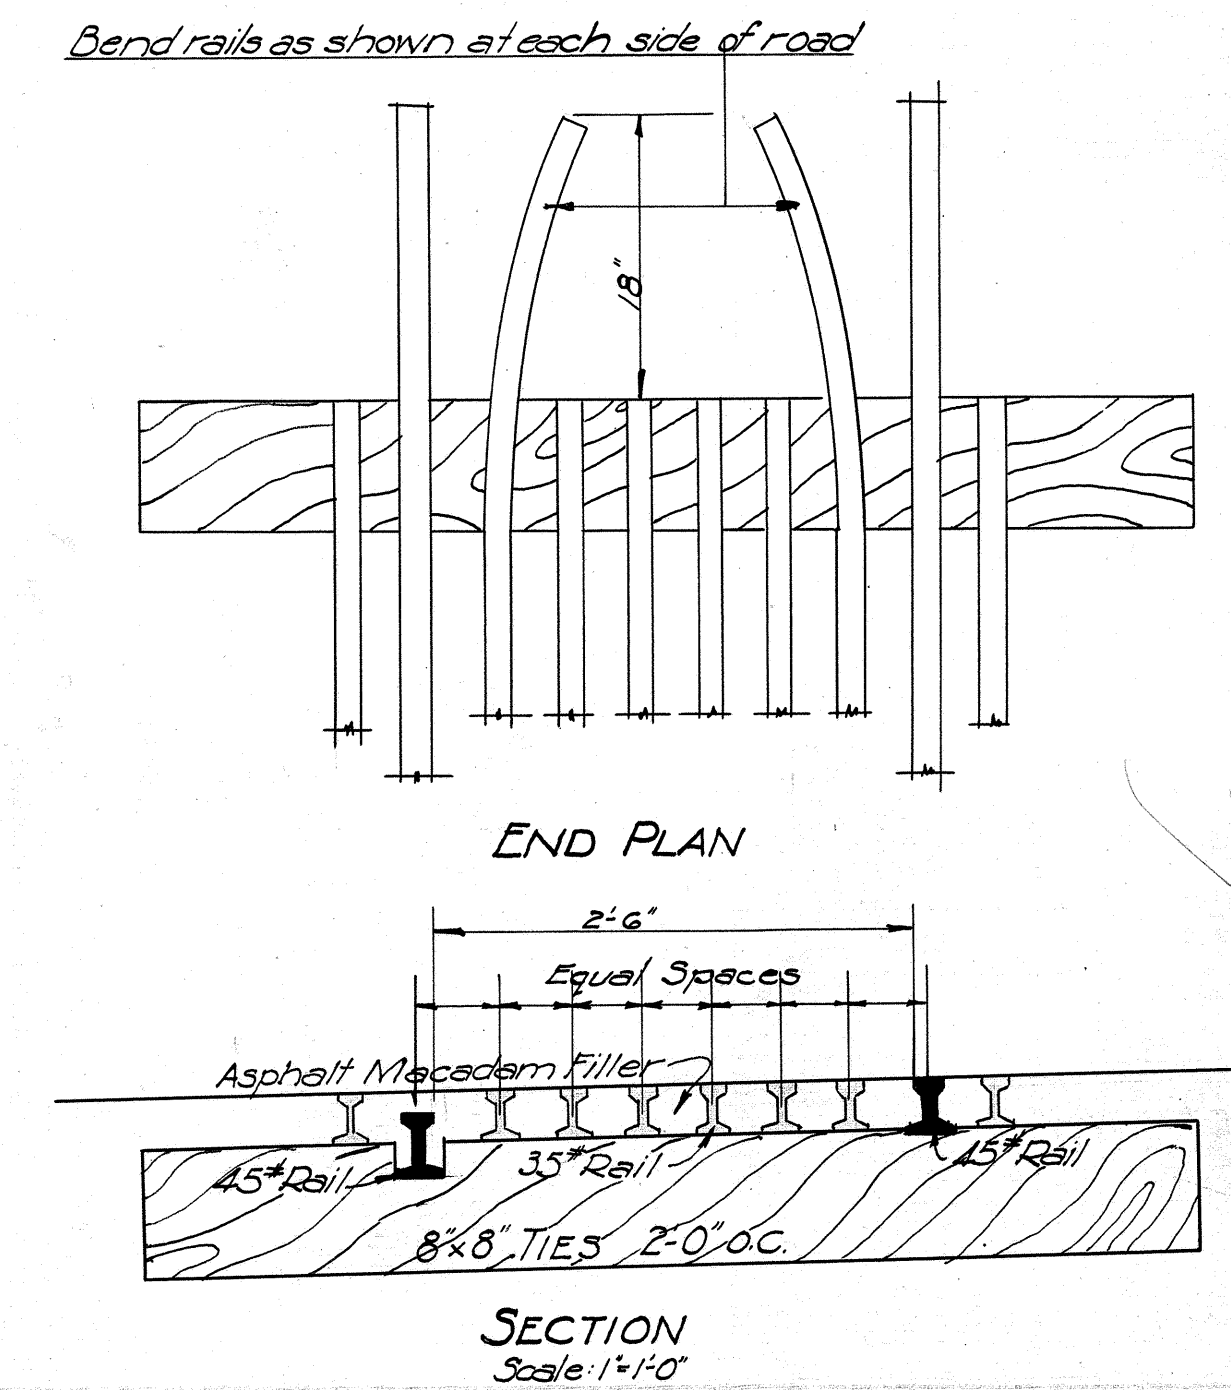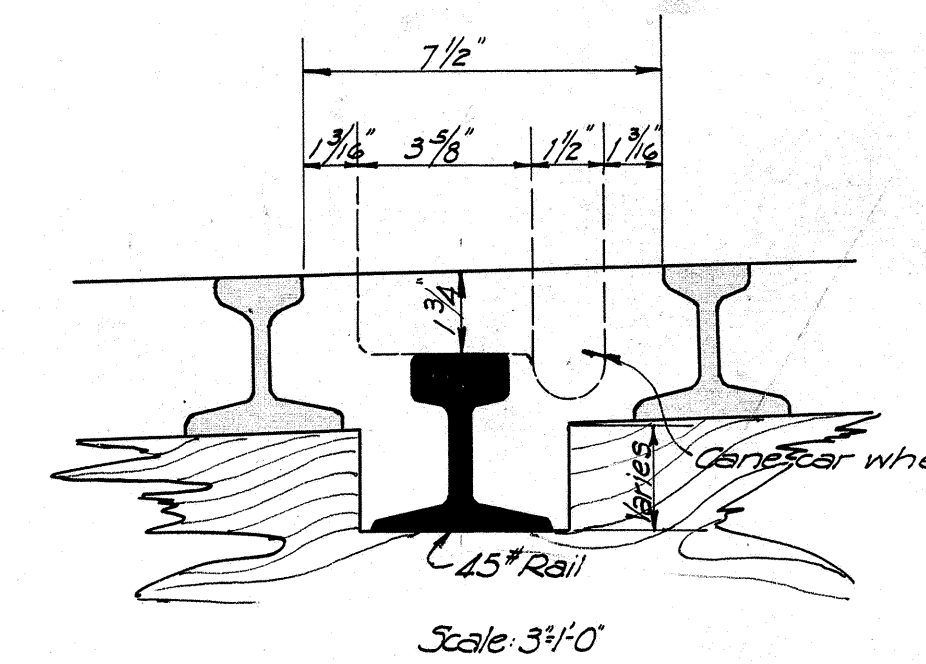

4276.6