



FED. ROAD DIST. NO.	STATE	FED. AID PROJ. NO.	FISCAL YEAR	SHEET NO.	TOTAL SHEETS
HAWAII	HAW	7-F	1932	2A	46


This Sheet supercedes Sheet No. 4276.9

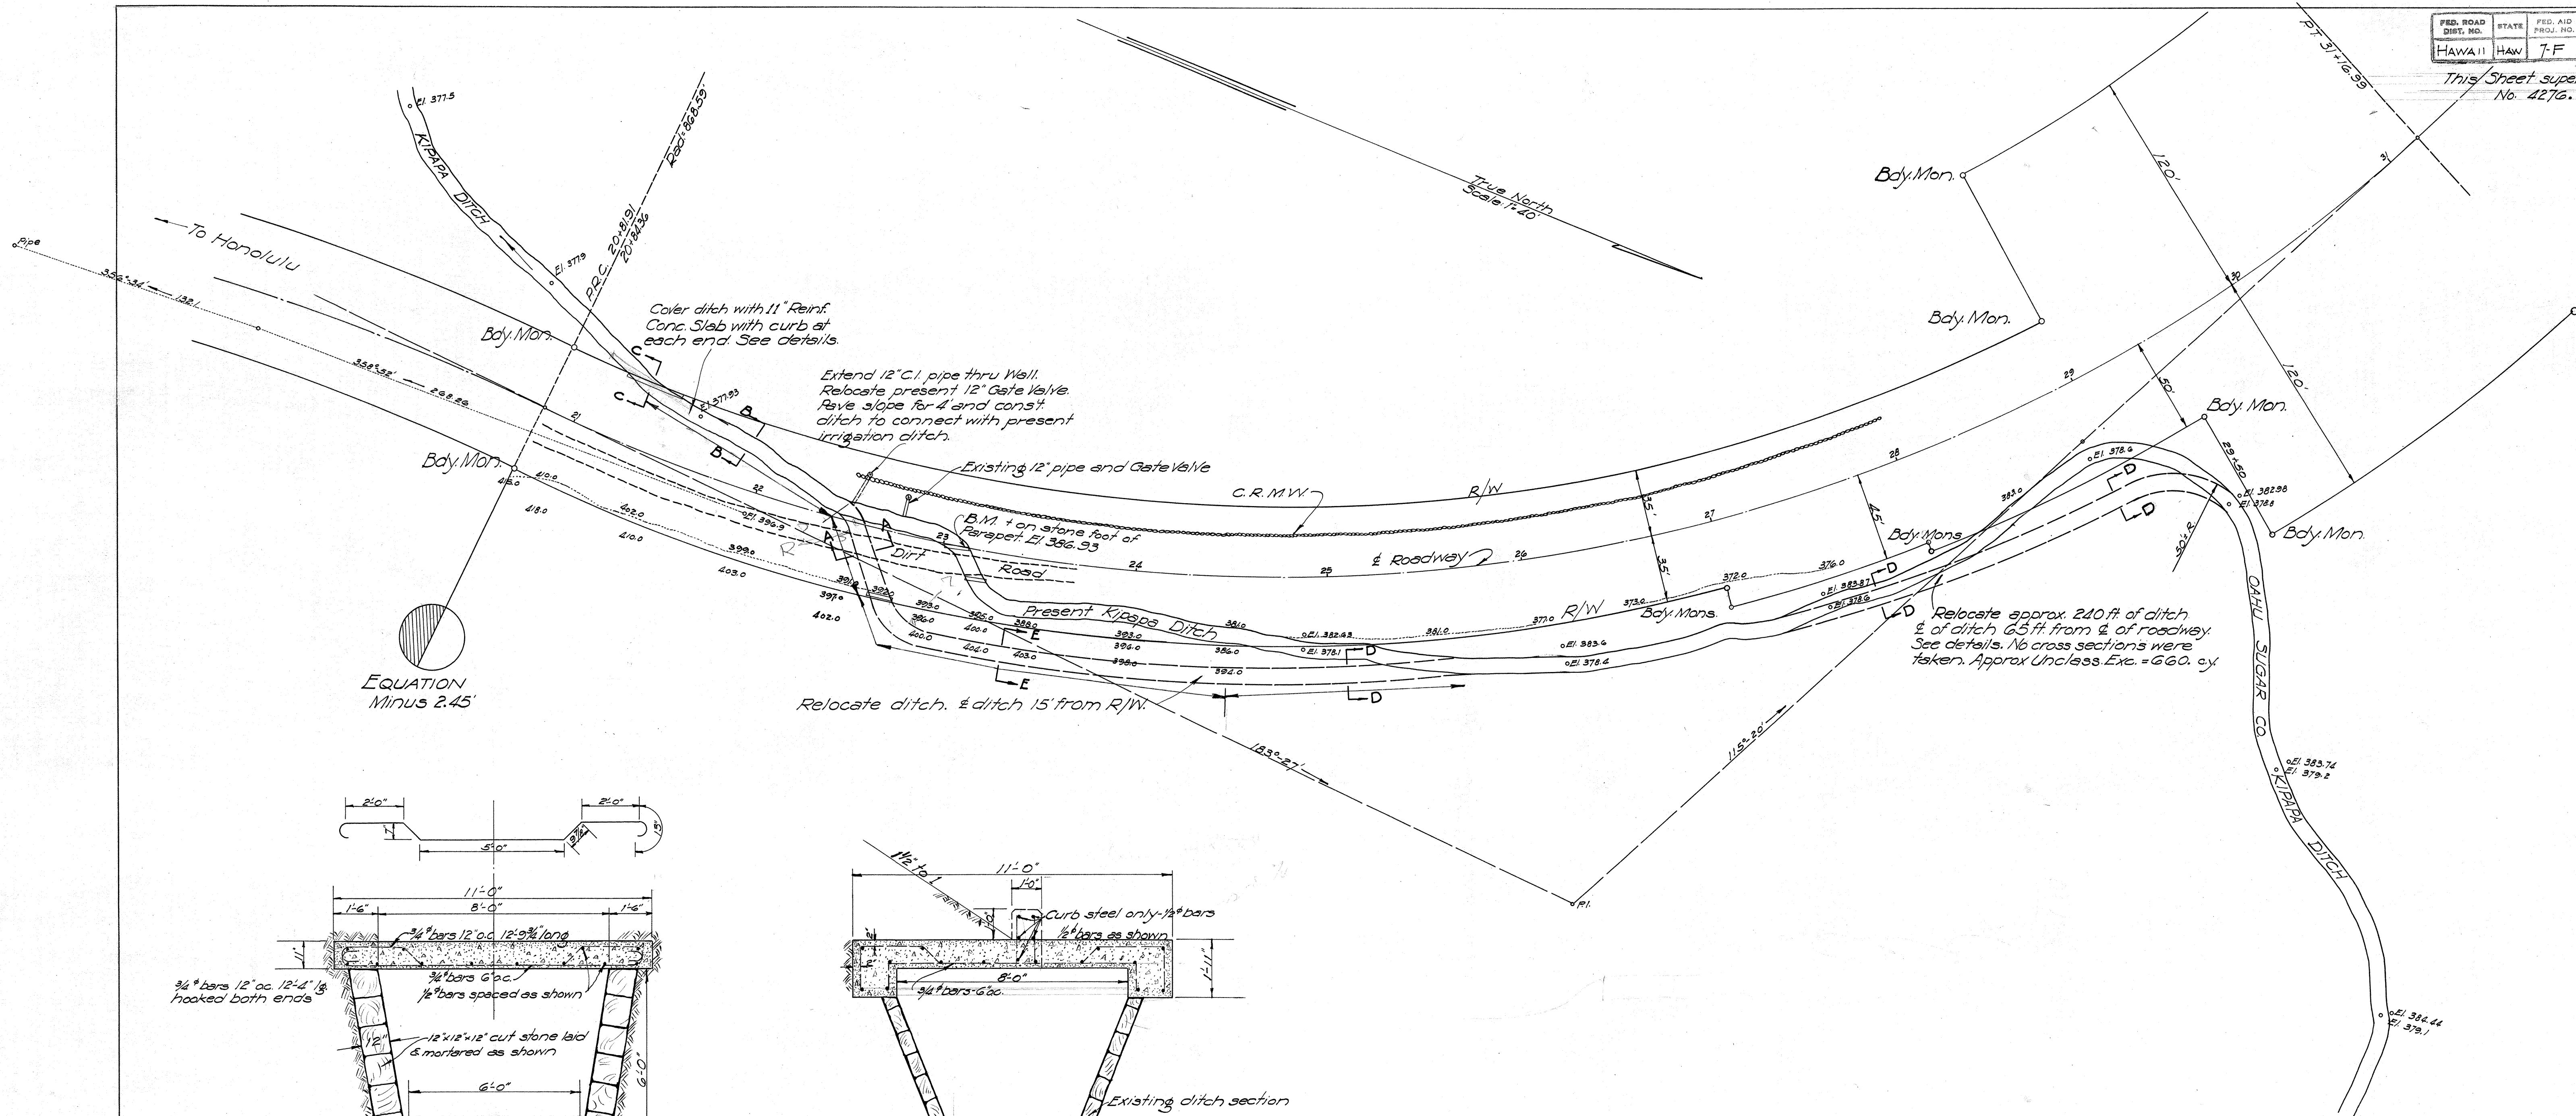

EQUATION
Minus 2.45'

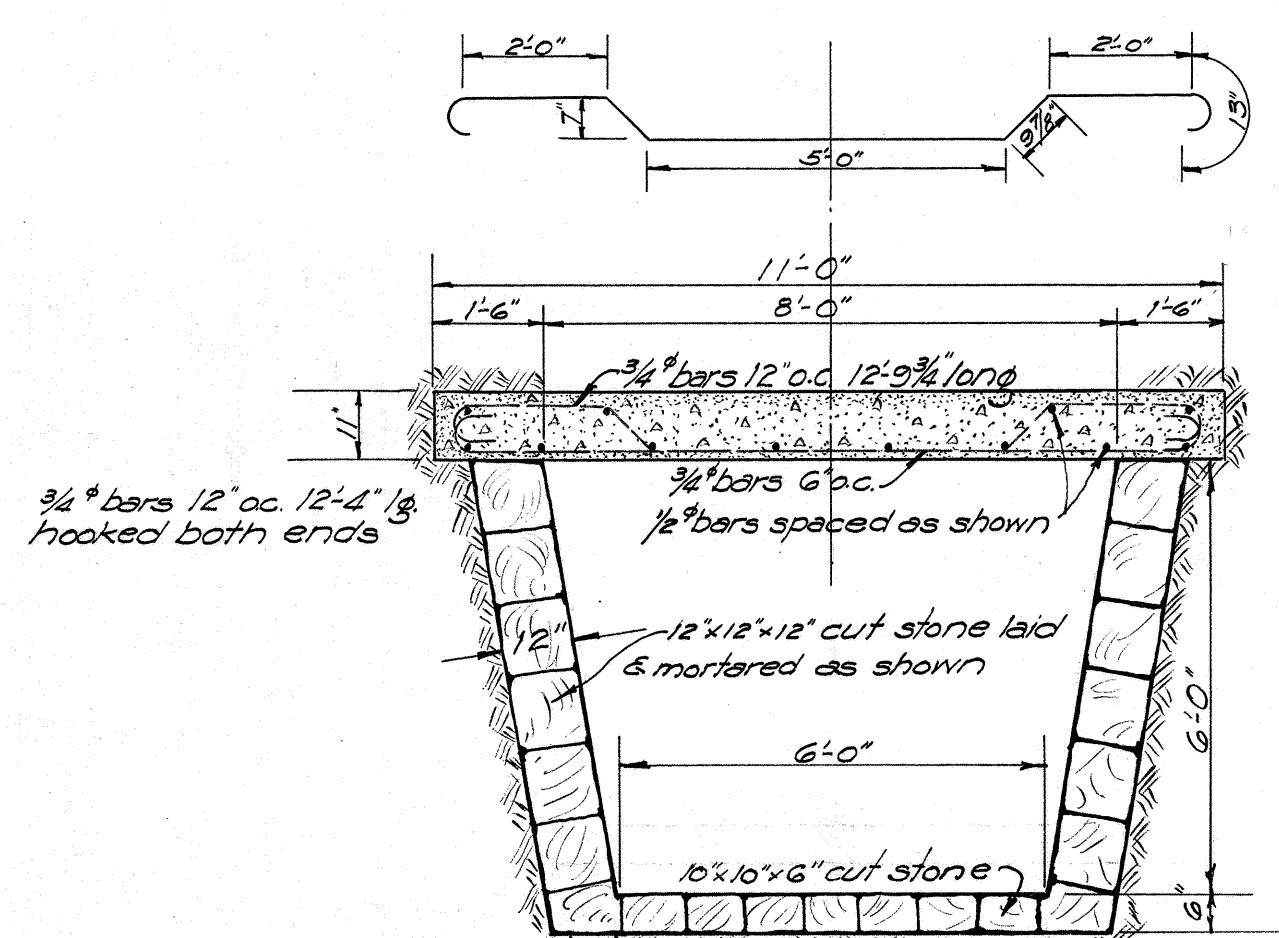


SECTION A-A

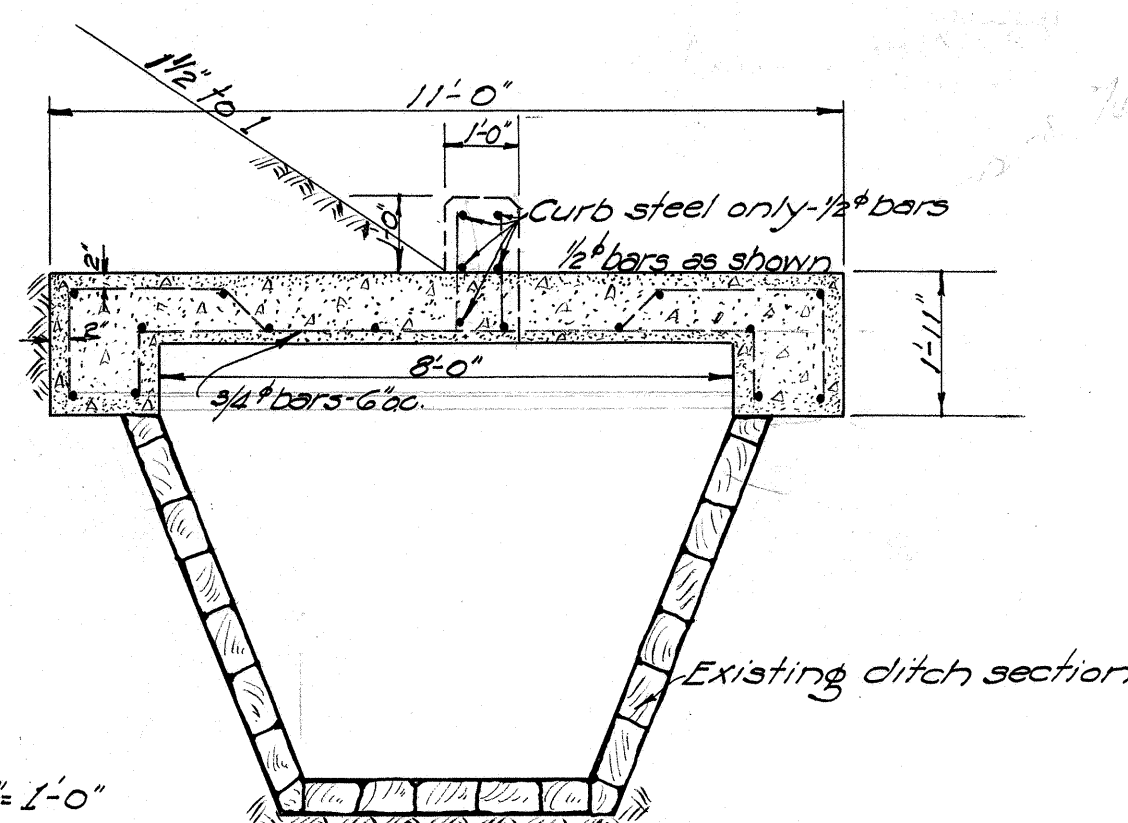


SECTION B-B (SLAB)
SECTION C-C (PART SLAB & CURB)

Scales: 3/8\"/>

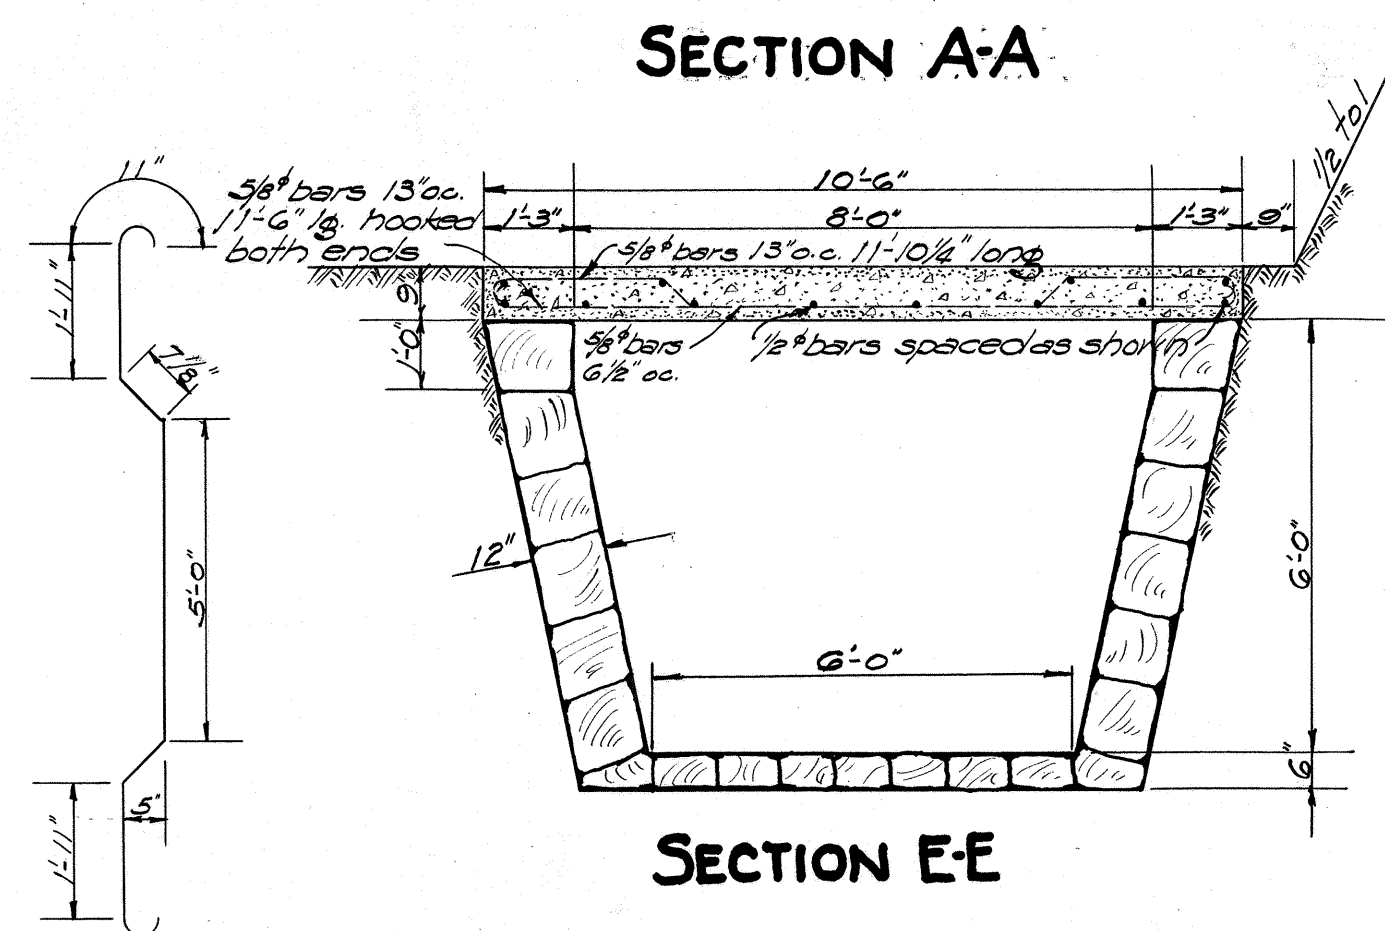

SECTION E-E

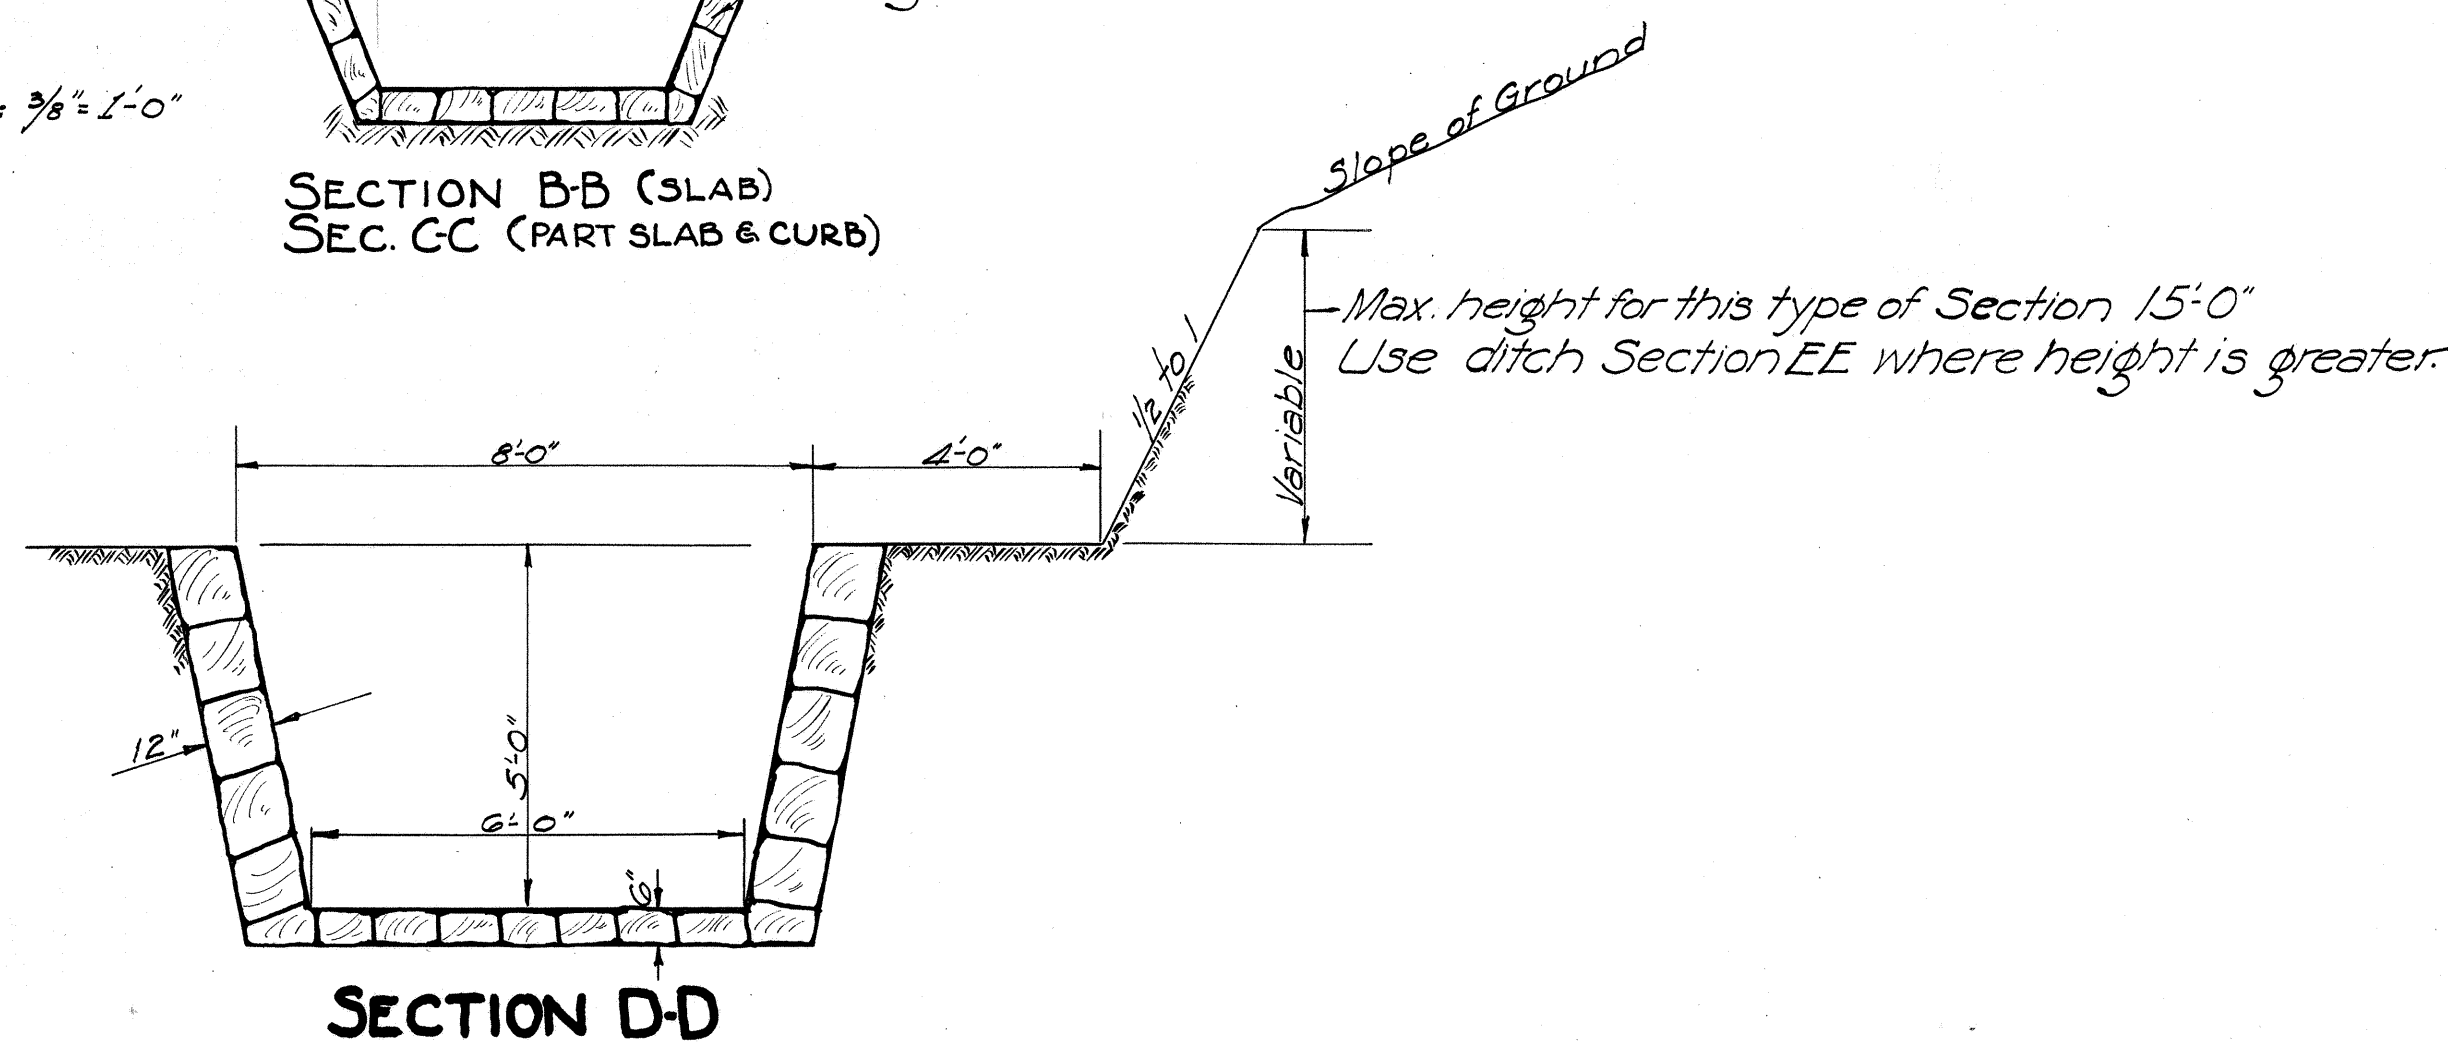

SECTION D-D

TERRITORIAL HIGHWAY DEPARTMENT
TERRITORY OF HAWAII
**RELOCATION OAHU SUGAR CO.'S
IRRIGATION DITCH**
Kamehameha Hy. Kipapa Gulch
F.A.P. 7F Jan. 1933

4276.9A