


FED. ROAD DIST. NO.	STATE	FED. AID PROJ. NO.	FISCAL YEAR	SHEET NO.	TOTAL SHEETS
HAWAII	HAW	NRH-7F	1933	1	2

INDEX TO DRAWINGS	
SHEET NO	DESCRIPTIONS
1	Title Sheet
2	Typical Road Section
3-4	Standard Details


TERRITORY OF HAWAII
TERRITORIAL HIGHWAY DEPARTMENT
HONOLULU T. H.

PLANS OF
KAMEHAMEHA HIGHWAY
NATIONAL RECOVERY HIGHWAY PROJECT NO. NR.H. 7-F.
HAWAII F.A.P NO 7-F REOPENED
EWA DISTRICT
OAHU, T. H.

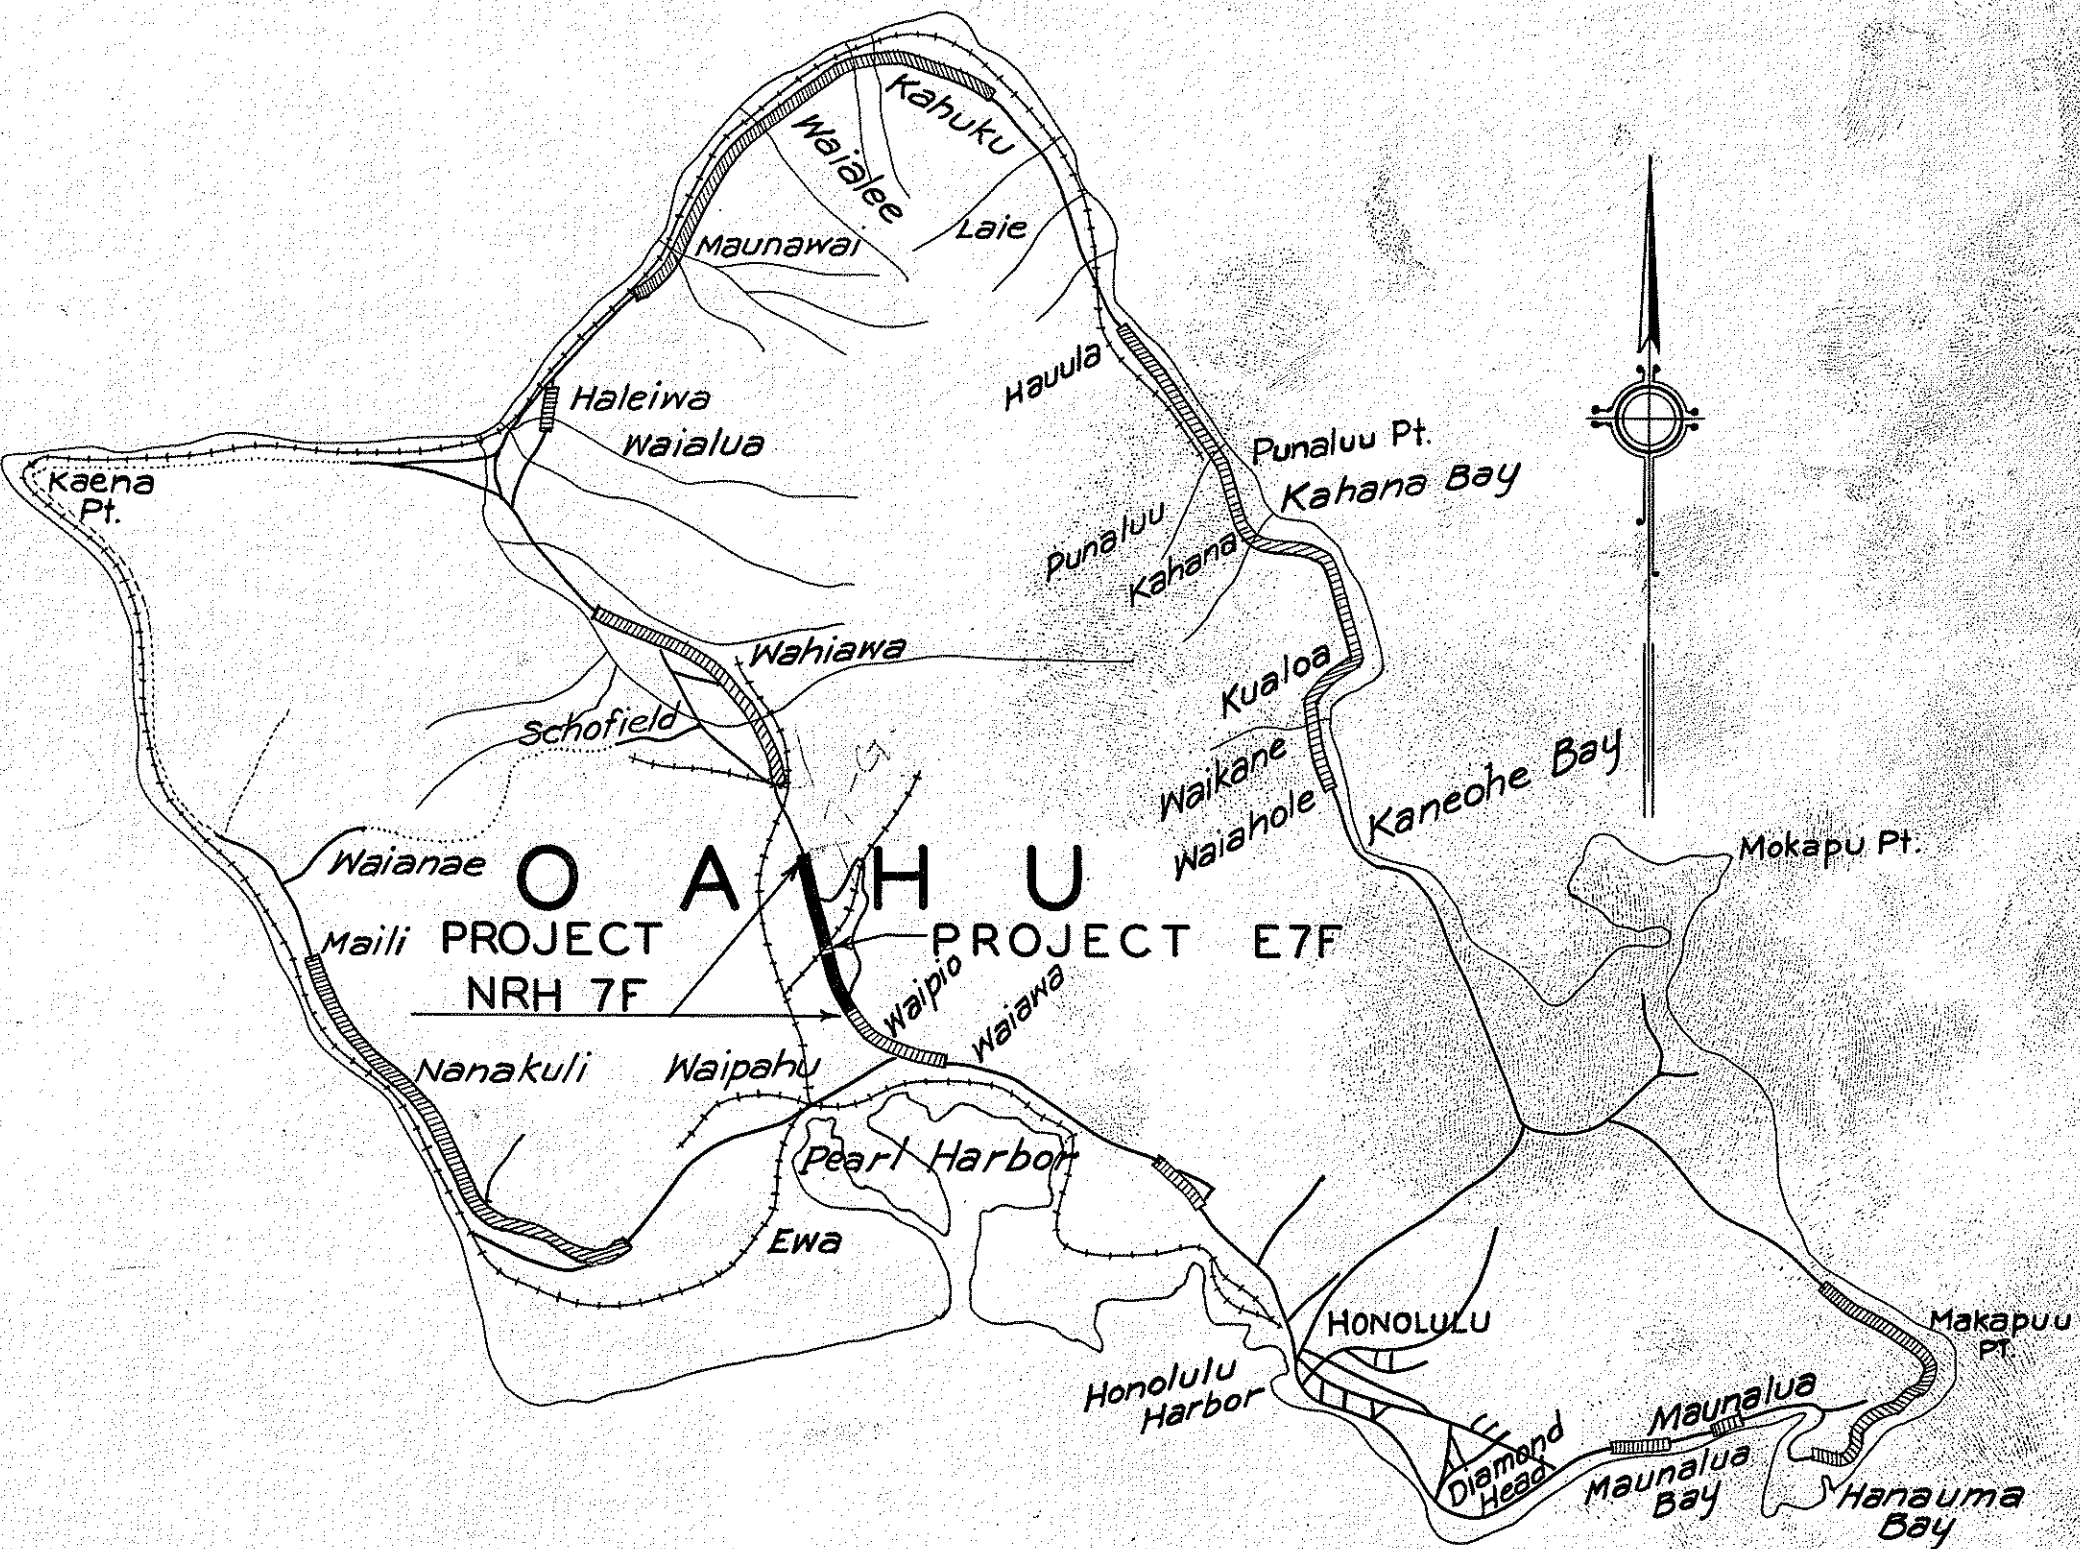

LEGEND

PREVIOUSLY CONSTRUCTED FEDERAL AID PROJECTS

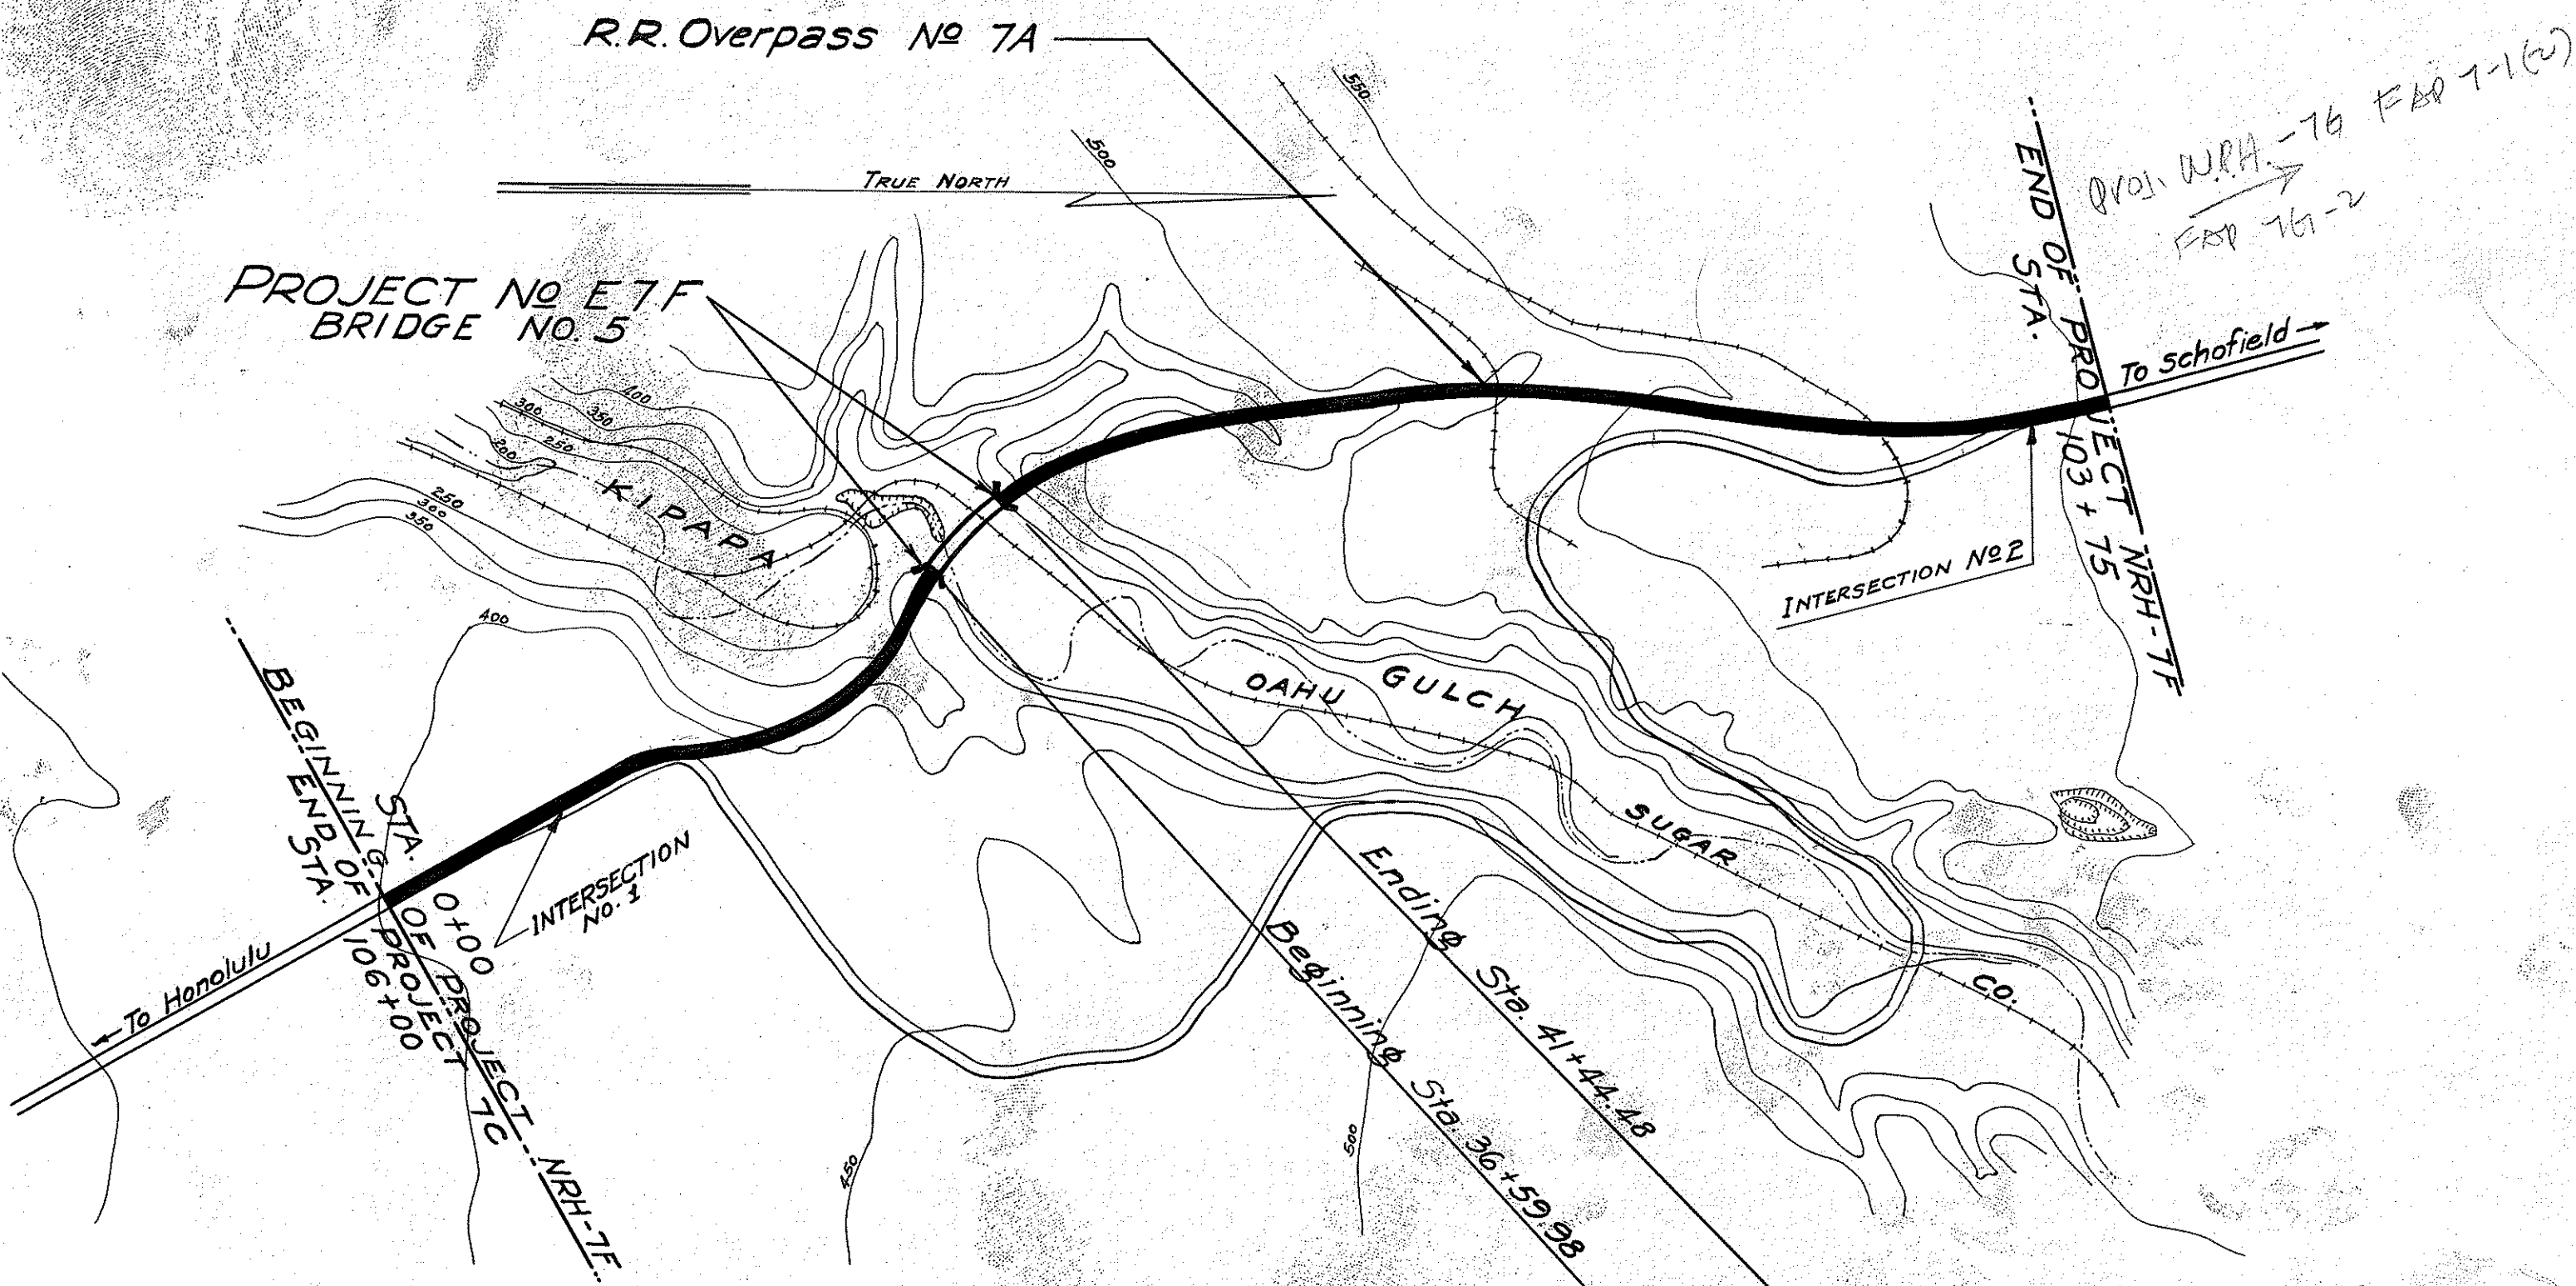

LENGTH OF PROJECT NRH 7-F	
GROSS	1.964
LESS PROJECT E7F	0.092
NET LENGTH (ROADWAY ONLY)	1.872

LAYOUT OF PROJECT
SCALE = 1/10,000

RECOMMENDED FOR APPROVAL

E. Wheeler 11-13-33
PRINCIPAL HIGHWAY ENGINEER
Bureau of Public Roads

RECOMMENDED FOR APPROVAL

CHIEF ENGINEER, Bureau of Public Roads

APPROVED

CHIEF, Bureau of Public Roads

APPROVED

L. H. Beggs
7 Jan 1, 1933
TERRITORIAL HIGHWAY ENGINEER

4303.1

0-1-9

DD-N

ORIGINAL	DATE
PLAN	4/15/33
NOTE BOOK	4/15/33
DESIGNED BY	A.K.
CHECKED BY	A.K.