


1934
H.F.C.
S.O.



1934
H.F.C.

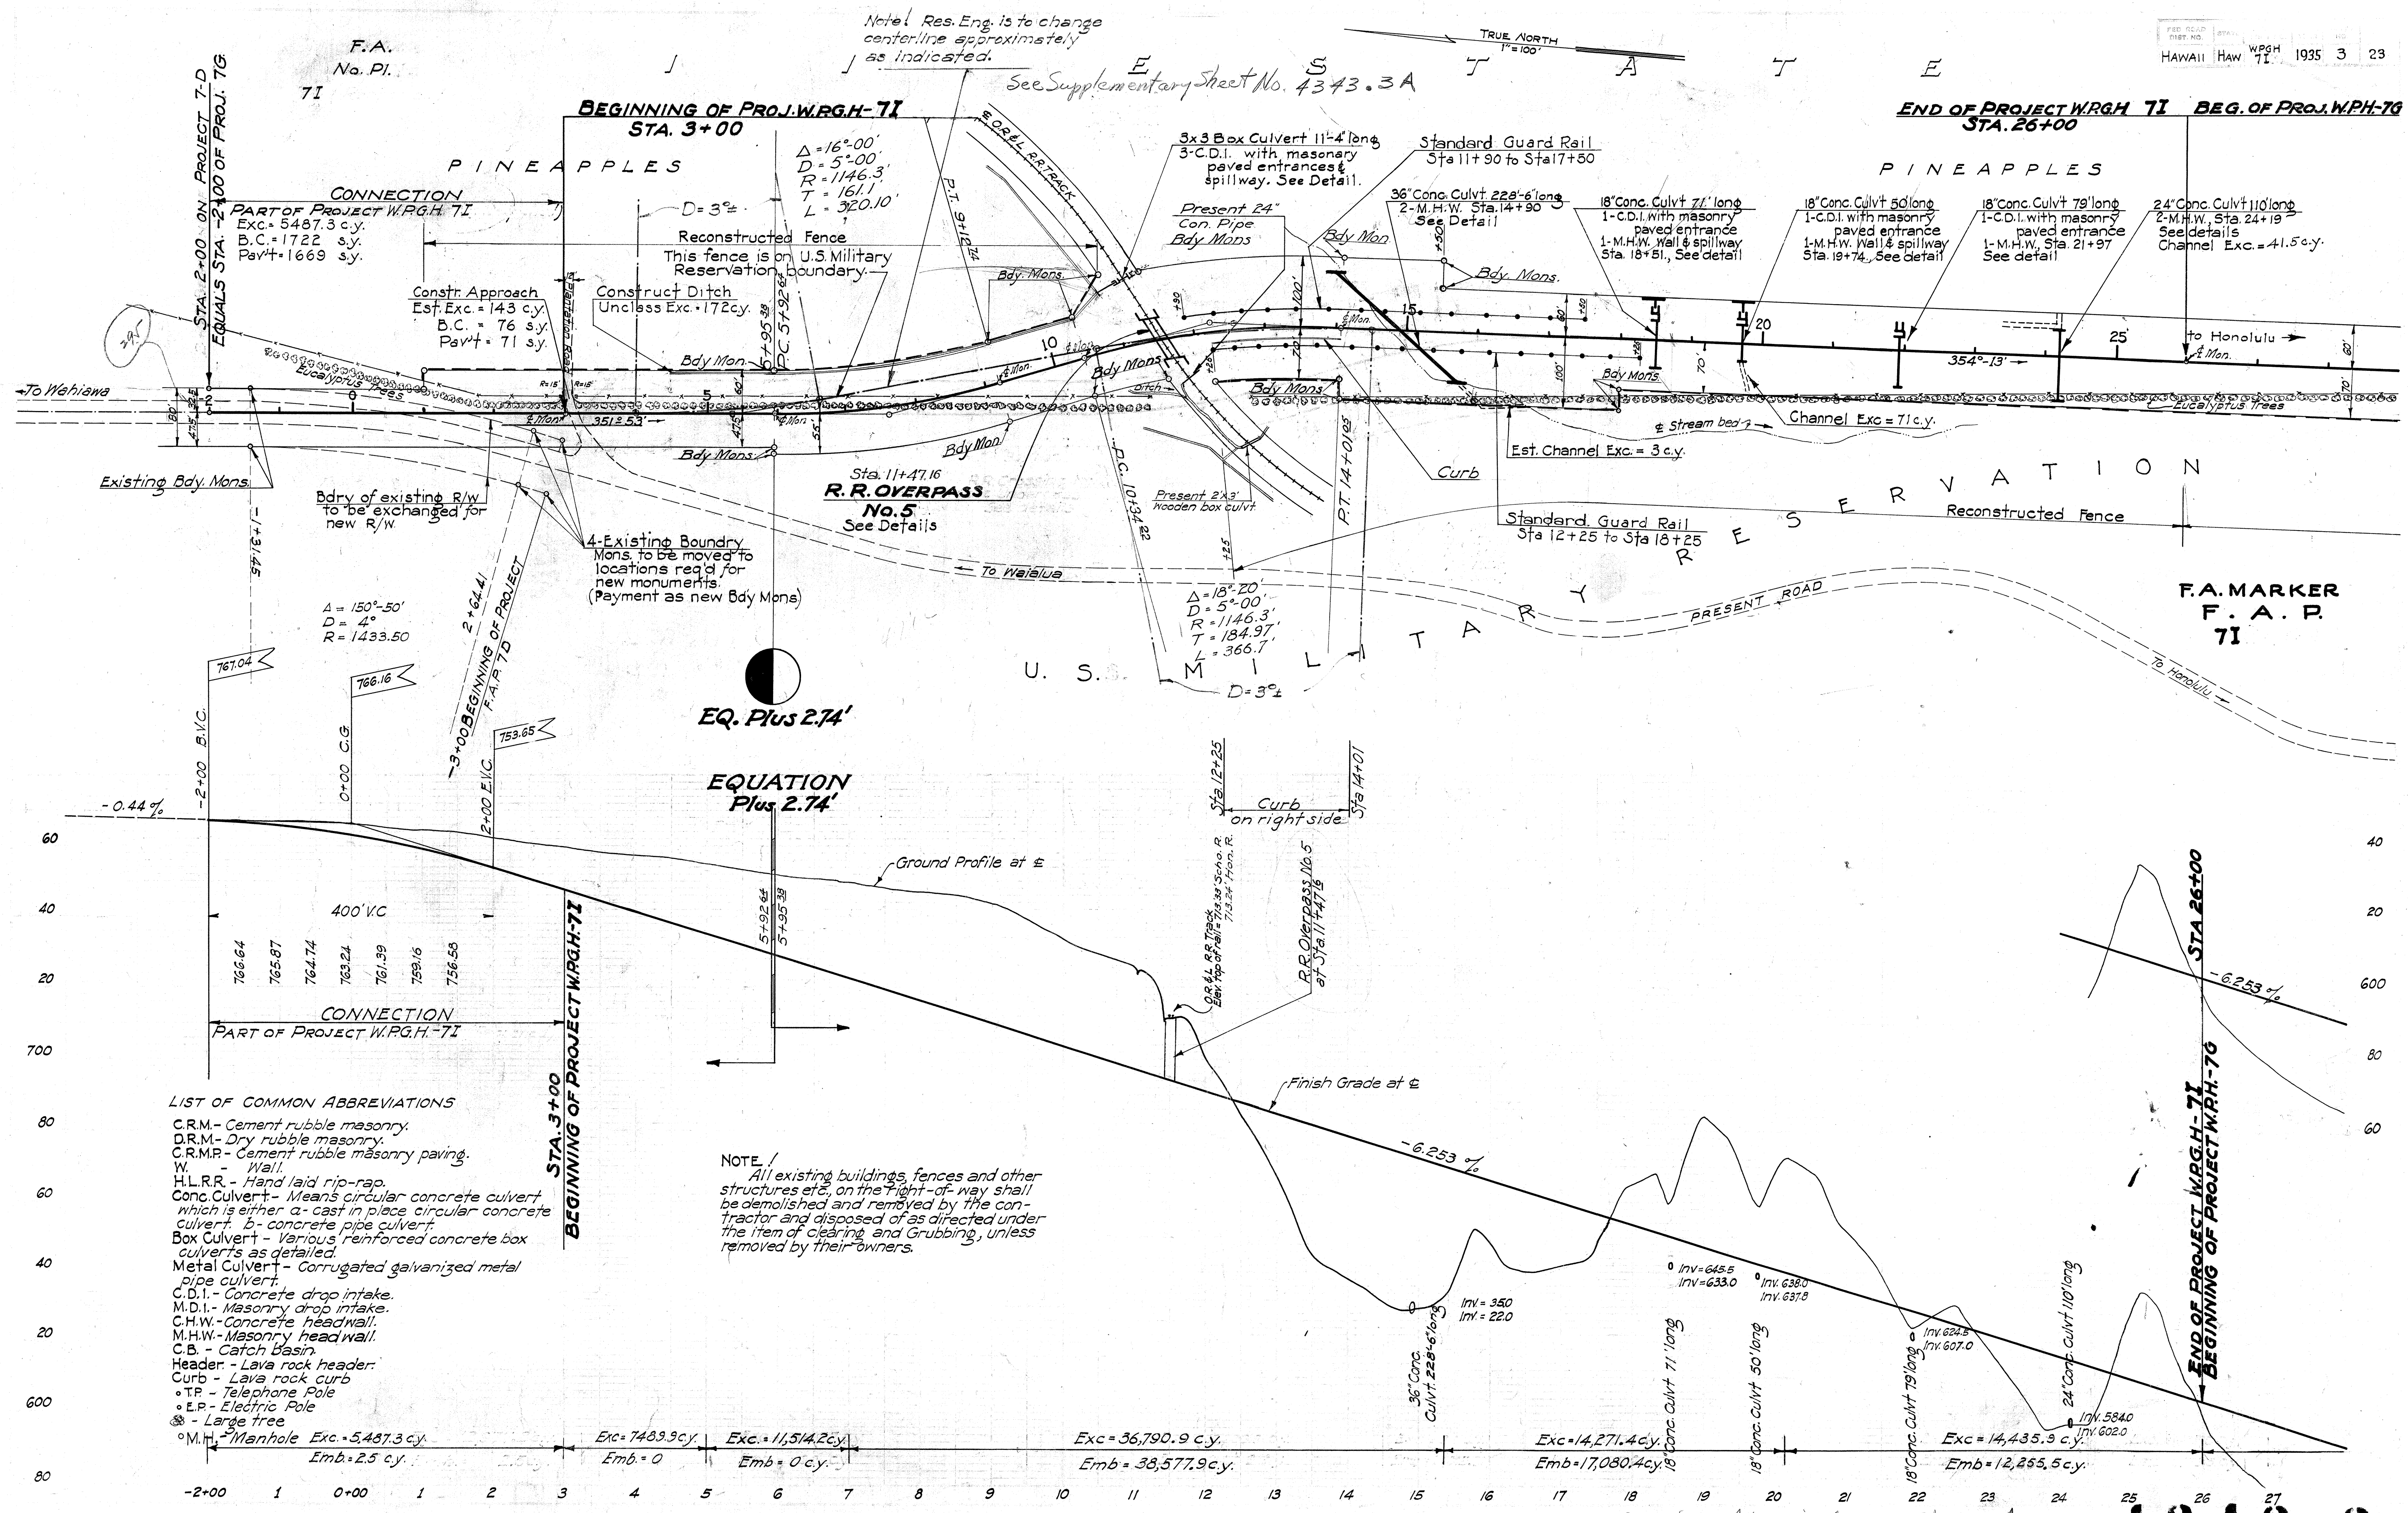

For Revised Alignment, See Sheet 3A

4343.3

FED. ROAD DIST. NO.	STATE	FED. AID PROJ. NO.	FISCAL YEAR	SHEET NO.	TOTAL SHEETS
HAWAII	HAW	WPGH 7-1	1935	3-A	23

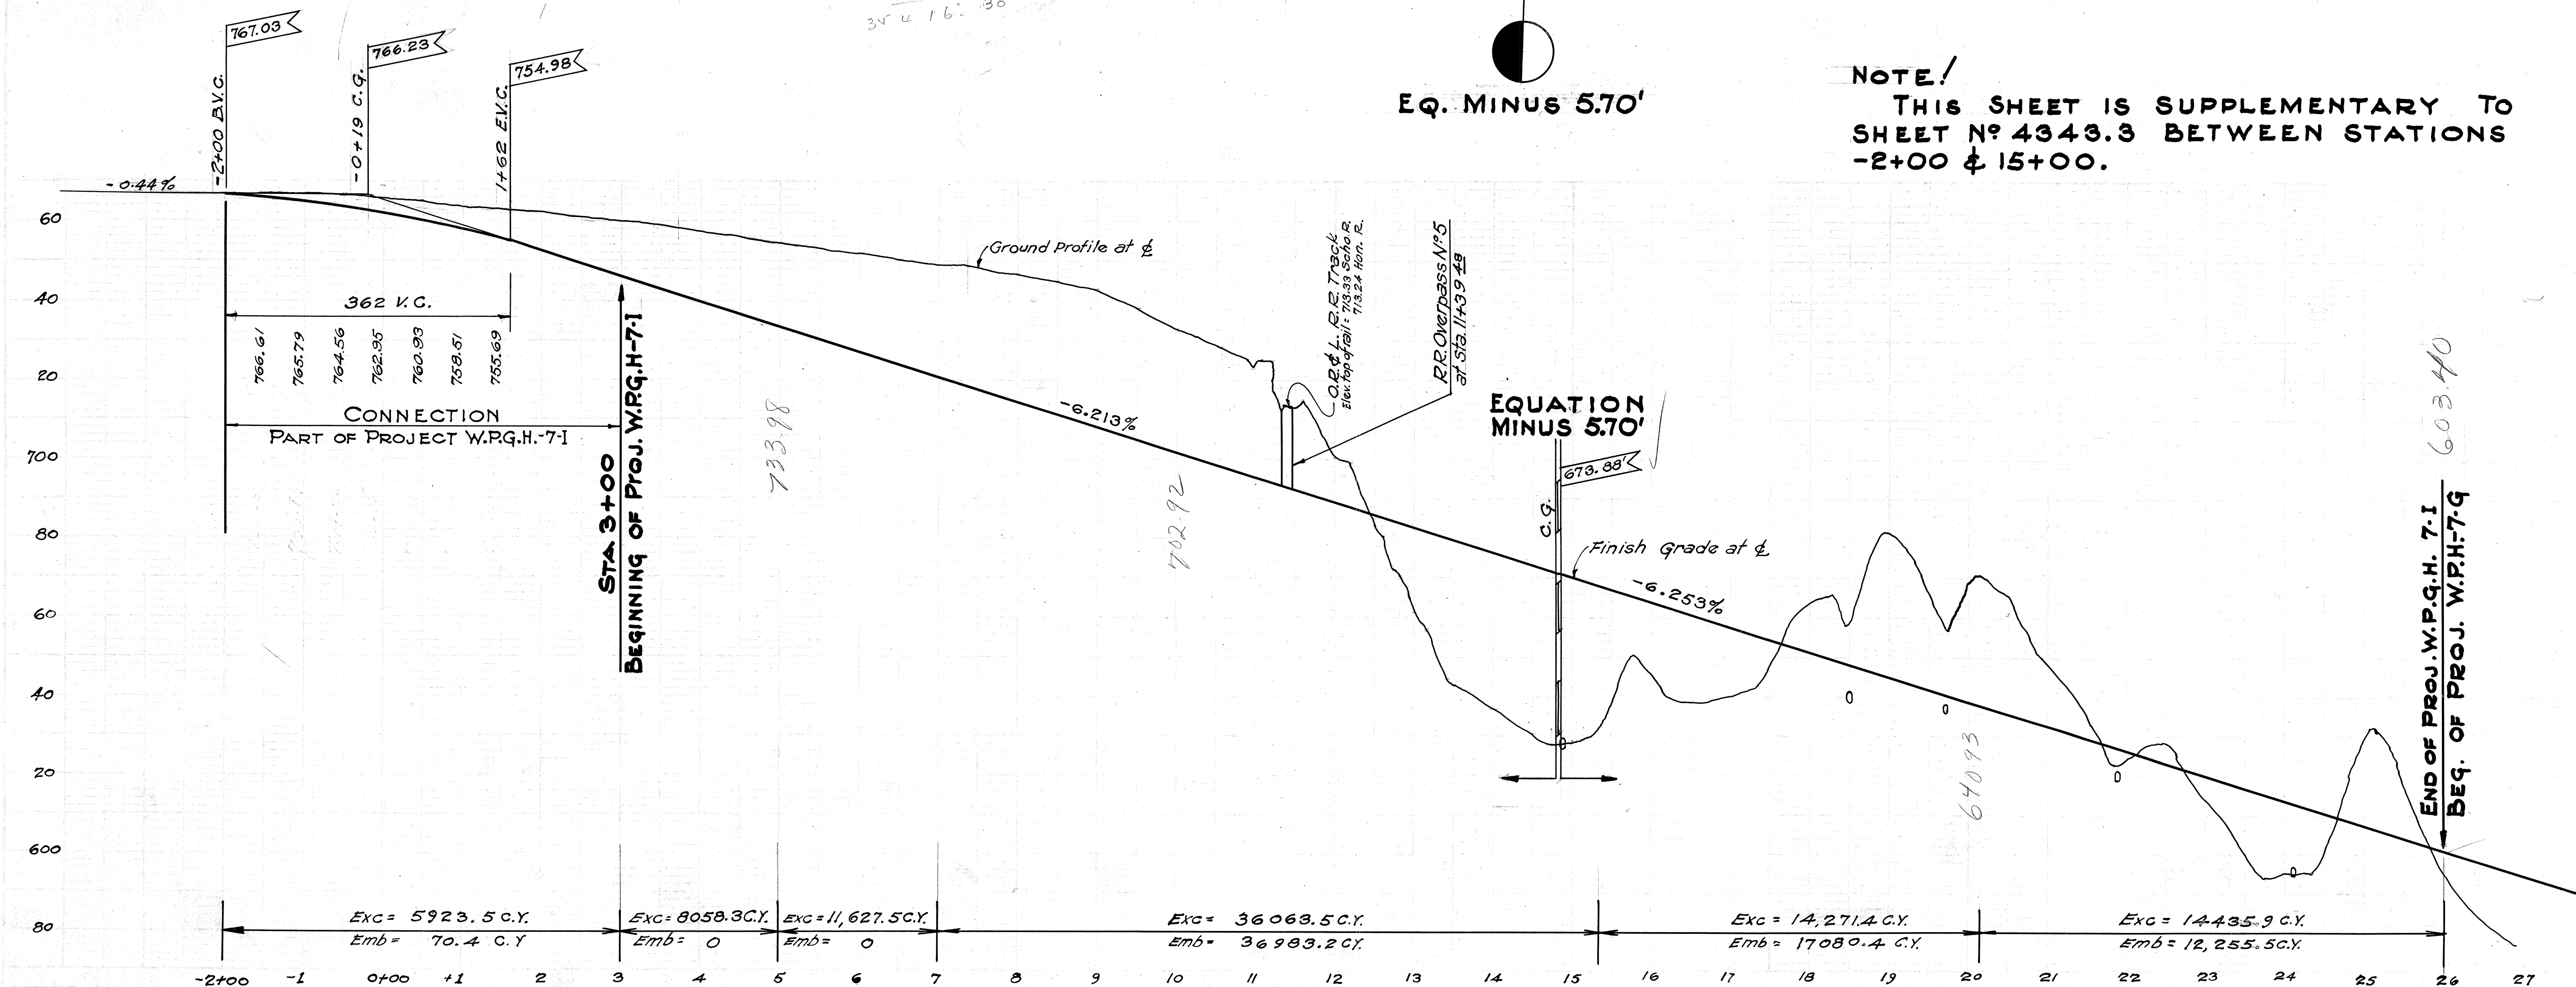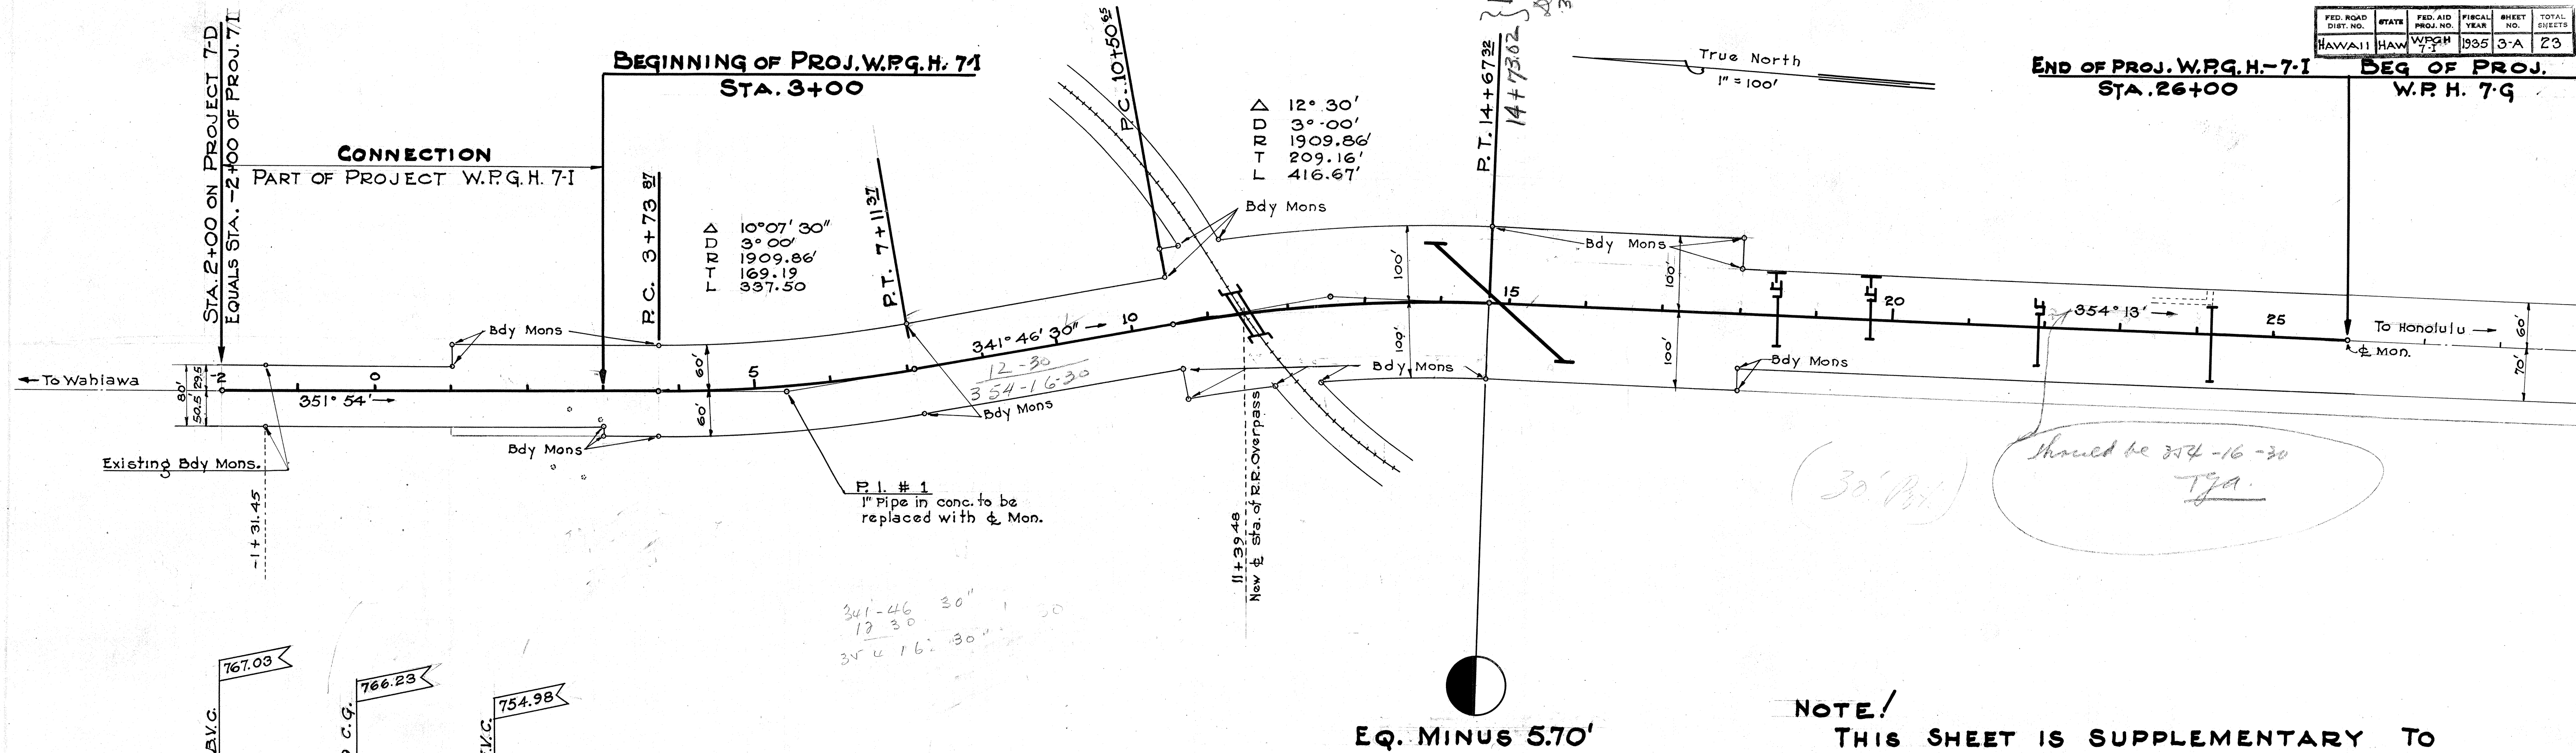

4343.3A