




Class "A" Conc.

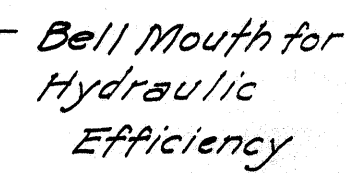


Scale 1" = 1'-0"

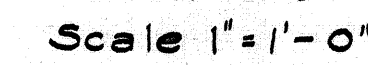



| ESTIMATED QUANTITIES   |           |
|------------------------|-----------|
| Class 'A' Concrete     | 2.0c.y.   |
| Structure Exc.         | 7.0c.y.   |
| Unclass. Exc.          | 250.0c.y. |
| Stl. Reinf. Conc. Pipe | 1680.0ft. |
| Manhole                | 1         |
| Grating with Hinges    | 1         |

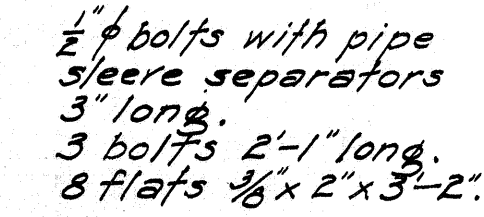


Scale  $1\frac{1}{2}" = 1'-0"$

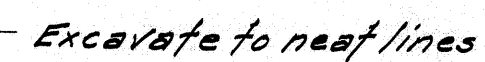

Scale  $\frac{3}{4}'' = 1'-0''$

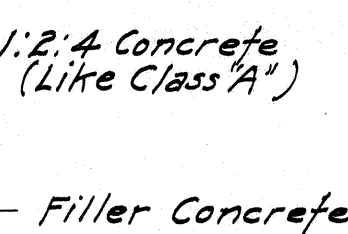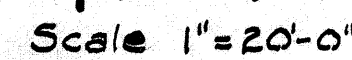

Scale  $\frac{3}{4}" = 1' - 0"$

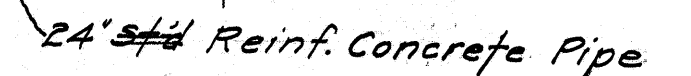

Scale  $\frac{3}{4}" = 1'-0"$

Manhole to be paid for complete in place including all excavation, concrete, bricks, ladders, frame and cover, backfill, etc.  
 Std reinforced concrete pipe with collars paid for complete in place per linear foot, including all excavation, pipe, collars, backfills, etc.

## DETAILS, DROP INTAKE MANHOLE & 24" PIPE

**4342.14**