

INDEX TO DRAWINGS	
SHEET NO.	DESCRIPTION
1	Title Sheet
2	Typical Road Section
3-6	Plan & Profile
7-8	Std Detail Sheets - No 1 & 2
9-10	Details of Culverts & Syphons, Indust. Track Cross.
11-23	Bridge Details
24-42	Cross Sections
6-A	Available Borrow Pit.


FED. ROAD DIST. NO.	STATE	FED. AID PROJ. NO.	FISCAL YEAR	SHEET NO.	TOTAL SHEETS
HAWAII	HAW	9F	1935	1	42

TERRITORY OF HAWAII
TERRITORIAL HIGHWAY DEPARTMENT
HONOLULU T. H.

PLANS OF **KAMEHAMEHA HIGHWAY**

FEDERAL AID PROJECT NO. 9F (REOPENED)

DISTRICT OF EWA
ISLAND OF OAHU

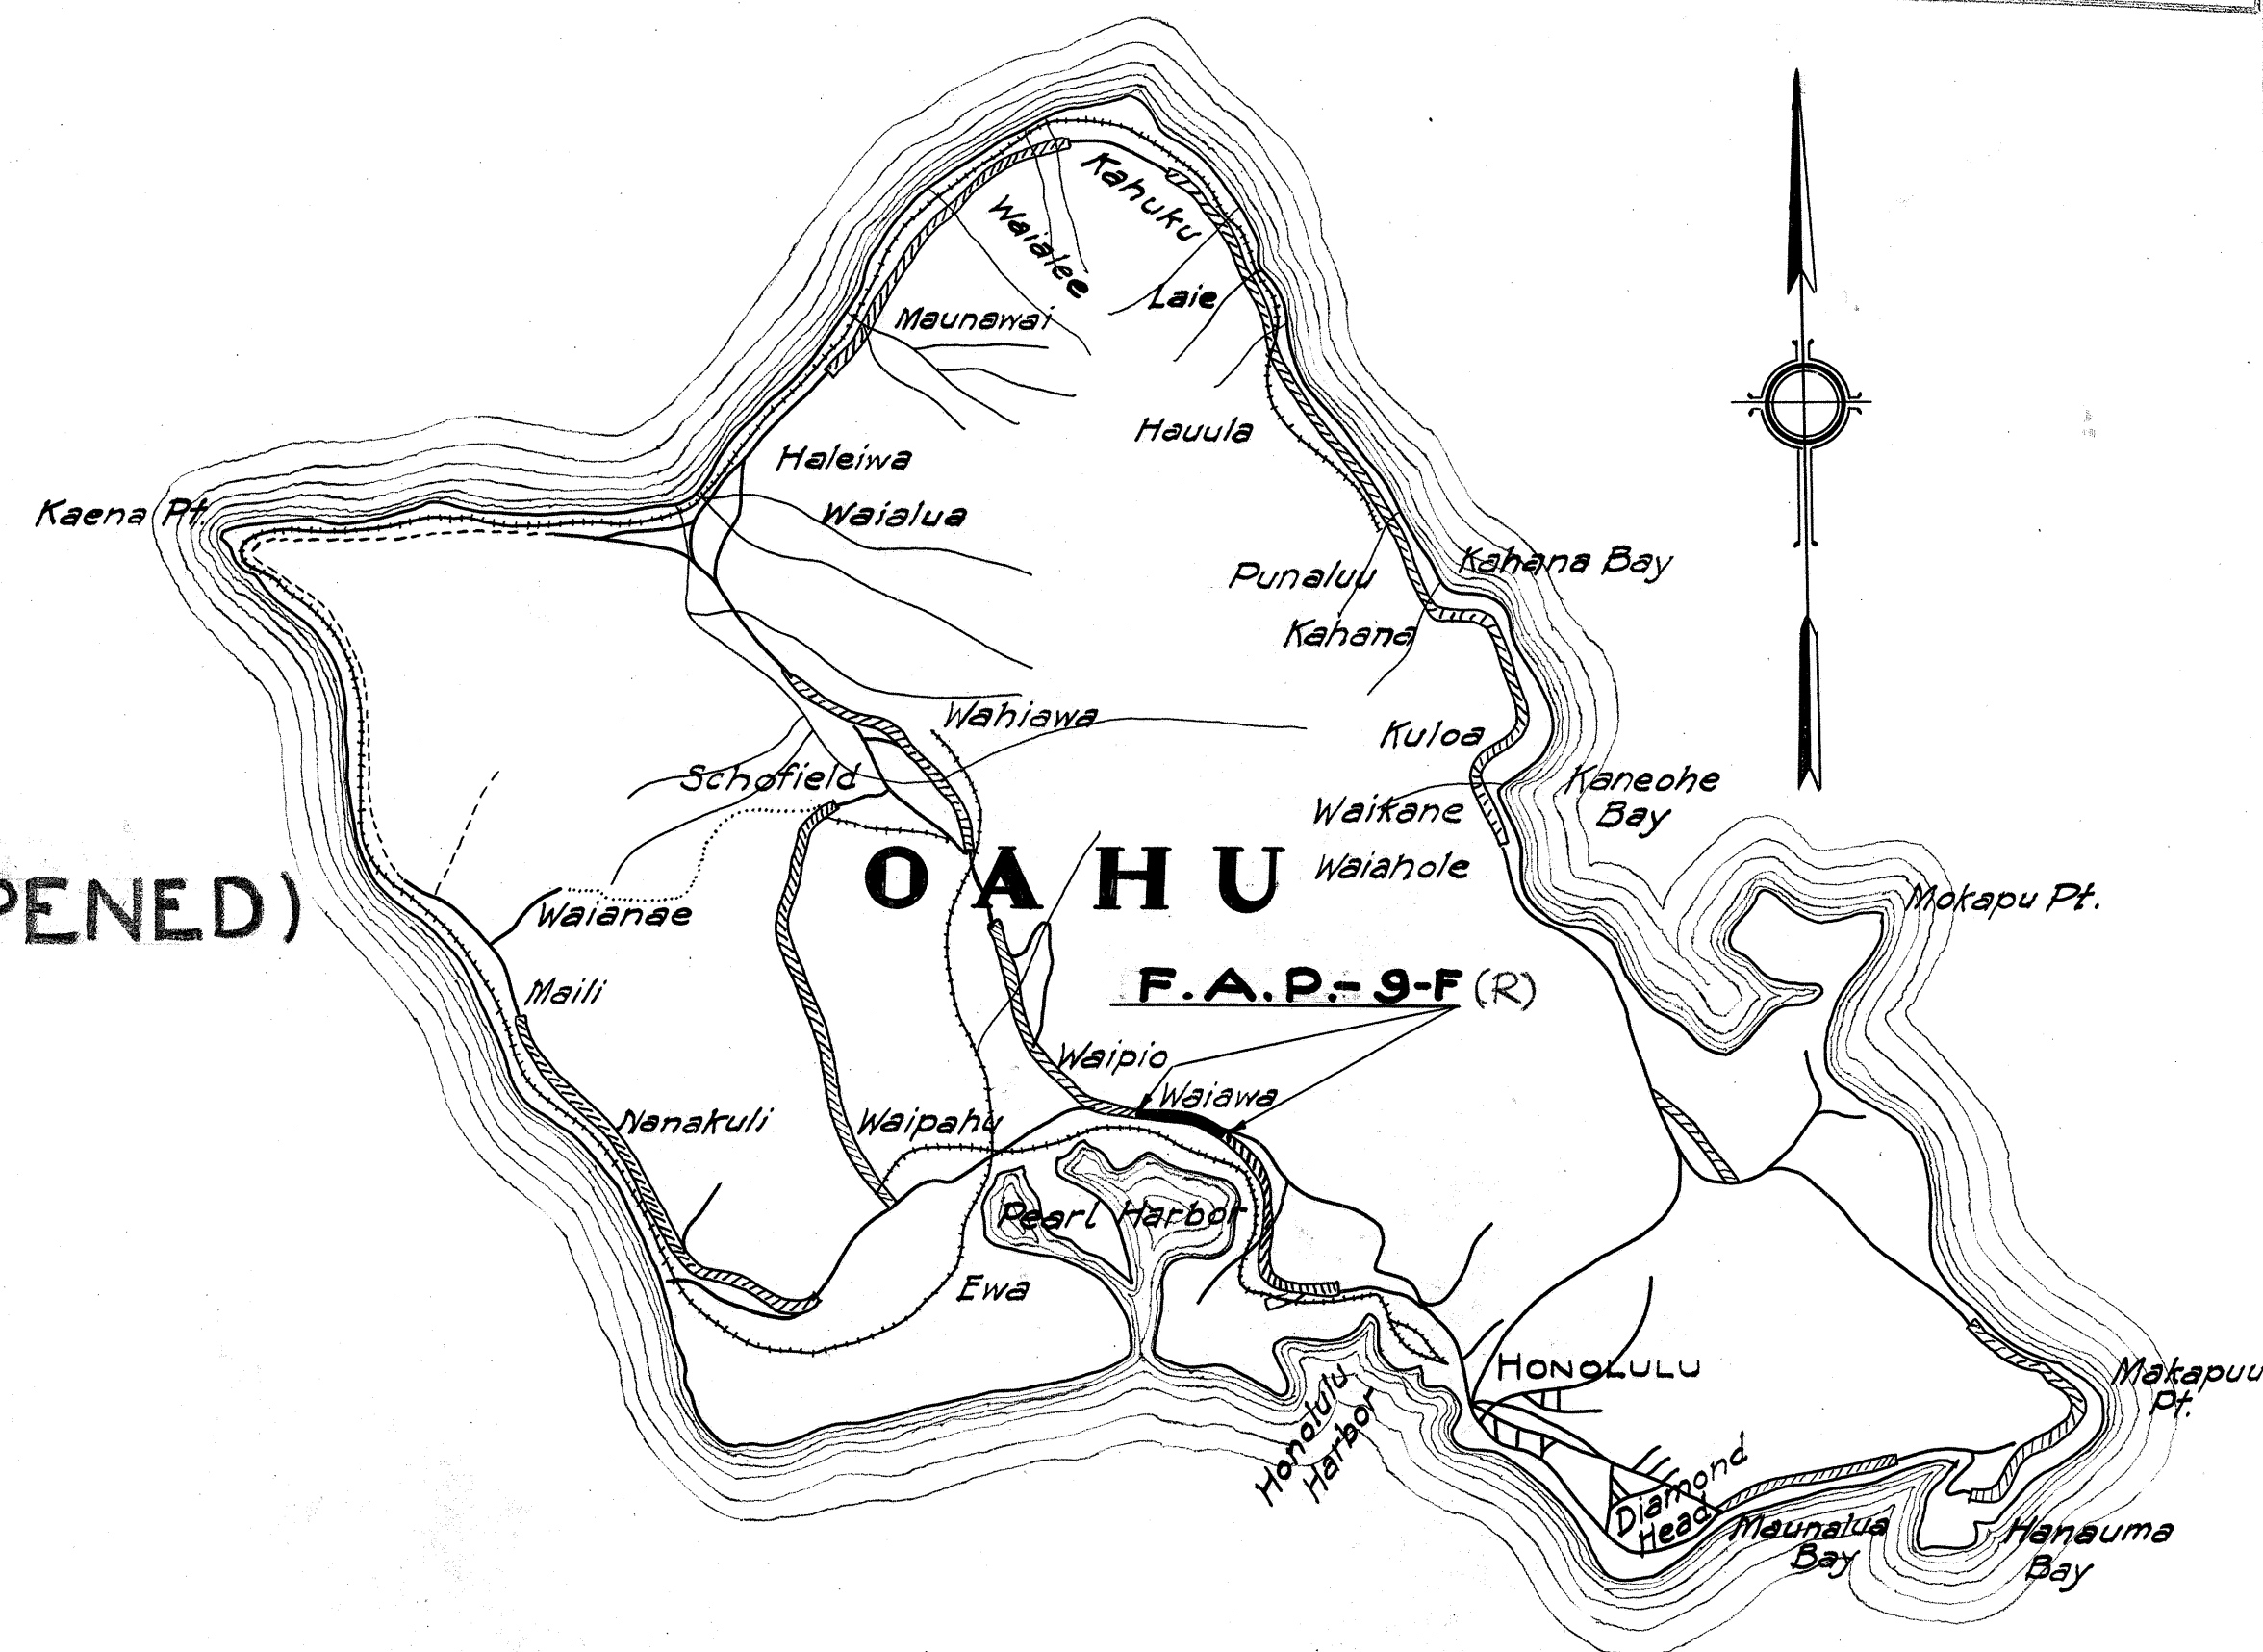

Federal Aid Projects previously constructed or under construction.


CONVENTIONAL SIGNS	
PRESENT ROAD	---
EXISTING FENCE	—*—*—*
BOUNDARY LINE (NOT FENCED)	---
EXISTING STONE FENCE	—•—•—•—
RAILROAD	—+—+—+—
CENTER LINE	—+—+—+—
LARGE TREE	🌳
CEMENT RUBBLE RETAINING WALLS	—[]—[]—[]—
BRIDGES	—()—()—()—
CULVERTS	—I—I—I—I—

SCALE

PLAN	1 INCH	100 FEET
PROFILE	HOR. 1 INCH	100 FEET
	VER. 1 INCH	10 FEET
CROSS SECTION	1 INCH	5 FEET

END OF FED. AID PROJ. No. 9F(R)
STA. 469+89.2

BEG. OF FED. AID PROJ. No. 9F(R)
STA. 361+50

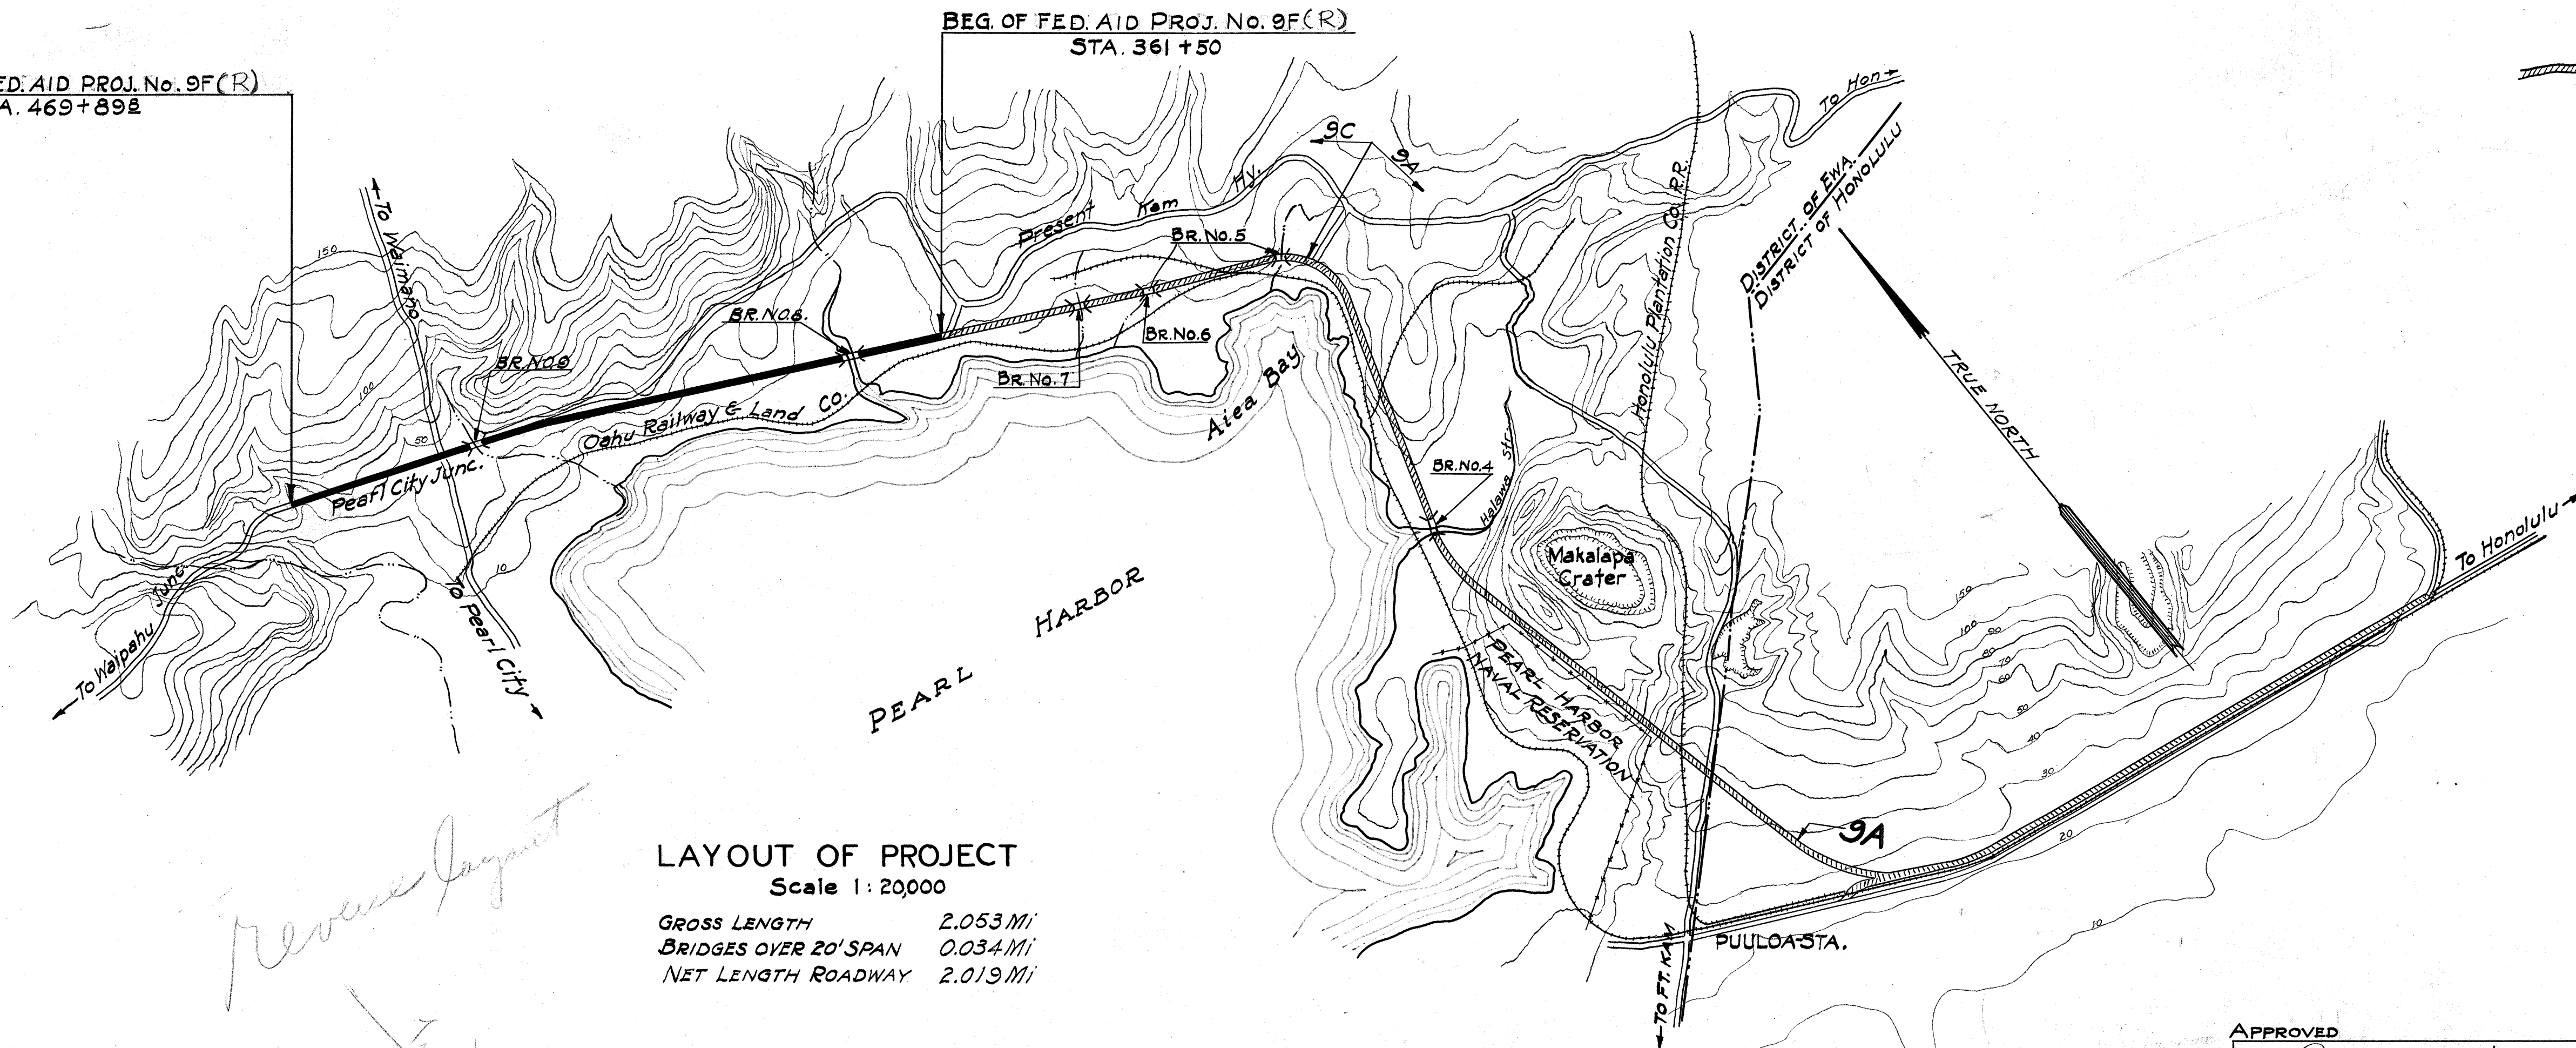

LAYOUT OF PROJECT
Scale 1:20,000

GROSS LENGTH 2.053 Mi
BRIDGES OVER 20' SPAN 0.034 Mi
NET LENGTH ROADWAY 2.019 Mi

APPROVED
Louis Blaine
DATE
TERRITORIAL HIGHWAY ENGINEER

RECOMMENDED FOR APPROVAL

PRINCIPAL HIGHWAY ENGINEER, Bu. of Pub. Rds.
RECOMMENDED FOR APPROVAL

CHIEF ENGINEER Bureau of Public Roads
APPROVED

CHIEF, Bureau of Public Roads.