
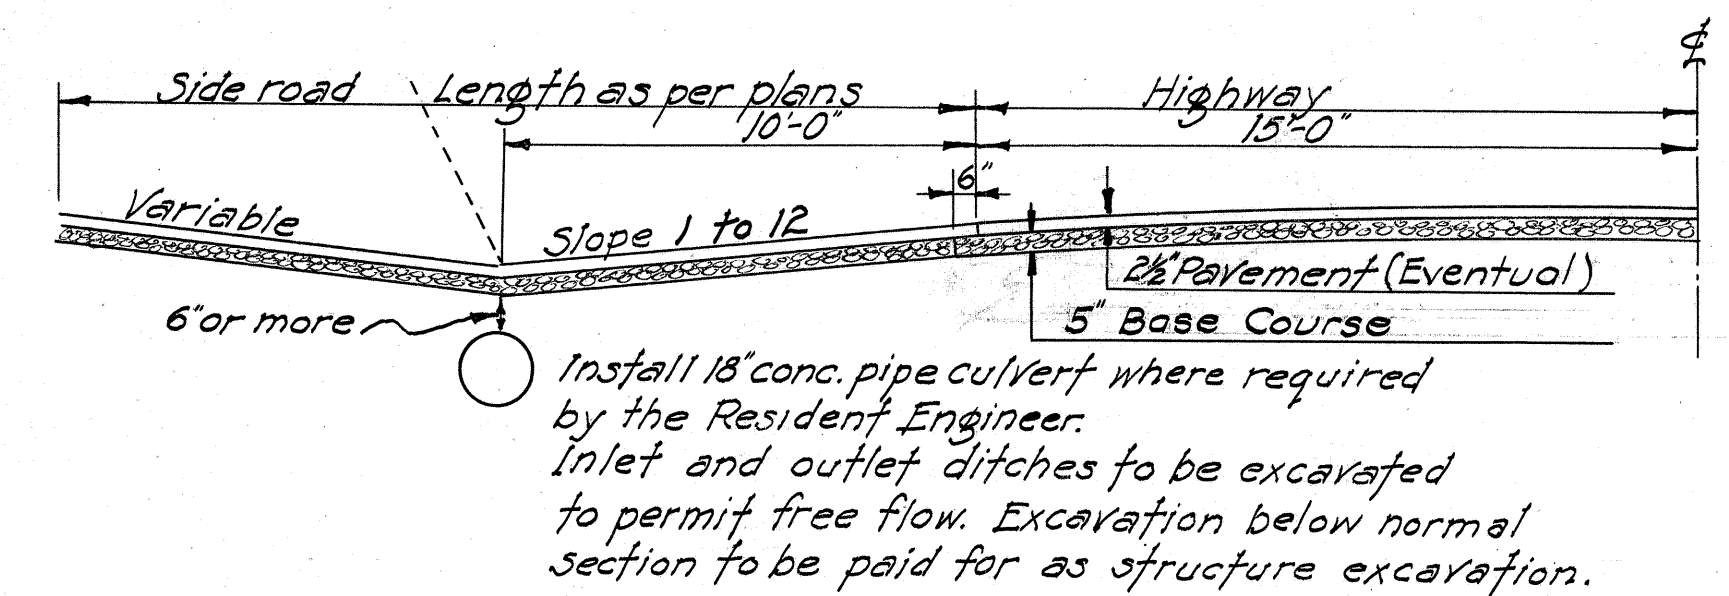
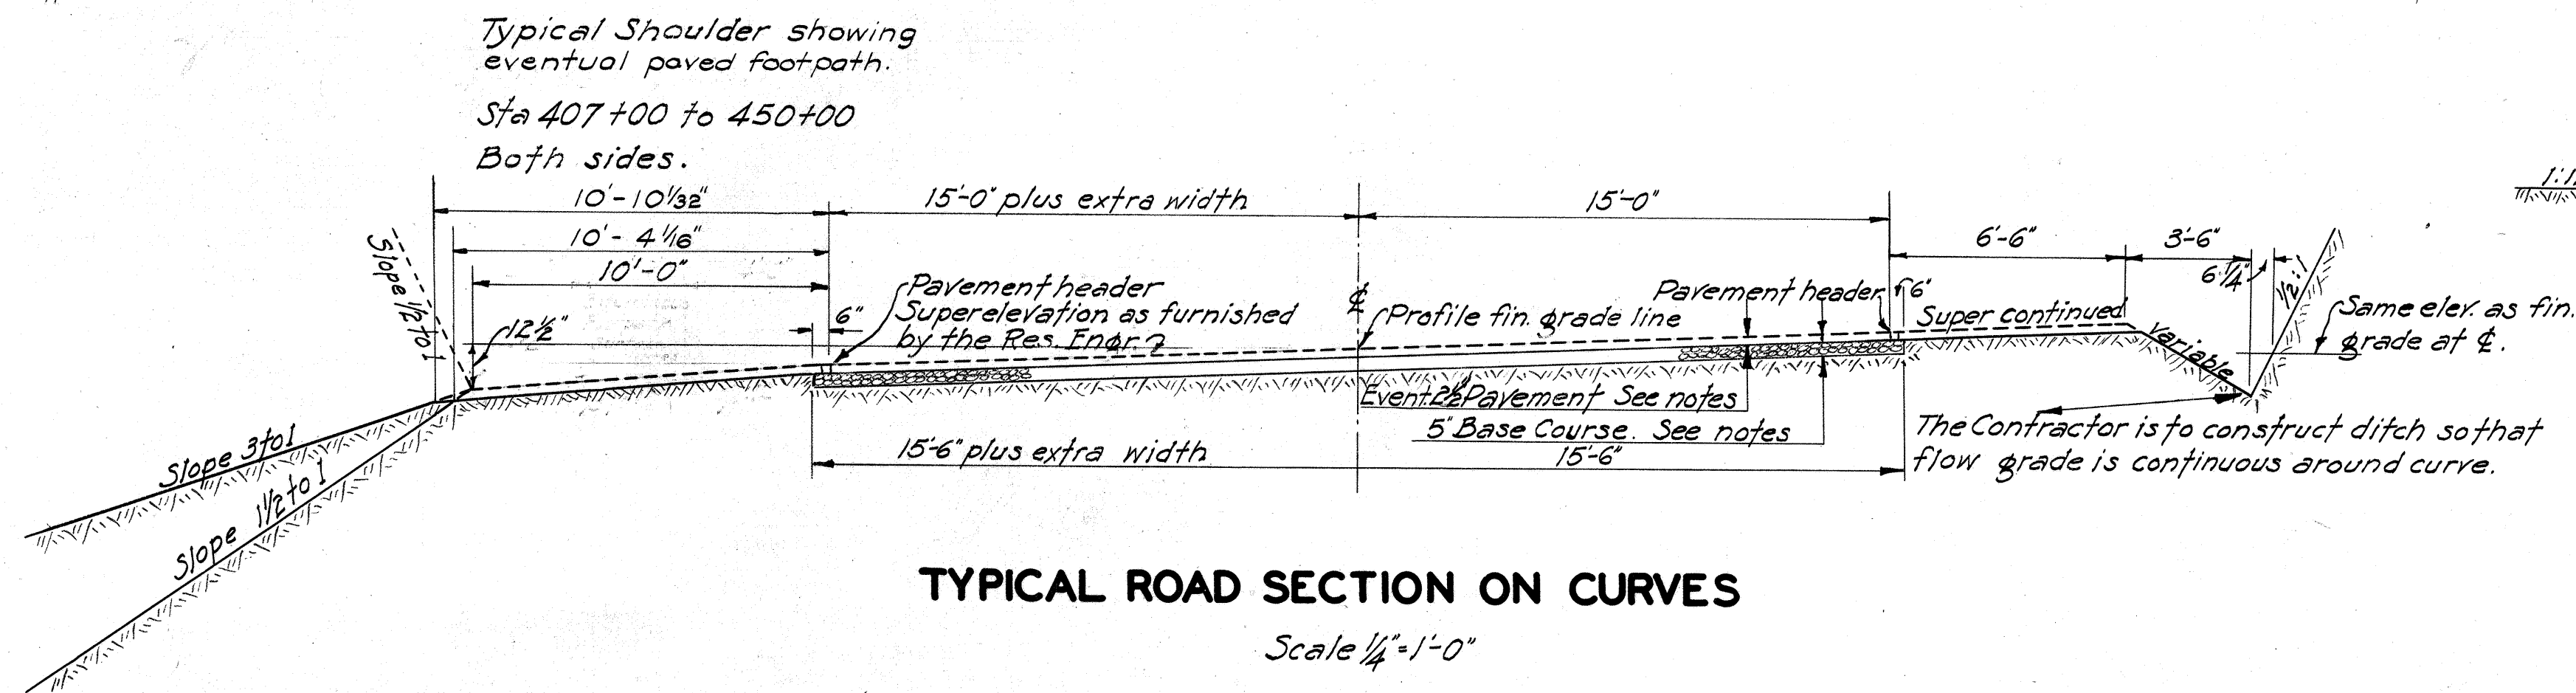
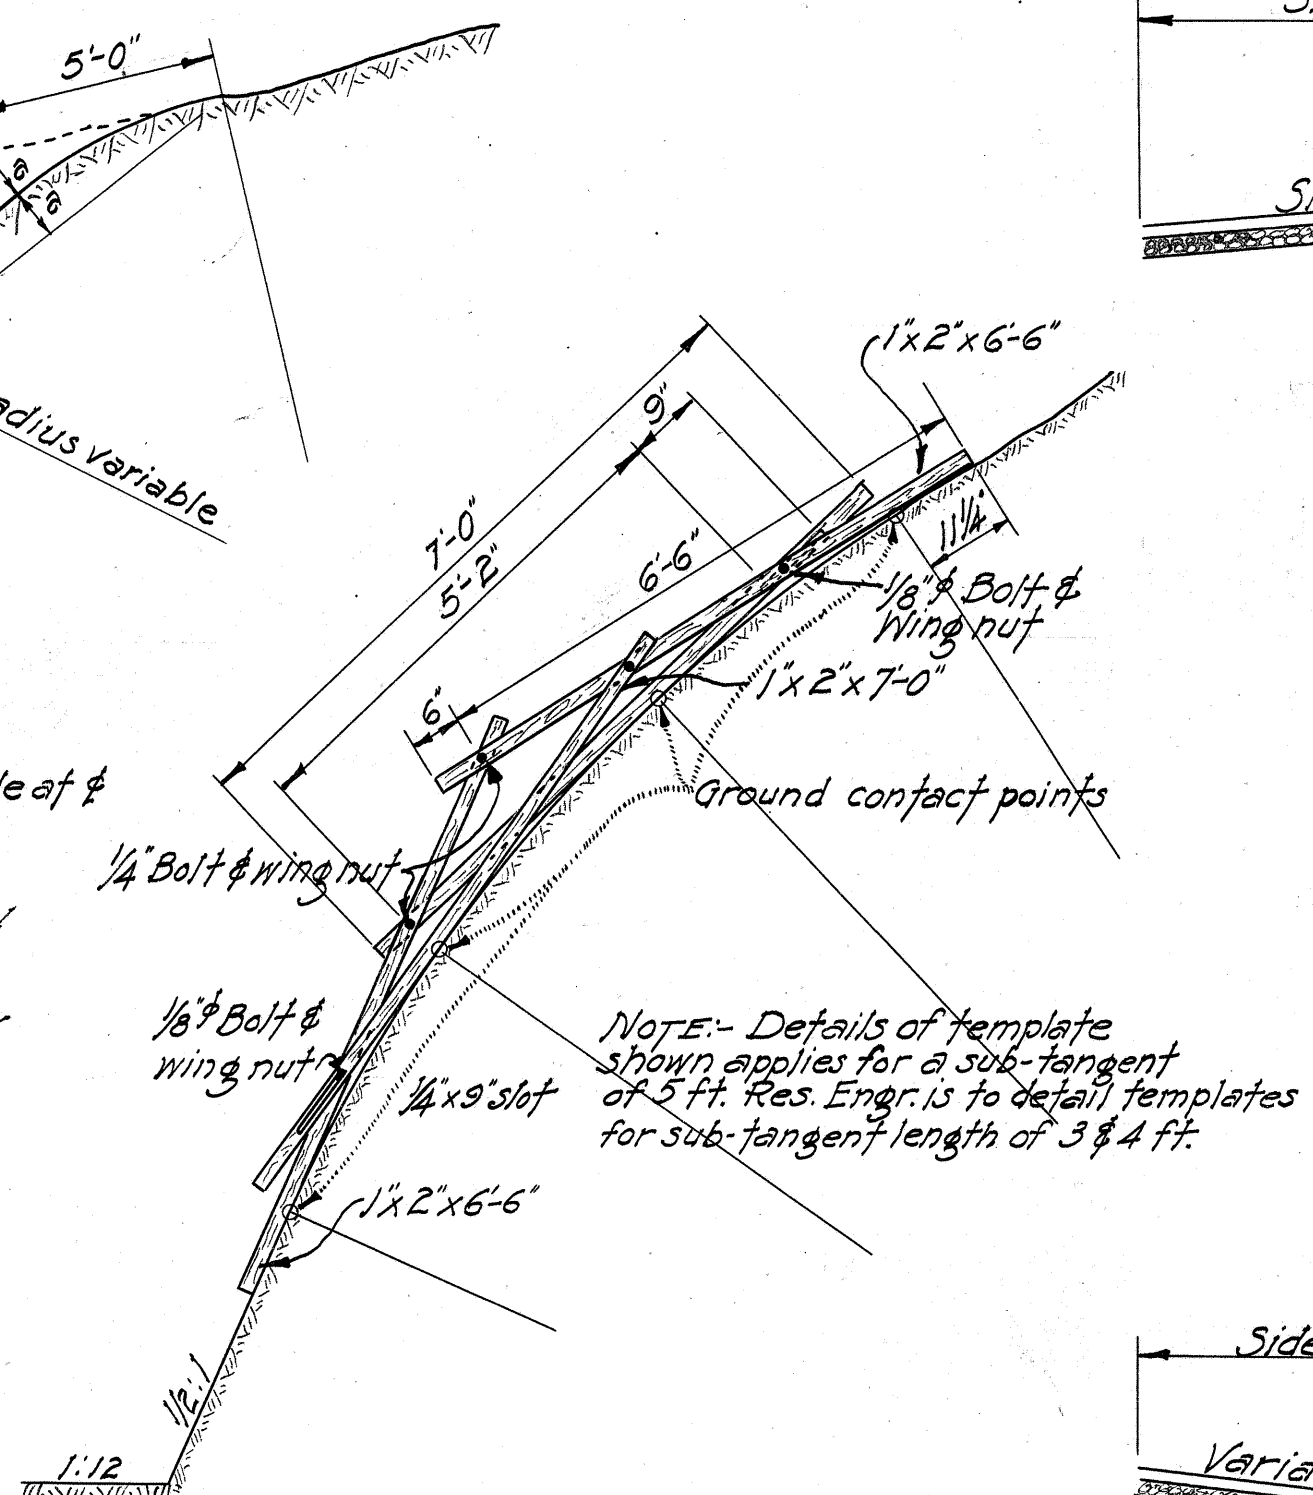


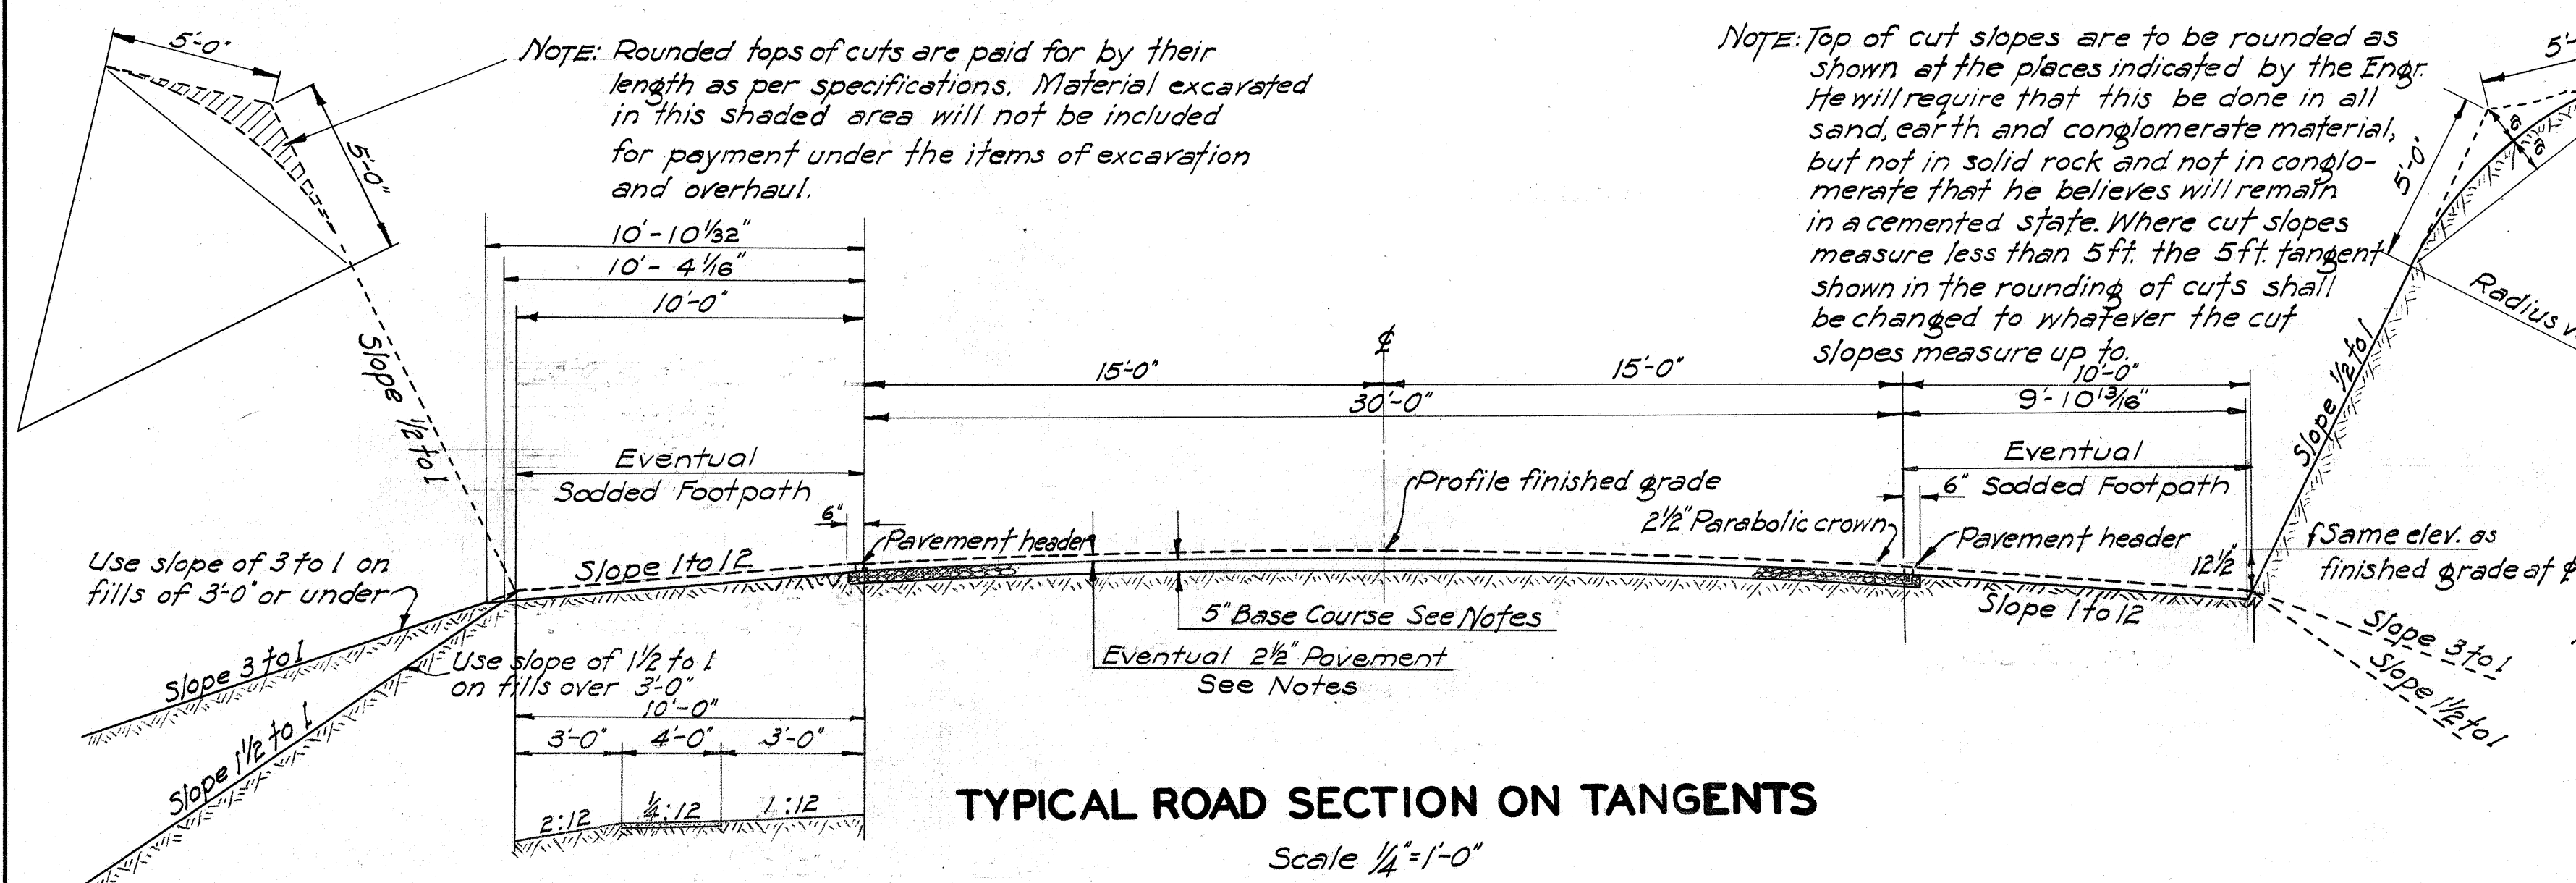

BASE COURSE & PAVEMENT NOTES

BROKEN STONE BASE COURSE: 5" (compacted thickness) Mineral Aggregate (12% wear)

BITUMINOUS TREATMENT OF BASE COURSE: Priming Coat of 1/4 to 1/3 gal. per sq. yd. liquid asphalt type SC-1A; 0.30 to 0.35 gal. per sq. yd. of bituminous binder (emulsified asphalt type); approx. 0.015 cu. yd. per sq. yd. of Crushed Rock (3/4 to #8).

***FOOTPATH:** Part of the footpath surface shall be a bituminous treated footpath surface of 3" finished thickness & part of the footpath surface shall be sodded footpath as noted below:

***BITUMINOUS TREATED FOOTPATH SURFACING:** 3" (Compacted thickness) layer of broken stone base course with a bituminous surface treatment.

***SODDED FOOTPATH SURFACE:** Sodded footpath shall be planted with maniana grass.

GENERAL NOTES: Particular reference is made to the specification covering these items of work.

* Types of footpath not included in this project 9F.

