




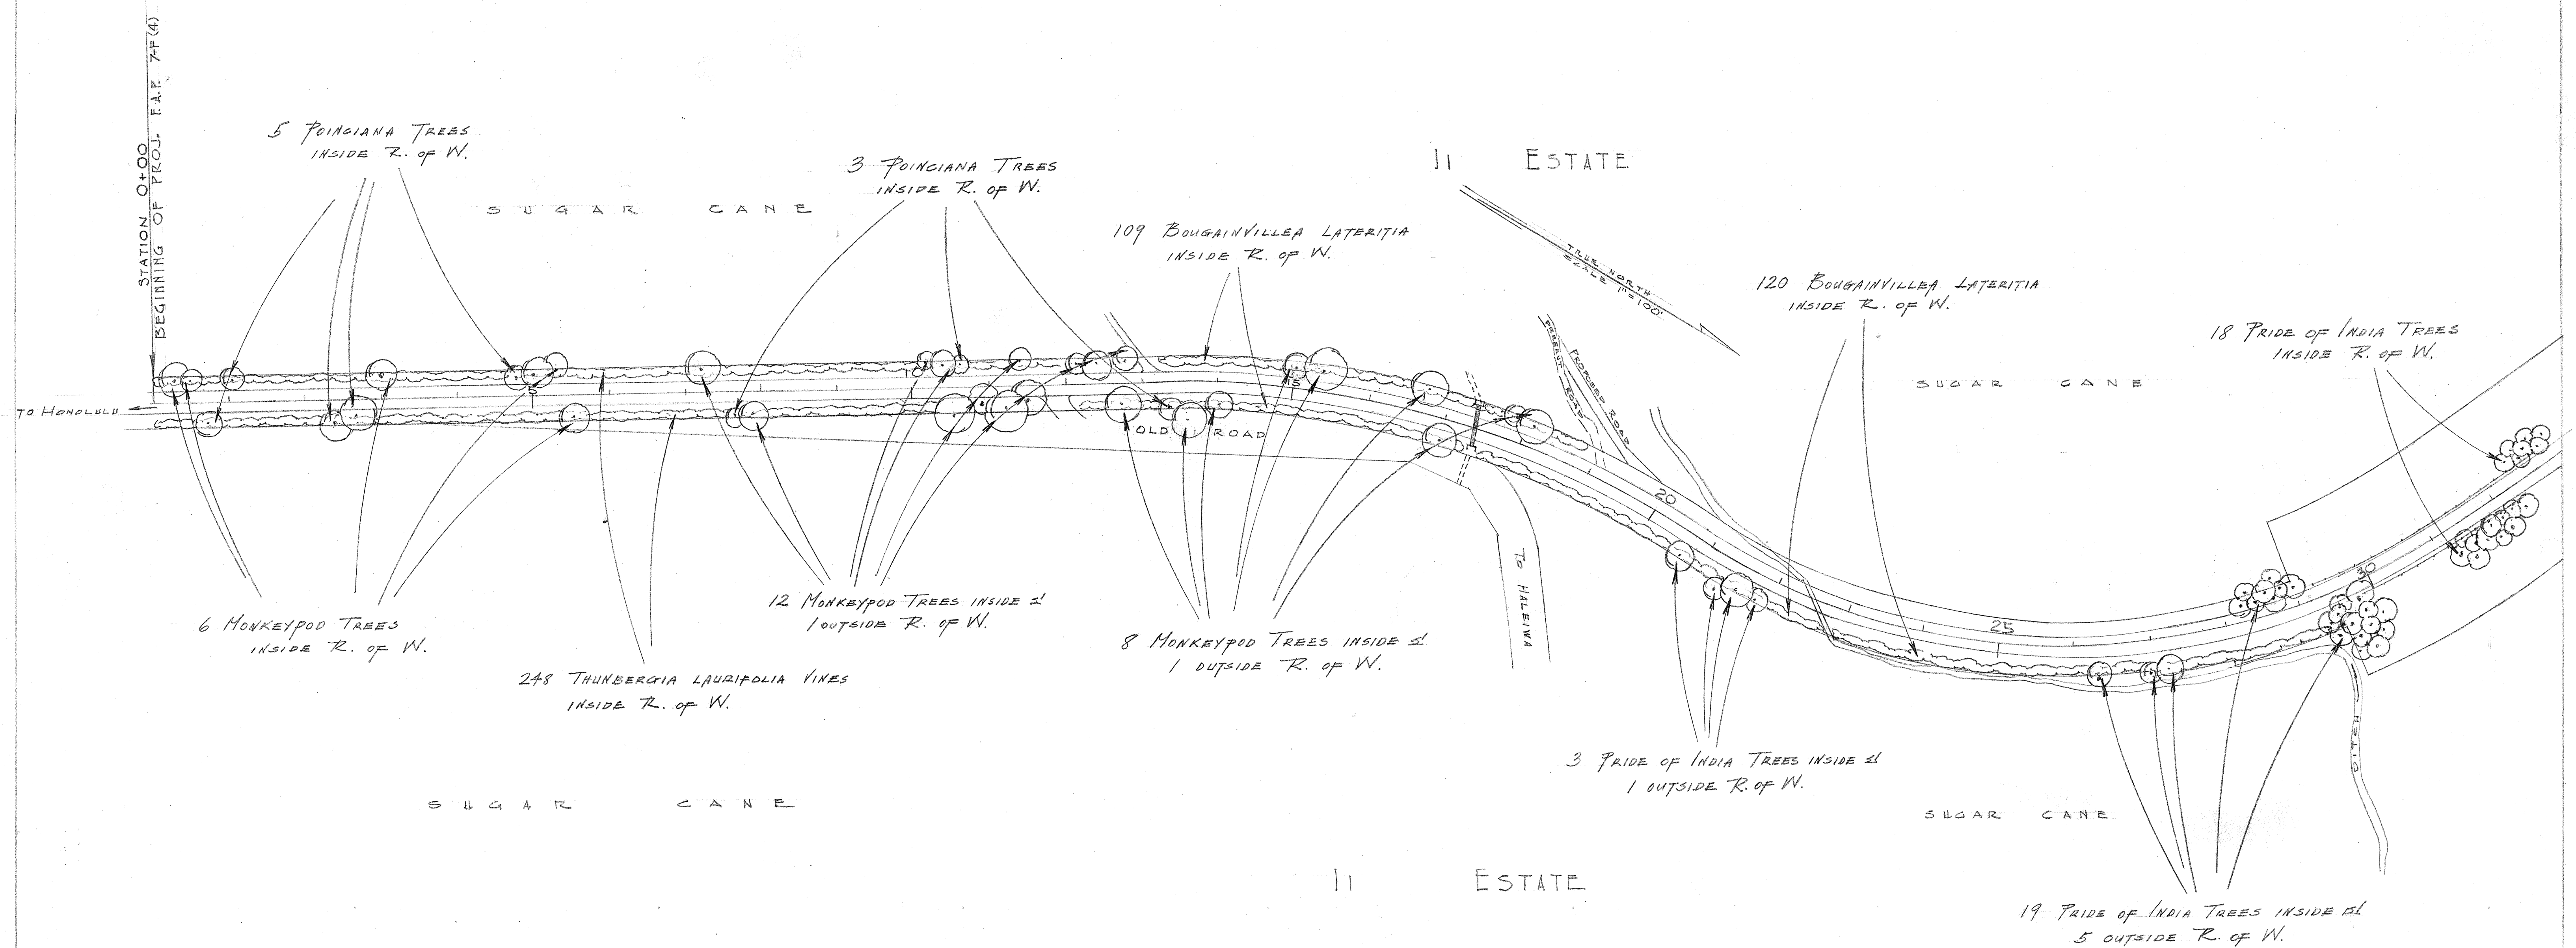

PLANTING KEY				
NO.	BOTANICAL NAME	COMMON NAME	INSIDE R. OF W.	OUTSIDE R. OF W.
1	Poinciana regia — Poinciana		14	
2	Samanea saman — Monkeypod		42	13
3	Thunbergia laurifolia — Thunbergia Vine		248	
4	Bougainvillea lateritia — Boug. Vine		660	
5	Melia azedarach — Pride of India		283	167
6	Bignonia venusta — Huapala Vine		142	
7	Convolvulus purpureus — Morning glory vine		200	
GRAND TOTAL			1589	180
				1769

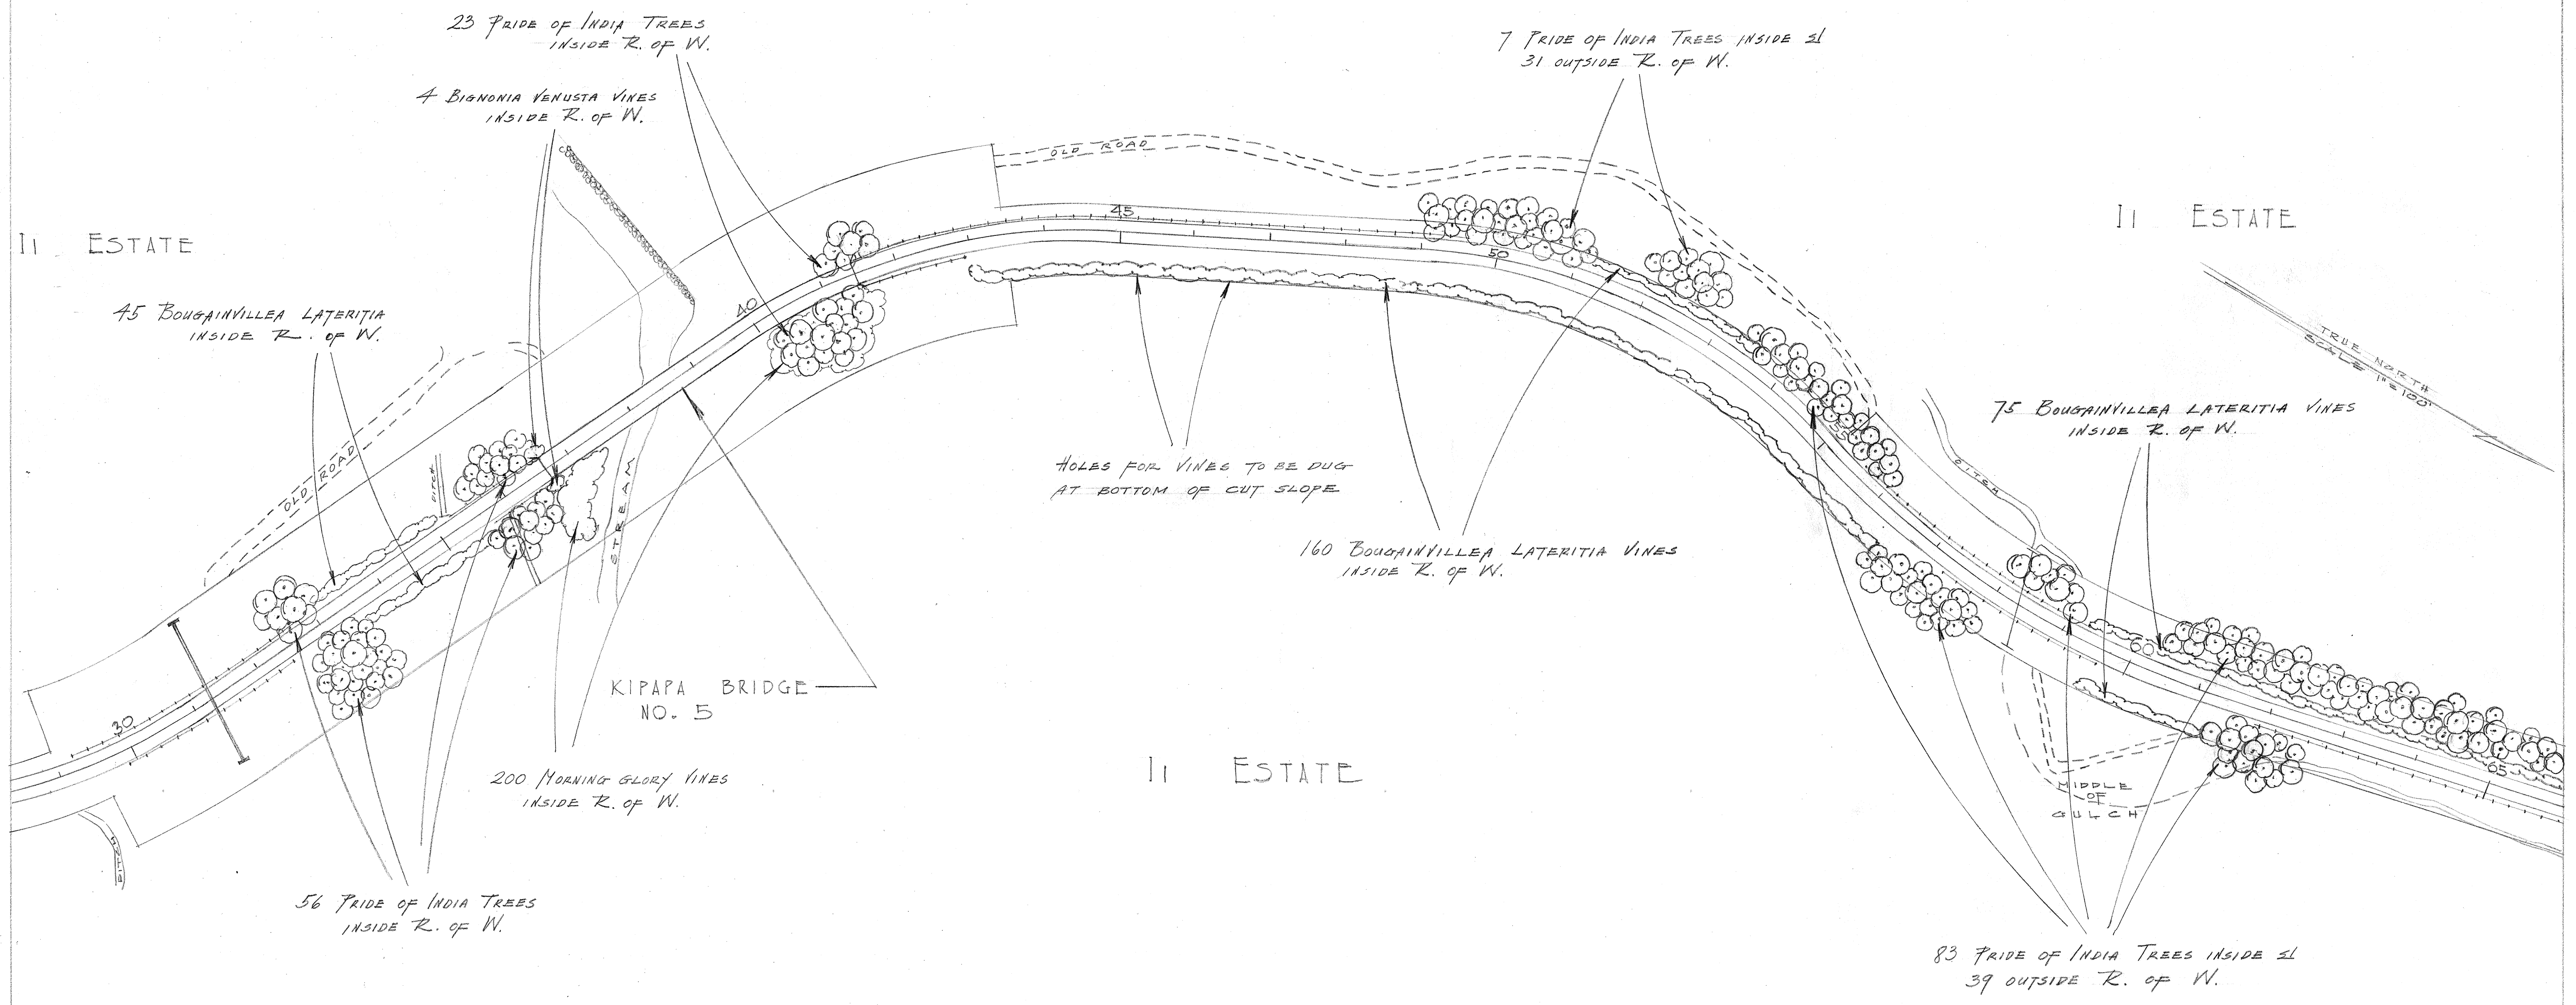

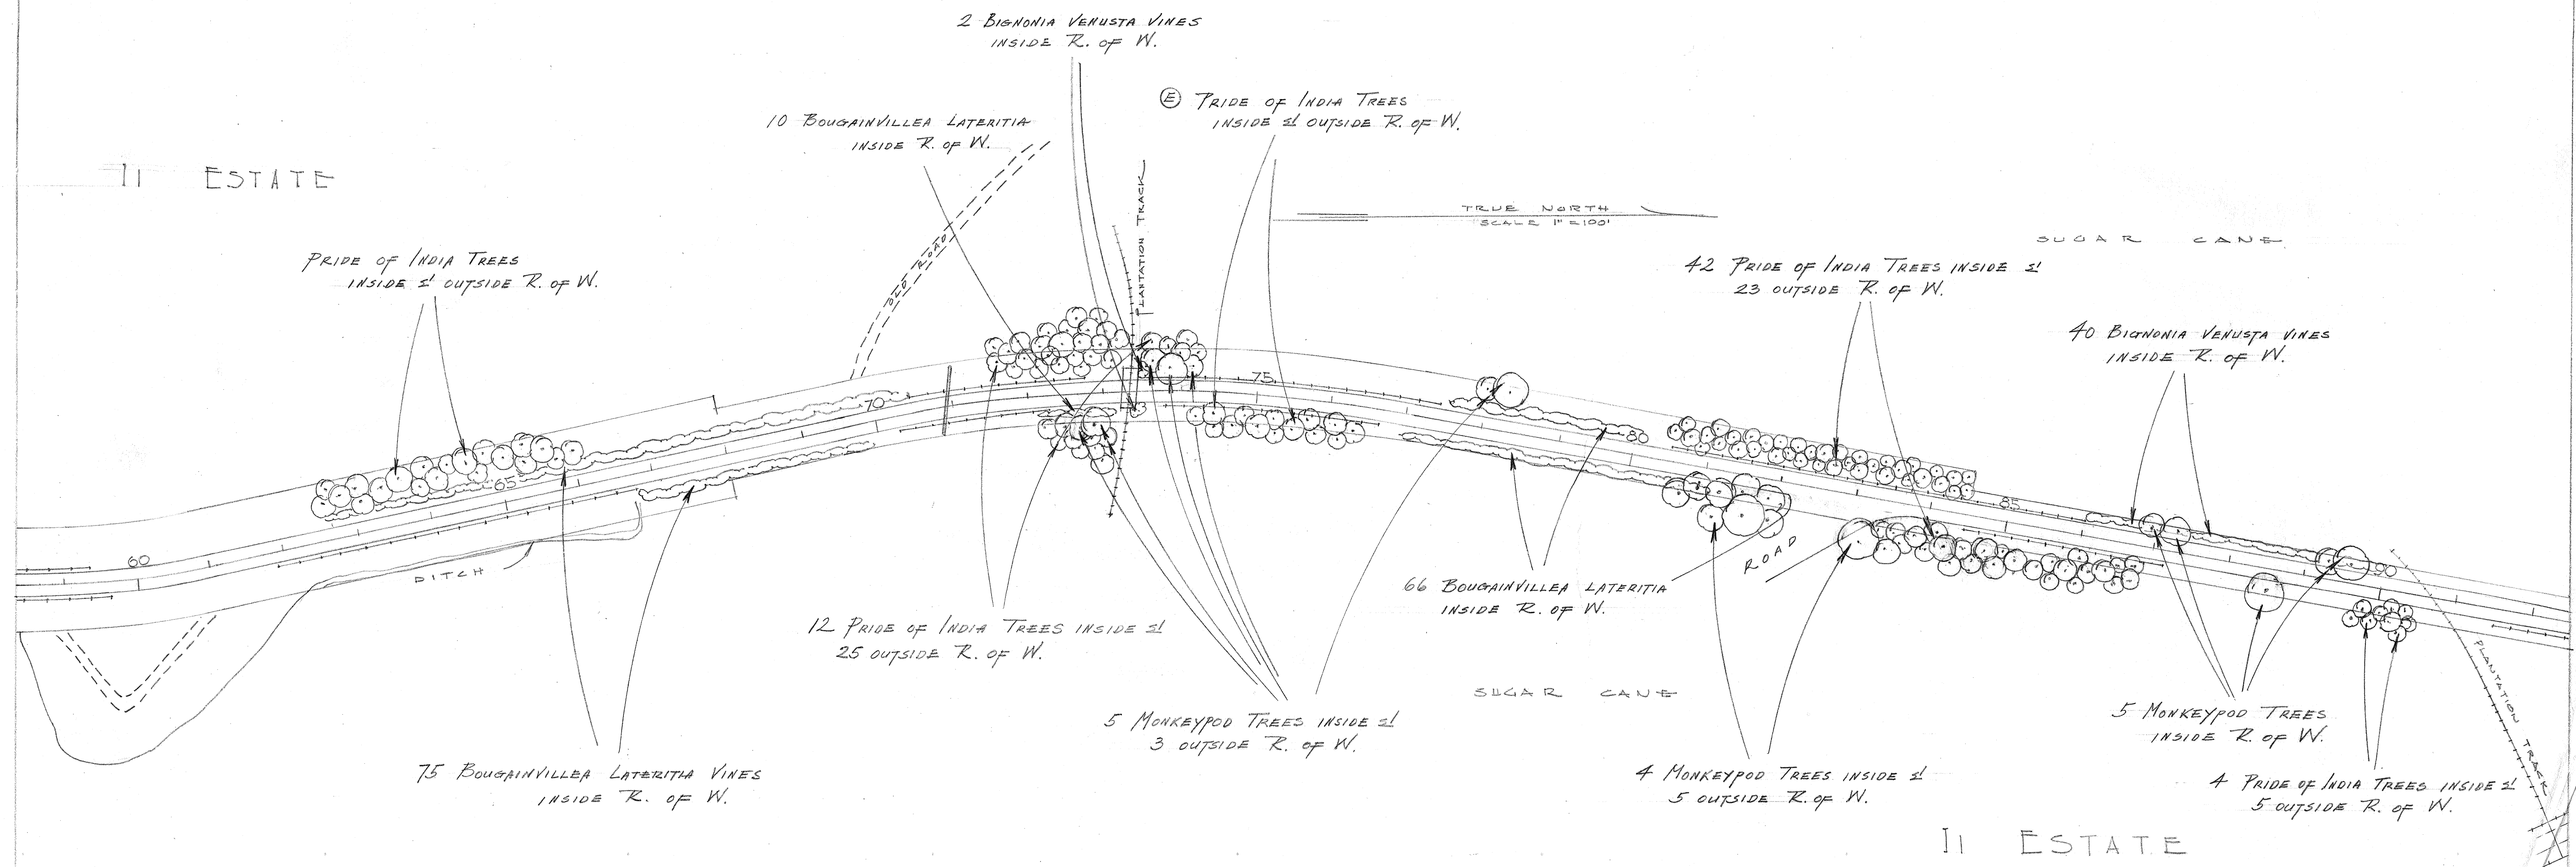

II ESTATE

SUGAR CANE

1 MONKEYPOD TREE
INSIDE R. OF W.

96 BIGNONIA VENUSTA VINES
INSIDE R. OF W.

1 MONKEYPOD TREE INSIDE &L
3 OUTSIDE R. OF W.

16 PRIDE OF INDIA TREES INSIDE &L
38 OUTSIDE R. OF W.

6 POINCIANA TREES
INSIDE R. OF W.

END OF PROJ. F.A.P. 7F(4)
STATION 103+75

TRUE NORTH
SCALE 1" = 100 FT.