


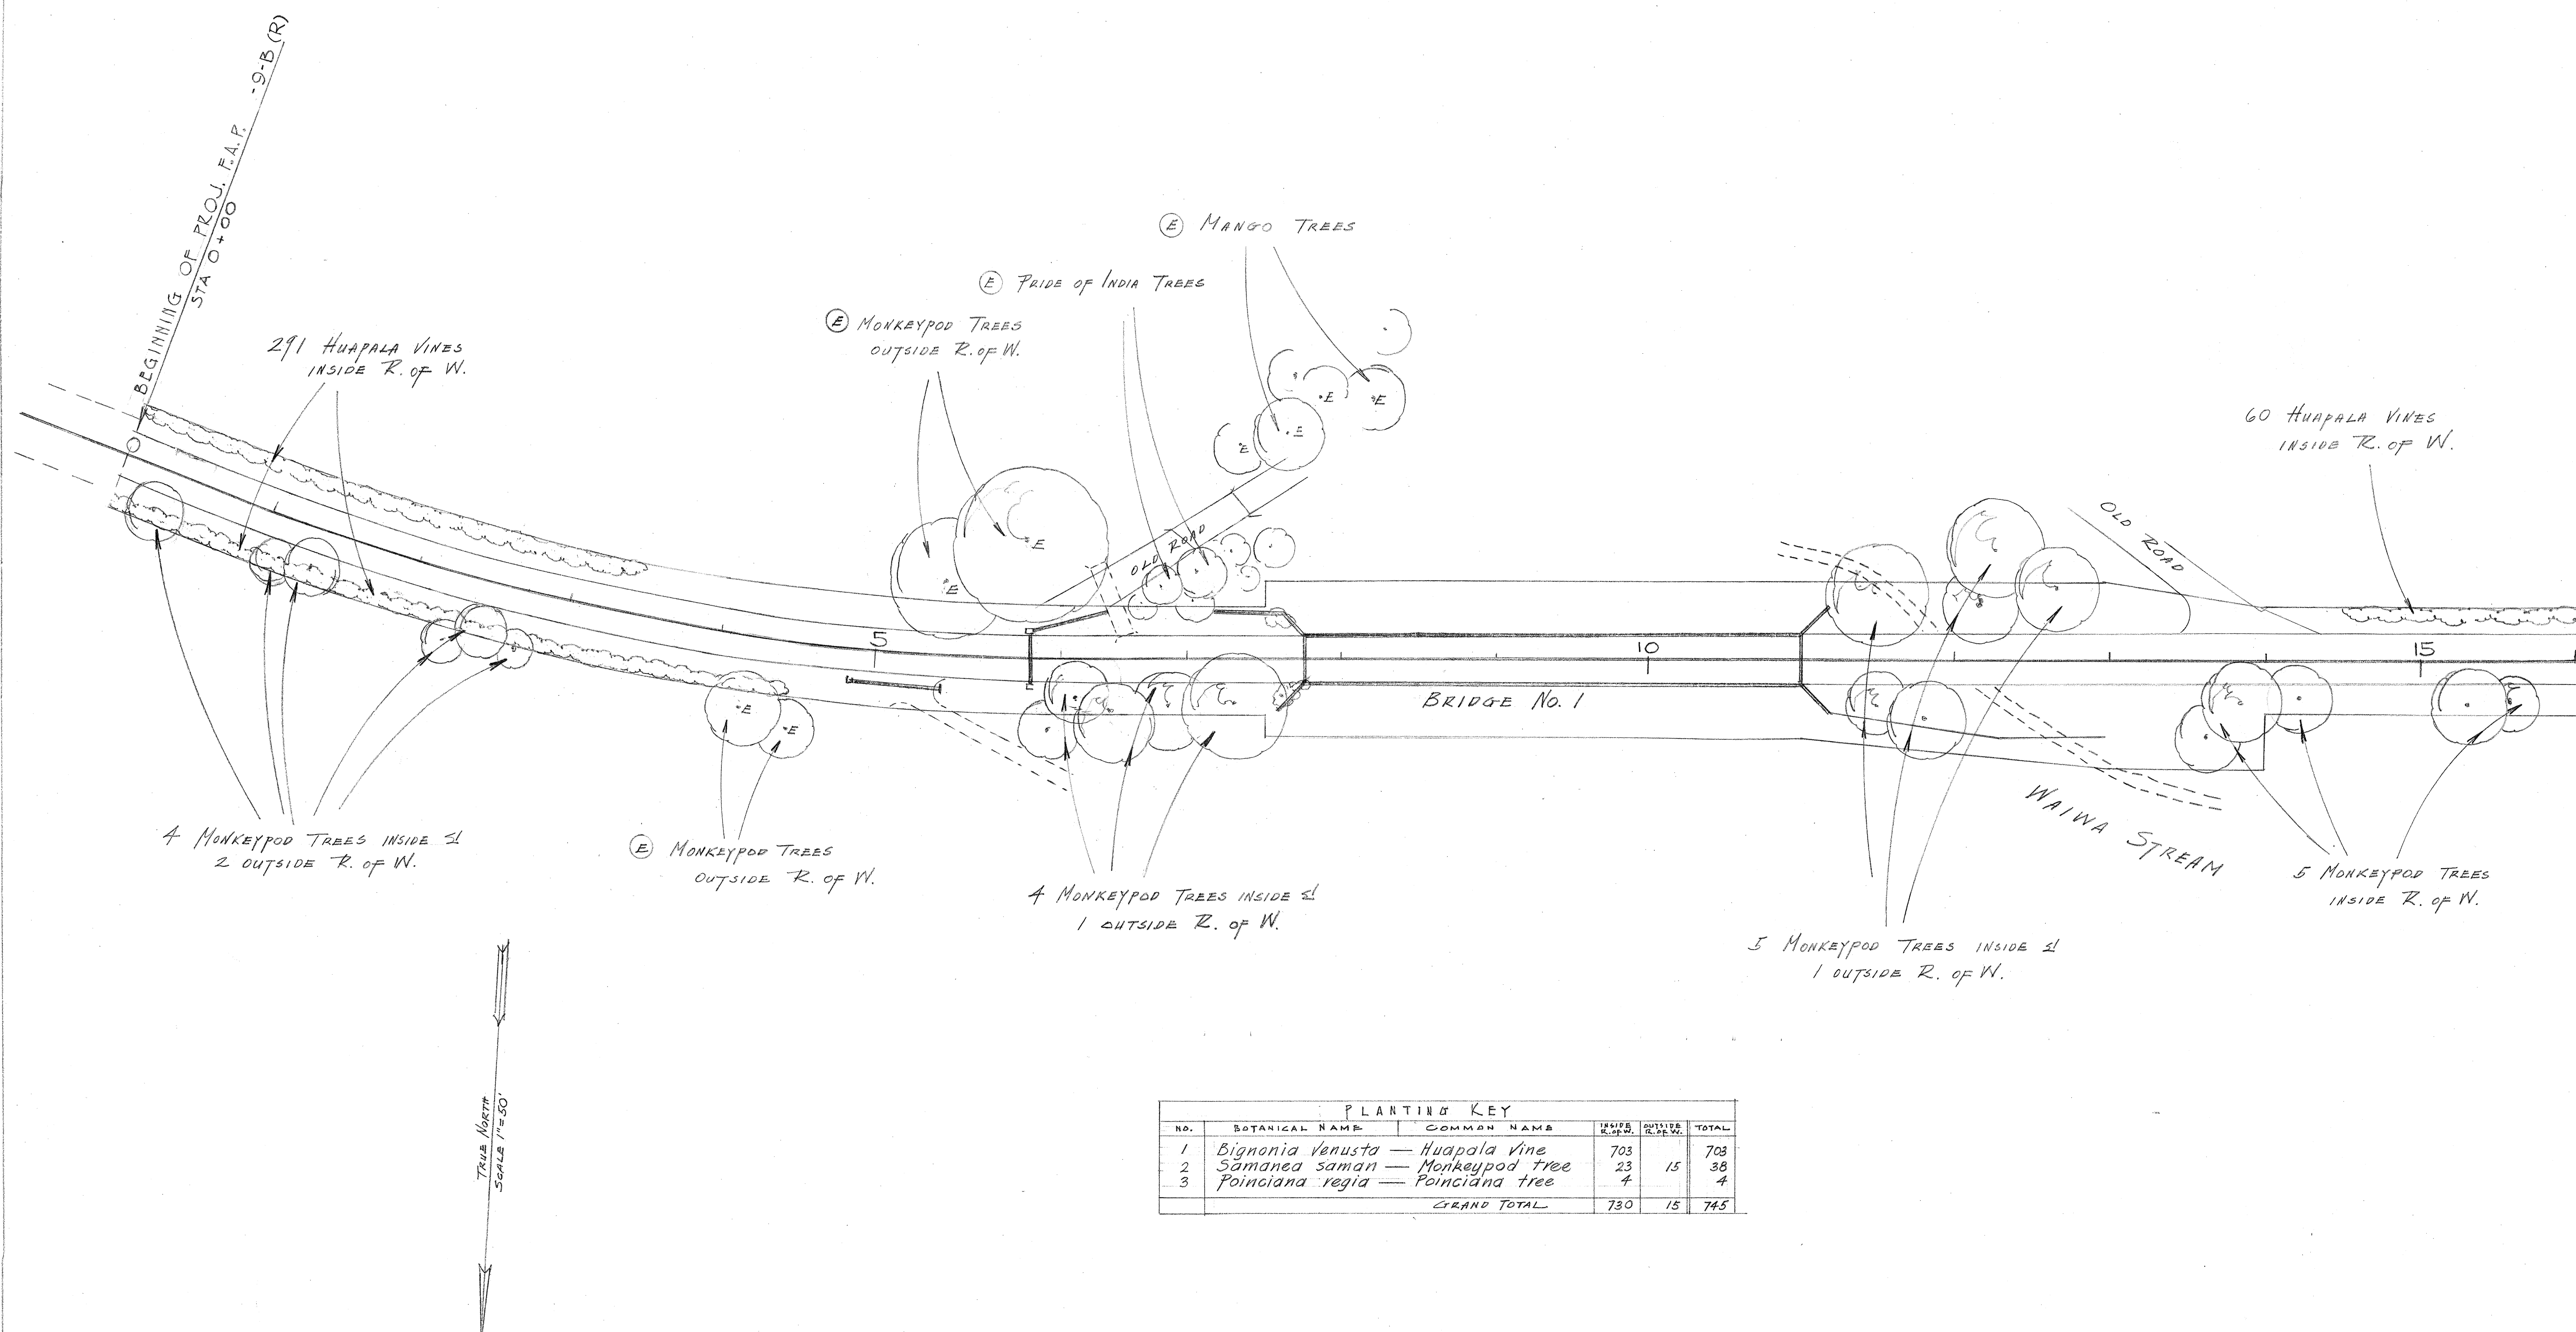

PLANTING KEY					
NO.	BOTANICAL NAME	COMMON NAME	INSIDE CROP NO.	OUTSIDE CROP NO.	TOTAL
1	<i>Bignonia Venusta</i>	Huapala Vine	703		703
2	<i>Samanea saman</i>	Monkeypod tree	23	15	38
3	<i>Poinciana regia</i>	Poinciana tree	4		4
GRAND TOTAL			730	15	745

TRUSTEES OF THE BISHOP ESTATE [OWNERS]

352 HUAPALA VINES
INSIDE R. OF W.

4 POINCIANA TREES
INSIDE R. OF W.

TO SCHOFIELD

