



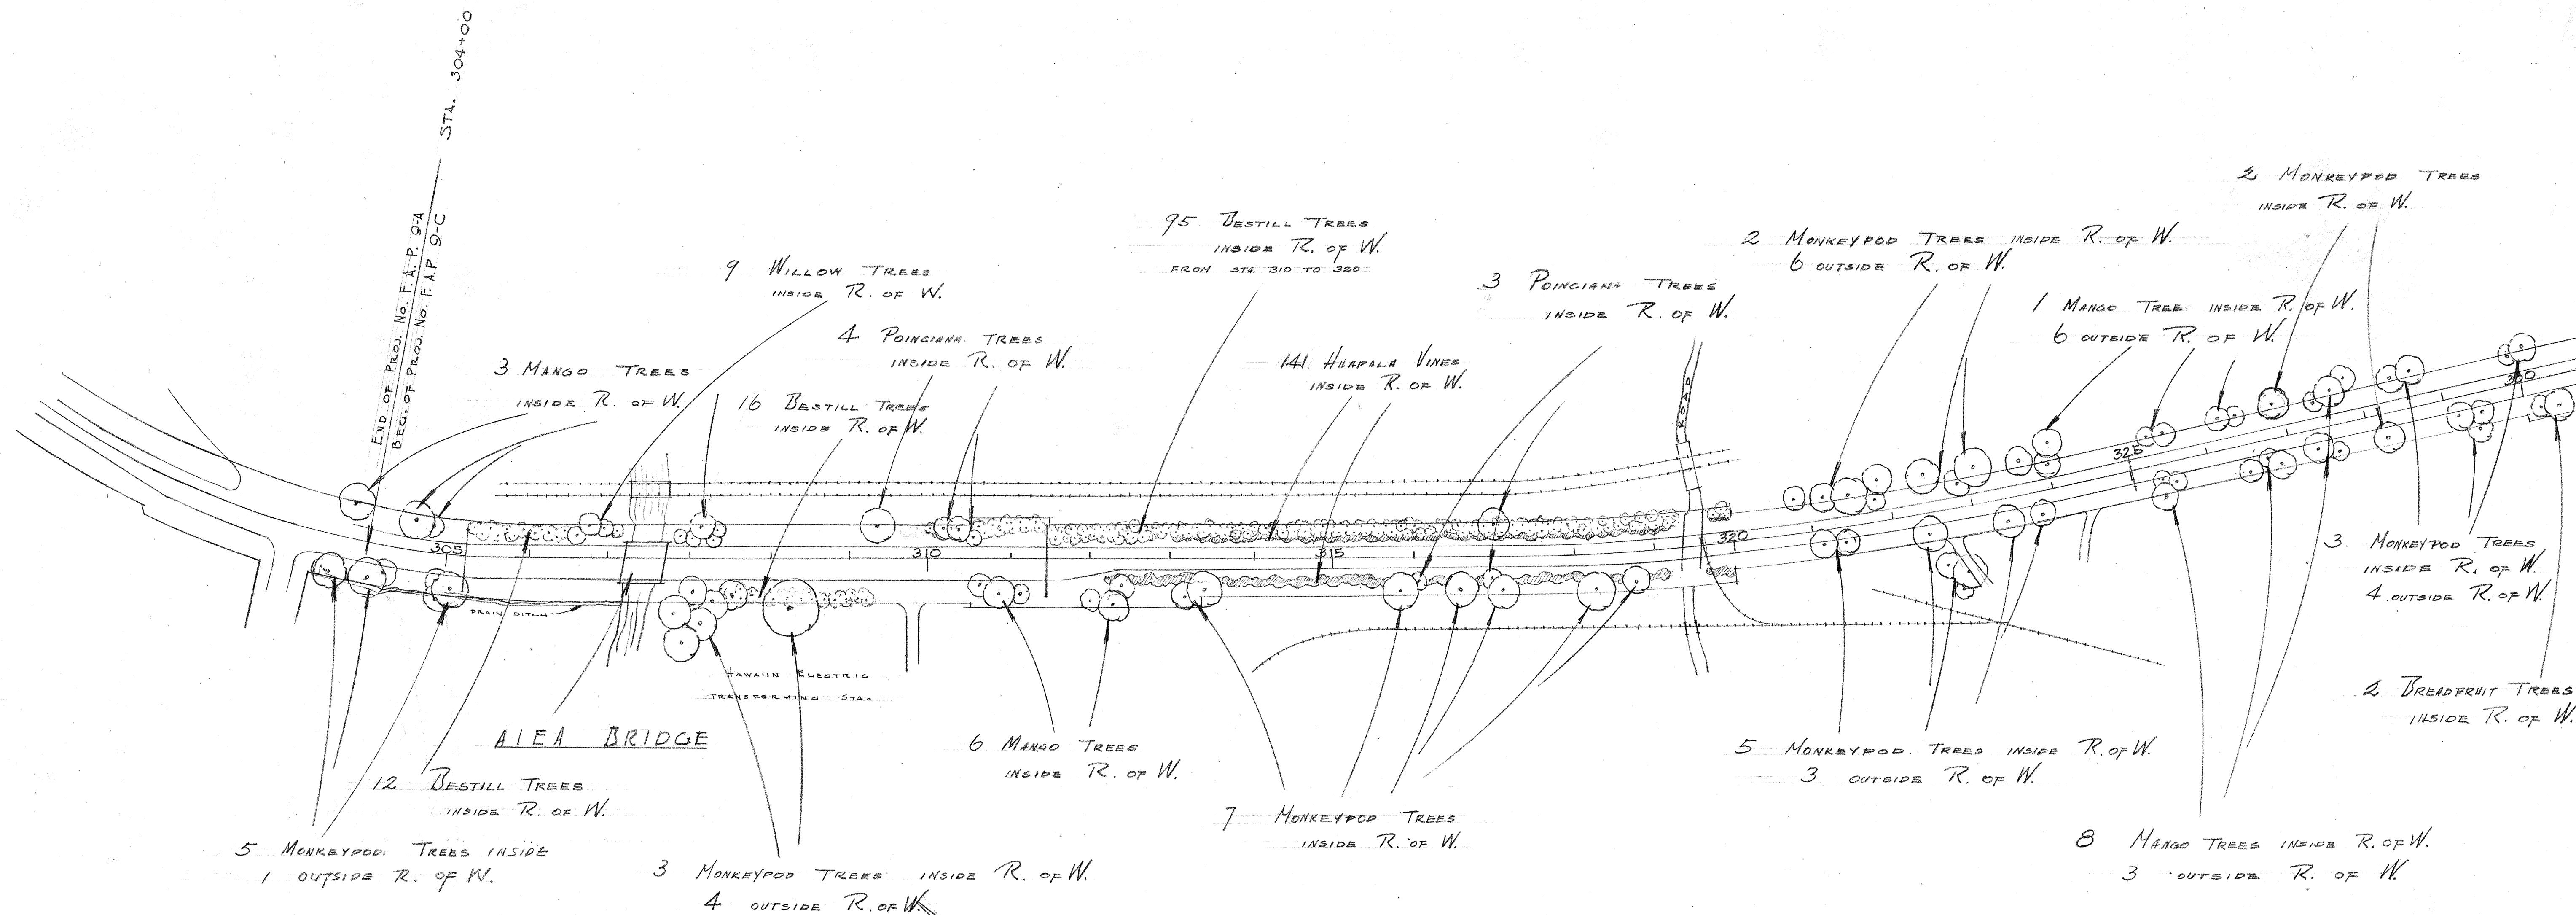

PLANTING KEY				
No.	BOTANICAL NAME	COMMON NAME	INSIDE R. OF W.	OUTSIDE R. OF W.
1	Mangifera indica	Mango Tree	48	25
2	Salix babylonica	Willow	13	6
3	Thevetia peruviana	Be-Still	123	6
4	Samanea saman	Monkeypod	31	19
5	Poinciana regia	Poinciana	10	1
6	Artocarpus incisa	Breadfruit	8	8
7	Bignonia venusta	Huapala Vine	204	8
8	Cocos nucifera	Cocohut	54	61
GRAND TOTAL			491	126
				617

FED. ROAD DIST. NO.	STATE	FED. AID PROJ. NO.	FISCAL YEAR	SHEET NO.	TOTAL SHEETS
HAWAII	HAW	9C	1938	4	5

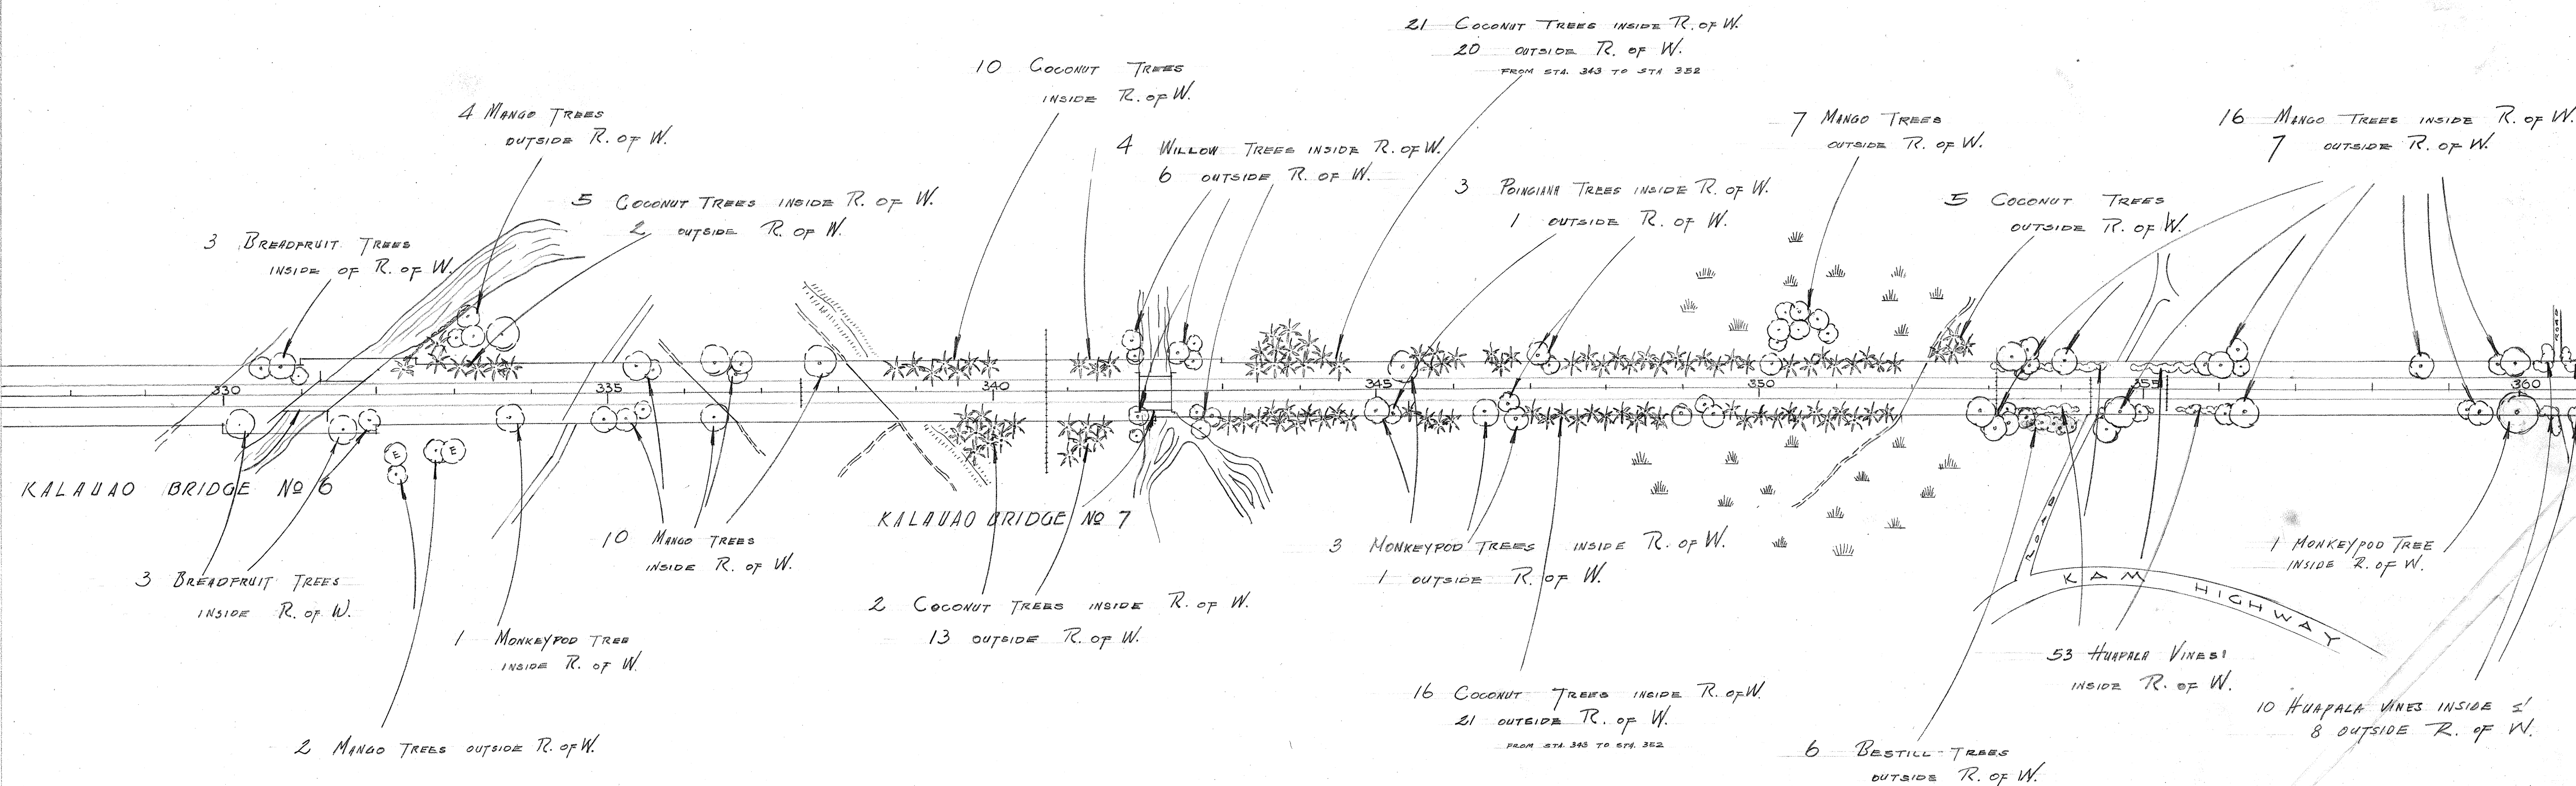


PROJ. NO. F.A.P. 9-C SHEET NO. 2

4445.4

FED. ROAD DIST. NO.	STATE	FED. AID PROJ. NO.	FISCAL YEAR	SHEET NO.	TOTAL SHEETS
HAWAII	HAW	9F(8)	1938	3	6

FED. ROAD DIST. NO.	STATE	FED. AID PROJ. NO.	FISCAL YEAR	SHEET NO.	TOTAL SHEETS
HAWAII	HAW	9C	1938	5	5

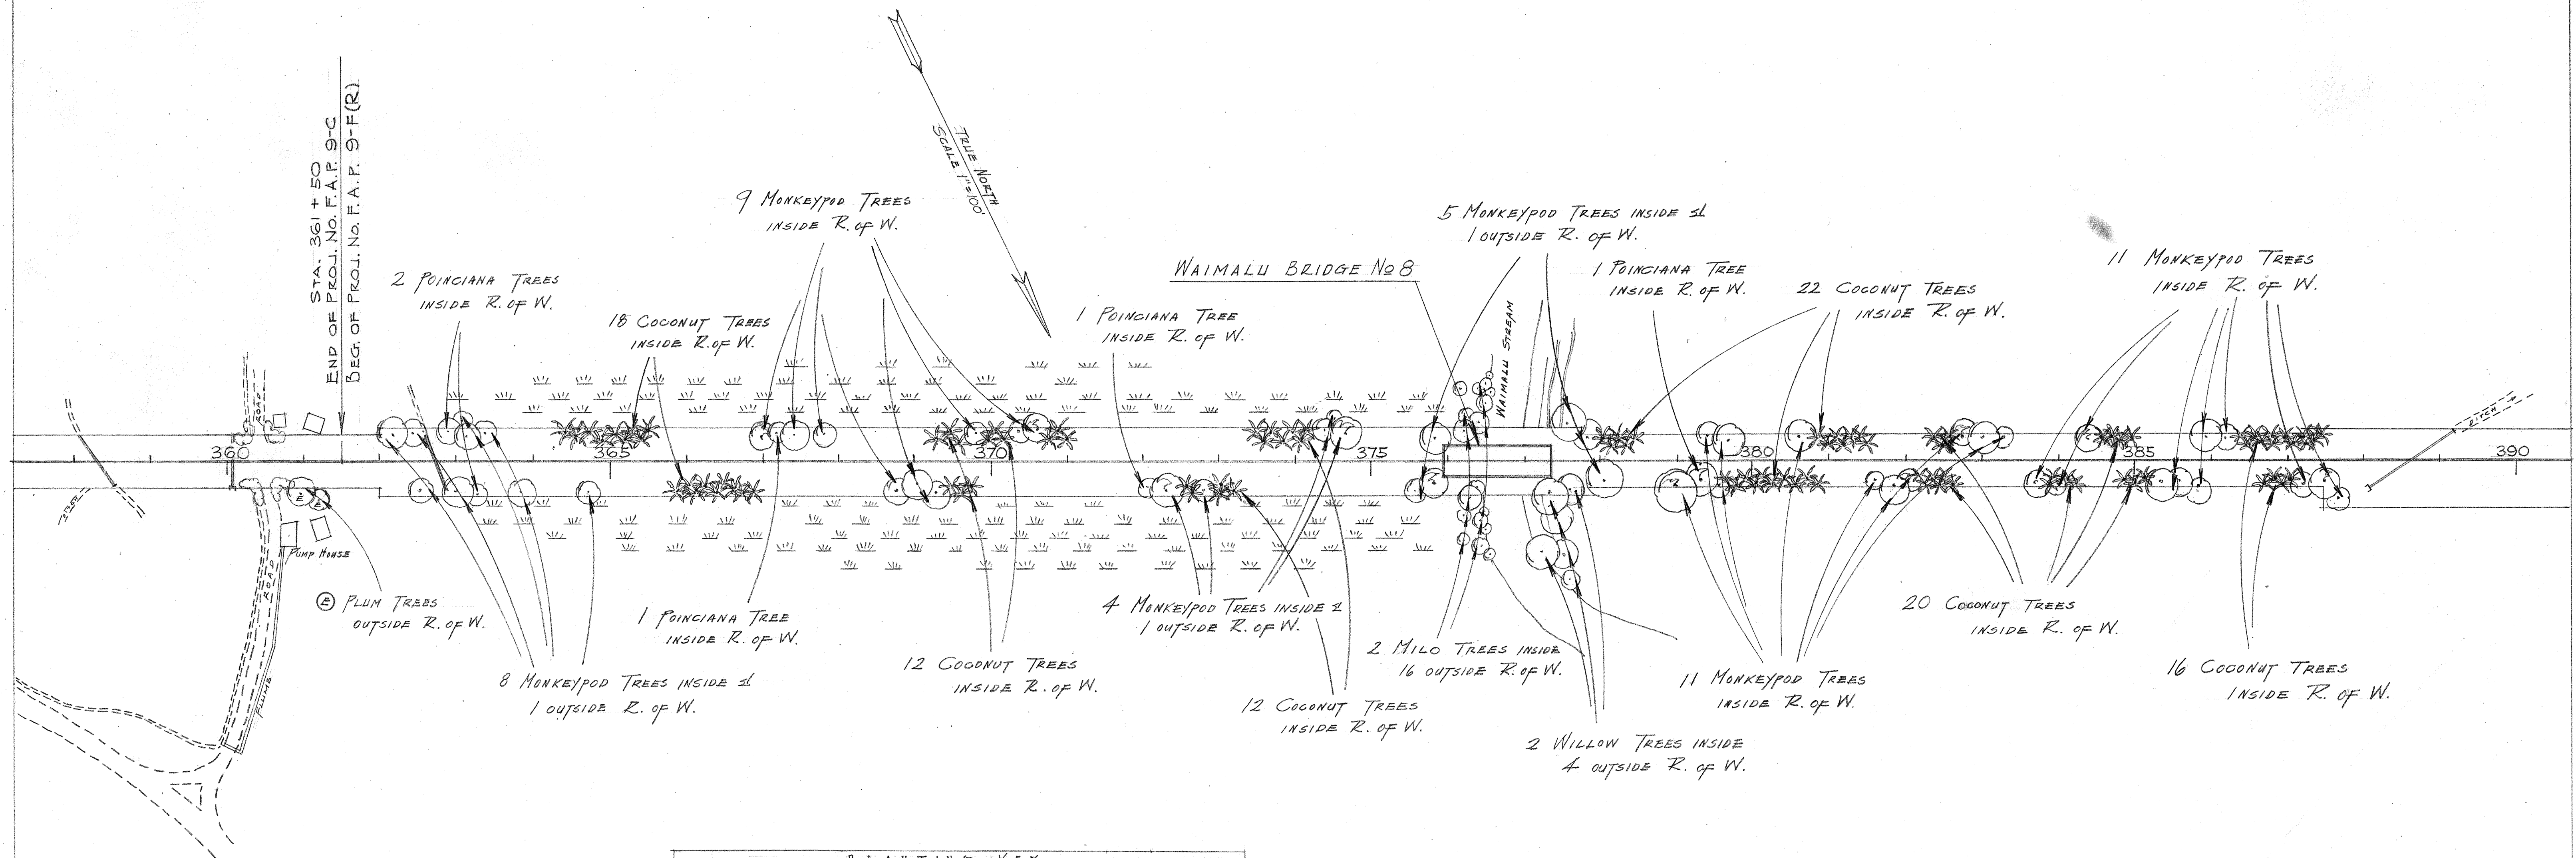

PLANTING KEY					
NO.	BOTANICAL NAME	COMMON NAME	INSIDE R.O.F. W.	OUTSIDE R.O.F. W.	TOTAL
1	<i>Bignonia venusta</i>	Huapala Vine	539		539
2	<i>Poinciana regia</i>	Poinciana Tree	69	15	84
3	<i>Cocos nucifera</i>	Coconut	100		100
4	<i>Samanea saman</i>	Monkeypod	123	41	164
5	<i>Theopatia populnea</i>	Milo	6	19	25
6	<i>Salix babylonica</i>	Willow	10	20	30
7	<i>Mangifera indica</i>	Mango	2		2
8	<i>Artocarpus incisa</i>	Breadfruit	1		1
9	<i>Thevetia nereitolia</i>	Be-Still	126		126
GRAND TOTAL			976	95	1071

PROJ. NO. F.A.P. 9-C SHEET NO. 3

PROJ. NO. F.A.P. 9-F(8) SHEET NO. 1

4445.5 4439.3