
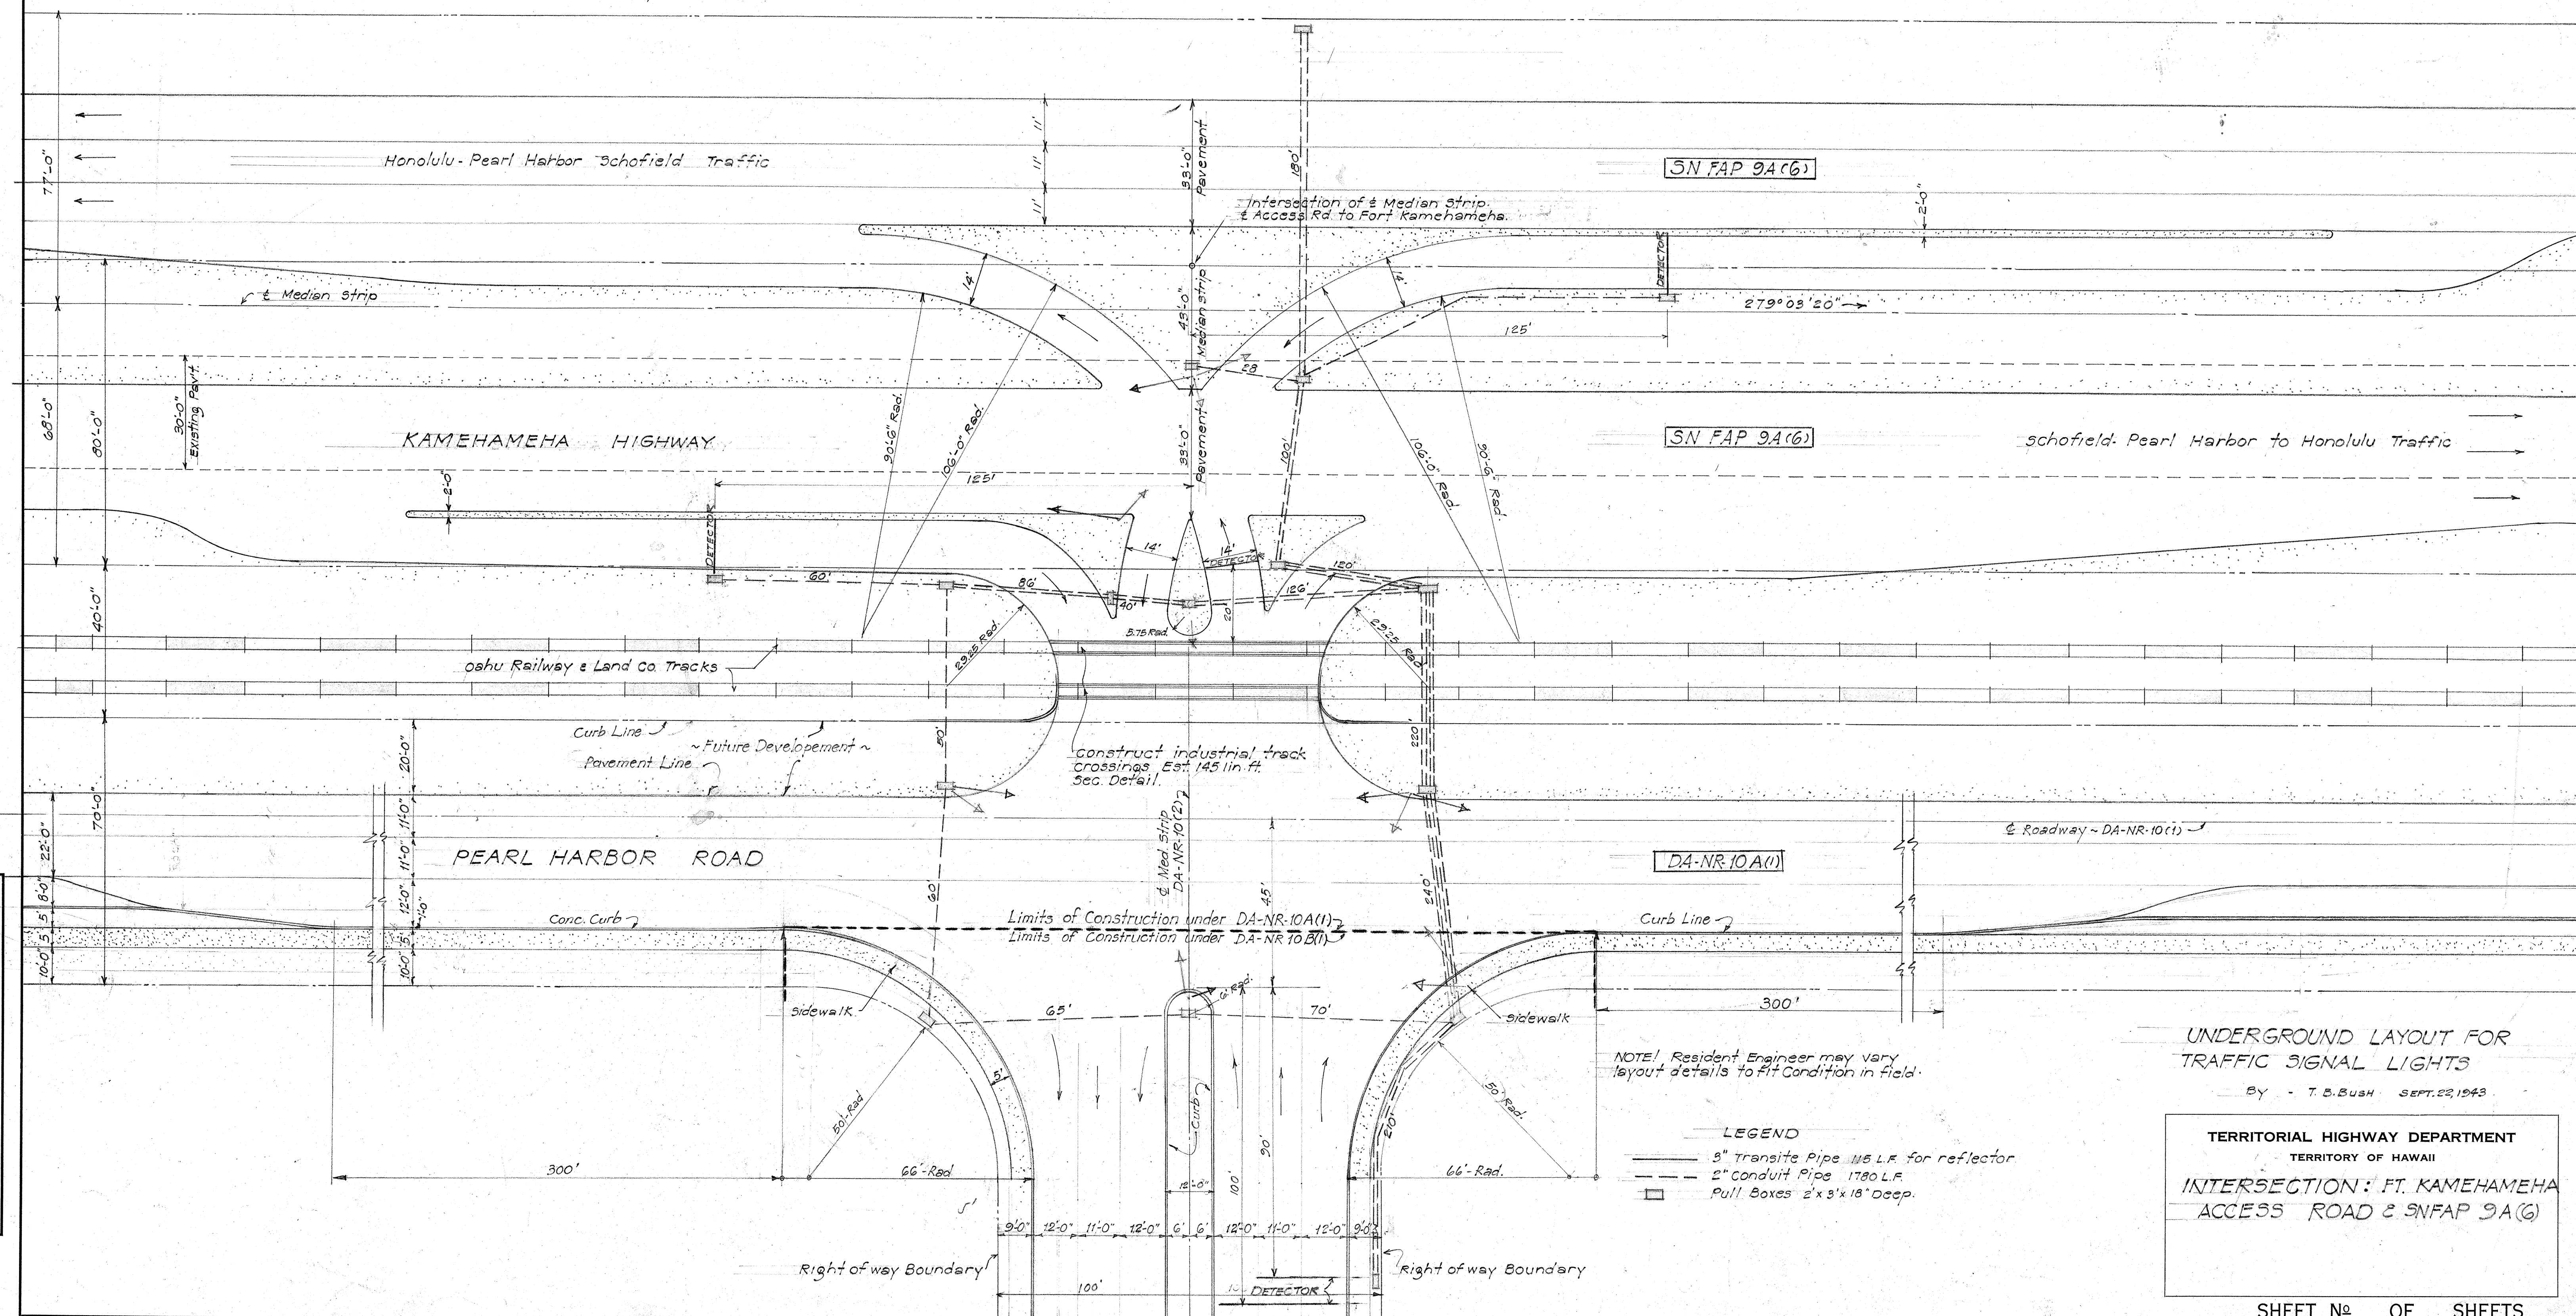


FED. ROAD DIST. NO.	STATE	FED. AID PROJ. NO.	FISCAL YEAR	SHEET NO.	TOTAL SHEET
Hawaii	Haw	SNFAP 9AC	1942	28	25

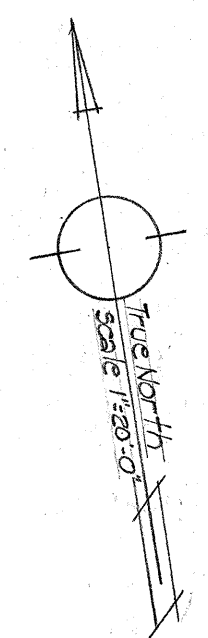

UNDERGROUND LAYOUT FOR
TRAFFIC SIGNAL LIGHTS

By - T. B. BUSH SEPT. 22, 1943


TERRITORIAL HIGHWAY DEPARTMENT
TERRITORY OF HAWAII

INTERSECTION: FT. KAMEHAMEHA
ACCESS ROAD & SNFAP 9A(6)

VOID = See Revised Sheet 10-A

ORIGINAL	SURVEY PLOTTED BY.....	DATE.....
PLAN	DESIGNED BY.....	
	DRAWN BY.....	
	TRACED BY.....	
NOTE BOOK	QUANTITIES BY.....	
	QUANTITIES CHECKED BY.....	
N _o .	CHECKED BY.....	

FED. ROAD DIST. NO.	STATE	FED. AID PROJ. NO.	FISCAL YEAR	SHEET NO.	TOTAL SHEETS
HAWAII	HAW	SN. FAP 9A(6)	1942	2-D	25

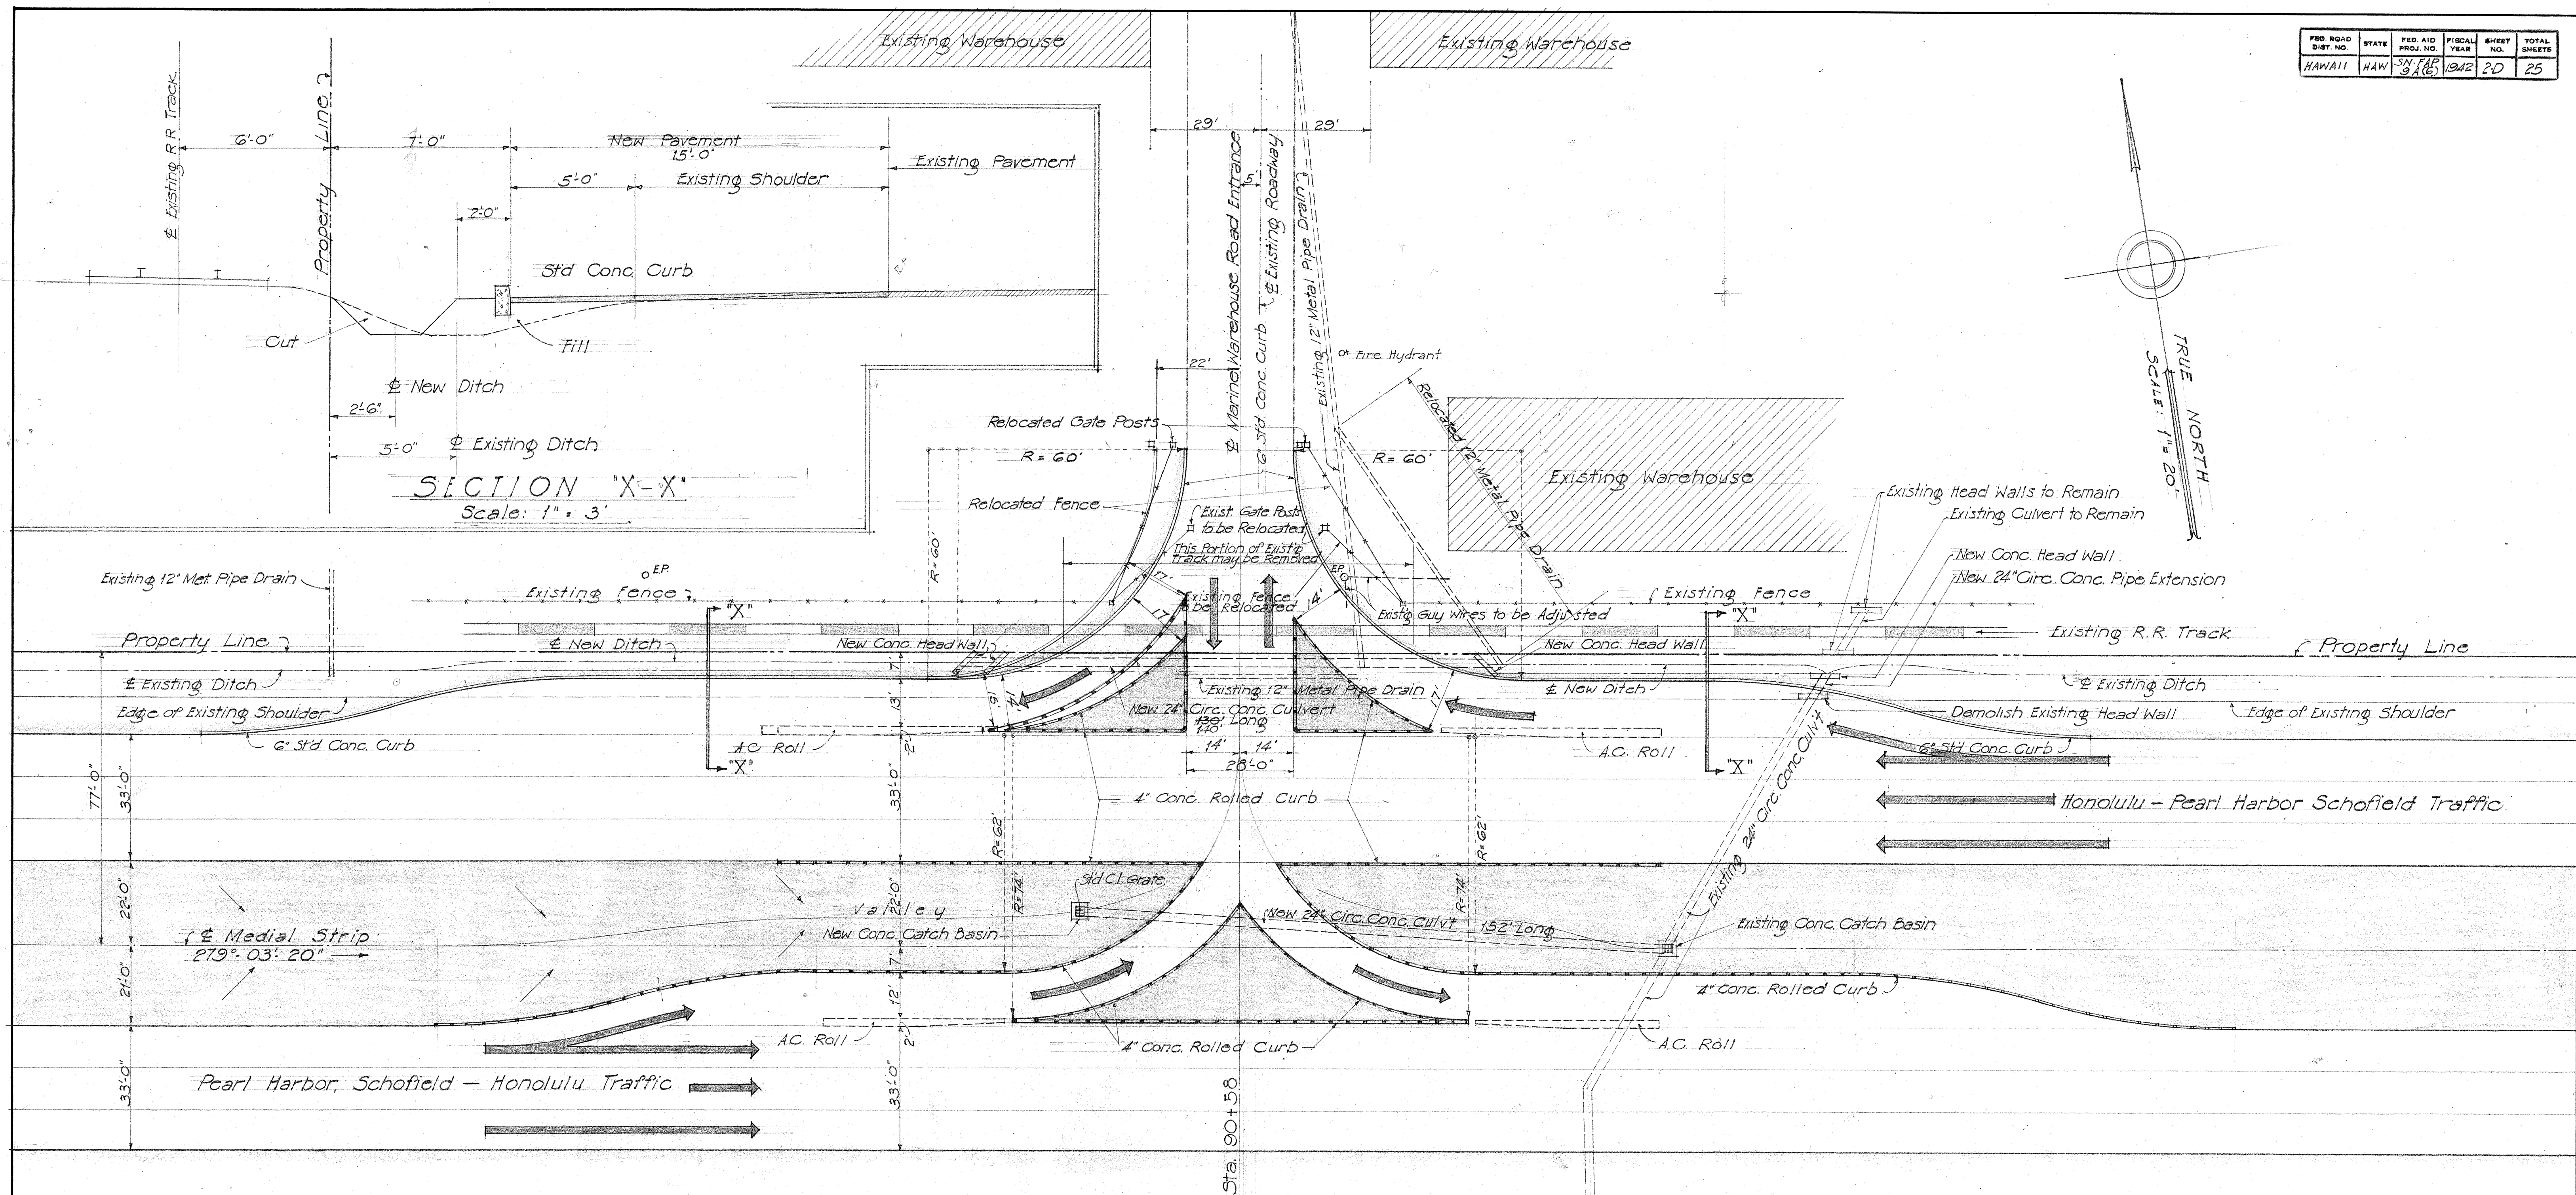

LEGEND

-  4" Conc. Rolled Curb
 6" Std Conc. Curb

Scale of Plan : $1'' = 20 \text{ Ft.}$



Additional Pavement - 13,556 \$

TERRITORIAL HIGHWAY DEPARTMENT
TERRITORY OF HAWAII

INTERSECTION MARINE WARE-
HOUSE ENTRANCE ROAD WITH
KAMEHAMEHA HIGHWAY
Sta. 90+58 of SN-FAP 9A(6)
Scale: As Noted

5 0 9 1 . 2 10

FED. ROAD DIST. NO.	STATE	FED. AID PROJ. NO.	FISCAL YEAR	SHEET NO.	TOTAL SHEETS
HAWAII	HAWAII	SN-FAP 9A(6)	1942		

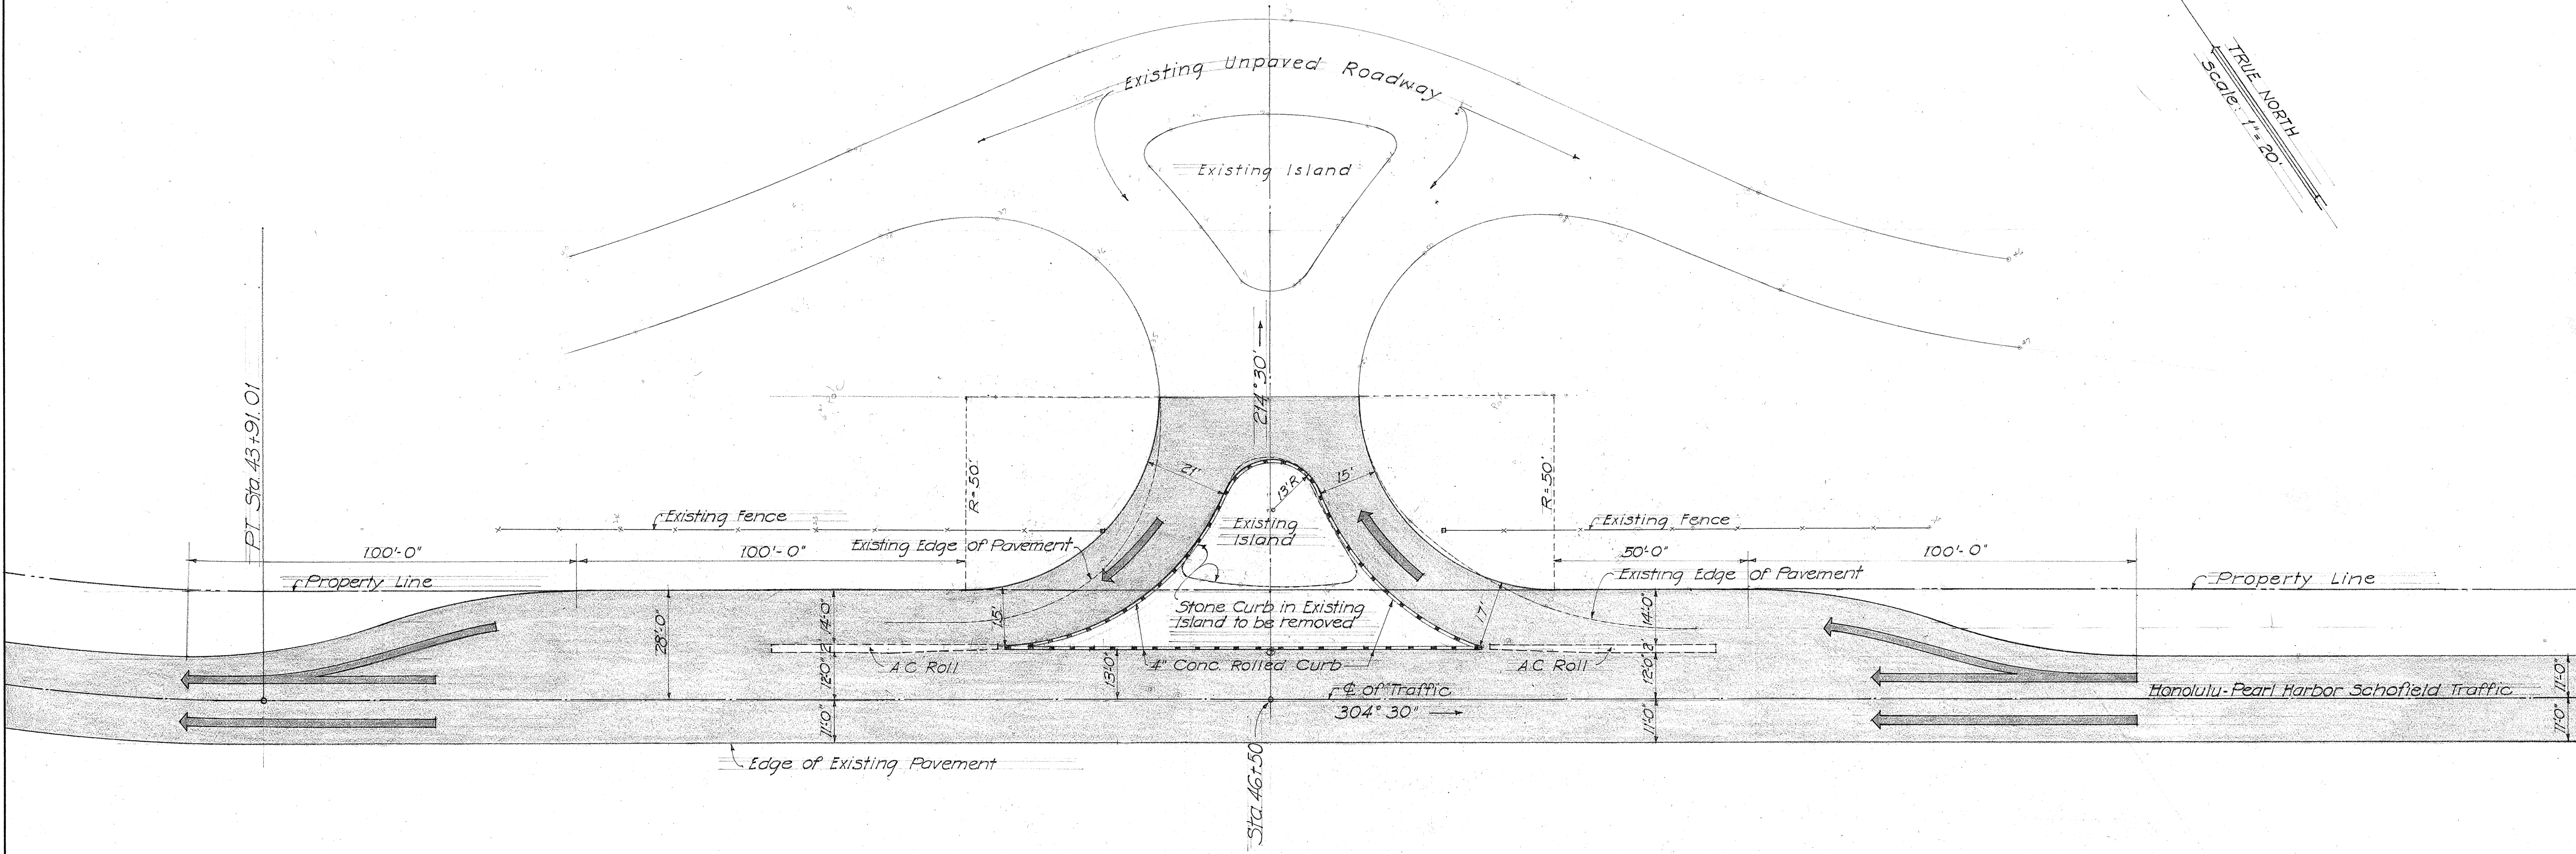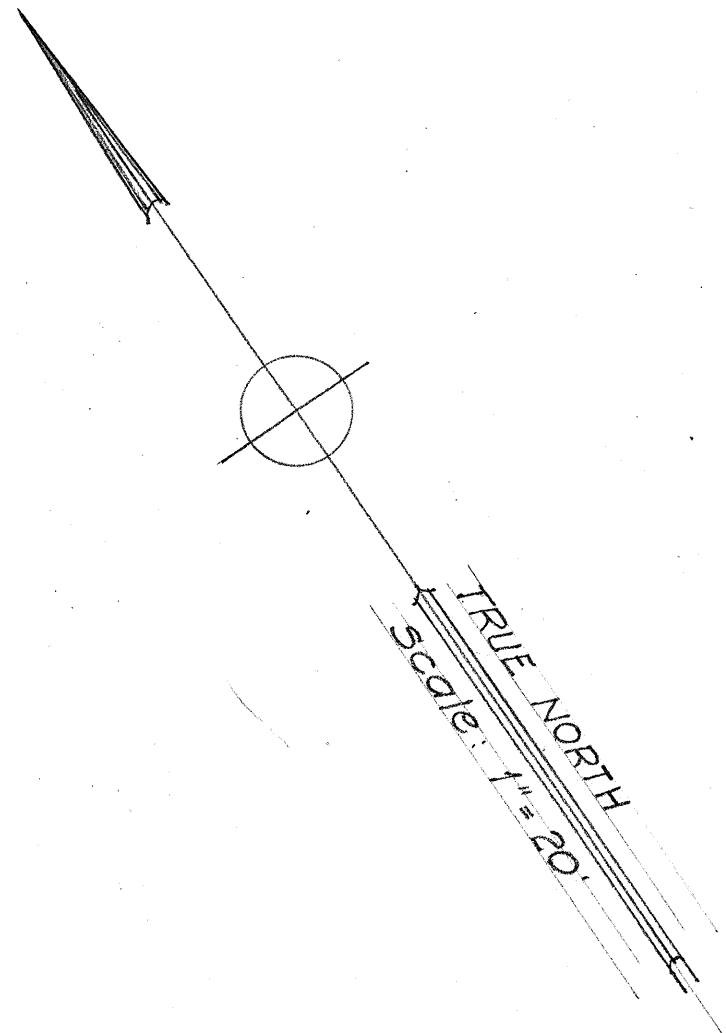

ORIGINAL PLAN	SURVEY PLOTTED BY	DATE
NOTEBOOK	DRAWN BY	"
	TRACED BY	"
	QUANTITIES BY	"
	CHECKED BY	"

TERRITORIAL HIGHWAY DEPARTMENT
TERRITORY OF HAWAII

KAMEHAMEHA HIGHWAY
PROJ. N° SN-FAP 9A(6)
NAVY ENTRANCE
STA. 46+50
Scale: 1" = 20'

7-26-44

5091.213