




FED. ROAD DIST. NO.	STATE	FED. AID PROJ. NO.	FISCAL YEAR	SHEET NO.	TOTAL SHEETS
SN-FAP-9A(6)	HAWAII	3A(6)	1941	2	

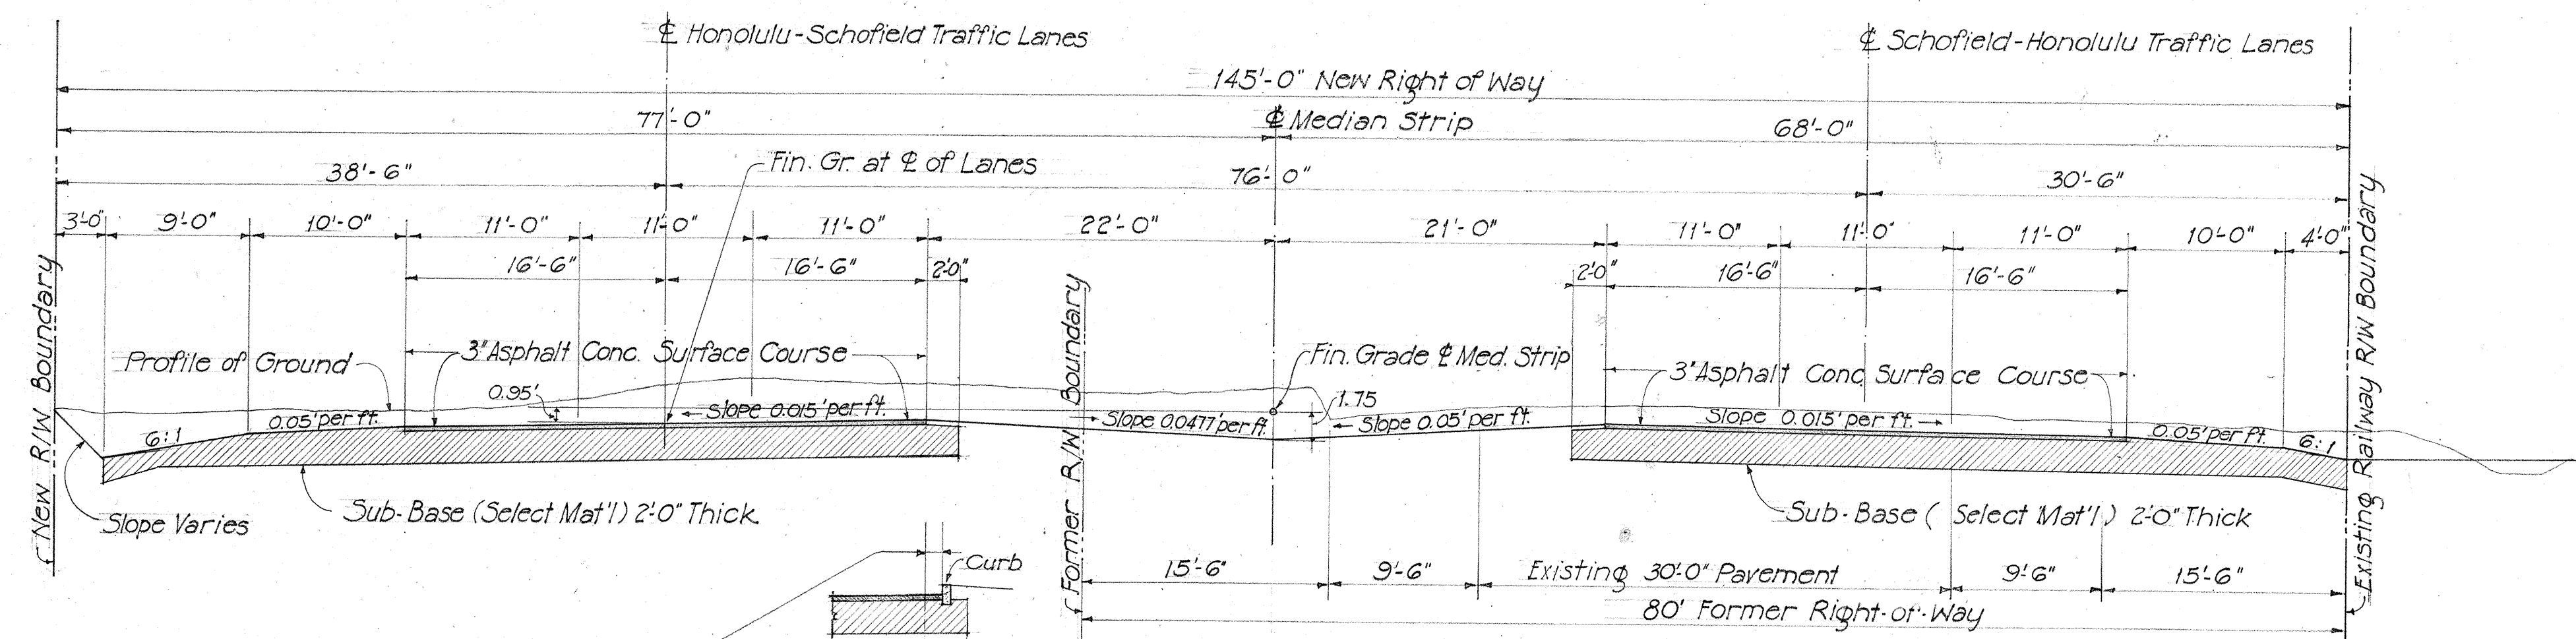


TYPICAL SECTION IN CUTS STA. 66+41.01 — STA. 144+67
Scale: $\frac{1}{8}" = 1'-0"$

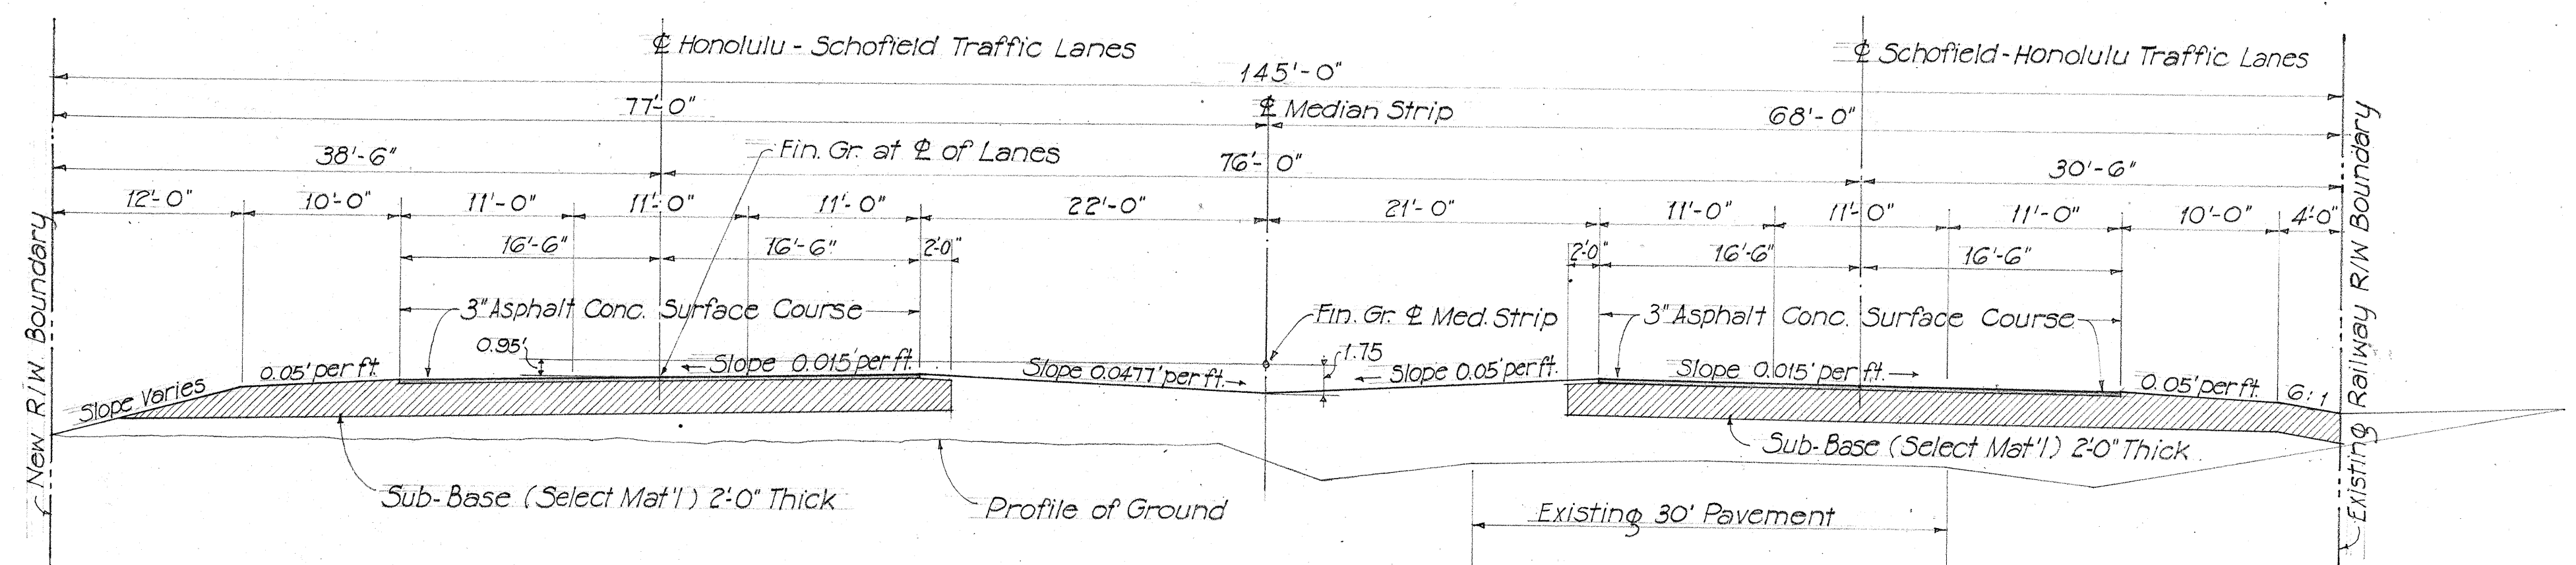


TYPICAL SECTION IN FILLS STA. 66+41.01 — STA. 144+67
Scale: $\frac{1}{8}" = 1'-0"$

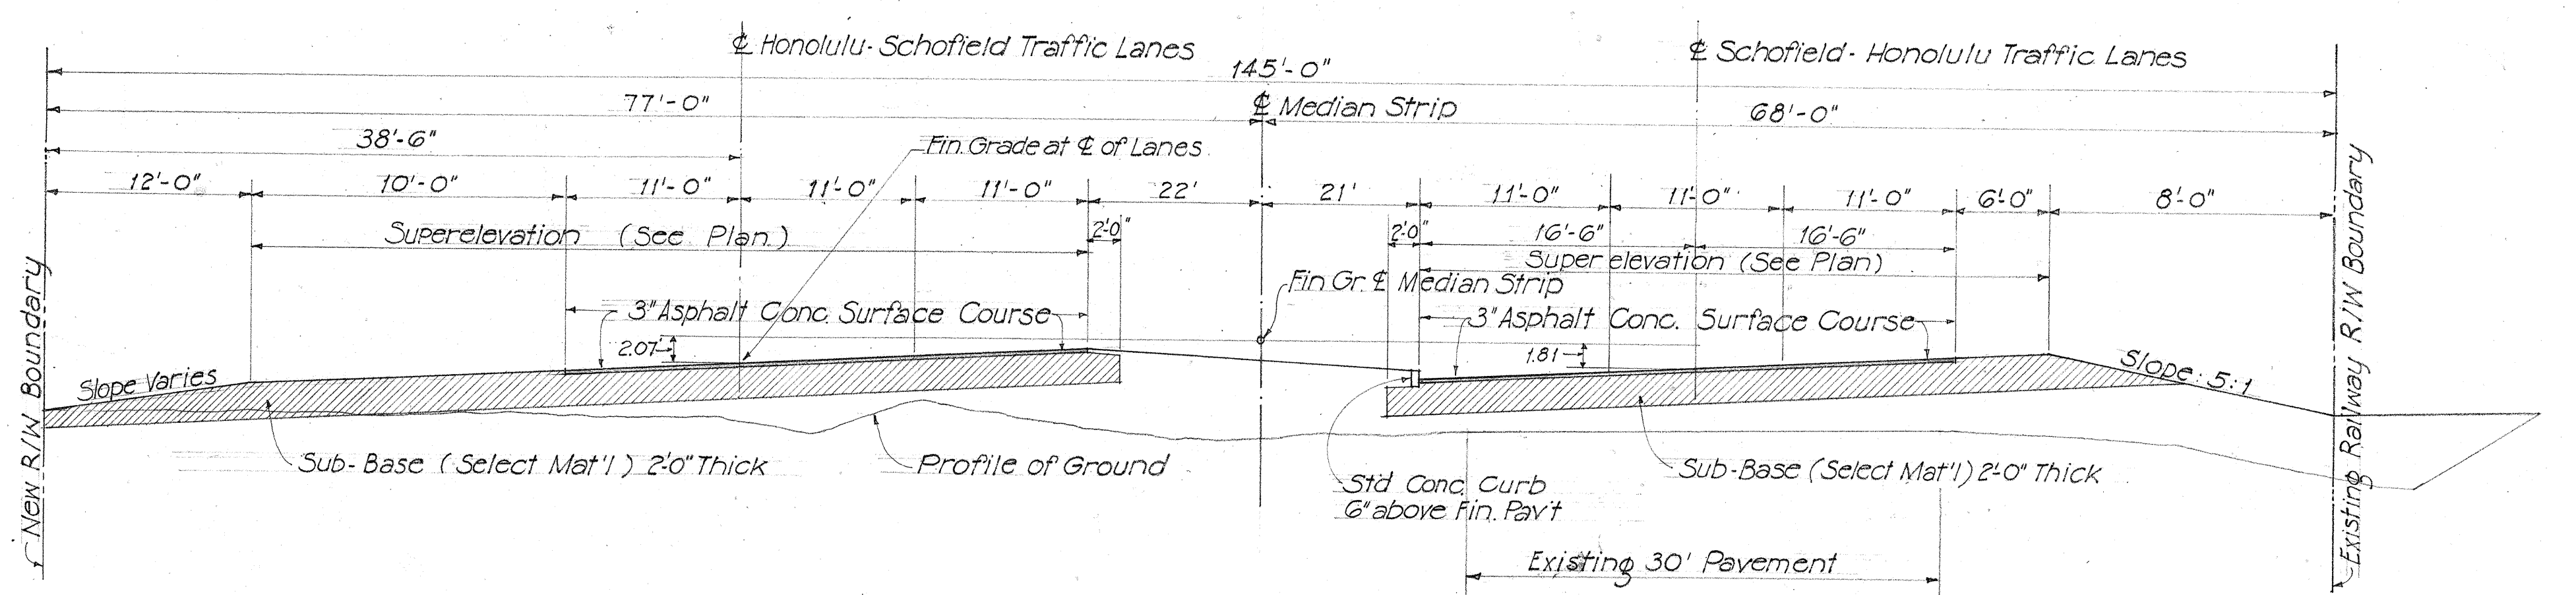

TYPICAL SECTION ON CURBS
Scale: $\frac{1}{8}" = 1'-0"$

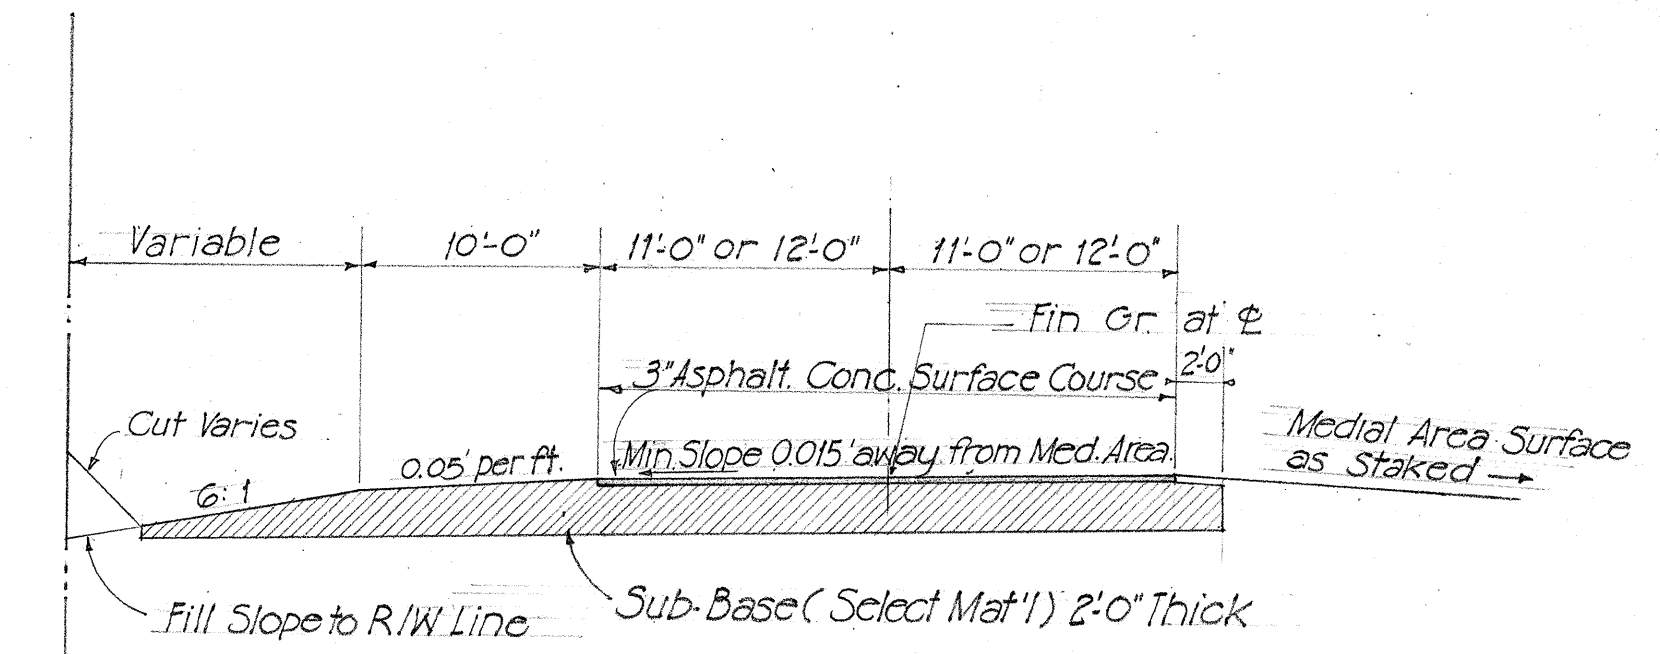

TYPICAL SECTION AT INTERSECTIONS STA. 34+45.27 — STA. 66+41.01
Scale: $\frac{1}{8}" = 1'-0"$

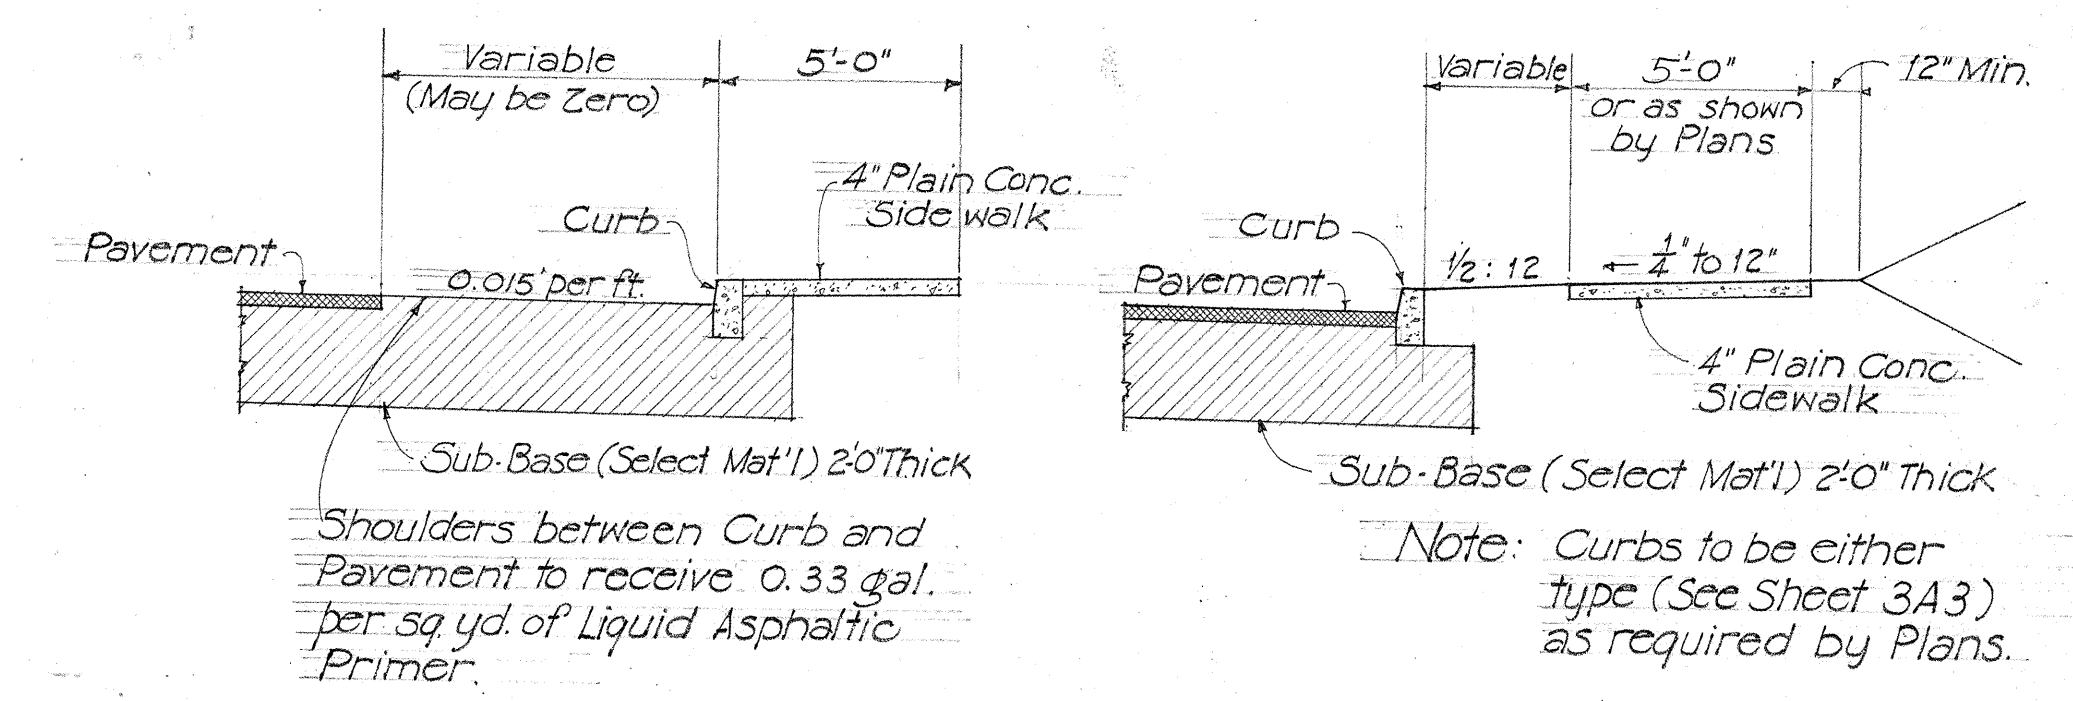

TYPICAL SECTIONS
SHOWING VARIABLE POSITIONS OF CURB AND SIDEWALK.
(SEE PLANS FOR VARIATIONS REQUIRED)
Scale: $\frac{1}{4}" = 1'-0"$

TERRITORIAL HIGHWAY DEPARTMENT
TERRITORY OF HAWAII
REVISED
TYPICAL SECTIONS FOR SN-FAP-9A(6)
KAMEHAMEHA HIGHWAY FROM THE
PEARL HARBOR INTERSECTION TO
PUULOLO ROAD
Scale: As Noted
March 1944

Revised: March 1944



DATE	DESIGNED BY	CHECKED BY
NOV 1943	W. H. HARRIS	W. H. HARRIS
NOV 1943	W. H. HARRIS	W. H. HARRIS
NOV 1943	W. H. HARRIS	W. H. HARRIS
NOV 1943	W. H. HARRIS	W. H. HARRIS

**DARK LINES INDICATE WORK
UNDER THIS CONTRACT**



**FAINT LINES DENOTE
FUTURE CONSTRUCTION**

FED. ROAD DIST. NO.	STATE	FED. AID PROJ. NO.	FISCAL YEAR	SHEET NO.	TOTAL SHEETS
HAWAII	HAW	SN-FAP 9-A(6)	1941	2 A	25



UNDER THIS CONTRACT

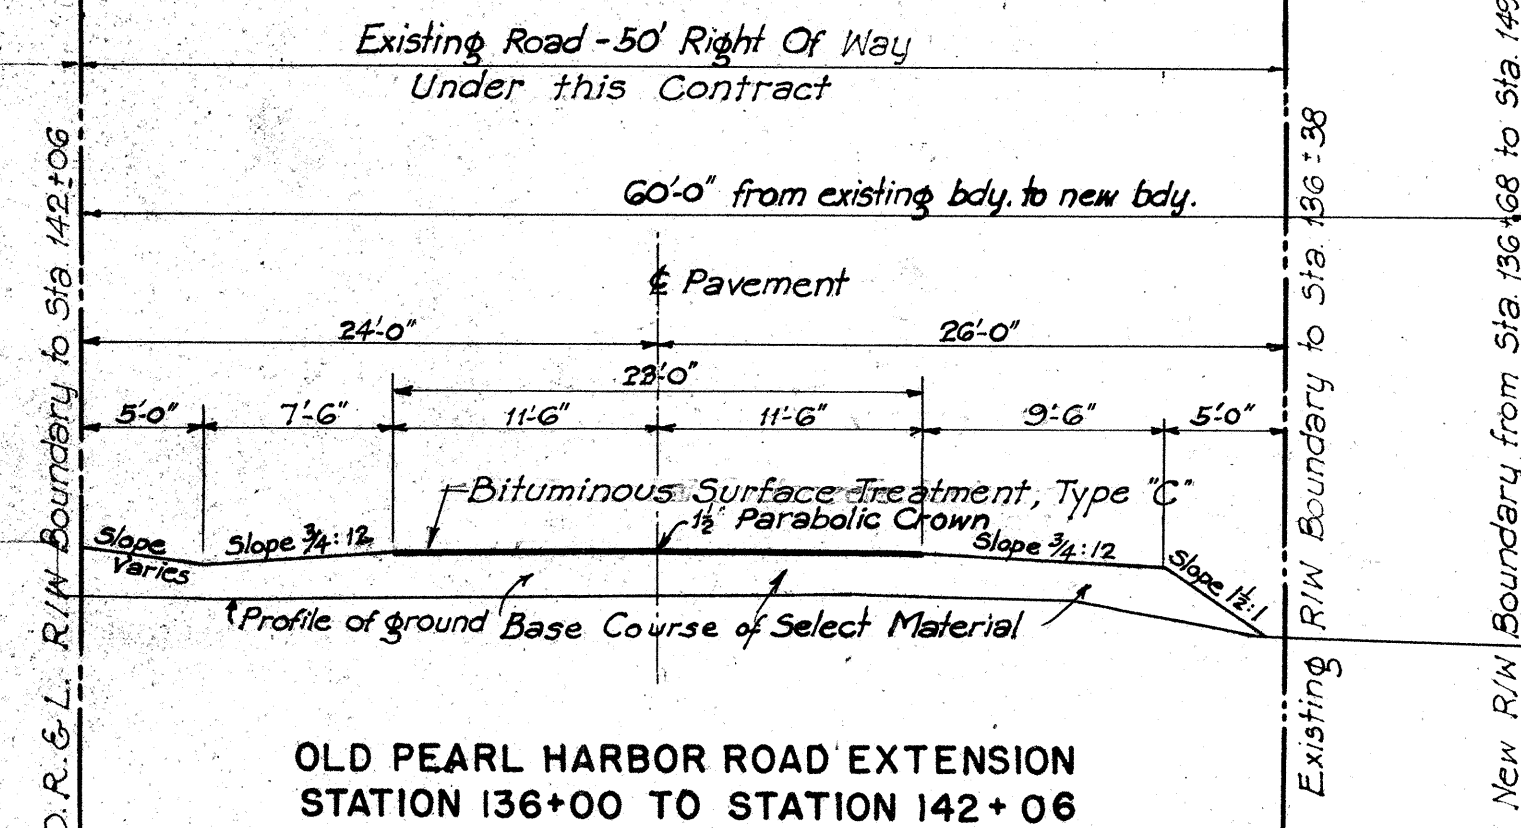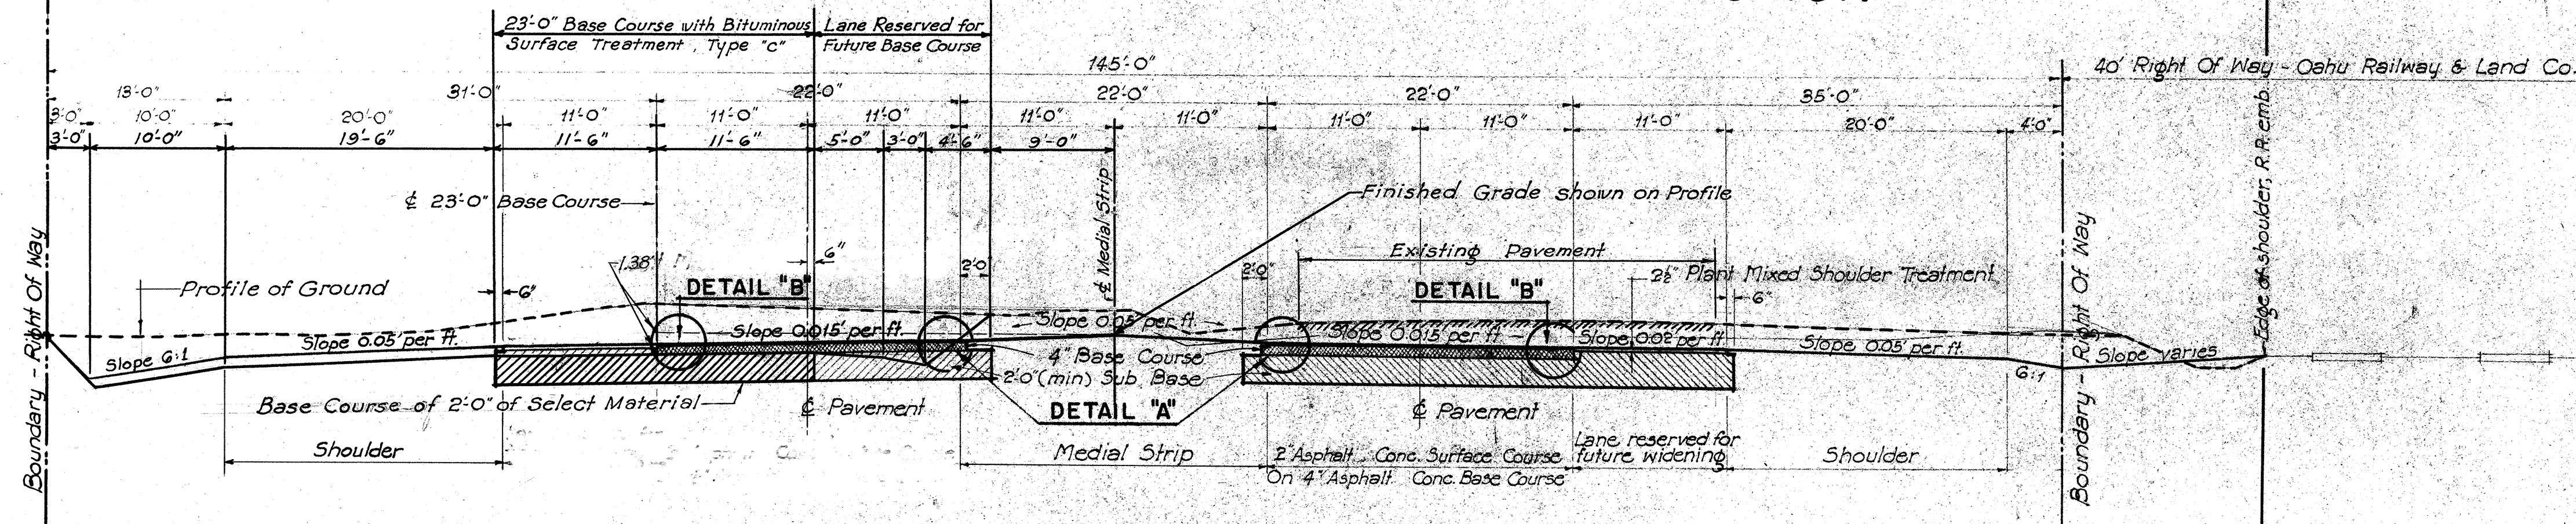



SECTION IN CUTS

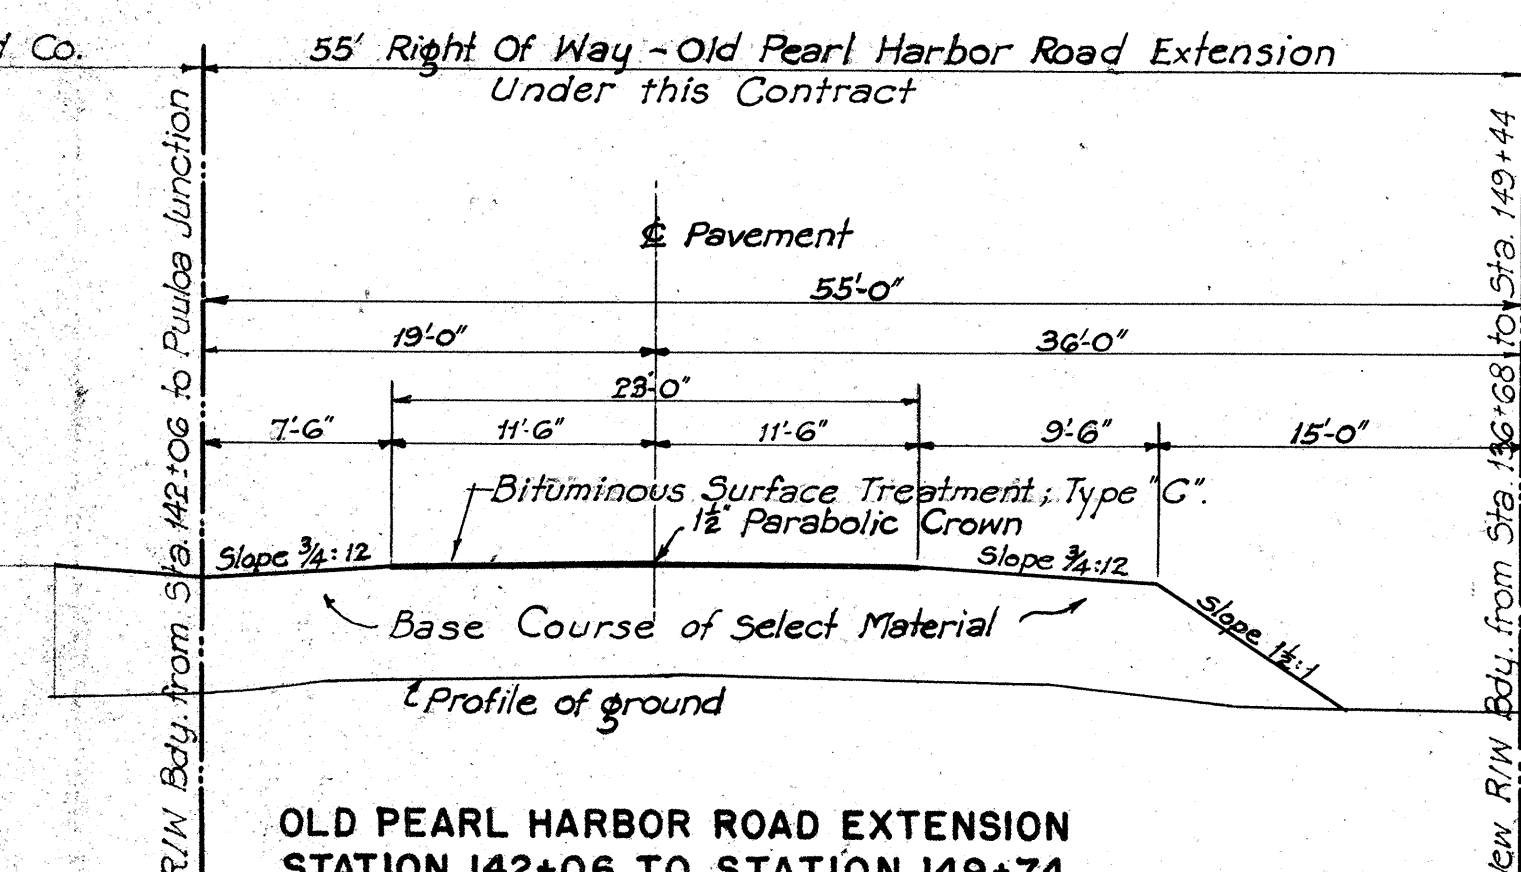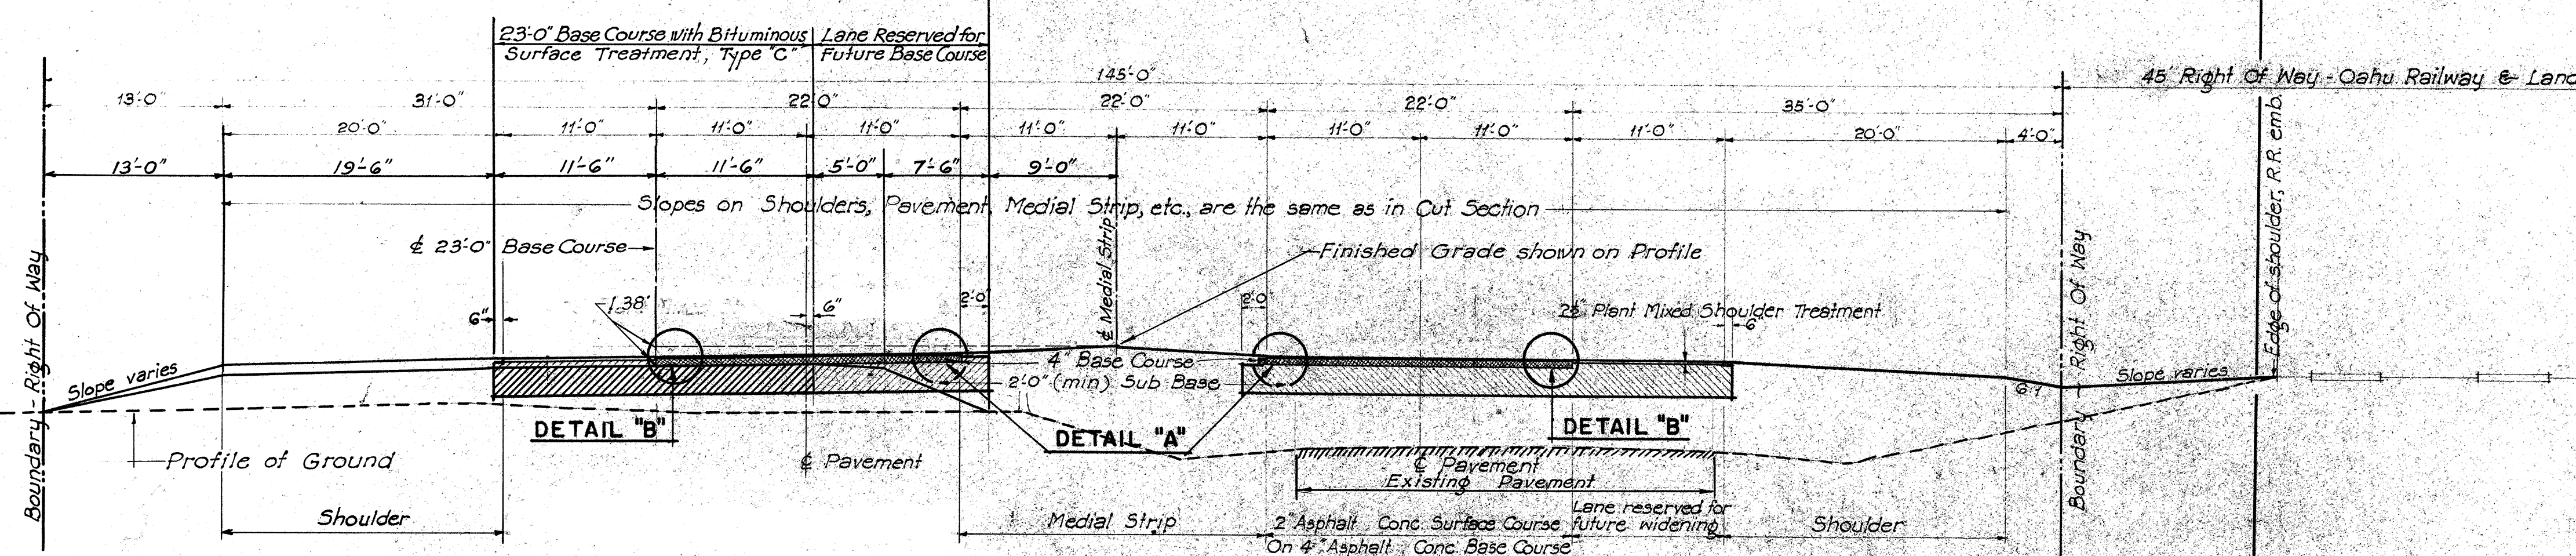

SECTION ON FILLS

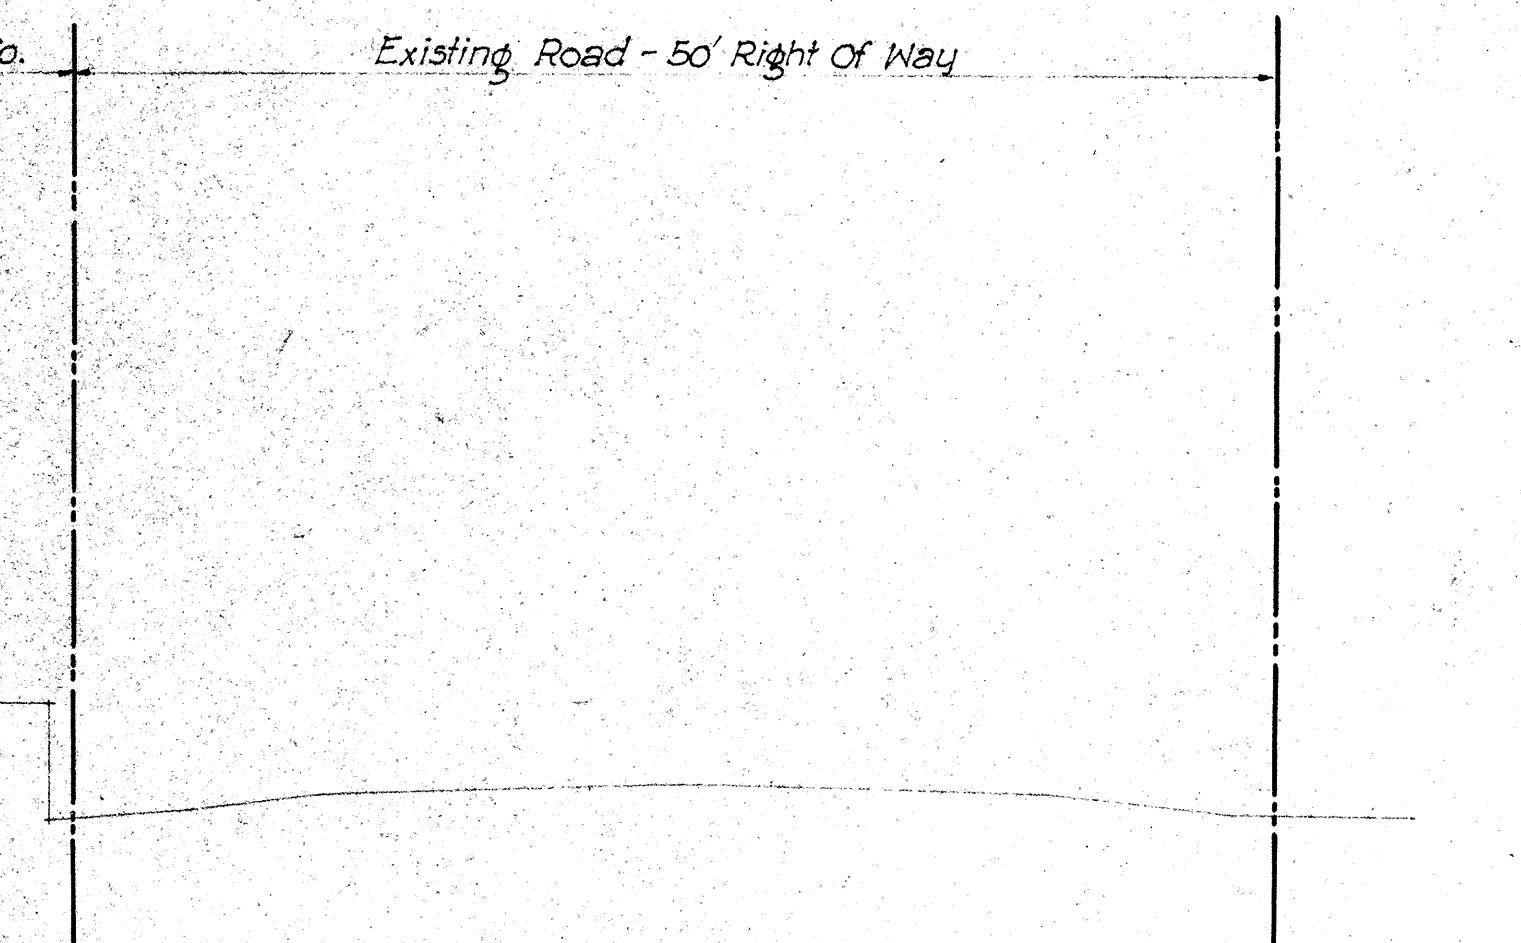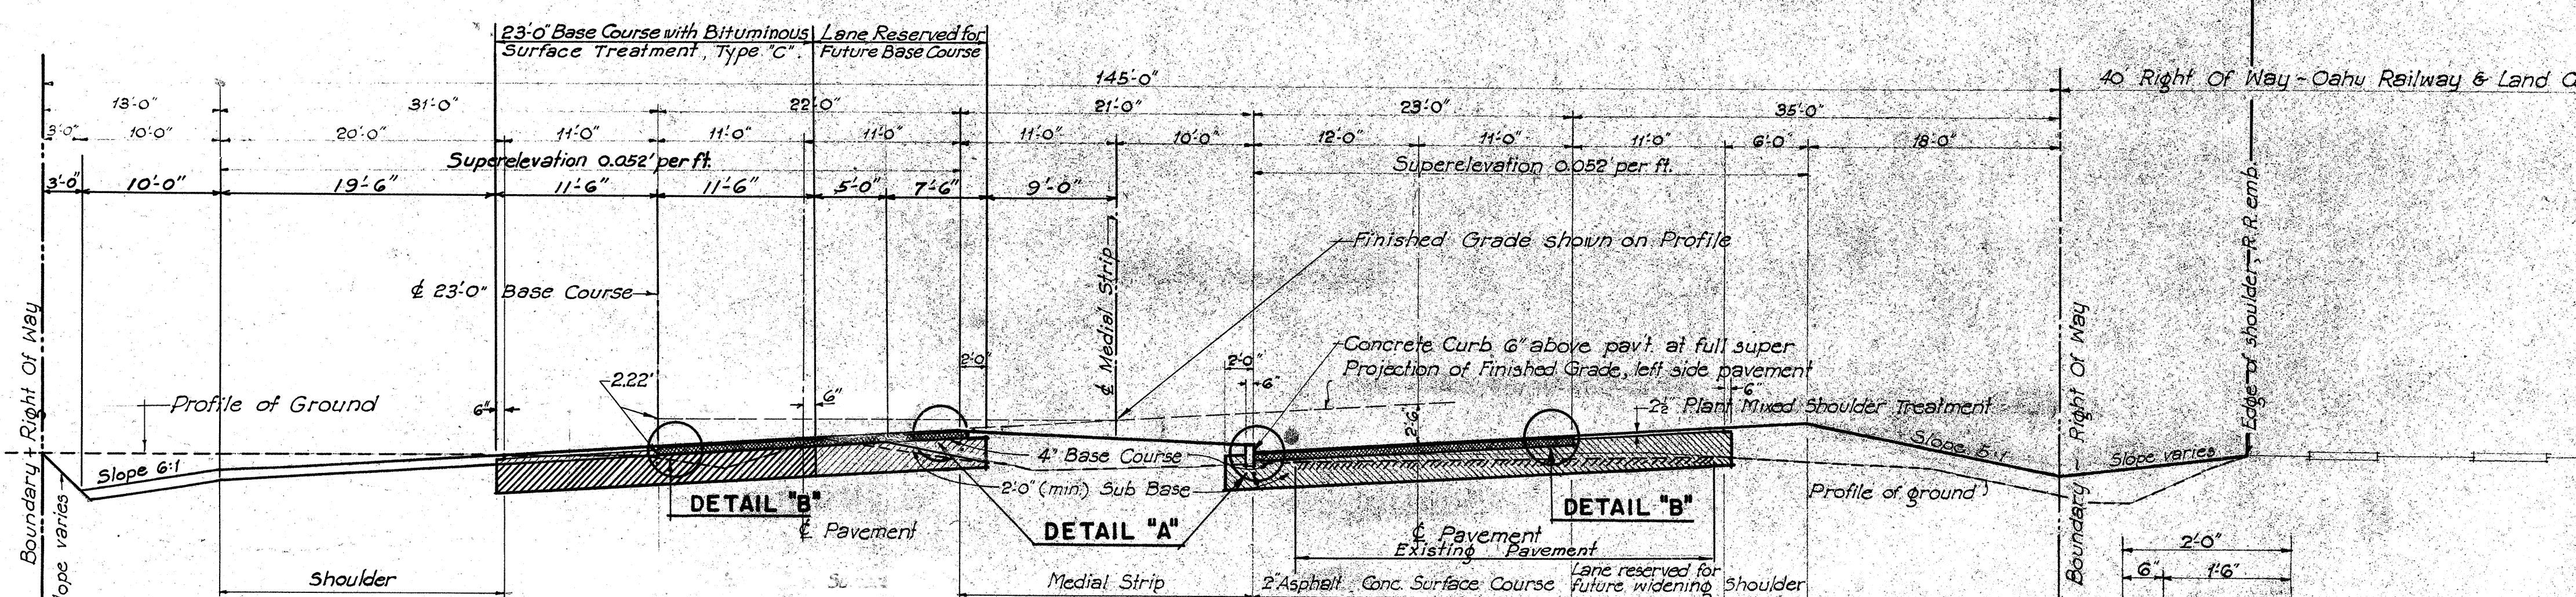

SECTION ON CURVE

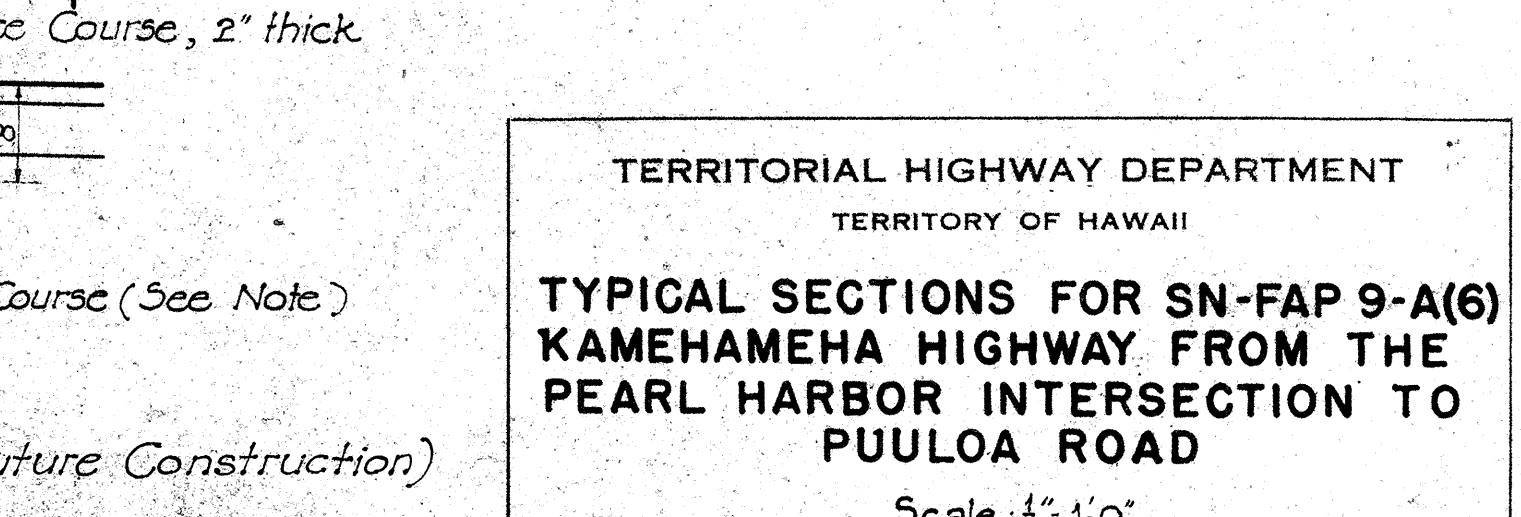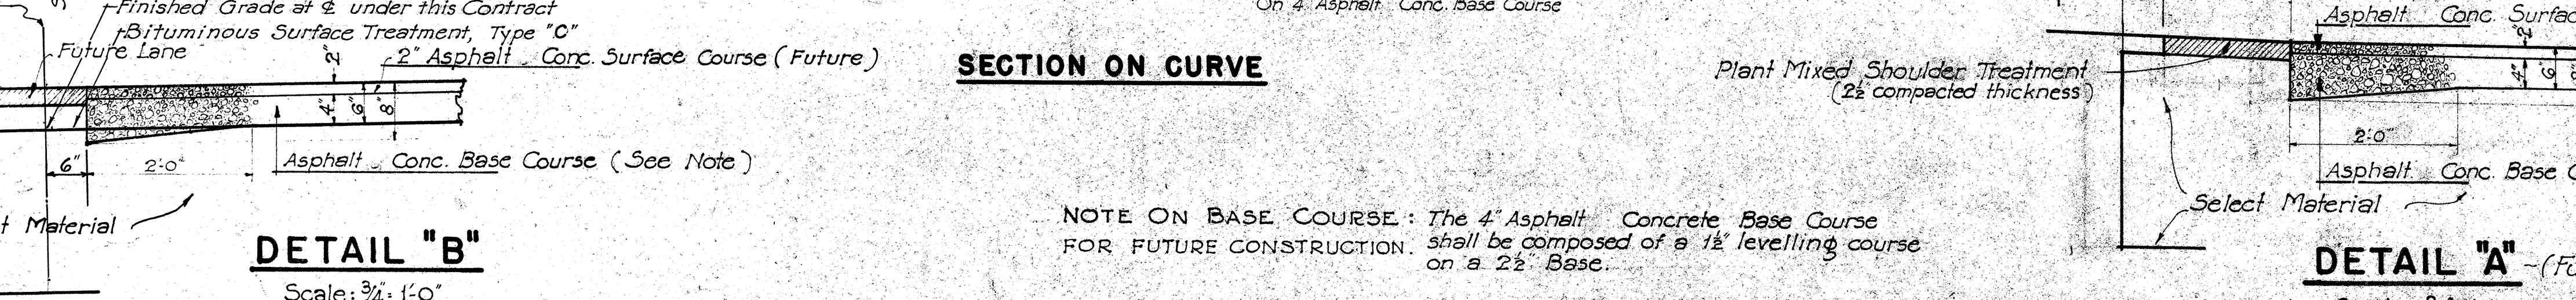

DETAIL "B"
Scale: 3/4" = 1'-0"

NOTE ON BASE COURSE: The 4" Asphalt Concrete Base Course FOR FUTURE CONSTRUCTION shall be composed of a 1 1/2" levelling course on a 2 1/2" Base.

DETAIL "A" (Future Construction)
Scale: 3/4" = 1'-0"

TERRITORIAL HIGHWAY DEPARTMENT
TERRITORY OF HAWAII
**TYPICAL SECTIONS FOR SN-FAP 9-A(6)
KAMEHAMEHA HIGHWAY FROM THE
PEARL HARBOR INTERSECTION TO
PUULO ROAD**
Scale: 3/4" = 1'-0"

SHEET NO. OF SHEETS

5091.2A

Revised July, 1942
VOID

DESIGNED BY	DATE
NOTED BY	10/41
CHECKED BY	