


| FED. ROAD DIST. NO. | STATE | FISCAL YEAR | SHEET NO. | TOTAL SHEETS |
|---------------------|-------|-------------|-----------|--------------|
| HAWAII              | HAW.  | 51 00       | 6         | 9            |

|                            |      |
|----------------------------|------|
| FINAL SURVEY NOTE BOOK NO. | DATE |
| BY                         |      |
| NO.                        |      |

|                               |      |
|-------------------------------|------|
| ORIGINAL SURVEY NOTE BOOK NO. | DATE |
| BY                            |      |
| NO.                           |      |

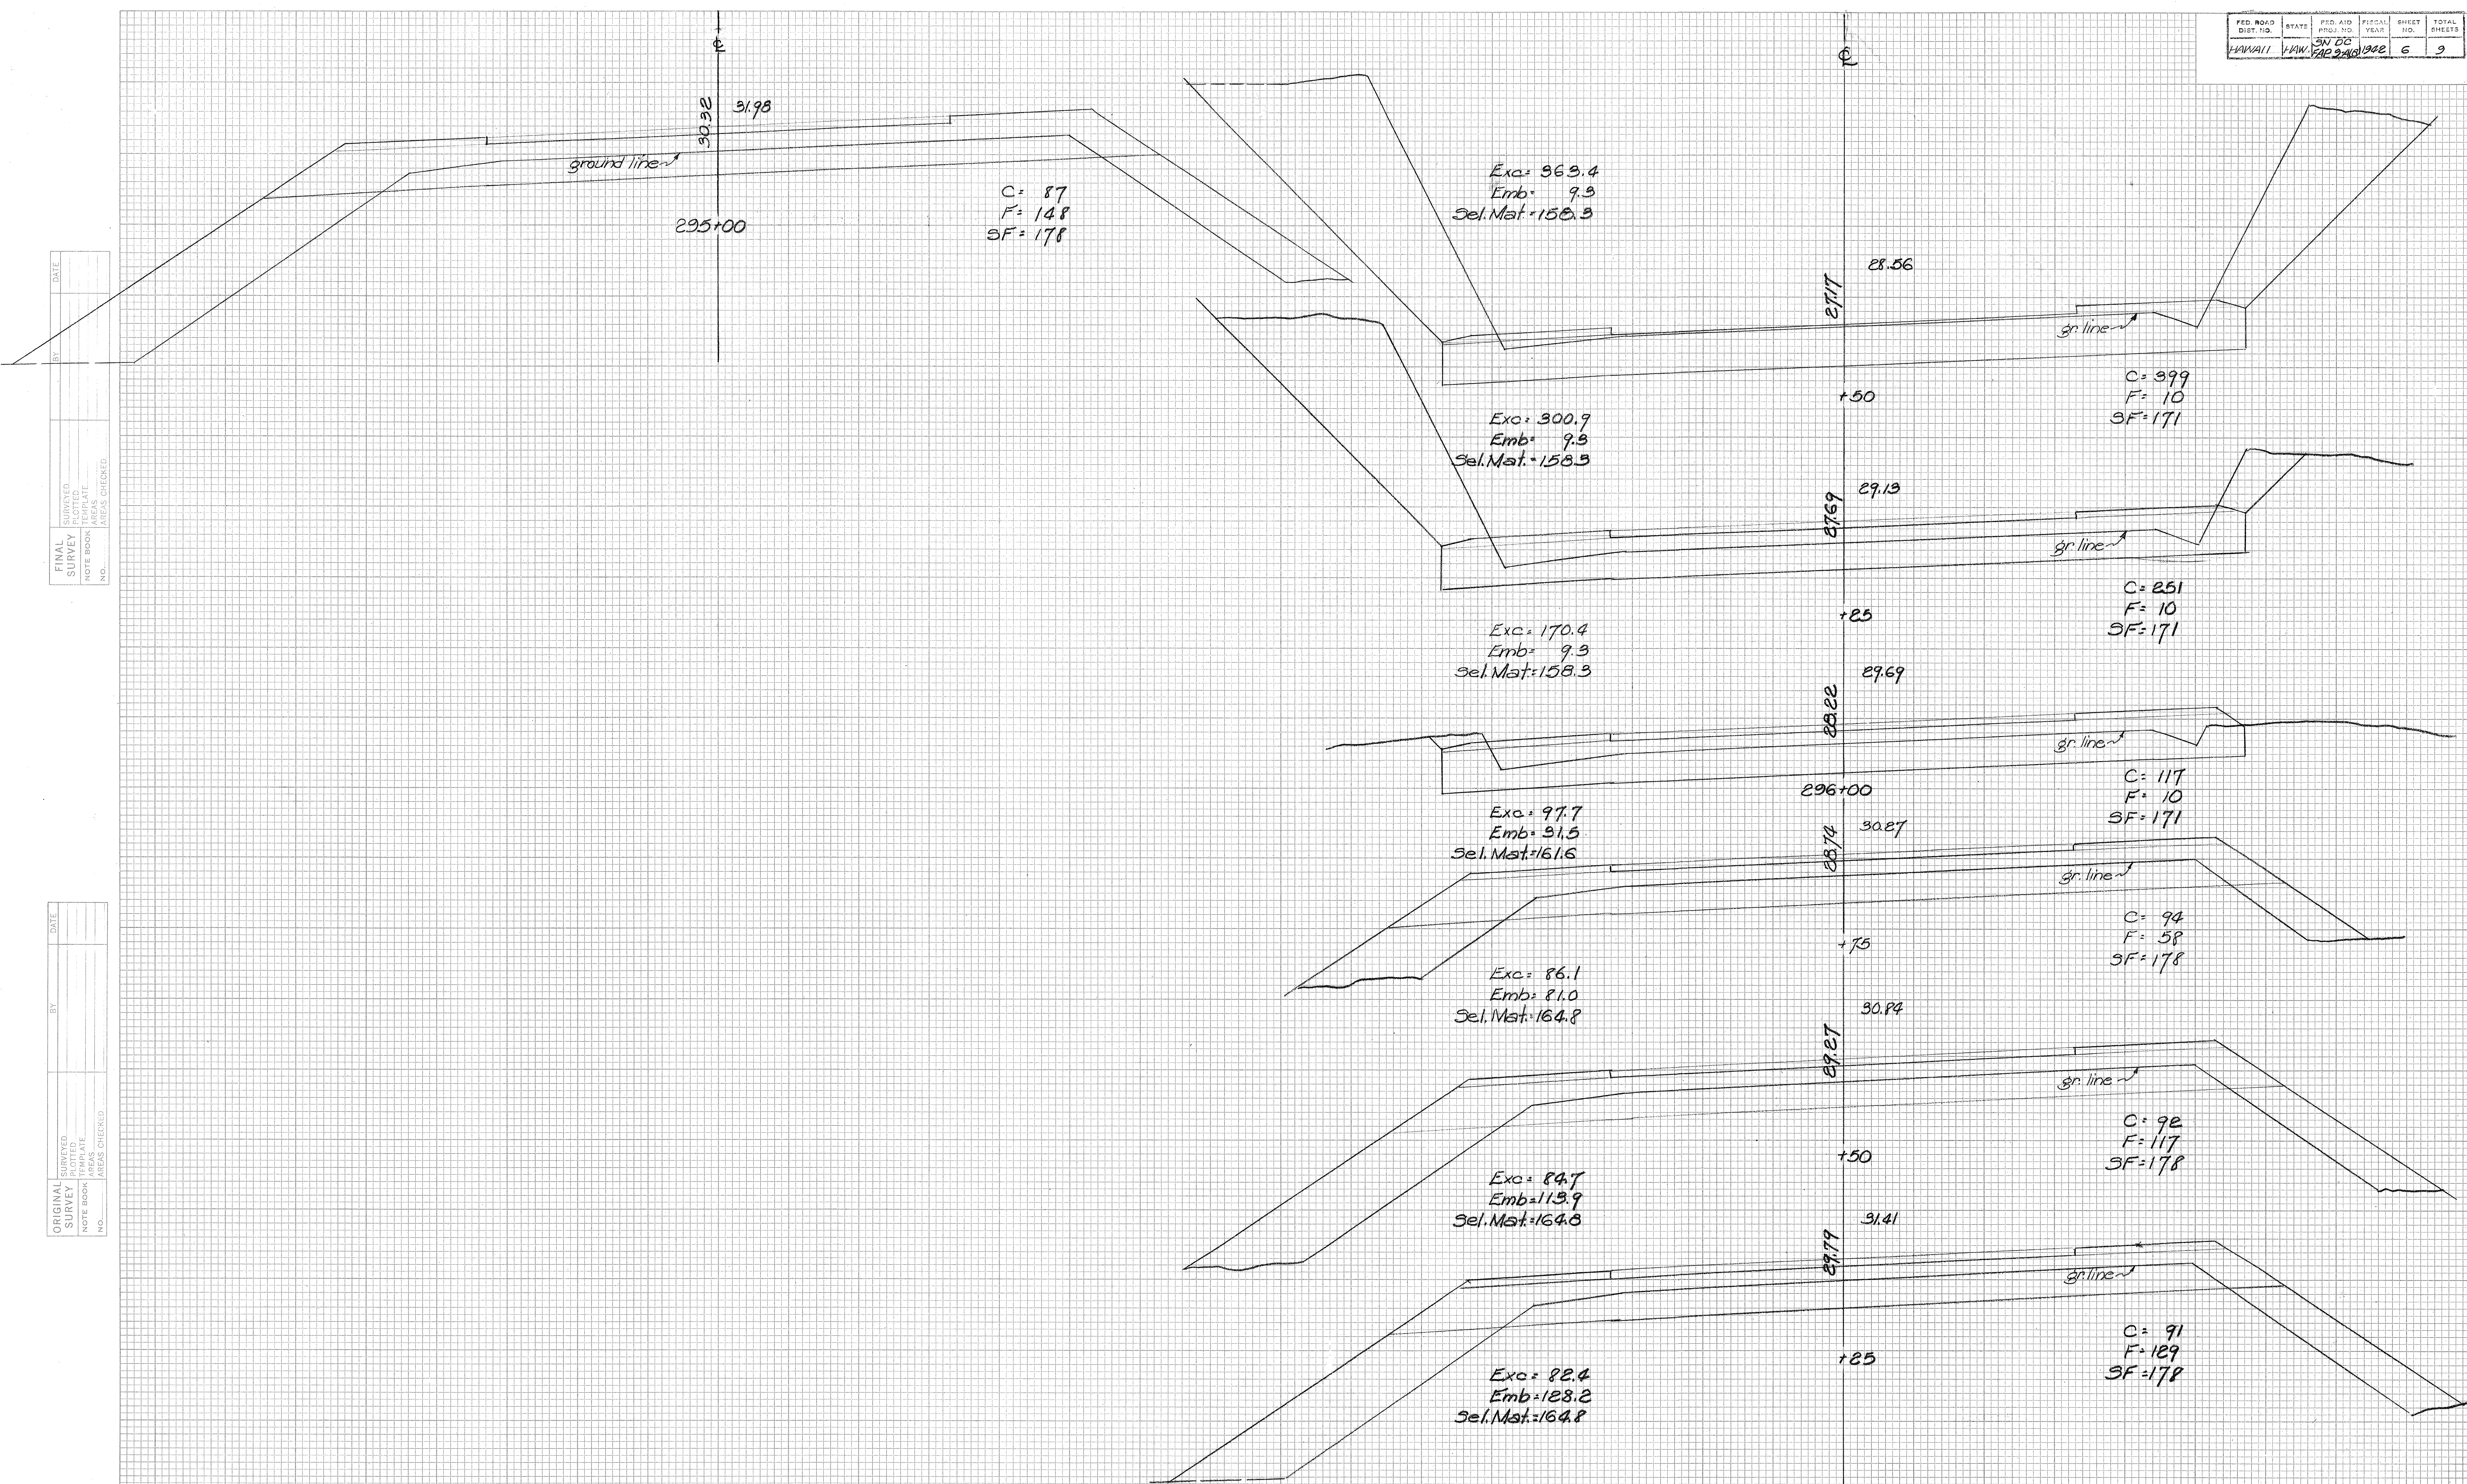

5116.6



| FED. ROAD DIST. NO. | STATE  | FED. AID PROJ. NO. | FISCAL YEAR | SHEET NO. | TOTAL SHEETS |
|---------------------|--------|--------------------|-------------|-----------|--------------|
| HAWAII              | HAWAII | SN 02              | FY 2010     | 7         | 9            |

Exc: 724.8  
Emb: 9.3  
Sel. Mat: 188.2

Exc: 617.1  
Emb: 9.3  
Sel. Mat: 177.8

Exc: 514.8  
Emb: 9.3  
Sel. Mat: 169.9

Exc: 435.2  
Emb: 9.3  
Sel. Mat: 162.0

Exc: 377.8  
Emb: 9.3  
Sel. Mat: 158.3

C: 731  
F: 10  
SF: 196

C: 602  
F: 10  
SF: 188

C: 510  
F: 10  
SF: 179

C: 430  
F: 10  
SF: 171

C: 386  
F: 10  
SF: 171

Exc: 843.5  
Emb: 9.3  
Sel. Mat: 188.9

Exc: 813.0  
Emb: 9.3  
Sel. Mat: 188.9

Exc: 762.2  
Emb: 9.3  
Sel. Mat: 188.9

Exc: 777.8  
Emb: 9.3  
Sel. Mat: 188.9

C: 905  
F: 10  
SF: 204

C: 851  
F: 10  
SF: 204

C: 841  
F: 10  
SF: 204

C: 839  
F: 10  
SF: 204



Exc: 826.9  
Emb: 9.3  
Sel. Mat: 188.9

Exc: 849.1  
Emb: 9.3  
Sel. Mat: 188.9

Exc: 855.1  
Emb: 9.3  
Sel. Mat: 188.9

Exc: 855.1  
Emb: 9.3  
Sel. Mat: 188.9

Exc: 824.6  
Emb: 9.3  
Sel. Mat: 188.9

1983 20.57

300+00

20.35 21.14

+75

2088 21.71

+50

2140 22.28

+25

2103 22.35

239+00

C-905  
F: 10  
SF: 204

C-929  
F: 10  
SF: 204

C-913  
F: 10  
SF: 204

C-929  
F: 10  
SF: 204

C-917  
F: 10  
SF: 204

Exc: 566.6  
Emb: 9.3  
Sel. Mat: 156.7

Exc: 788.9  
Emb: 9.3  
Sel. Mat: 188.9

Exc: 845.8  
Emb: 9.3  
Sel. Mat: 188.9

Exc: 873.1  
Emb: 9.3  
Sel. Mat: 188.9

1773 18.29

301+00

18.25 18.86

+75

18.78 19.43

+50

19.30 20.00

+25

C-827  
F: 10  
SF: 204

C-877  
F: 10  
SF: 204

C-940  
F: 10  
SF: 204

C-946  
F: 10  
SF: 204



|               |      |
|---------------|------|
| FINAL SURVEY  | DATE |
| SURVEYED      | BY   |
| PLOTTED       | BY   |
| NOTE BOOK     | NO.  |
| AREAS CHECKED |      |

|                 |      |
|-----------------|------|
| ORIGINAL SURVEY | DATE |
| SURVEYED        | BY   |
| PLOTTED         | BY   |
| NOTE BOOK       | NO.  |
| AREAS CHECKED   |      |

