

INDEX TO DRAWINGS	
SHEET NO.	DESCRIPTIONS
1	Title Sheet
2	Typical Sections
3	Plan & Profile
4-5	Standard Details
6-9	Cross Sections

FED. ROAD DIST. NO.	STATE	FED. AID PROJ. NO.	FISCAL YEAR	SHEET NO.	TOTAL SHEETS
HAWAII	HAW.	SN DC FAP 9-A(8)	1942	1	9


TERRITORY OF HAWAII
TERRITORIAL HIGHWAY DEPARTMENT
HONOLULU T.H.
PLANS OF
KAMEHAMEHA HIGHWAY
FEDERAL AID PROJECT NO. SN DC FAP 9-A(8)

EWA DISTRICT
ISLAND OF OAHU


SCALES

PLAN	1 INCH = 100 FT.
PROFILE	HOR. 1 INCH = 100 "
	VER. 1 INCH = 10 "
GROSS SECT.	HOR. 1 INCH = 5 "
	VER. 1 INCH = 5 "

CONVENTIONAL	SIGNS
Existing Road	---
Existing Fence	-x-x-
Boundary Line	---
Center Line	---
Paved Approaches, etc.	---
Culverts	I
Bridges	---
Railroad	+

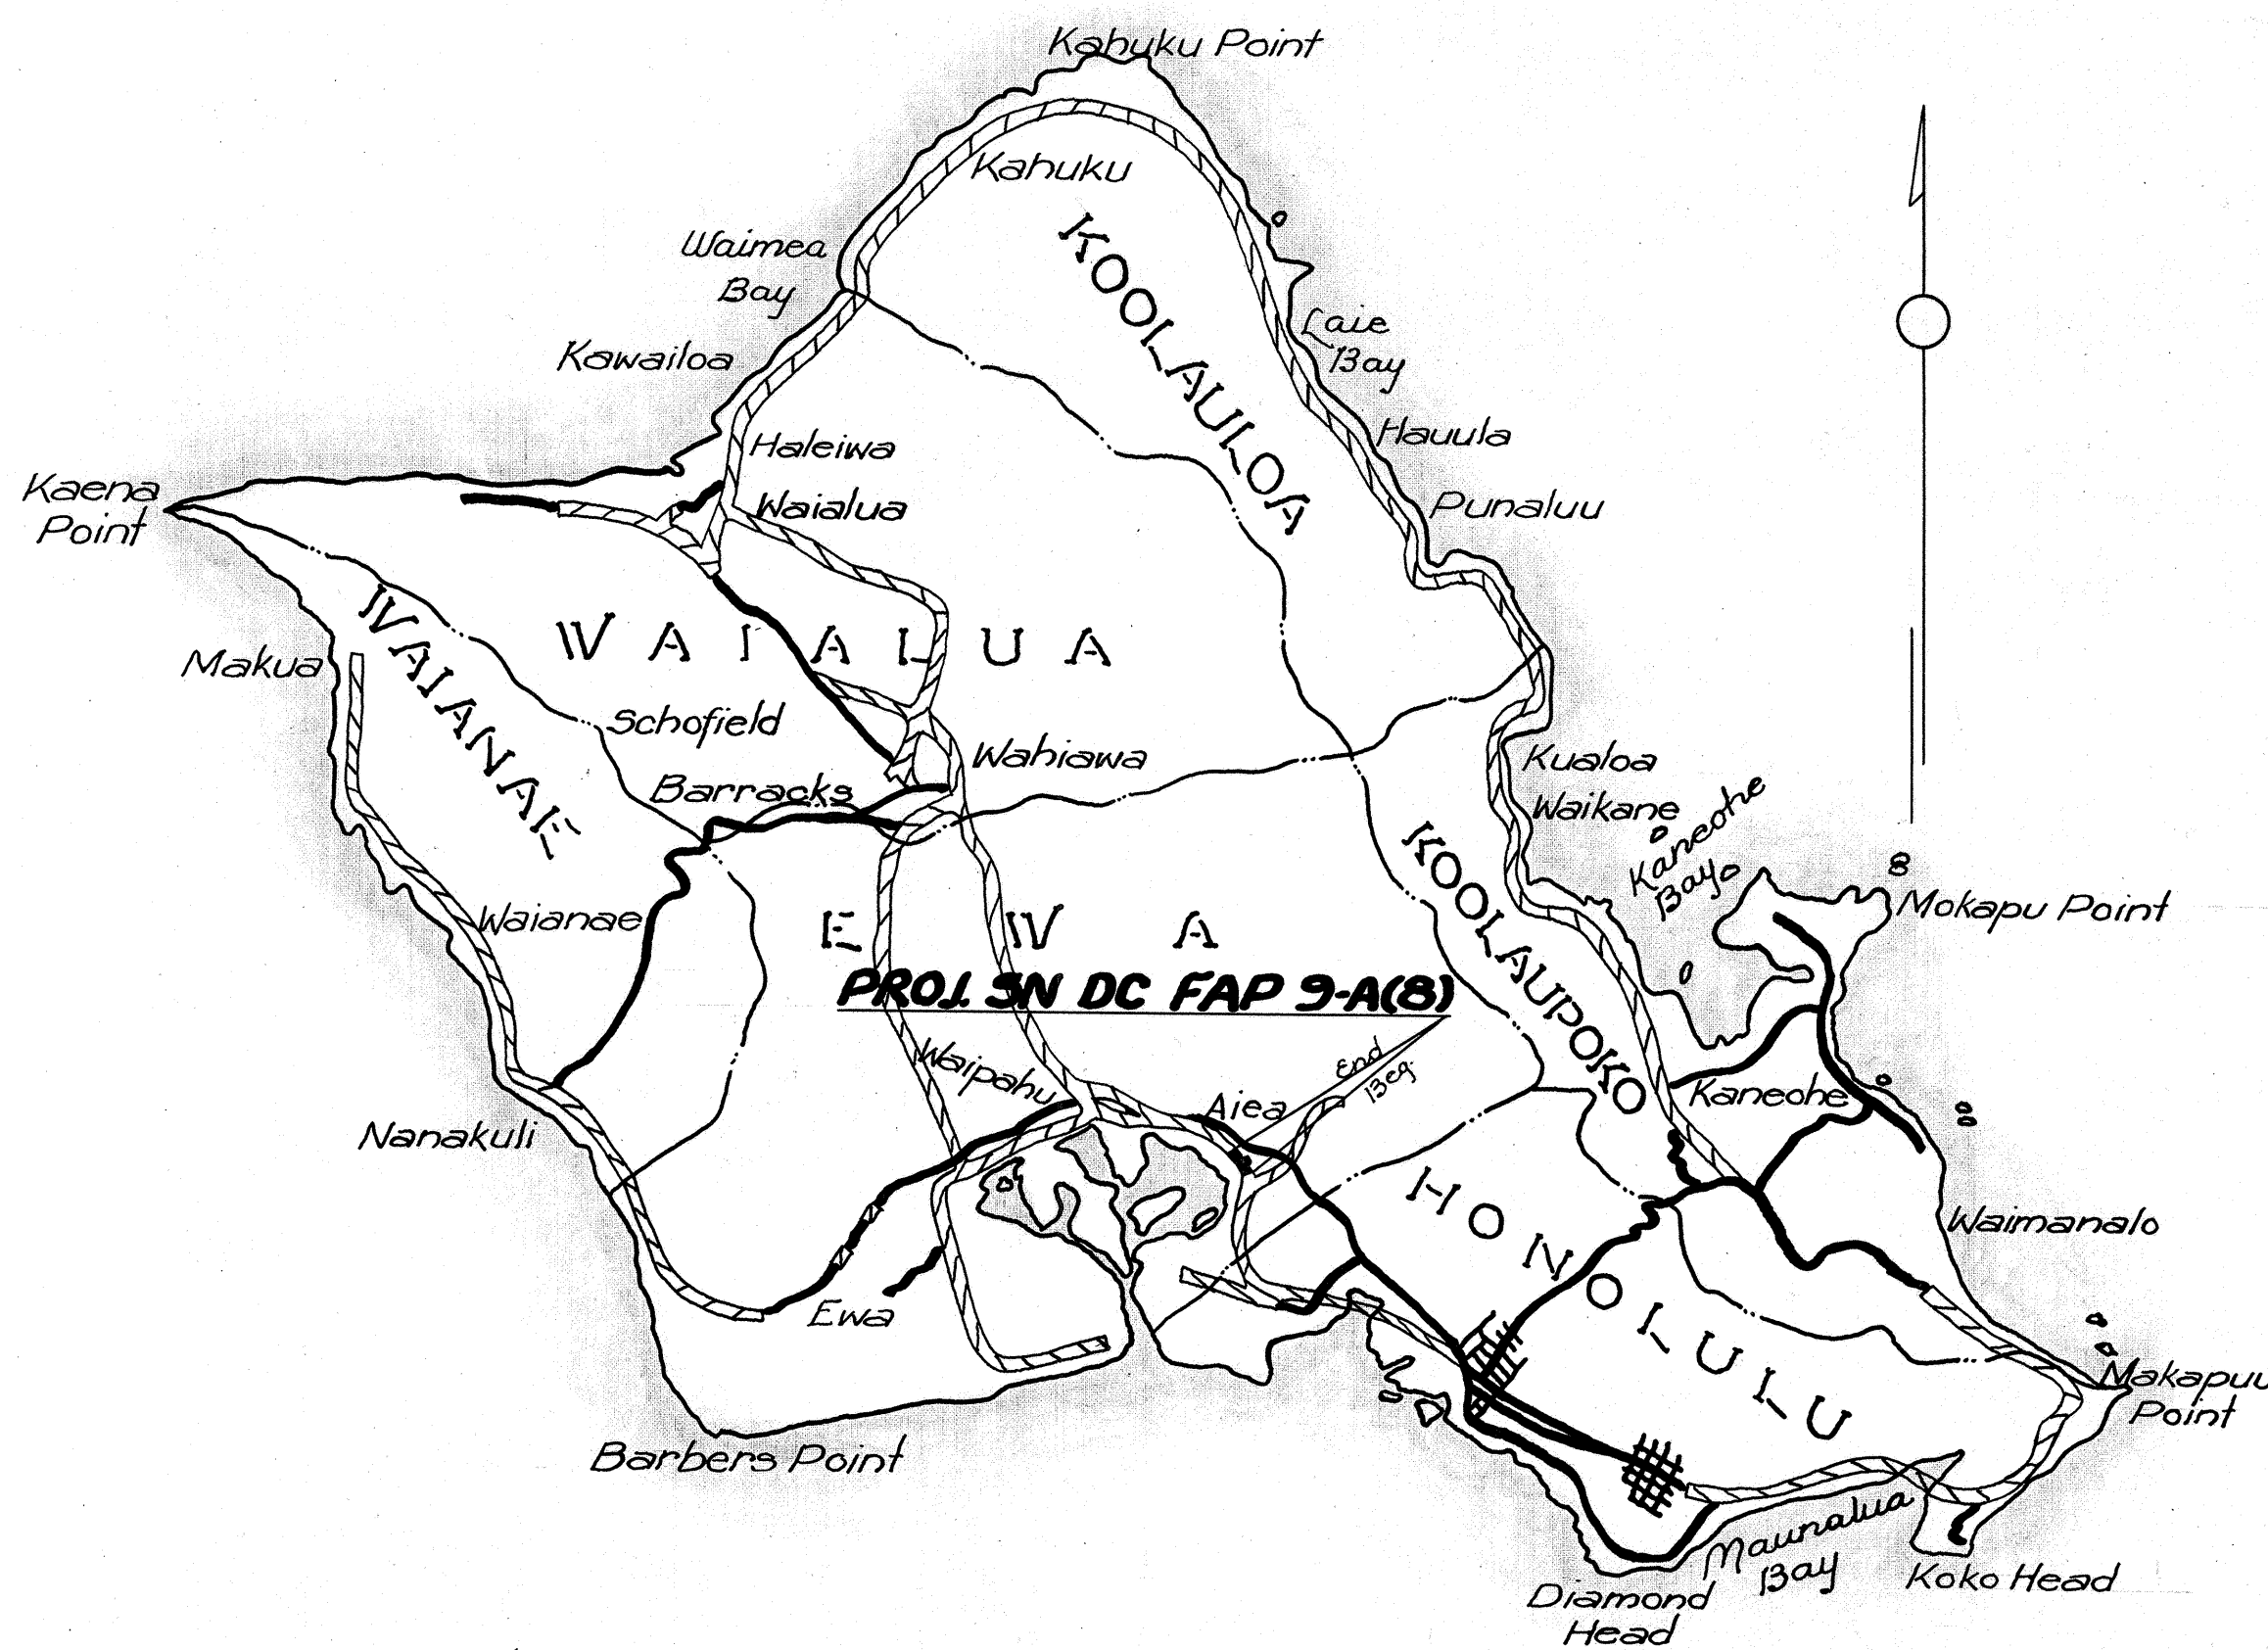

Federal Aid Projects previously constructed
or under construction.

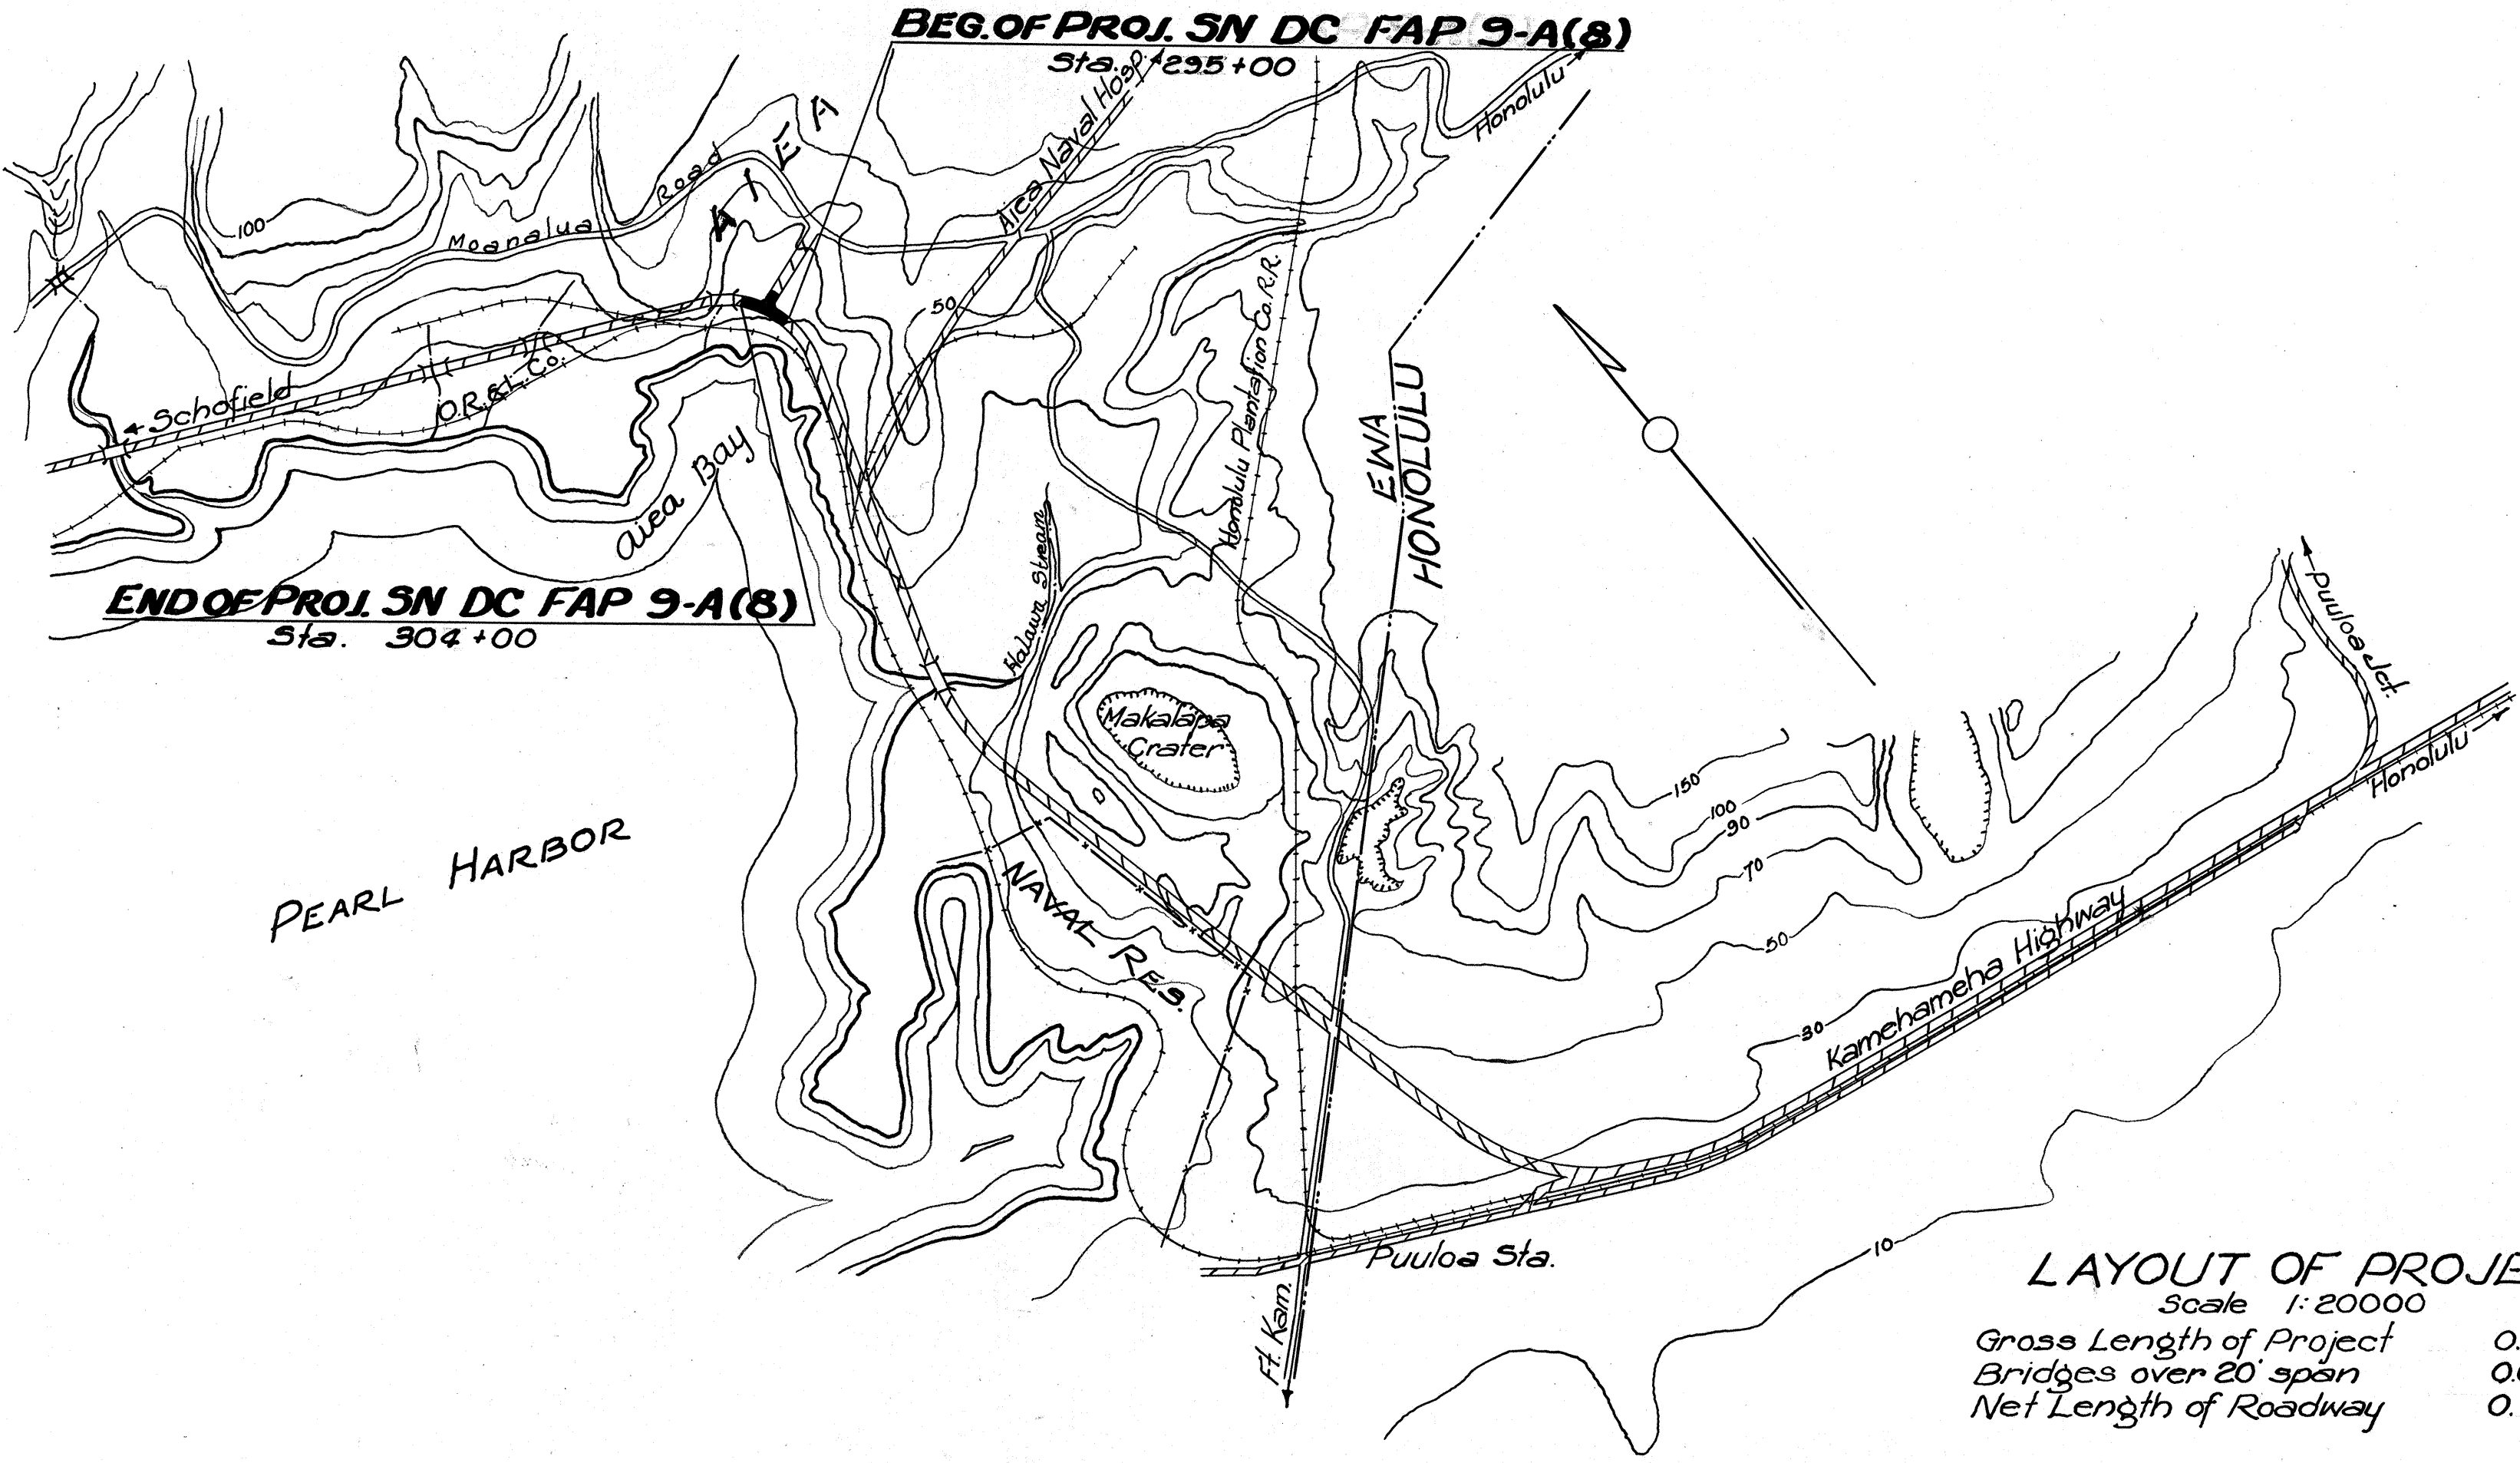

LAYOUT OF PROJECT
Scale 1:20000
Gross Length of Project 0.170 Miles
Bridges over 20' span 0.000 Miles
Net Length of Roadway 0.170 Miles

SURVEY PLOTTED BY	DATE
DESIGNED BY	
TRACED BY	
QUANTITIES BY	
CHECKED BY	
ORIGINAL PLAN	
NOTE BOOK	

RECOMMENDED FOR APPROVAL
[Signature]
Prin. Hway Engr: Public Roads Administration, Federal Wks. Agency

RECOMMENDED FOR APPROVAL
[Signature]
Chief Western Region: Public Roads Administration, Federal Wks. Agency

APPROVED
[Signature]
Territorial Highway Engineer

APPROVED
[Signature]
Commissioner: Public Roads Administration, Federal Wks. Agency