
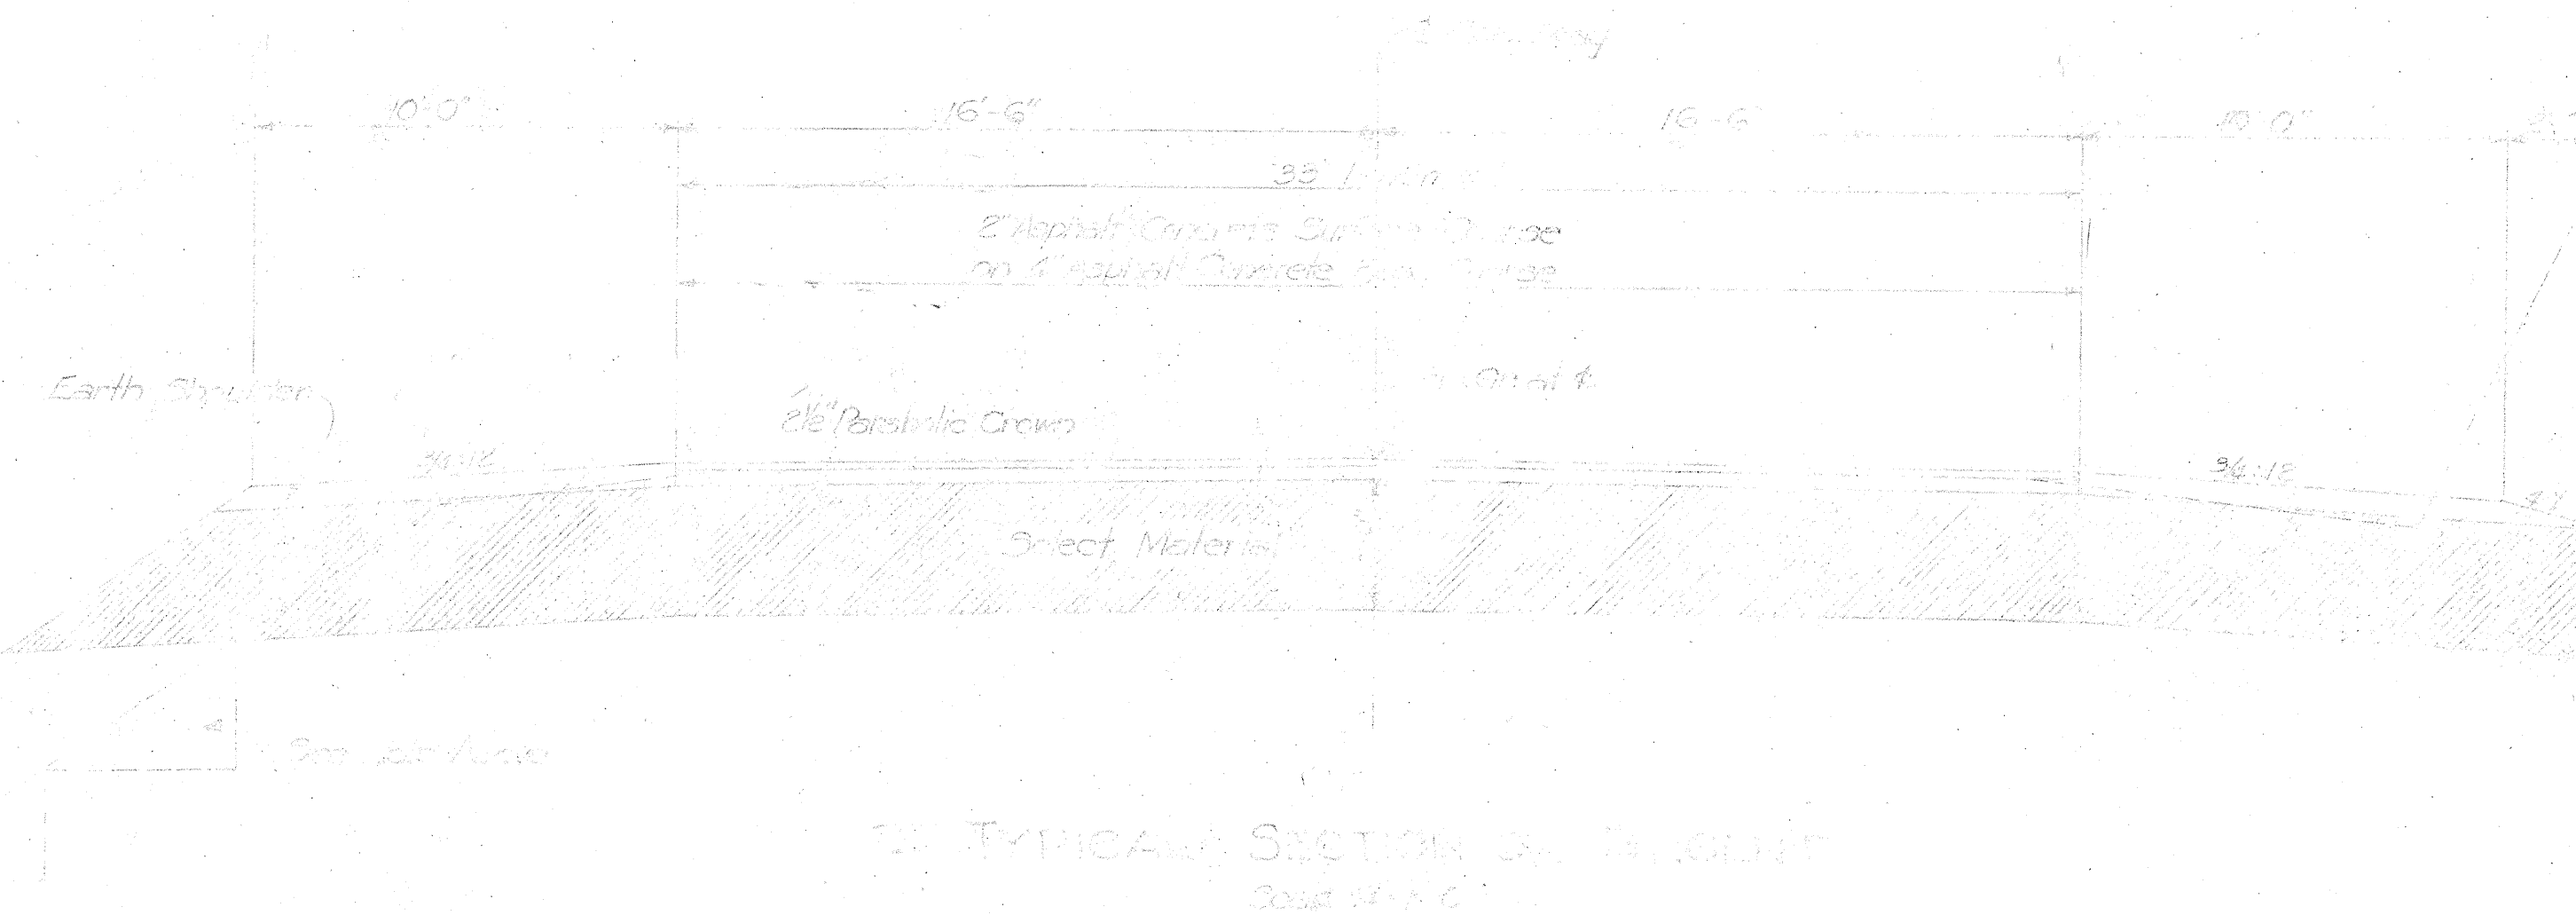


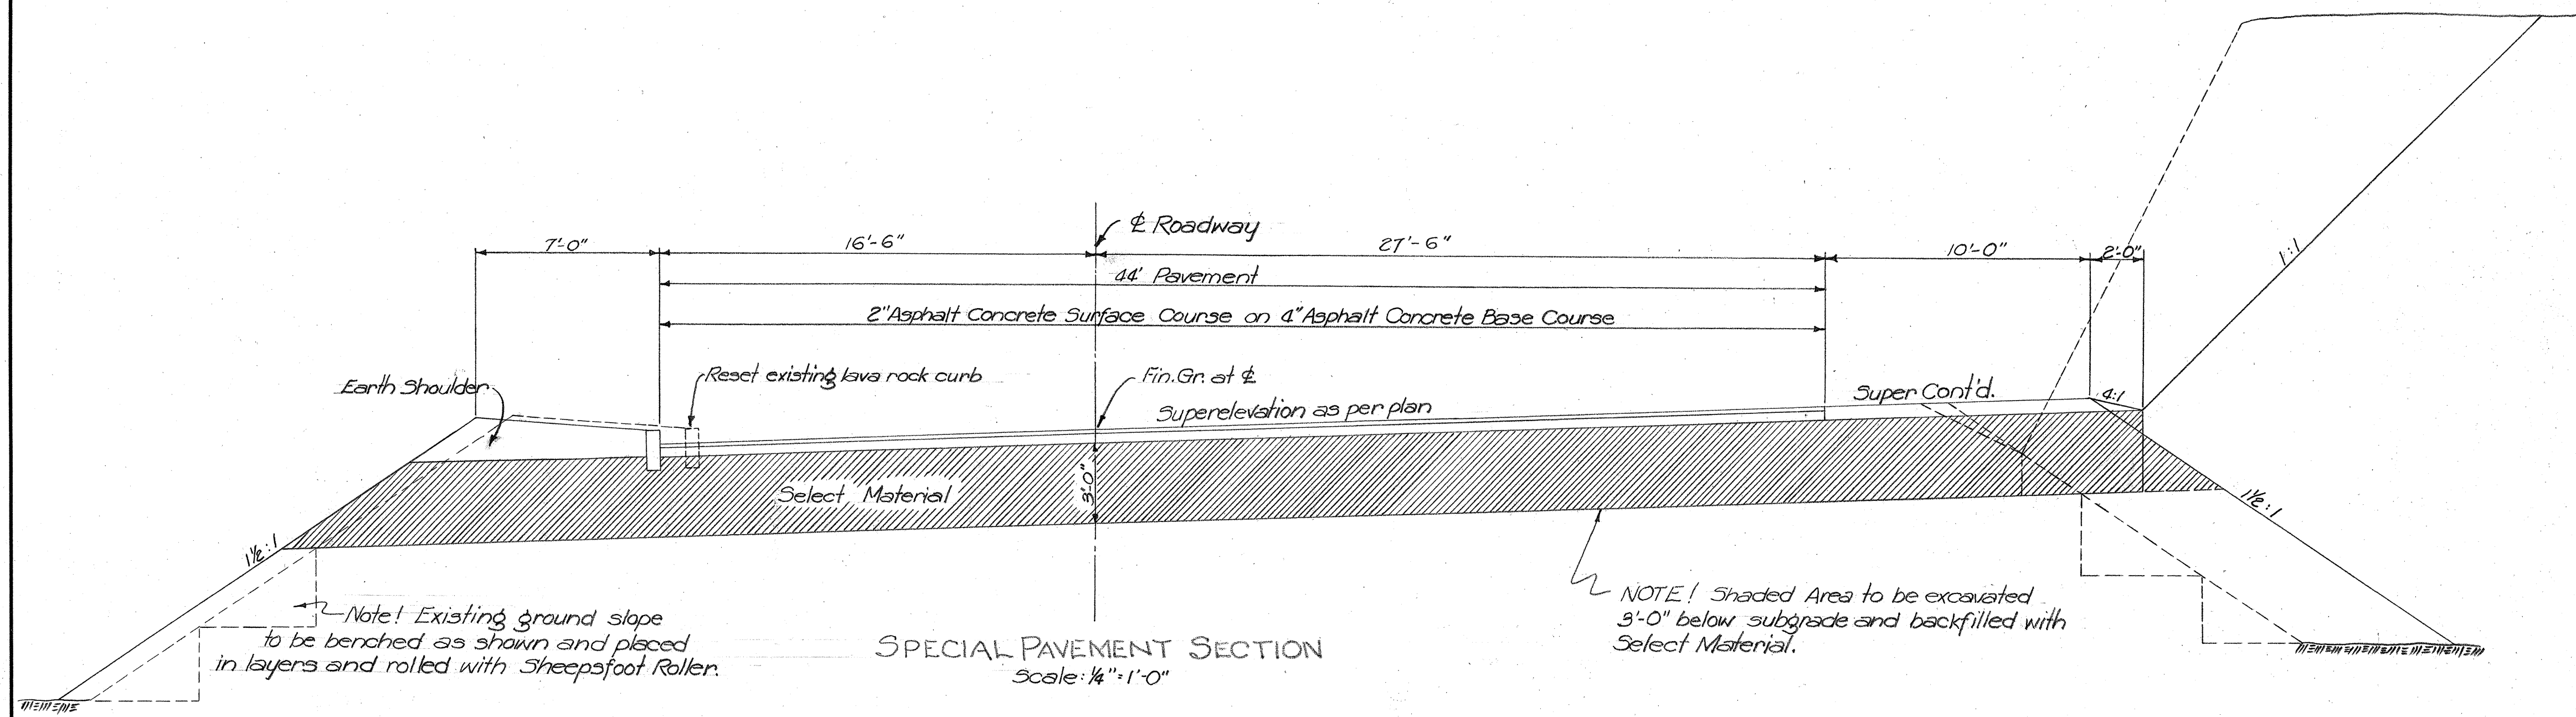

NOTE ON BASE COURSE: The 4" Asphalt Concrete Base Course shall be composed of a 1 1/2" levelling course on a 2 1/2" Base.