



PROFILE	BY	DATE
CONVEYED		
PLOTTED		
GRADES CHECKED		
B. M.'S NOTED		
STRUCTURE NOTATIONS CHECKED		

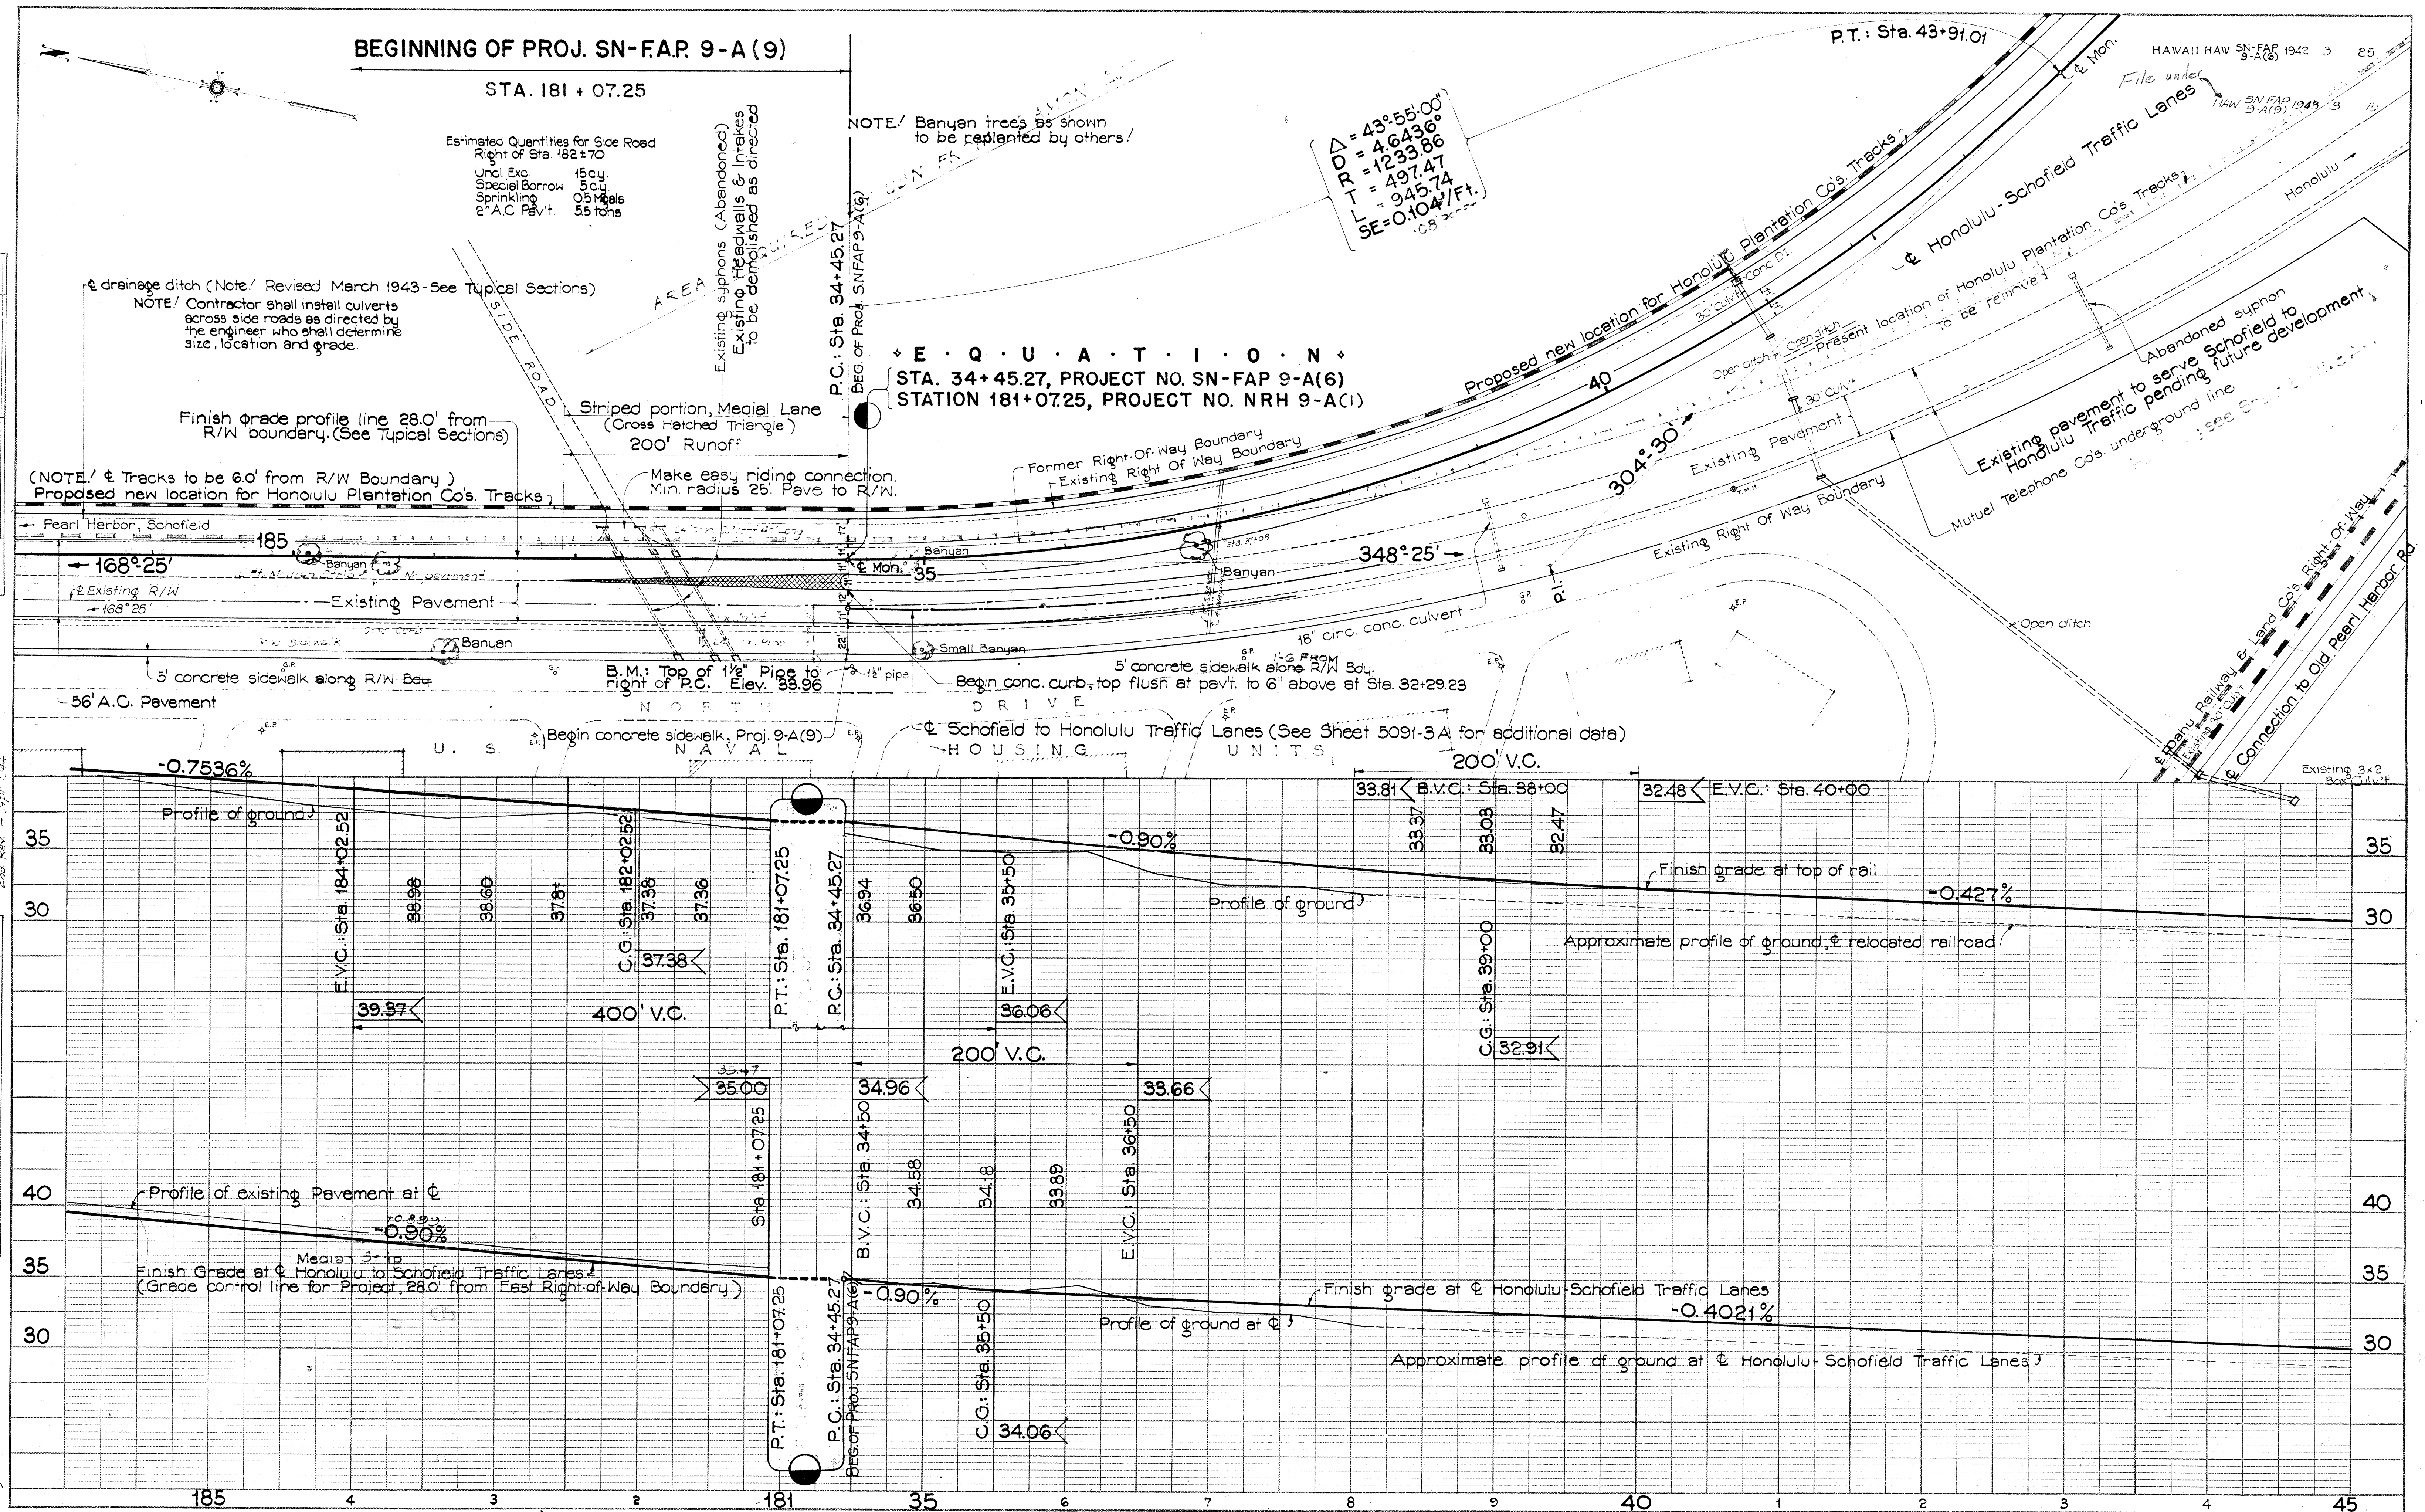


5115.3 5091.3
File → SN FAP 9-A(9) SN FAP 9-A(6)

FED. ROAD DIST. NO.	STATE	PROJ. NO.	FISCAL YEAR	SHEET NO.	TOTAL SHEETS
HAWAII	HAW.	9A(6)	1943	4	15

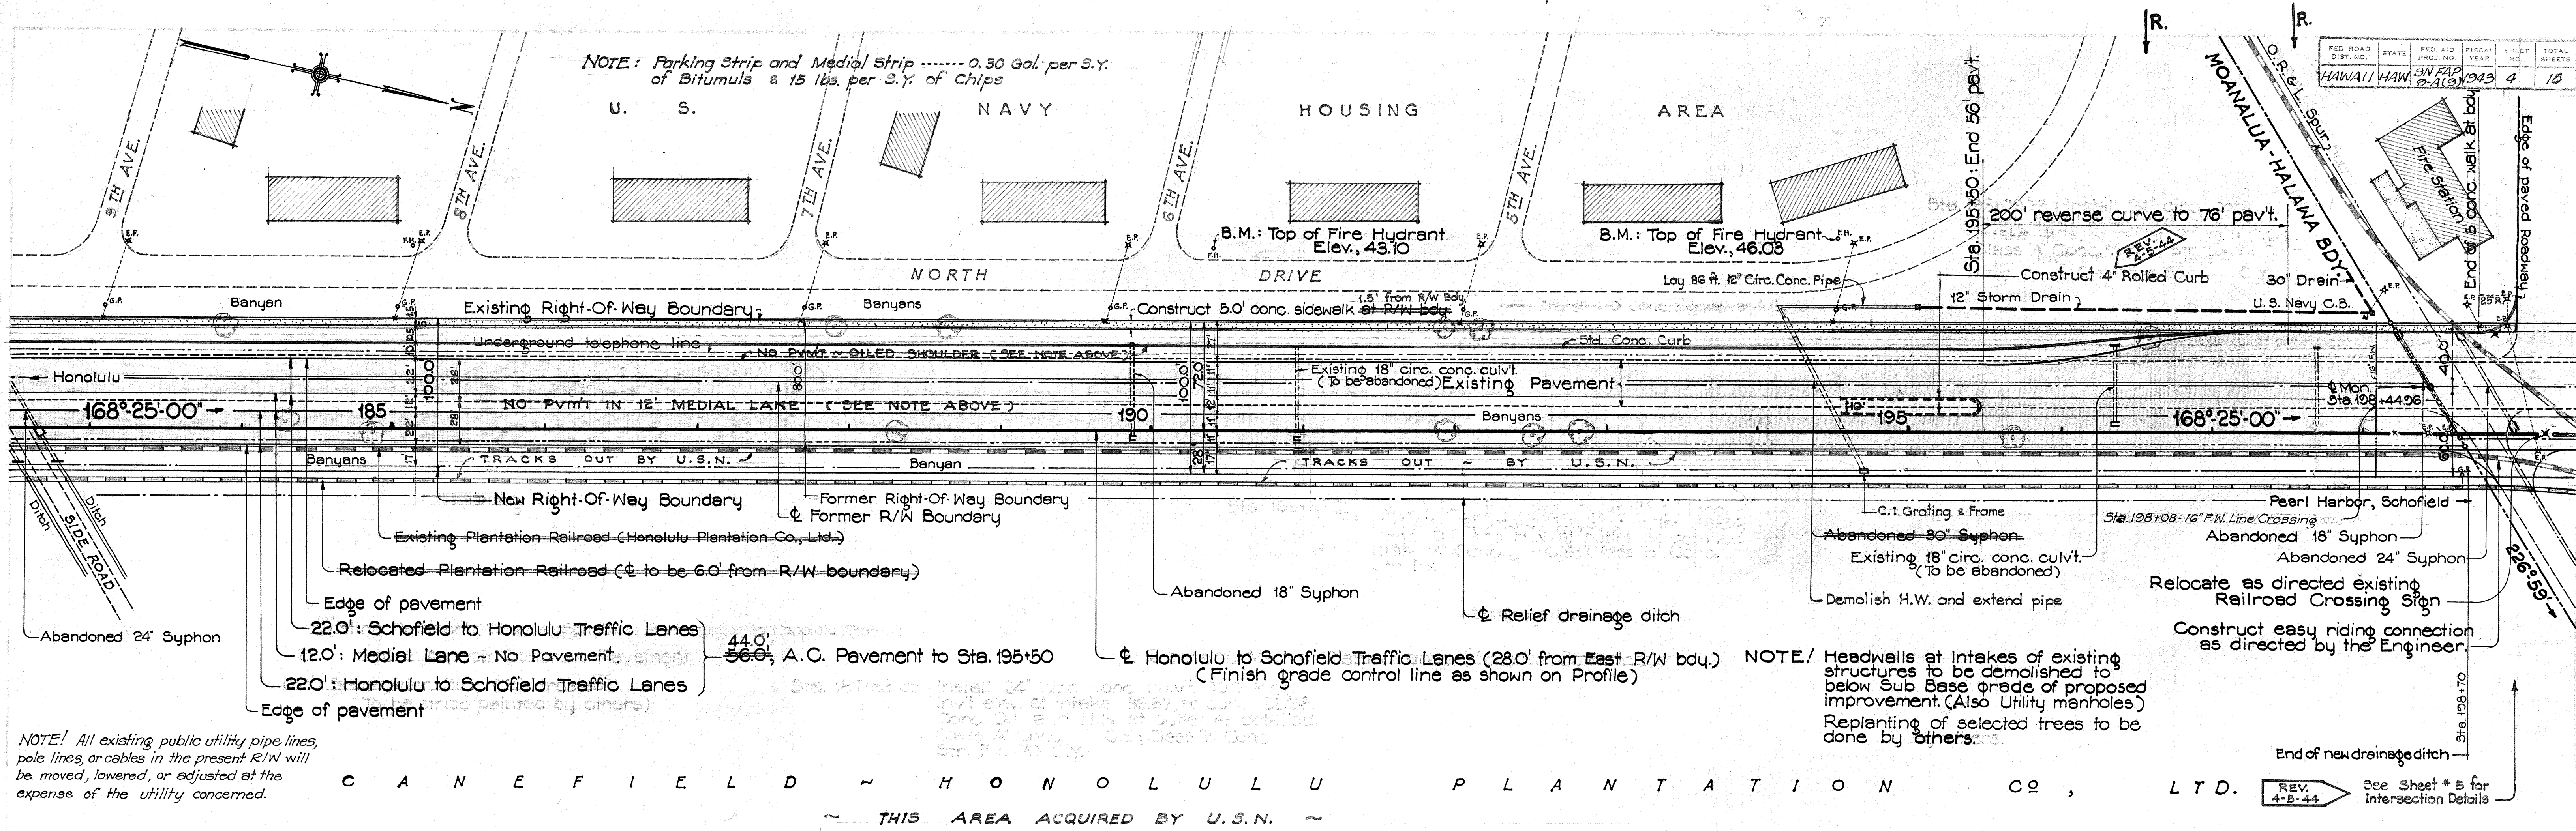


NOTE: All existing public utility pipe lines, pole lines, or cables in the present R/W will be moved, lowered, or adjusted at the expense of the utility concerned.

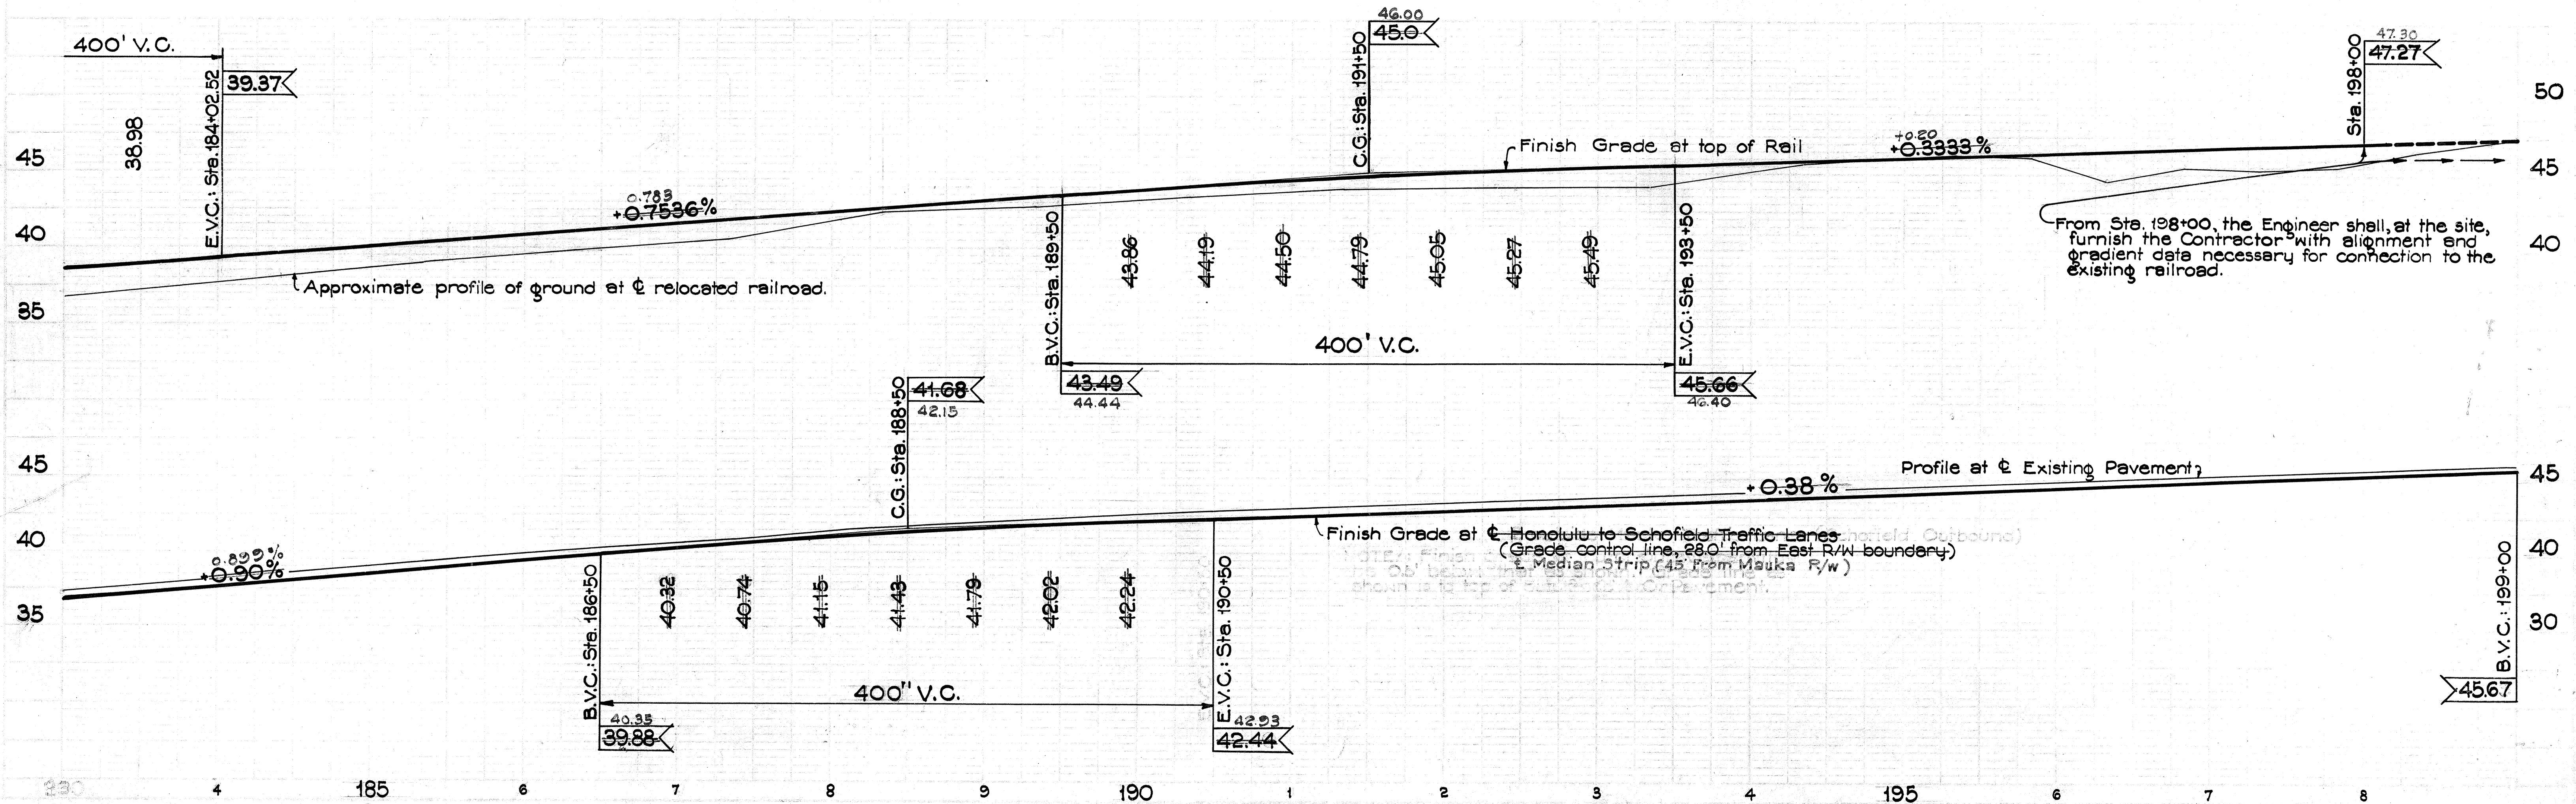

5115.4

See proj. FAP-9A(6) for Sht #3


Nav's 10' F.M. Line Crossing at 188+00
Spotted on tracing - 2/1/44
1st Rev. Nov. 1943
2nd Rev. 4-5-44

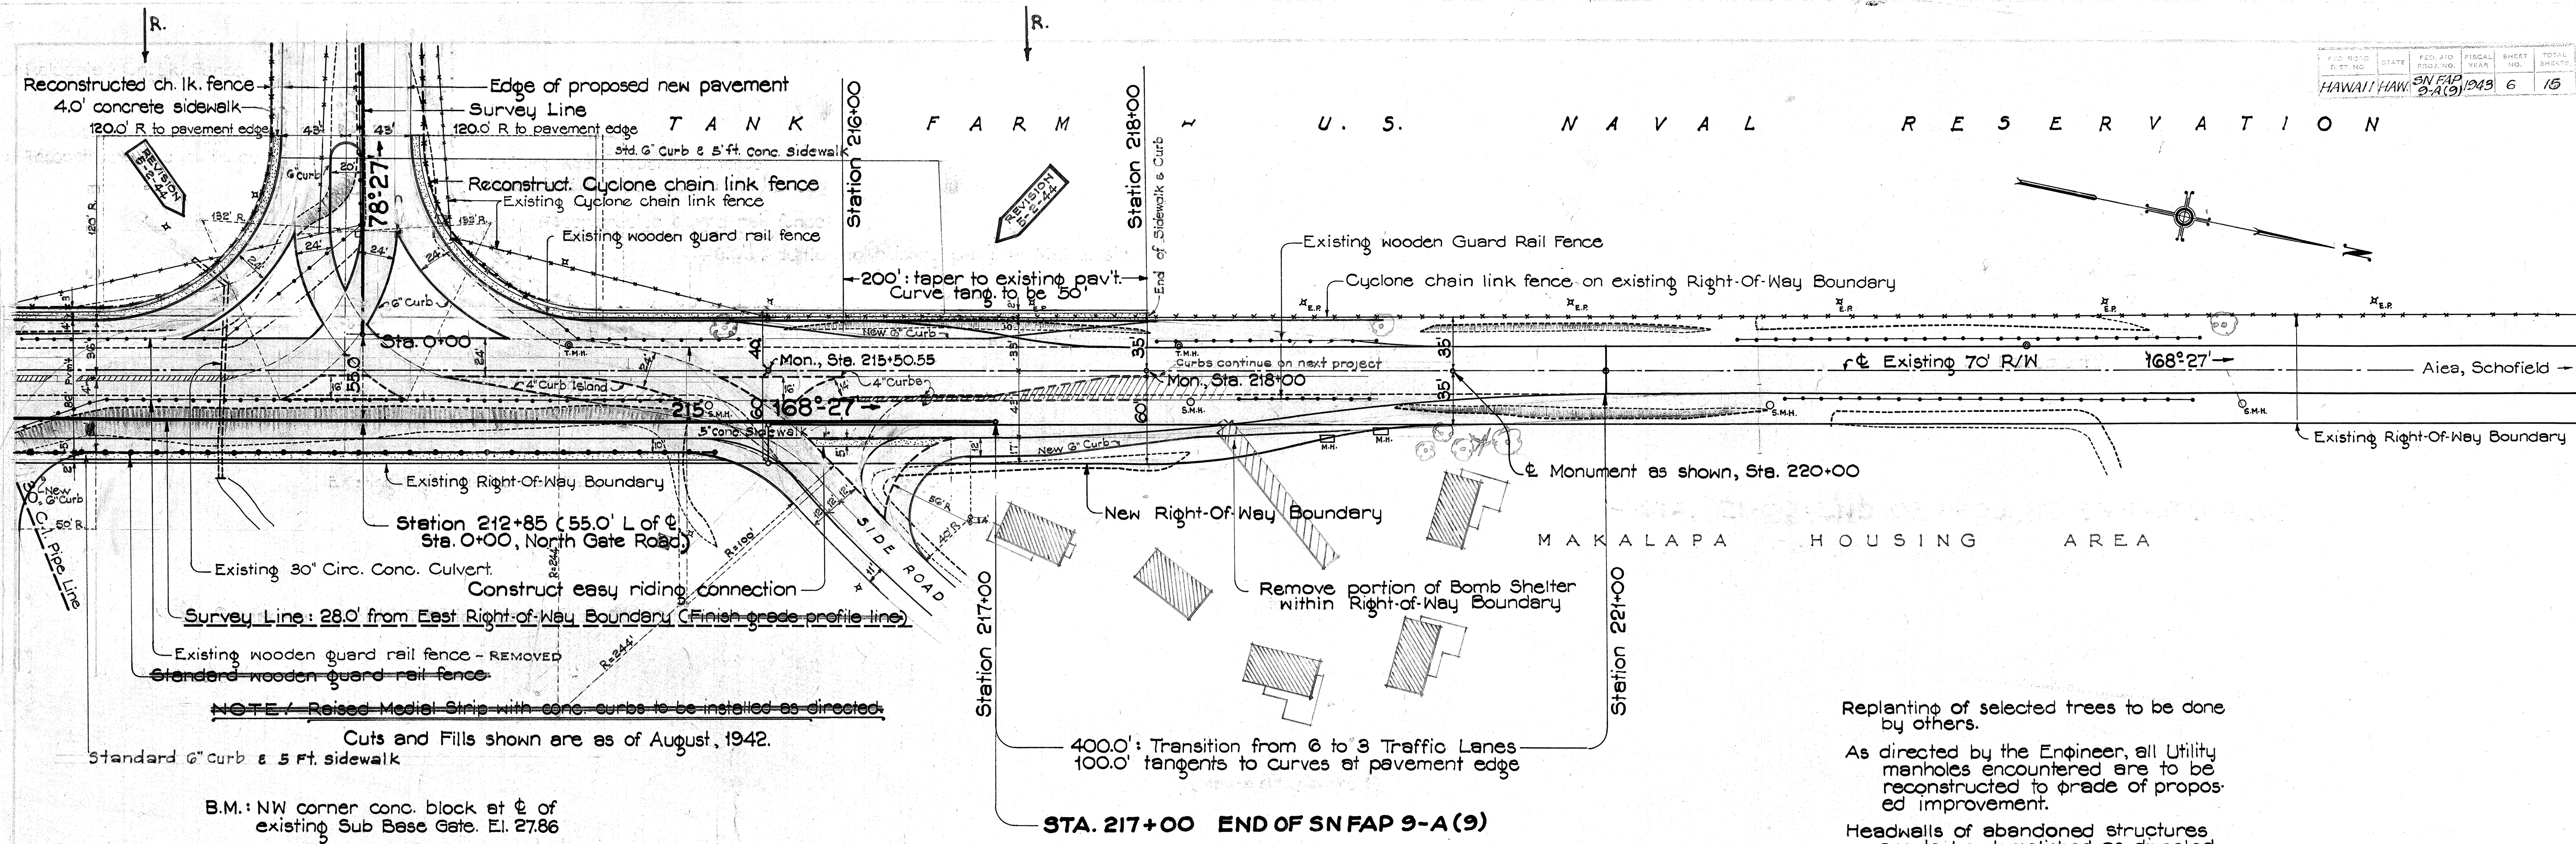

Replanting of selected trees to be done by others.
As directed by the Engineer, all Utility manholes encountered are to be reconstructed to grade of proposed improvement.
Headwalls of abandoned structures are to be demolished as directed.

Estimated Quantities for Side Road Right of Sta. 215+85

Special Borrow	45 cu.
Sprinkling	15 M gals
2" A.C. Pav't	15.5 tons


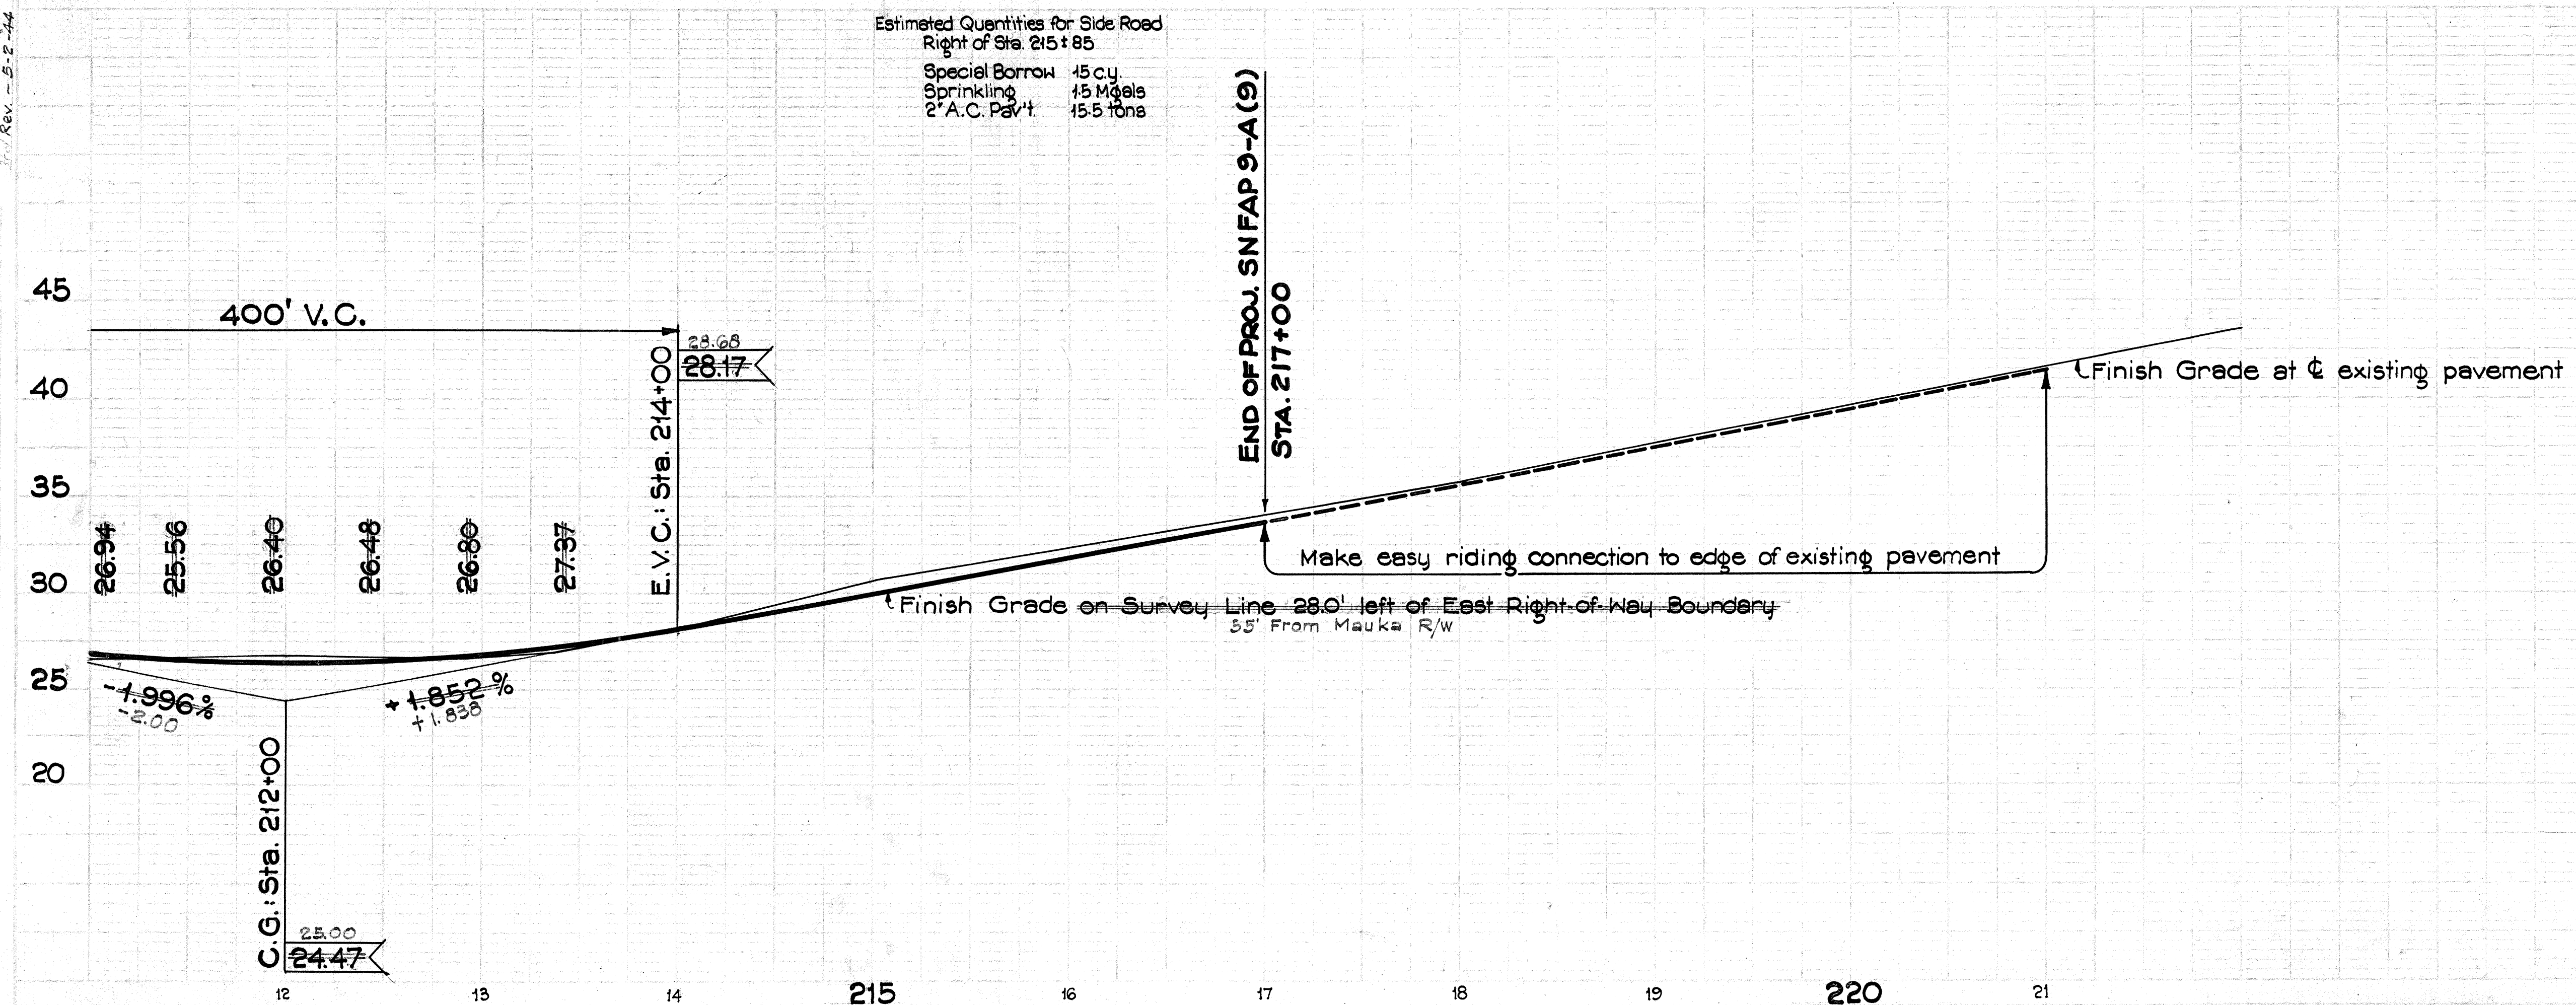


PLAN
 REVISIONS
 DATE
 BY
 CHECKED
 DATE
 BY

1st. Rev. - Nov. 1943
 2nd. Rev. - Apr. 1944


PROFILE
 REVISIONS
 DATE
 BY
 CHECKED
 DATE
 BY

PROJECT NO.	STATE	FISCAL YEAR	SHEET NO.	TOTAL SHEETS
HAWAII	HAWAII	1943	7	16

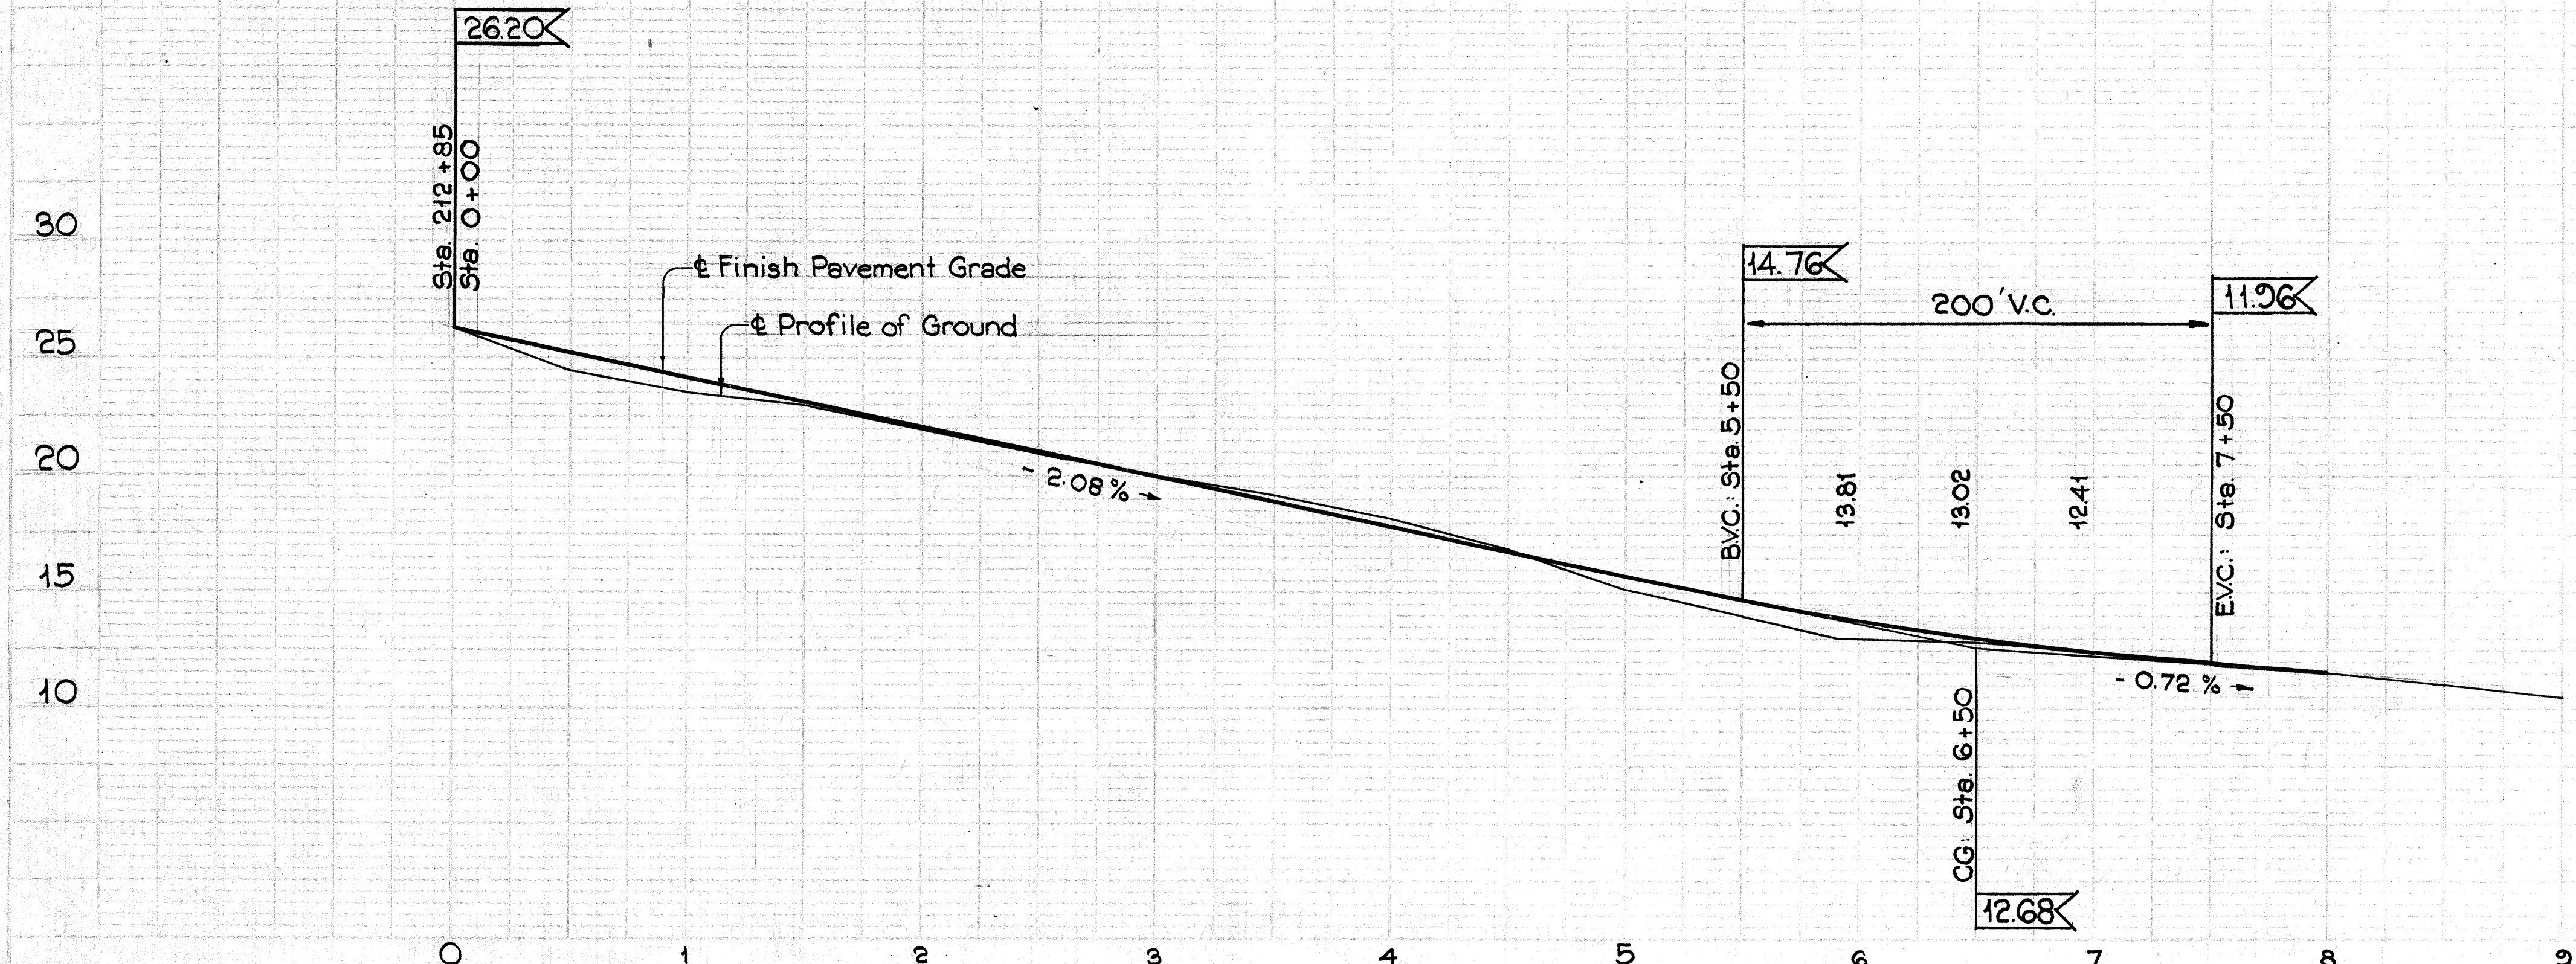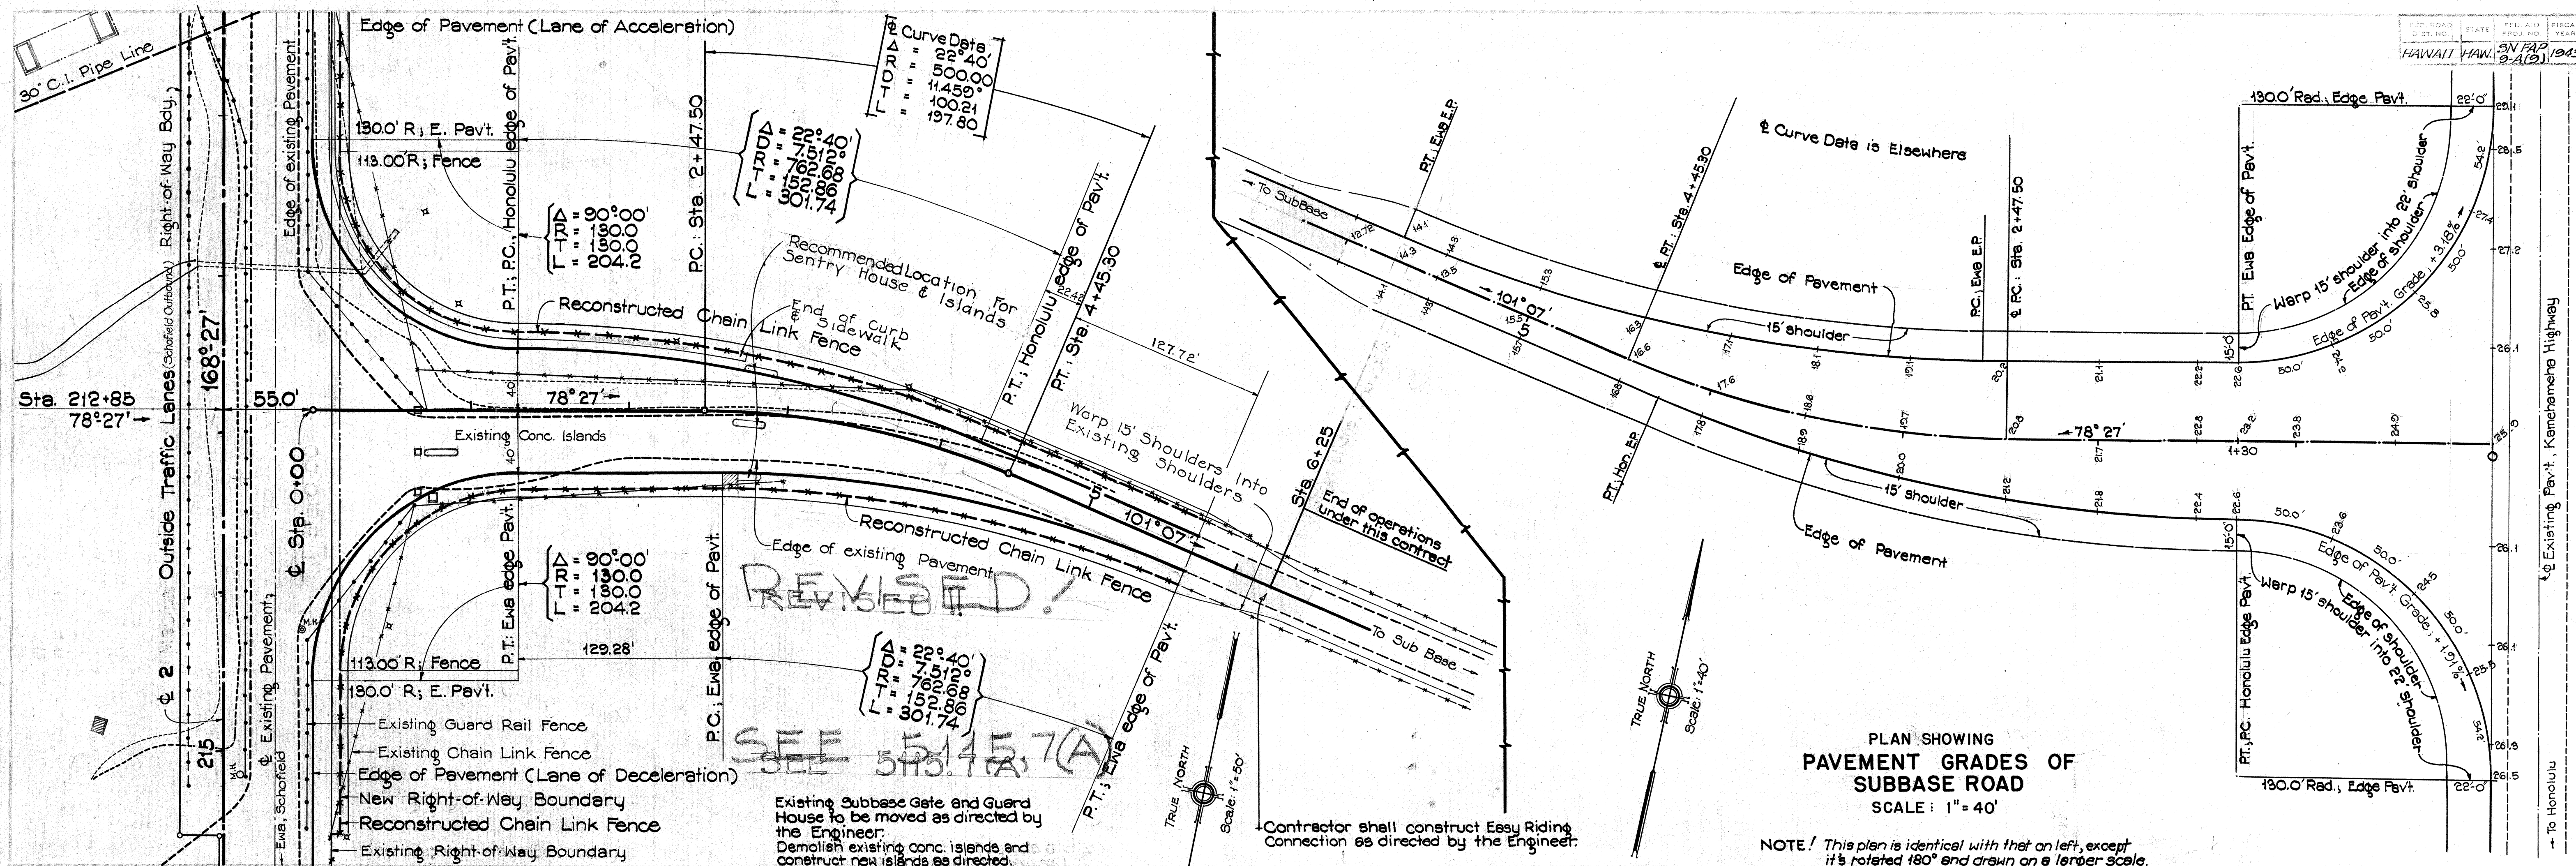

5115.7

FED. ROAD DIST. NO.	STATE	FED. AID PROJ. NO.	FISCAL YEAR	SHEET NO.	TOTAL SHEETS
HAWAII	HAW	SN-FAP 9-A(9)	1942	8	26

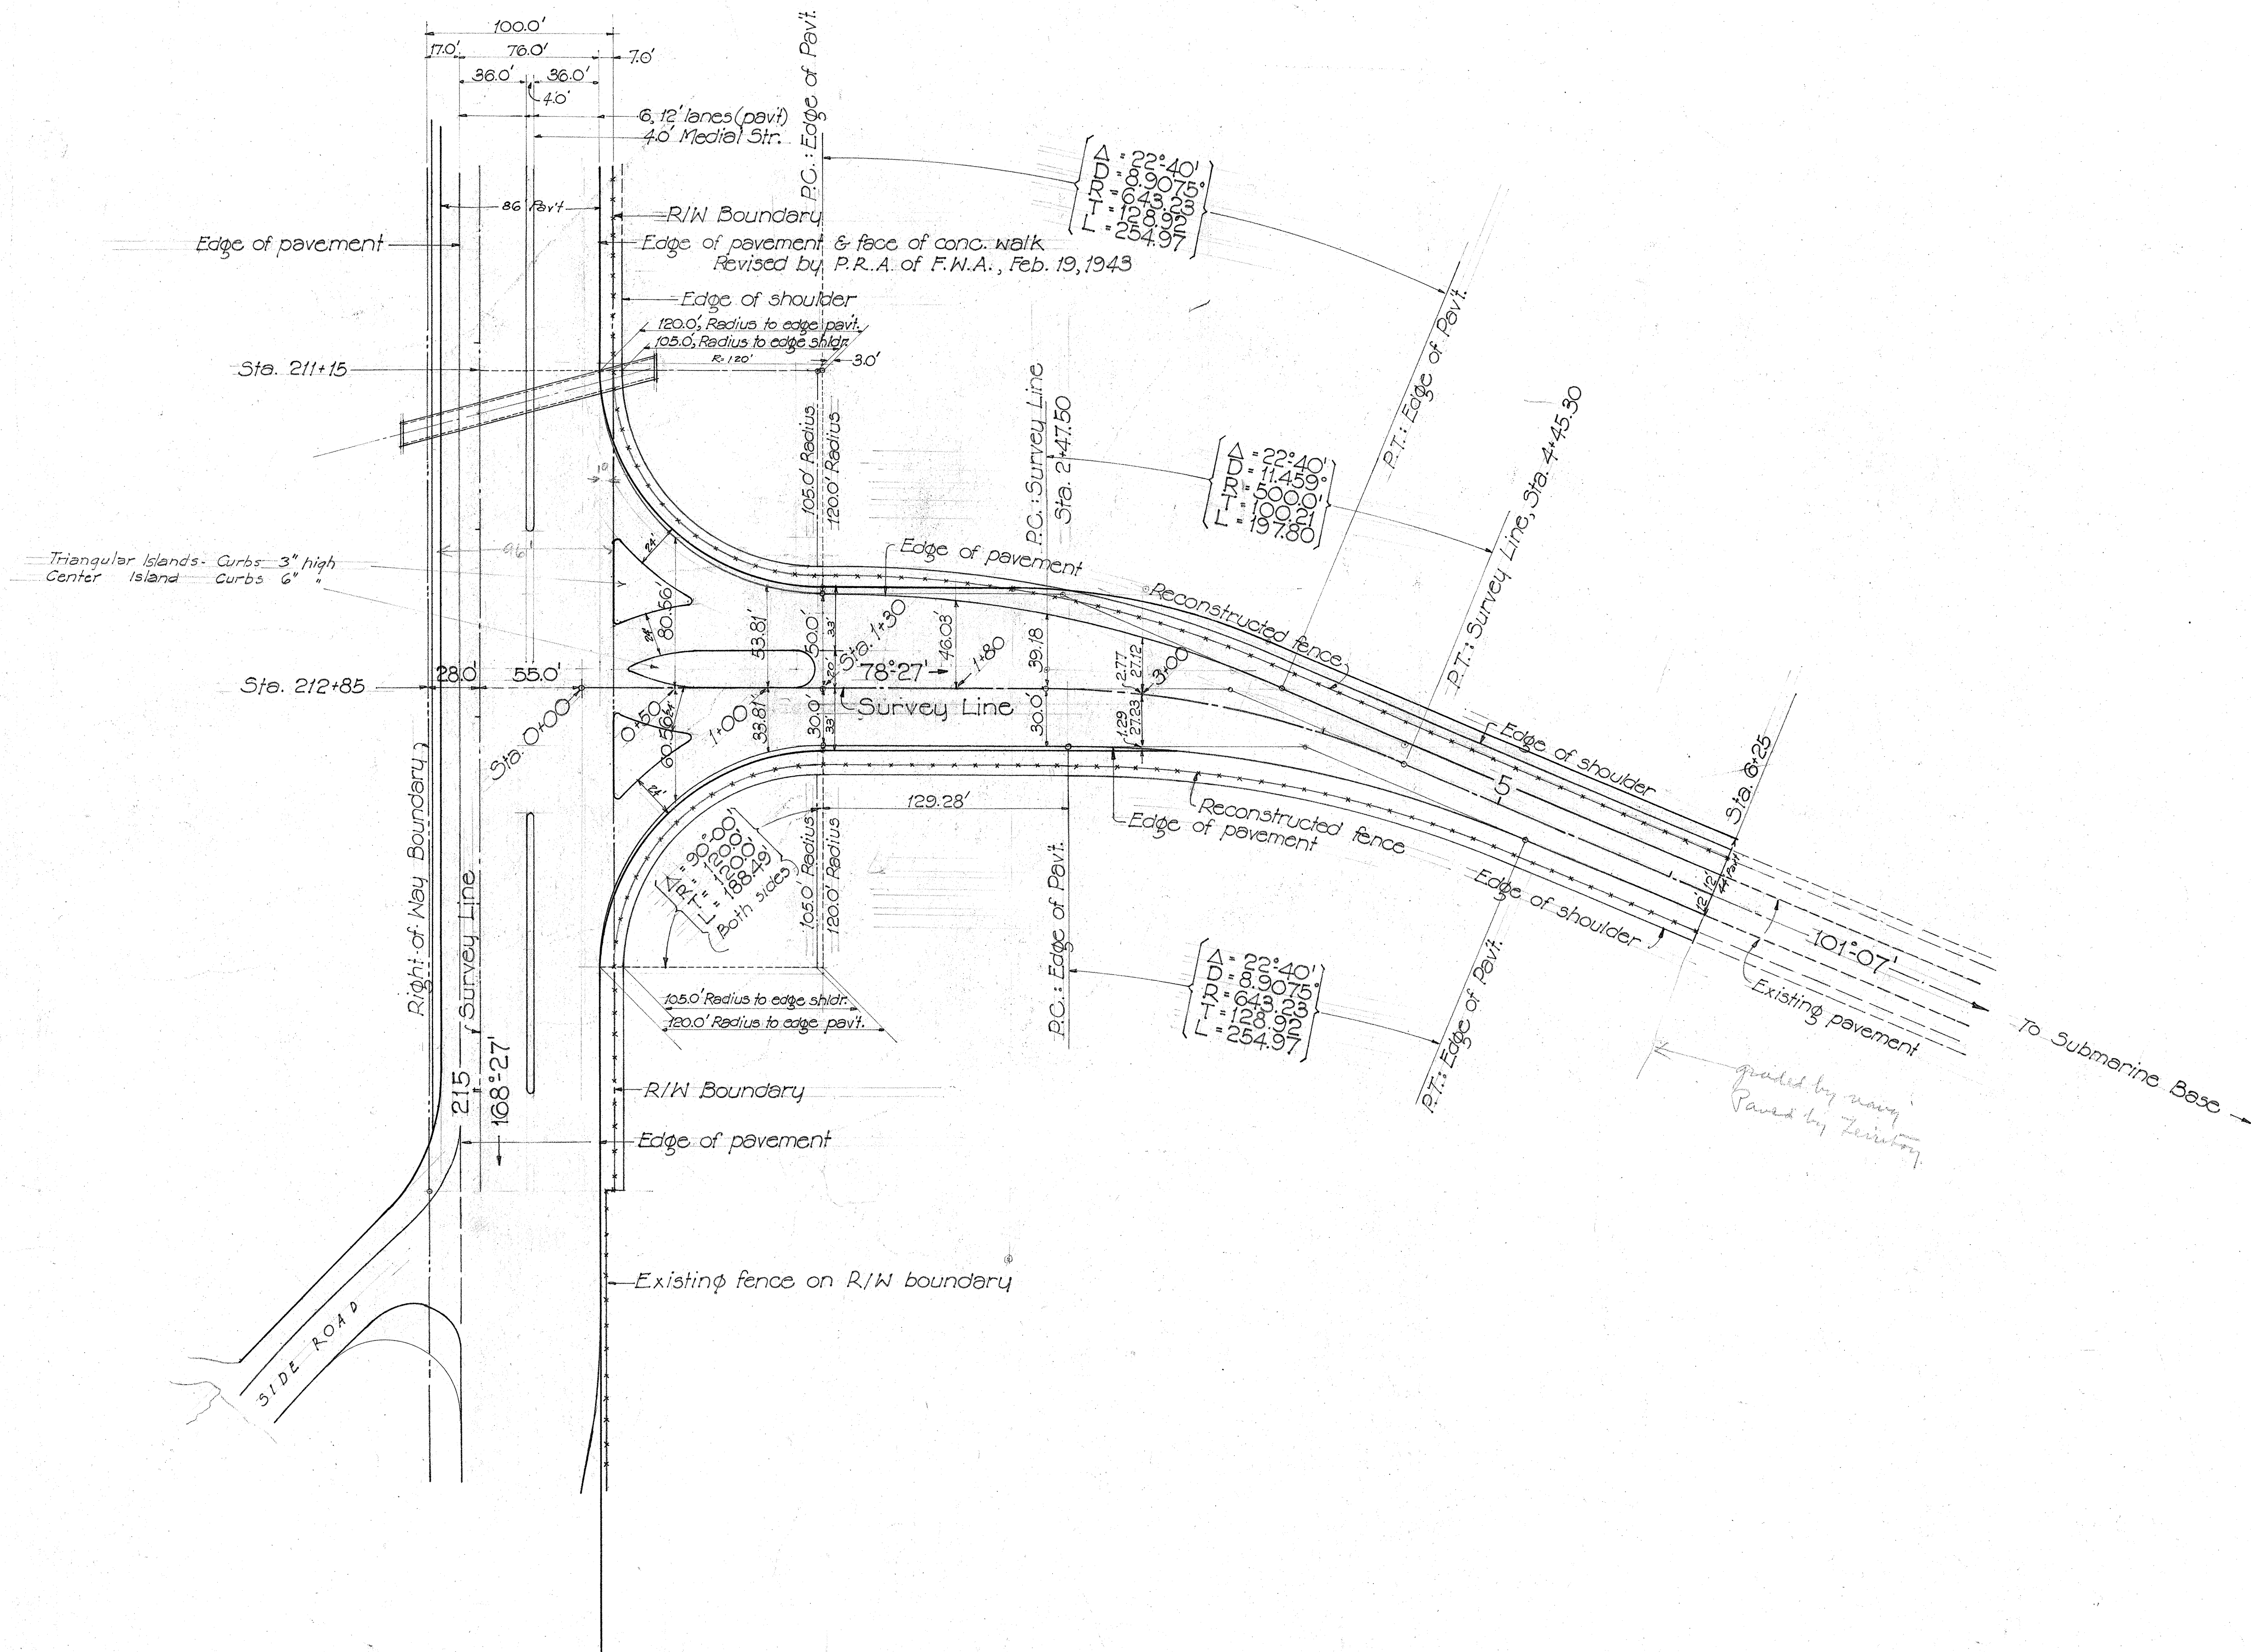

ORIGINAL PLAN	DESIGNED BY	DATE
NOTE BOOK	TRACED BY	
No.	QUANTITIES BY	
	CHECKED BY	

1st Rev. Nov. 1943
2nd Rev. Apr. 1944

TERRITORIAL HIGHWAY DEPARTMENT
TERRITORY OF HAWAII

REVISED LAYOUT
SUB-BASE ROAD
Project No SN-FAP 9-A(9)
Feb. 10, 1943
Scale, 1"=50'



SHEET No OF SHEETS

5115-7(A)

FED. ROAD DIST. NO.	STATE	FED. AID PROJ. NO.	FISCAL YEAR	SHEET NO.	TOTAL SHEETS

This sheet revised 7/27/45

ORIGINAL PLAN	DATE
DRAWN BY	
NOTED BY	
CHECKED BY	

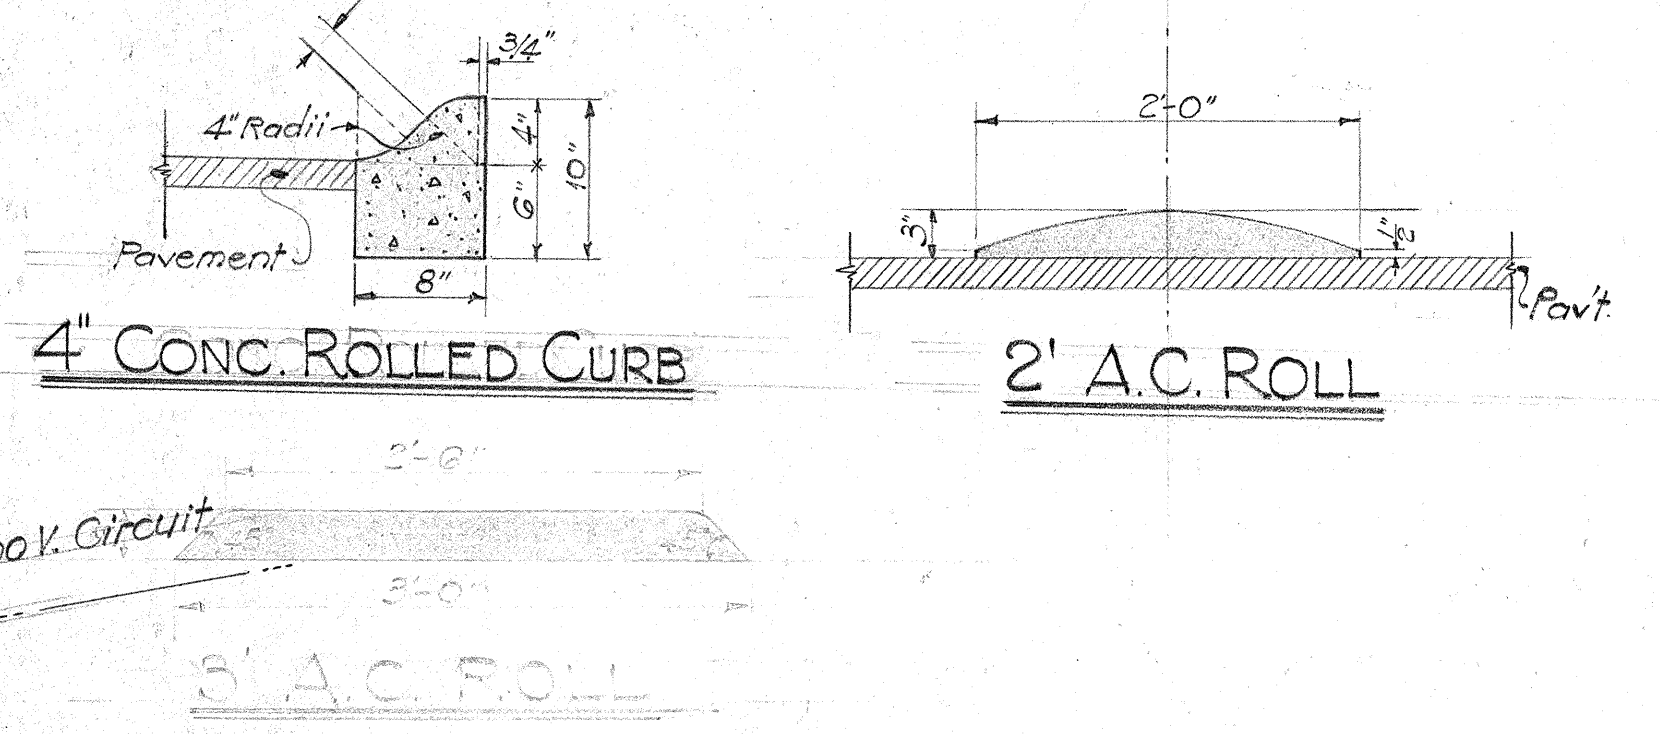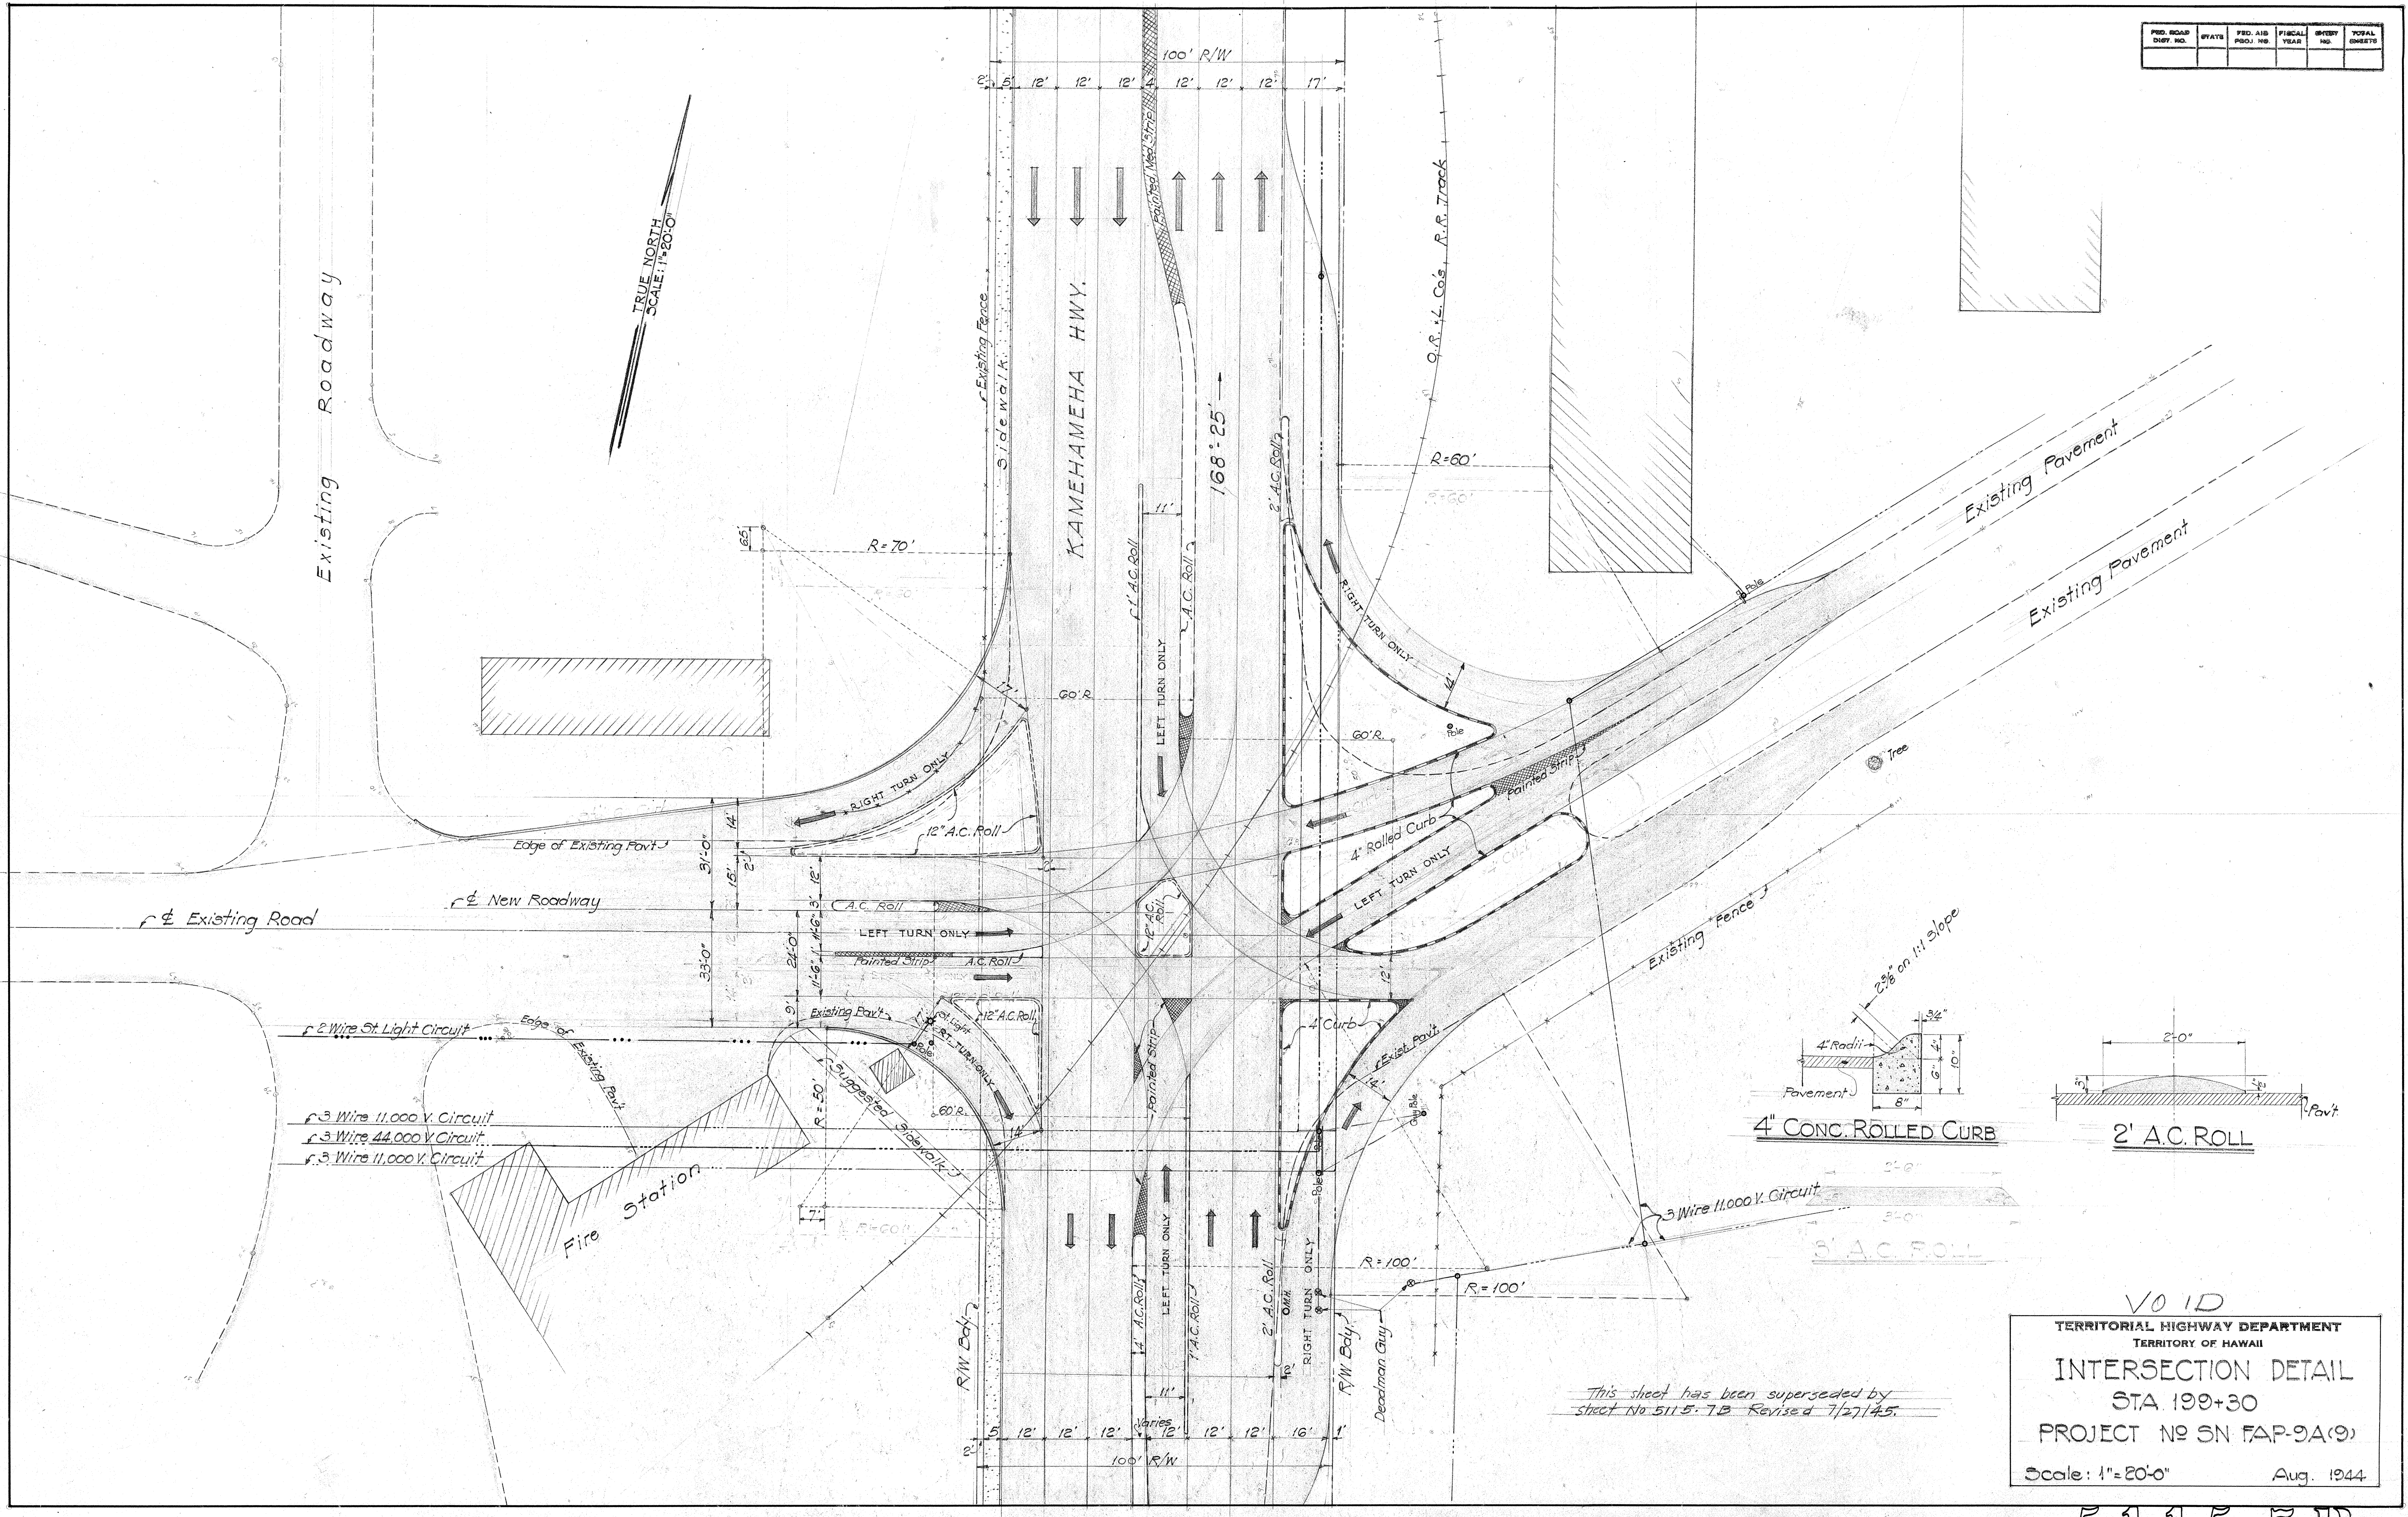


This sheet has been superseded by sheet No. 5115-7B Revised 7/27/45.

VO 1D
 TERRITORIAL HIGHWAY DEPARTMENT
 TERRITORY OF HAWAII
INTERSECTION DETAIL
 STA. 199+30
 PROJECT NO SN FAP-9A(9)
 Scale: 1"=20'-0" Aug. 1944

5115.7B

All Std. Conc. Curb and all Conc. Roll Curb to be Cast-in-place

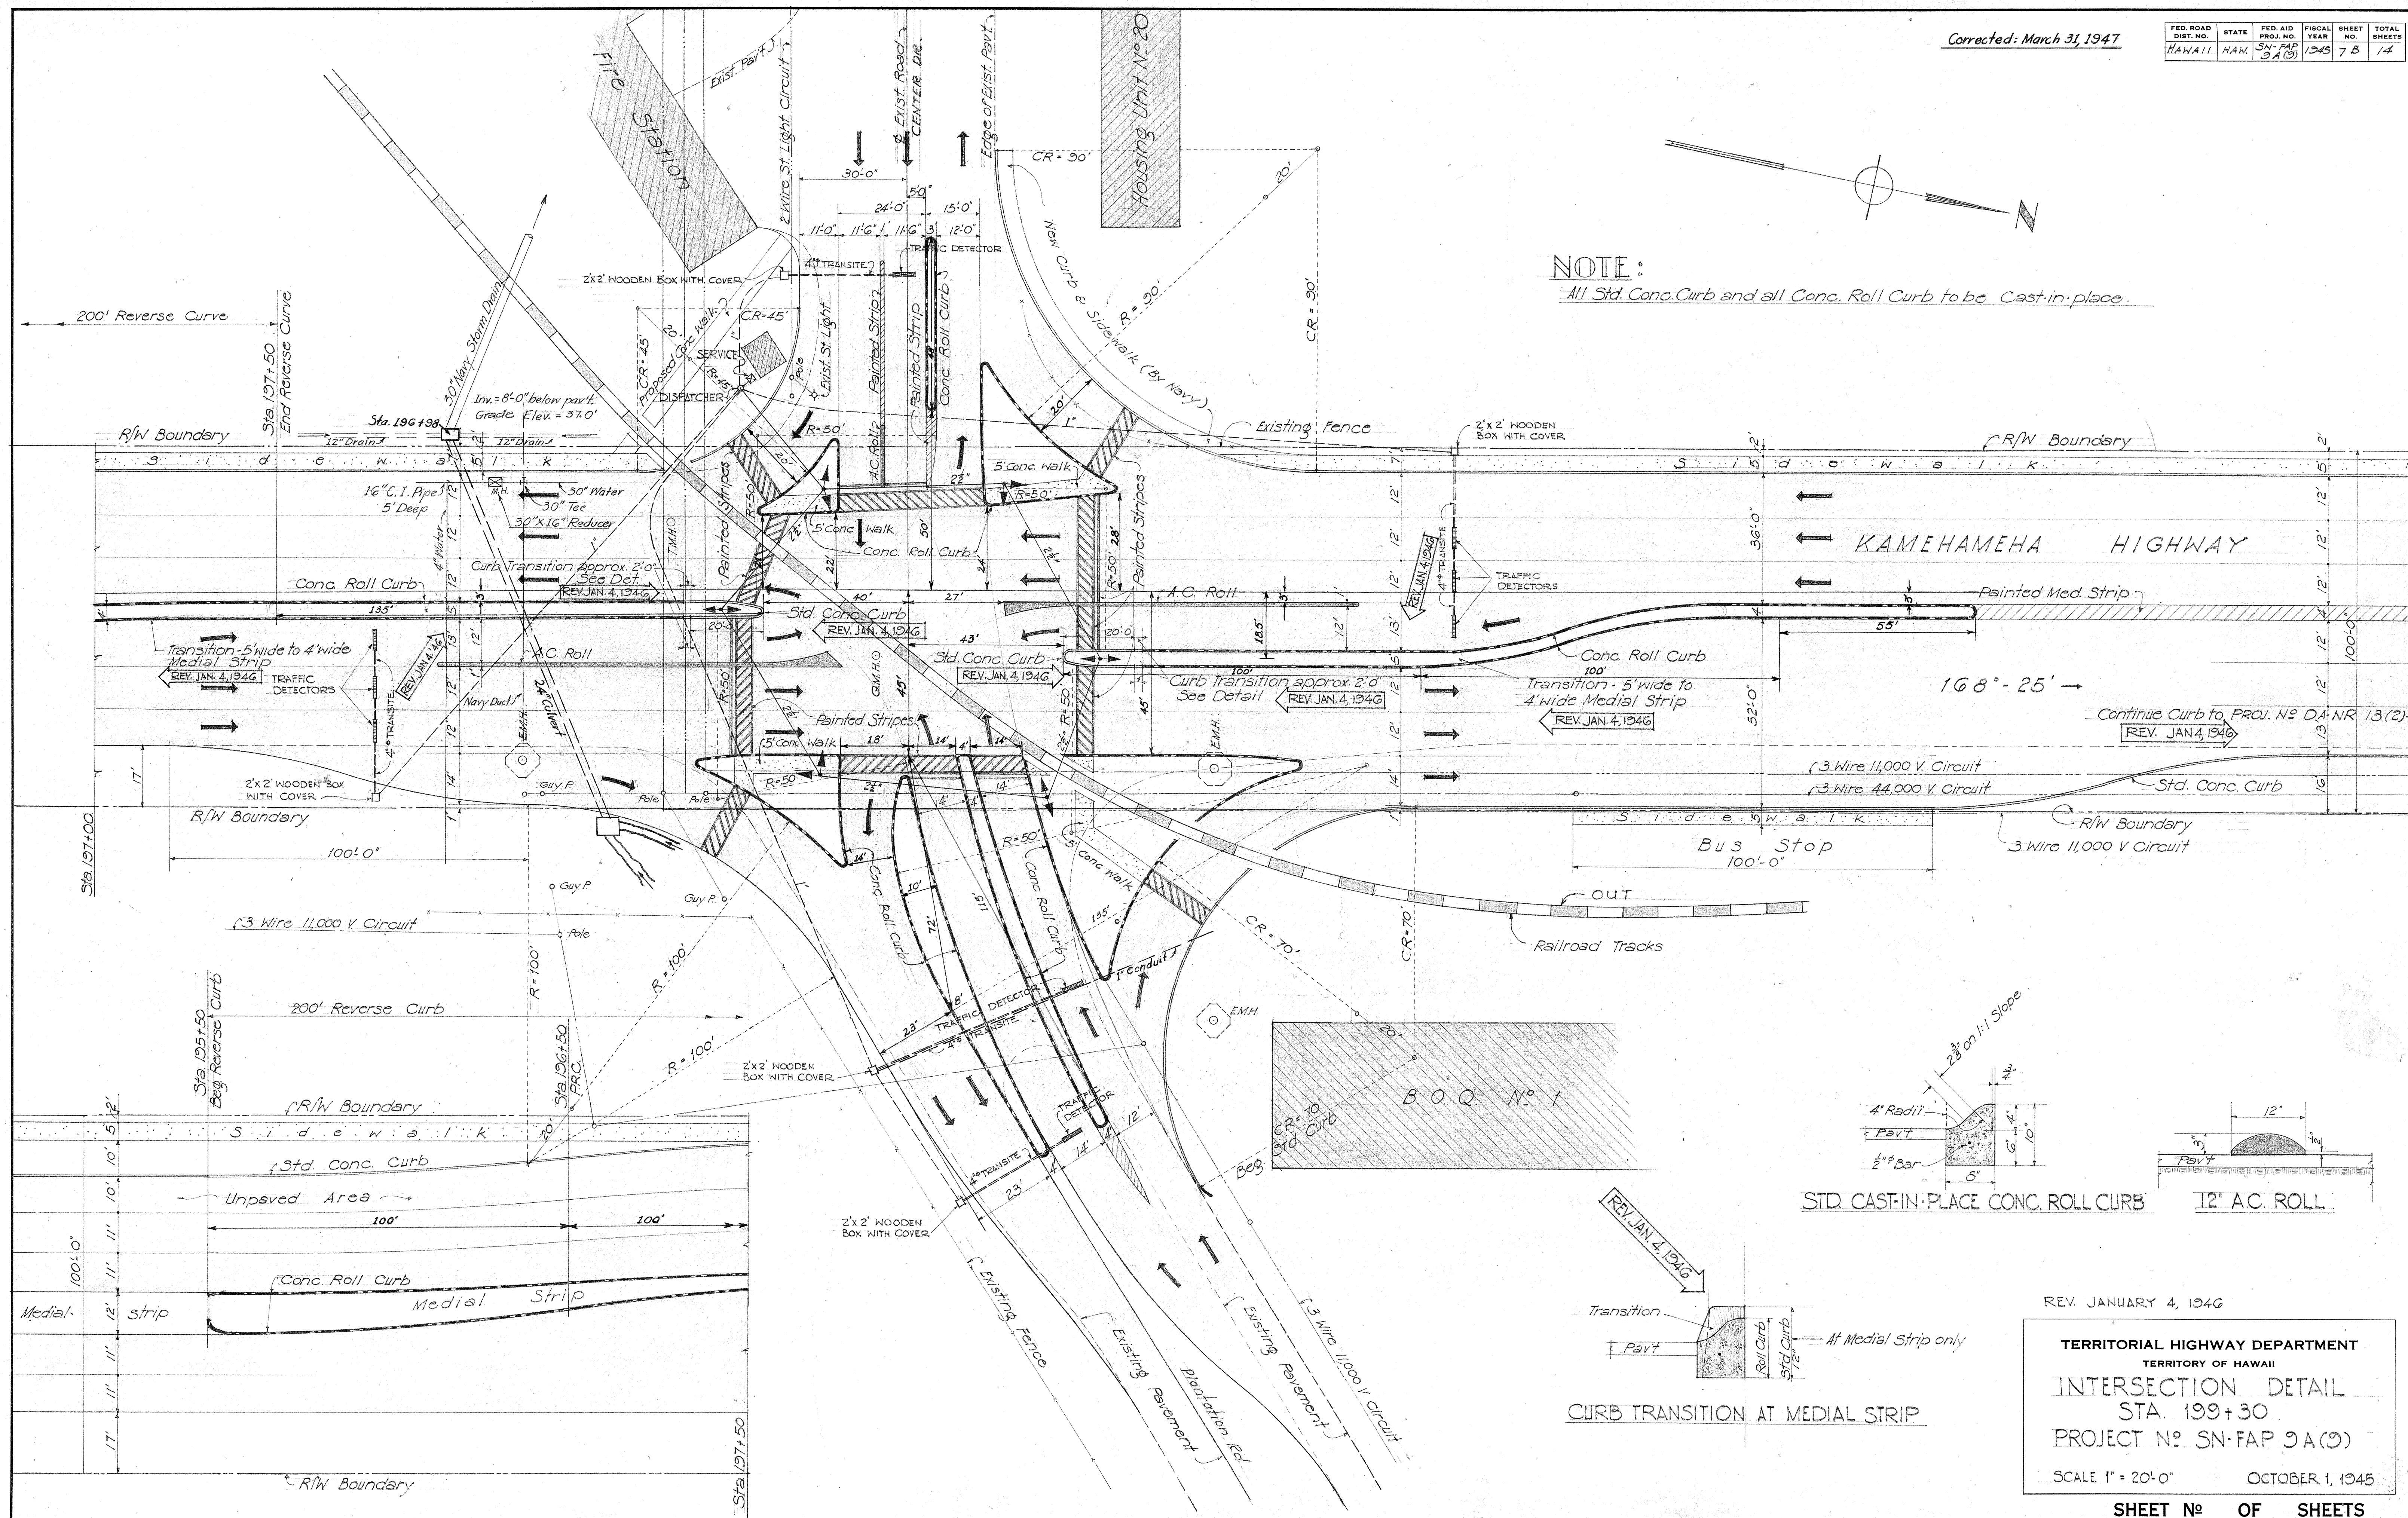

SHEET No OF SHEETS

5115.7 IR

Rev. October 1/1945
Conforming to Navy Plan
Job Sheet N° 6516A
PW Drawing N° OA-N2-370

ORIGINAL PLAN	SURVEY PLOTTED BY _____ DATE _____ DRAWN BY _____ TRACED BY _____ QUANTITIES BY _____ QUANTITIES CHECKED BY _____ CHECKED BY _____
NOTE BOOK	