

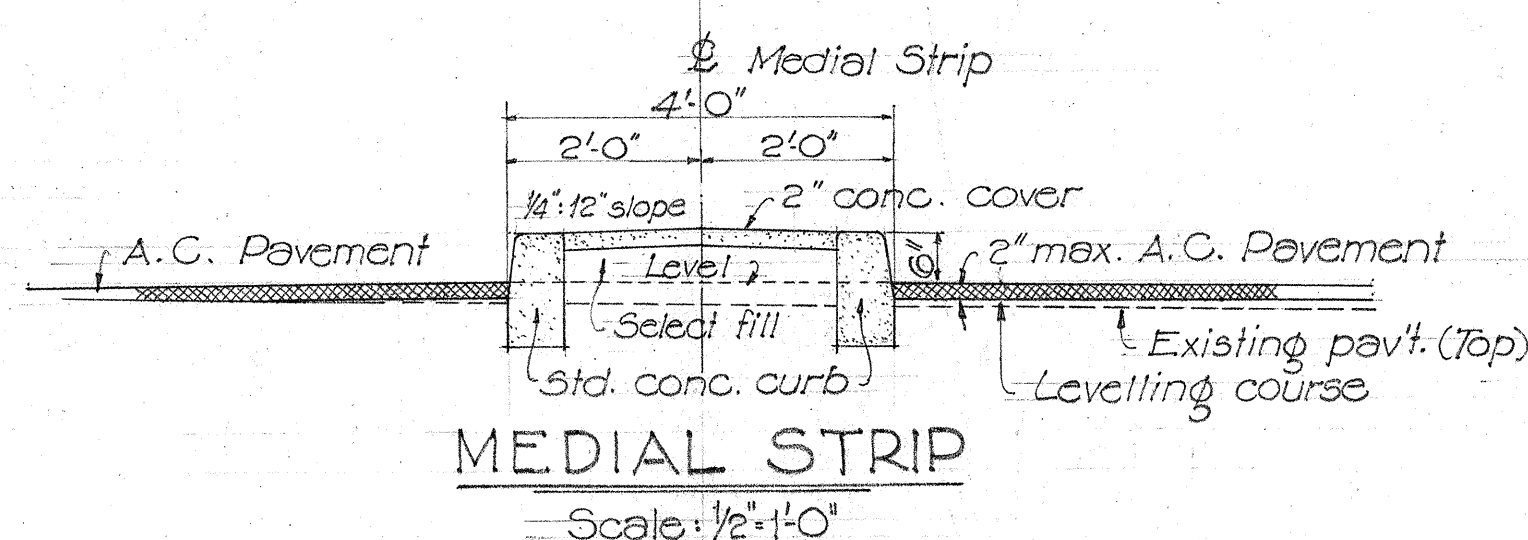
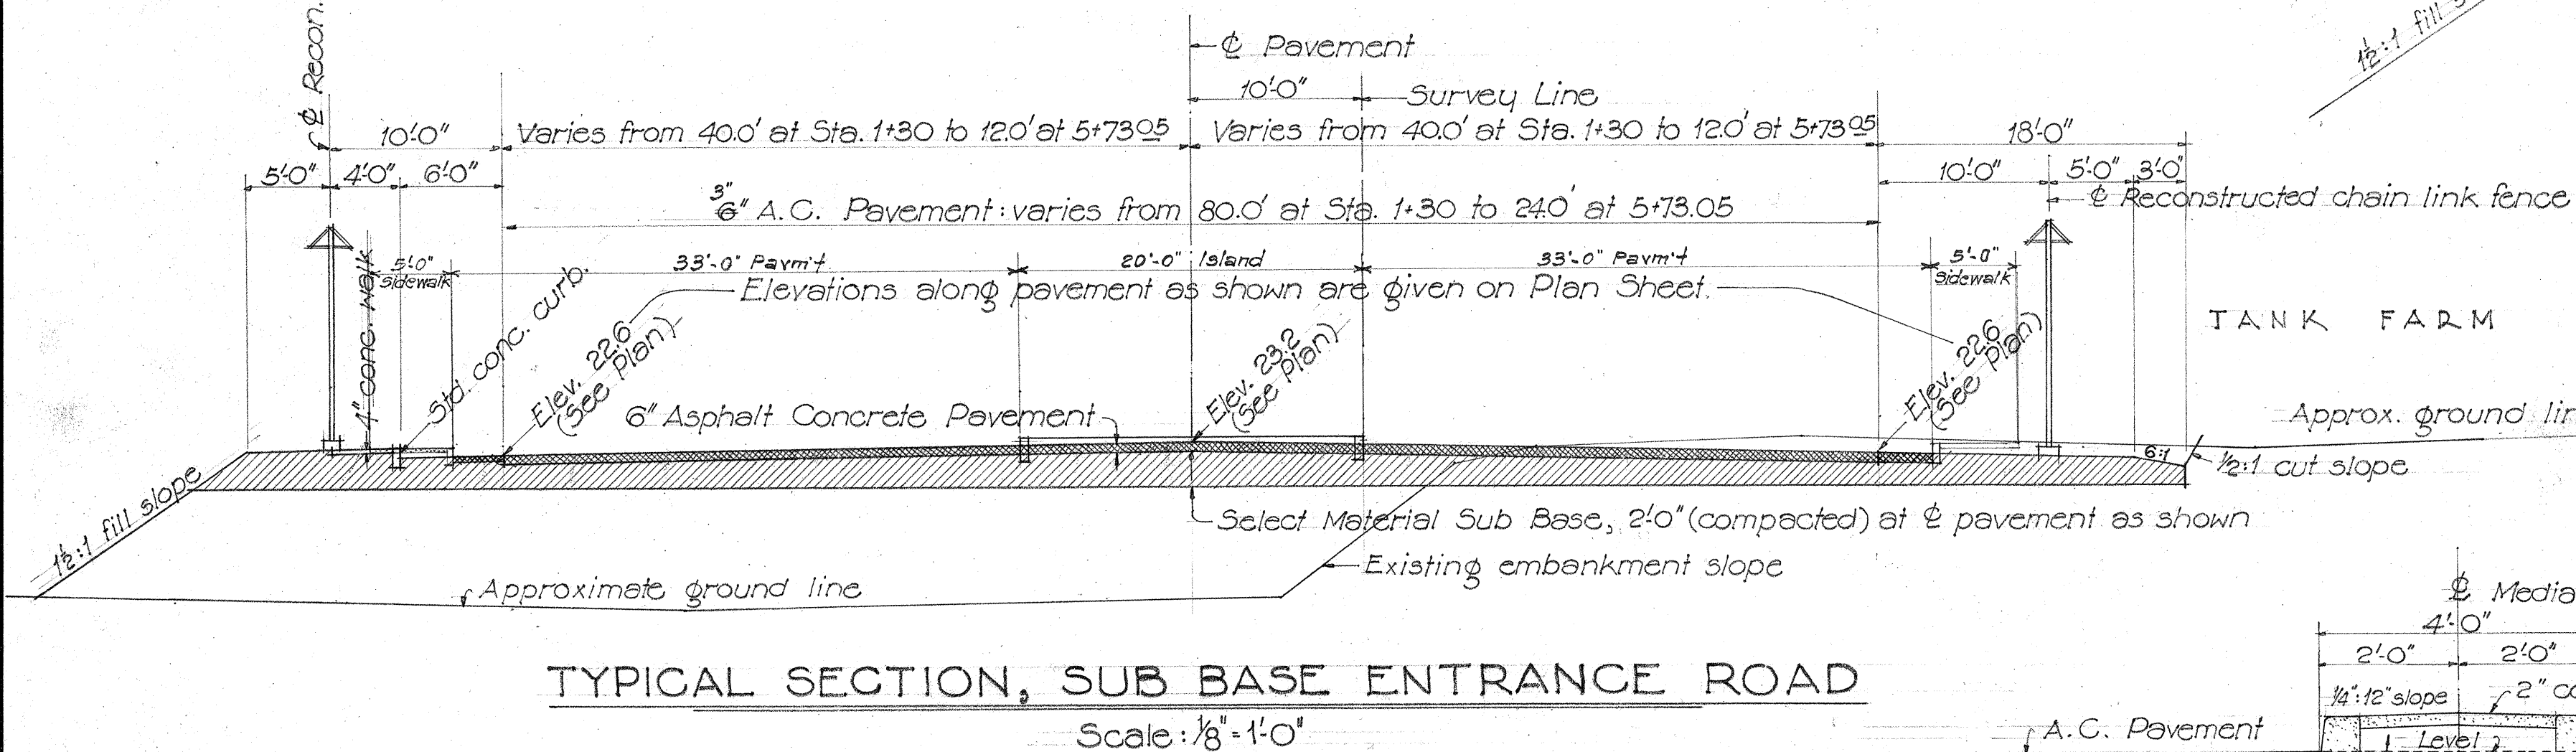
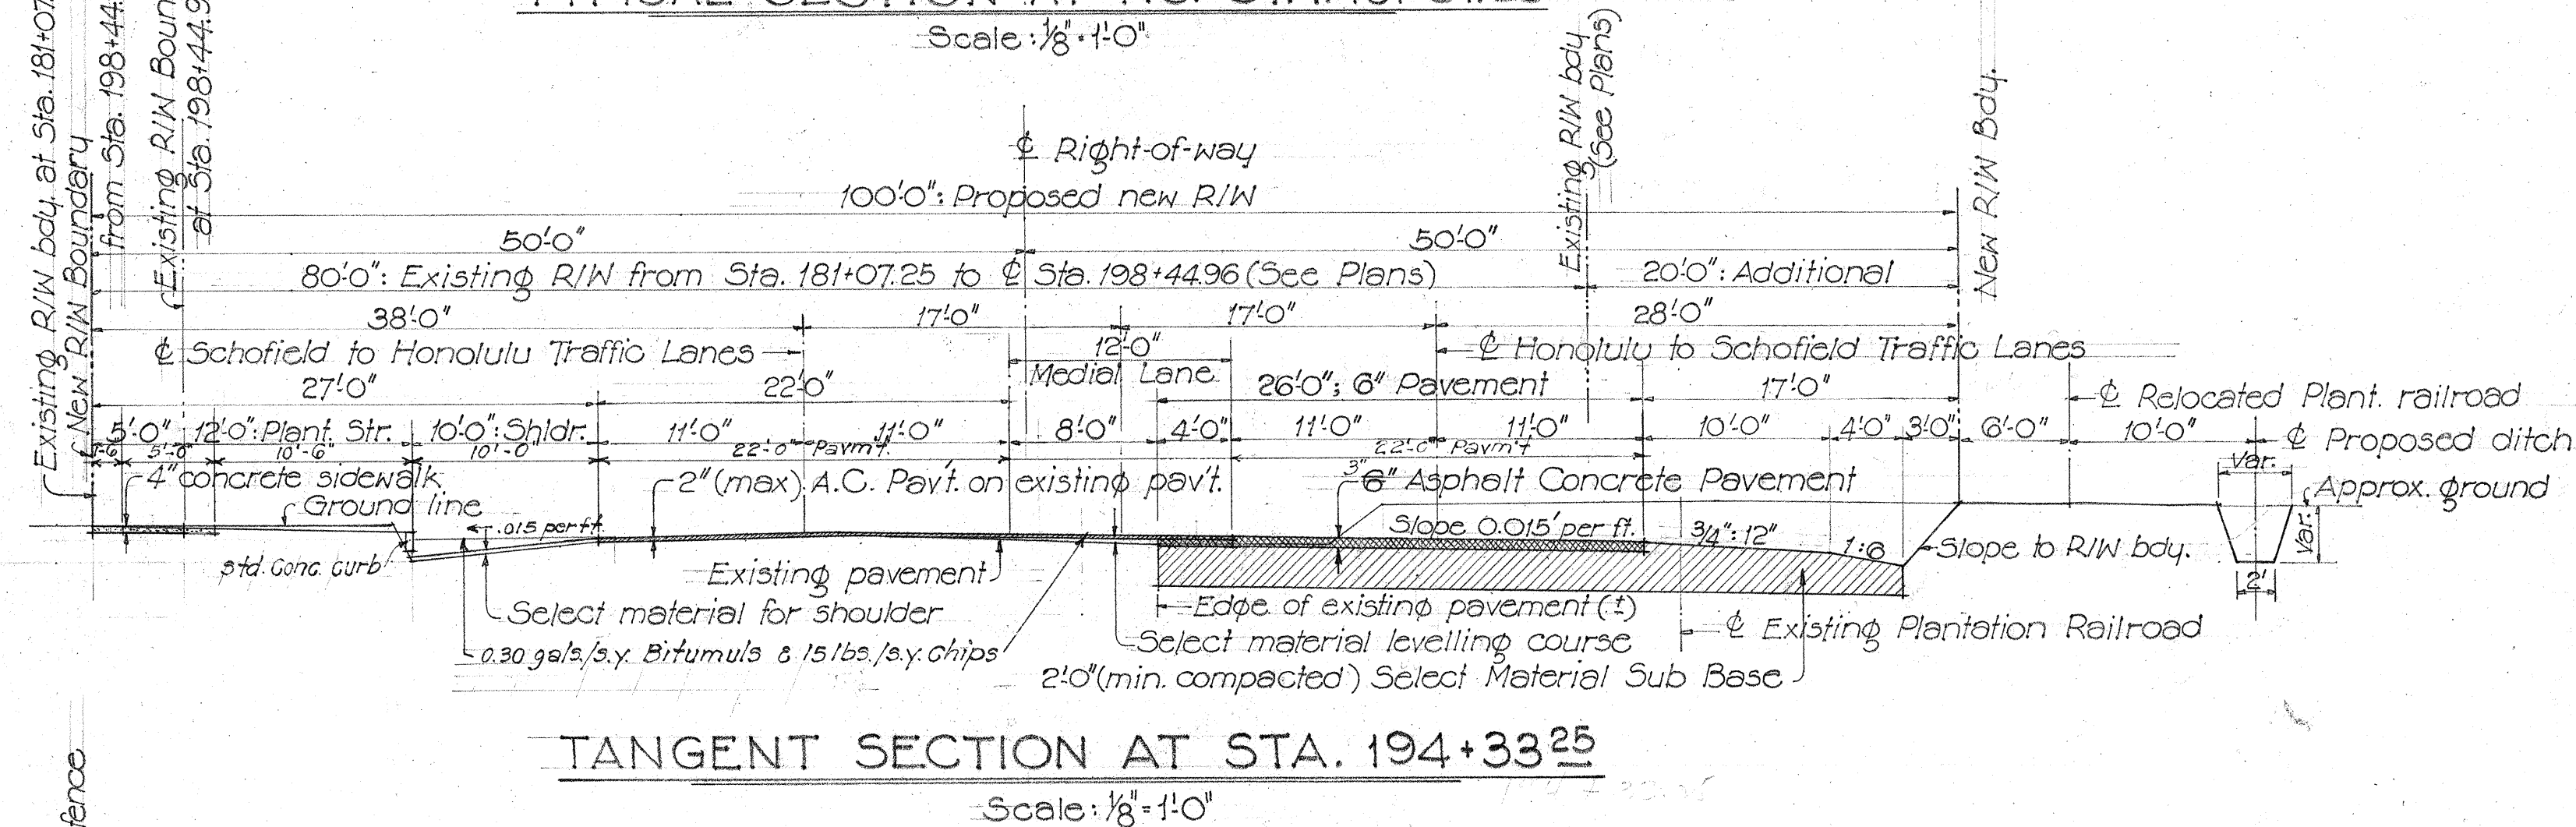
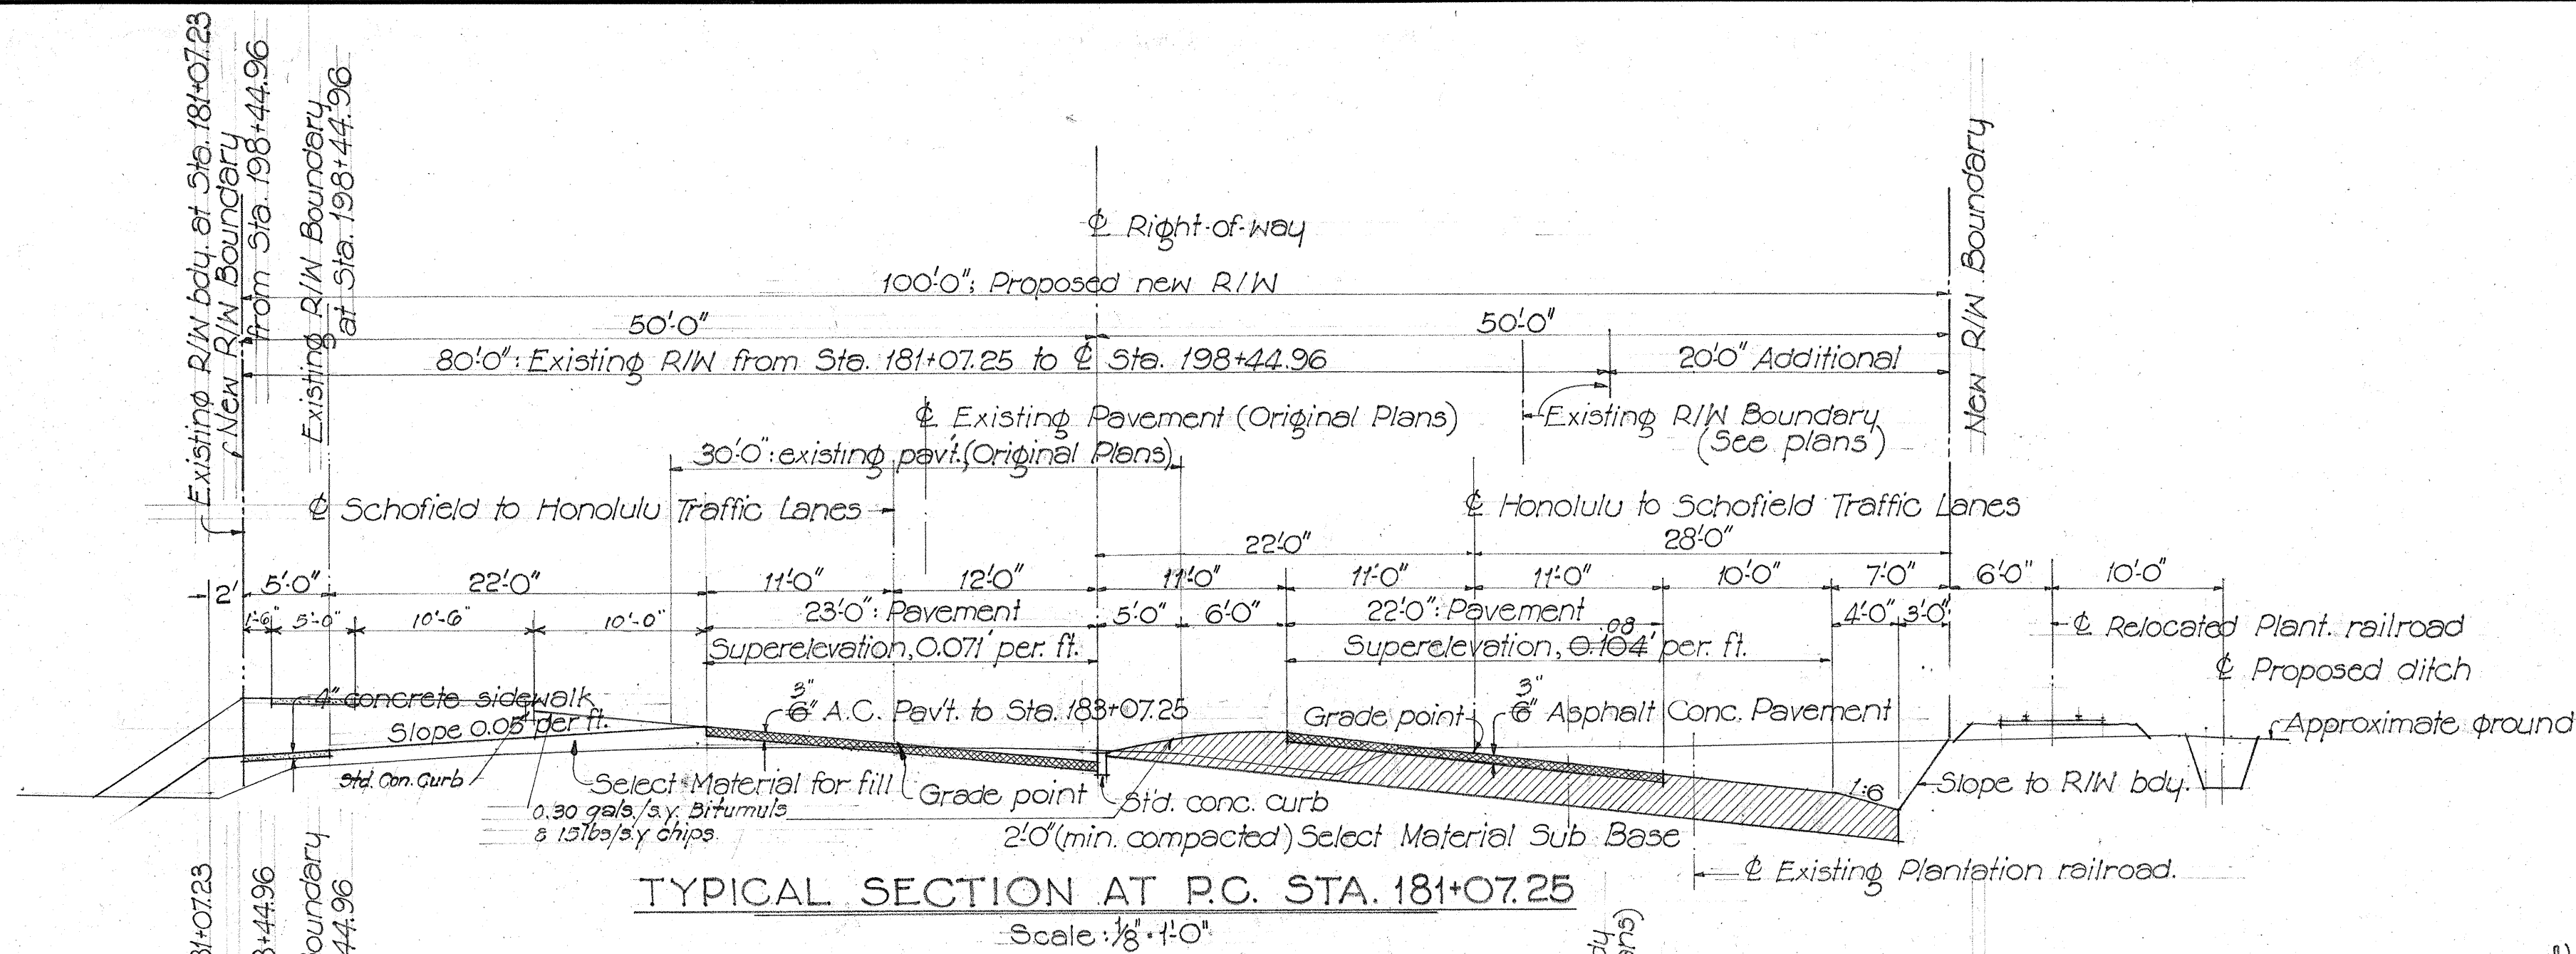
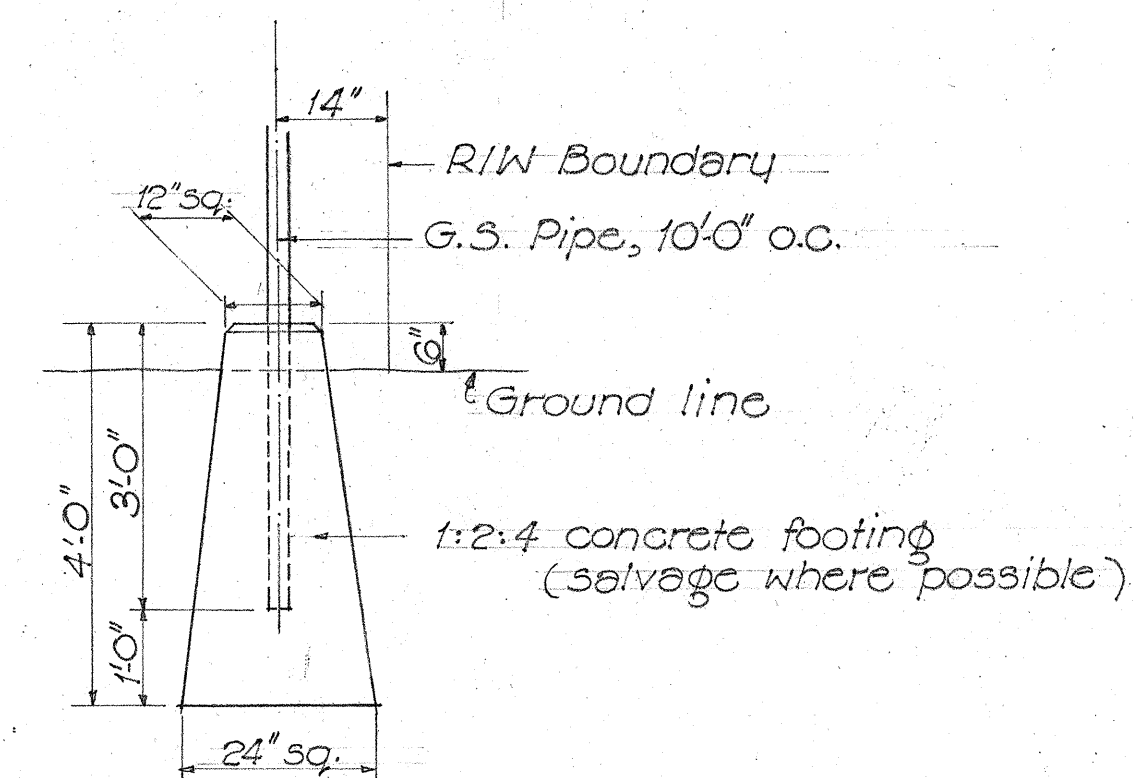


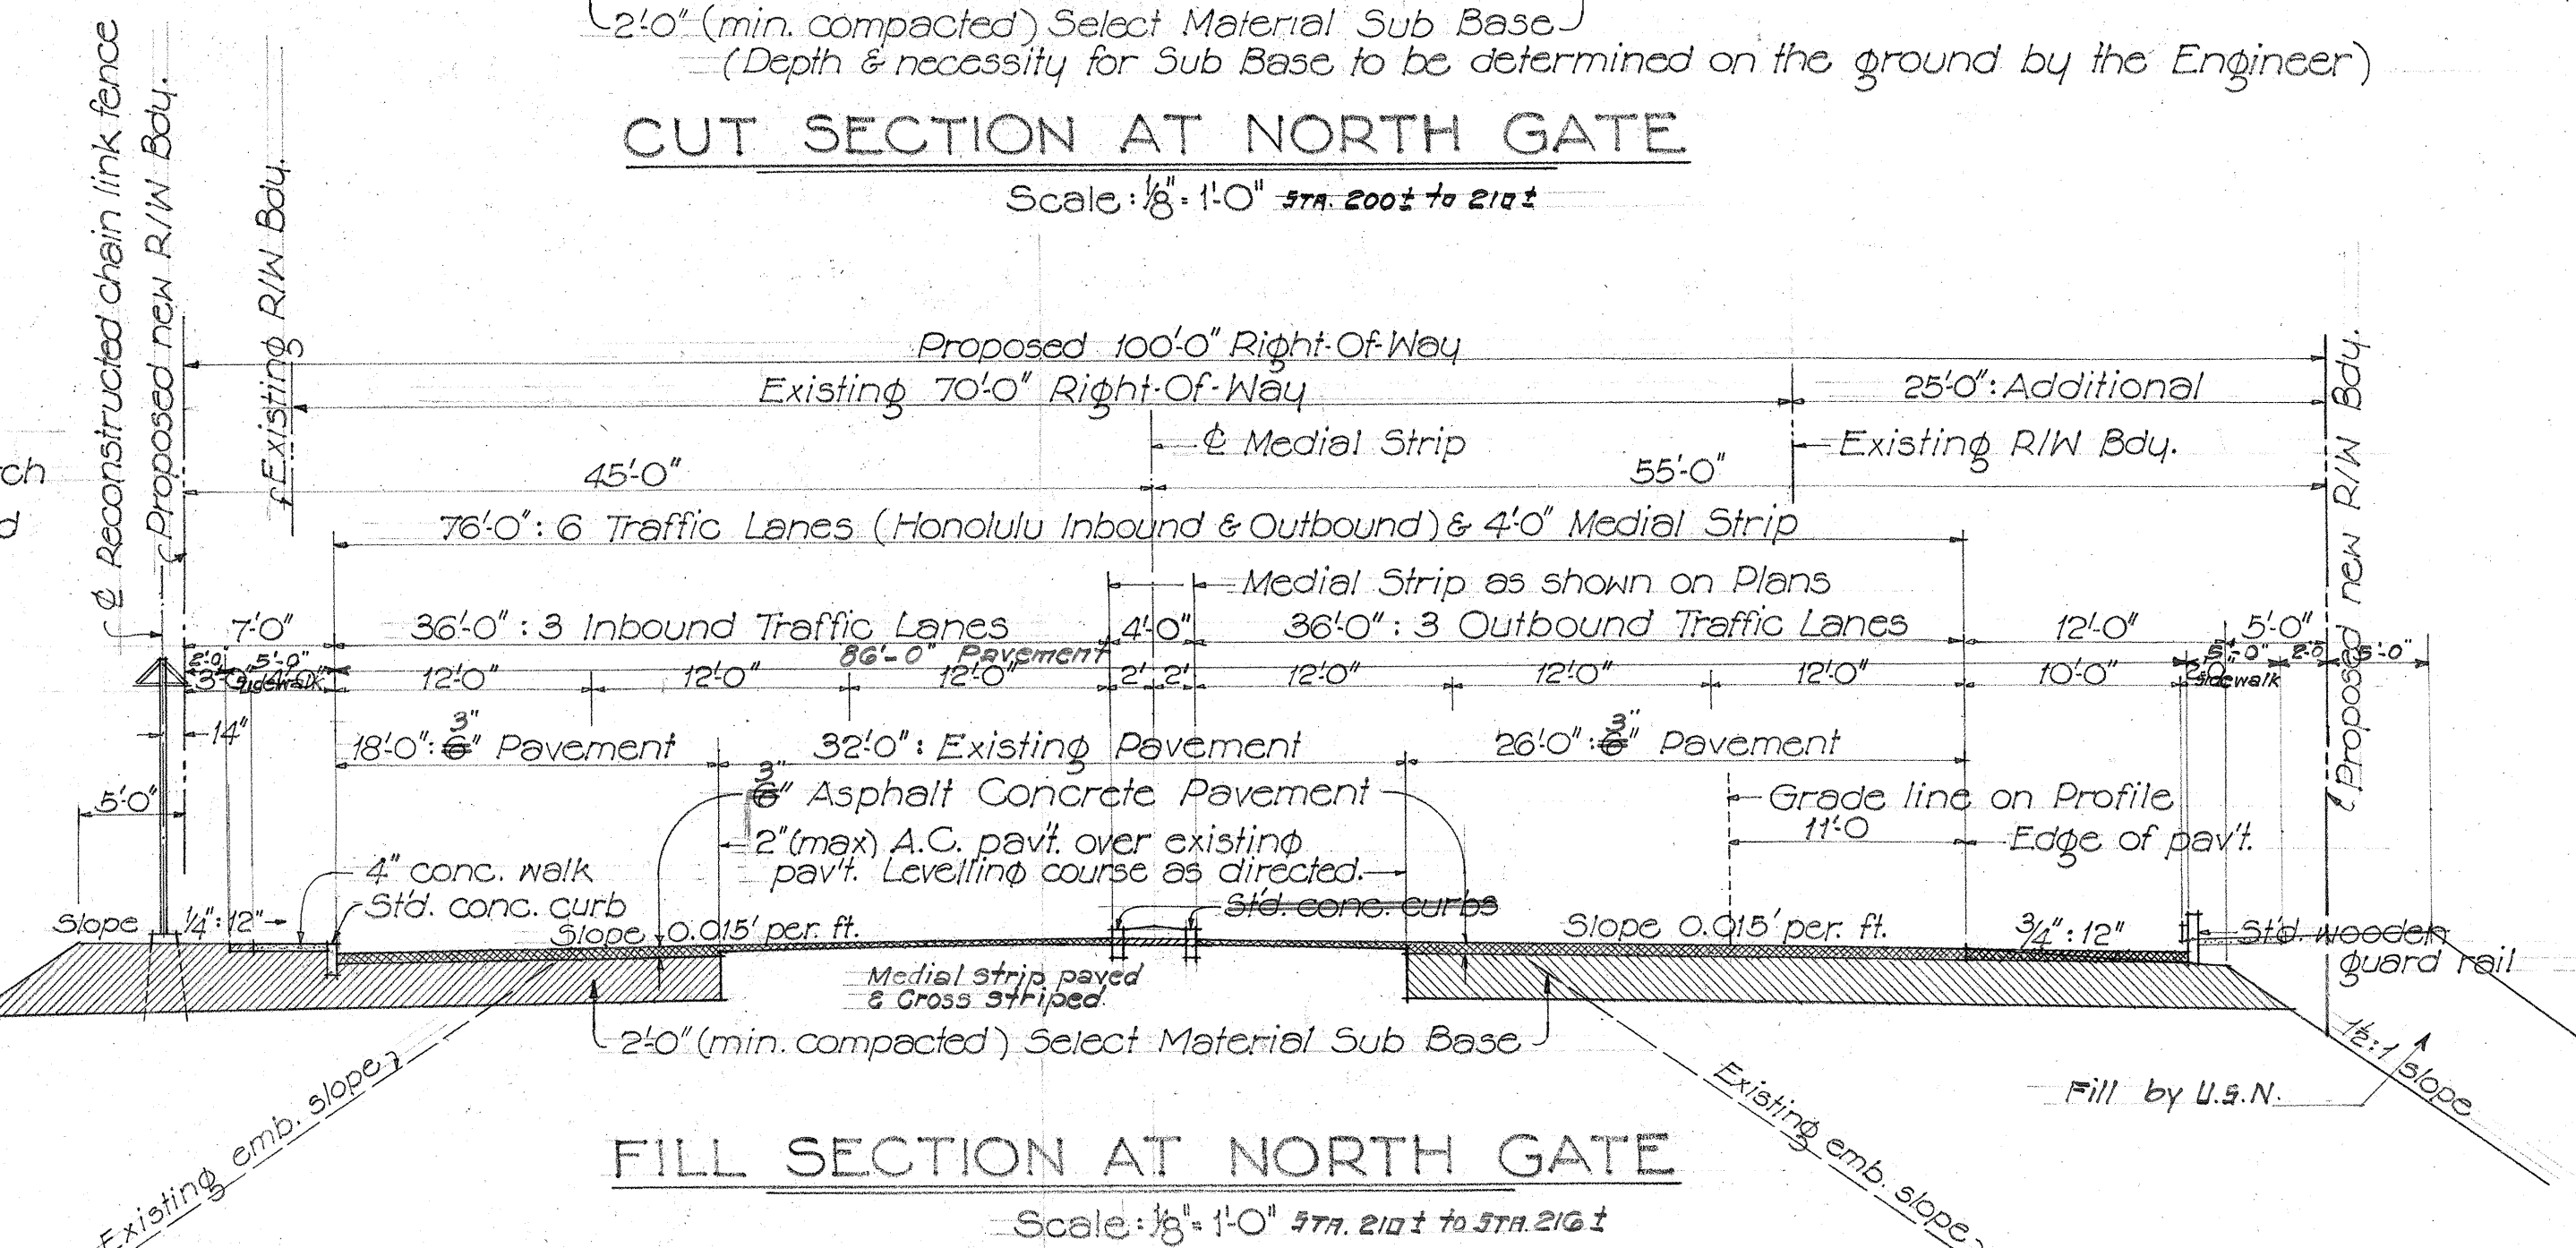

Note: The Engineer may omit Medial Strip as shown

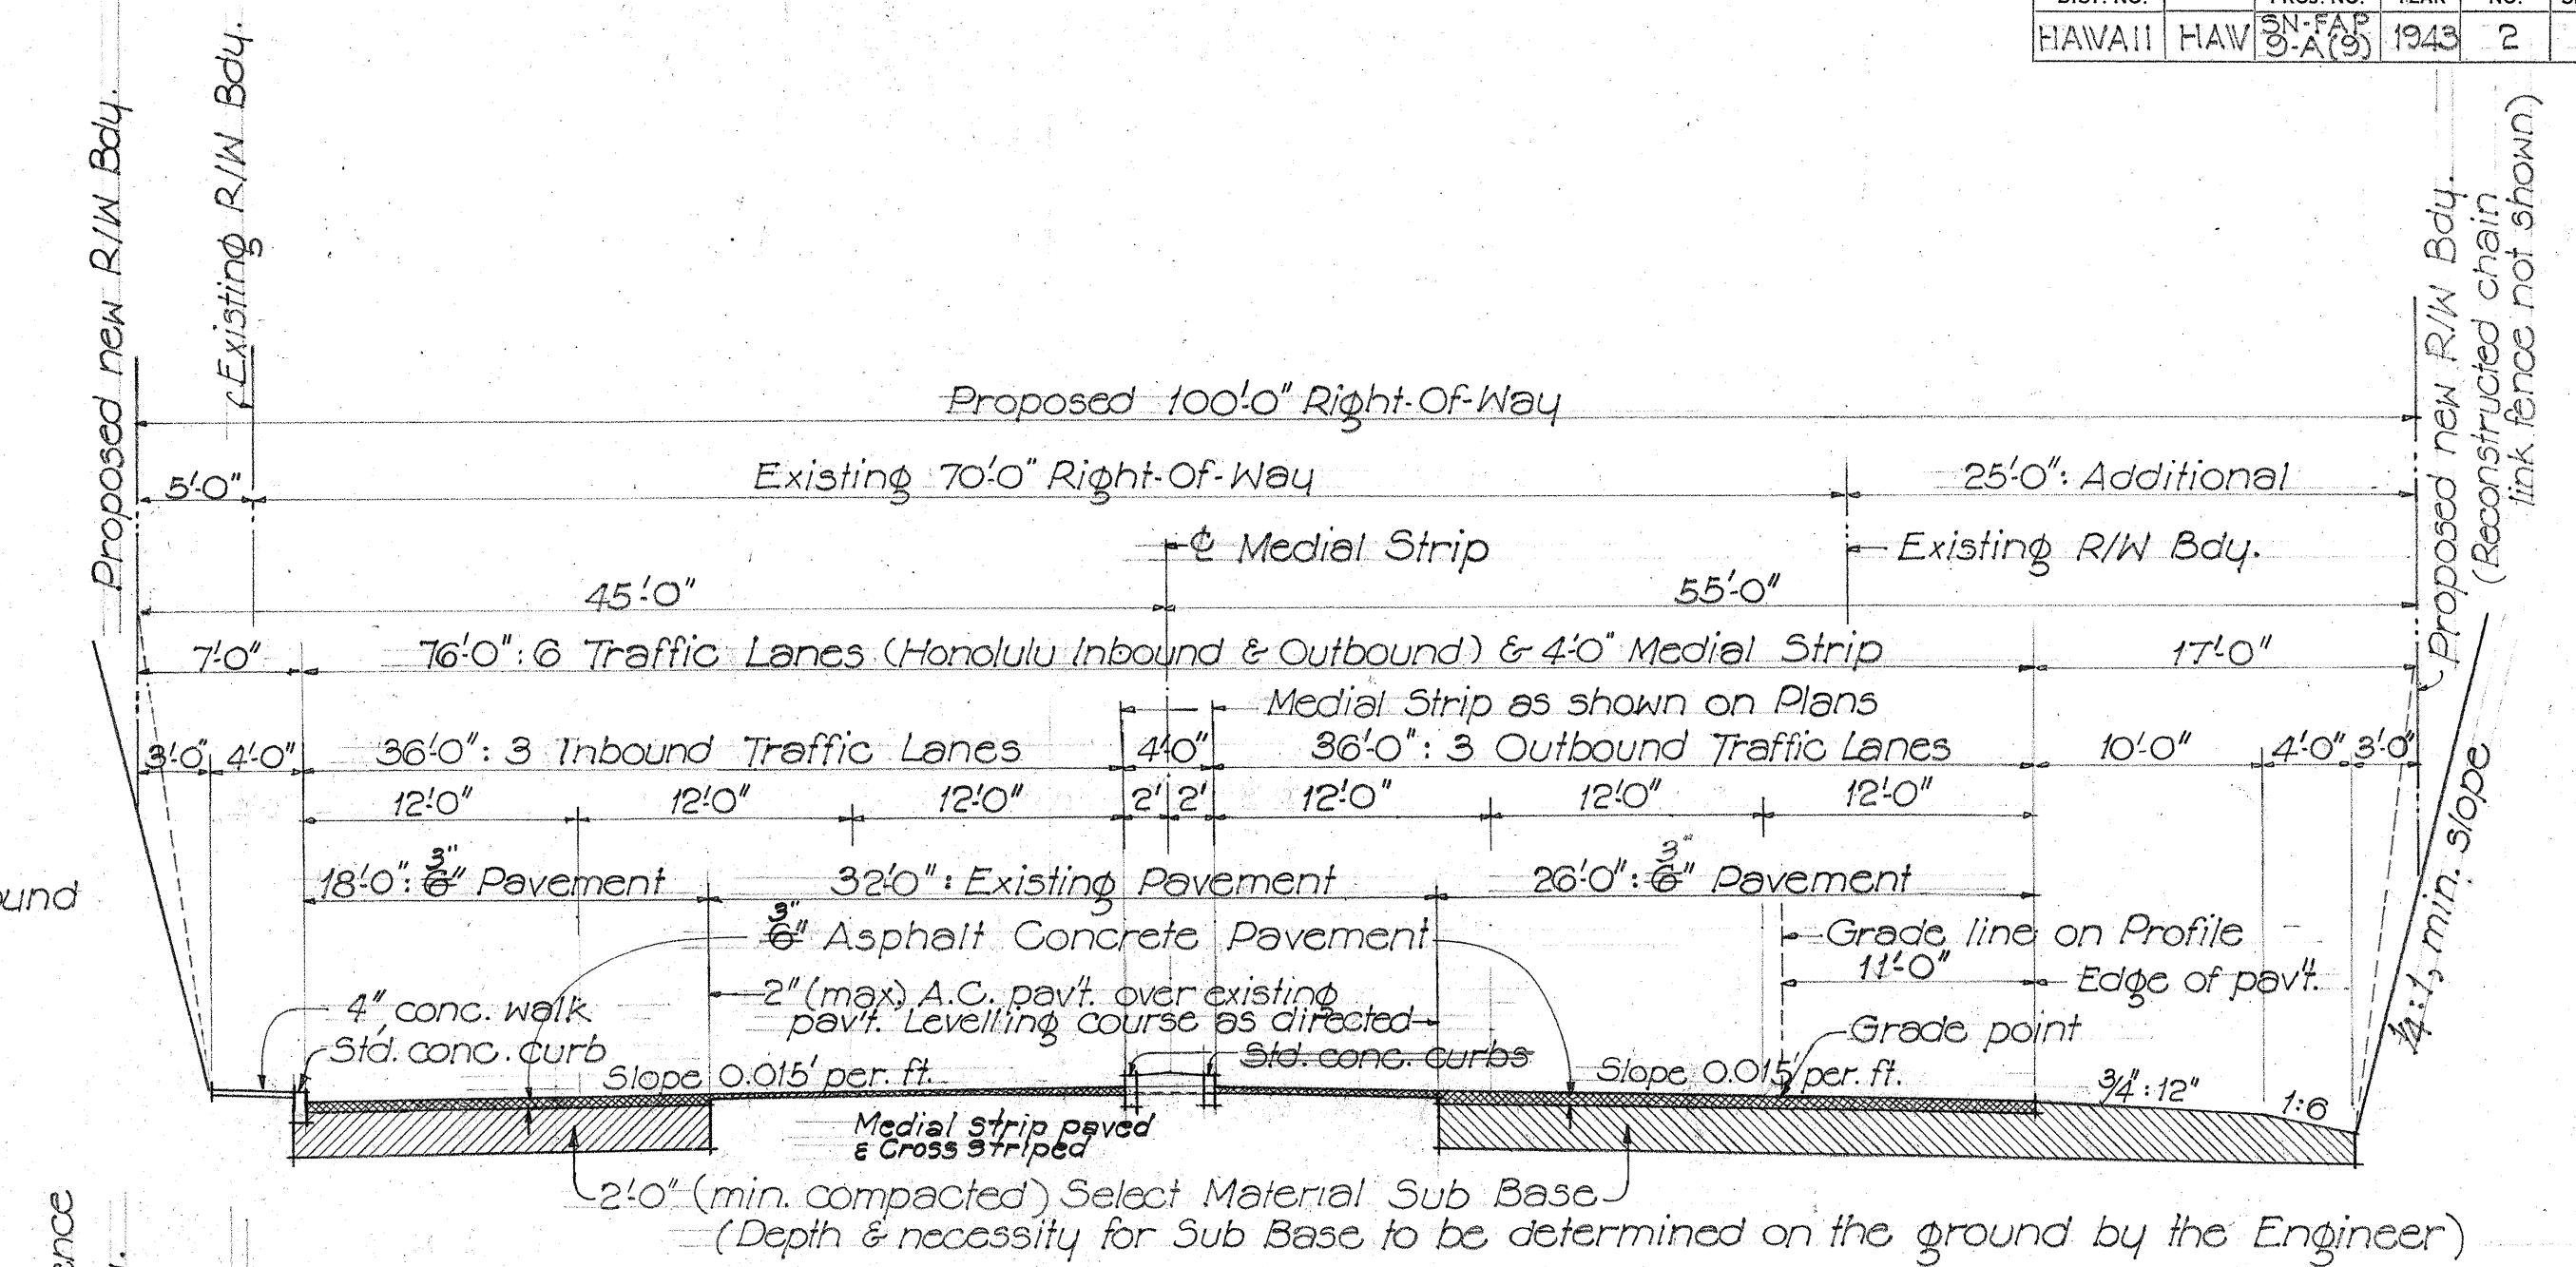

TERRITORIAL HIGHWAY DEPARTMENT
TERRITORY OF HAWAII
TYPICAL SECTIONS
PROJ. NO. SN-FAP 9-A(9)
Kamehameha Highway: From
Pearl Harbor Circle to North Gate
Scales as shown

1st Rev. ~ Nov. 1943
2nd Rev. ~ Apr. 1944

SURVEY PLOTTED BY: DATE: _____
DRAWN BY: _____
CHECKED BY: _____
ORIGINAL PLAN: _____
NOTE BOOK: _____