

FED. ROAD DIST. NO.	STATE	FED. AID PROJ. NO.	FISCAL YEAR	SHEET NO.	TOTAL SHEETS
HAWAII	HAW.	DAWR7(4)	1944	16	23

FED. ROAD DIST. NO.	STATE	FED. AID PROJ. NO.	FISCAL YEAR	SHEET NO.	TOTAL SHEETS
HAWAII	HAW.	38-A(2)	1944	37A	43

DATE	BY

DATE	BY

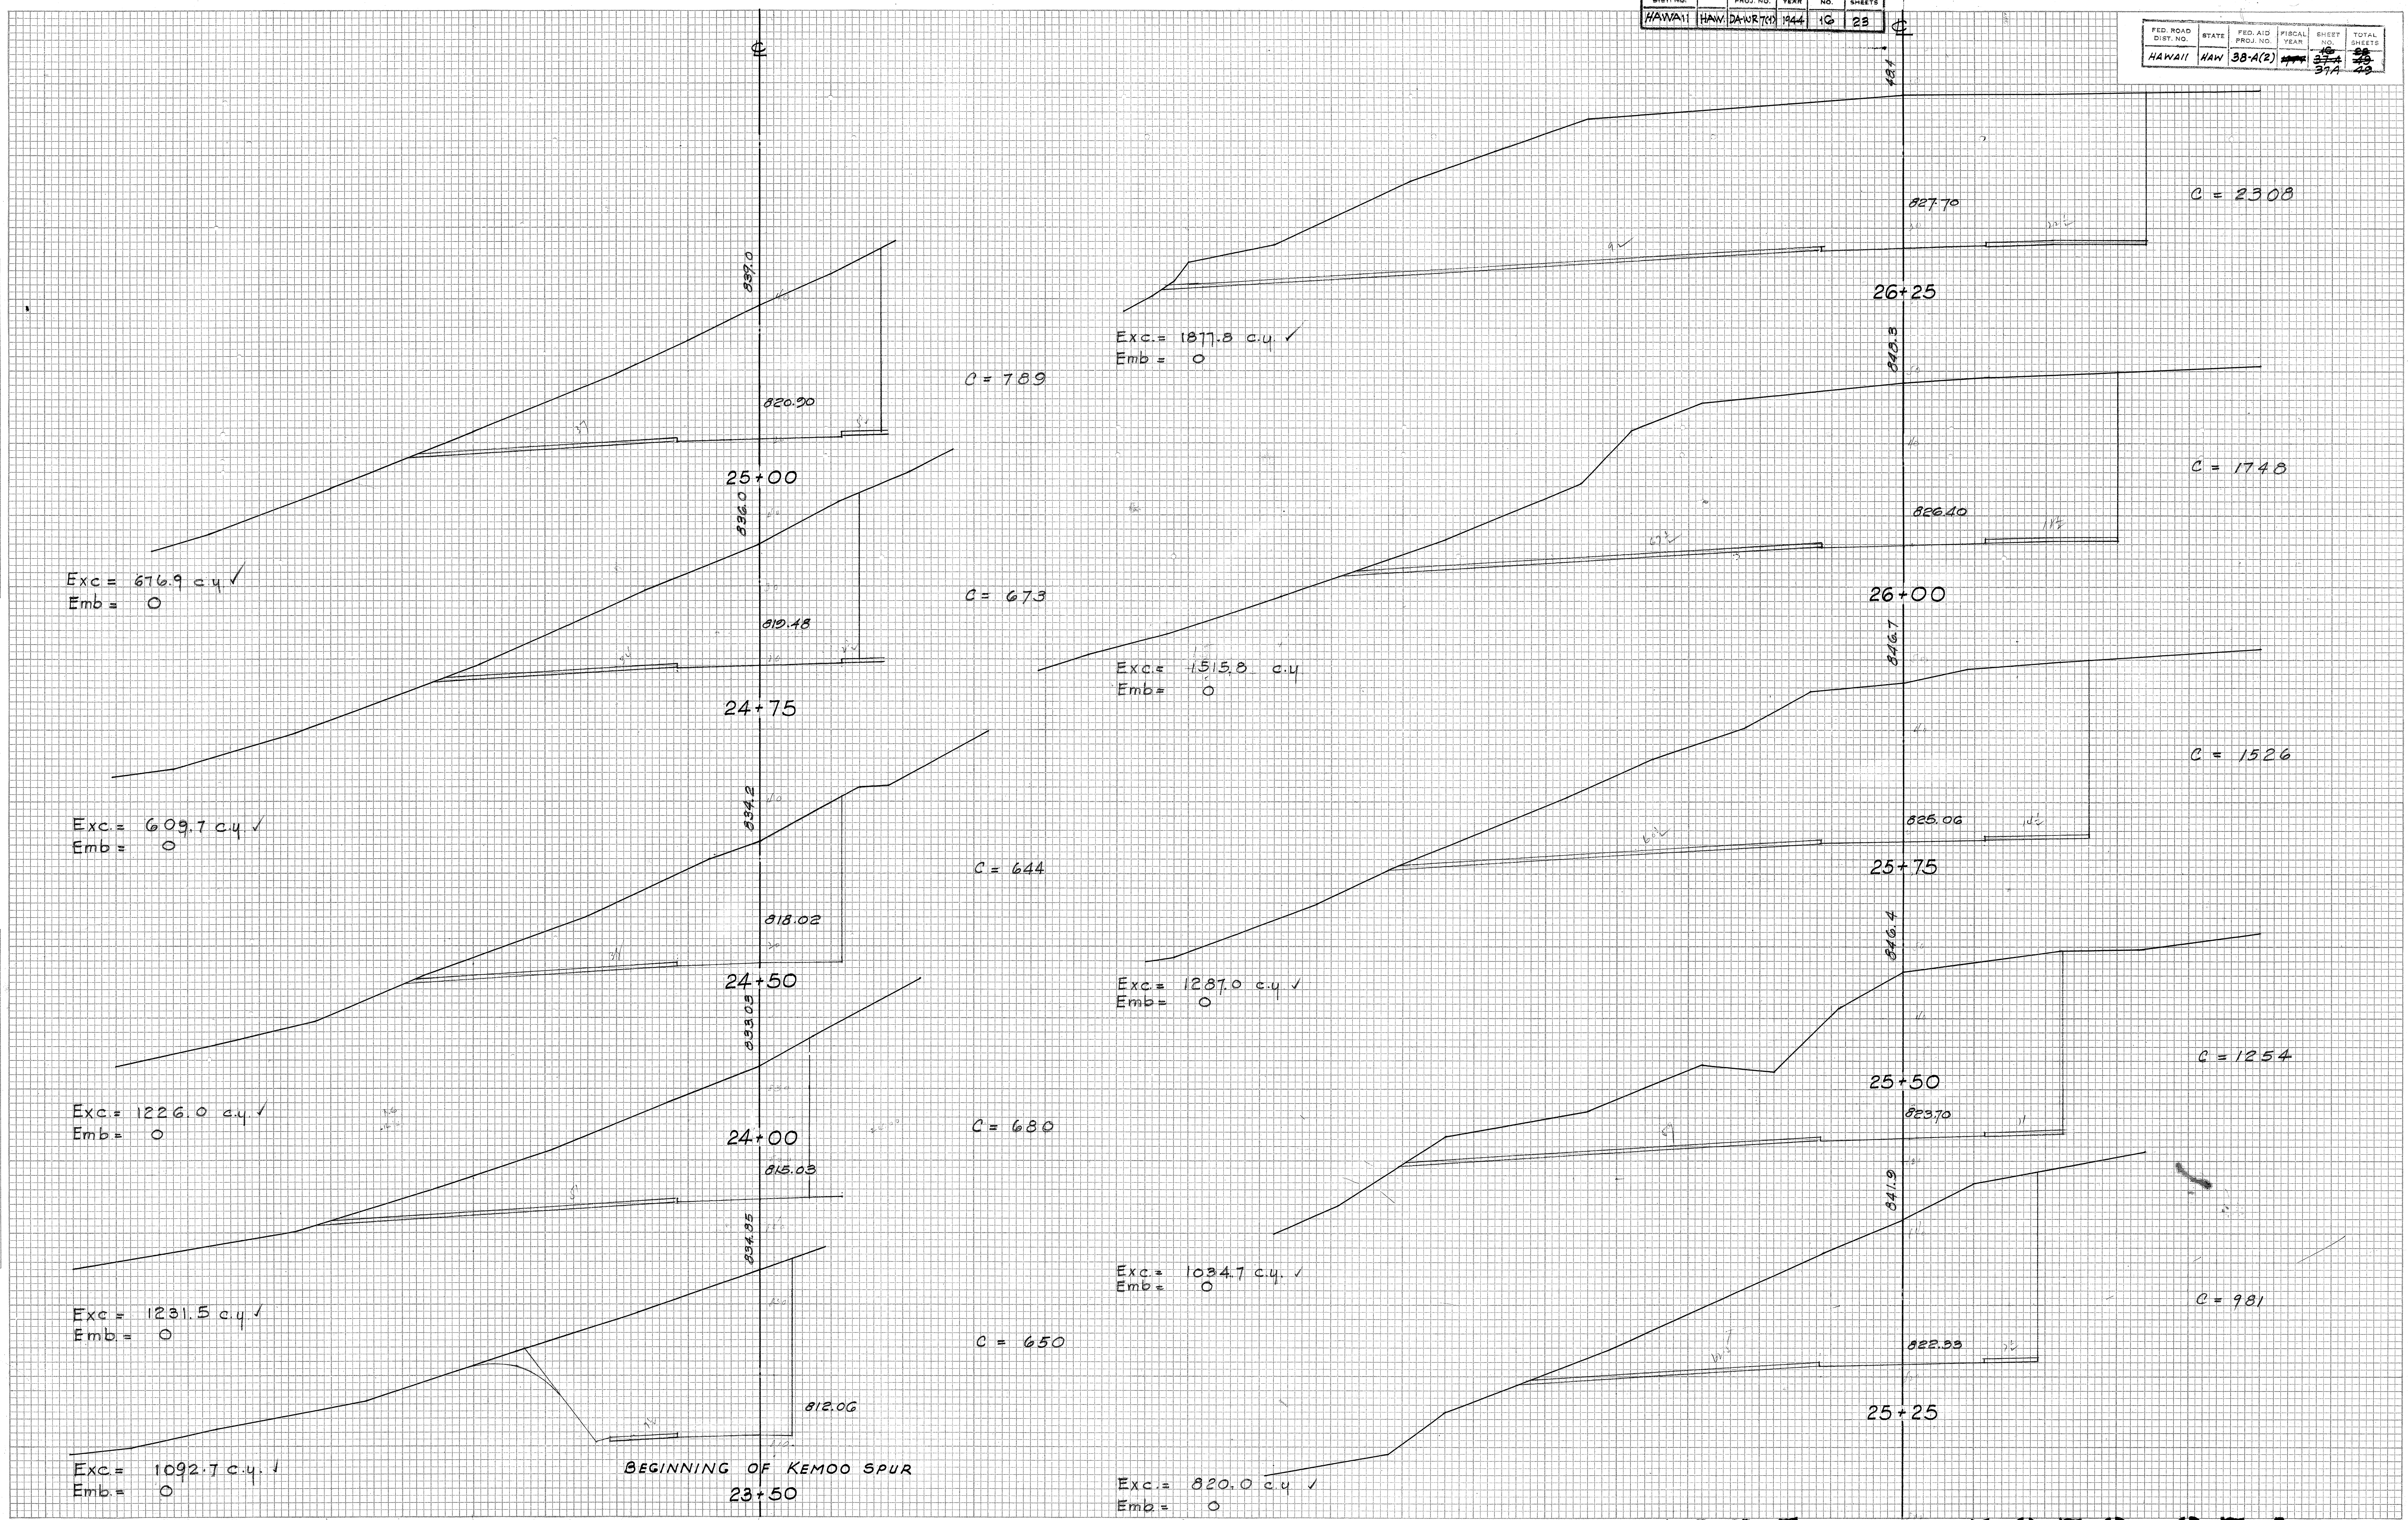


PLATE 3-CROSS SECTION O. P. R. & R. E. STANDARD
KEUFFEL & ESSER CO., NEW YORK.

5135.16 5072.37A

FED. ROAD DIST. NO.	STATE	FED. AID PROJ. NO.	FISCAL YEAR	SHEET NO.	TOTAL SHEETS
HAWAII	HAW	38-4(2)		37B	43

FED. ROAD DIST. NO.	STATE	FED. AID PROJ. NO.	FISCAL YEAR	SHEET NO.	TOTAL SHEETS
HAWAII	HAW	DA-WR-1944		17	23

DATE	BY	NO.

DATE	BY	NO.


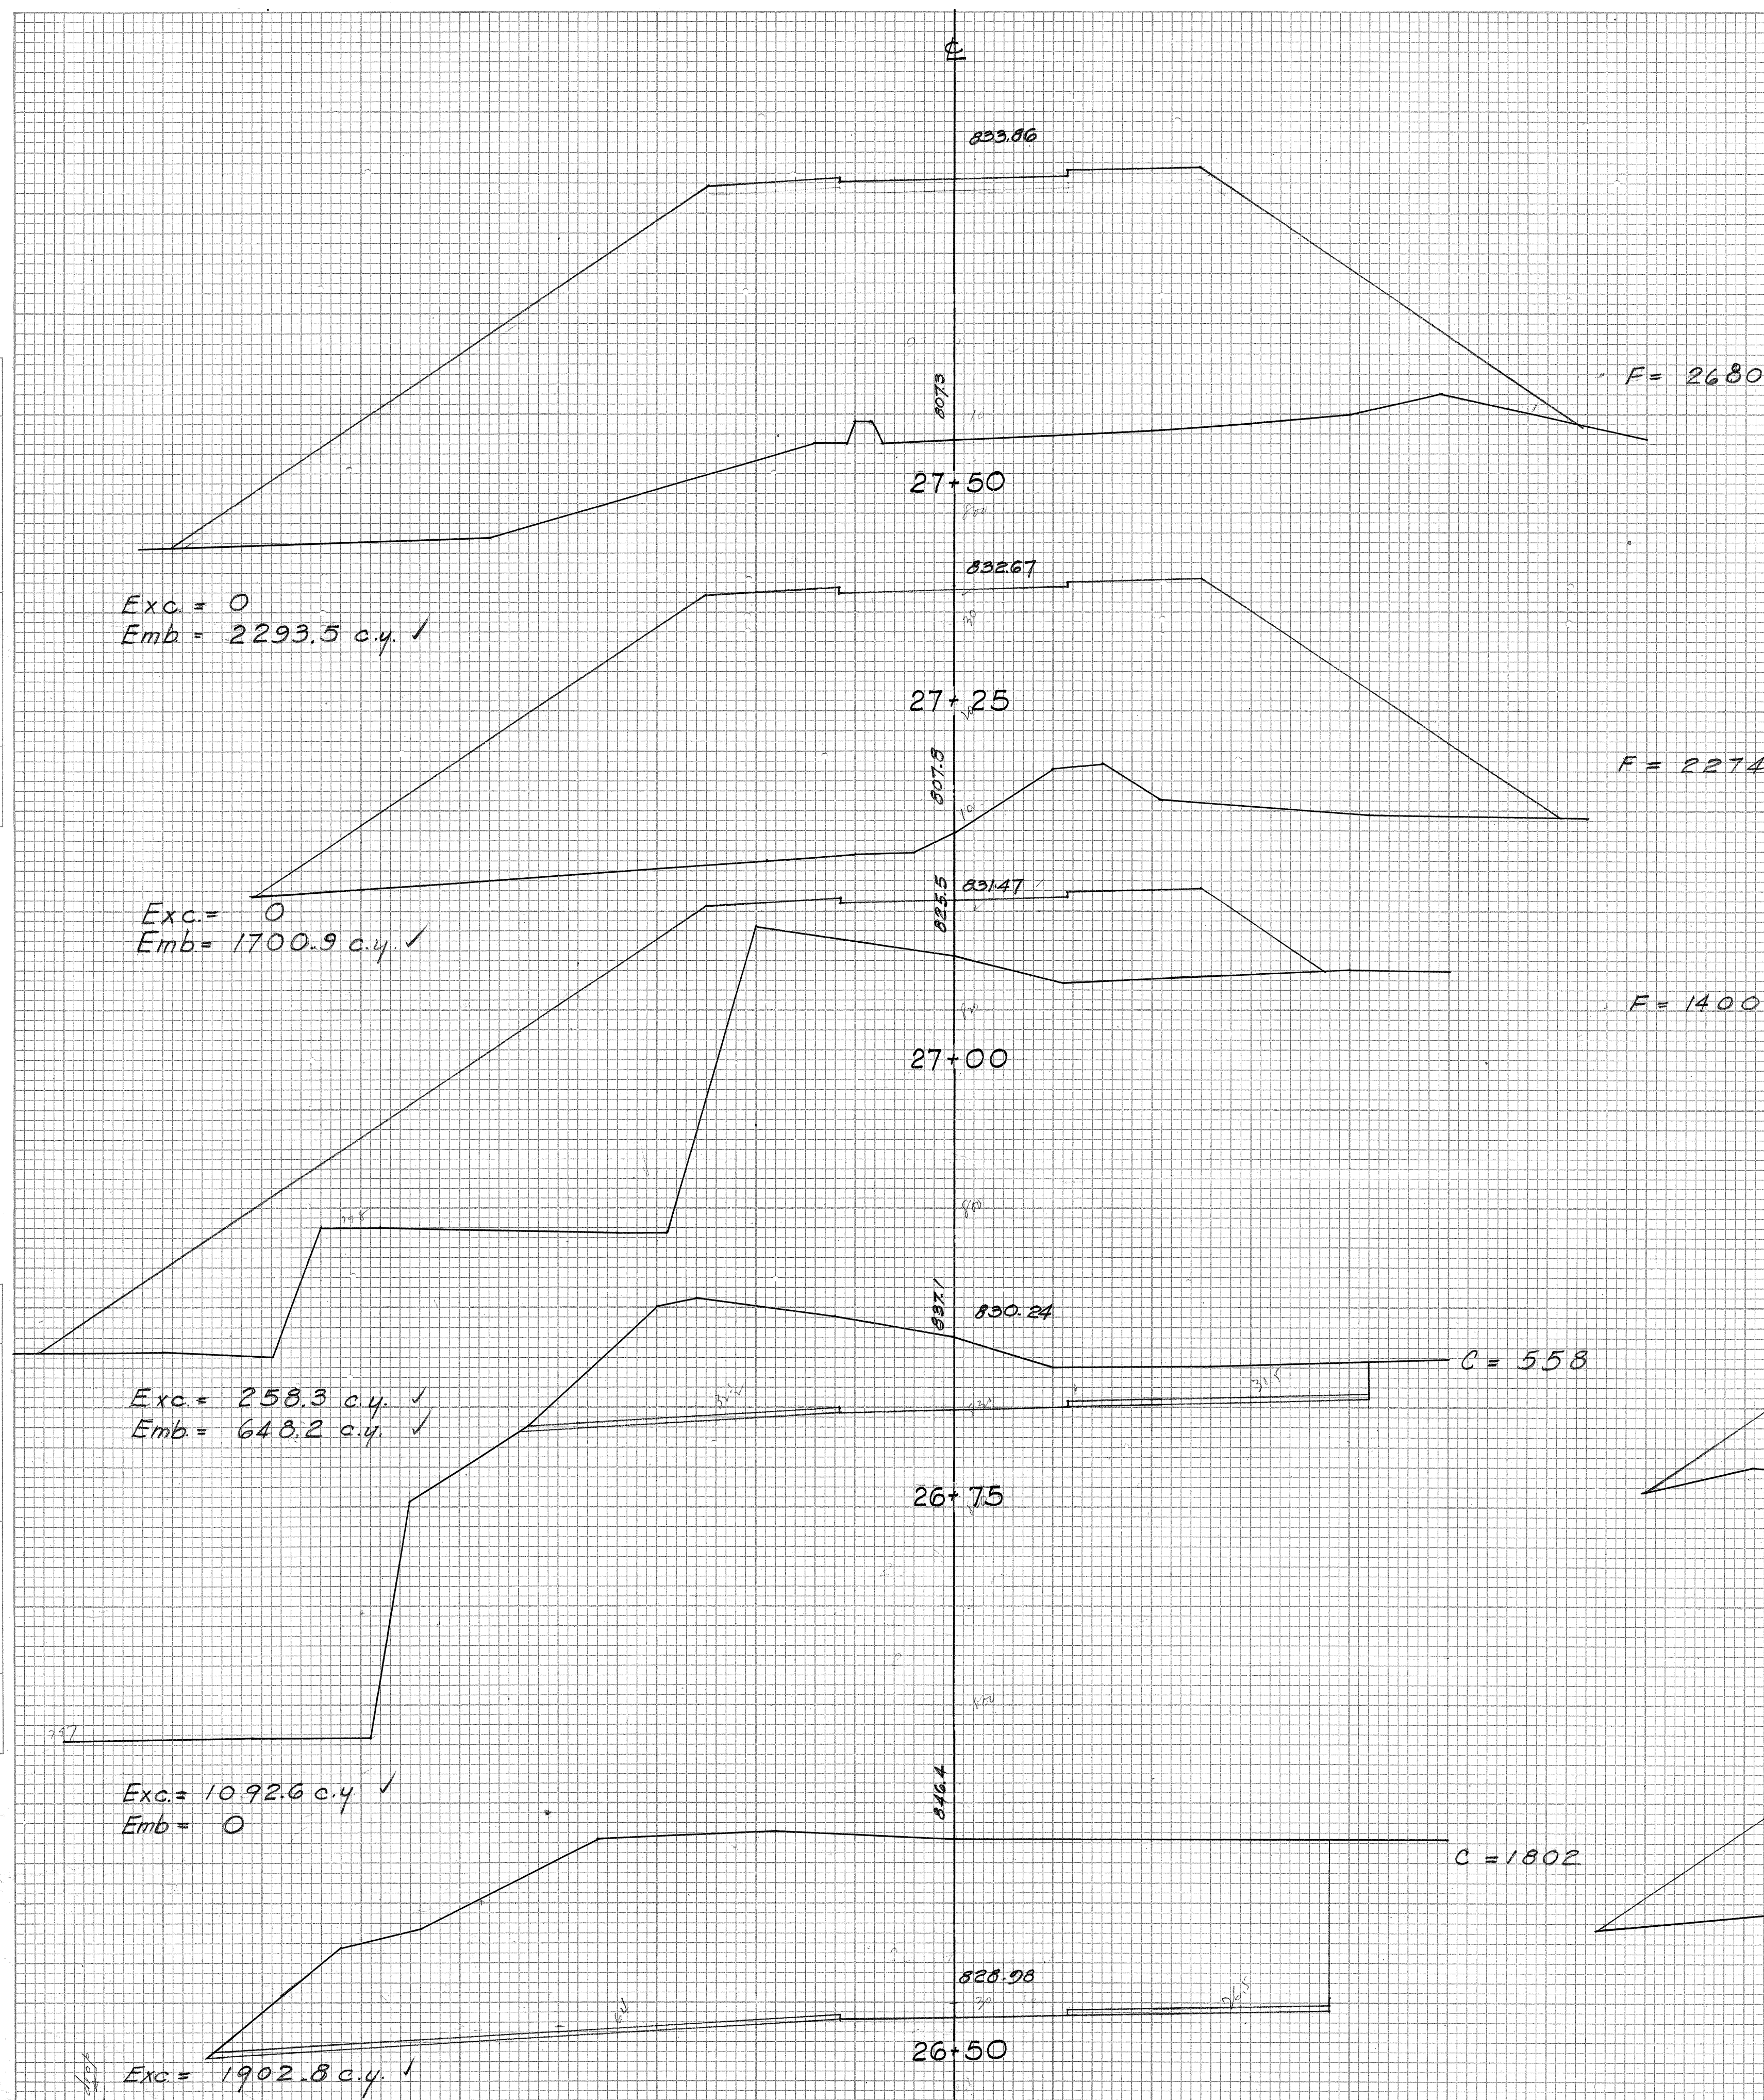


PLATE 3—CROSS SECTION O. P. R. & R. E. STANDARD
KEUFFEL & ESSER CO., NEW YORK.

MADE IN U. S. A. 20420

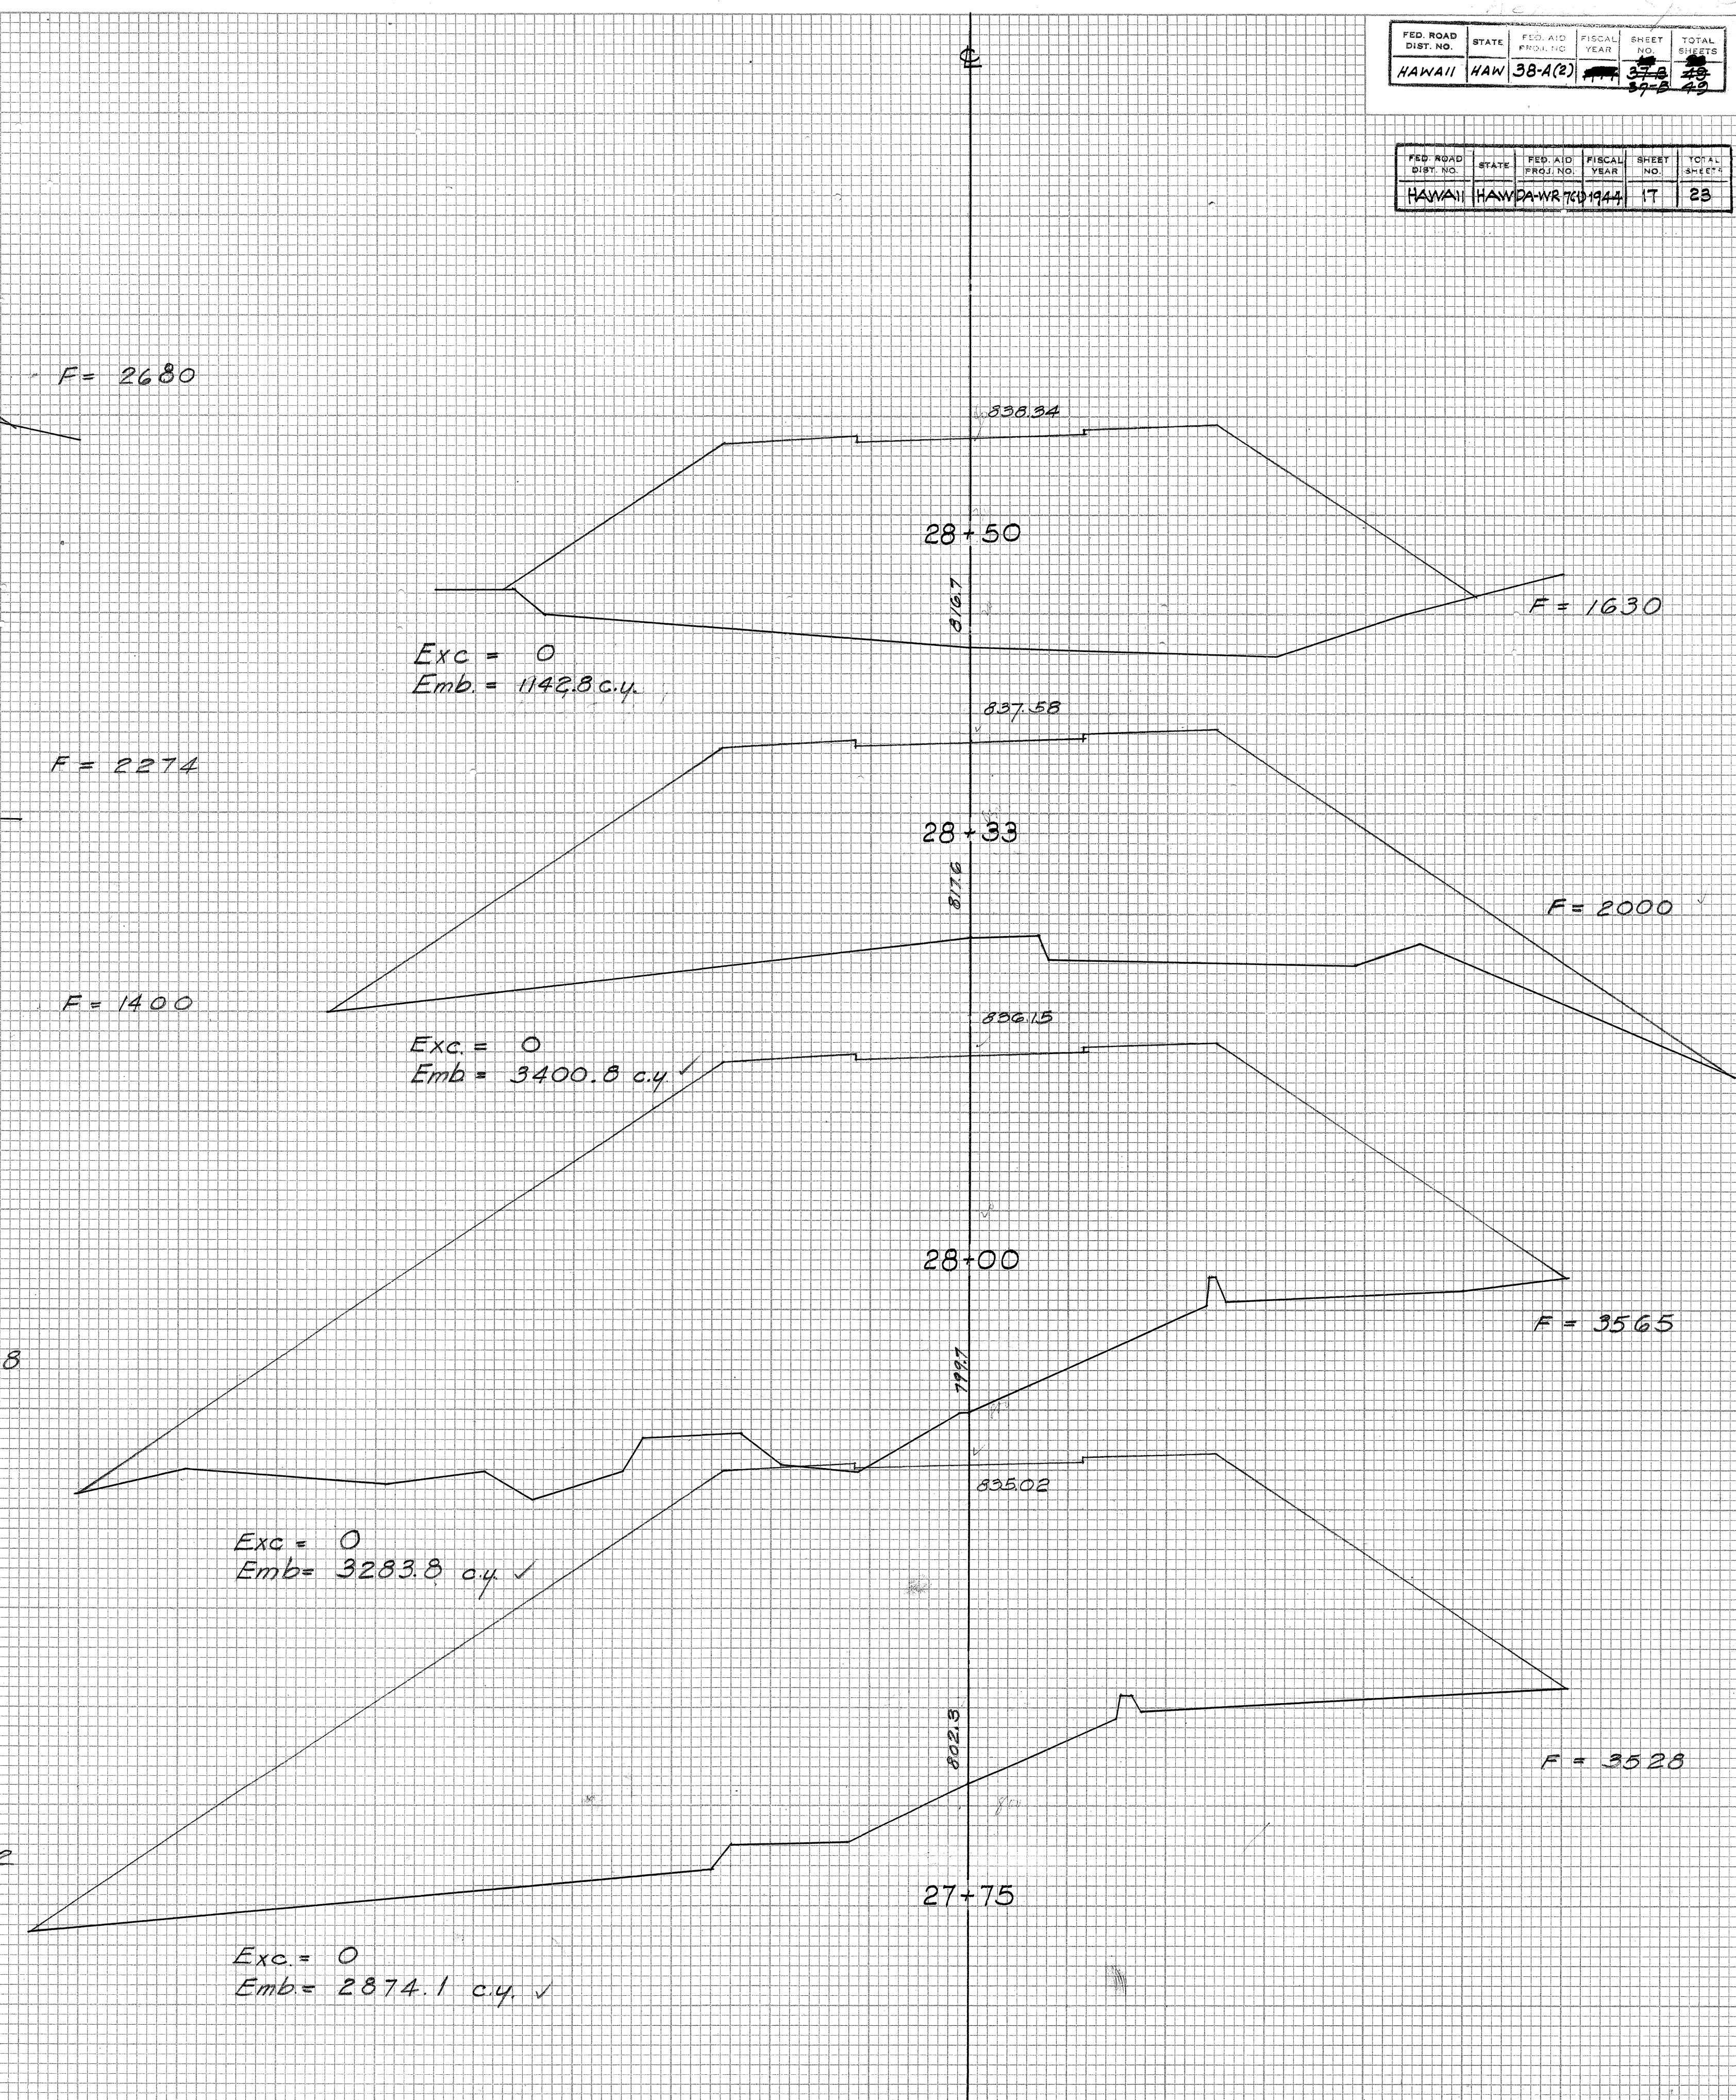



3135.17 5072.37B

FED. ROAD DIST. NO.	STATE	FED. AID PROJ. NO.	FISCAL YEAR	SHEET NO.	TOTAL SHEETS
HAWAII	HAW	38-A(2)	1941	38-A	49

FED. ROAD DIST. NO.	STATE	FED. AID PROJ. NO.	FISCAL YEAR	SHEET NO.	TOTAL SHEETS
HAWAII	HAW	DA-WR-10	1942	18	25

DATE	BY	NO.

DATE	BY	NO.

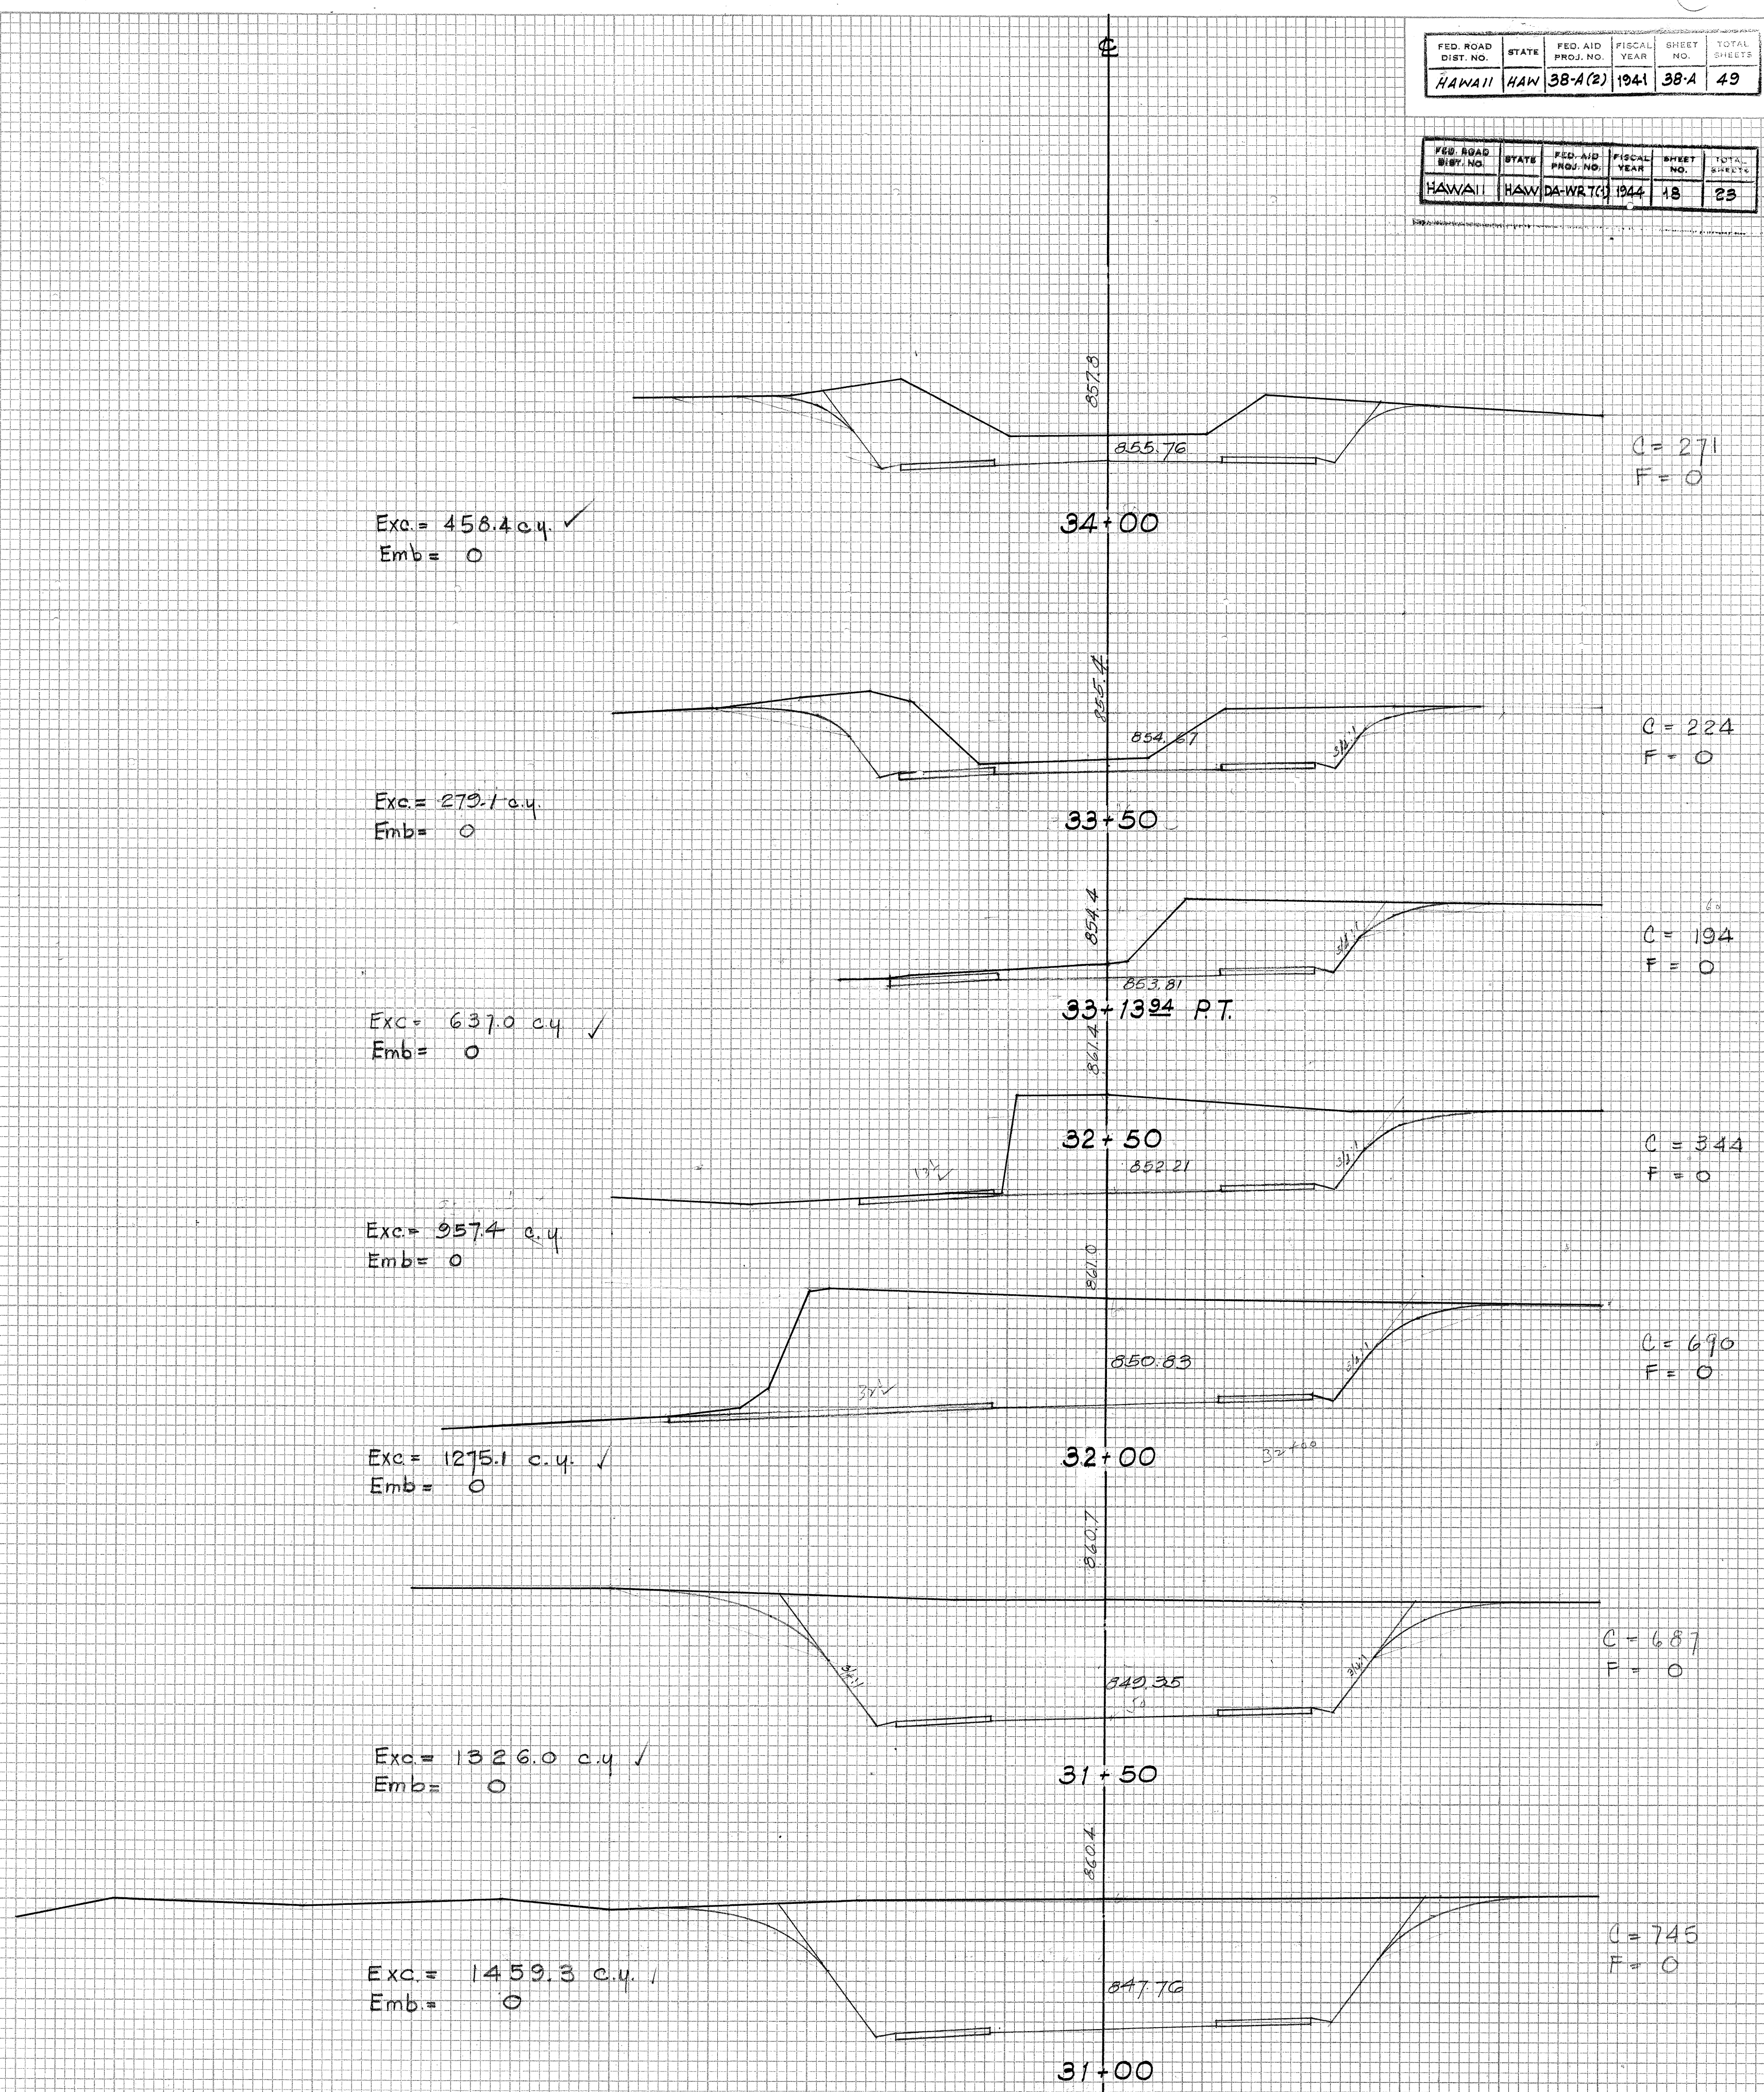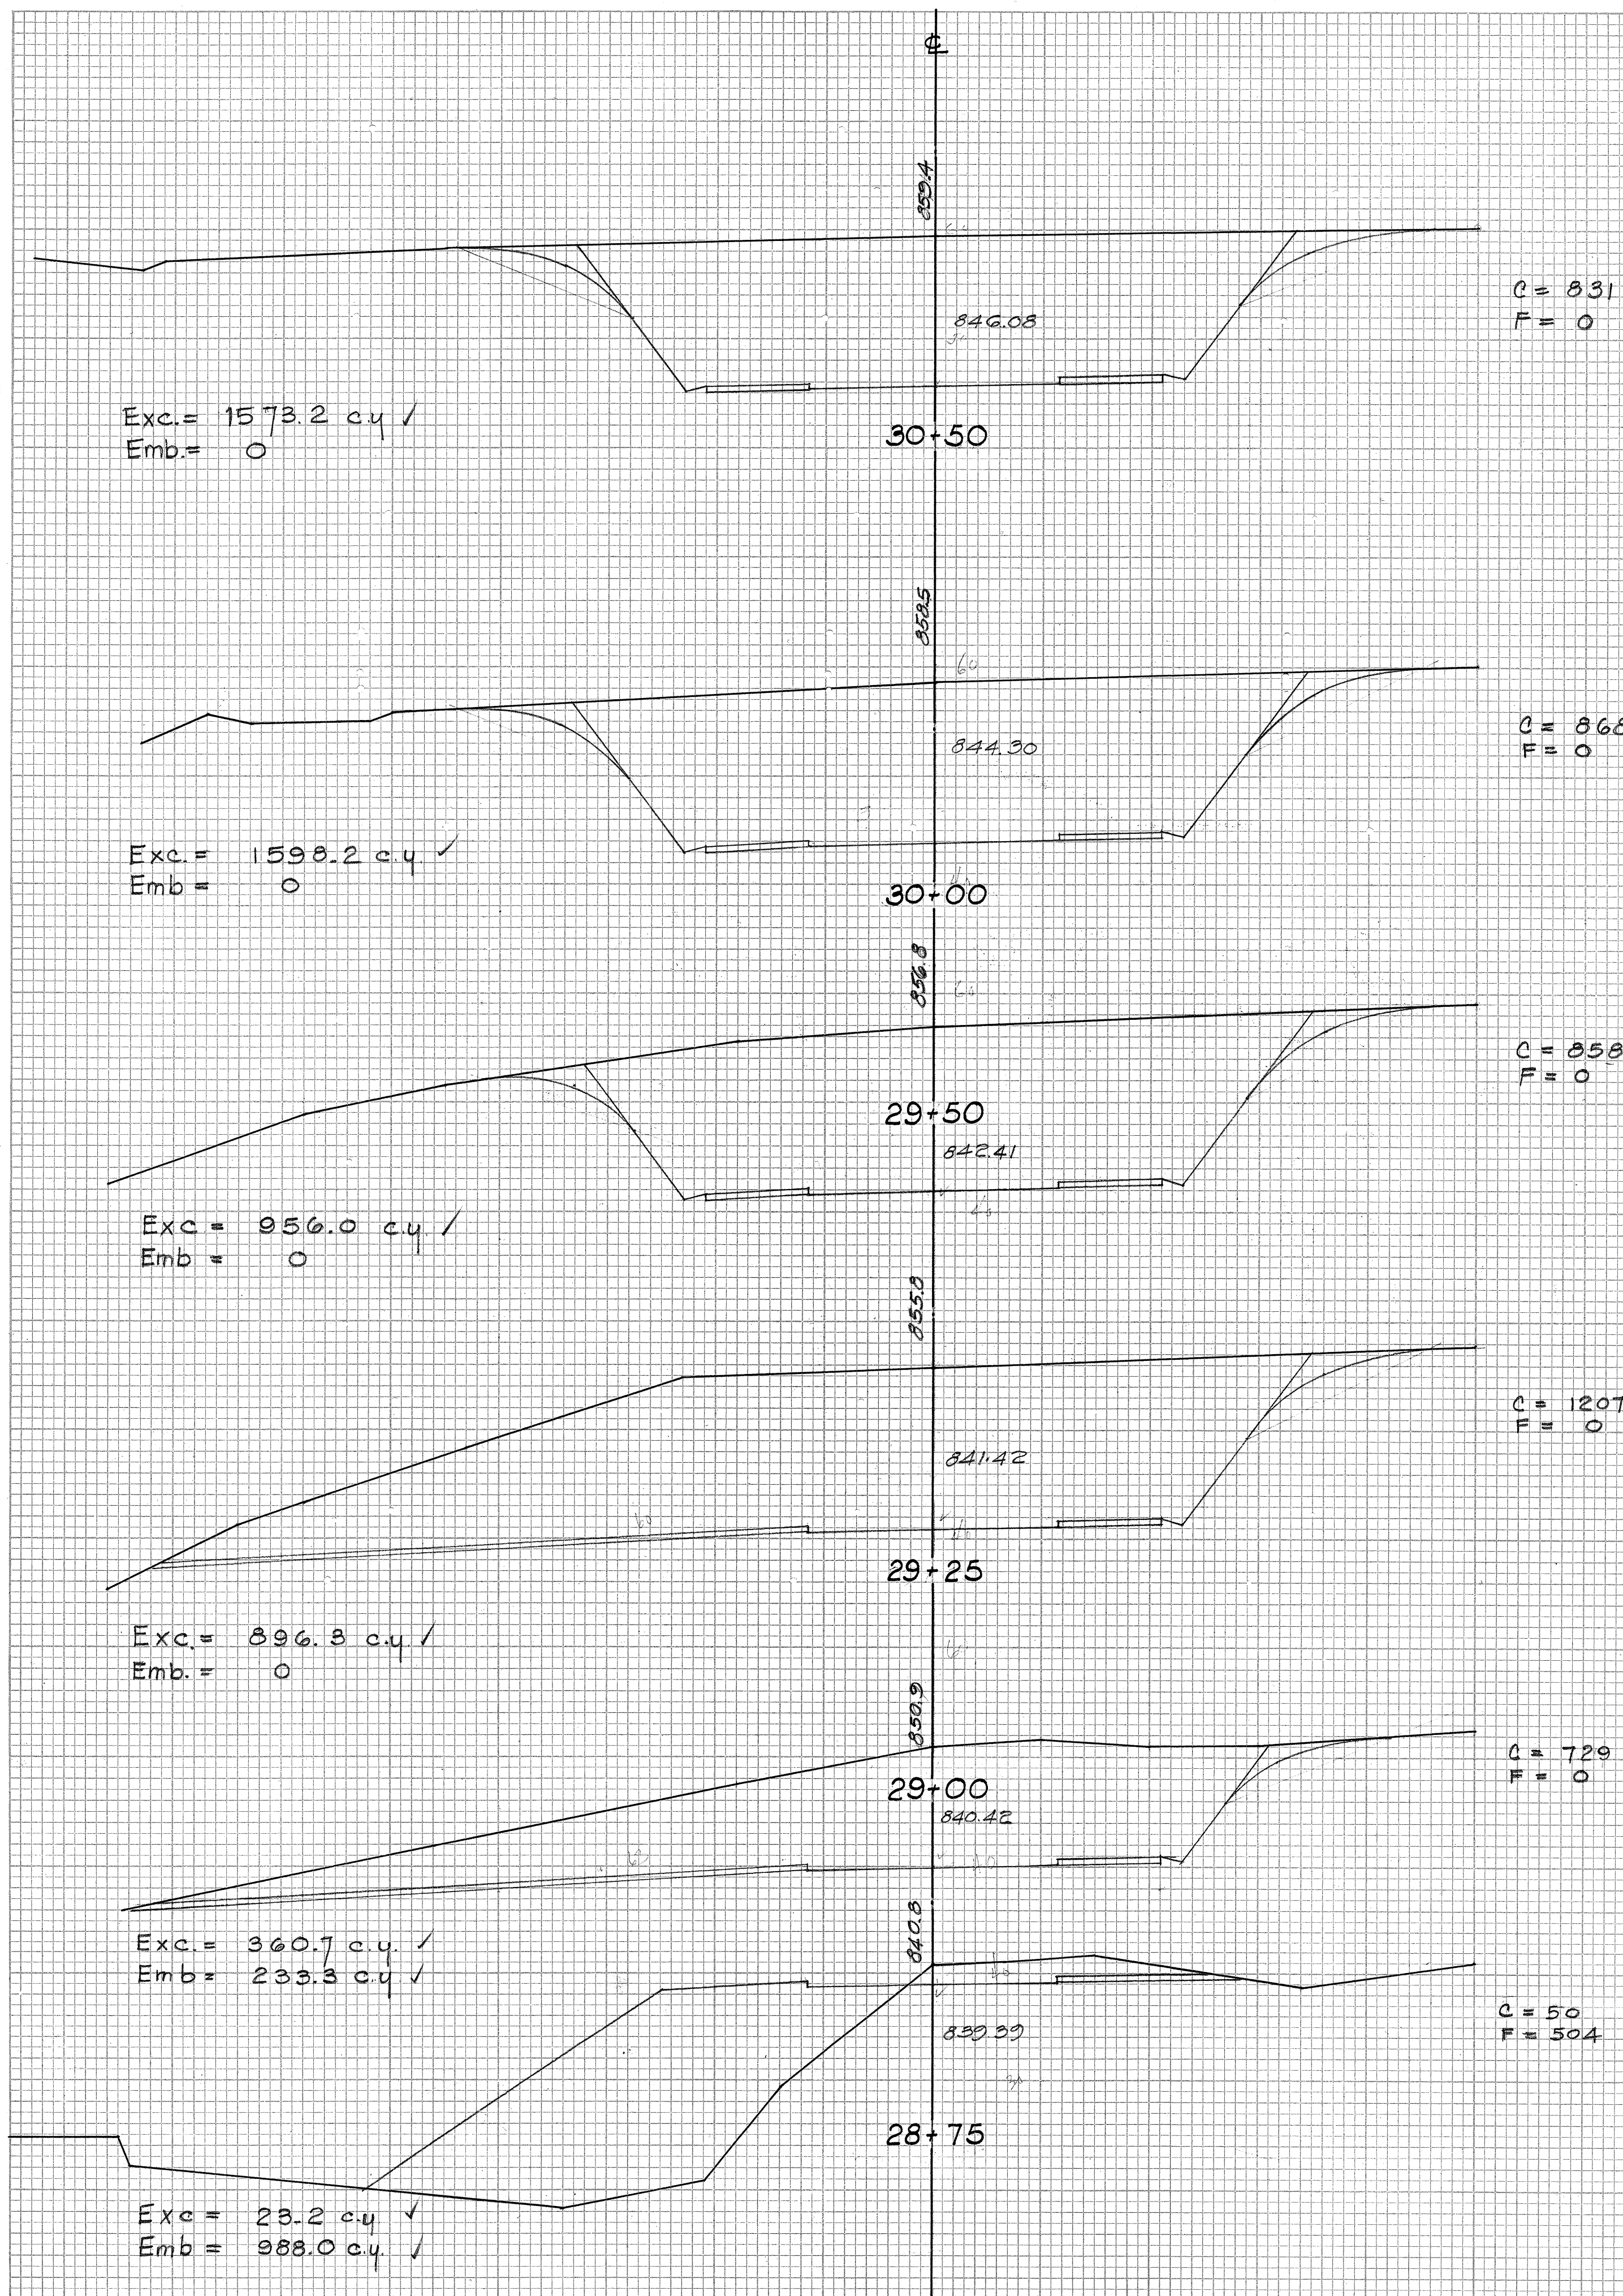


FINAL SURVEY PLOTTED
NOTE BOOK NO. 1
DATE BY

ORIGINAL SURVEY PLOTTED
NOTE BOOK NO. 1
DATE BY

FED. ROAD DIST. NO.	STATE	FED. AID PROJ. NO.	FISCAL YEAR	SHEET NO.	TOTAL SHEETS
HAWAII	HAW	38-A(2)	1941	39-A	49

FED. ROAD DIST. NO.	STATE	FED. AID PROJ. NO.	FISCAL YEAR	SHEET NO.	TOTAL SHEETS
HAWAII	HAW	DA-WR-10	1944	19	29

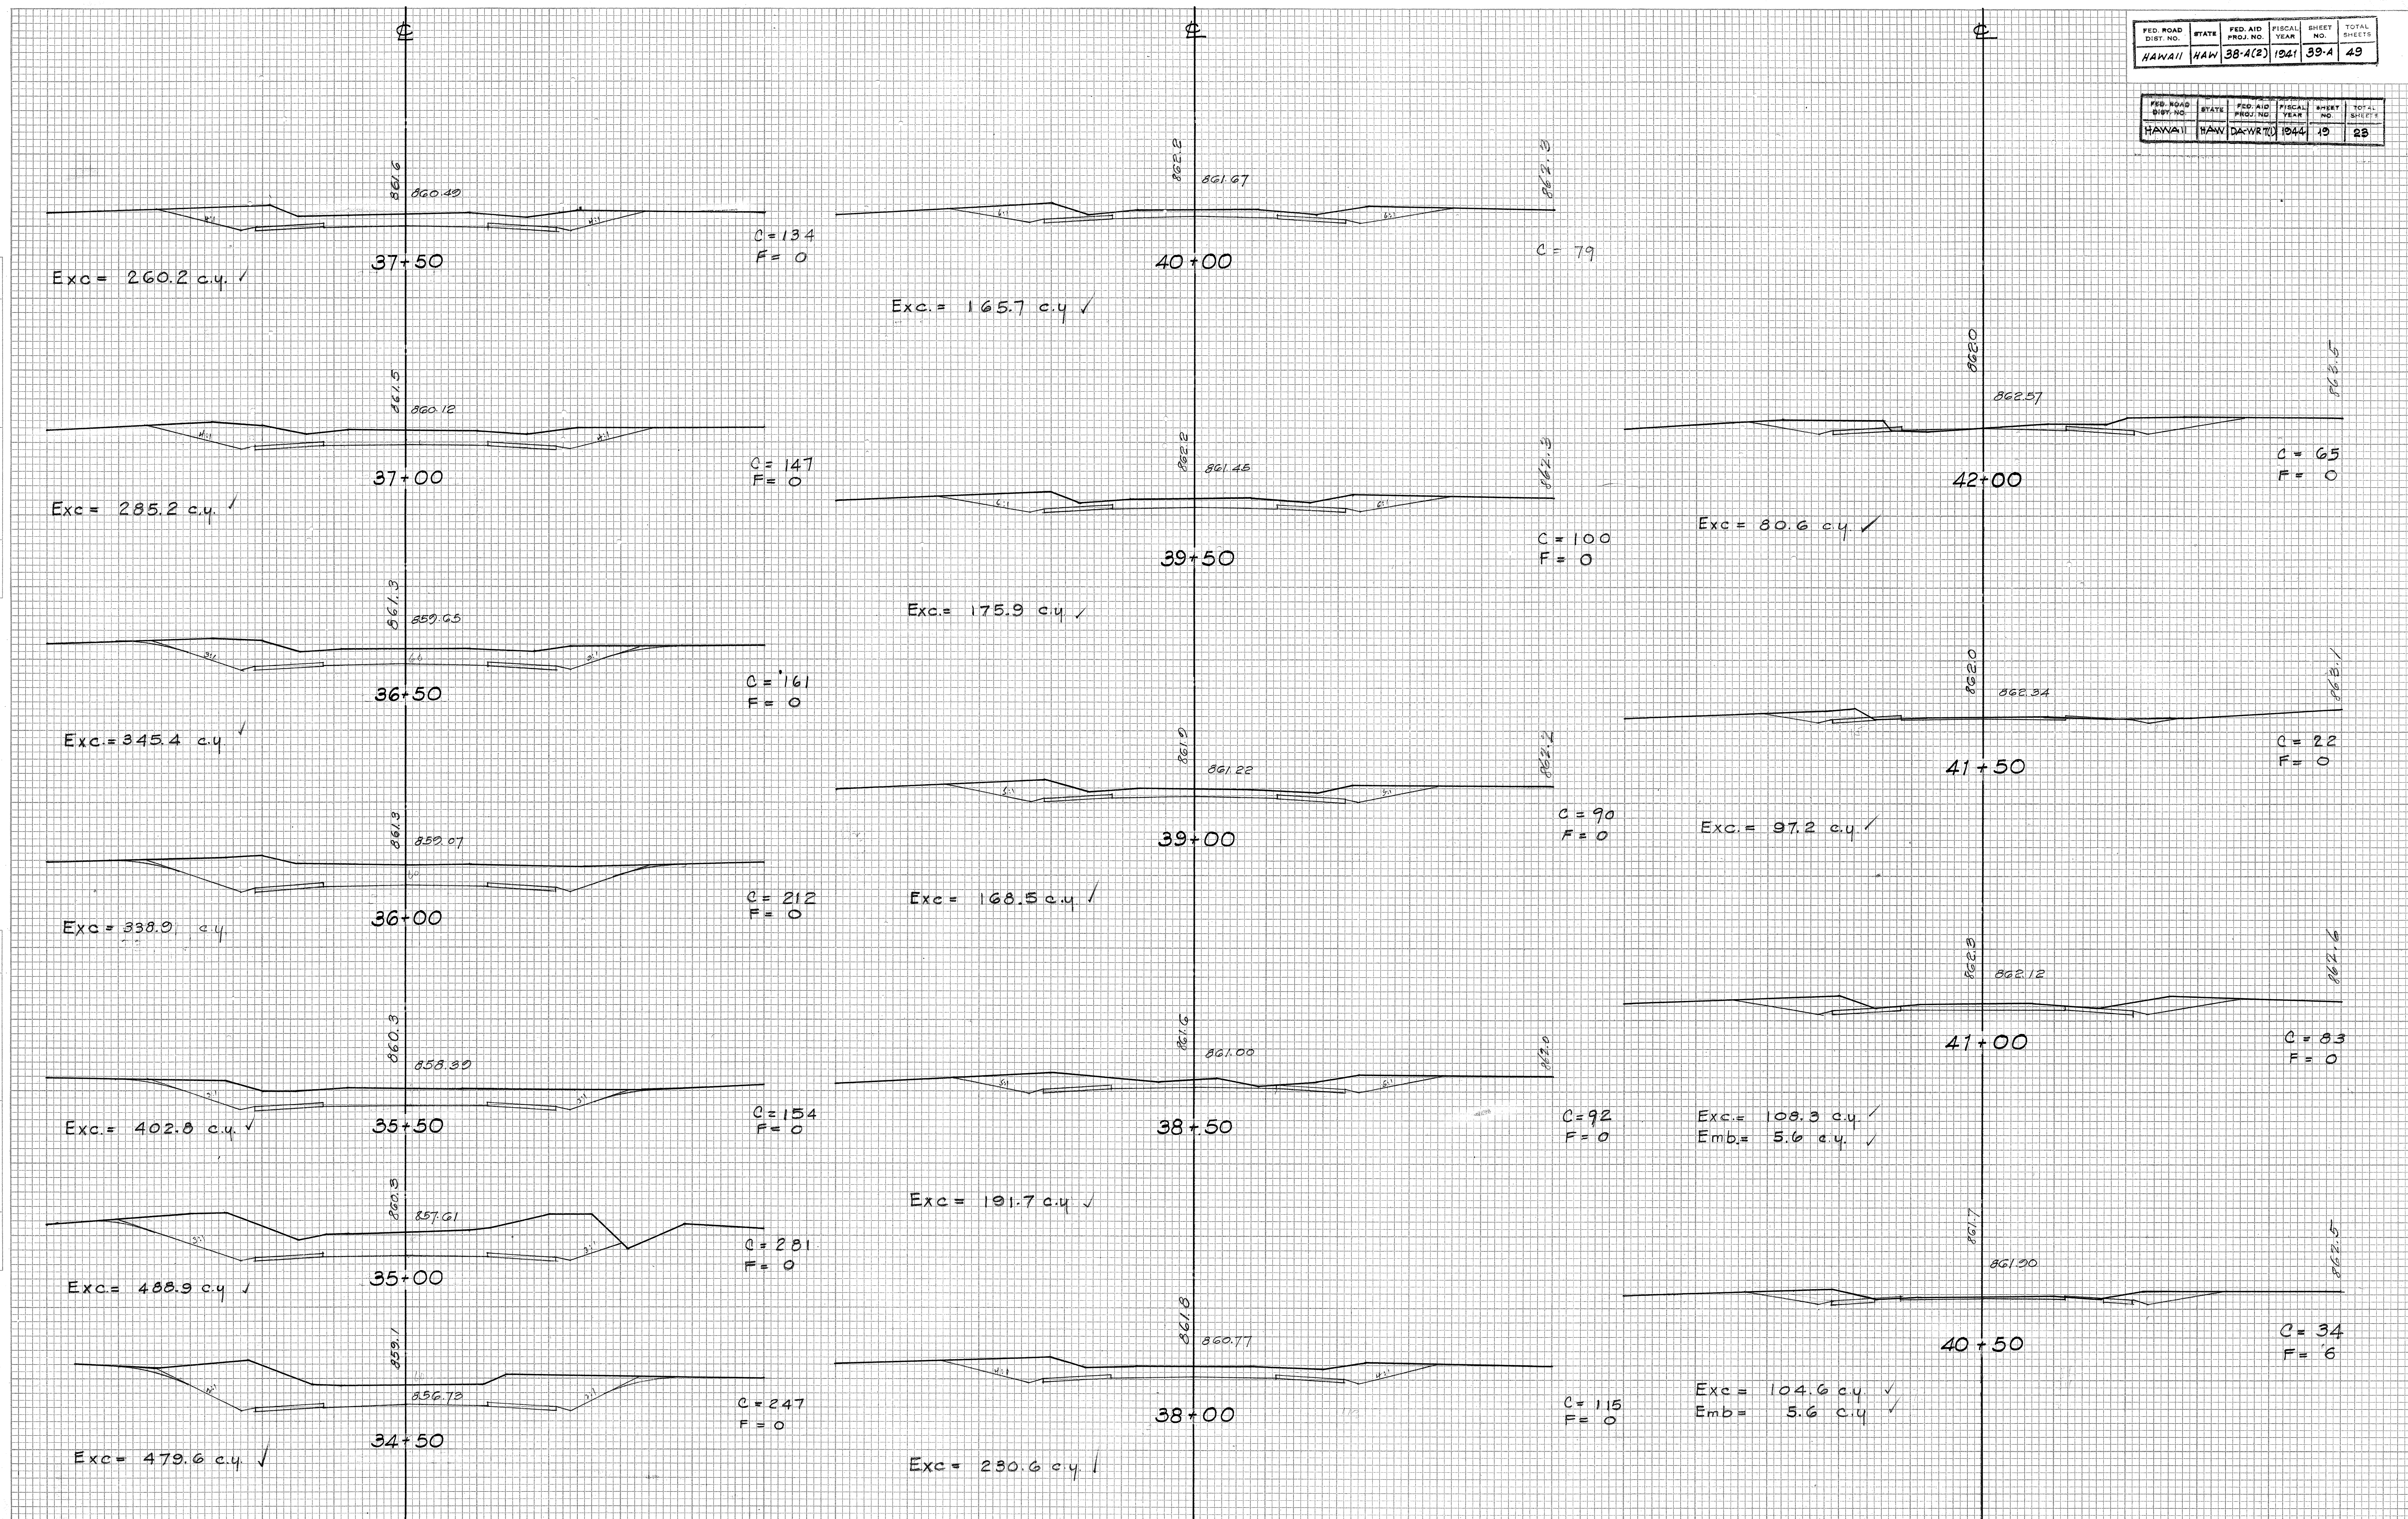


H-10

FED. ROAD DIST. NO.	STATE	FED. AID PROJ. NO.	FISCAL YEAR	SHEET NO.	TOTAL SHEETS
HAWAII	HAW	38-A(2)	1941	40-A	49

FED. ROAD DIST. NO.	STATE	FED. AID PROJ. NO.	FISCAL YEAR	SHEET NO.	TOTAL SHEETS
HAWAII	HAW	DAWR(1)	1944	20	23

DATE _____ BY _____
NO. _____
FINAL SURVEY _____
NOTE BOOK _____
NO. _____
TEMP. _____
AREAS CHECKED _____

DATE _____ BY _____
NO. _____
ORIGINAL SURVEY _____
NOTE BOOK _____
NO. _____
TEMP. _____
AREAS CHECKED _____

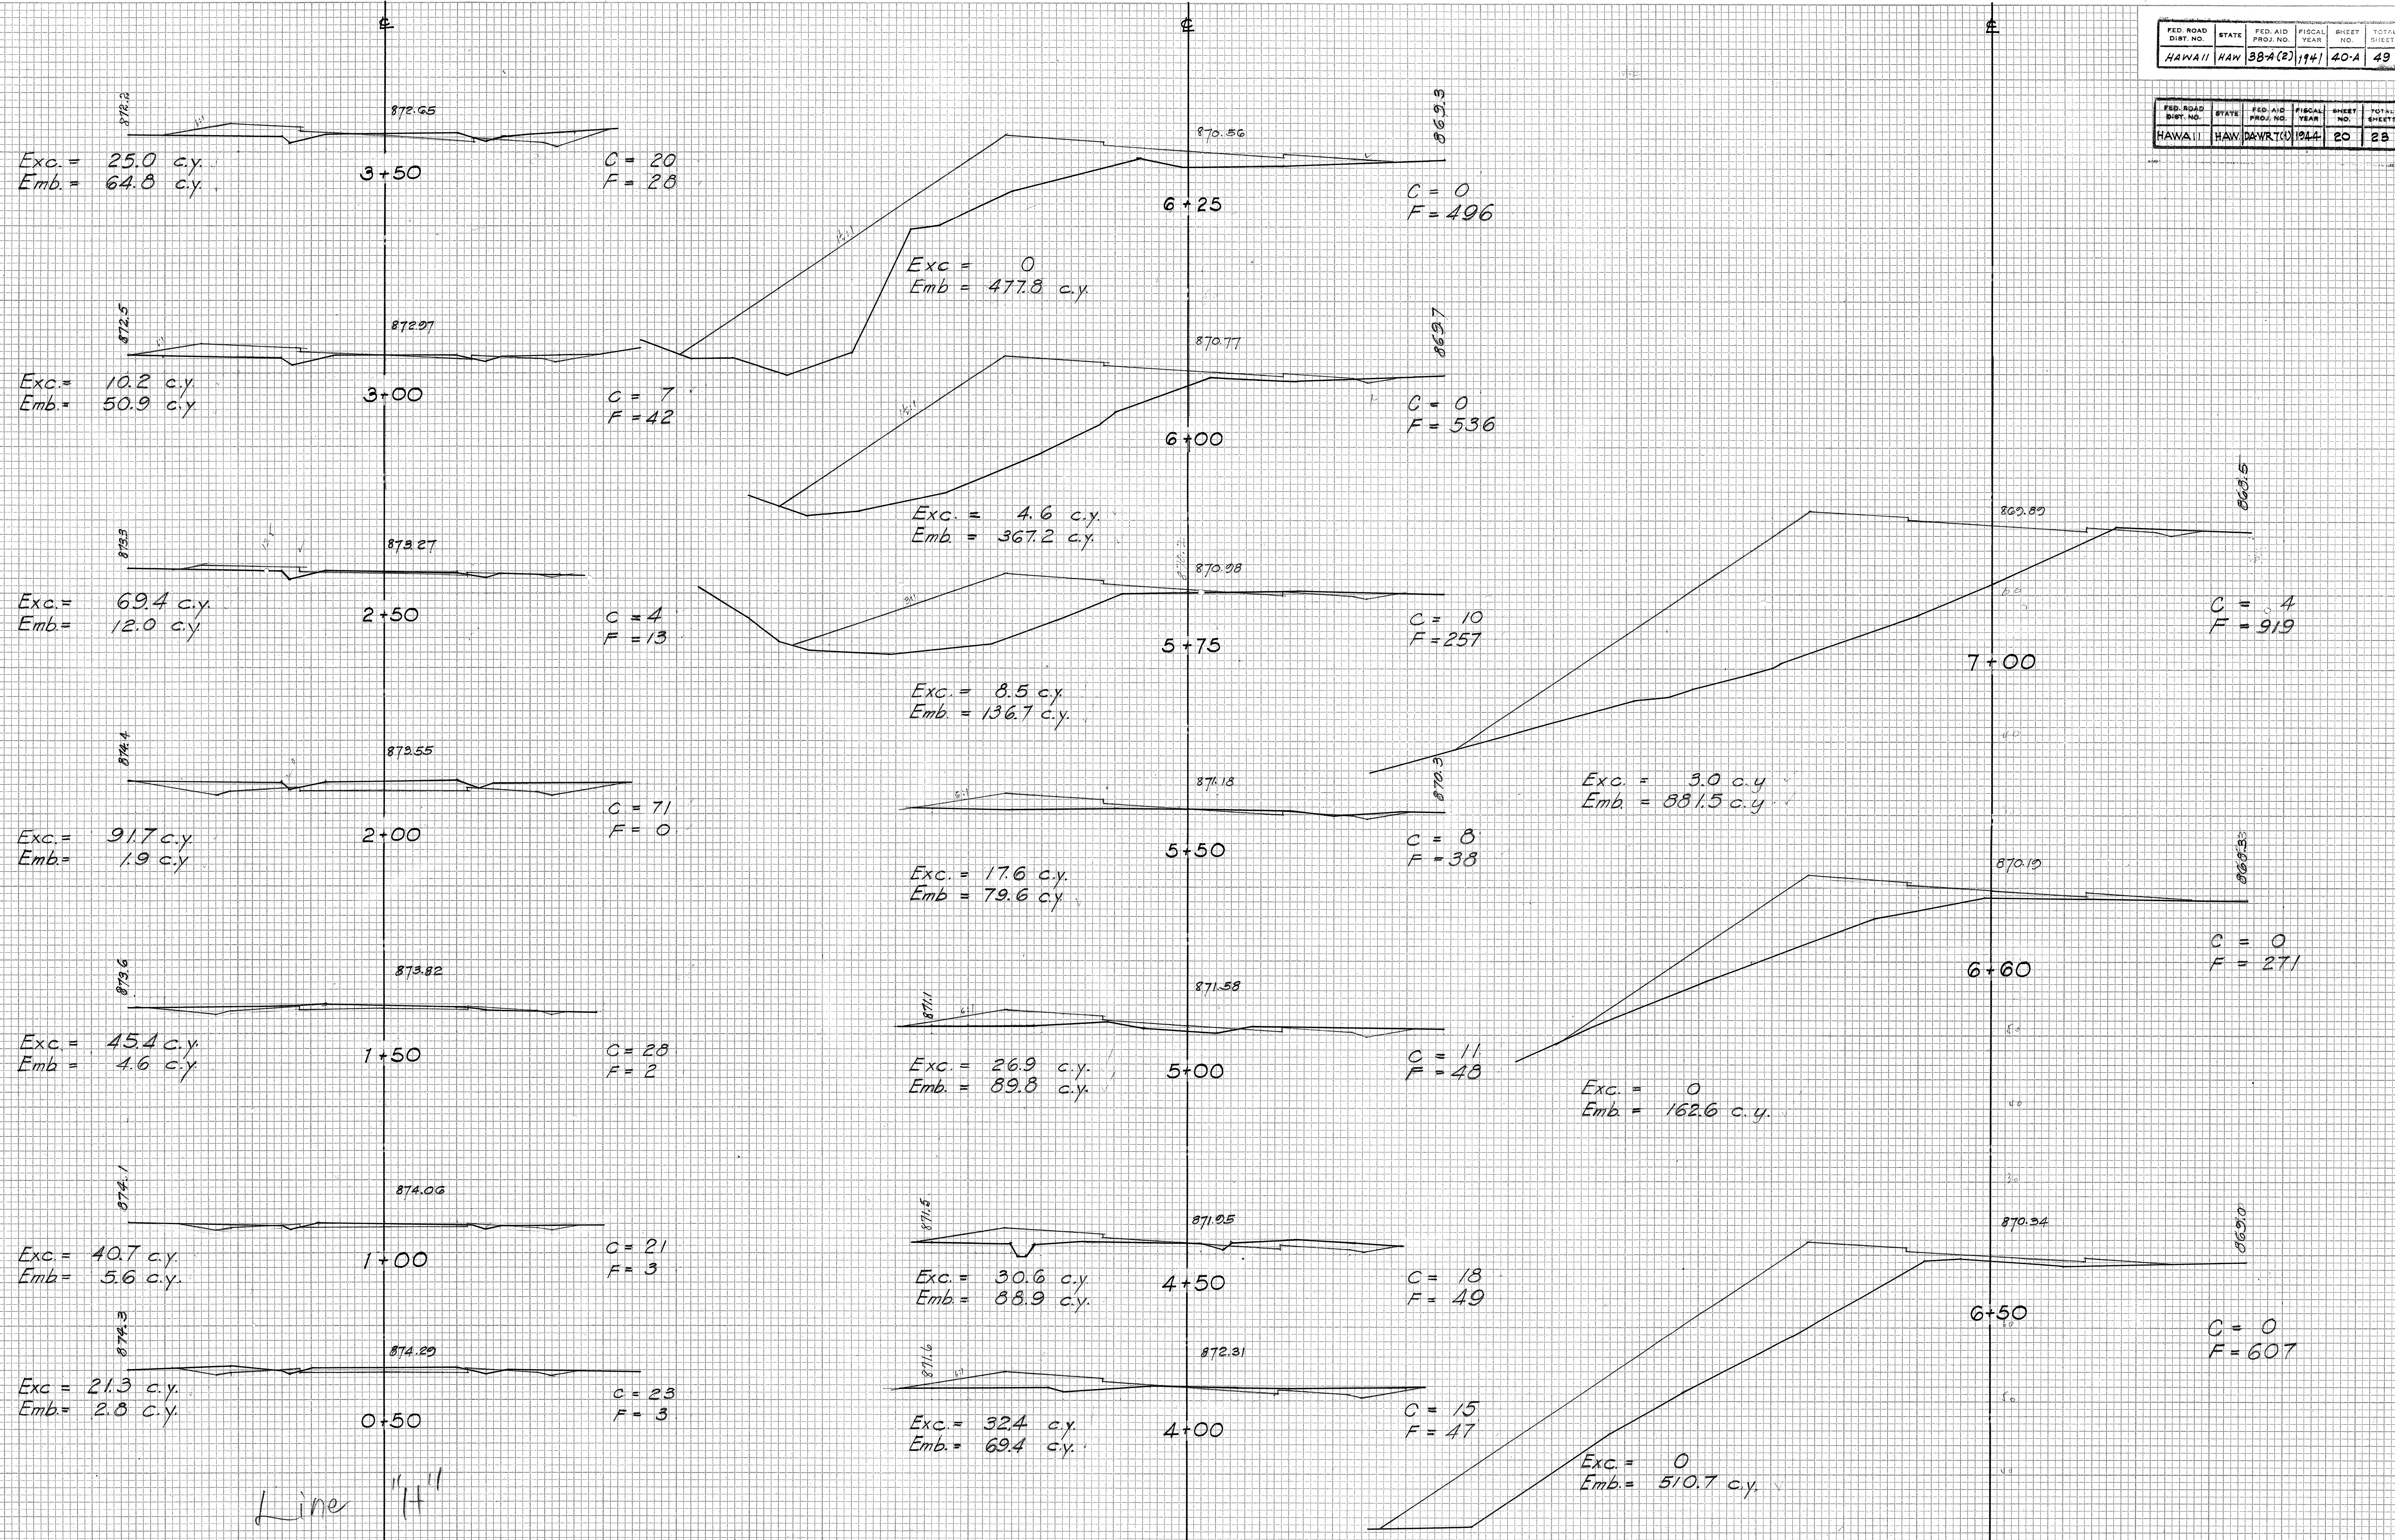


513520 5072.40A

DATE: 12/1/44
BY: [Signature]
CHECKED: [Signature]
NO. 12

FINAL SURVEY NOTE BOOK NO. [Blank]
DATE: [Blank]
BY: [Blank]
CHECKED: [Blank]
NO. 12



ORIGINAL SURVEY NOTE BOOK NO. [Blank]
DATE: [Blank]
BY: [Blank]
CHECKED: [Blank]
NO. 12

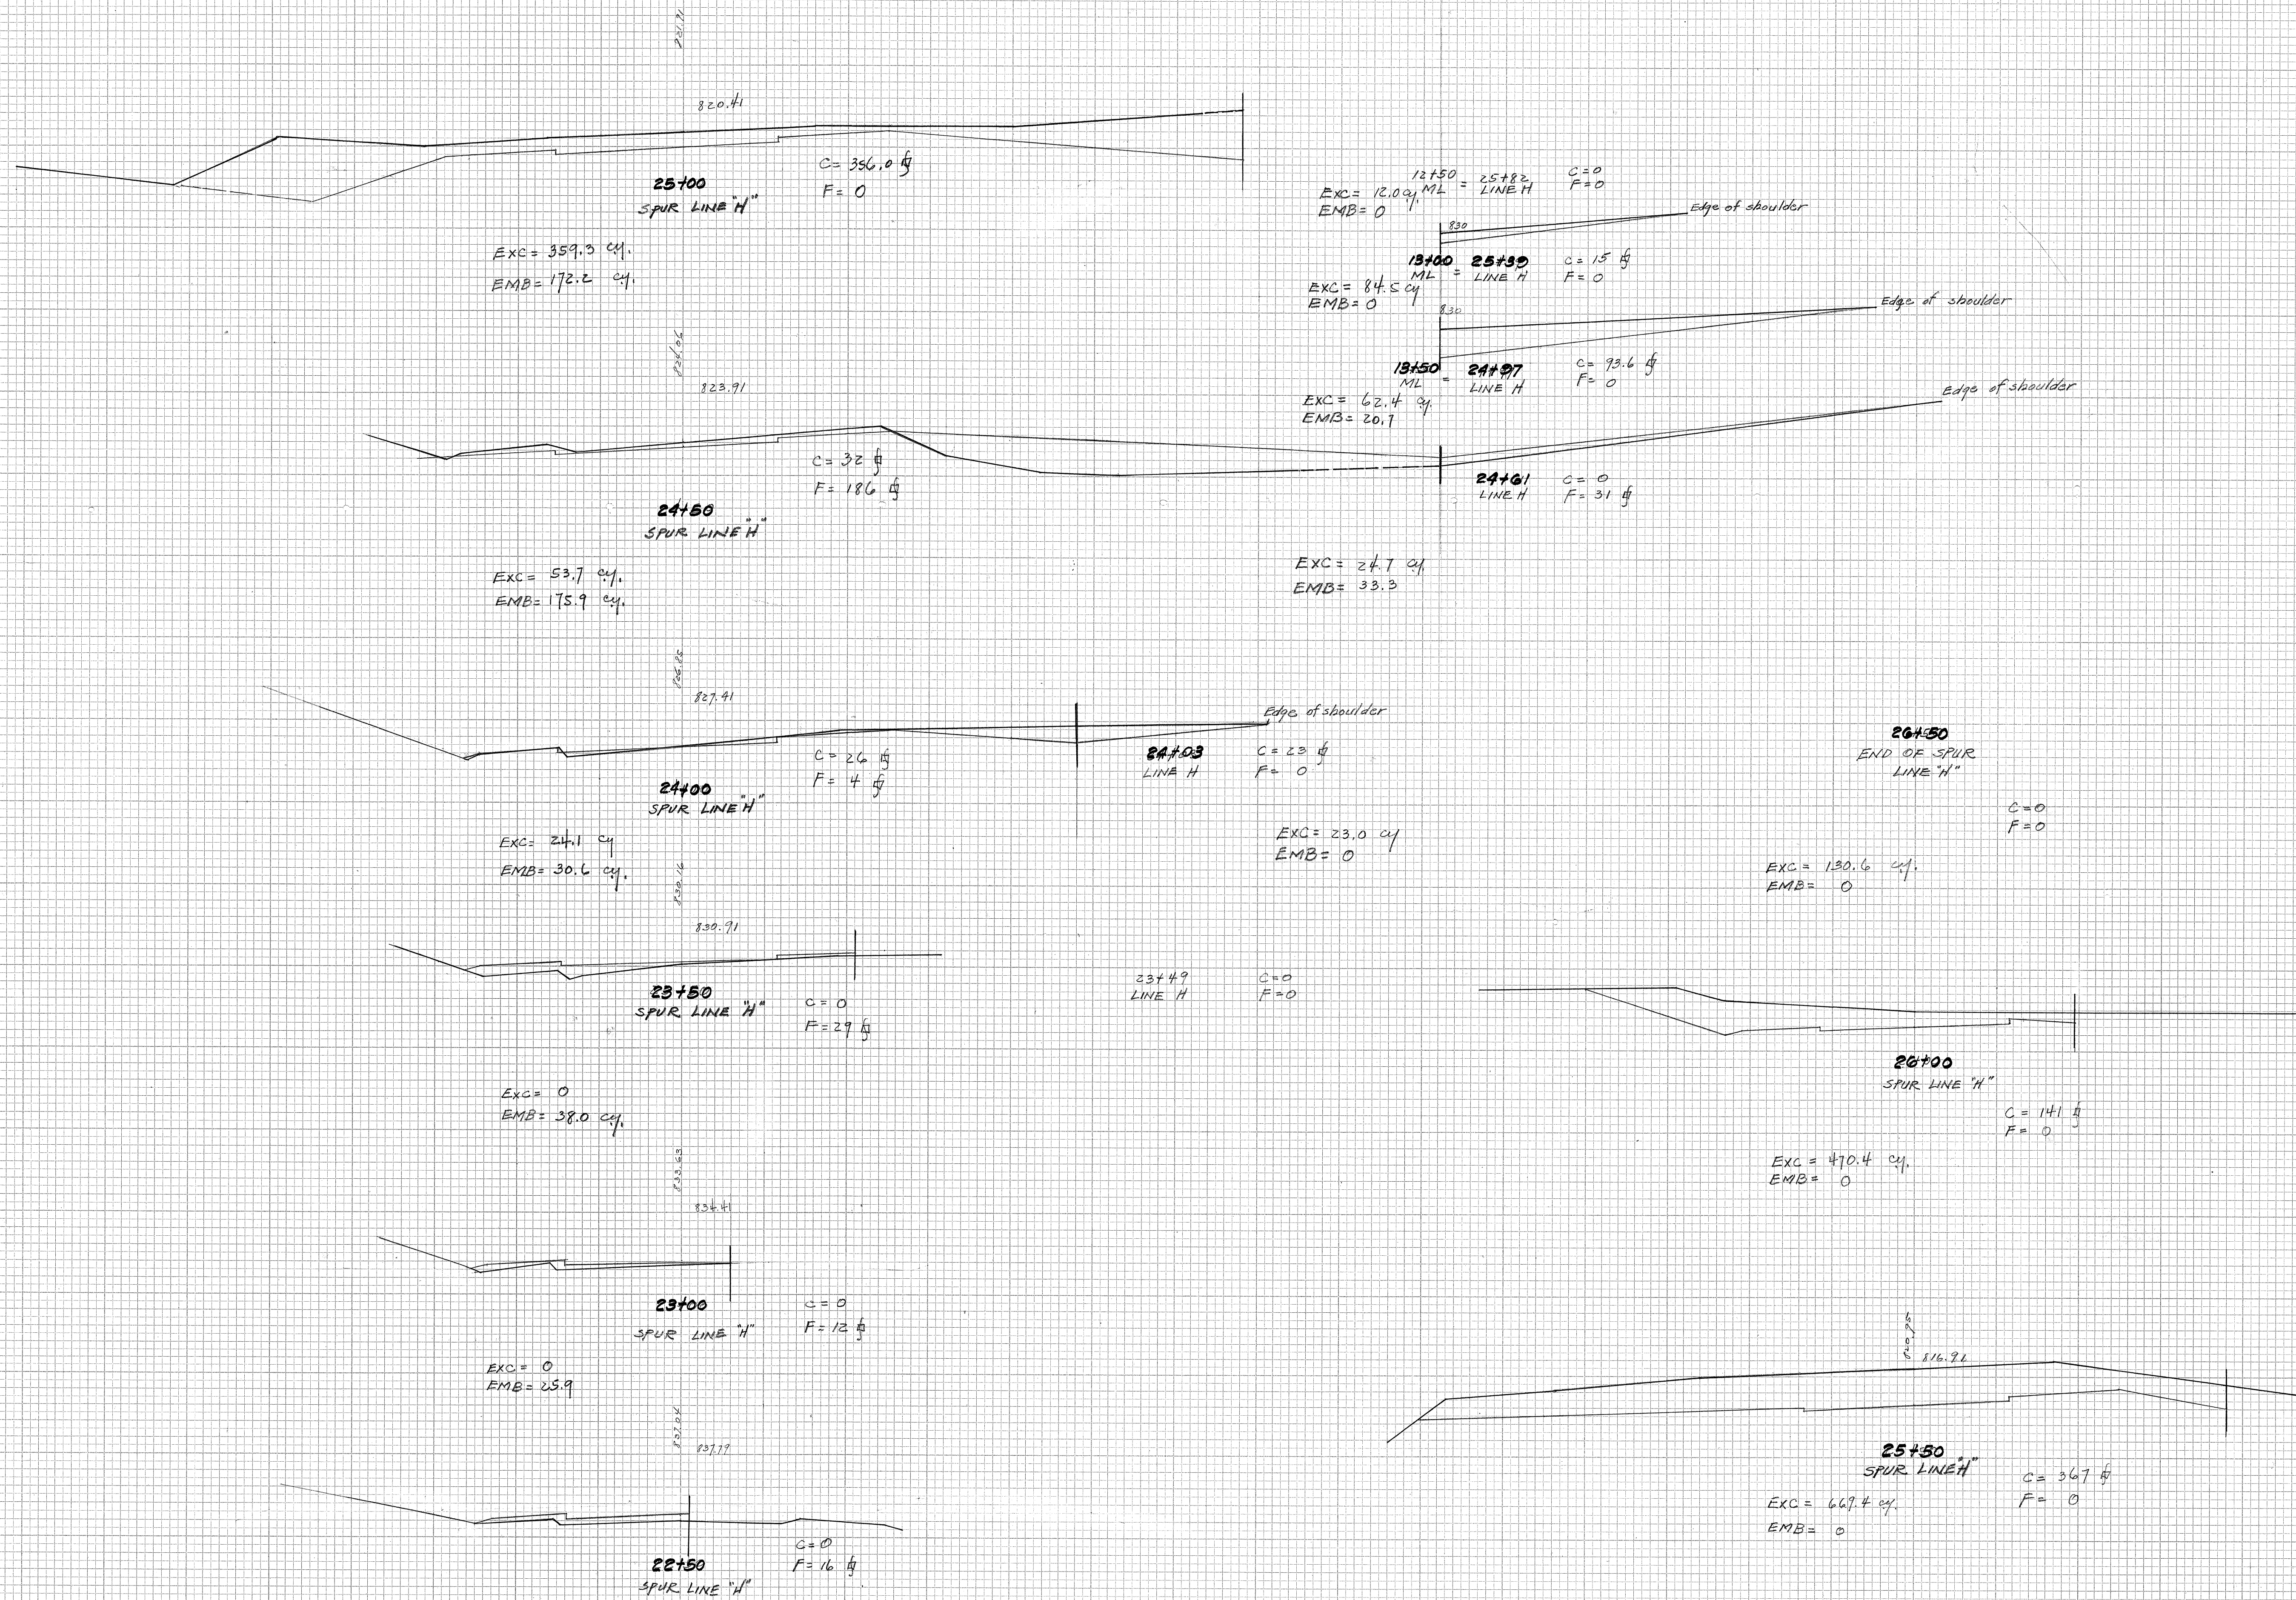

FINAL SURVEY
DATE
BY
NO.

ORIGINAL SURVEY
DATE
BY
NO.

FED. ROAD DIST. NO.	STATE	FED. AID PROJ. NO.	FISCAL YEAR	SHEET NO.	TOTAL SHEETS
HAWAII	HAWAII	DA-1170	1944	22	23

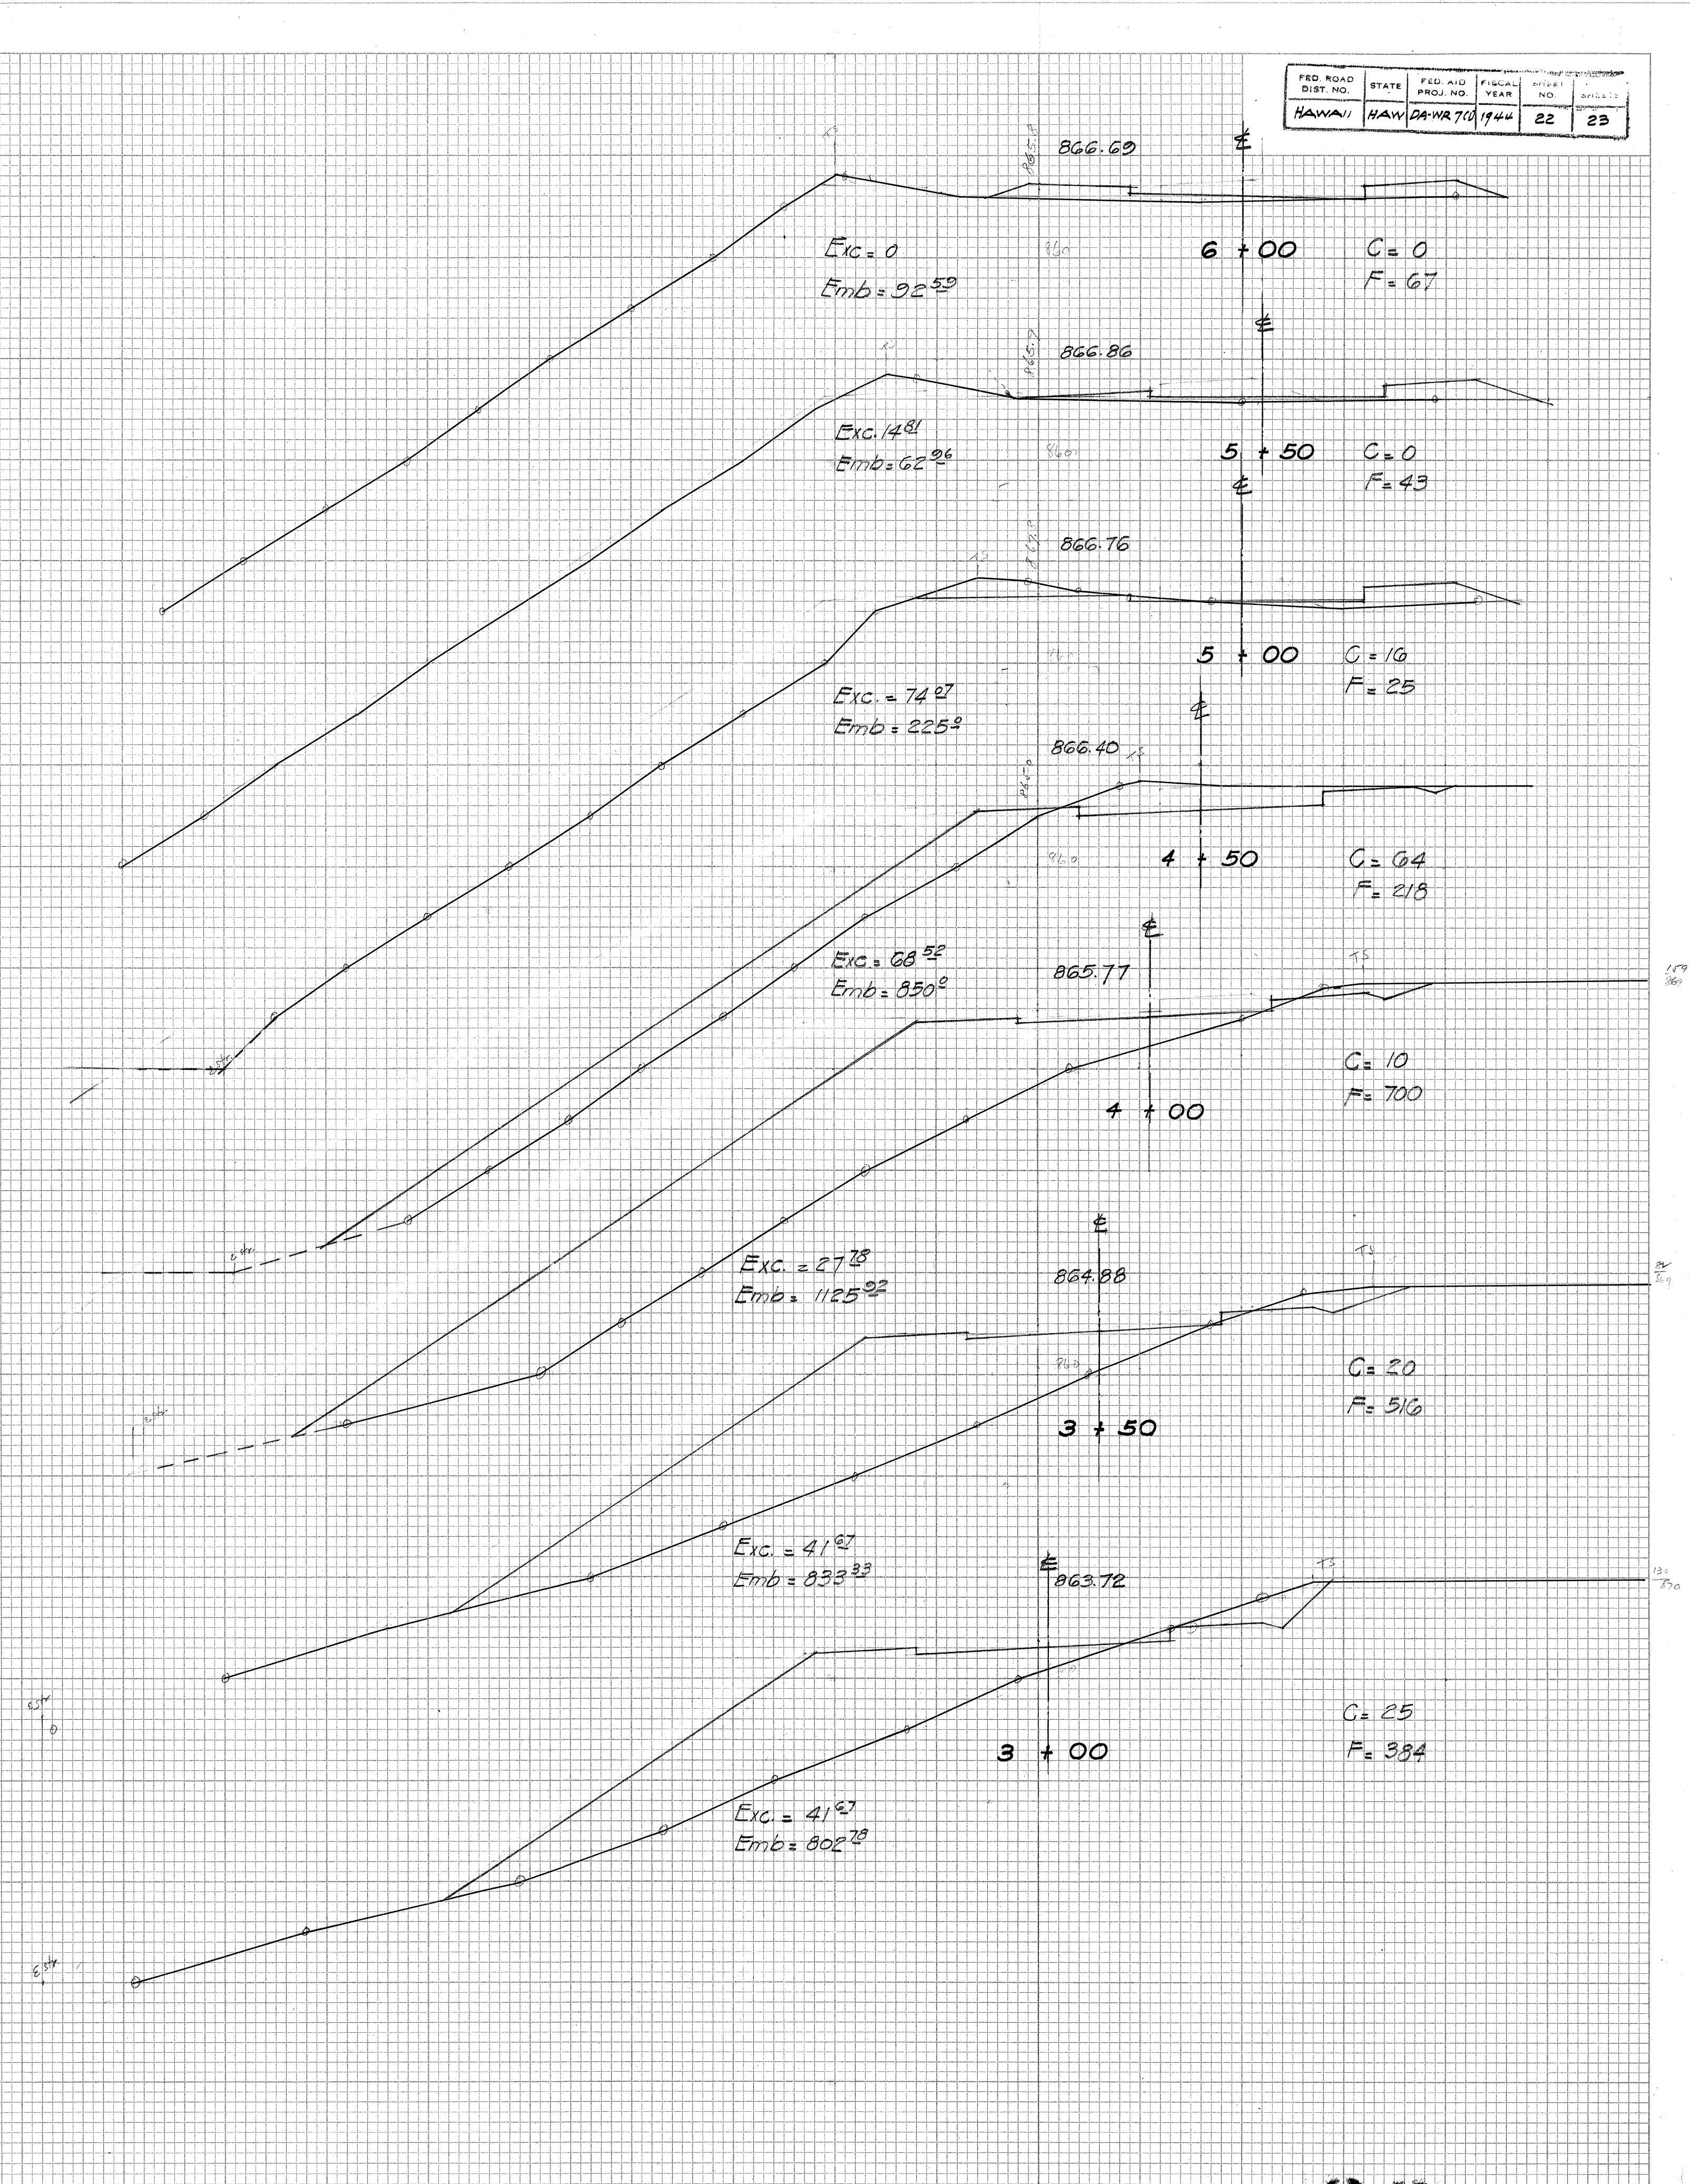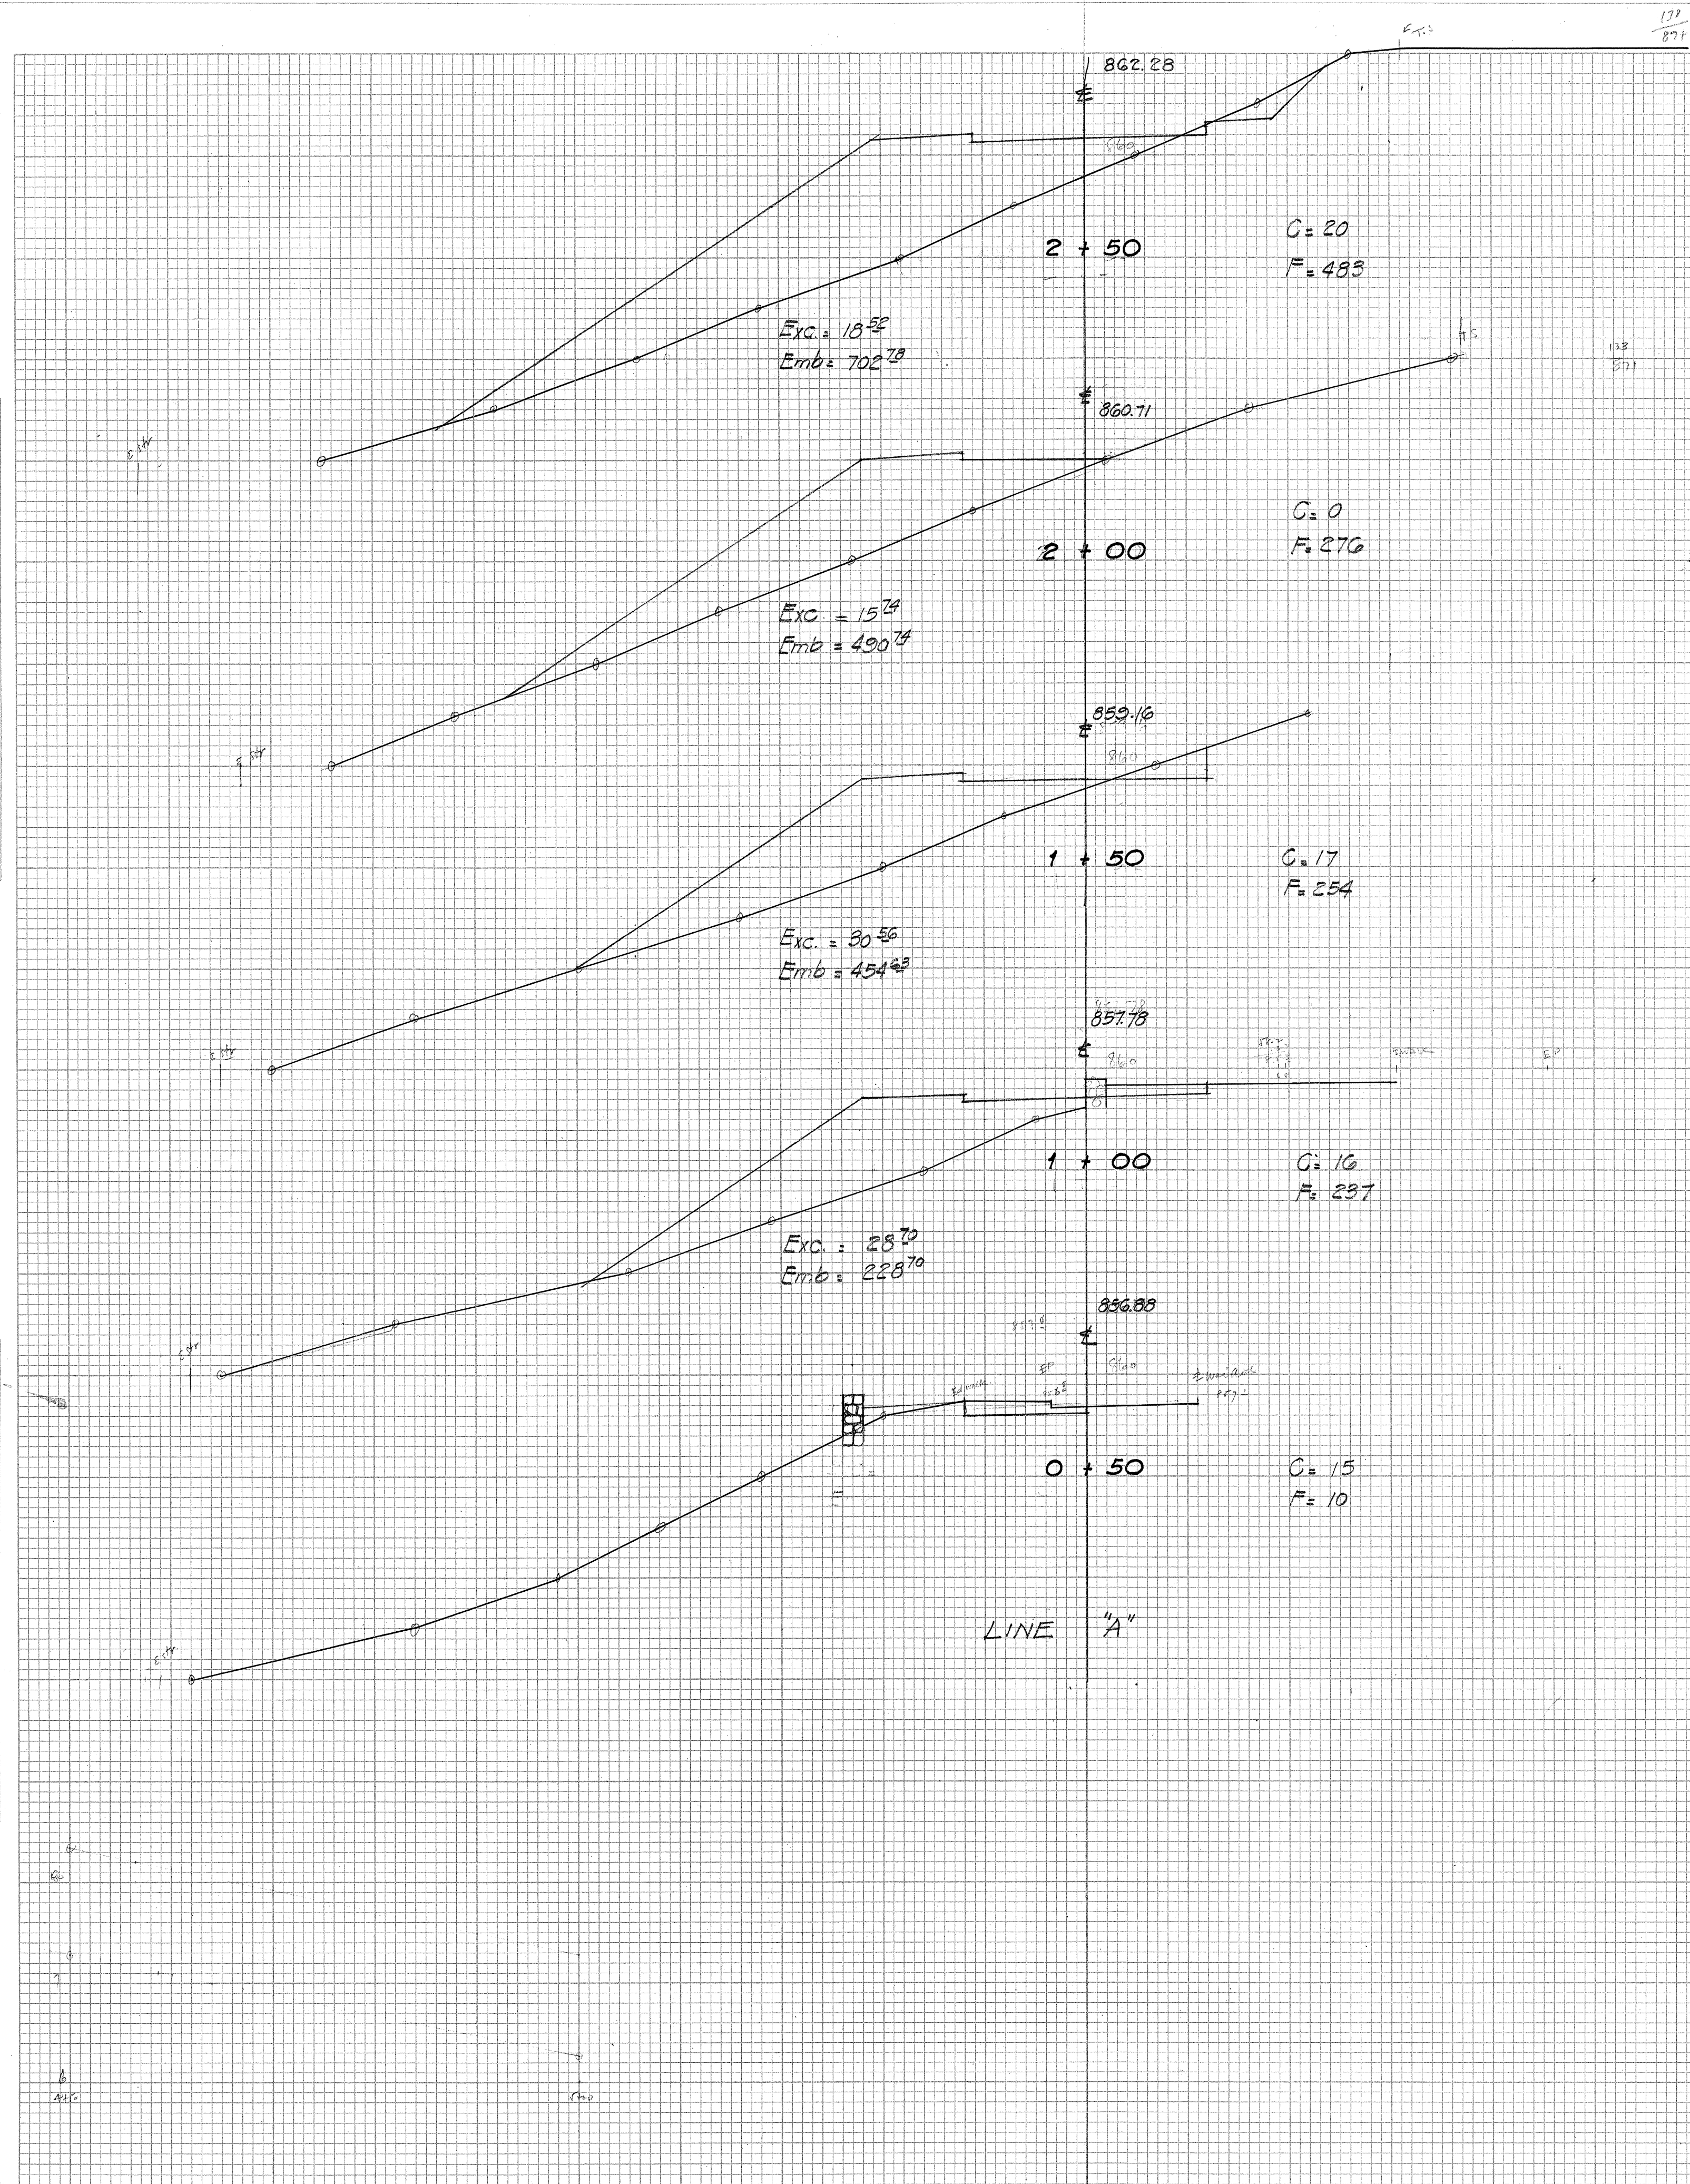

513522

FED. ROAD DIST. NO.	STATE	FED. AID PROJ. NO.	FISCAL YEAR	SHEET NO.	SHEET TOTAL
HAWAII	HAWAII	DAW-70	1944	23	23

DATE	BY

DATE	BY

DATE	BY

DATE	BY

