




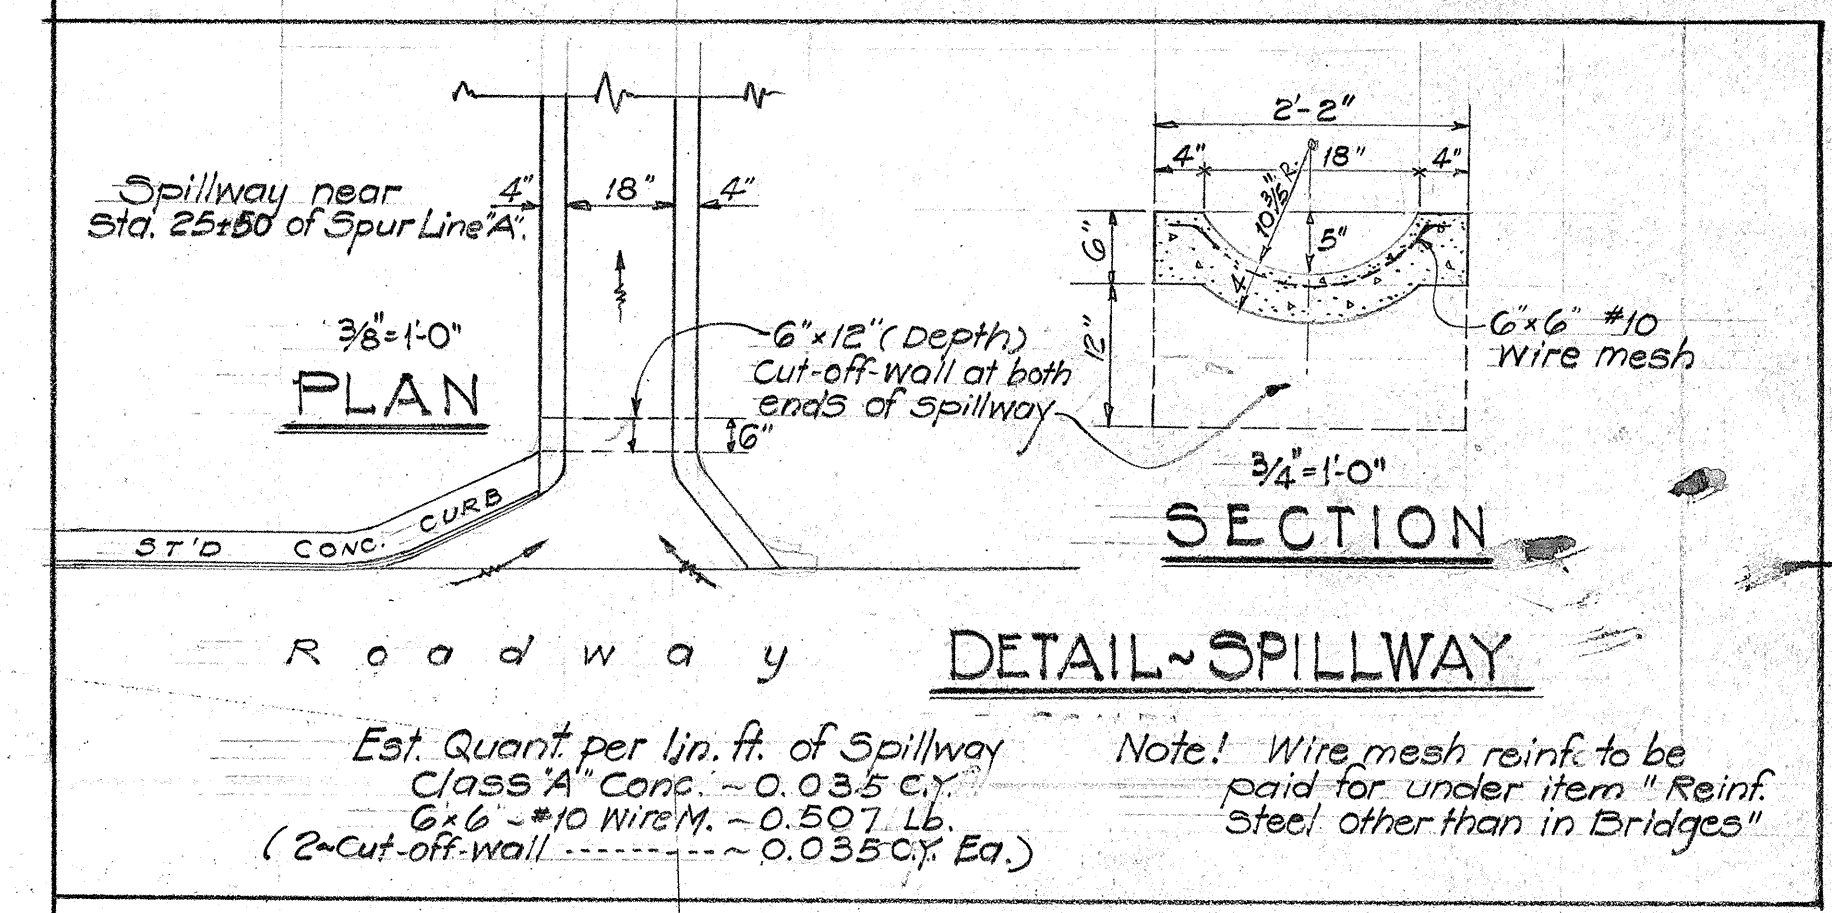

CURVE DATA
 $\Delta = 80^\circ 35' 05''$
 $R = 417.56$
 $T = 353.94$
 $L = 586.92$
 $SE = 0.0674$
 $EW = 3'$

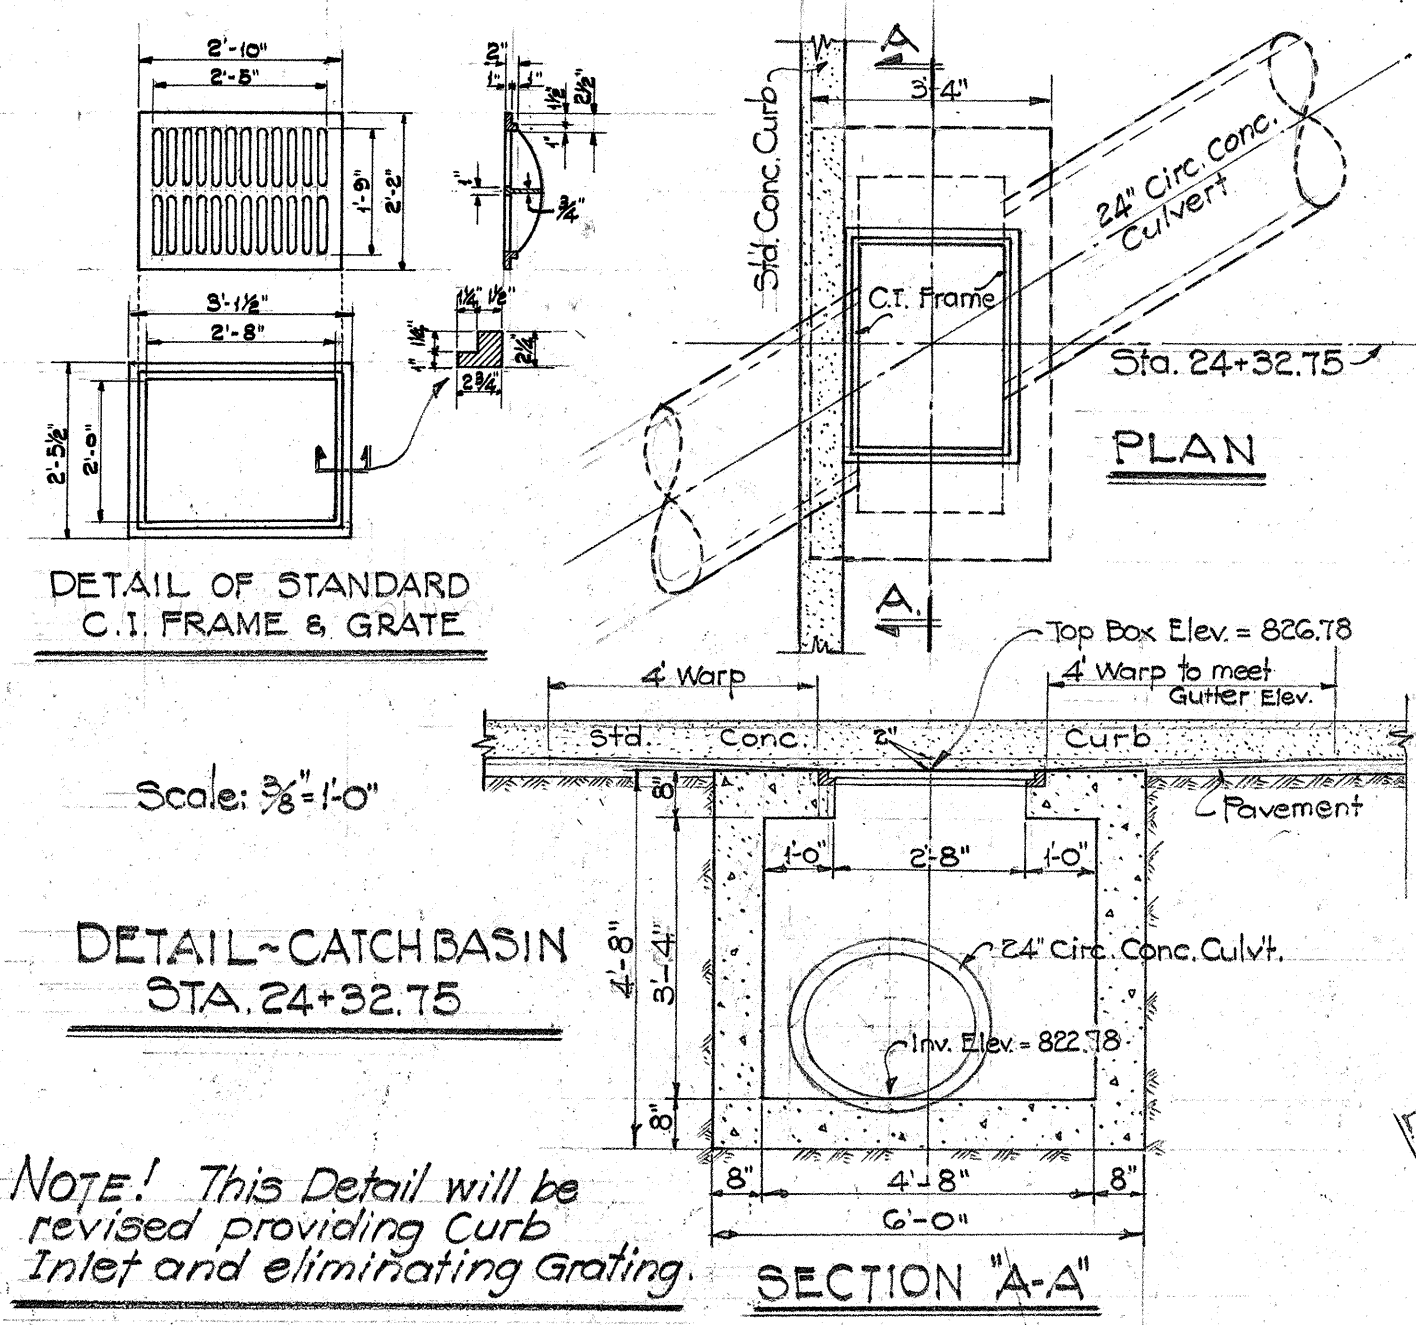

CURVE DATA
 $\Delta = 99^\circ 24' 55''$
 $R = 300'$
 $T = 353.84$
 $L = 520.54$
 $SE = 0.0674$
 $EW = 4'$

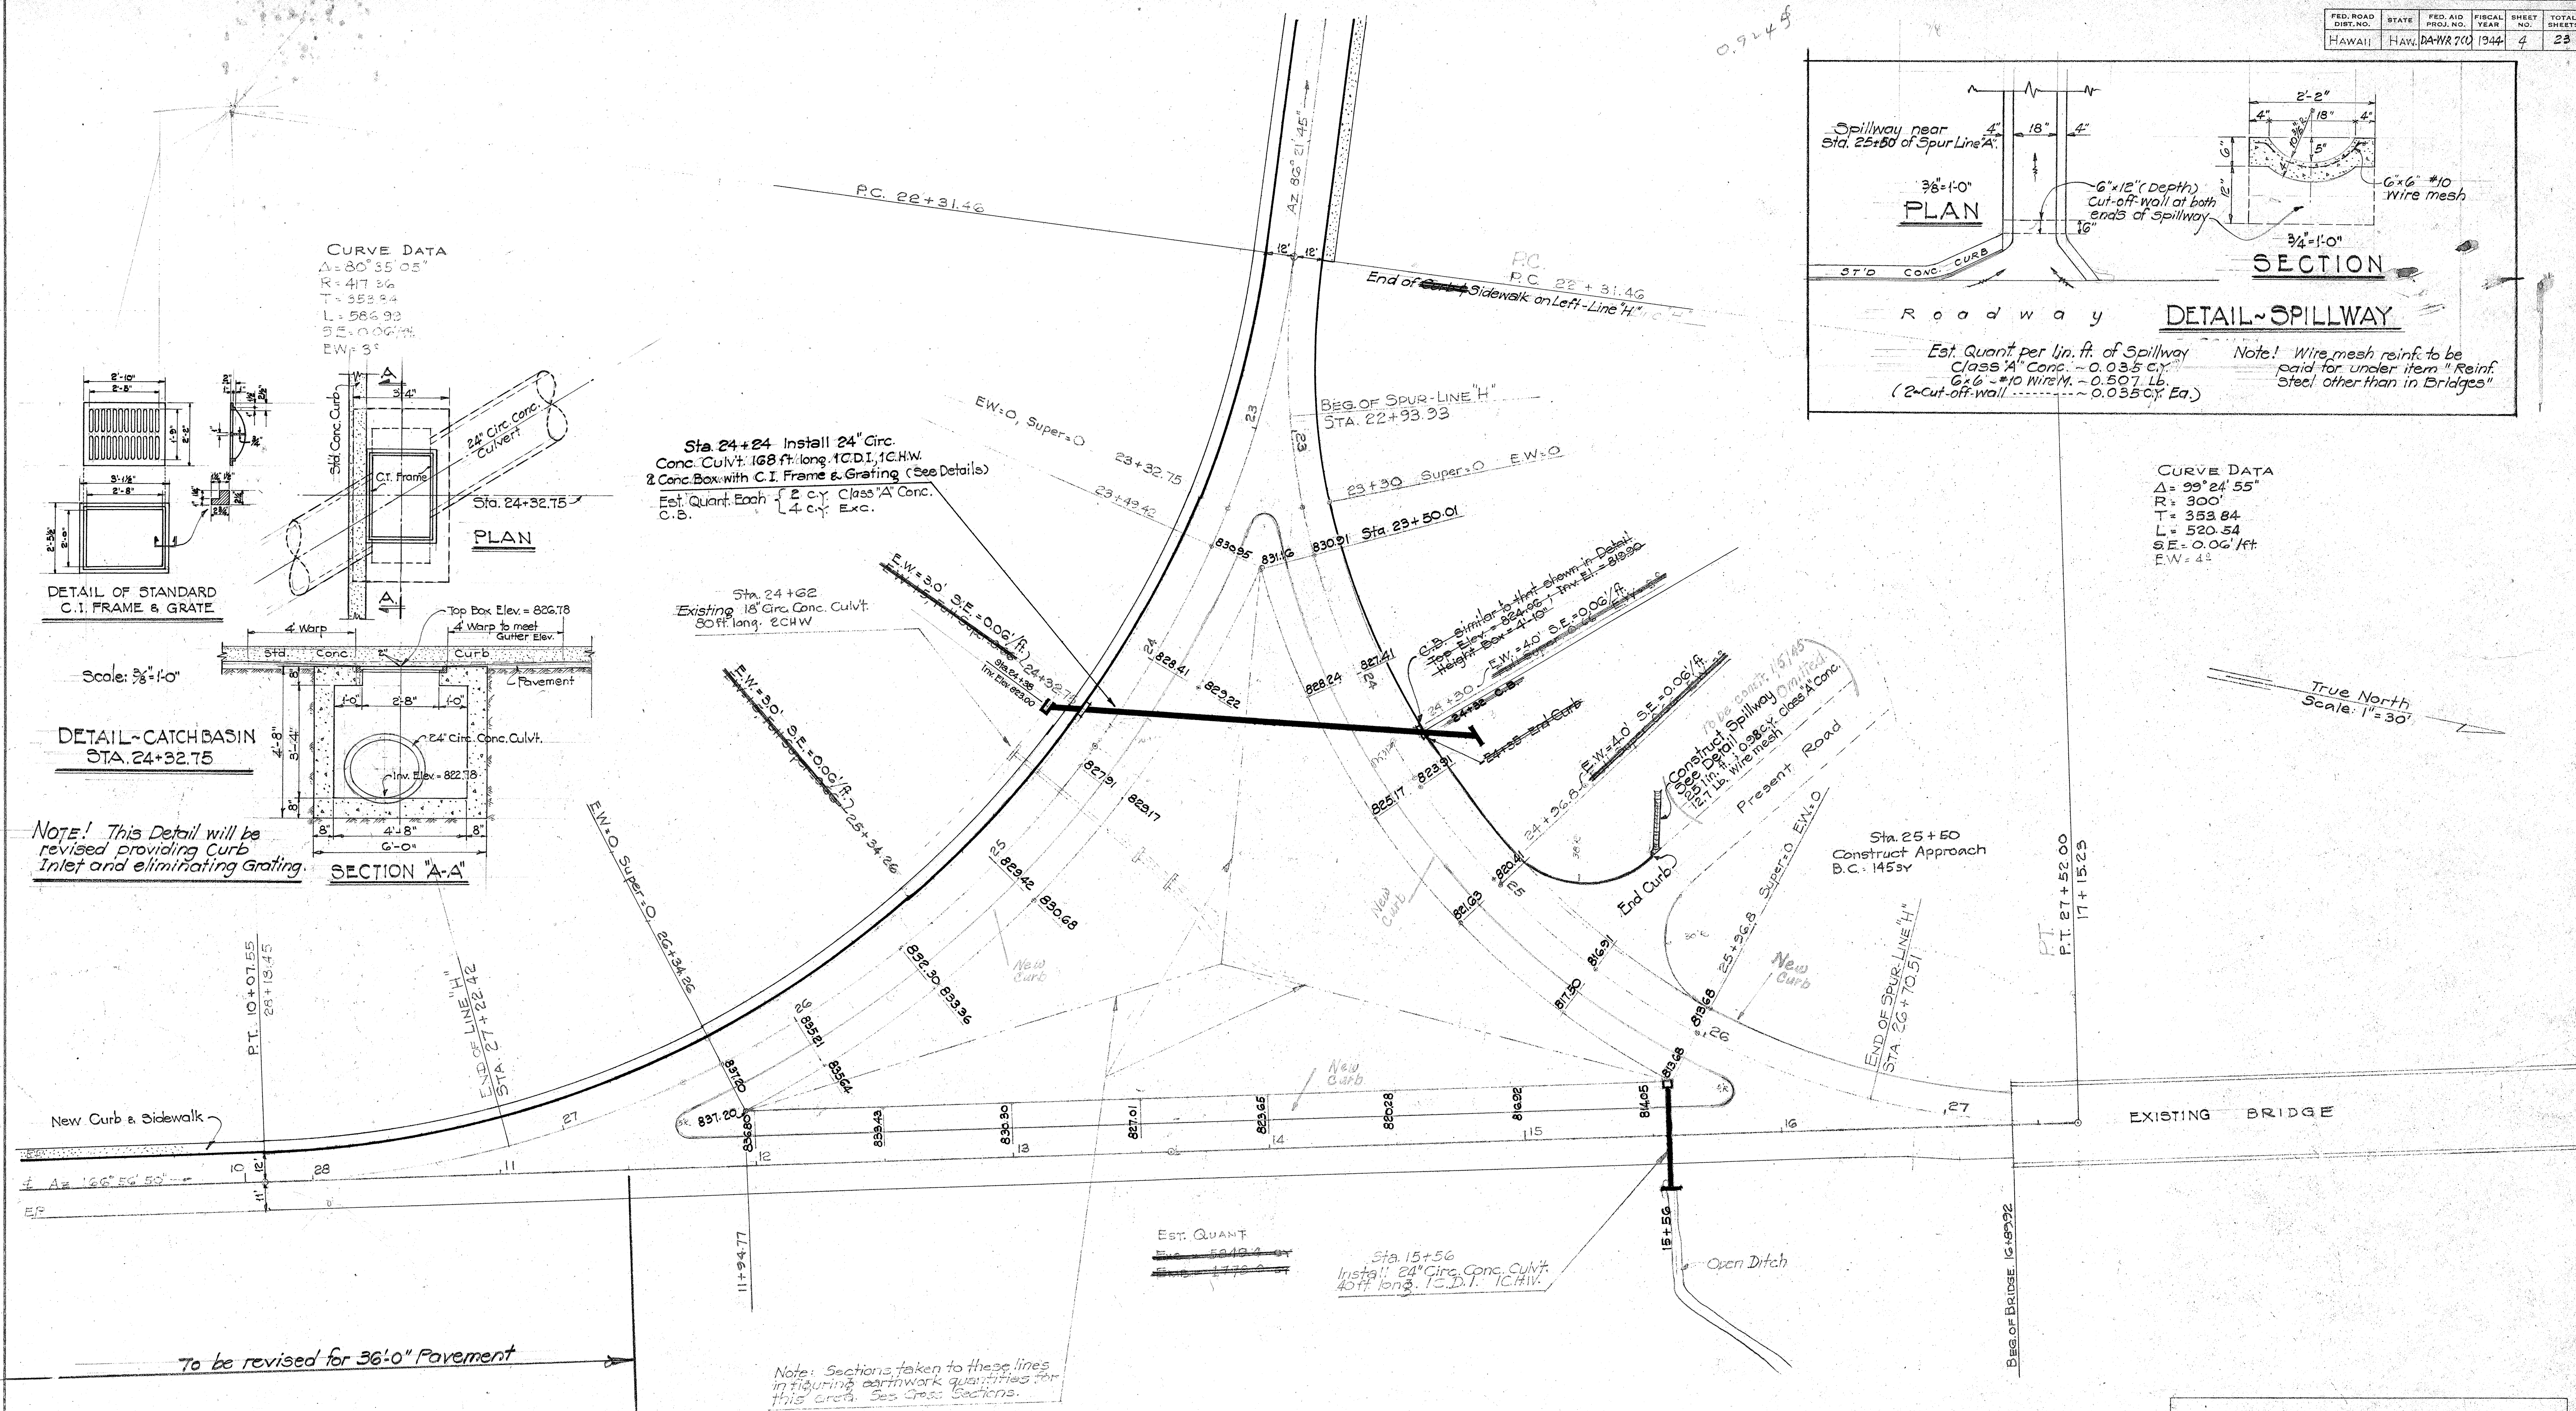

ORIGINAL PLAN	DATE
DRAWN BY	DESIGNED BY
NOTE BOOK	QUANTITIES BY
CHECKED BY	CHECKED BY

TERRITORIAL HIGHWAY DEPARTMENT
TERRITORY OF HAWAII
GRADING AT INTERSECTION
ALSO
DETAIL OF SPILLWAY
Schofield-Wahiawa Cutoff DA-WR-7(1)
May 1944
SHEET No. 4 OF 23

5135.4