

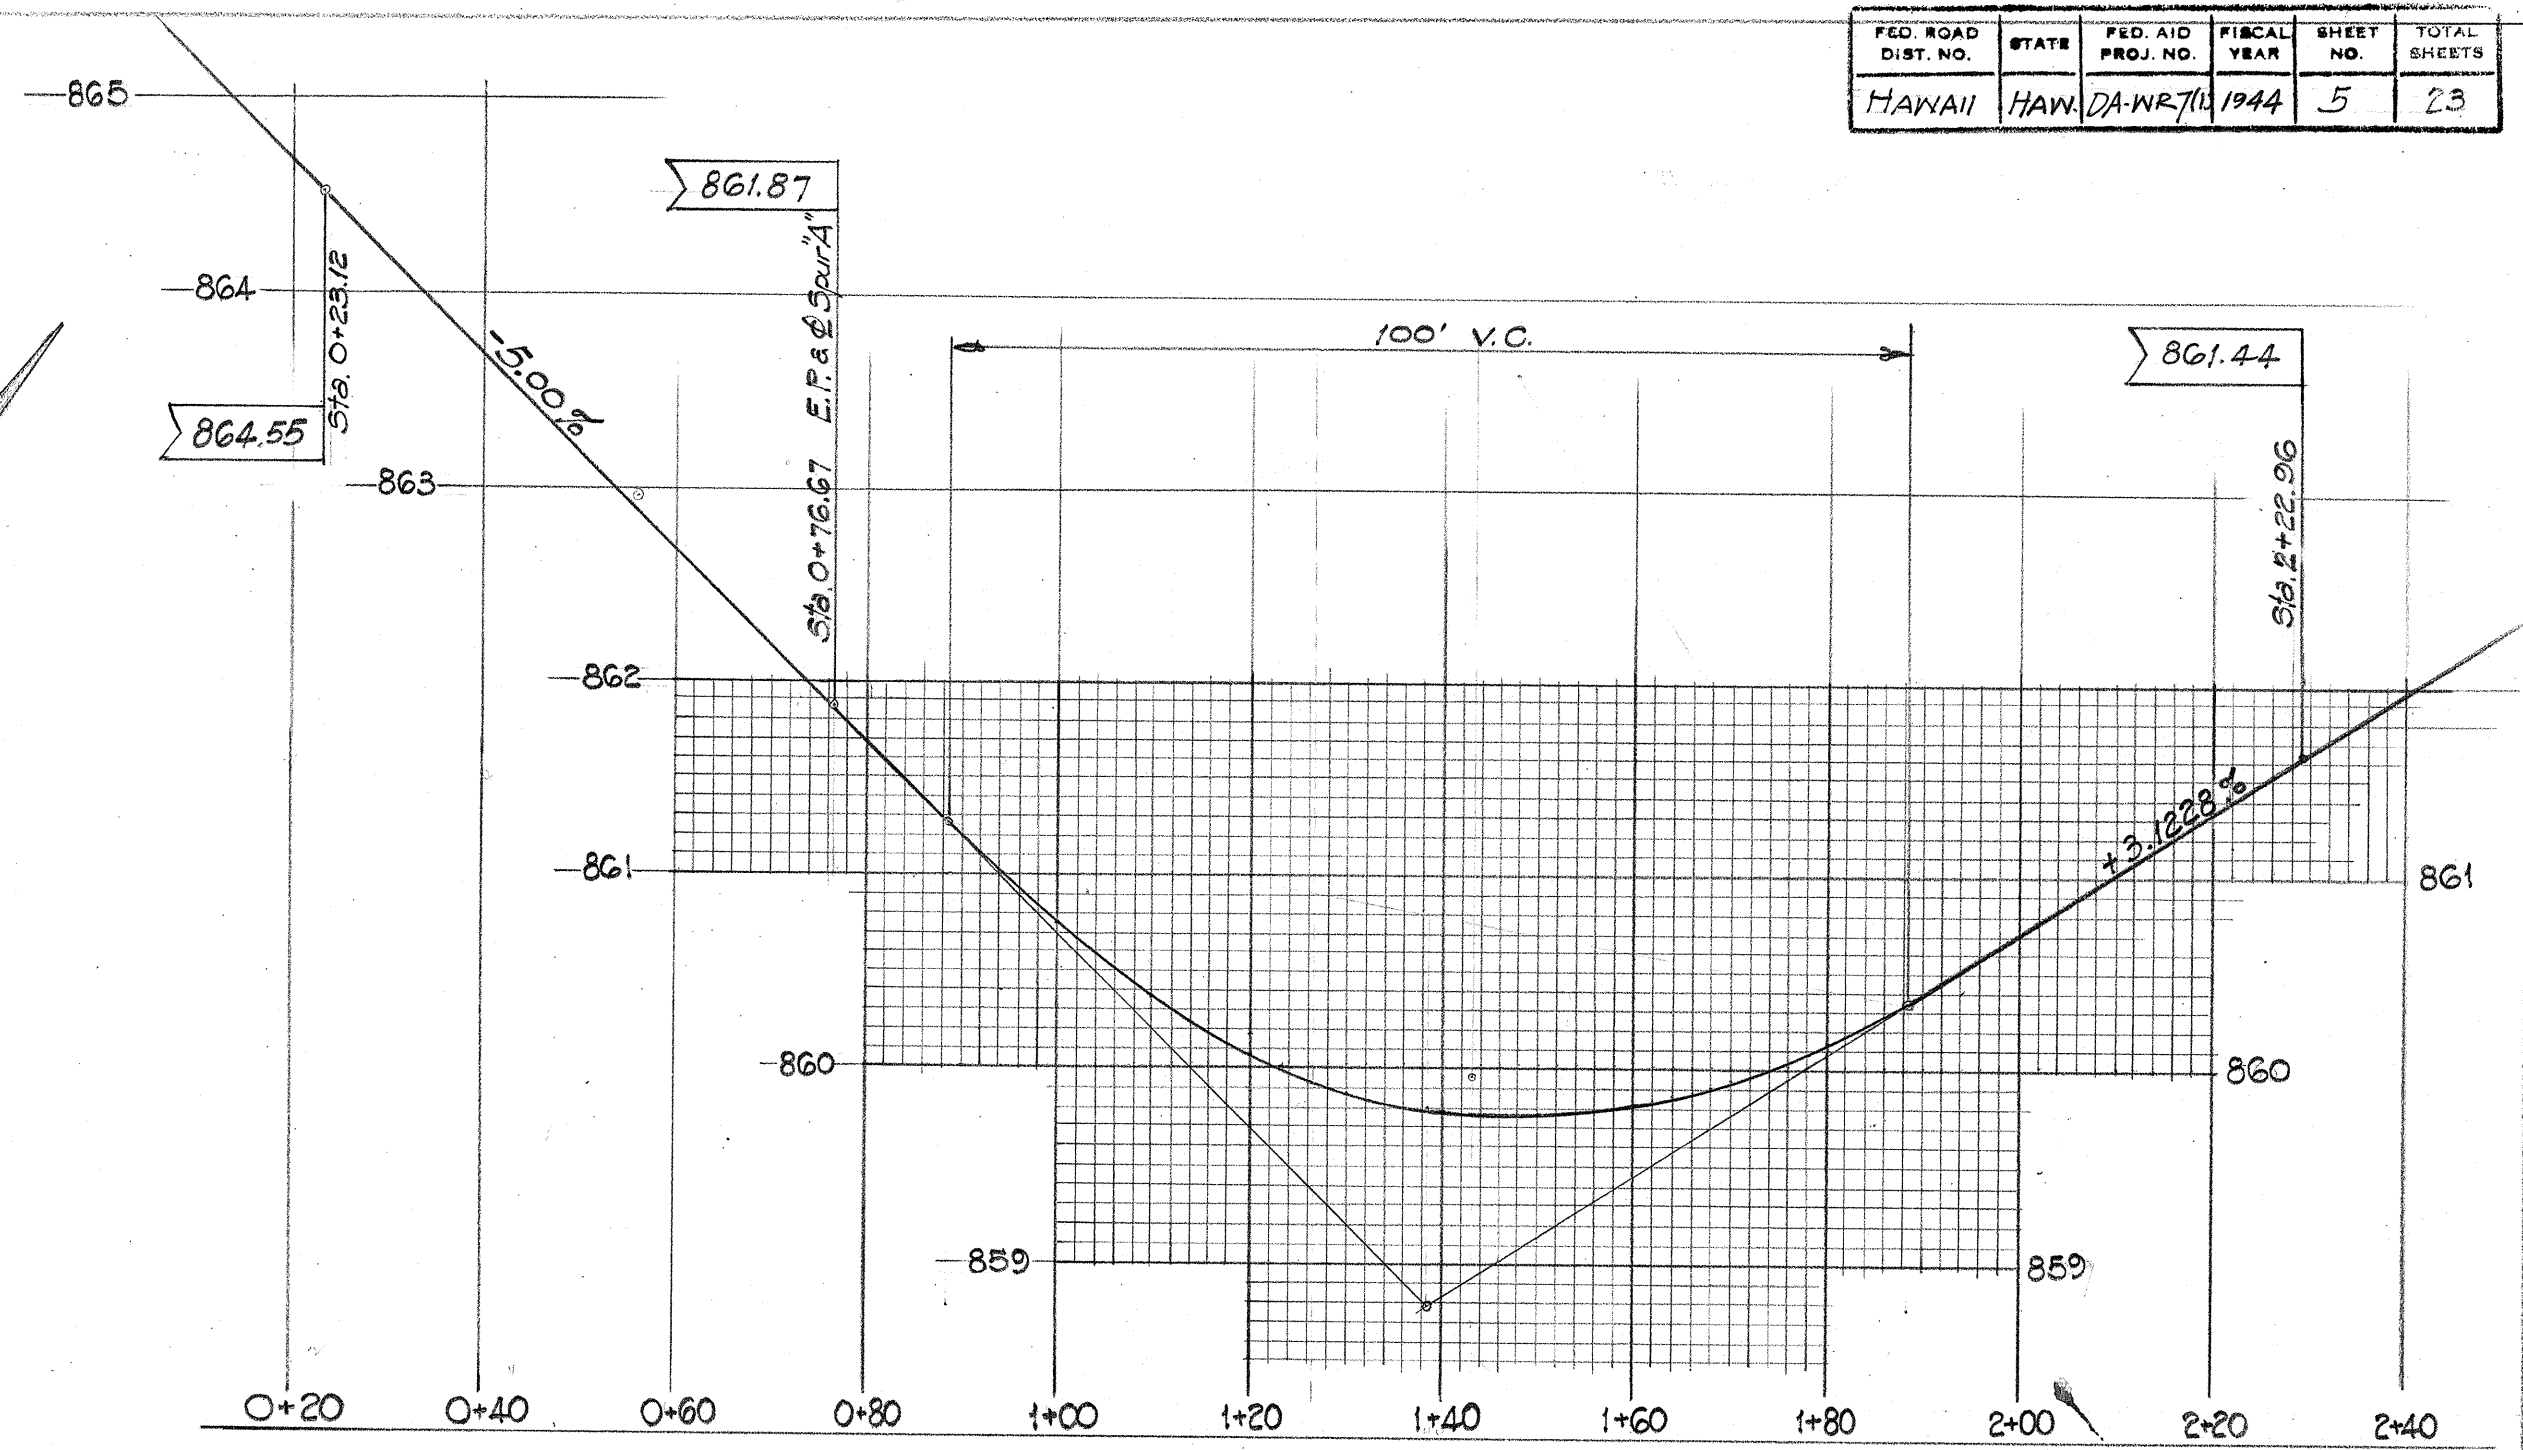
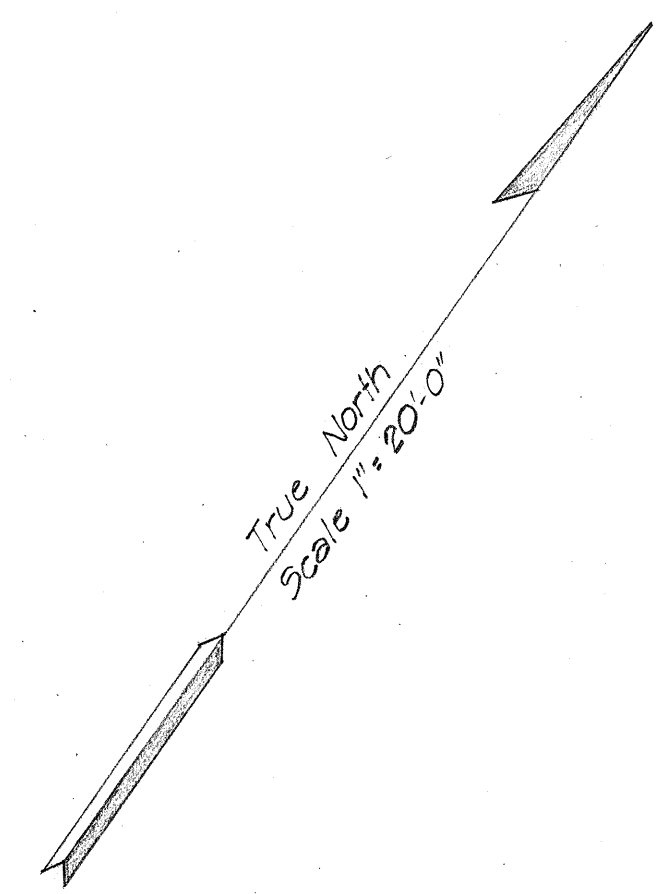


FED. ROAD DIST. NO.	STATE	FED. AID PROJ. NO.	FISCAL YEAR	SHEET NO.	TOTAL SHEETS
HAWAII	HAW	DA-WR-70	1944	5	23

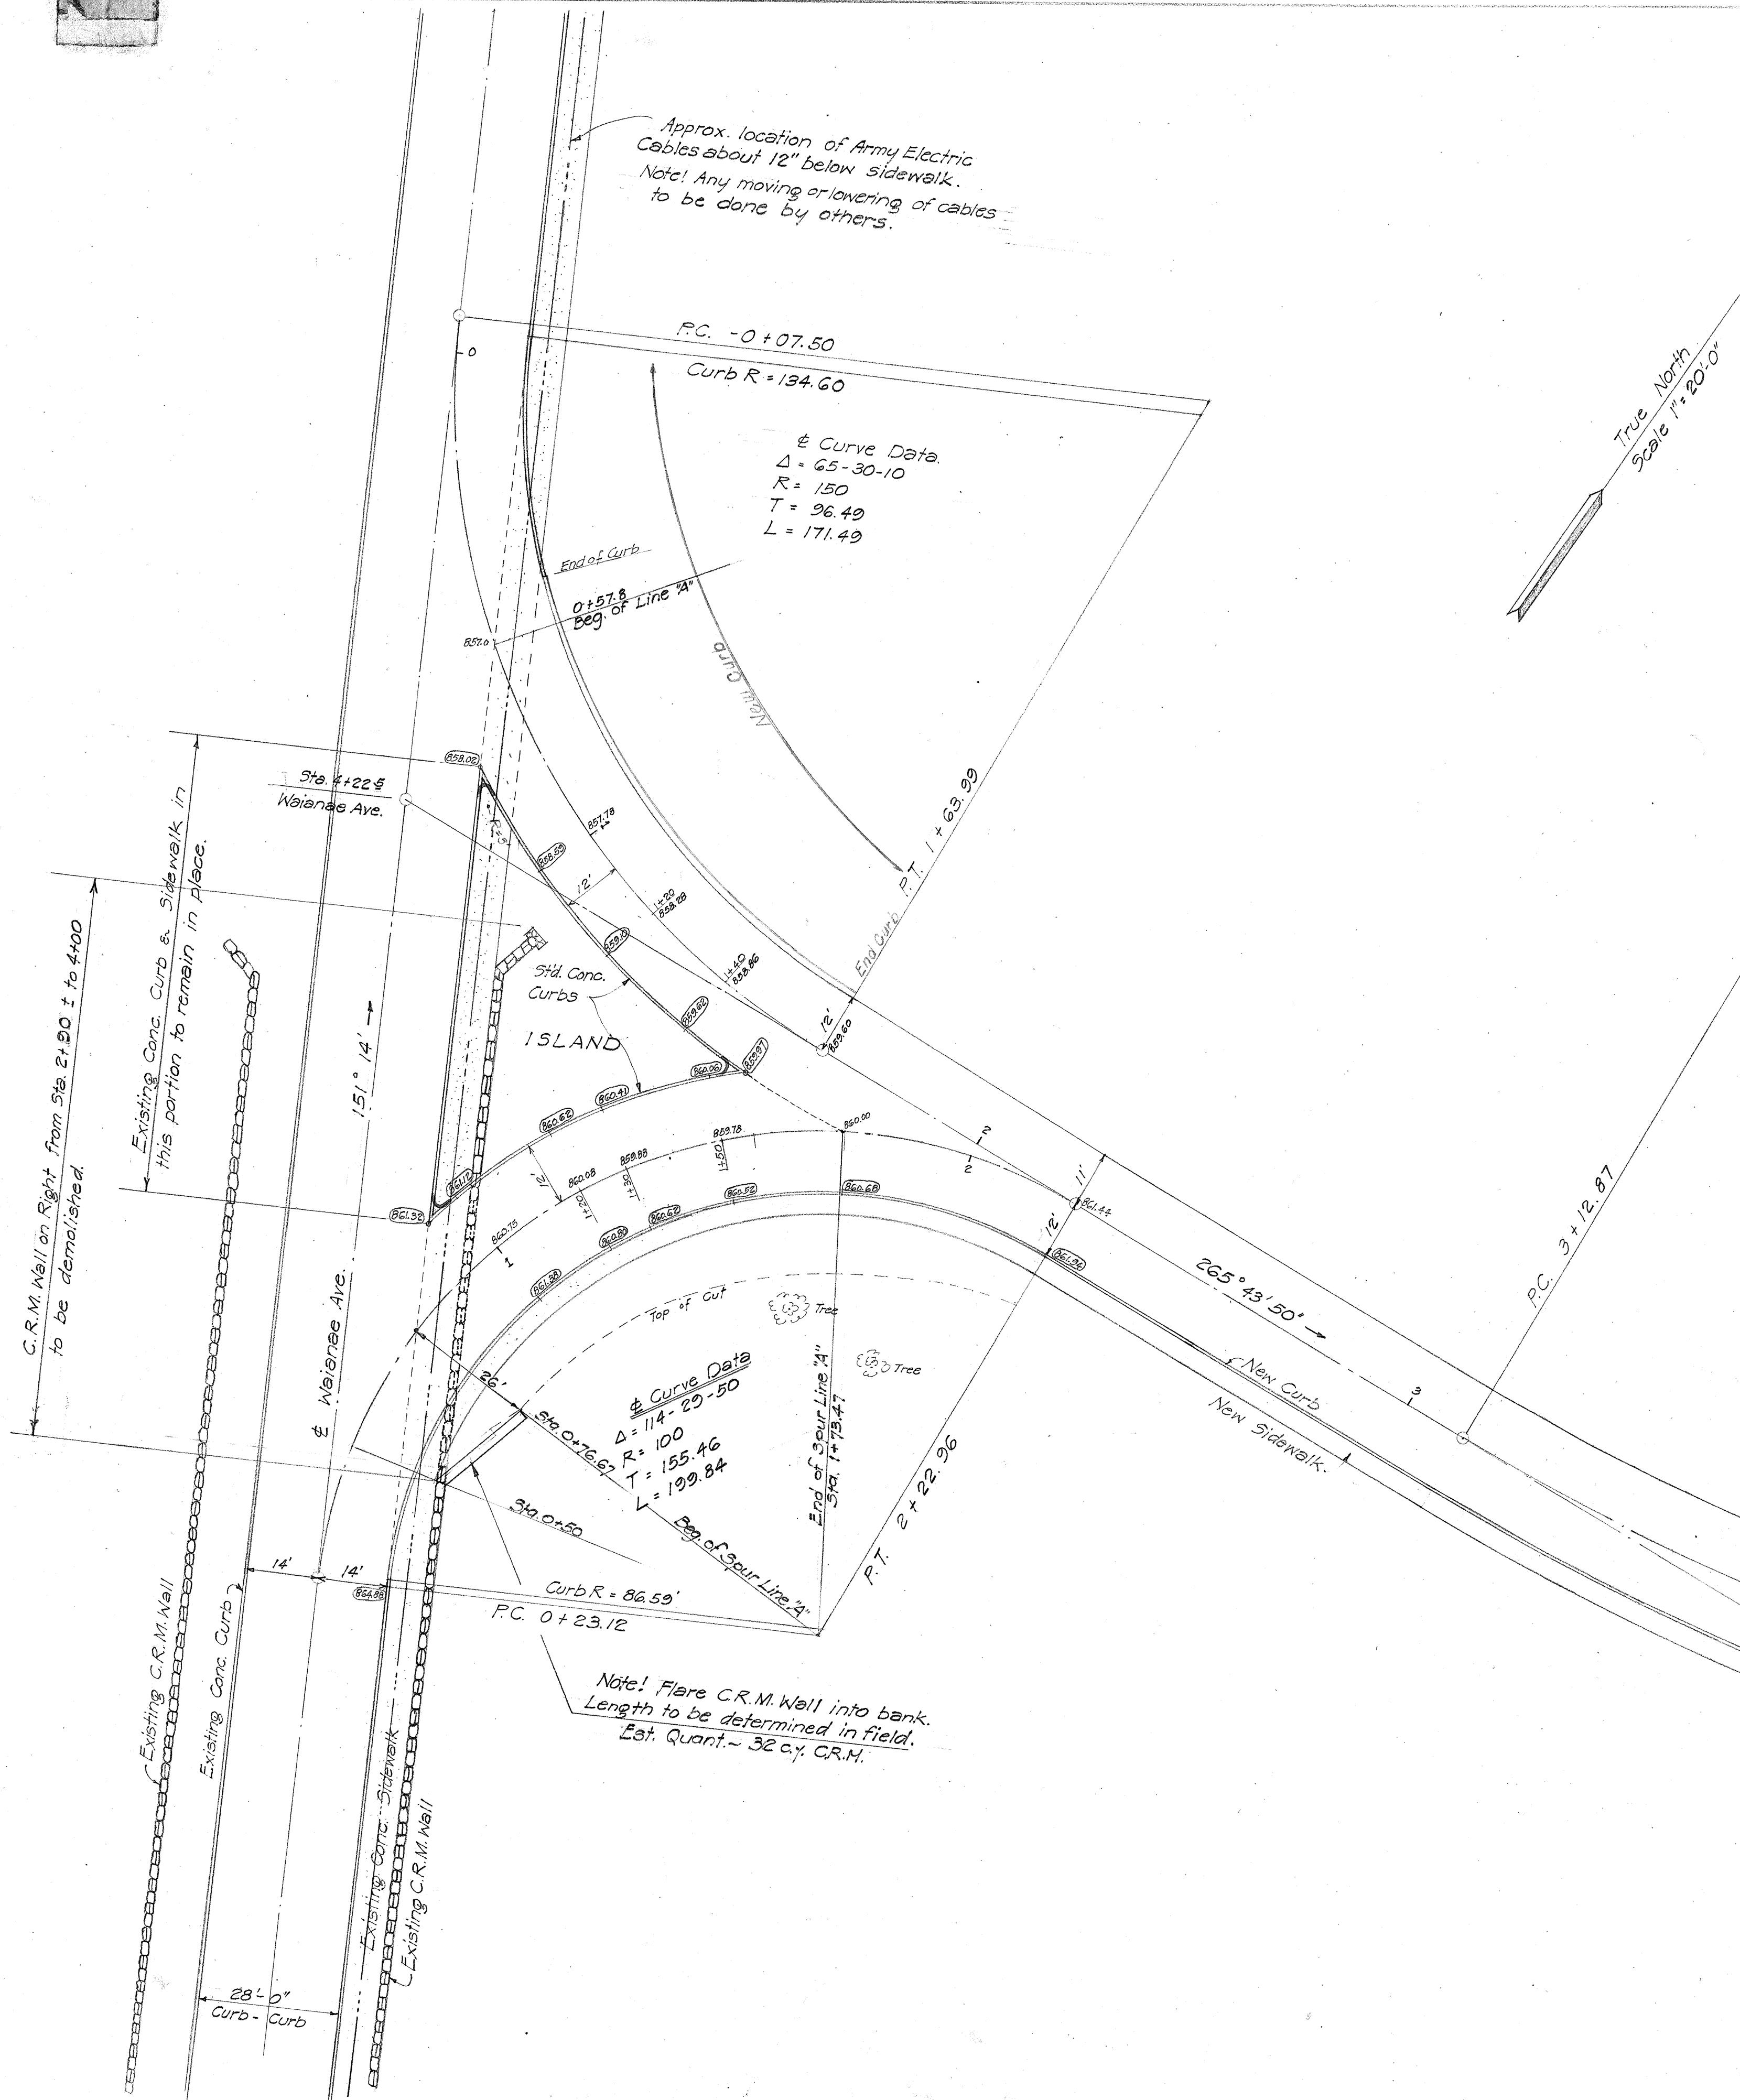

PROFILE ~ Φ SPUR LINE "A" IN ENLARGED SCALE
 Scales: Hor. --- 1" = 20'-00"
 Ver. --- 1" = 1'-00"

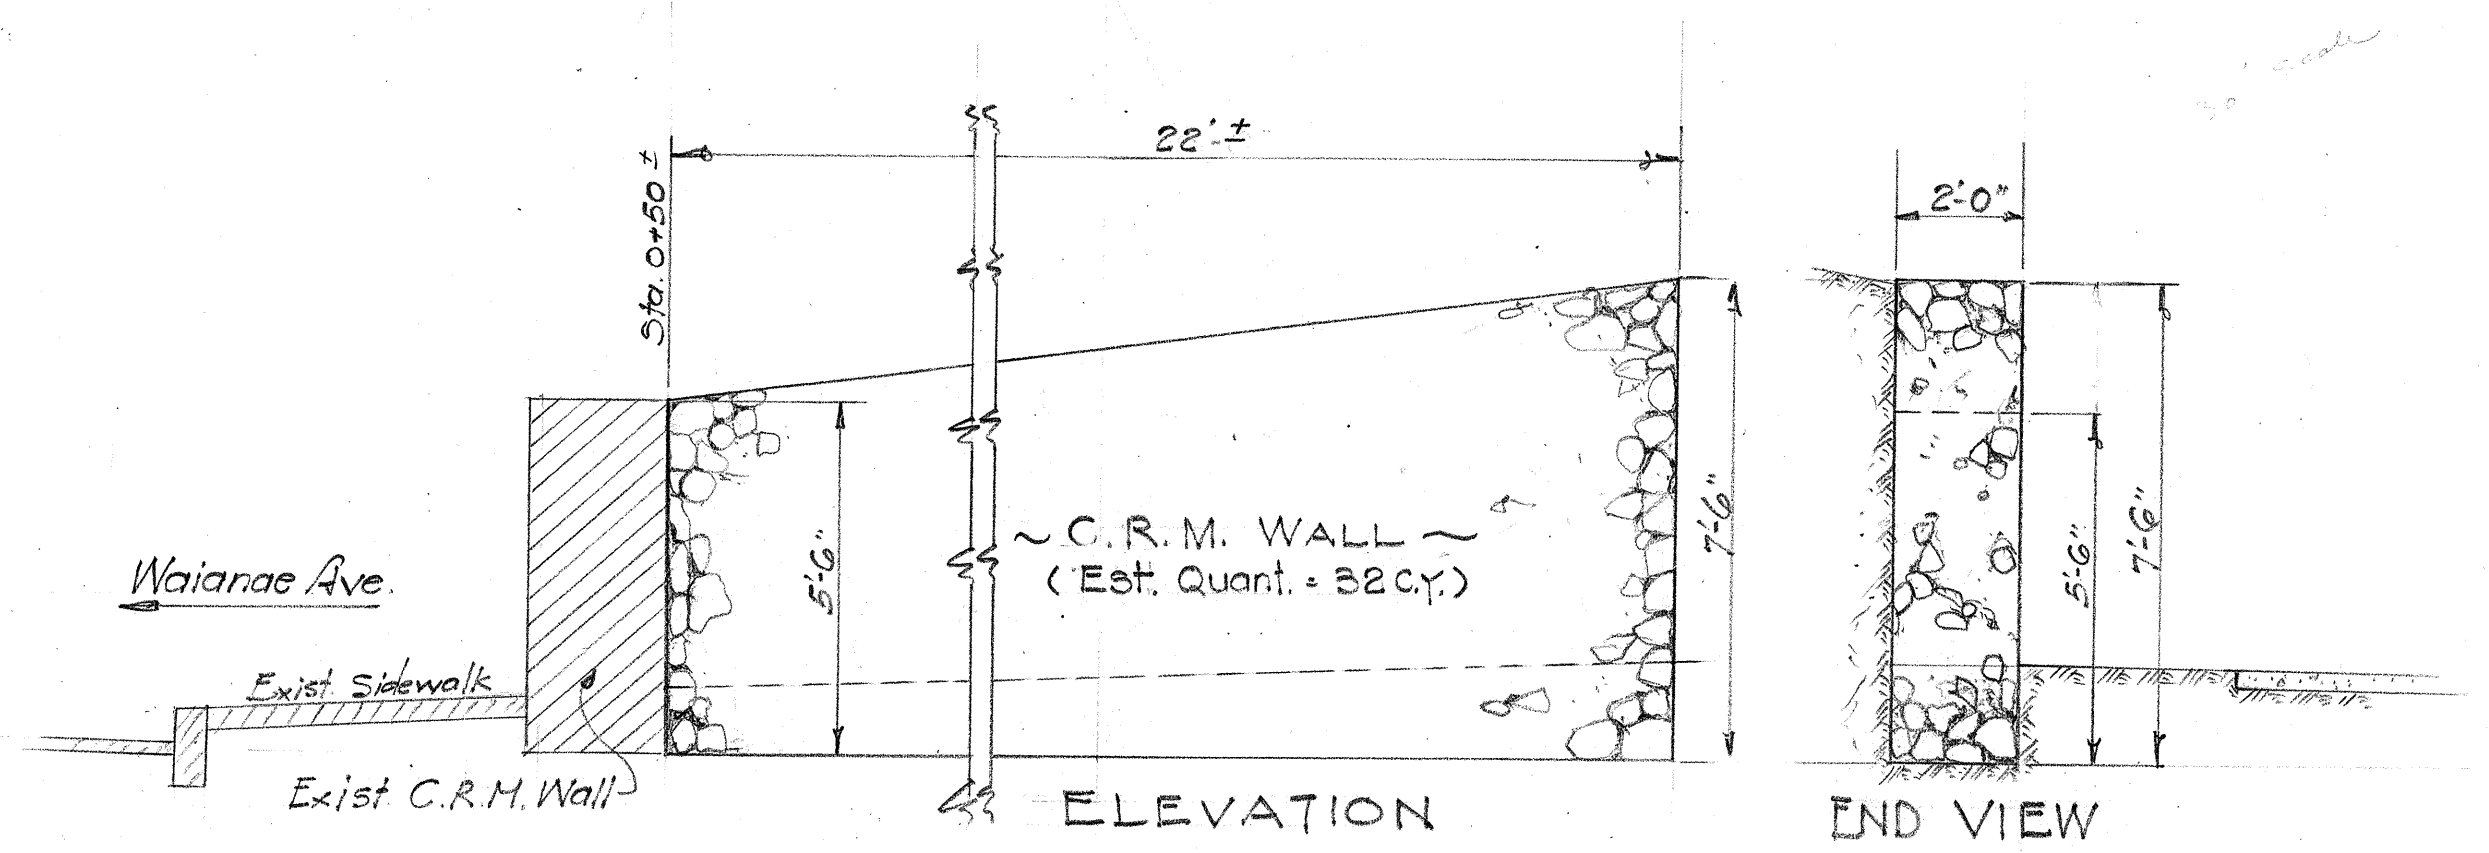

C.R.M. RETAINING WALL AT BEG. OF SPUR LINE "A"
 Scale: 1" = 3'-0"

ORIGINAL	SURVEY PLOTTED BY	DATE
DESIGNED BY		
DRAWN BY		
NOTE BOOK	QUANTITIES BY	
NO.	CHECKED BY	

TERRITORIAL HIGHWAY DEPARTMENT
TERRITORY OF HAWAII

INTERSECTION DETAILS
LINE "A" & WAIANAE AVE.
Schofield Wahiawa Cutoff
May 1944

DA-WR 7(1)

5135.5