


FED. ROAD DIST. NO.	STATE	FED. AID PROJ. NO.	FISCAL YEAR	SHEET NO.	TOTAL SHEETS
HAWAII	HAW	DA-NR 13 (2)	1944	20	79

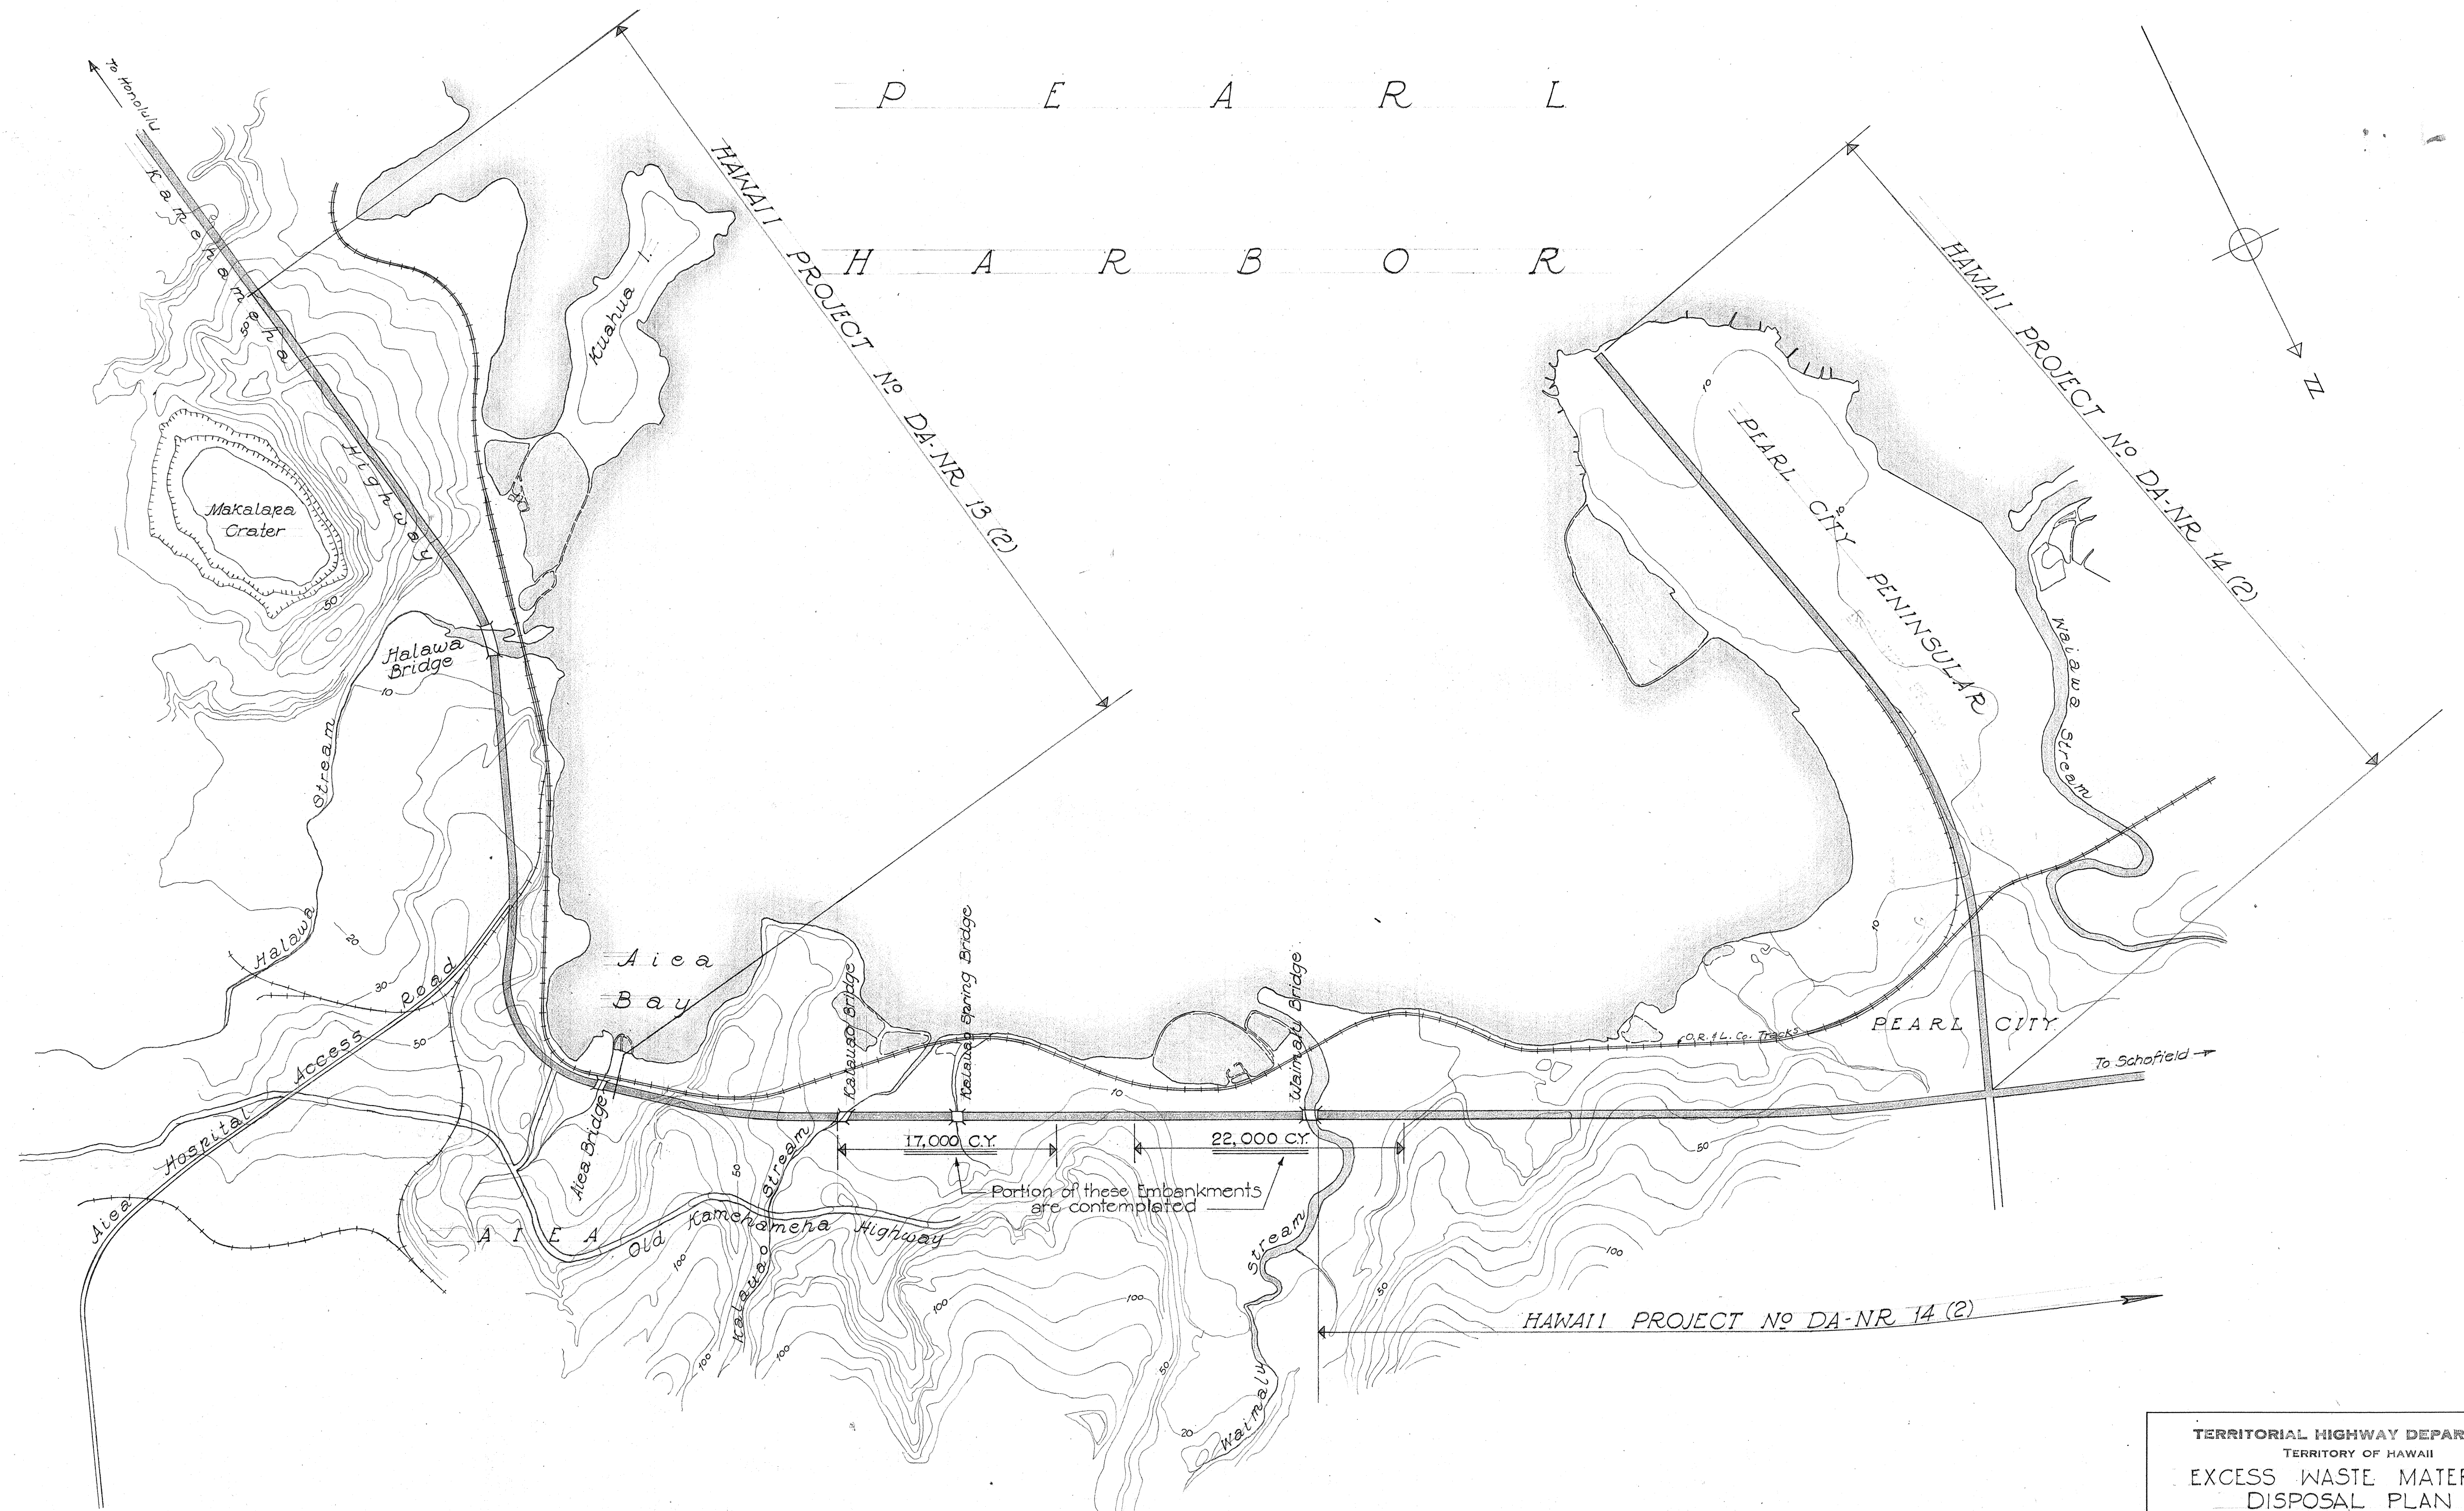

PLAN SHOWING DISPOSAL OF EXCESS WASTE MATERIAL FROM HAWAII PROJECT NO. DA-NR 13 (2)

Scale: 1:10,000

TERRITORIAL HIGHWAY DEPARTMENT
TERRITORY OF HAWAII
EXCESS WASTE MATERIAL
DISPOSAL PLAN

— KAMEHAMEHA HIGHWAY
— EAST GATE TO KALUAUO BRIDGE
— HAWAII PROJECT NO. DA-NR 13 (2)

SHEET NO. OF SHEETS

5143.20

ORIGINAL PLAN	SURVEY PLOTTED BY	DATE
DESIGNED BY		
DRAWN BY		
CHECKED BY		
NOTED BY		