

| INDEX TO DRAWINGS |                               |
|-------------------|-------------------------------|
| SHEET NO.         | DESCRIPTION                   |
| 1                 | Title Sheet                   |
| 2-3               | Typical Sections              |
| 4-11              | Plan & Profile - Roadway      |
| 12-19             | Plan & Profile - Utilities    |
| 20                | Excess Material Disposal Plan |
| 21-25             | Standard Details              |
| 26-28             | Pedestrian Underpass          |
| 29                | Standard Bridge Details       |
| 30-46             | Bridge Details                |
| 47-79             | Cross Sections                |

Tatsu: put this note in red and  
and have Howard sign it.

All changes made during  
construction have been shown  
in red on these tracings  
and checked by:

Resident Engineer  
Date:

TERRITORY OF HAWAII  
TERRITORIAL HIGHWAY DEPARTMENT  
HONOLULU T. H.

PLANS OF  
KAMEHAMEHA HIGHWAY  
HAWAII PROJECT NO. DA-NR 13 (2)  
EAST GATE TO AIEA BRIDGE

EWA DISTRICT  
ISLAND OF OAHU


| INDEX TO DRAWINGS<br>APPLICABLE TO HAW. PROJ. NO. DA-NR 13 (2) |                               |            |                                            |
|----------------------------------------------------------------|-------------------------------|------------|--------------------------------------------|
| REFERENCE NO.                                                  | DESCRIPTION                   | SHEET NO.  | SHEETS ADDED TO THIS PROJ.<br>JUNE 4, 1945 |
| 1                                                              | Title Sheet                   | 5143.1     |                                            |
| 2-3                                                            | Typical Sections              | 5143.2 & 3 | 5143.4A JUNE 26 '45                        |
| 4-10                                                           | Plan & Profile - Roadway      | 5143.4-10  | 5143.10A, 11A, 11B                         |
| 11-17                                                          | Plan & Profile - Utilities    | 5143.12-18 |                                            |
| 18                                                             | Excess Material Disposal Plan | 5143.20    |                                            |
| 19-22                                                          | Standard Details              | 5143.21-24 |                                            |
| 23-25                                                          | Pedestrian Underpasses        | 5143.26-28 |                                            |
| 26                                                             | Standard Bridge Details       | 5143.29    |                                            |
| 27-34                                                          | Bridge Details                | 5143.30-37 |                                            |
| 35-60                                                          | Cross Sections                | 5143.47-72 | 5143.73 — 79A                              |

SCALE


PLAN ..... 1 INCH = 50 FEET

PROFILE ..... { HOR. 1 INCH = 50 FEET  
VER. 1 INCH = 5 FEET

CROSS SECTIONS ..... { HOR. 1 INCH = 10 FEET  
VER. 1 INCH = 5 FEET

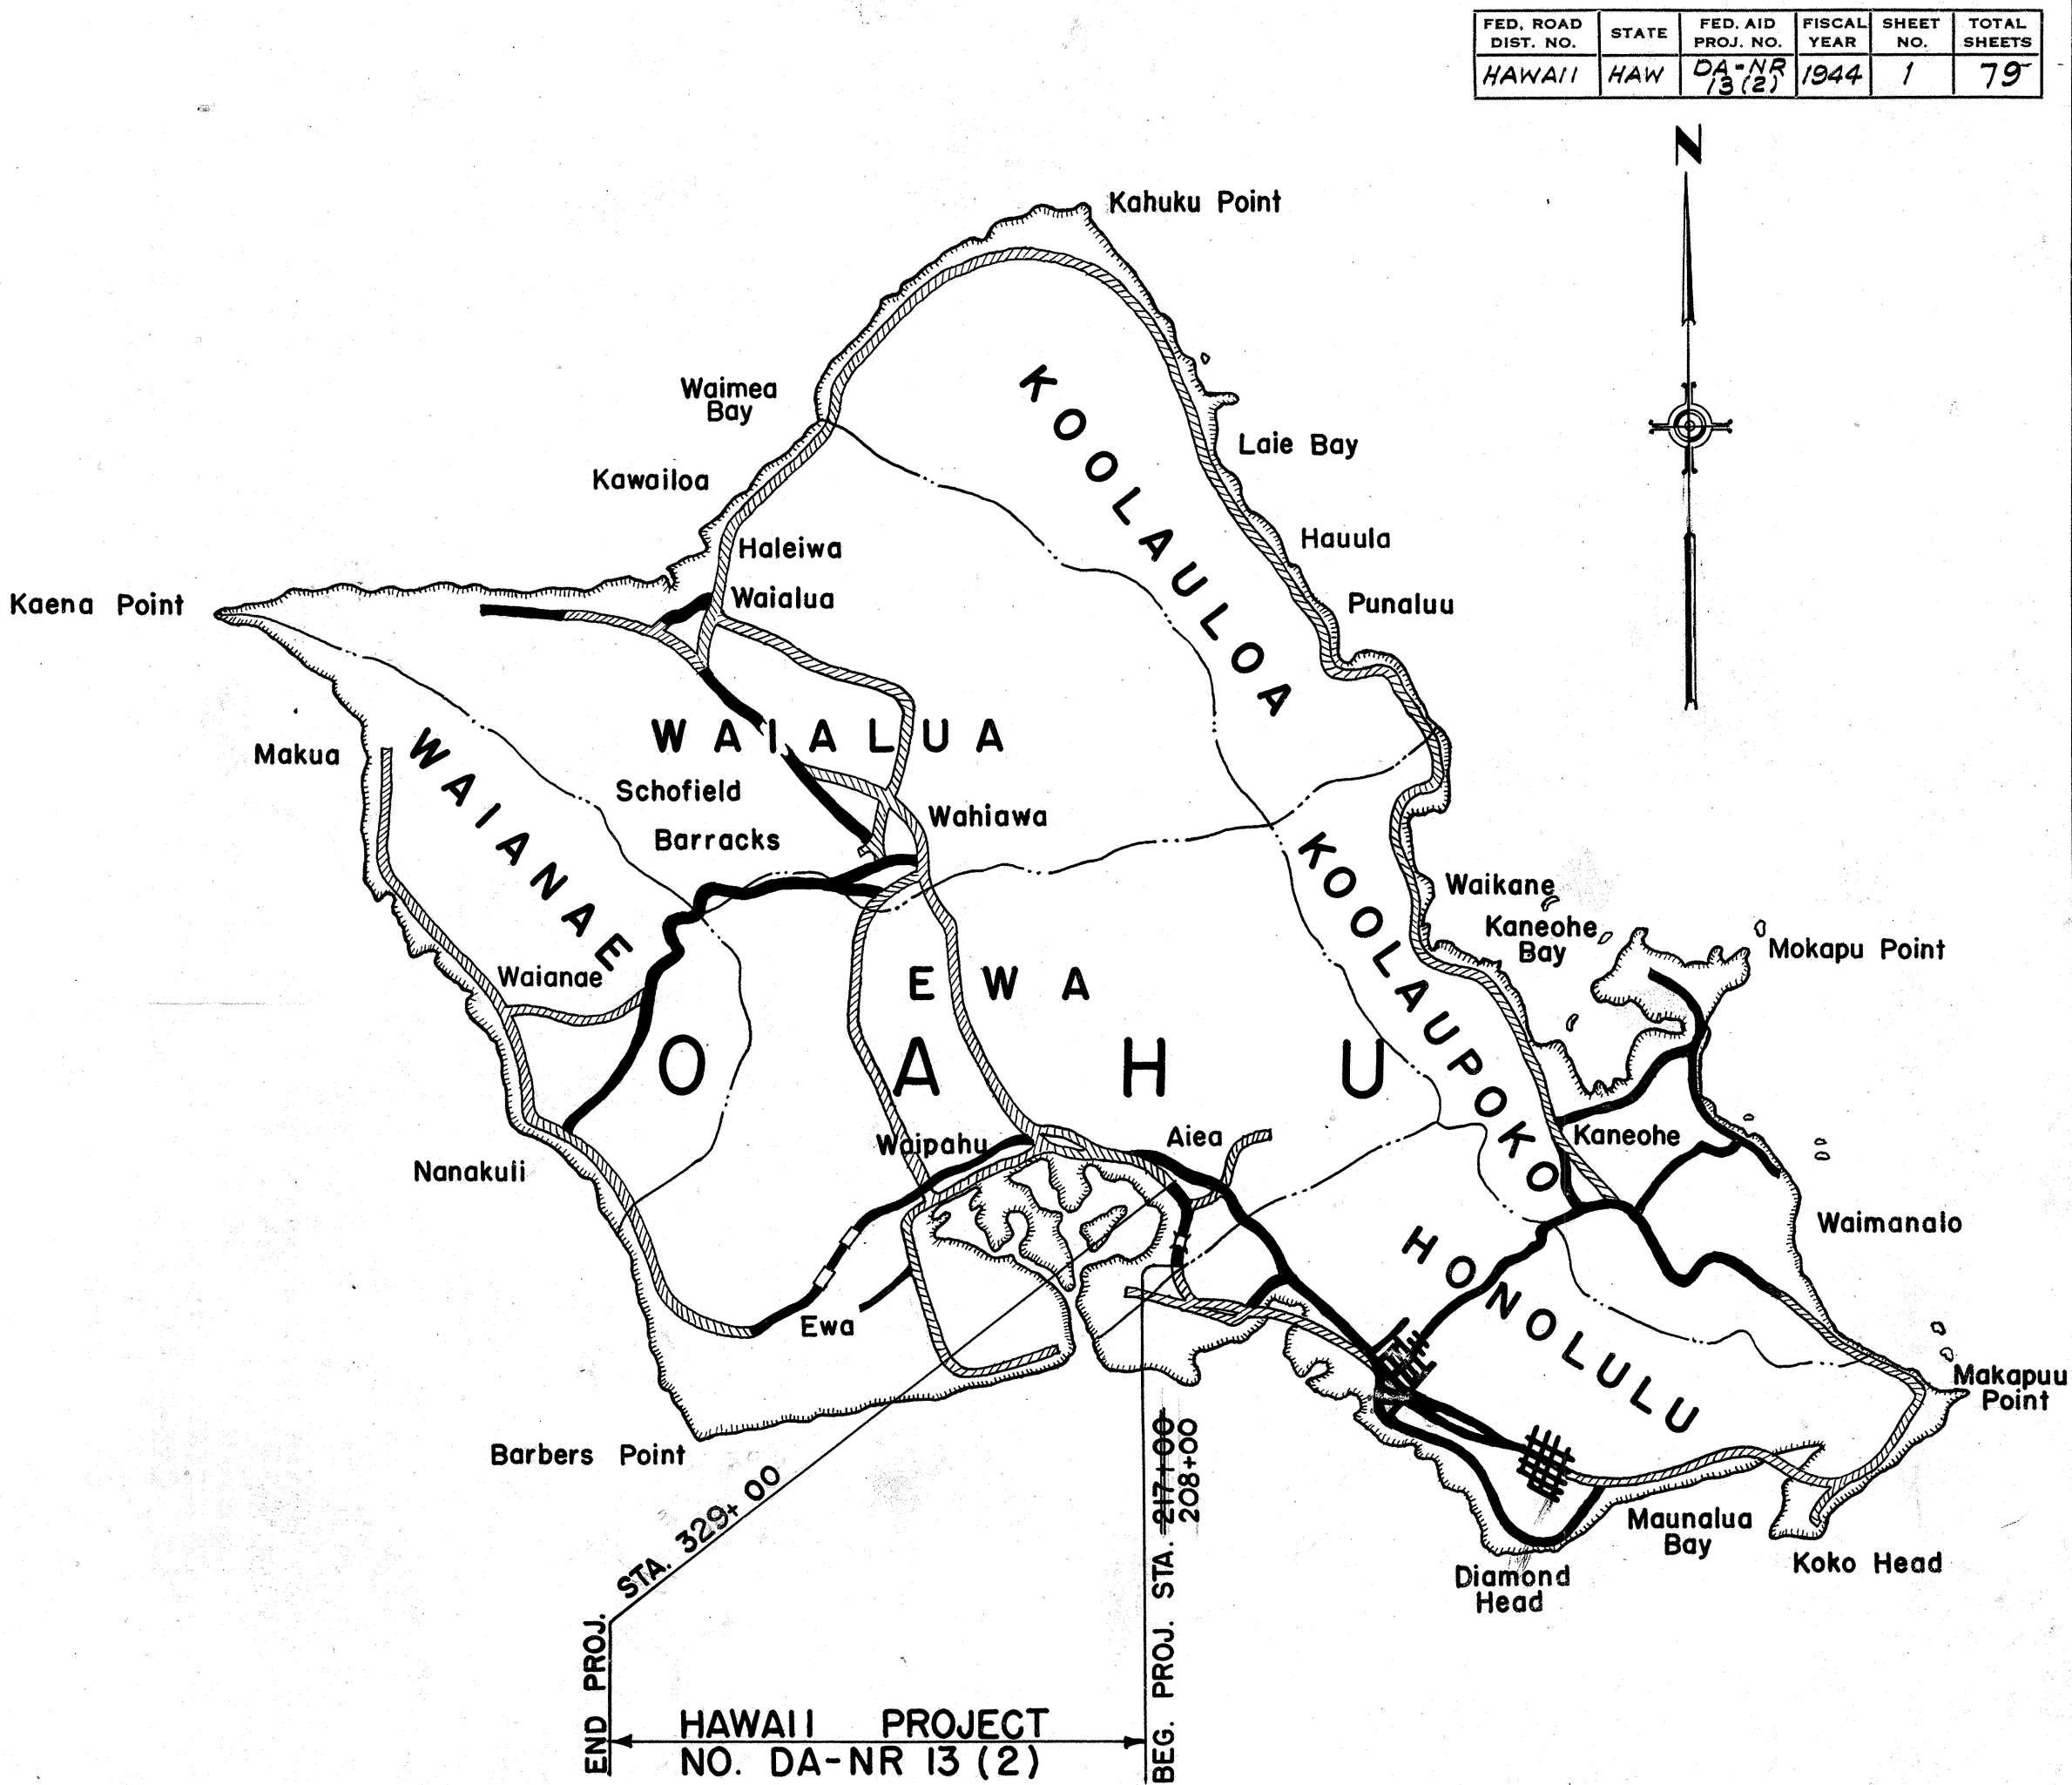

Federal Aid Projects previously constructed or under construction.

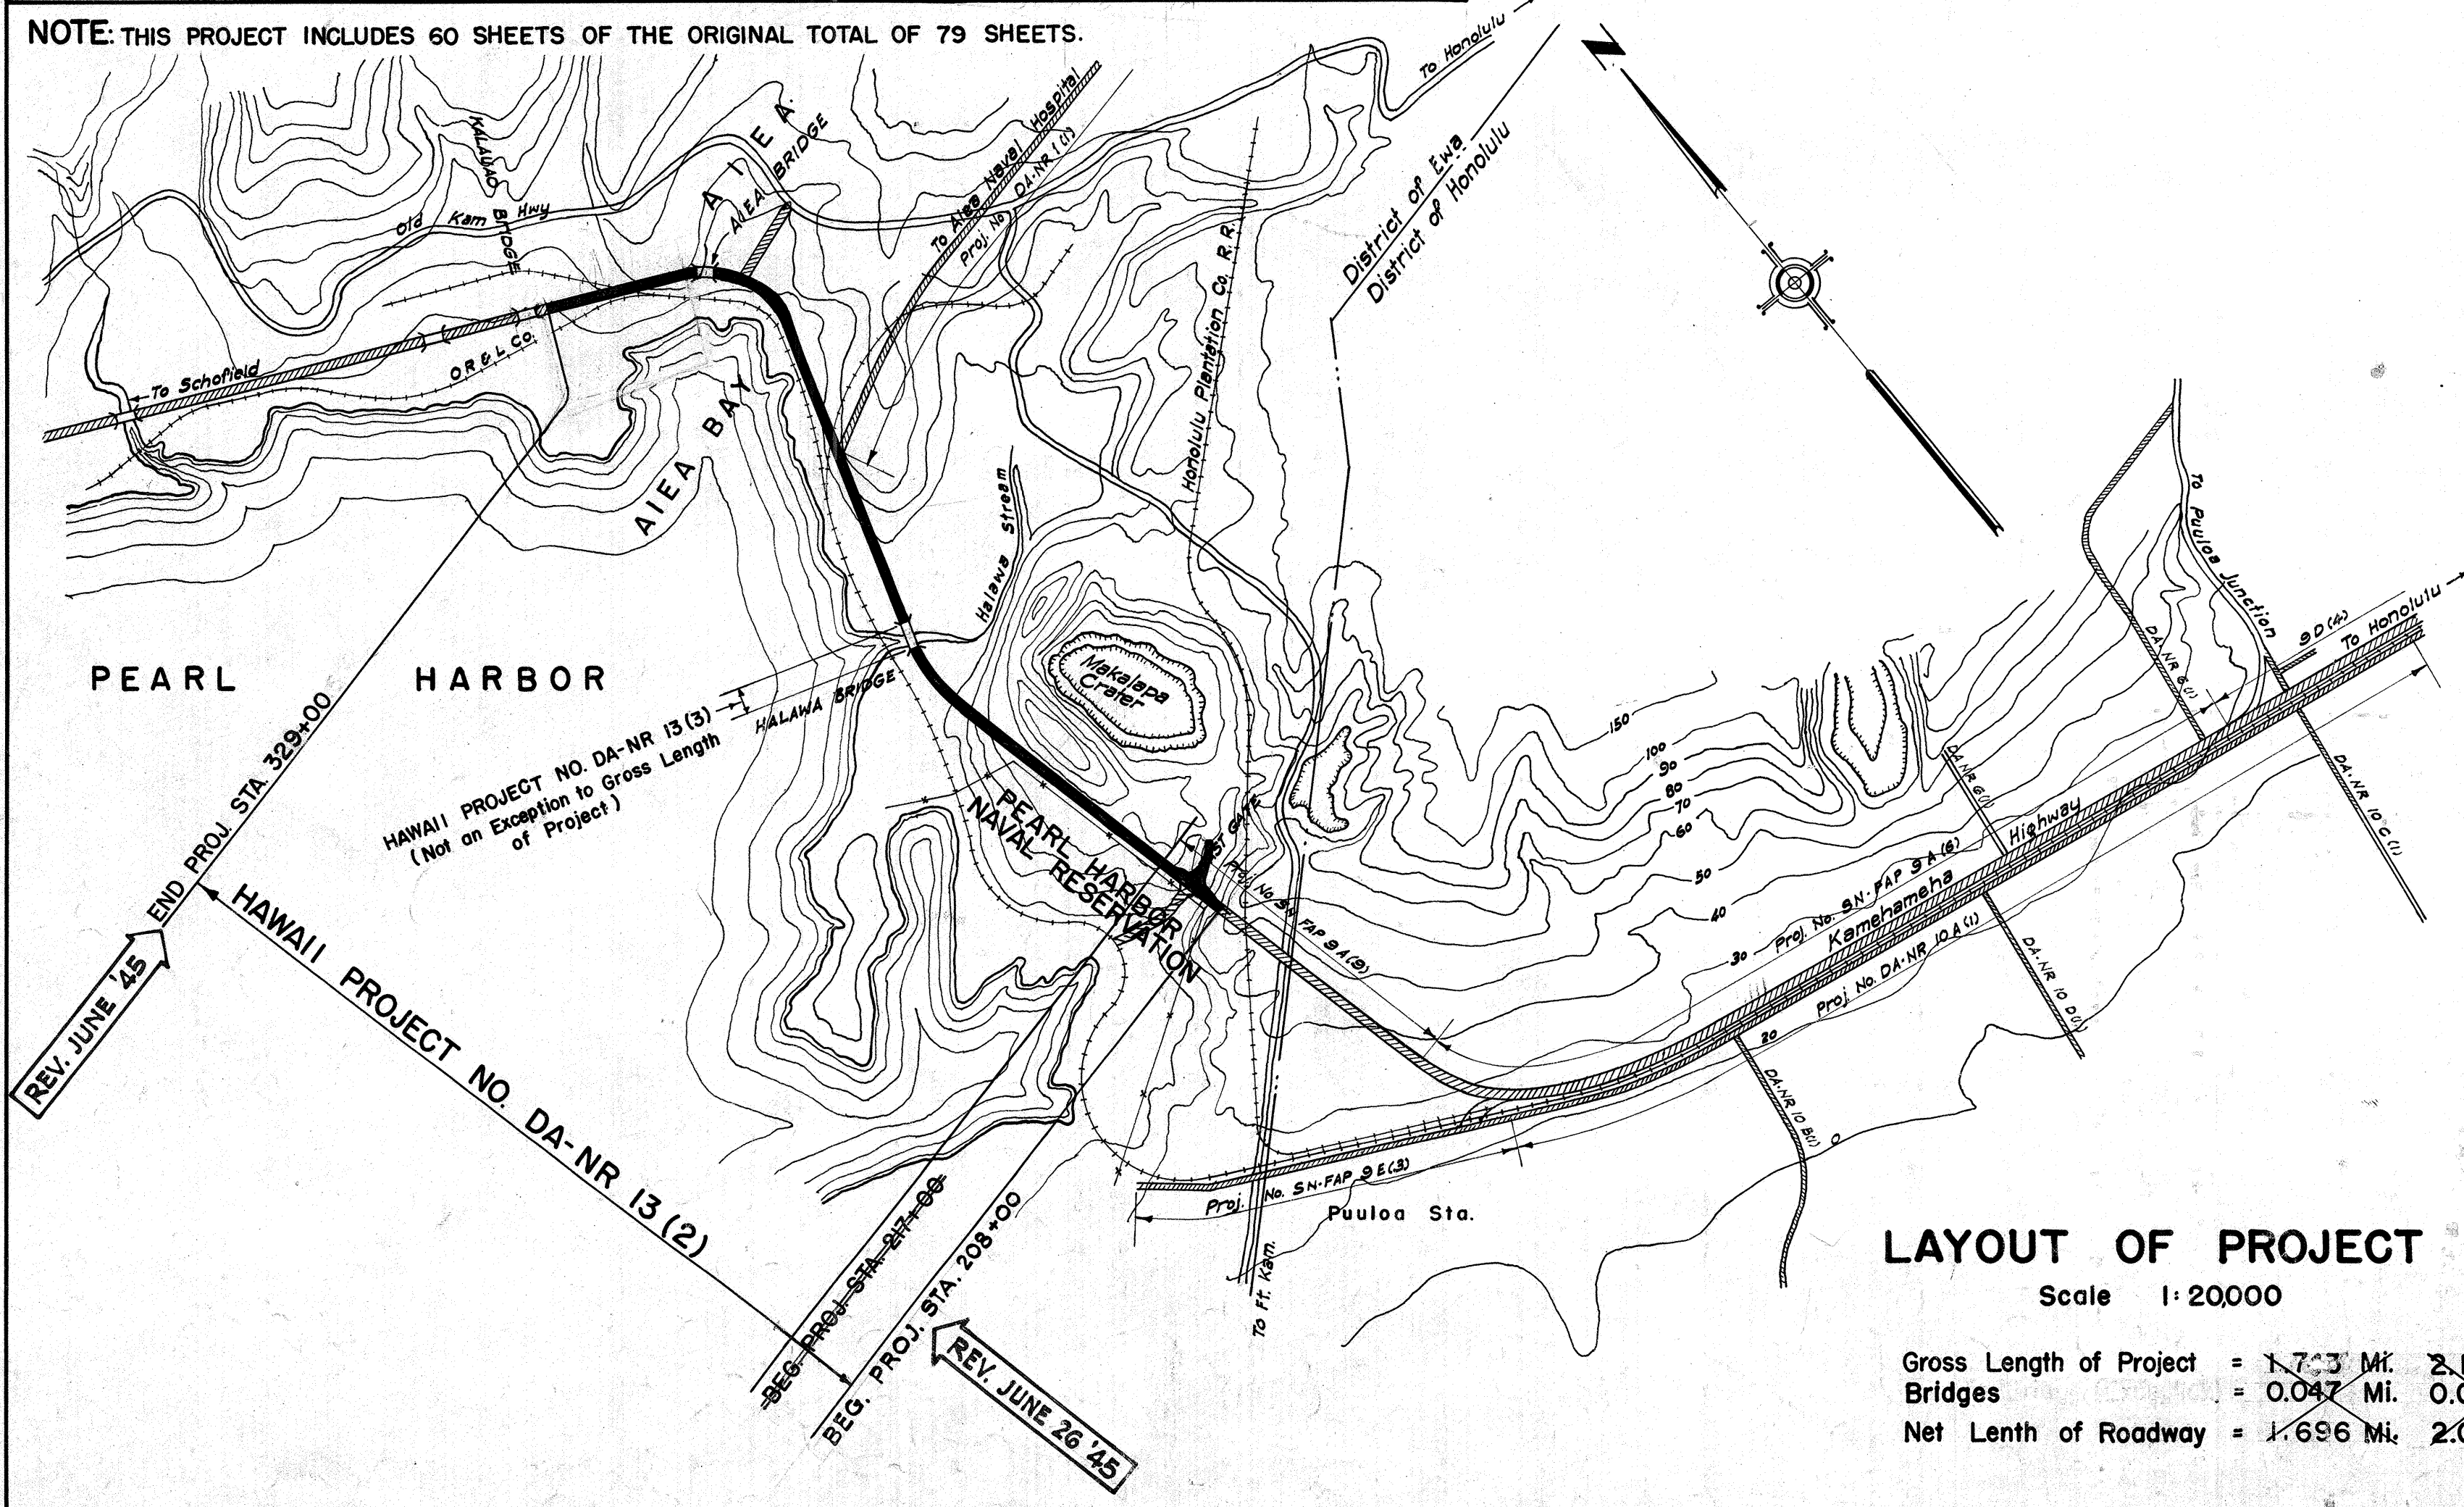

LAYOUT OF PROJECT  
Scale 1:20,000

Gross Length of Project = 1.703 Mi. 2.141 Mi.  
Bridges = 0.047 Mi. 0.047 Mi.  
Net Length of Roadway = 1.656 Mi. 2.094 Mi.

REV. JUNE '45

2.312 Mi.  
0.047 Mi. REV. JUNE 26 '45  
2.265 Mi.

APPROVED

APPROVED

*B.F. Rush*  
Date: Oct 23, '44  
TERRITORIAL HIGHWAY ENGINEER

RECOMMENDED FOR APPROVAL

DISTRICT ENGINEER  
PUBLIC ROADS ADMINISTRATION  
FEDERAL WORKS AGENCY

RECOMMENDED FOR APPROVAL

CHIEF, WESTERN REGION  
PUBLIC ROADS ADMINISTRATION  
FEDERAL WORKS AGENCY

APPROVED

COMMISSIONER  
PUBLIC ROADS ADMINISTRATION  
FEDERAL WORKS AGENCY

5143.1