




FED. ROAD DIST. NO.	STATE	FED. AID PROJ. NO.	FISCAL YEAR	SHEET NO.	TOTAL SHEETS
HAWAII	HAW.	DA-NR 13 (2)	1944	2	70

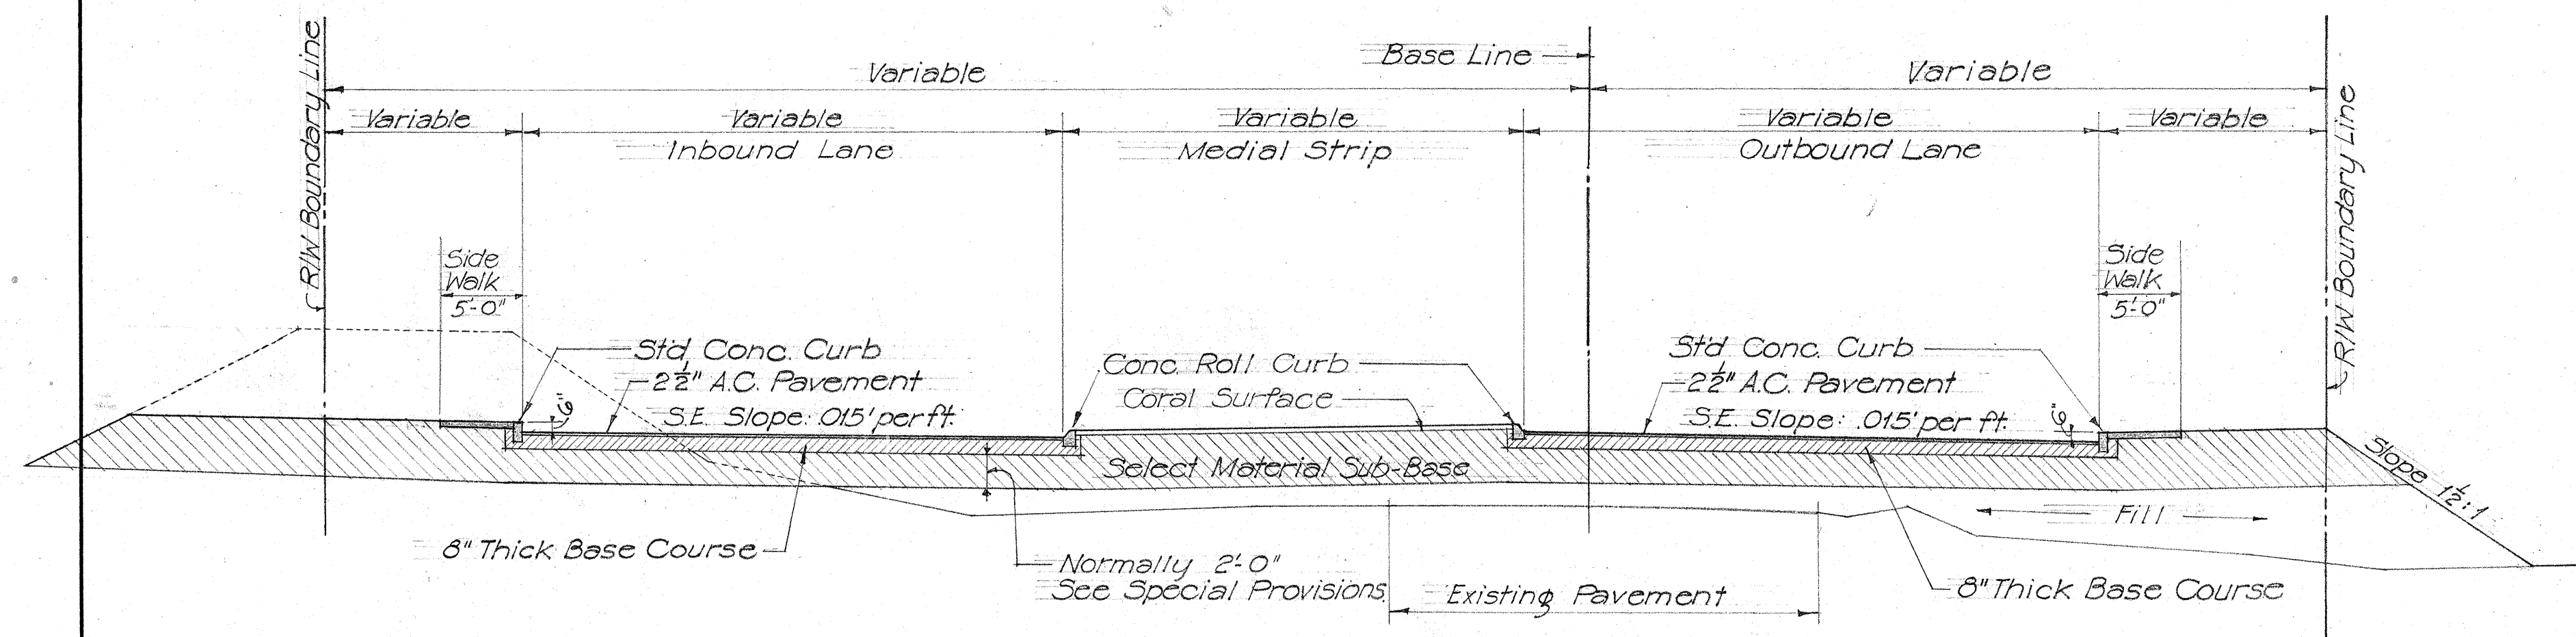


SECTION AT STA. 253+00

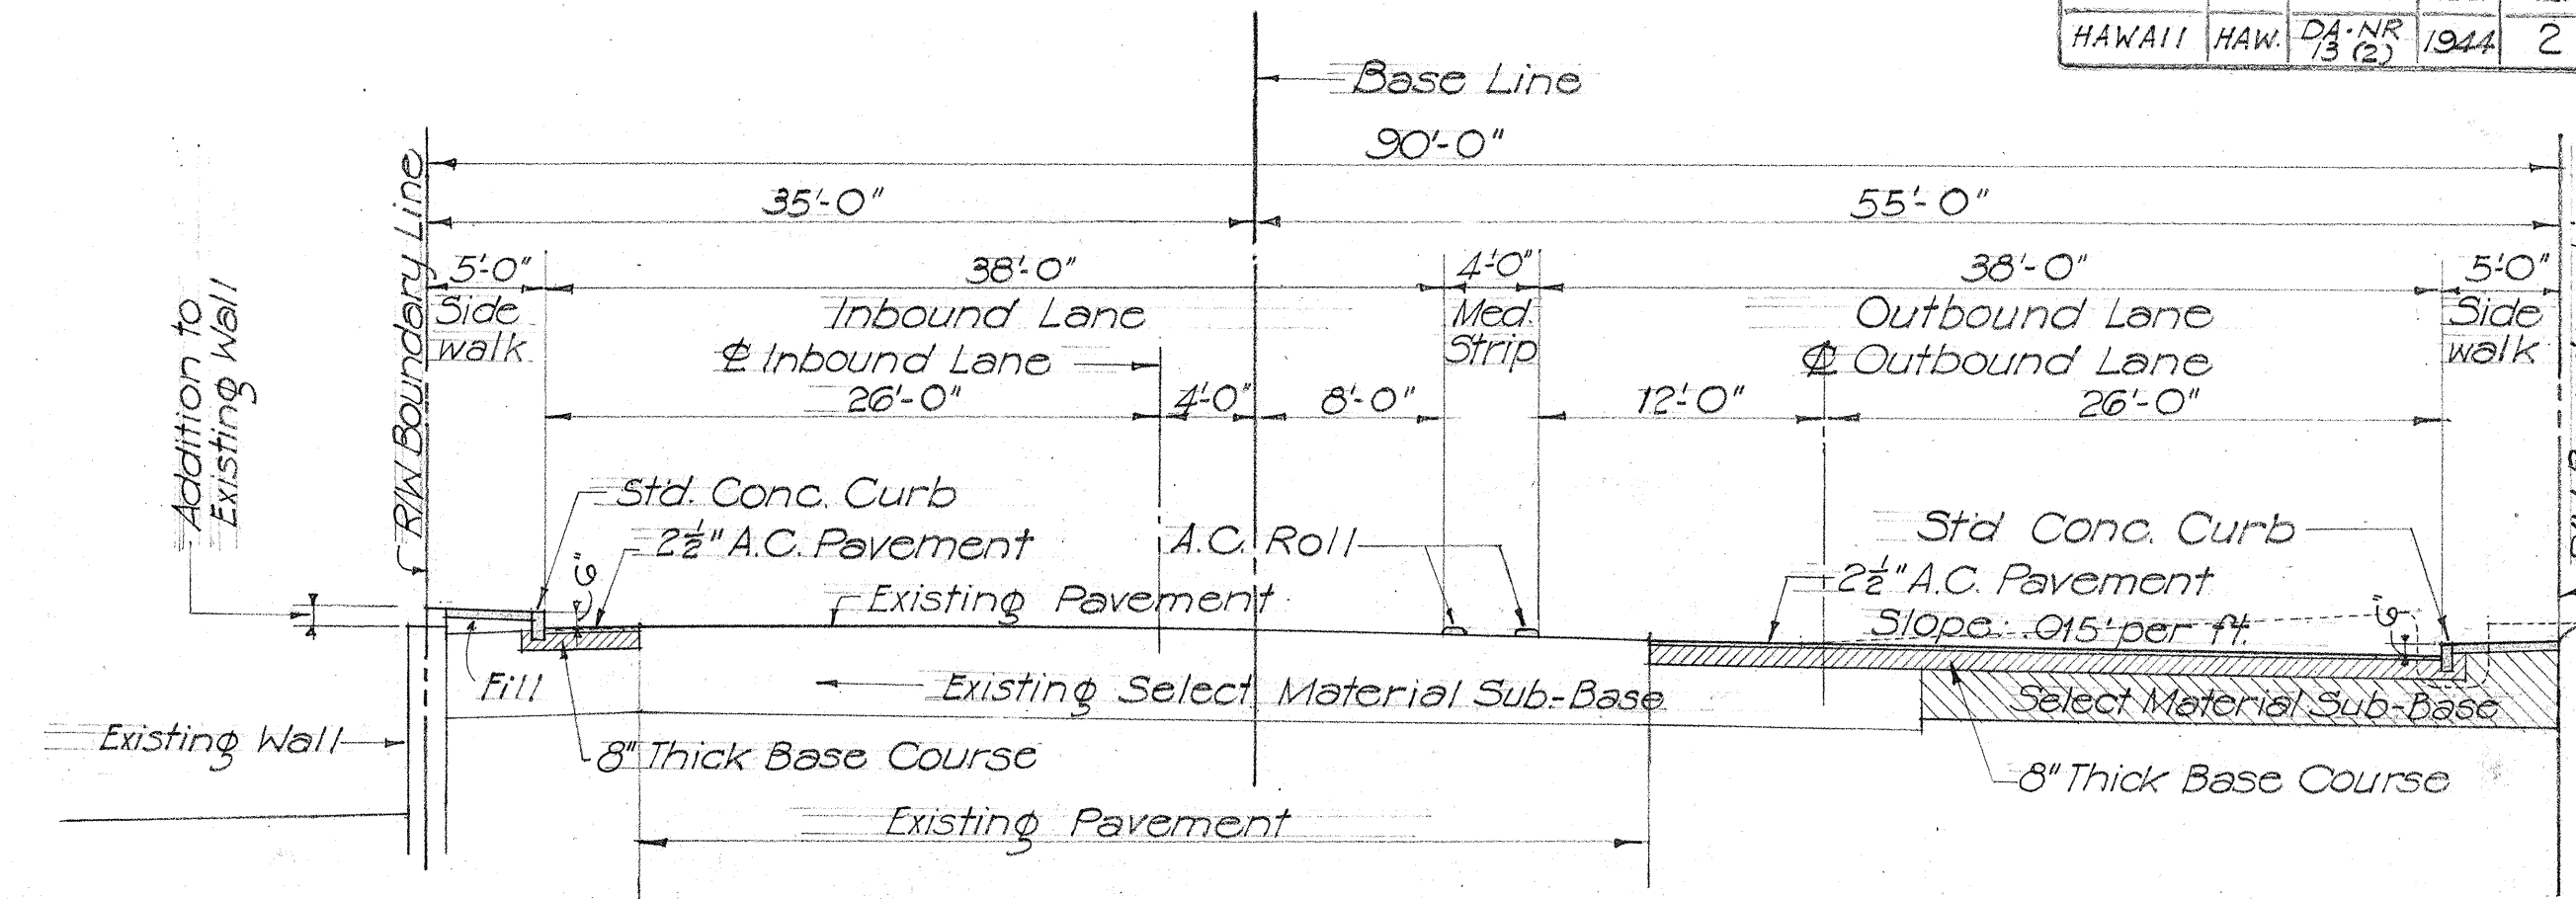

SECTION AT STA. 272+79.36

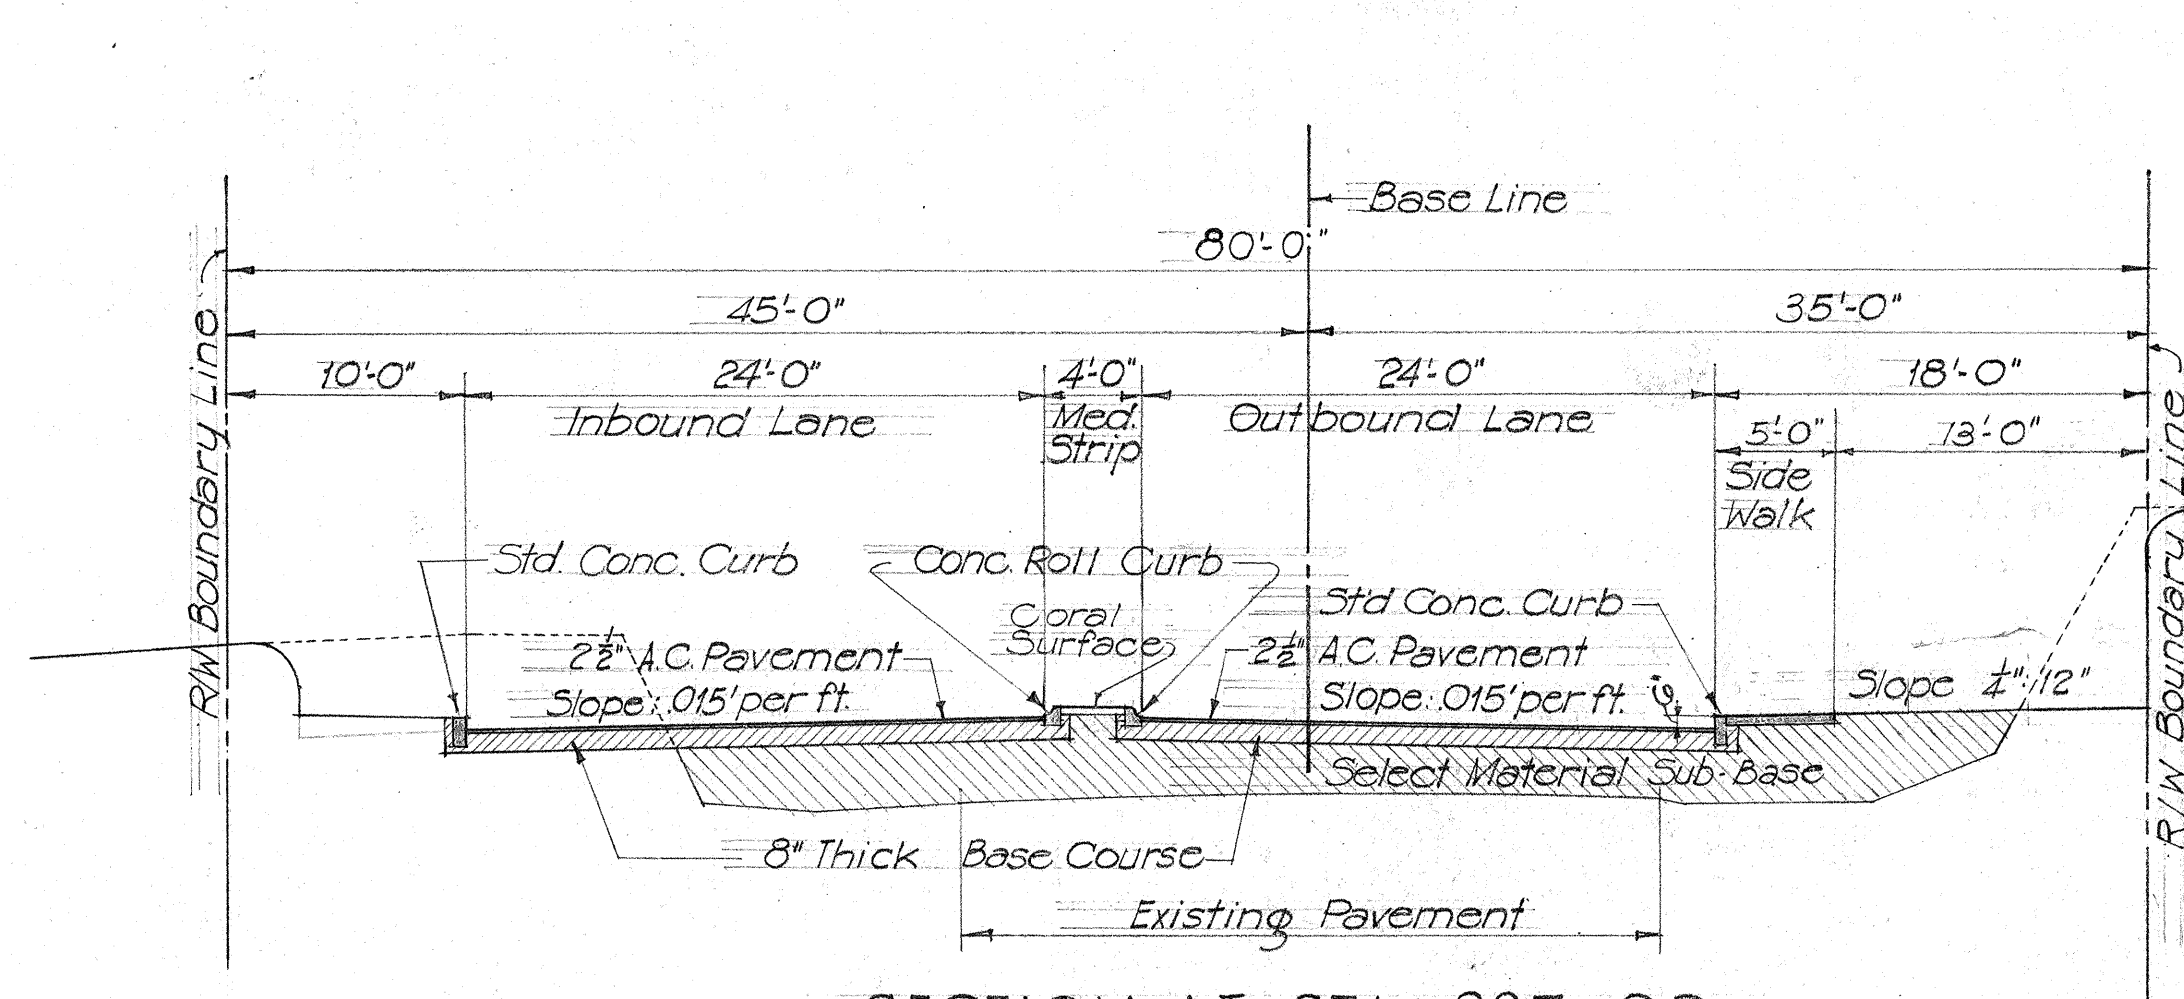


SECTION AT STA. 237+00

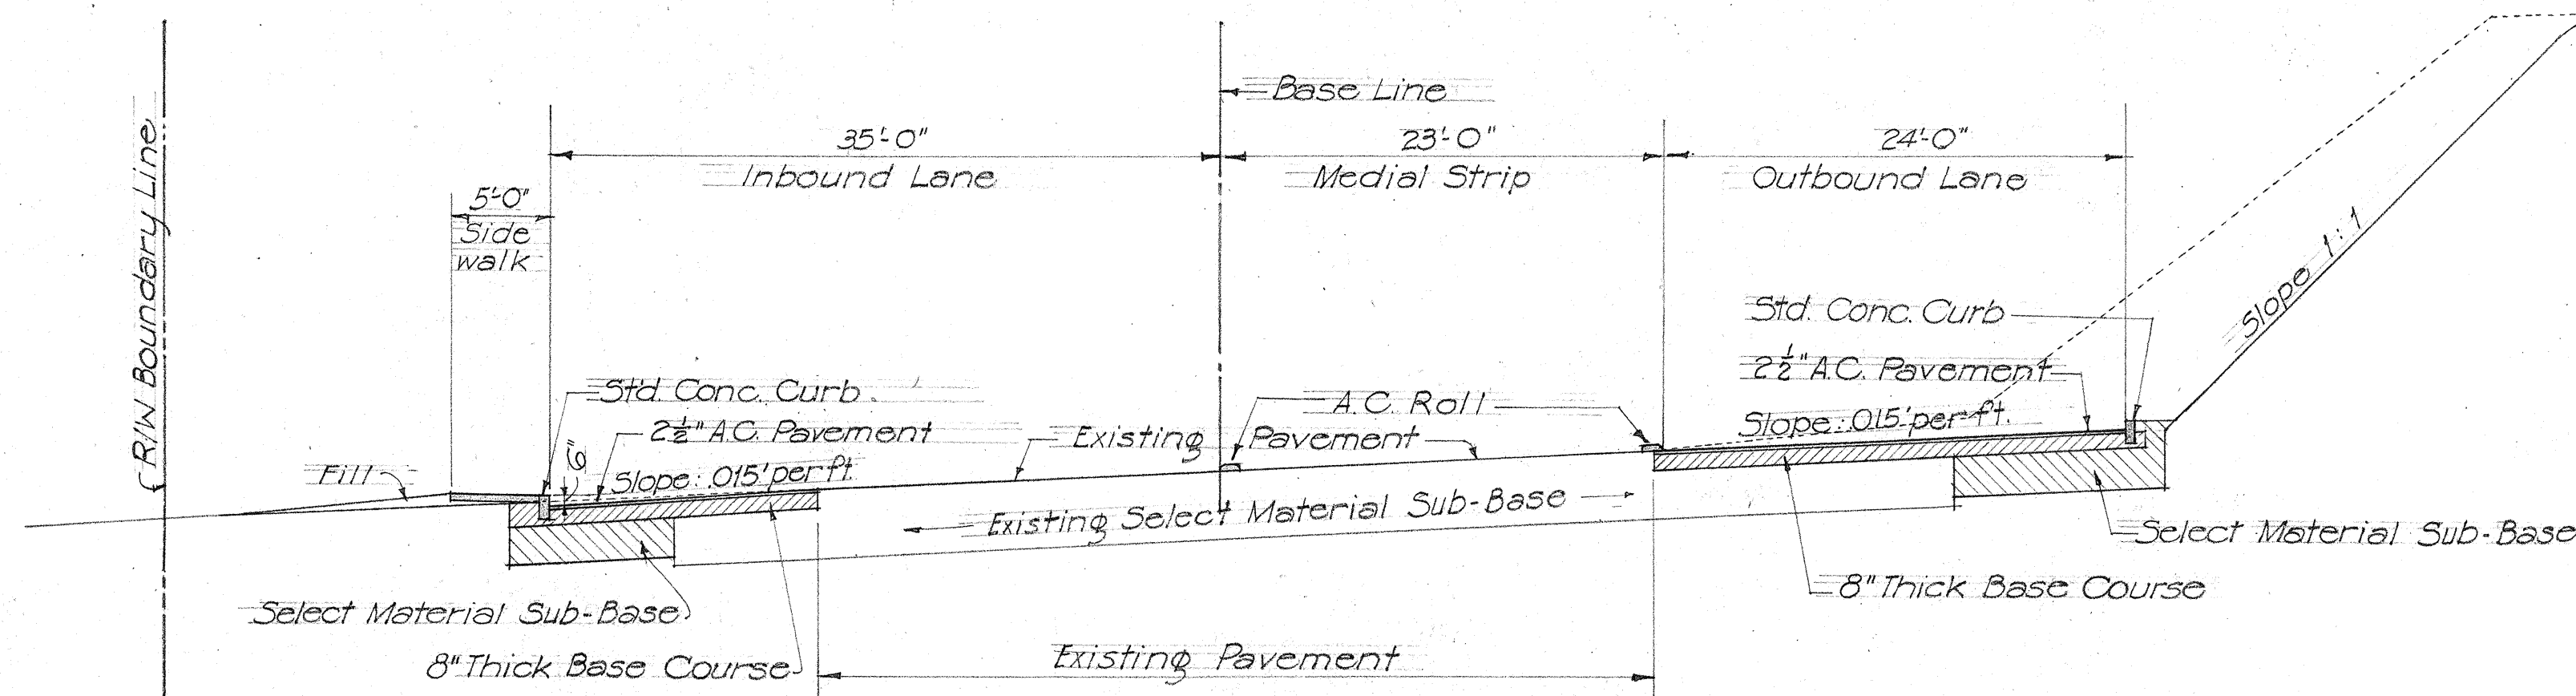


SECTION AT STA. 300+00

NOTE:

A 2 1/2" Asphalt Concrete Surface Course shall be constructed wherever notes on Plans refer to a 2 1/2" A.C. Pavement.

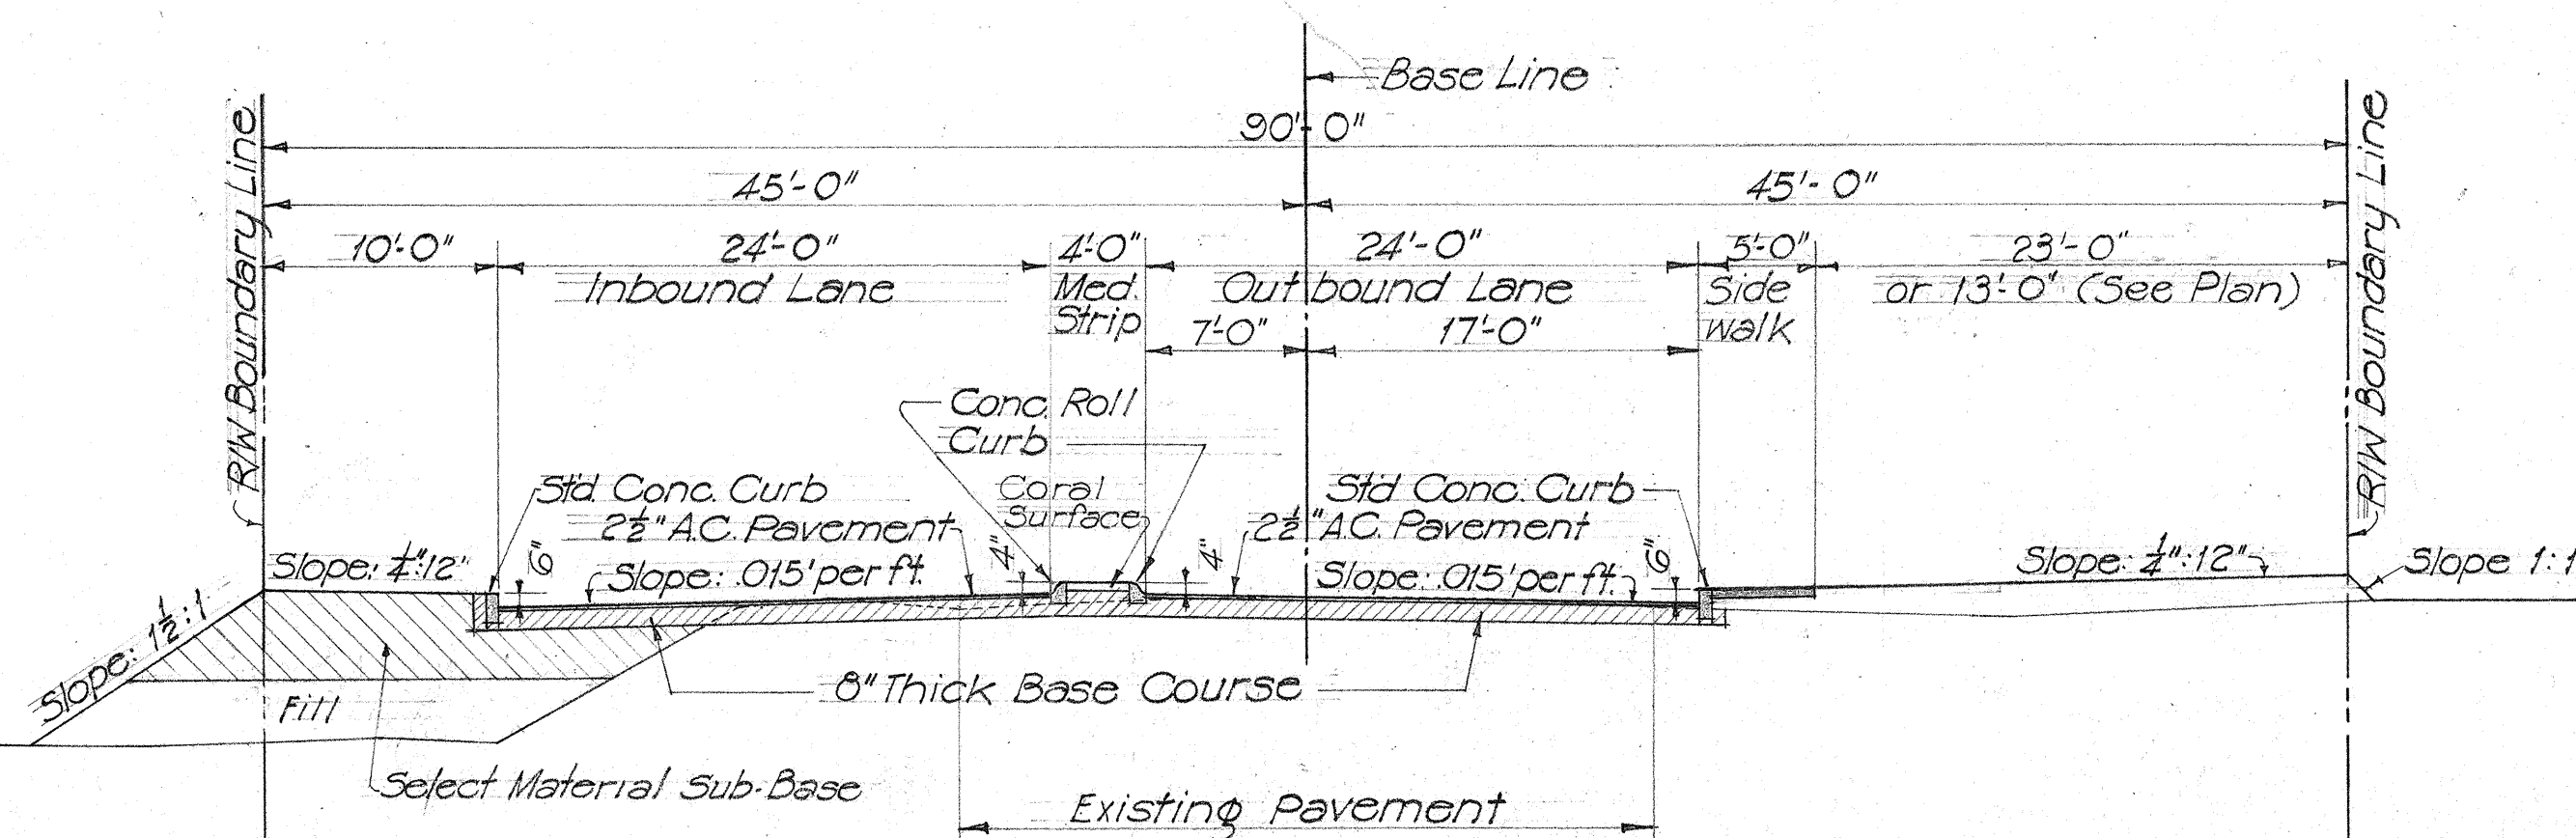

SECTION AT STA. 223+50

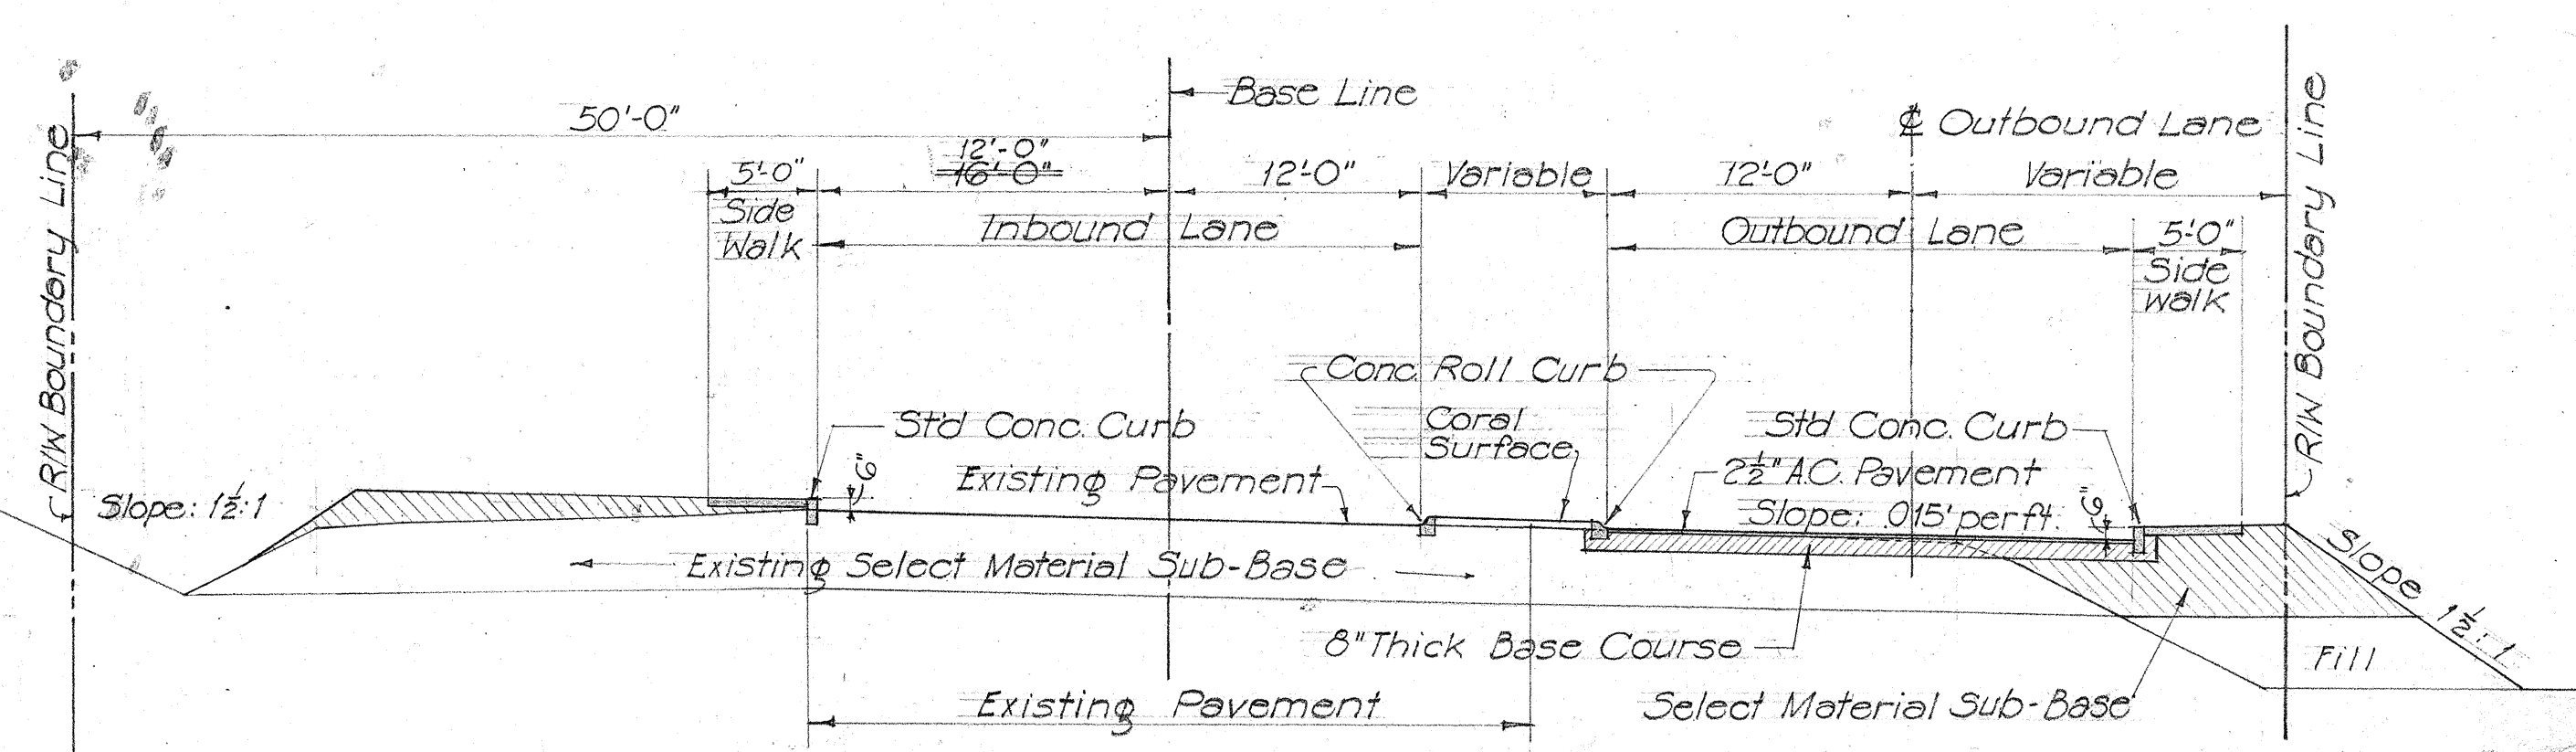

SECTION AT STA. 268+50


NOTES:

- 1 - Std. Conc. Curb shall be:
Std. Precast Concrete Curb or
Std. Cast-in-place Concrete Curb.
- 2 - Concrete Roll Curb shall be:
Cast-in-place Concrete Roll Curb.
- 3 - Above depends on bid items accepted.

Scale: 1/8" = 1'-0"


SECTIONS
AT STATIONS
KAMEHAMEHA HIGHWAY
EAST GATE TO KALAUAO BRIDGE
HAWAII PROJECT NO DA-NR 13 (2)
Scale: As Noted.

FED. ROAD DIST. NO.	STATE	FED. AID PROJ. NO.	FISCAL YEAR	DESIGN NO.	TOTAL SHEETS
HAWAII	HAW.	DA-NR 13 (2)	1944	3	70

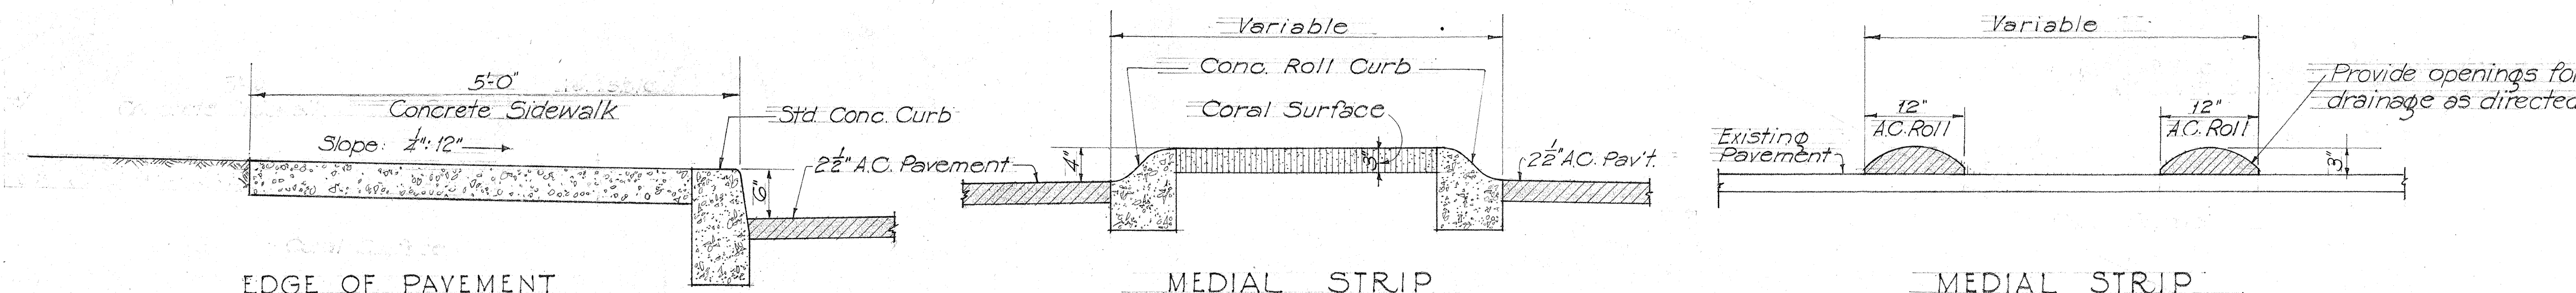

TYPICAL SECTIONS SHOWING USE OF CORAL SURFACE AND OILED CORAL SURFACE

Scale: 1" = 1'-0"

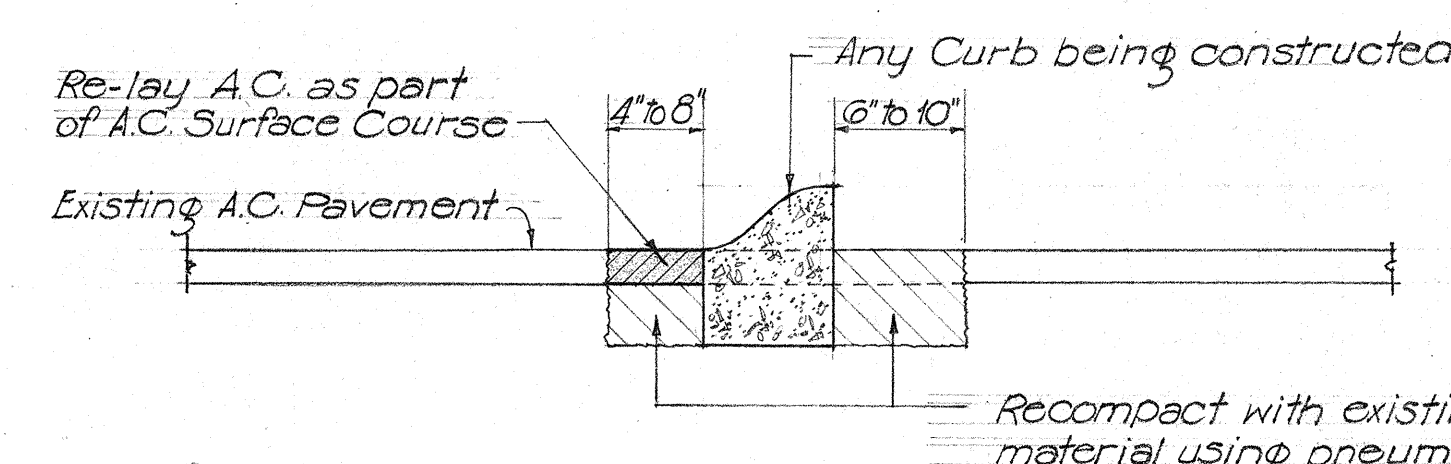


NOTE:

Use same treatment for curbs or gutters near or adjacent to existing pavements.


DETAIL OF CURB CONSTRUCTION WHERE EXISTING PAVEMENT IS TO REMAIN IN PLACE

Scale: 1" = 1'-0"

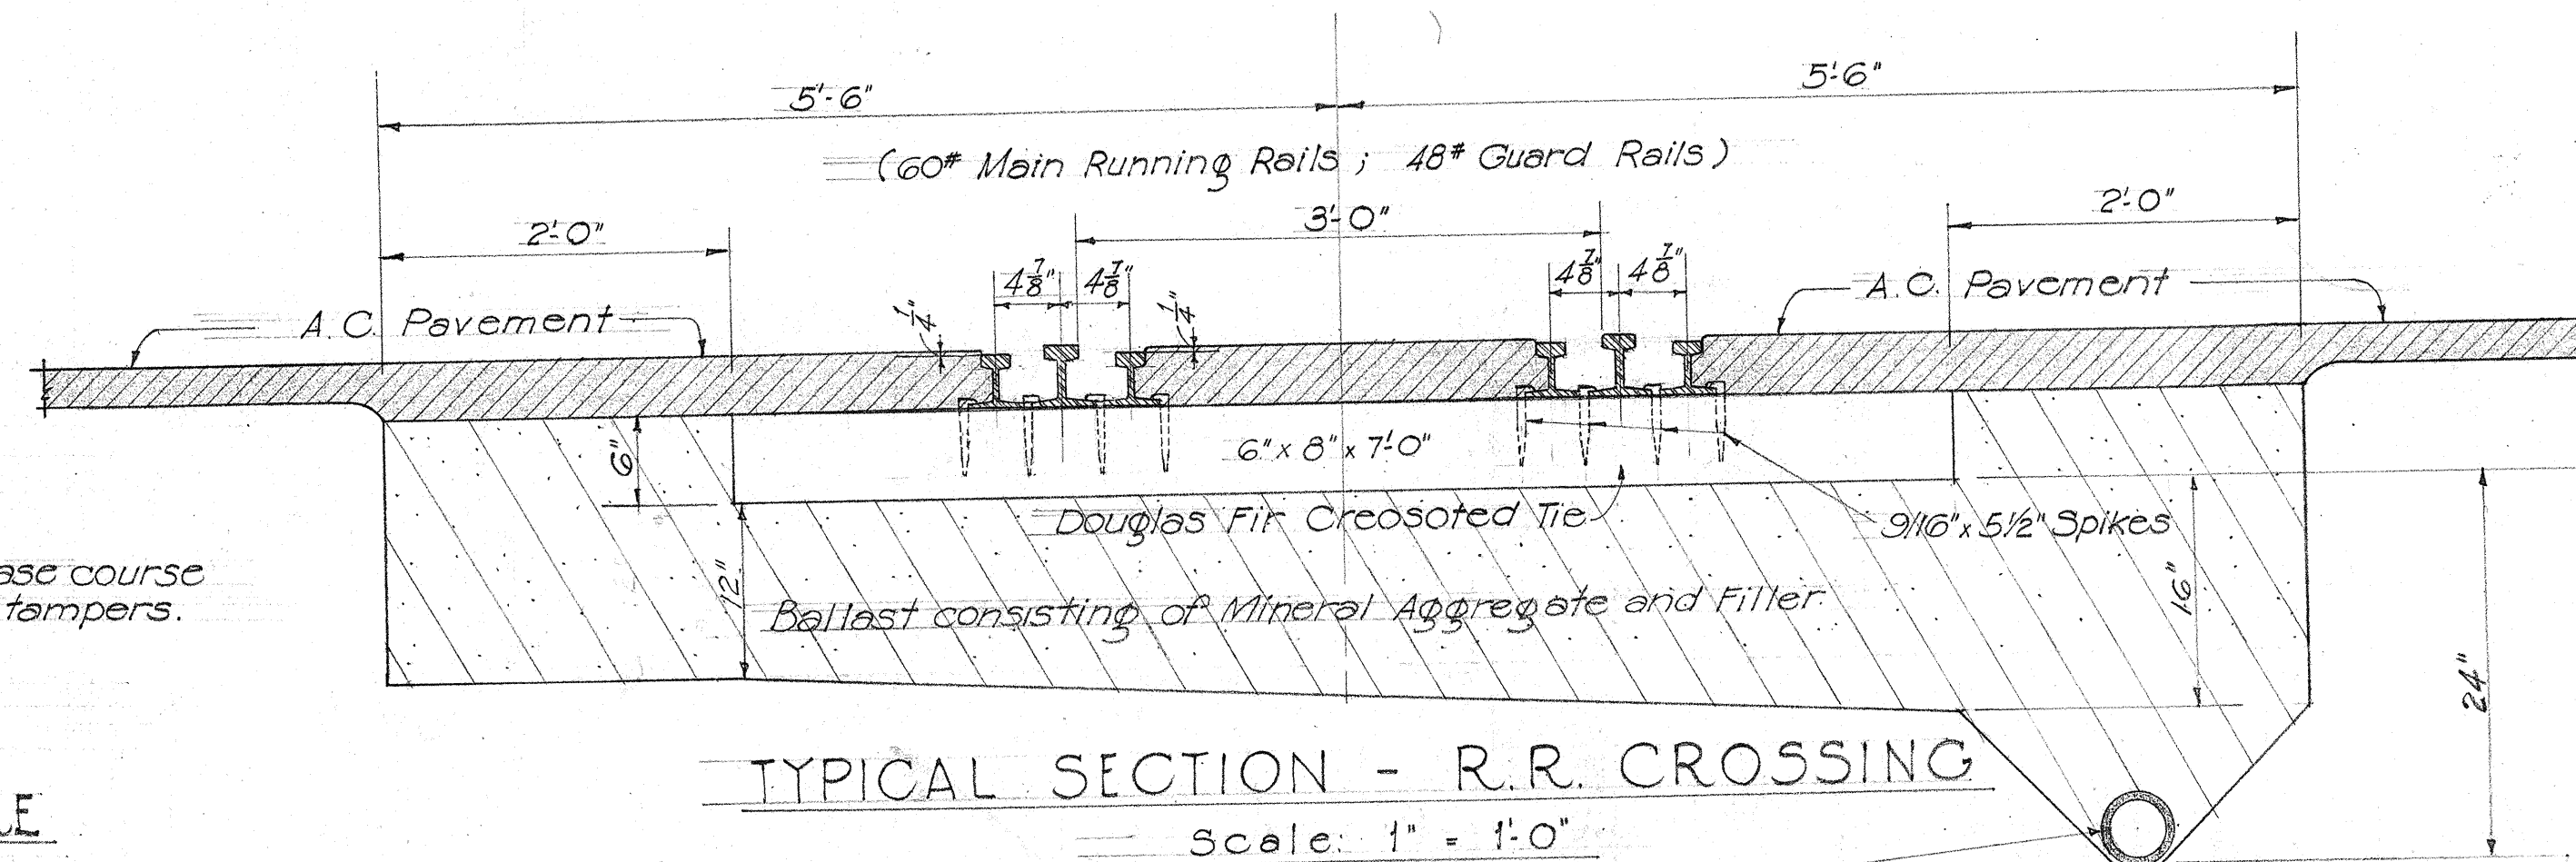

TYPICAL SECTION - R.R. CROSSING

Scale: 1" = 1'-0"

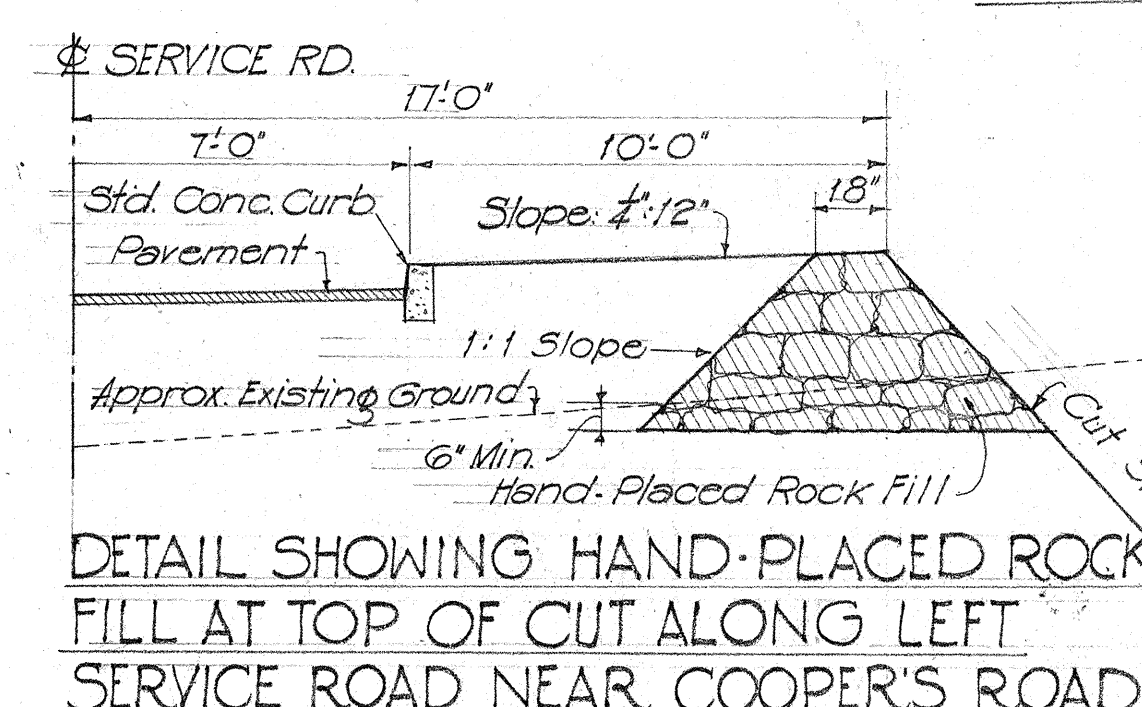


DETAIL SHOWING HAND-PLACED ROCK FILL AT TOP OF CUT ALONG LEFT SERVICE ROAD NEAR COOPER'S ROAD

Scale: 1/4" = 1'-0"



4" Butt-joint Tile Drain shall run continuously through all sections of R.R. Crossing and between same discharging in low ground at West End - See approx. location Sht. #5143, 8 This is incidental to Item "Railroad Crossing"

NOT PART OF HAW. PROJ. NO DA-NR 13 (2)

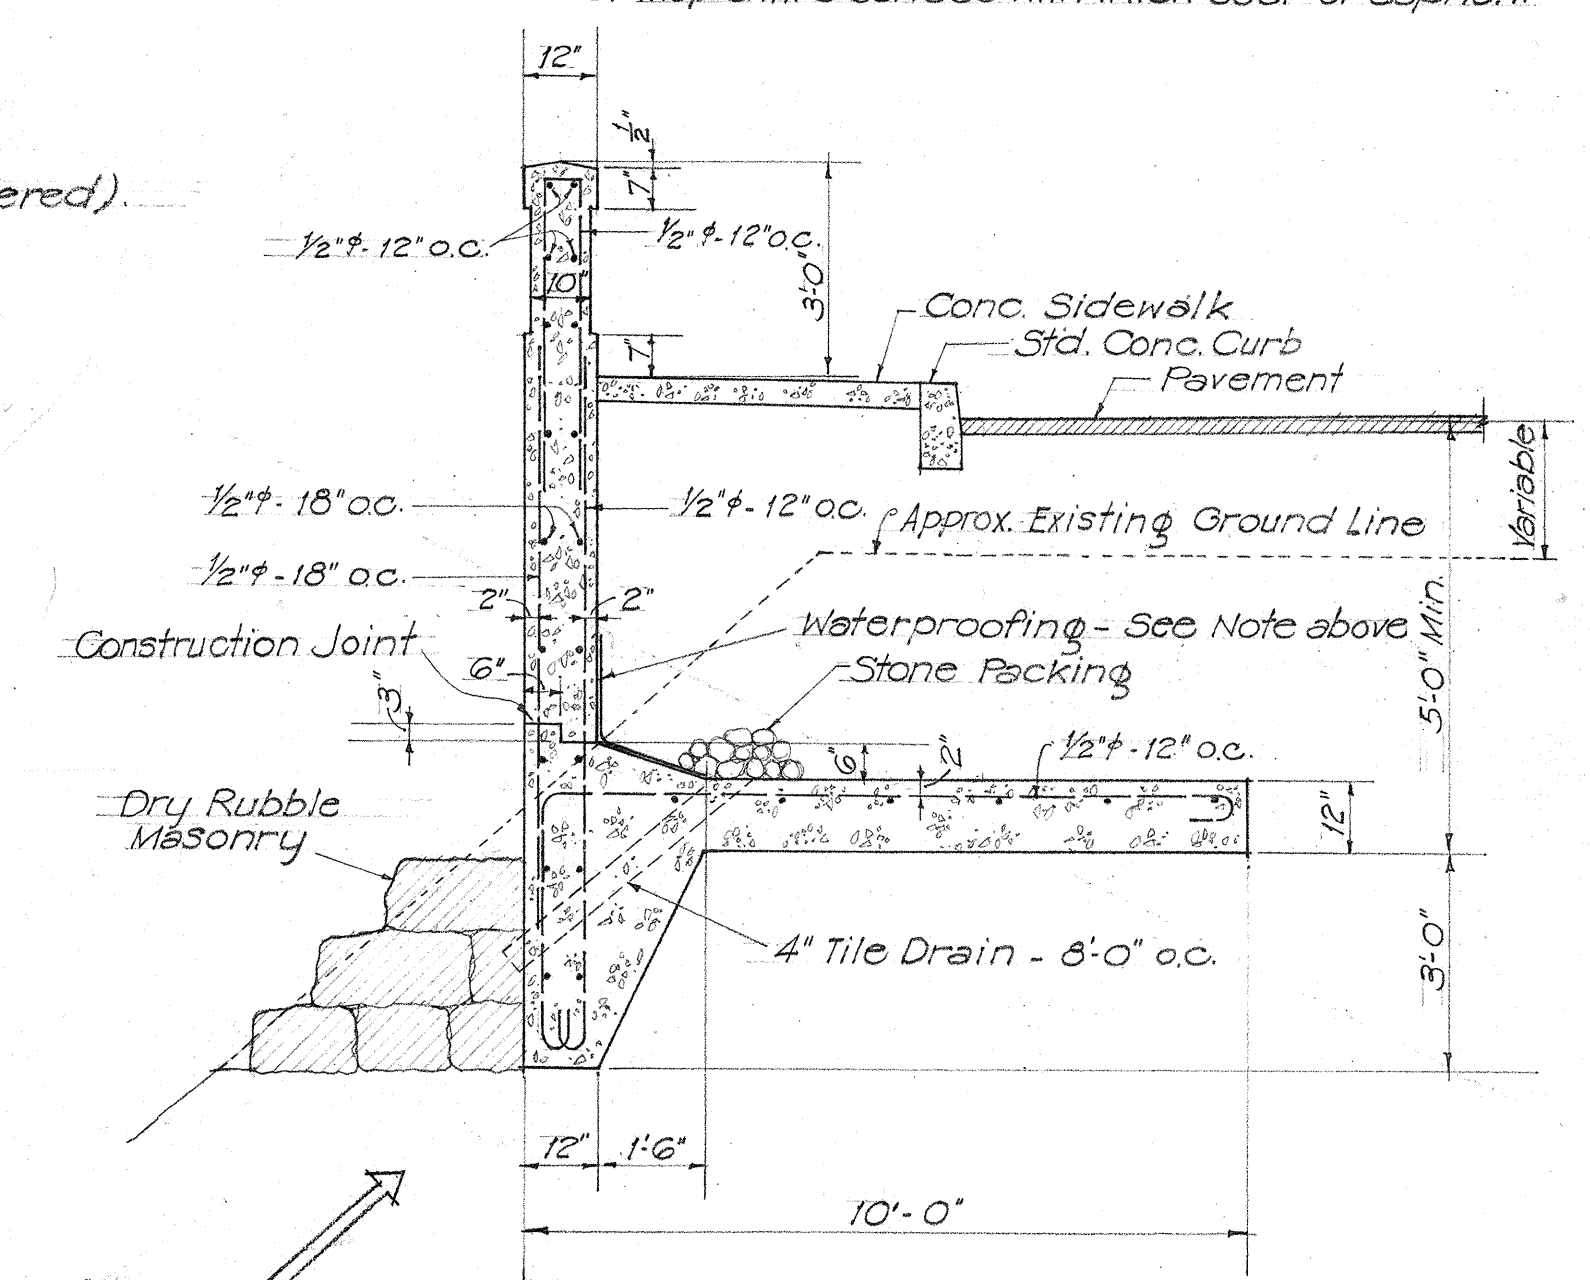



DETAIL OF RETAINING WALL AT SOUTH RETURN OF COOPER'S RD.

Scale: 3/8" = 1'-0"

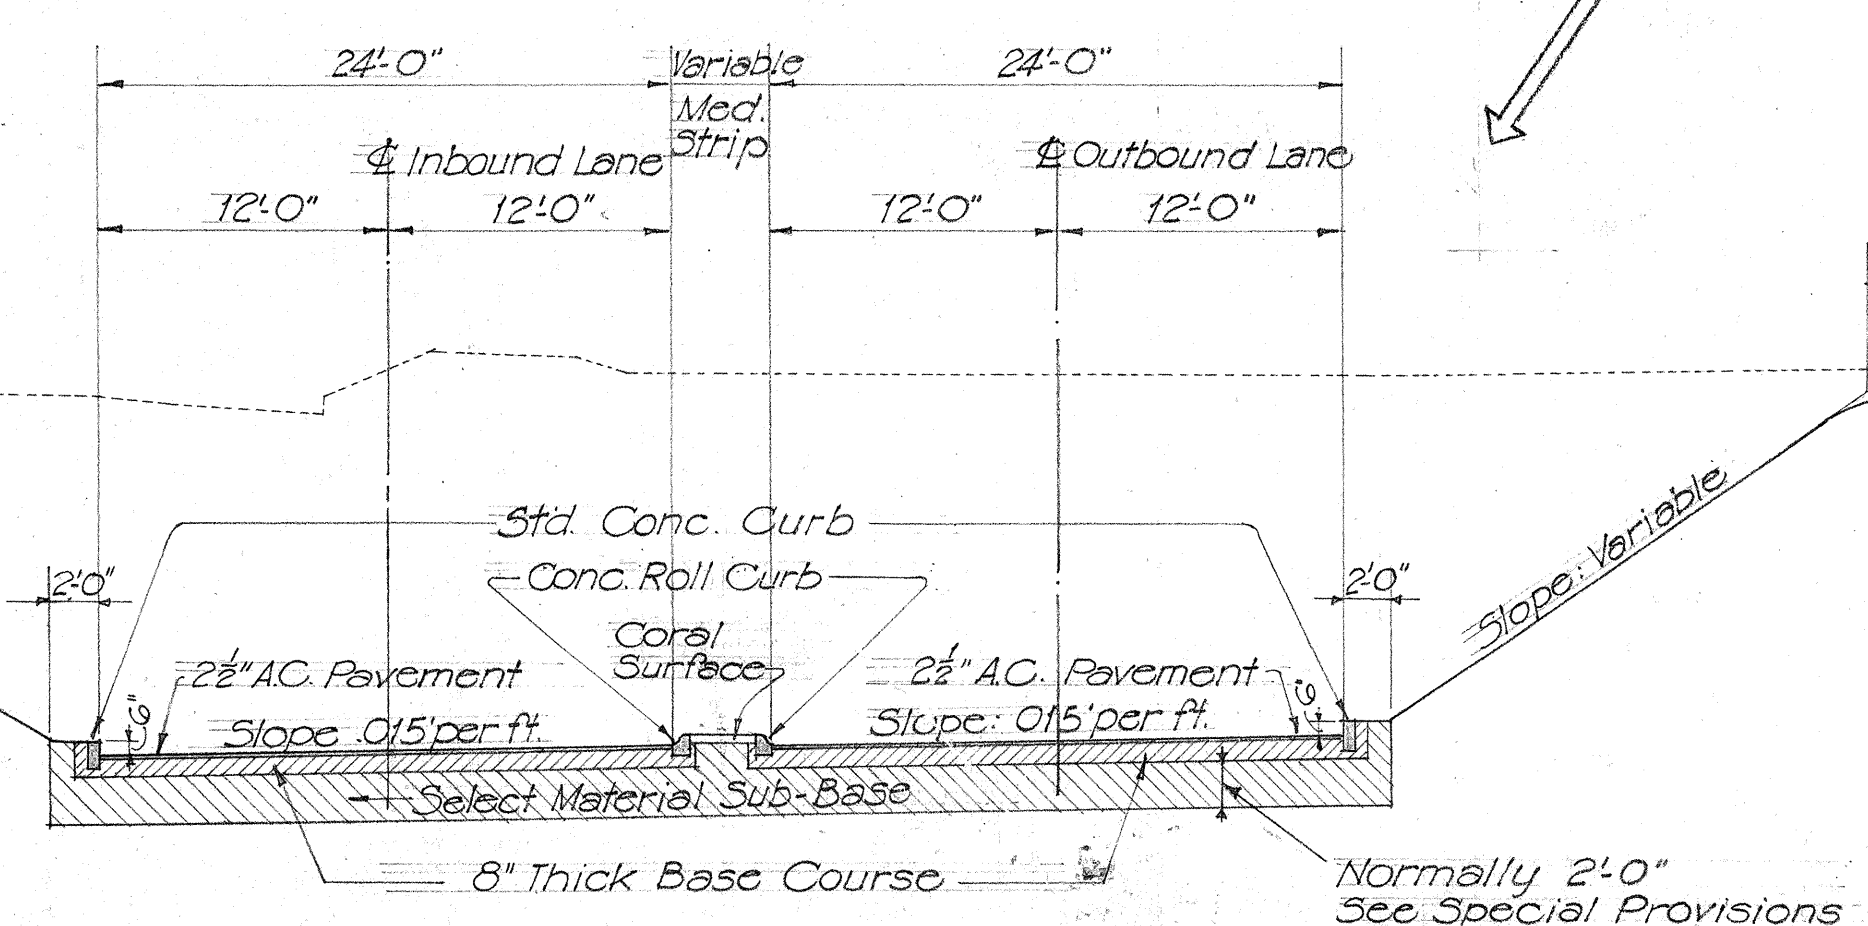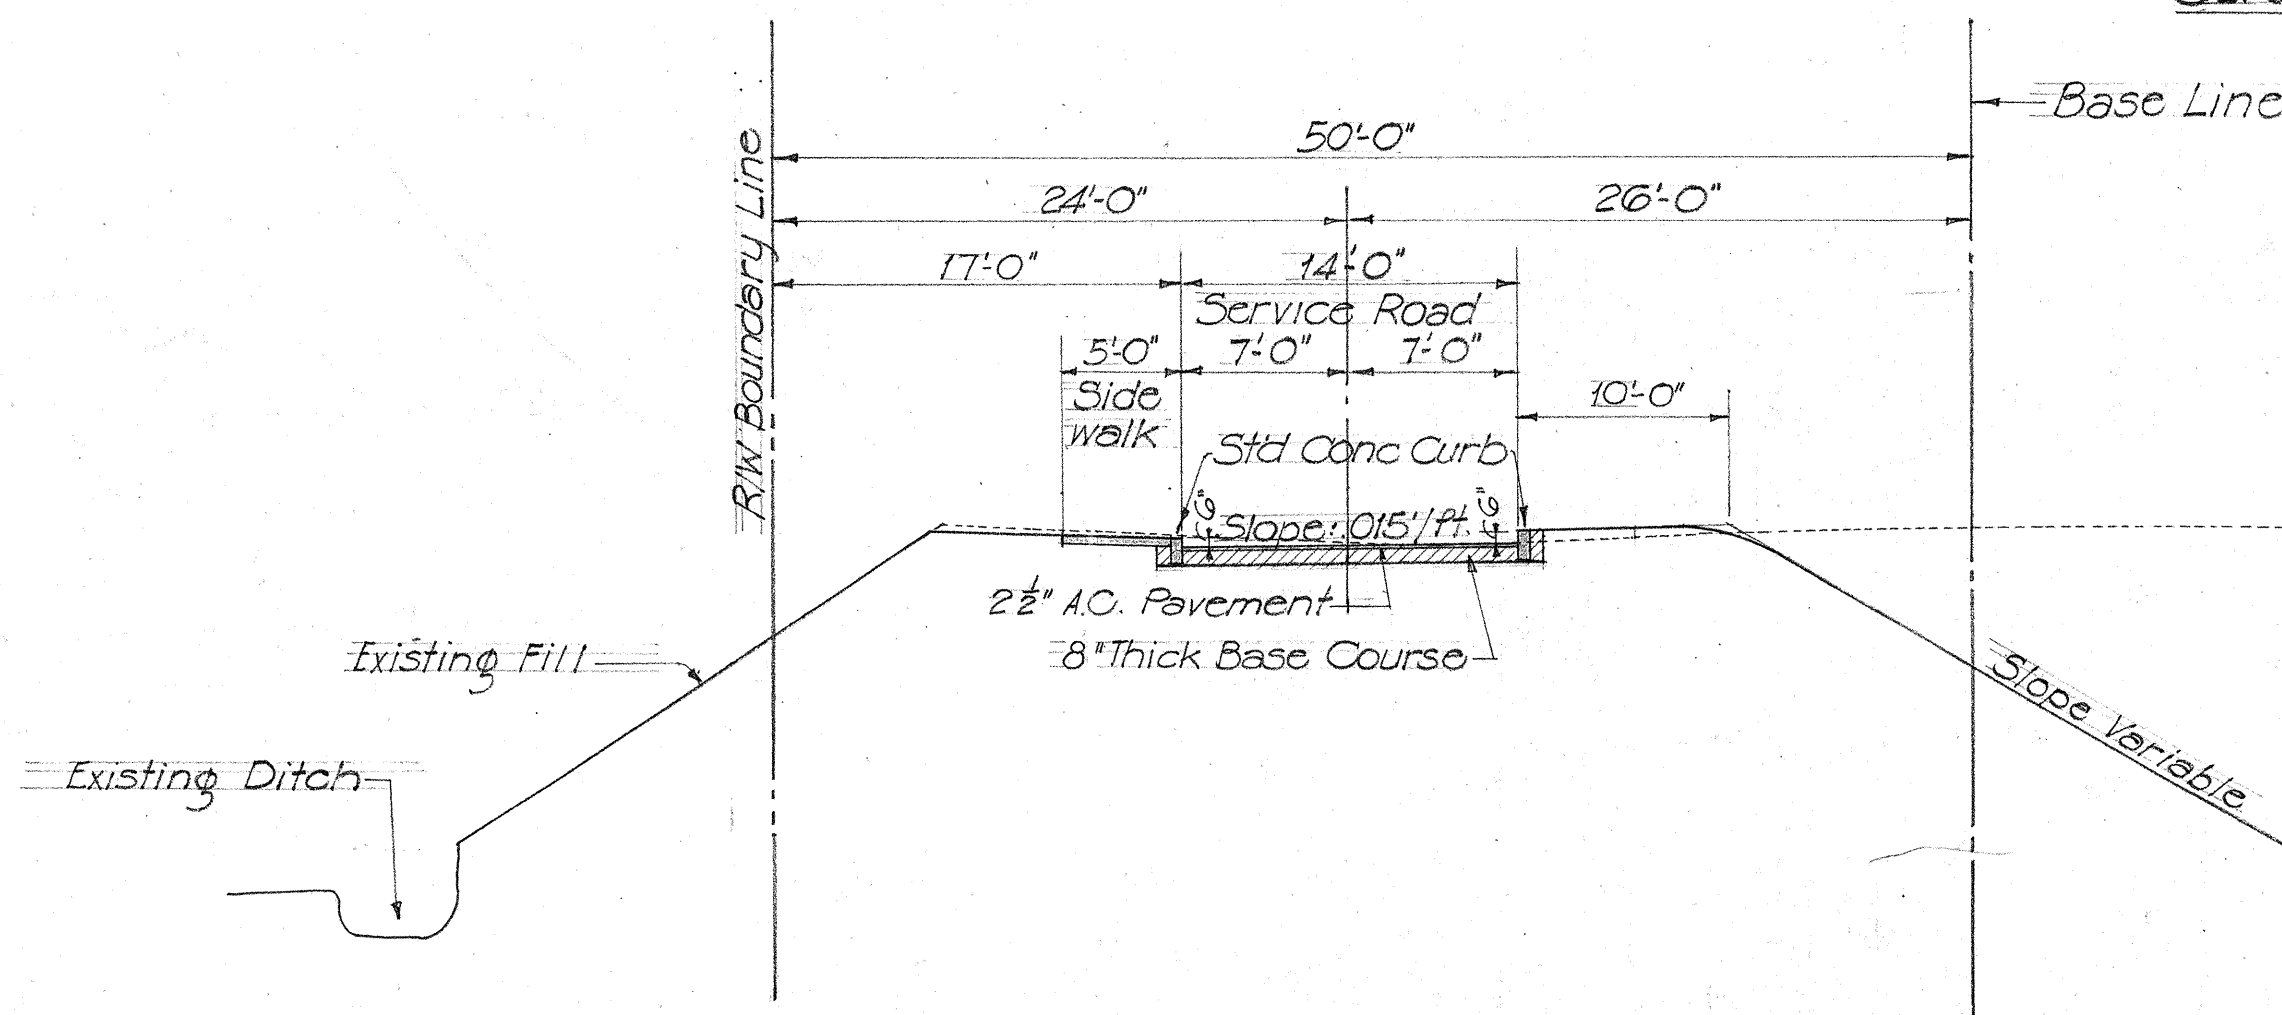

SECTION AT STA 316+00

Scale: 1/8" = 1'-0"

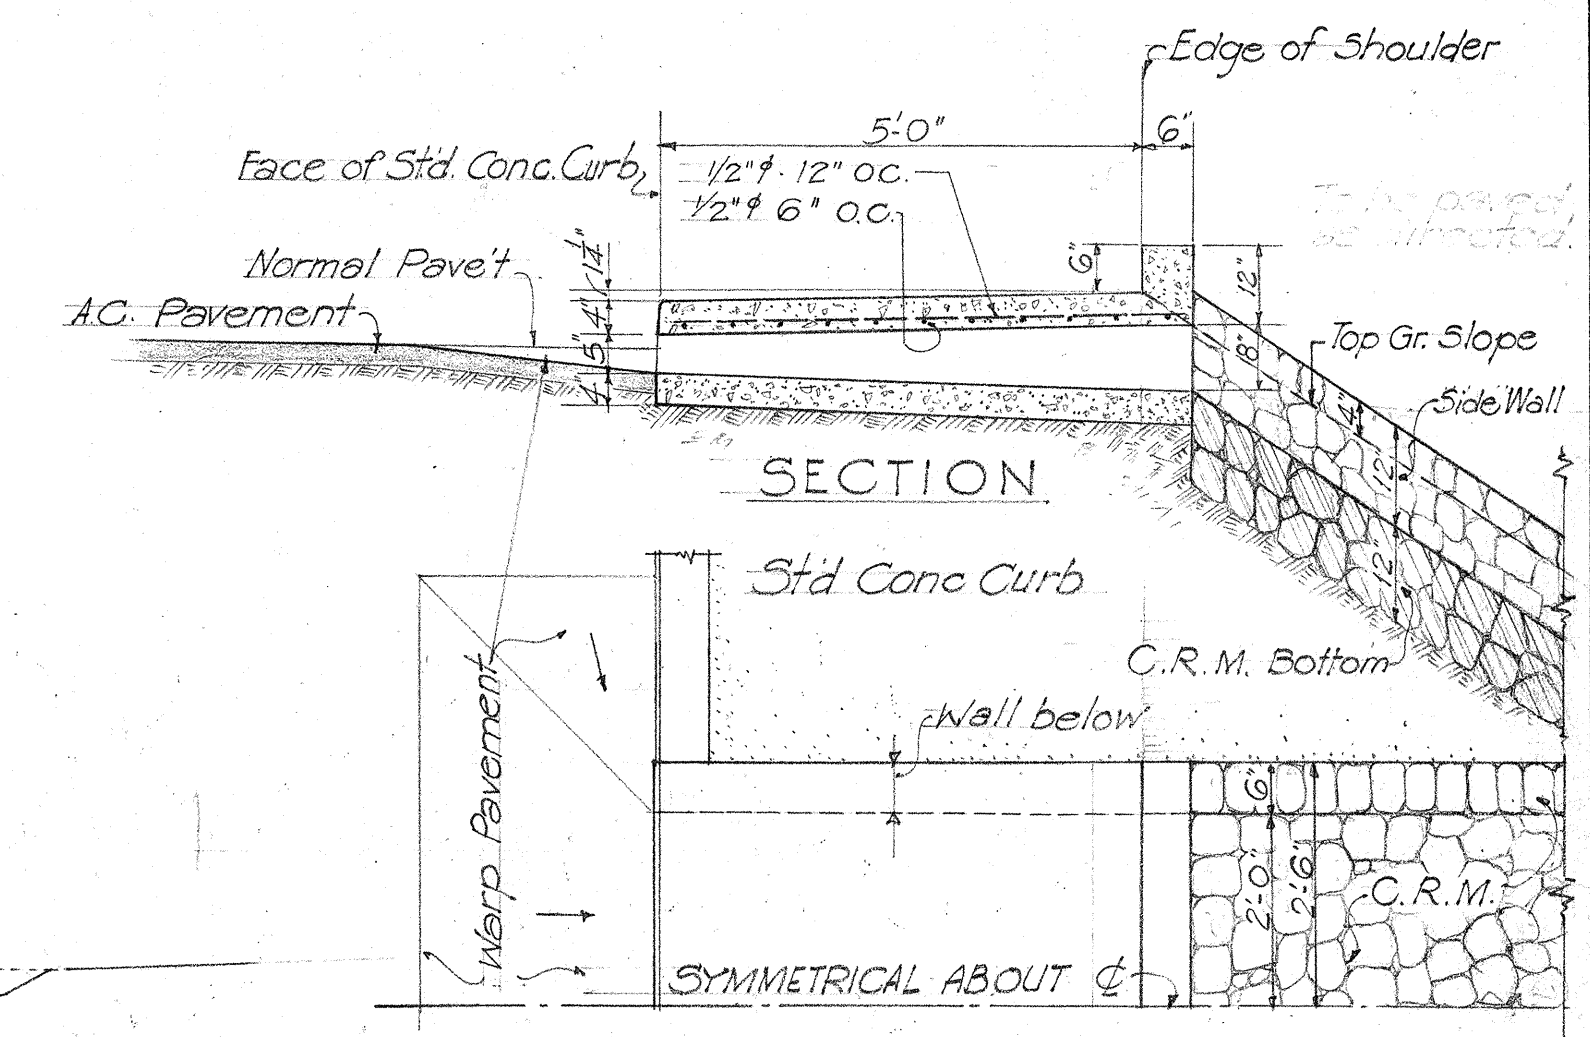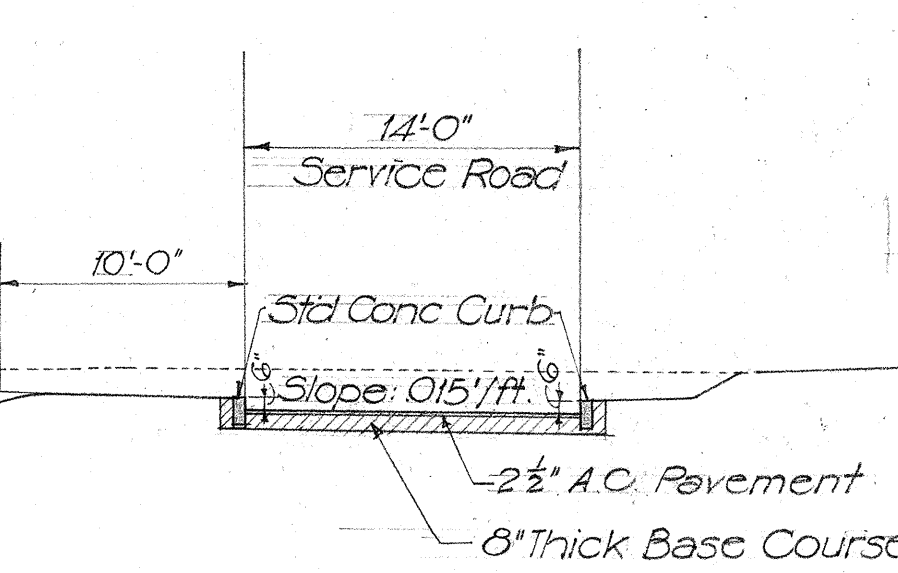

SECTION

1/2 PLAN DETAIL OF SIDEWALK DRAIN

Scale: 1/2" = 1'-0"

SECTIONS AT STATIONS
KAMEHAMEHA HIGHWAY
EAST GATE TO KALAUAO BRIDGE
HAWAII PROJECT NO DA-NR 13 (2)
Scale: As Noted

REVISION 11-15-44
Rev. (Sidewalk Drain) 5-31-45

DATE	11-15-44
DESIGNED BY	R.O.
DRAWN BY	R.O.
CHECKED BY	R.O.
NOTED BY	
QUANTITIES BY	
CHECKED BY	
ORIGINAL	
PLAN	
NOTEBOOK	
No.	