


FED. ROAD DIST. NO.	STATE	FED. AID PROJ. NO.	FISCAL YEAR	SHEET NO.	TOTAL SHEETS
HAWAII	HA	5N 00	1962	6	9

FINAL SURVEY	DATE
SURVEYED	BY
PLOTTED	
NOTE BOOK	
AREAS CHECKED	
NO.	

ORIGINAL SURVEY	DATE
SURVEYED	BY
PLOTTED	
NOTE BOOK	
AREAS CHECKED	
NO.	

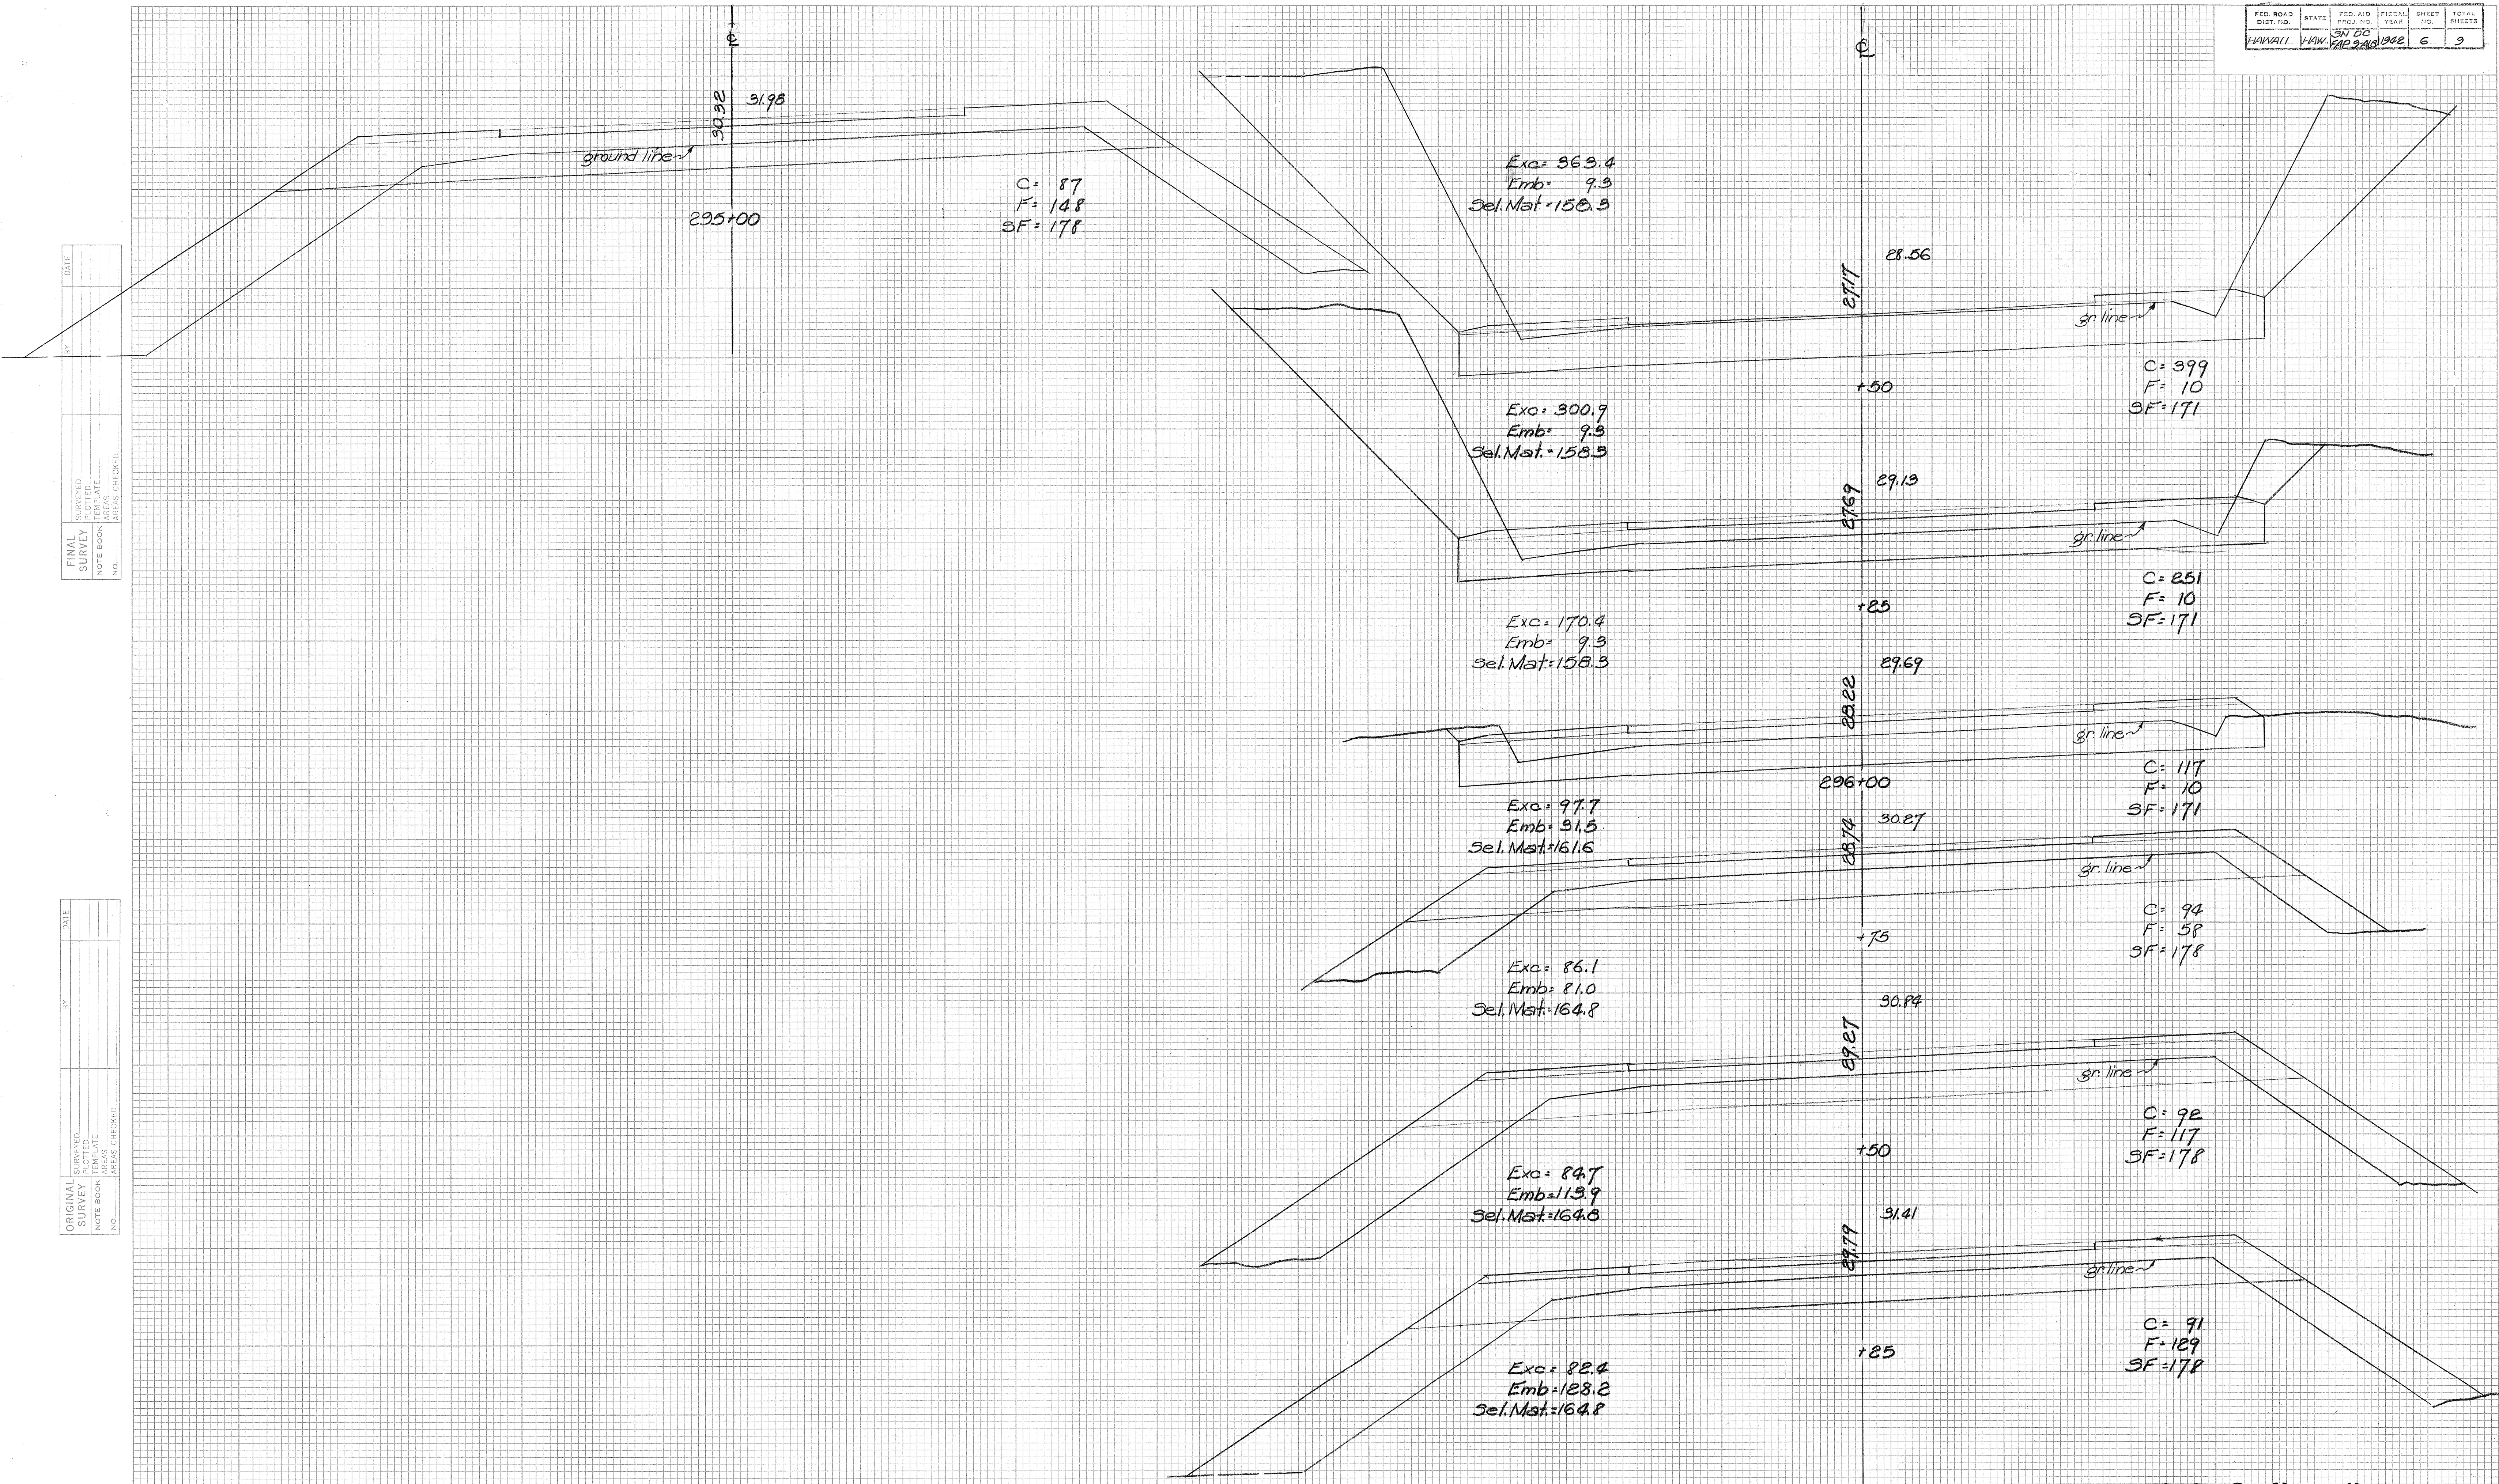

FED. ROAD DIST. NO.	STATE	FED. AID PROJ. NO.	FISCAL YEAR	SHEET NO.	TOTAL SHEETS
HAWAII	HAWAII	3N-DR-124P	1948	7	9

DATE	BY	FINAL SURVEY	SURVEYED	PLOTTED	DATE	BY
		NOTE BOOK				
		AREAS CHECKED				

DATE	BY	ORIGINAL SURVEY	SURVEYED	PLOTTED	DATE	BY
		NOTE BOOK				
		AREAS CHECKED				

Exc: 726.8
Emb: 9.3
Sel. Mat: 188.2

Exc: 617.1
Emb: 9.3
Sel. Mat: 177.8

Exc: 514.8
Emb: 9.3
Sel. Mat: 169.9

Exc: 435.2
Emb: 9.3
Sel. Mat: 162.0

Exc: 377.3
Emb: 9.3
Sel. Mat: 153.3

C: 731
F: 10
SF: 196

C: 602
F: 10
SF: 188

C: 510
F: 10
SF: 179

C: 430
F: 10
SF: 171

C: 386
F: 10
SF: 171

Exc: 843.5
Emb: 9.3
Sel. Mat: 188.9

Exc: 813.0
Emb: 9.3
Sel. Mat: 188.9

Exc: 782.2
Emb: 9.3
Sel. Mat: 188.9

Exc: 777.8
Emb: 9.3
Sel. Mat: 188.9

C: 905
F: 10
SF: 204

C: 851
F: 10
SF: 204

C: 841
F: 10
SF: 204

C: 839
F: 10
SF: 204

Exc: 856.9
Emb: 9.3
Sel. Mat: 188.9

Exc: 849.1
Emb: 9.3
Sel. Mat: 188.9

Exc: 855.1
Emb: 9.3
Sel. Mat: 188.9

Exc: 855.1
Emb: 9.3
Sel. Mat: 188.9

Exc: 834.6
Emb: 9.3
Sel. Mat: 188.9

Exc: 566.6
Emb: 9.3
Sel. Mat: 156.7

Exc: 788.9
Emb: 9.3
Sel. Mat: 188.9

Exc: 842.1
Emb: 9.3
Sel. Mat: 188.9

Exc: 873.1
Emb: 9.3
Sel. Mat: 188.9

C: 905
F: 10
SF: 204

C: 929
F: 10
SF: 204

C: 918
F: 10
SF: 204

C: 929
F: 10
SF: 204

C: 917
F: 10
SF: 204

C: 827
F: 10
SF: 204

C: 877
F: 10
SF: 204

C: 940
F: 10
SF: 204

C: 946
F: 10
SF: 204

FED. ROAD DIST. NO.	STATE	FISCAL YEAR	SHEET NO.	TOTAL SHEETS
HAWAII	VI	1942	9	9

Exc: 176.9
Emb: 25.5
Sel. Mat.: 193.1

1563 16.00

C: 191
F: 28
SF: 210

Exc: 191.7
Emb: 26.9
Sel. Mat.: 166.7

304+00

Exc: 193.1
Emb: 19.9
Sel. Mat.: 193.1

302+00

C: 226
F: 15
SF: 207

Exc: 370.4
Emb: 53.7
Sel. Mat.: 333.3

12.48 12.58

C: 207
F: 29
SF: 180

Exc: 160.0
Emb: 9.5
Sel. Mat.: 122.1

16.16 16.58

C: 314
F: 17
SF: 205

Exc: 176.9
Emb: 29.2
Sel. Mat.: 166.7

308+00

Exc: 313.9
Emb: 11.5
Sel. Mat.: 174.2

16.49 16.94

C: 423
F: 10
SF: 204

Exc: 113.8
Emb: 45.6
Sel. Mat.: 114.7

13.72 13.72

C: 193
F: 29
SF: 180

Exc: 196.2
Emb: 4.1
Sel. Mat.: 63.1

16.97 17.47

C: 550
F: 10
SF: 204

Exc: 650
Emb: 31.7
Sel. Mat.: 67.8

14.06 14.29

C: 189
F: 34
SF: 180

Exc: 87.4
Emb: 1.5
Sel. Mat.: 30.2

17.20 17.72

C: 630
F: 10
SF: 204

Exc: 178.7
Emb: 44.9
Sel. Mat.: 190.7

14.59 14.65

C: 195
F: 120
SF: 207

Exc: 87.4
Emb: 1.5
Sel. Mat.: 30.2

17.20 17.72

C: 630
F: 10
SF: 204

Exc: 178.7
Emb: 44.9
Sel. Mat.: 190.7

14.59 14.65

C: 195
F: 70
SF: 205

Exc: 87.4
Emb: 1.5
Sel. Mat.: 30.2

17.20 17.81

C: 630
F: 10
SF: 204

Exc: 178.7
Emb: 44.9
Sel. Mat.: 190.7

15.10 15.43

C: 191
F: 27
SF: 207