
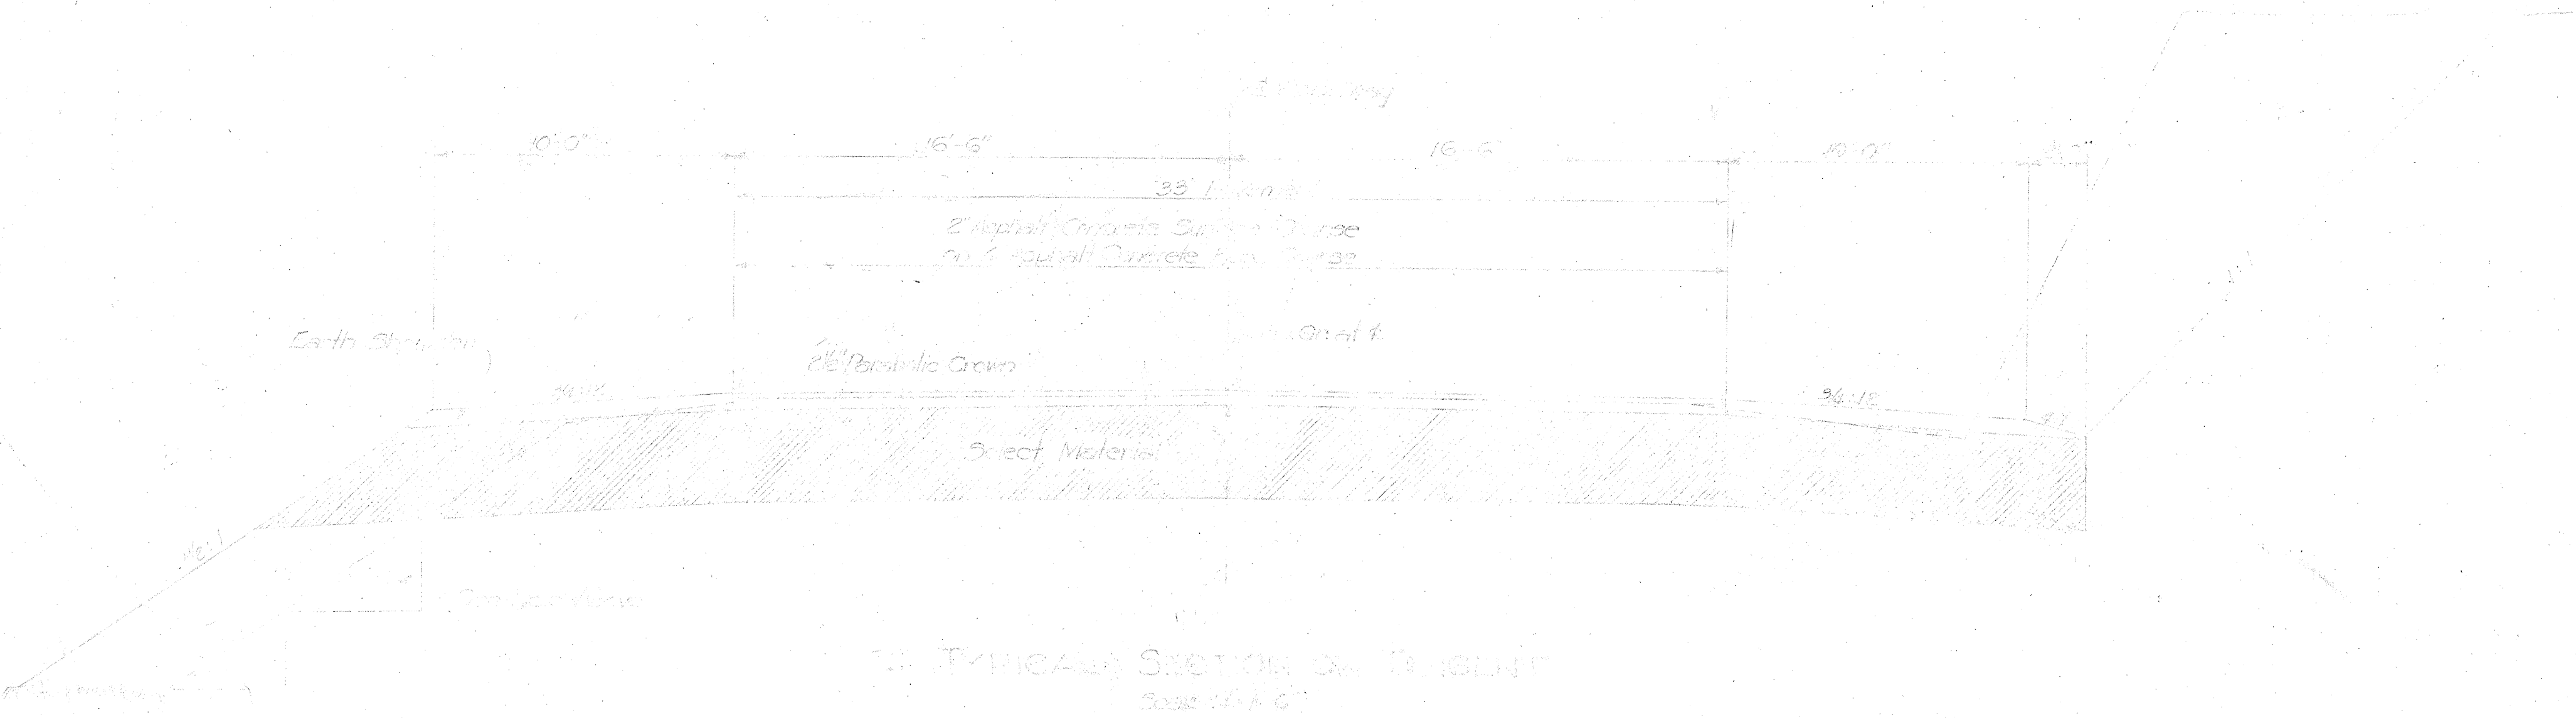


FED. ROAD DIST. NO.	STATE	FED. AID PROJ. NO.	FISCAL YEAR	SHEET NO.	TOTAL SHEETS
HAWAII	HAW.	SN DC FAP 9-A(8)	1942	2	9

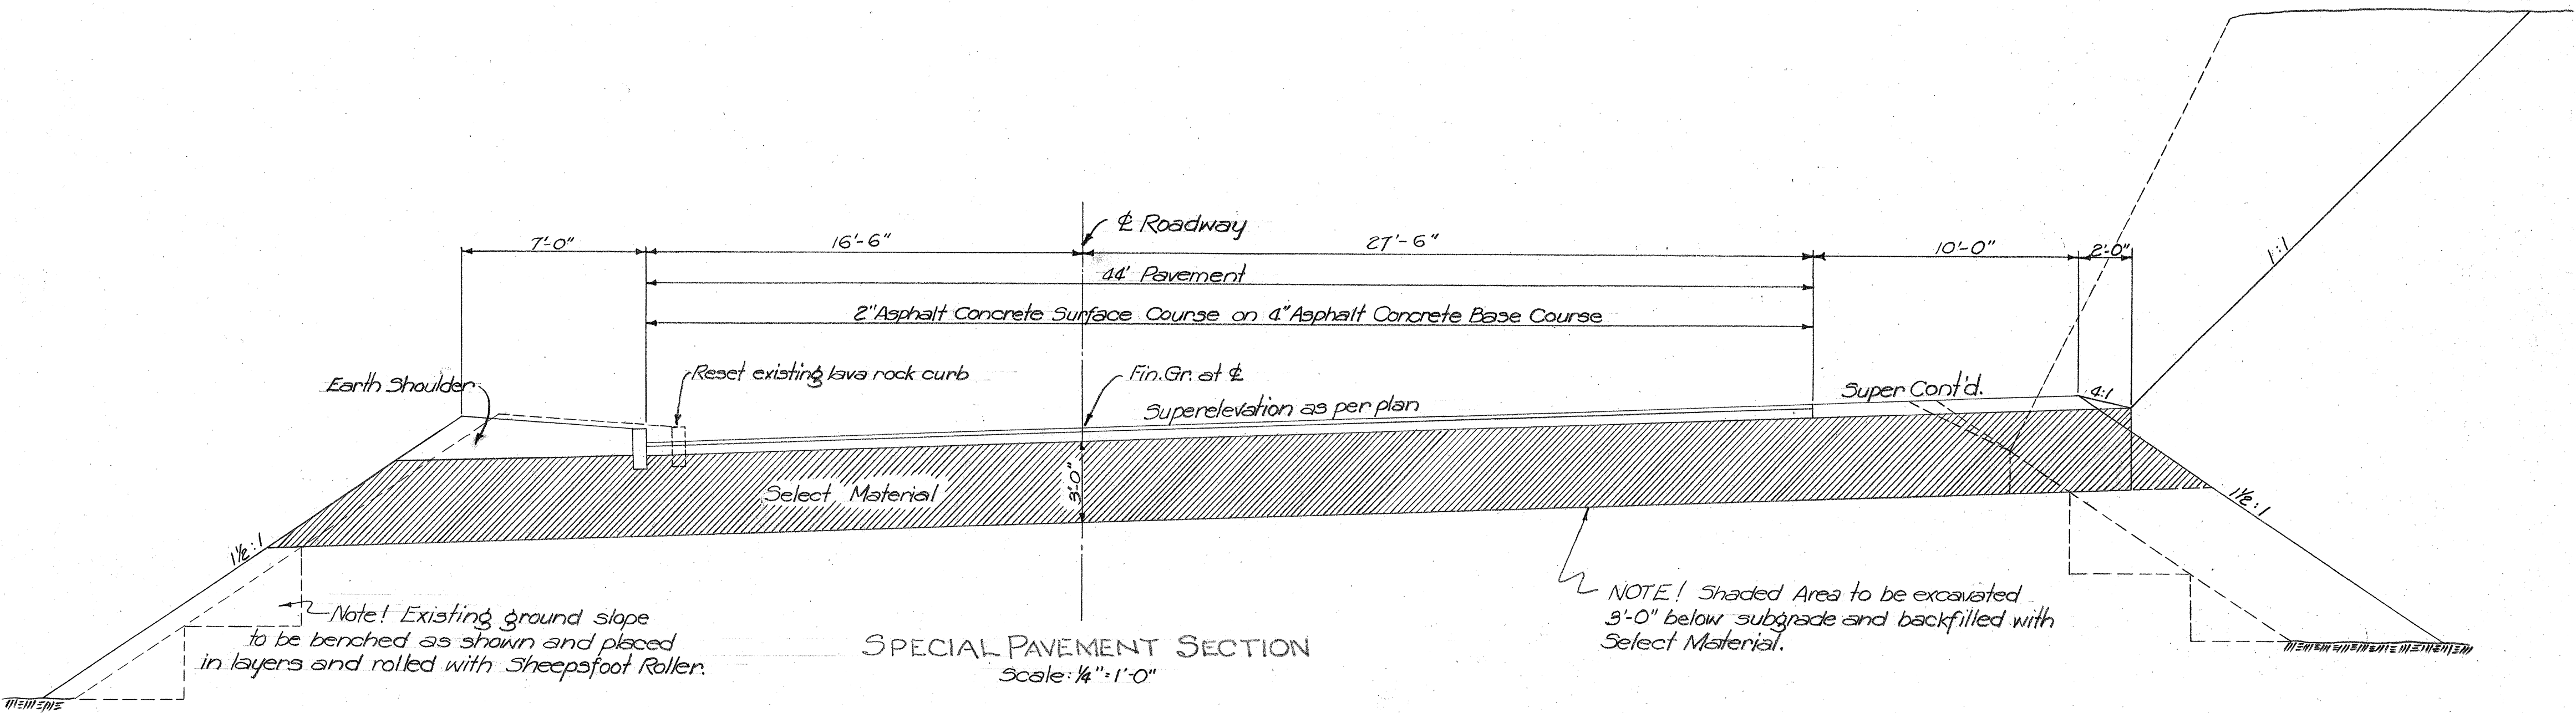

NOTE ON BASE COURSE: The 4" Asphalt Concrete Base Course shall be composed of a 1 1/2" levelling course on a 2 1/2" Base.

DESIGNED BY	DATE
DRAWN BY	"
TRACED BY	"
QUANTITIES CHECKED BY	"
CHECKED BY	"
ORIGINAL PLAN	No.

TERRITORIAL HIGHWAY DEPARTMENT
TERRITORY OF HAWAII

TYPICAL SECTIONS
SN DC FAP 9-A(8)
Scales as noted. Dec. 1942

SHEET No. 2 OF 9 SHEETS