
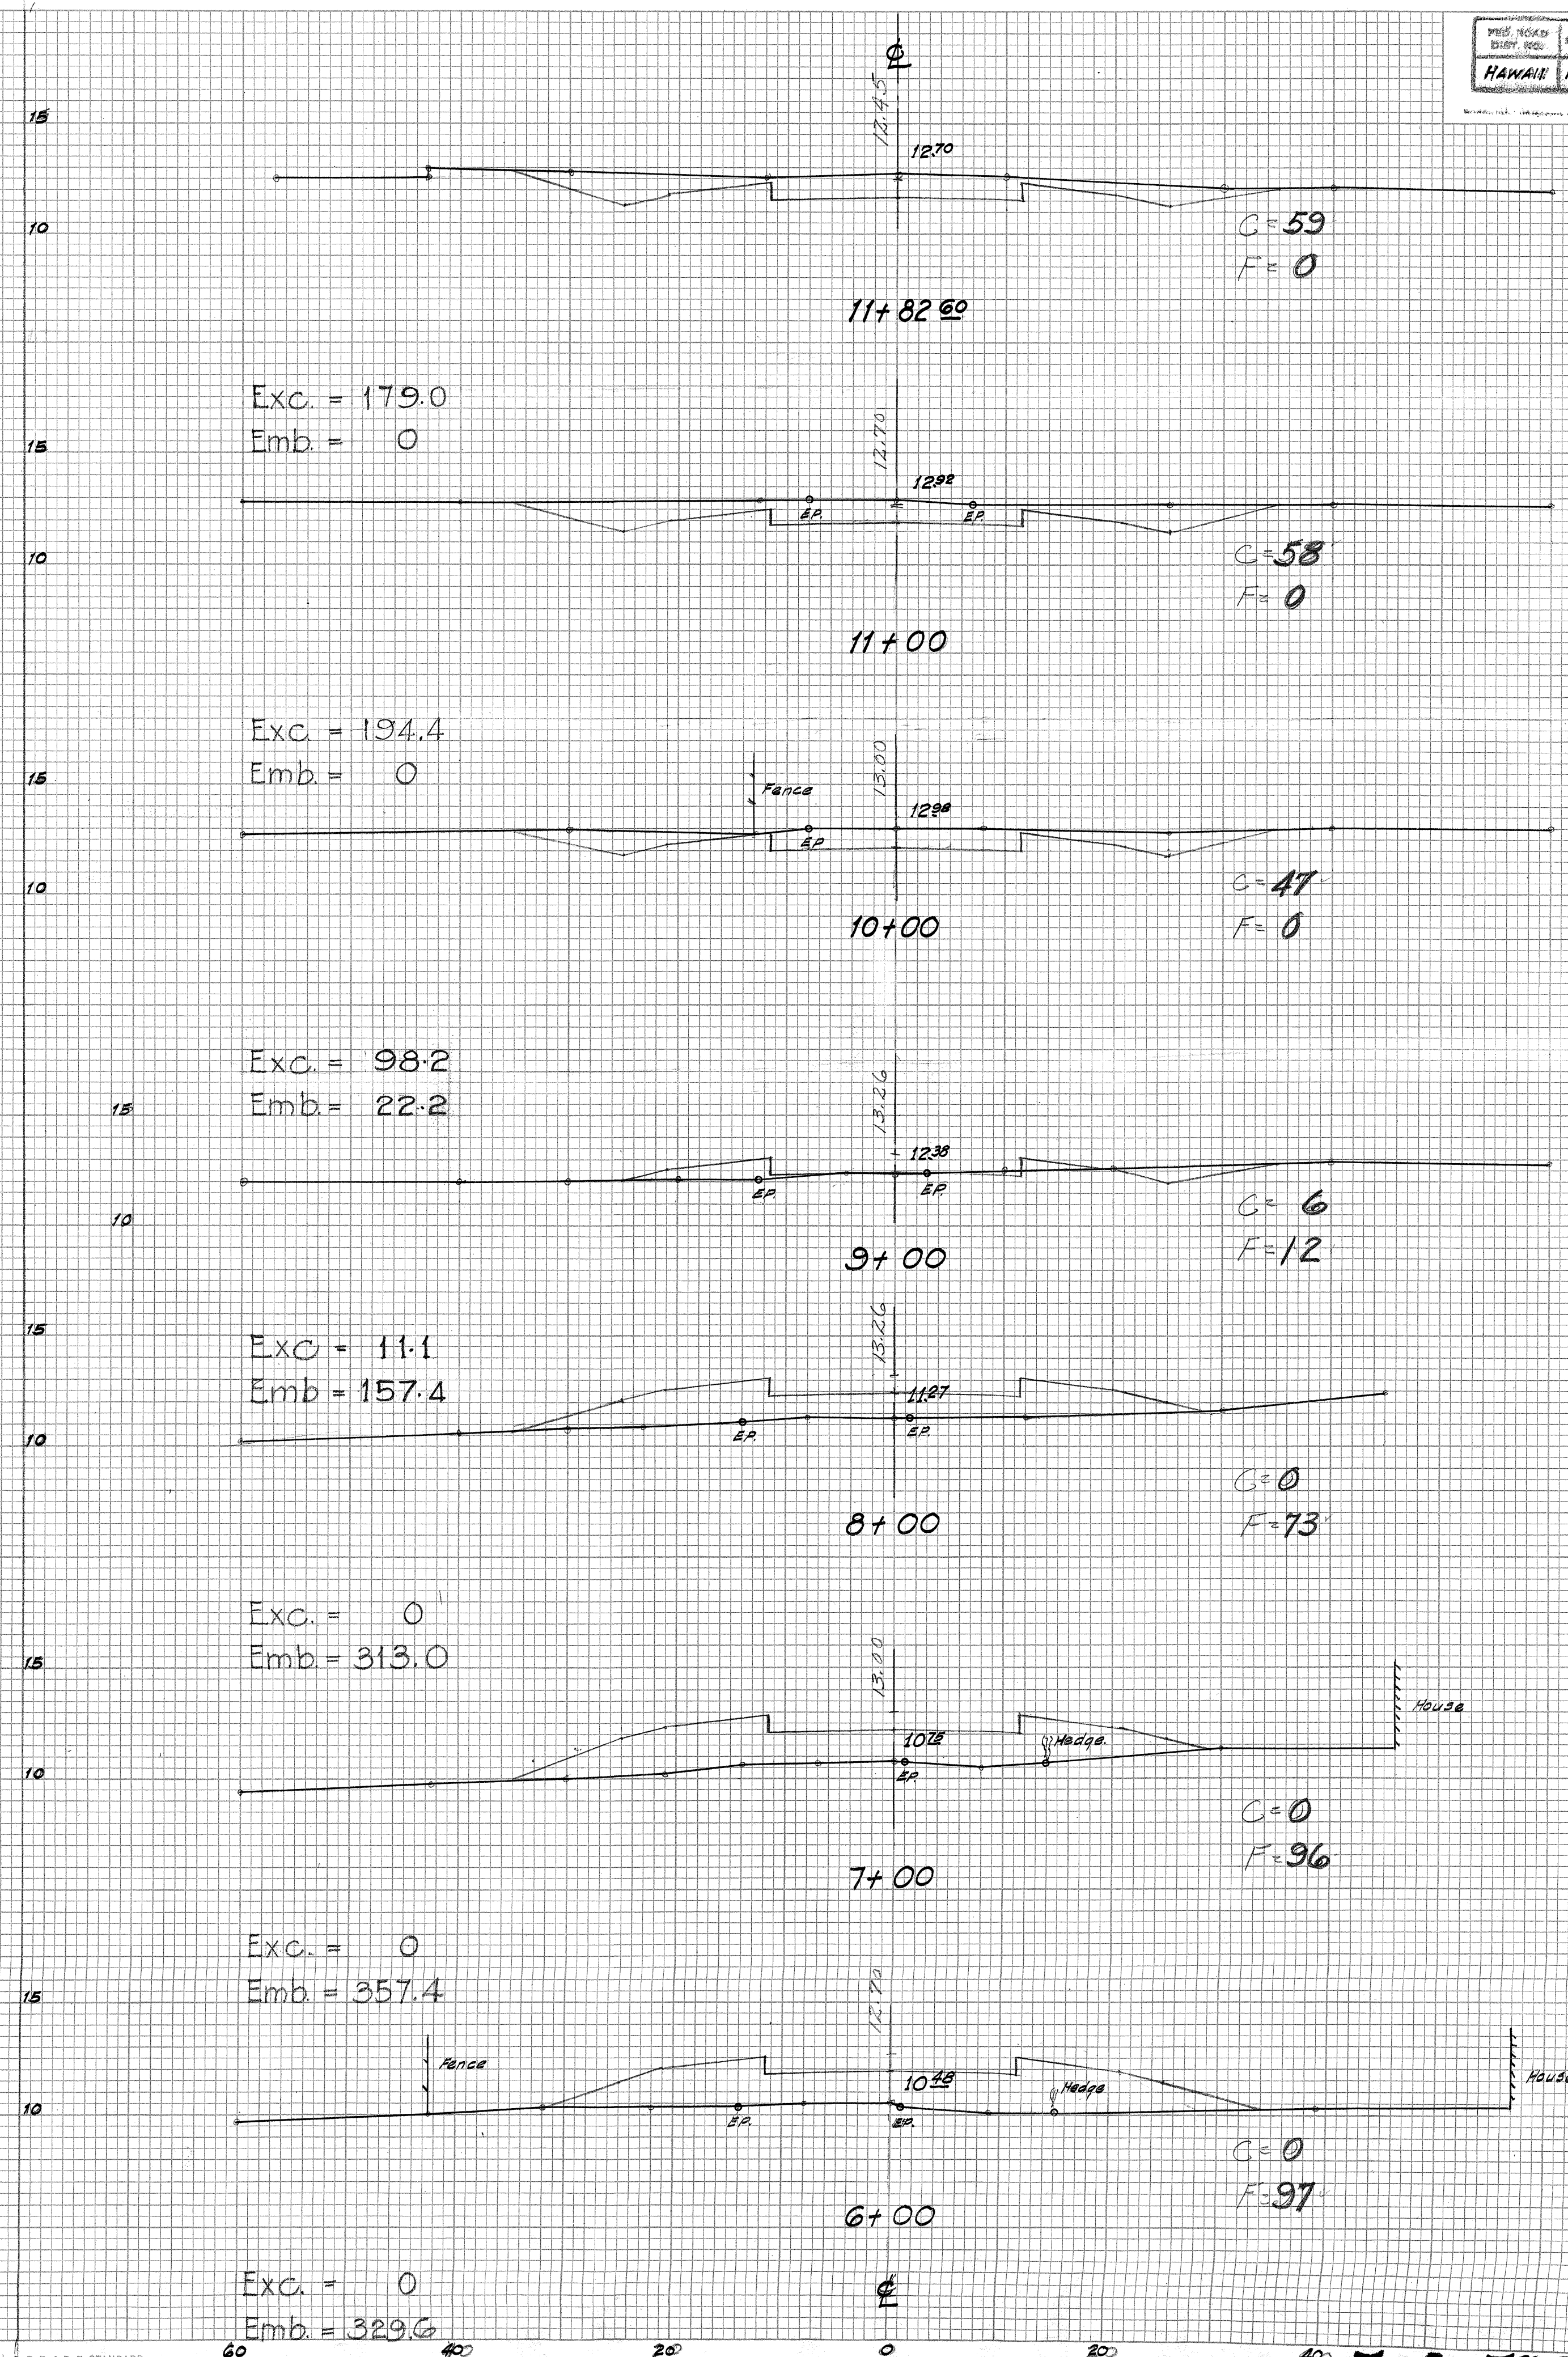


DATE	BY	SURVEYED	PLOTTED	TEMPERATURE	NO.
FINAL SURVEY		NOTE BOOK			
NO.		AREAS CHECKED			

Revised: April 30, 1945

DATE	BY	SURVEYED	PLOTTED	TEMPERATURE	NO.
4/22/45	J. H.				
ORIGINAL SURVEY		NOTE BOOK			
NO.		AREAS CHECKED			

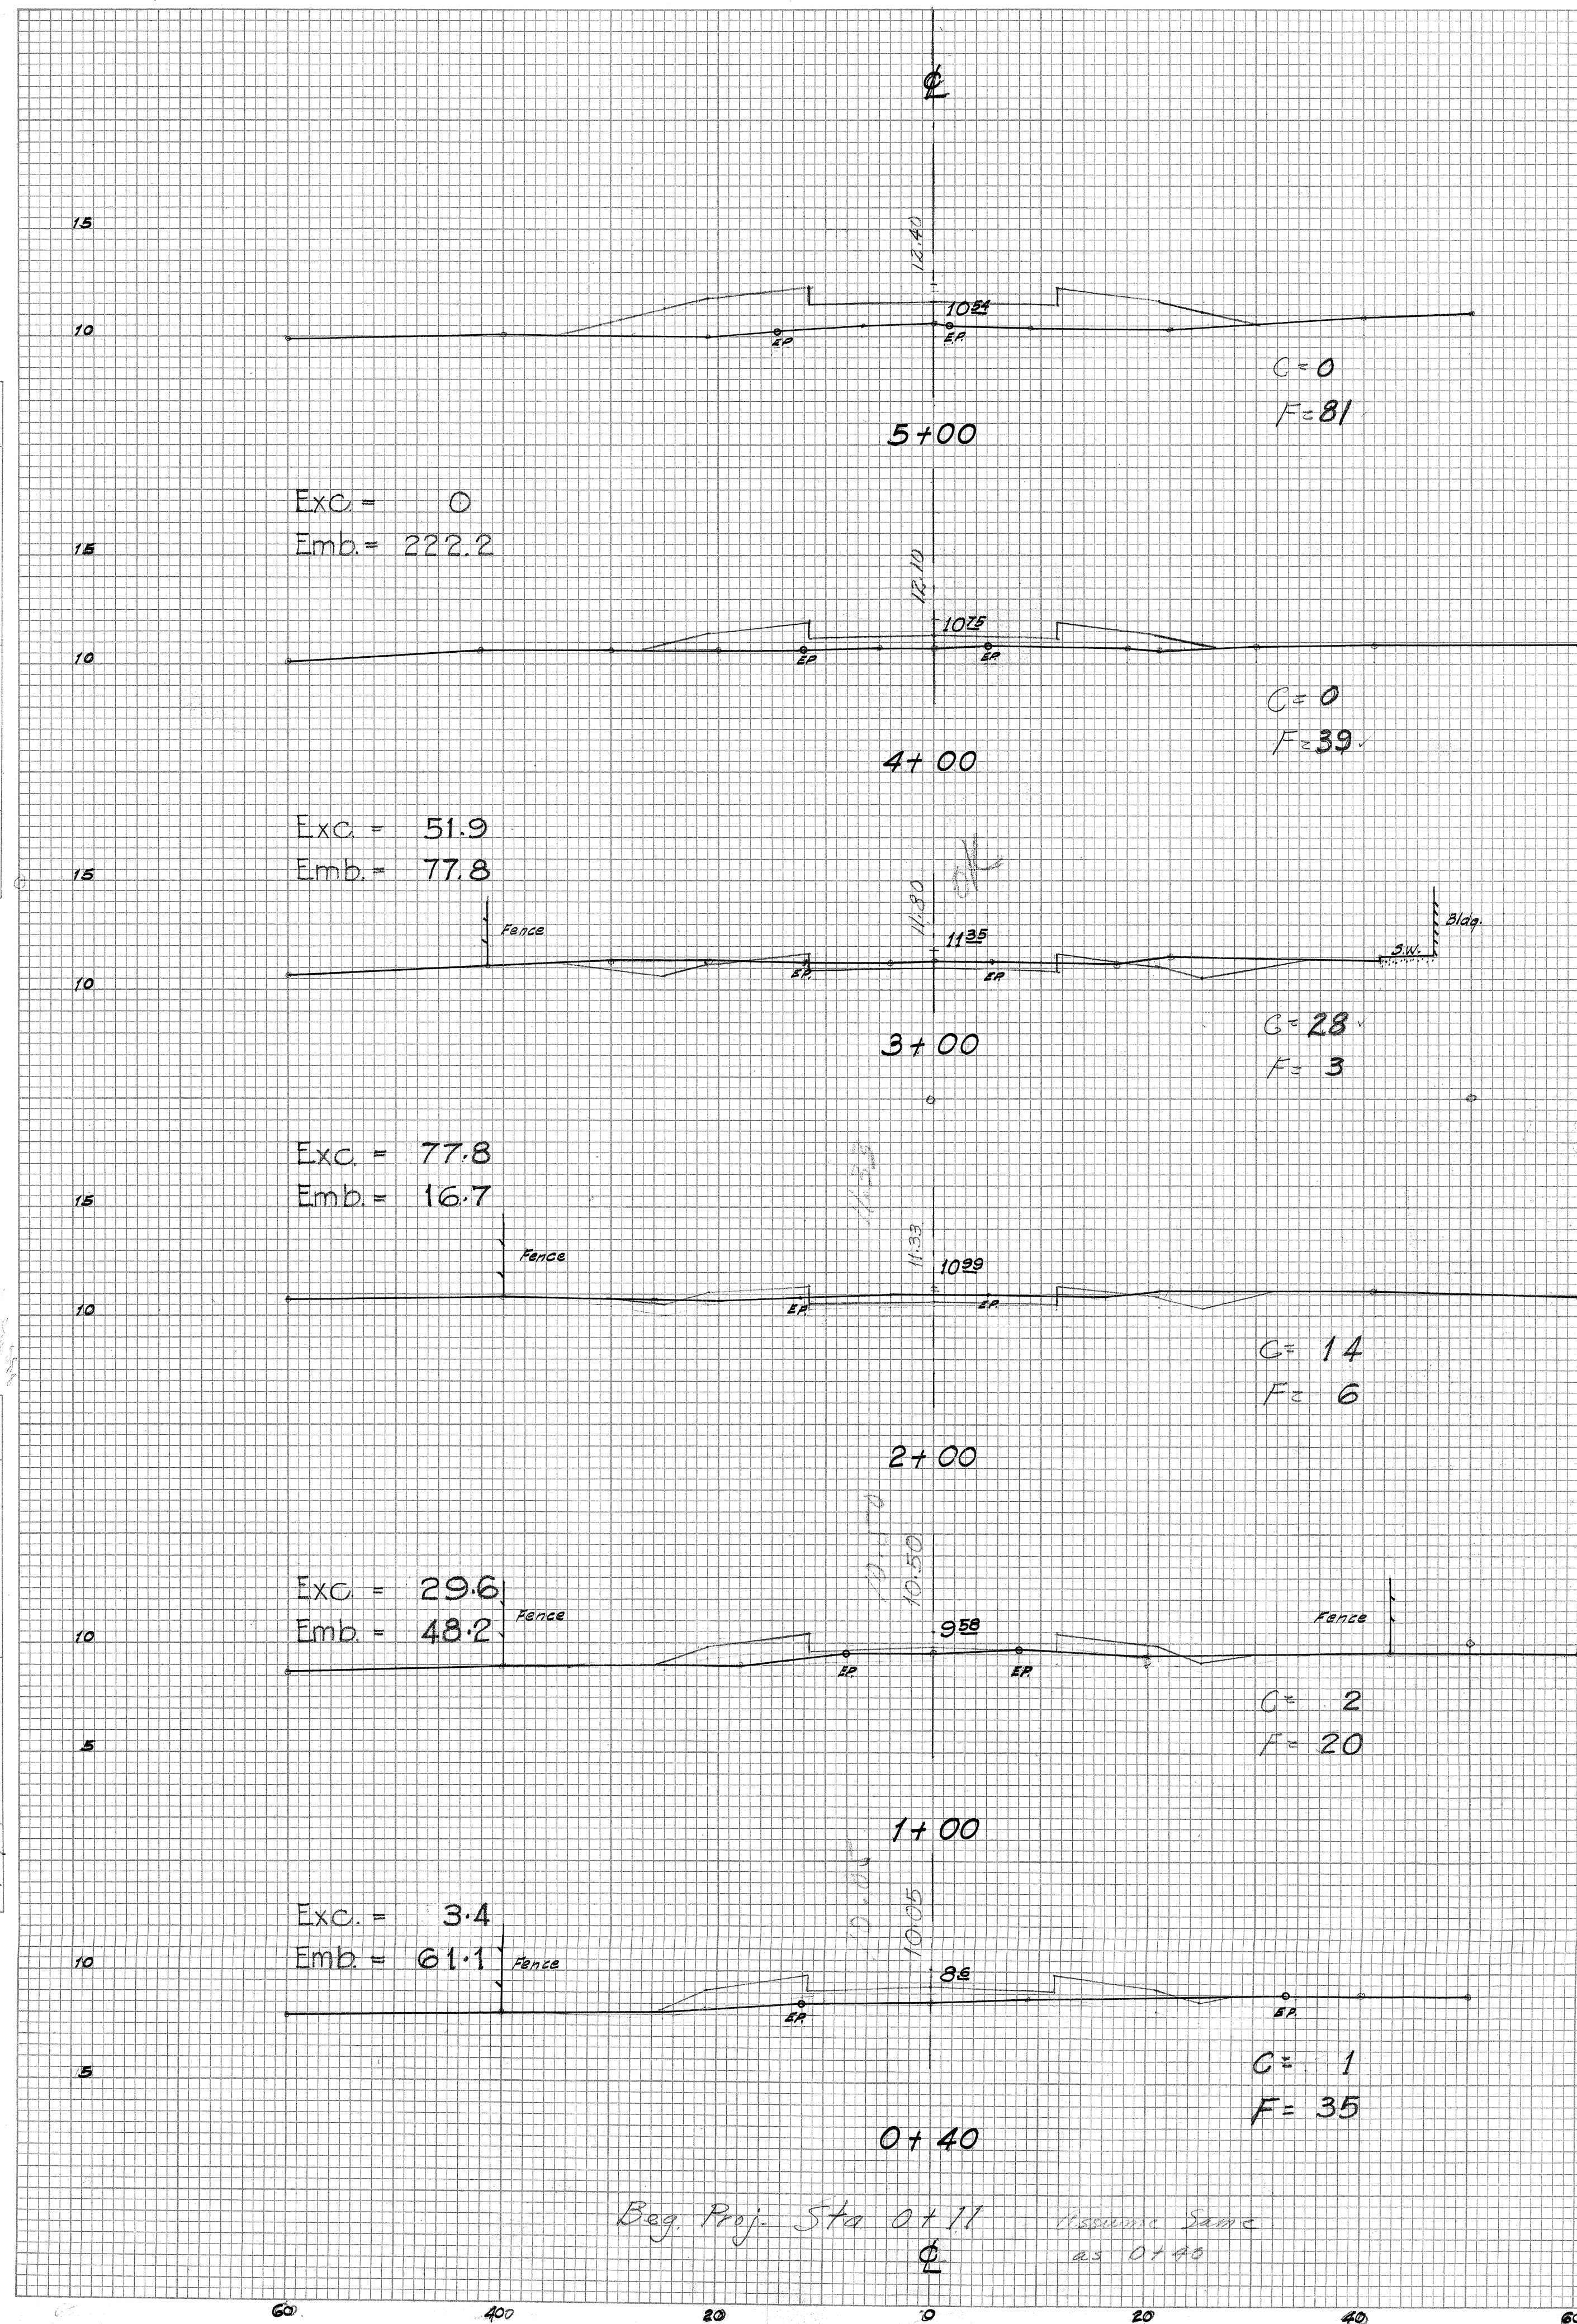

PROJ. NO.	STATE	FED. AID	FISCAL YEAR	SHEET NO.	TOTAL SHEETS
HAWAII HAW.	HA	DA-NR	1944	51	81

FINAL SURVEY	SURVEYED	BY	DATE
NOTE BOOK	PLOTTED		
	TEMPLATE		
	AREAS		
NO.	AREAS CHECKED		

ORIGINAL SURVEY		BY	DATE
	SURVEYED	<i>R. K. Mini</i>	<i>8/1/57</i>
	PLOTTED	<i>H. I.</i>	<i>1</i>
NOTE BOOK	TEMPLATE	<i>R. K.</i>	<i>5</i>
NO. _____	AREAS	<i>R. K.</i>	<i>W</i>
	AREAS CHECKED		

