

INDEX TO DRAWINGS	
SHEET NO.	DESCRIPTION
1	Title Sheet
2-3	Typical Sections
4-9	Plan & Profile Lehua Ave.
10-11	" " " Waimano Home Rd.
12	" " " R.R. Location
13	" " " Franklin Spur
14-19	" " " Kam. Highway
20-21	Intersection Details Lines & Grades
22-25	Standard Details
26	Catch Basin & Culv't Details
27	Syphon Details
28	Standard Bridge Details
29-34	Bridge Details
35-50	Cross Sections Lehua Ave.
51	" " Franklin Spur
52-76	" " Kam. Highway
77-80	" " Moanalua
81	" " R.R. Relocation

All changes made during construction have been shown in red on these tracings and checked by:

Tim Ho
Resident Engineer
Date April 9, 1947


TERRITORY OF HAWAII
TERRITORIAL HIGHWAY DEPARTMENT
HONOLULU - T. H.
PLANS OF
PEARL CITY ACCESS ROADS
LEHUA AVE. & SPURS & WAIMANO HOME ROAD
HAWAII PROJECT NO. DA-NR 14 (2)
EWA DISTRICT, ISLAND OF OAHU

SCALES

PLAN 1 INCH = 50 FEET
PROFILE HOR: 1 INCH = 50 FEET
VER: 1 INCH = 5 FEET
CROSS SECTIONS HOR: 1 INCH = 10 FEET
VER: 1 INCH = 5 FEET

CONVENTIONAL SIGNS

Centerline 55
Boundary Lines or
Fences (Noted) or
Existing Roadway
Circular Conc. Culvert
Railroad
Telephone Pole O.T.P.
Electric Power Line Pole O.E.P.
Sewer Manhole O.S.M.H.
Telephone Manhole O.T.M.H.
Fire Hydrant O.F.H.
Water Valve O.W.V.
Water Manhole O.W.M.H.
Std Conc. Roll Curb
Water Main N
Gasoline Pipe Line G
Communication Cable
Warning & Regulatory Signs (Type)
Centerline Monument (Type)

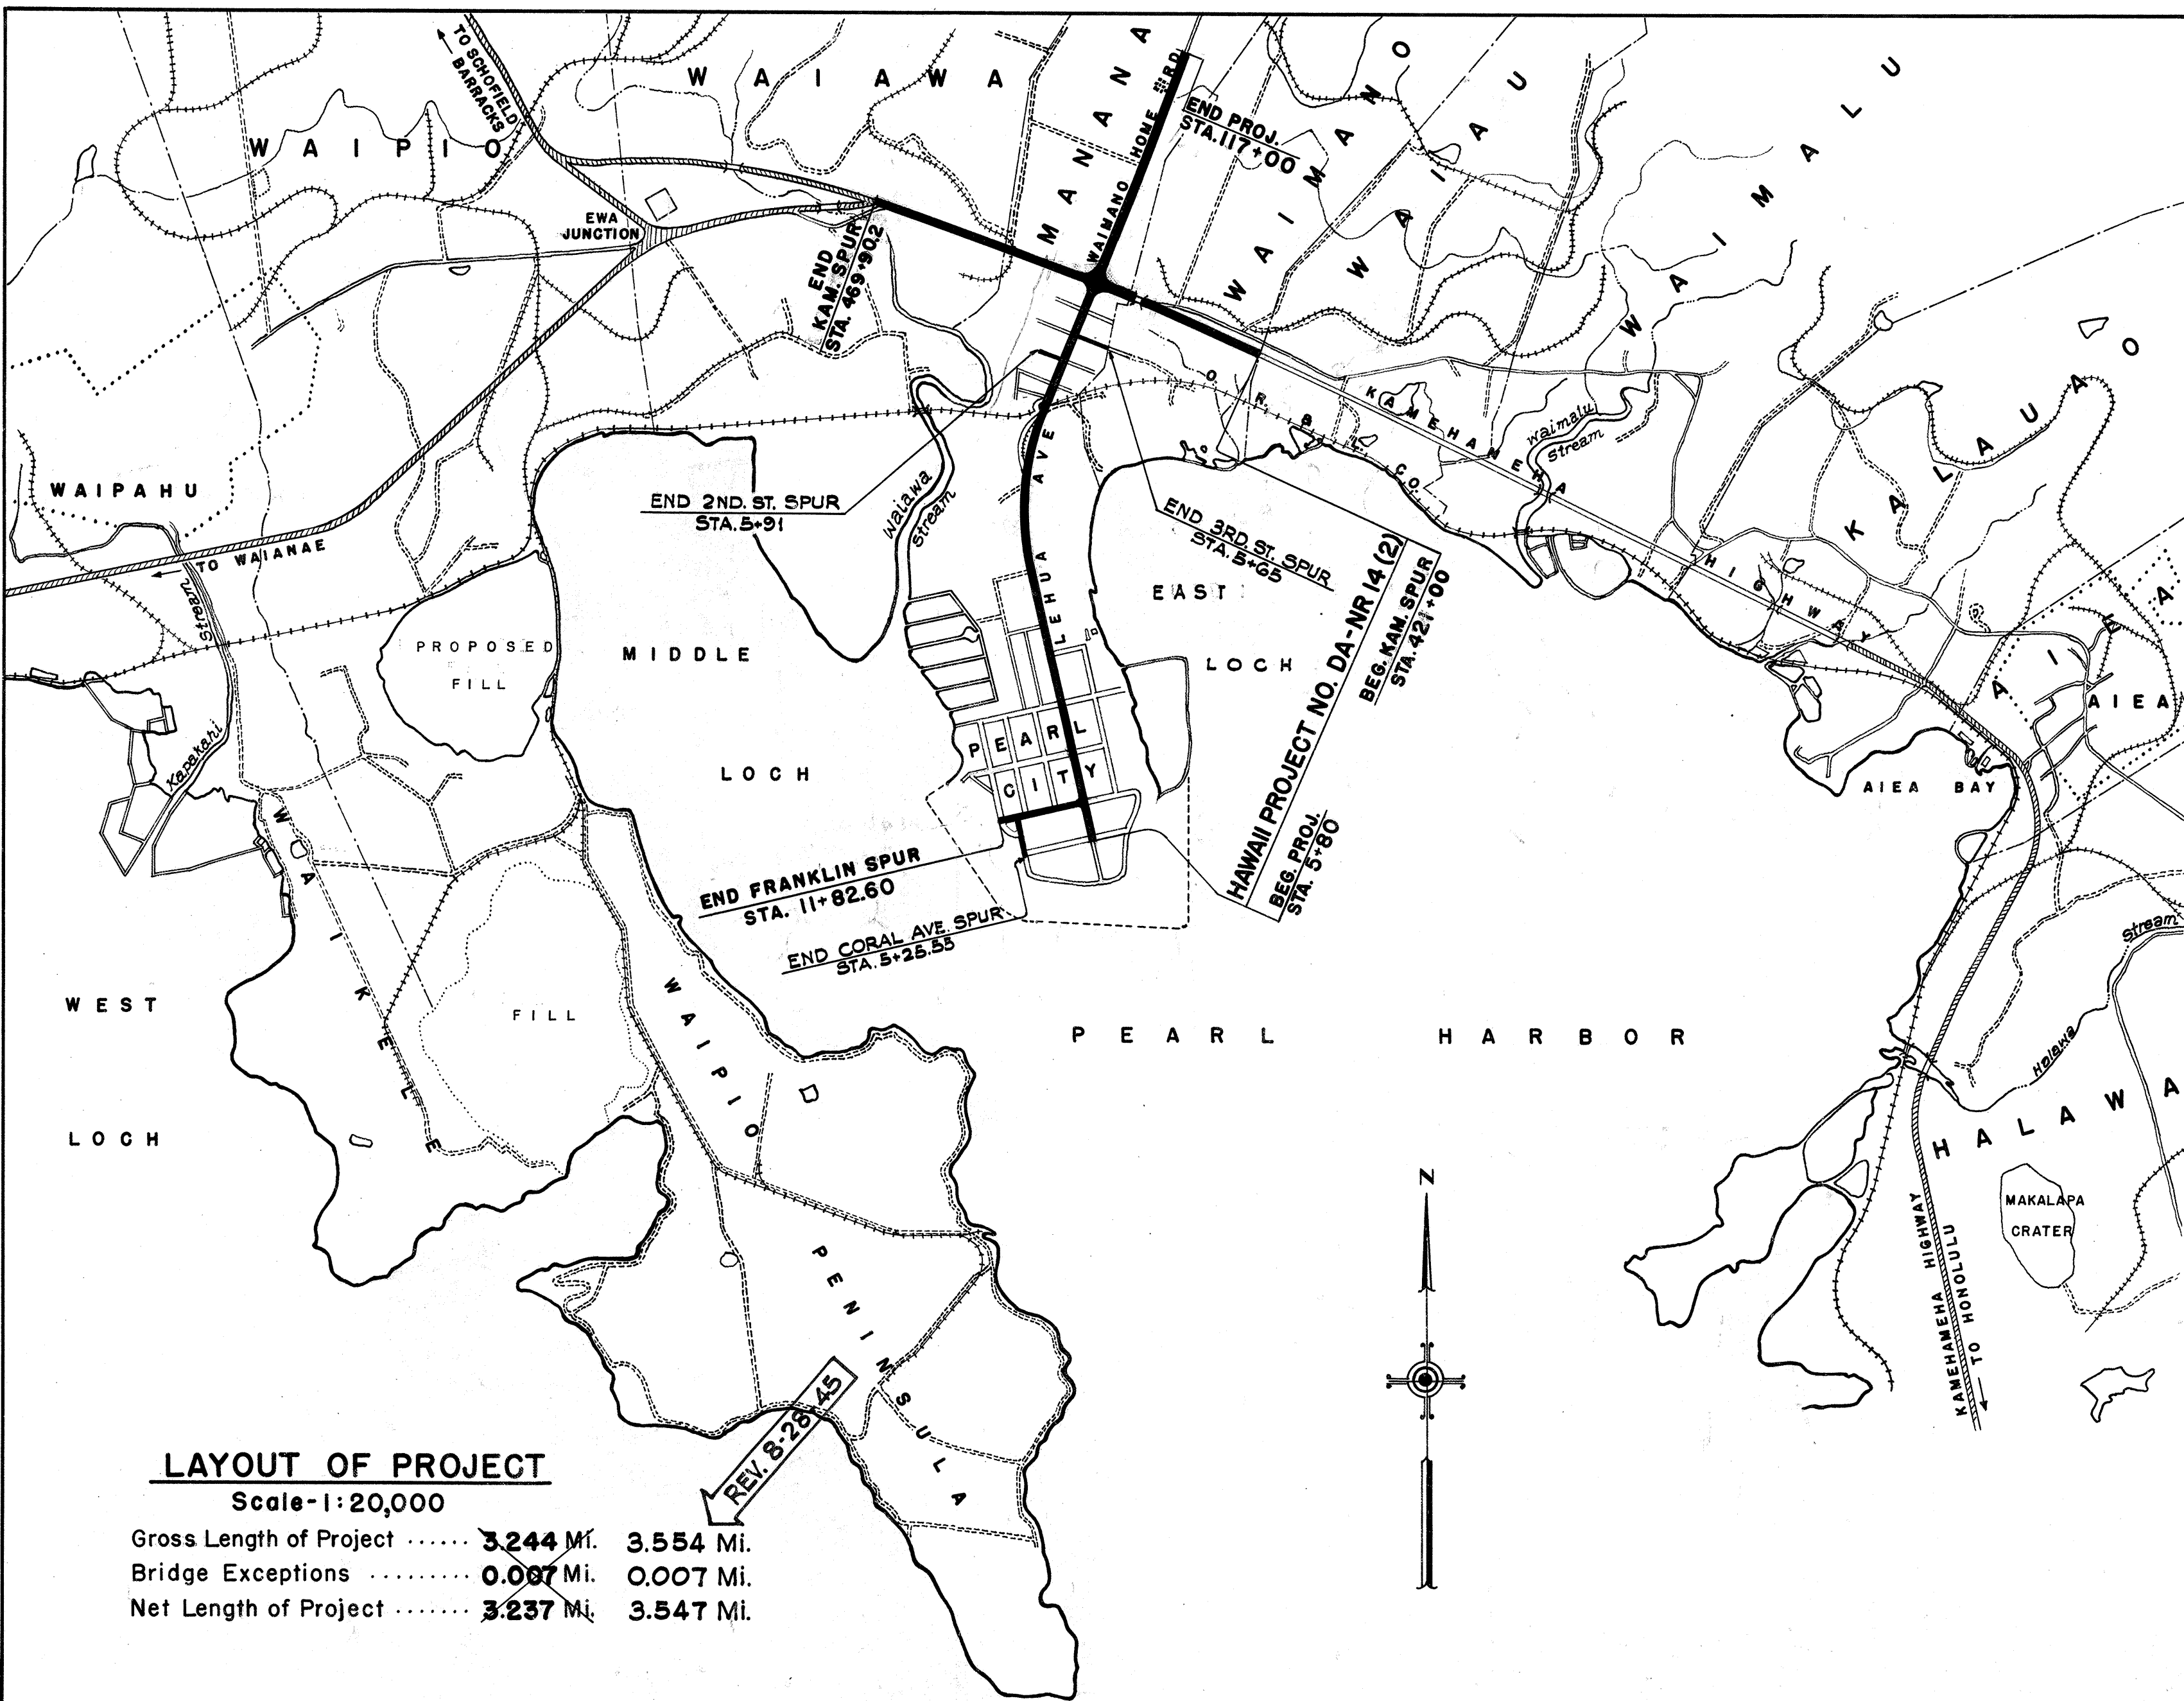


LAYOUT OF PROJECT

Scale: 1" = 20,000'

Gross Length of Project 3.244 Mi. 3.554 Mi.
Bridge Exceptions 0.007 Mi. 0.007 Mi.
Net Length of Project 3.237 Mi. 3.547 Mi.

FED. ROAD DIST. NO.	STATE	FED. AID PROJ. NO.	FISCAL YEAR	SHEET NO.	TOTAL SHEETS
HAWAII	HAW.	DA-NR 14 (2)	1944	1	81

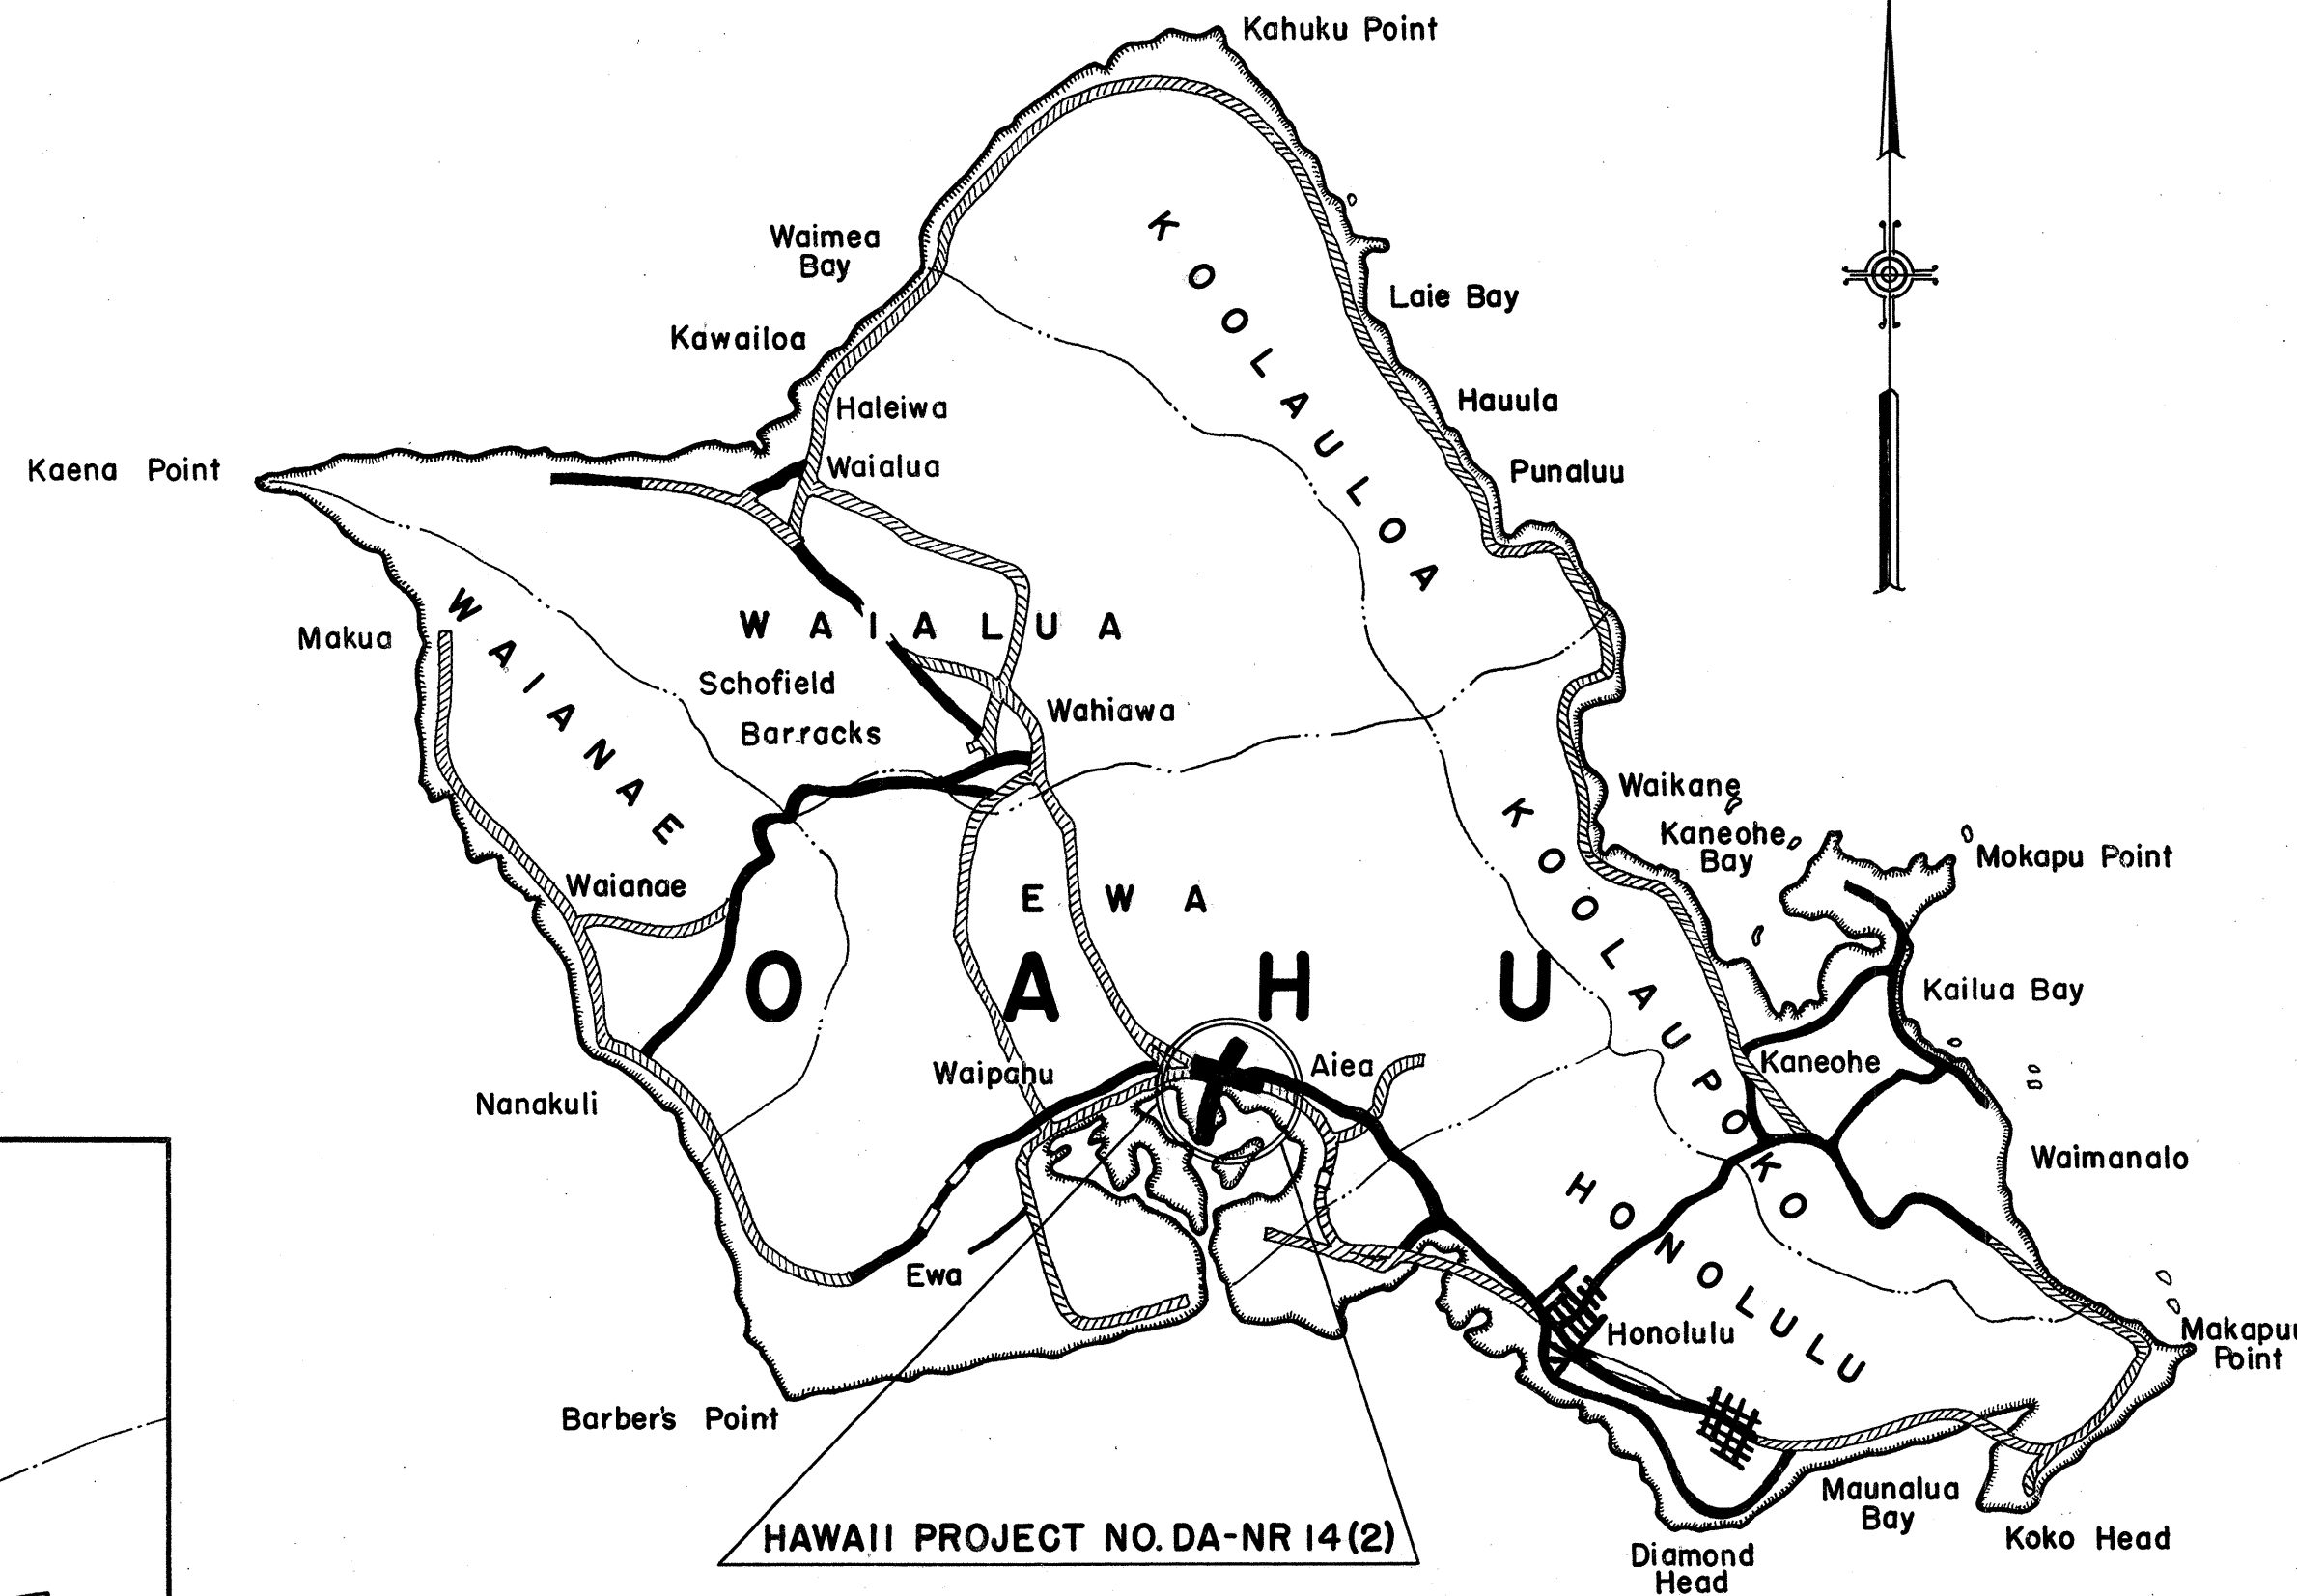

Federal Aid Projects Previously Constructed or Under Construction

REVISED INDEX TO DRAWINGS

REF. NO.	DESCRIPTION	SHEET NO.	REVISED DATE	INSERTED SHEET NO.	DATE
1	Title Sheet	5151.1	APR. 30, 1945		
2-3	Typical Sections	" 2-3	"		
4-9	Plan & Profile Lehua Ave.	" 4-9	"		
10	" " " Waimano Home Rd.	" 10	"	5151.11	MAY 31, 1945
11	" " " Franklin Spur	" 13	"	5151.13A	AUG. 28, 1945
12-15	" " " Kam. Highway	" 16-19	"		
16-19	Standard Details	" 22-25	"	5151.27	MAY 31, 1945
20	Standard Bridge Details	" 28	"		
21-26	Bridge Details	" 29-34	"		
27-40	Cross Sections Lehua Ave.	" 35-48	"	5151.49-50	MAY 31, 1945
41	" " Franklin Spur	" 51	"	5151.63-66	MAY 31, 1945
42-51	" " Kam. Highway	" 67-76	"	5151.73A-76A	MAY 31, 1945
	PLAN & PROFILE AND CROSS SECTION CORAL AVE., 2ND ST., & 3RD ST. SPURS	" 13A & 51A		5151.13A-51A	AUG. 28, 1945

APPROVED

APPROVED

B. F. Rush
TERRITORIAL HIGHWAY ENGINEER
DATE: 1-22-45

RECOMMENDED FOR APPROVAL

DISTRICT ENGINEER
Public Roads Administration,
Federal Works Agency

RECOMMENDED FOR APPROVAL

CHIEF WESTERN REGION
Public Roads Administration,
Federal Works Agency

APPROVED

COMMISSIONER
Public Roads Administration,
Federal Works Agency

5151.1