
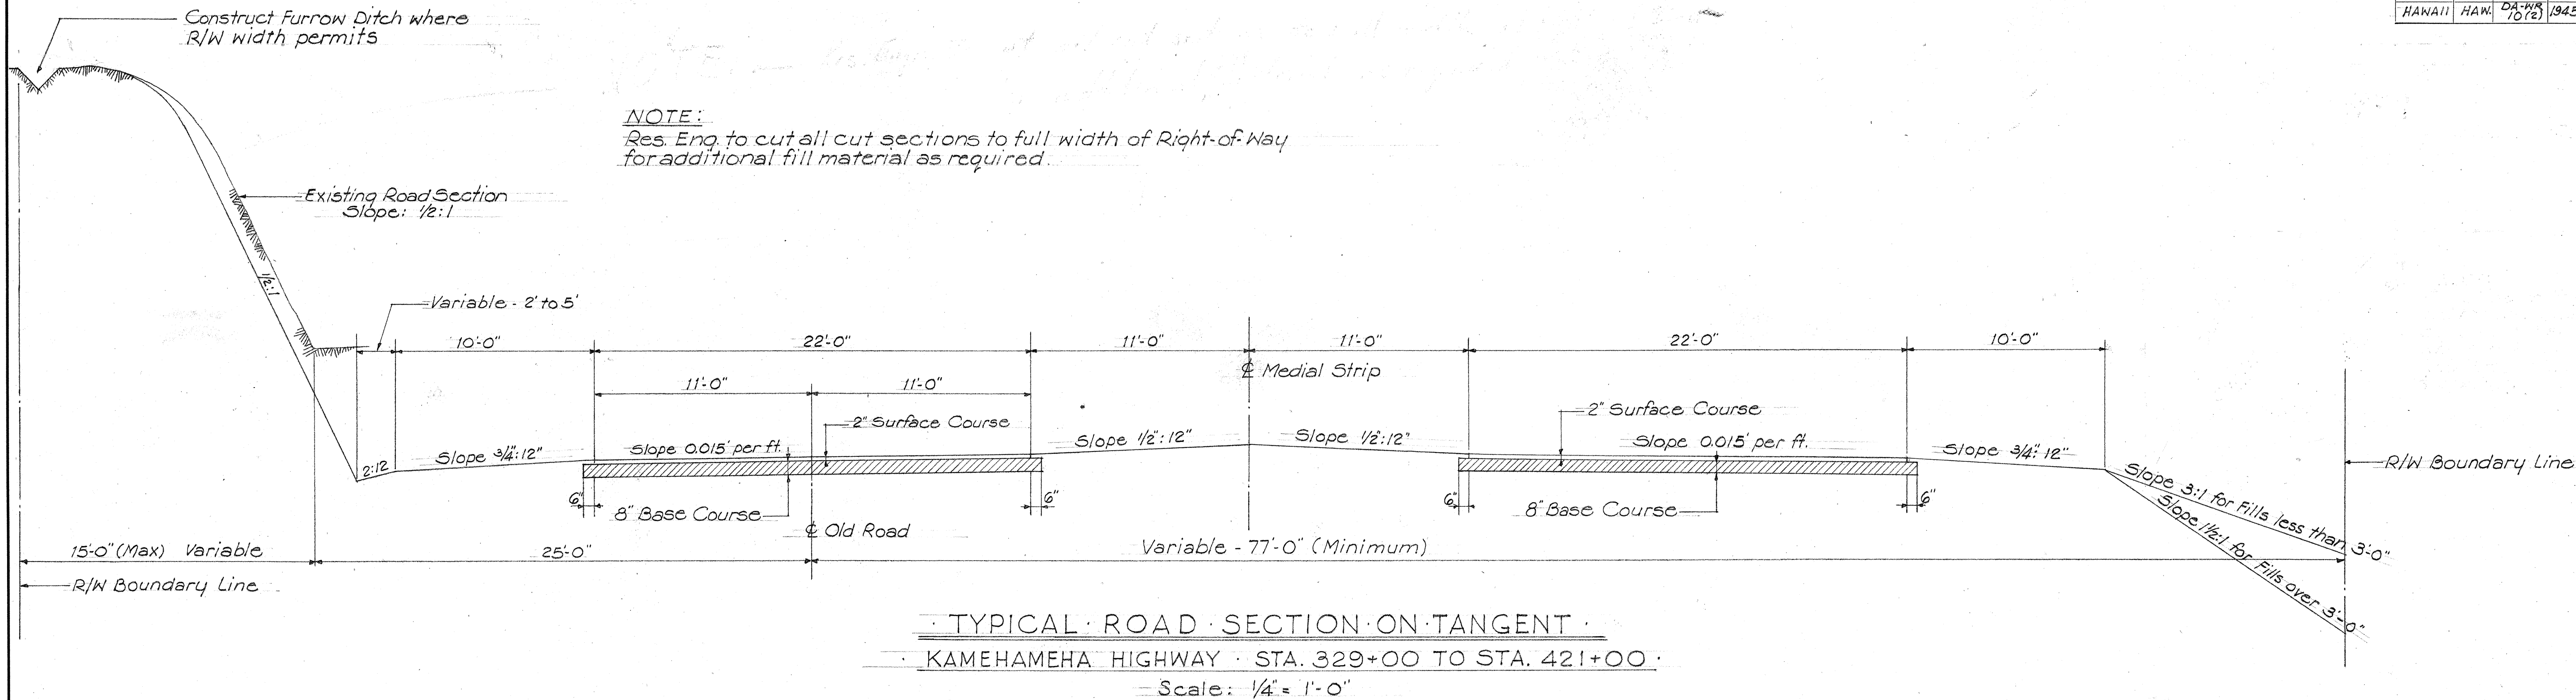


NOTE:
Bituminous Surface Treatment - (Type D) instead of Asphalt Concrete Surface Course shall be used on the approaches of minor roads and paved driveways which are selected by the Engineer.

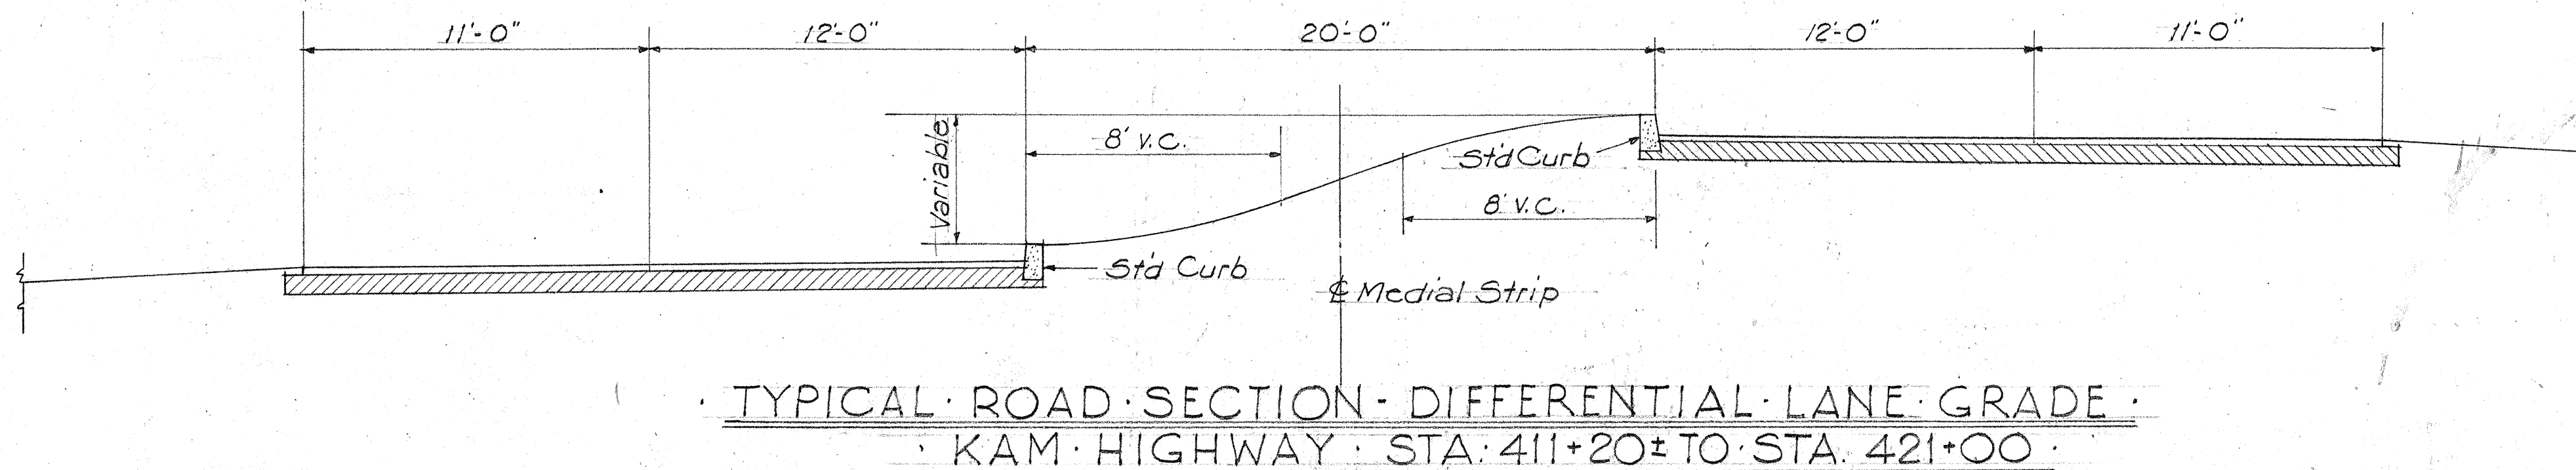

ORIGINAL PLAN No. 101

DESIGNED BY

TRACED BY

QUANTITIES BY

CHECKED BY

DATE

Revised: Aug 27, 1945

Rev. 8-27-45