

INDEX TO DRAWINGS	
SHEET NO.	DESCRIPTION
5244.1	Title Sheet
" .2	Typical Sections
" .3	Plan & Profile
" .4-.6	Standard Details
.7	Cross Sections

CONVENTIONAL SIGNS	
Centerline	100
Boundary Lines	0'
Fences (Noted)	
Existing Roadways	
Circular Culvert	
Box Culvert	
Bridge	
Telephone Pole	
Electric Power Pole	
Water Main	W ₂ W ₂ (W ₄ , 8, 12, Etc.)
Storm Drain	SD ₁₂ SD ₁₂ (SD 18, 24, Etc.)
Concrete Drop Intake	C.D.I.
Standard Catch Basin	
Standard Manhole	M.H.S.
Sewer Manhole	S.M.H.
Telephone Manhole	T.M.H.
Fire Hydrant	
Tree (Large, named)	Mango, Coca
Railroad	


TERRITORY OF HAWAII
TERRITORIAL HIGHWAY DEPARTMENT
HONOLULU - T. H.

PLANS OF
KAMEHAMEHA HIGHWAY
WAIKAKALAU TO WHEELER FIELD
FEDERAL AID PROJECT NO. SN-FAP 7(19)

Wahiwa District

Island of Oahu

S C A L E S	
PLAN	1 INCH = 50 FEET
PROFILE	HOR: 1 INCH = 50 FEET VER: 1 INCH = 5 FEET
CROSS SECTIONS	HOR: 1 INCH = 10 FEET VER: 1 INCH = 5 FEET

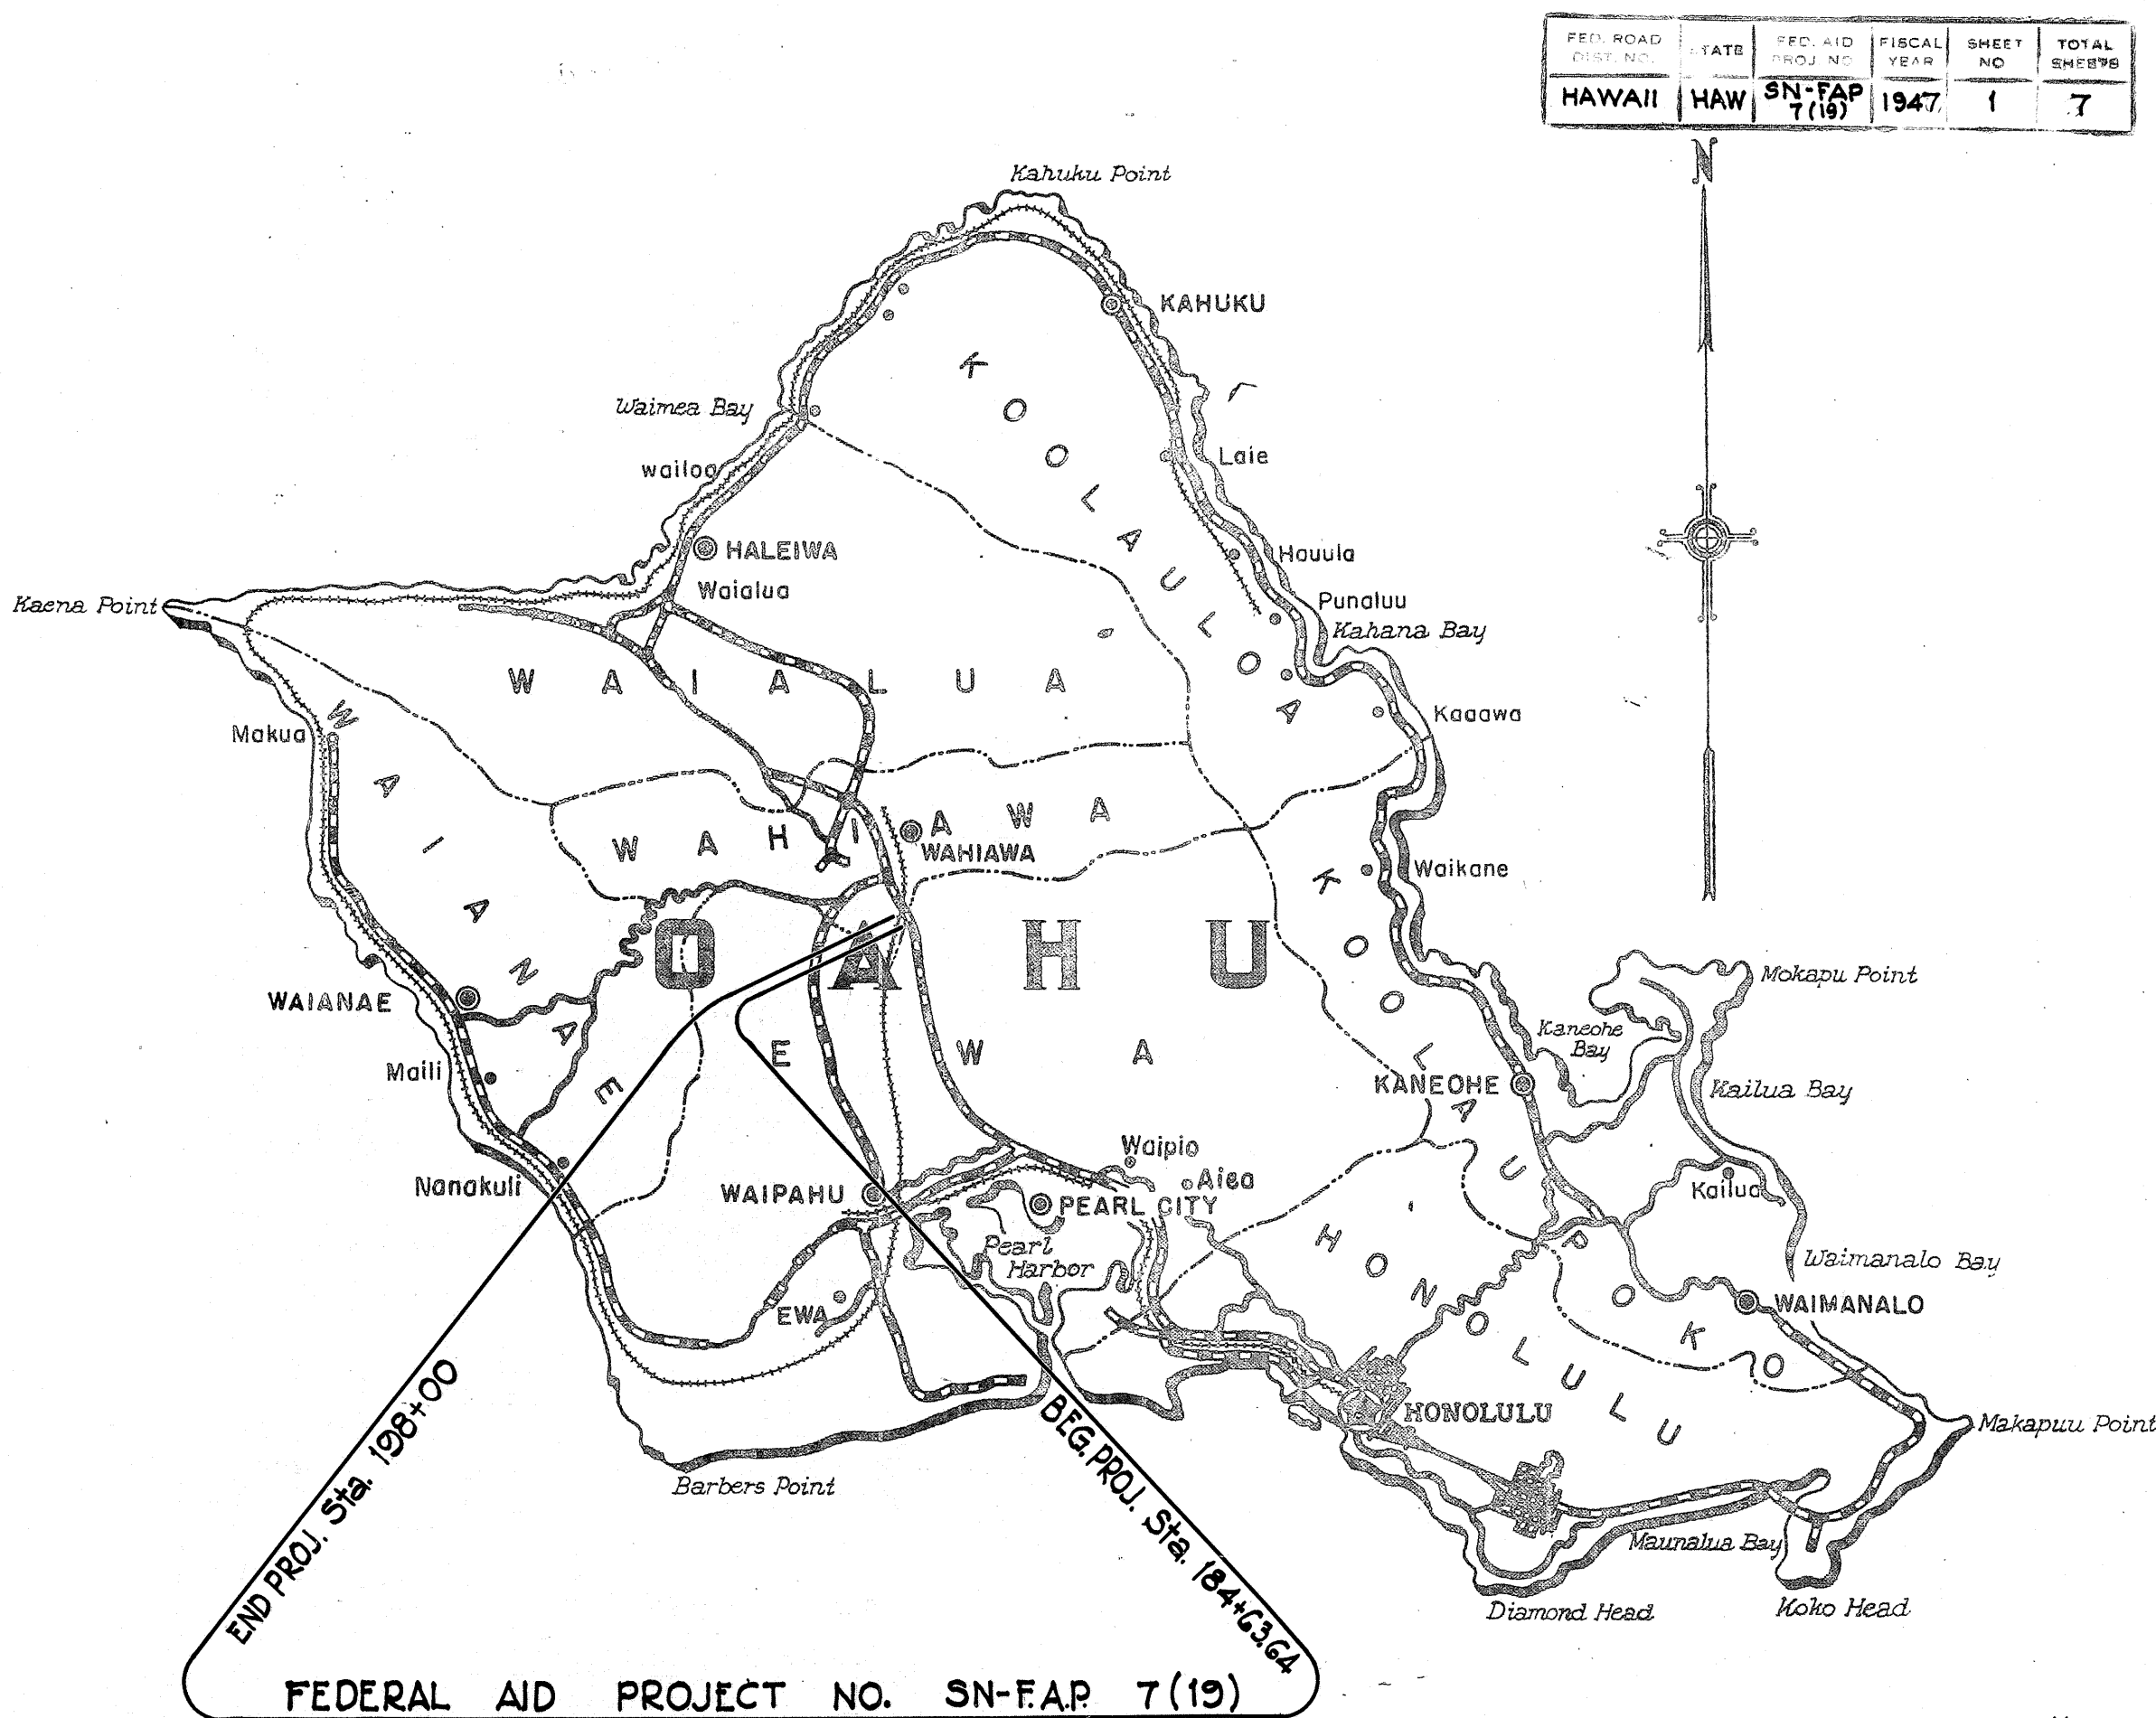

Federal Aid Projects Previously Constructed Or Under Construction

NOTE:


All changes made during construction have been noted on these tracings in red and checked by:

Howard B. Rush

RESIDENT ENGINEER

June 2, 1949

DATE

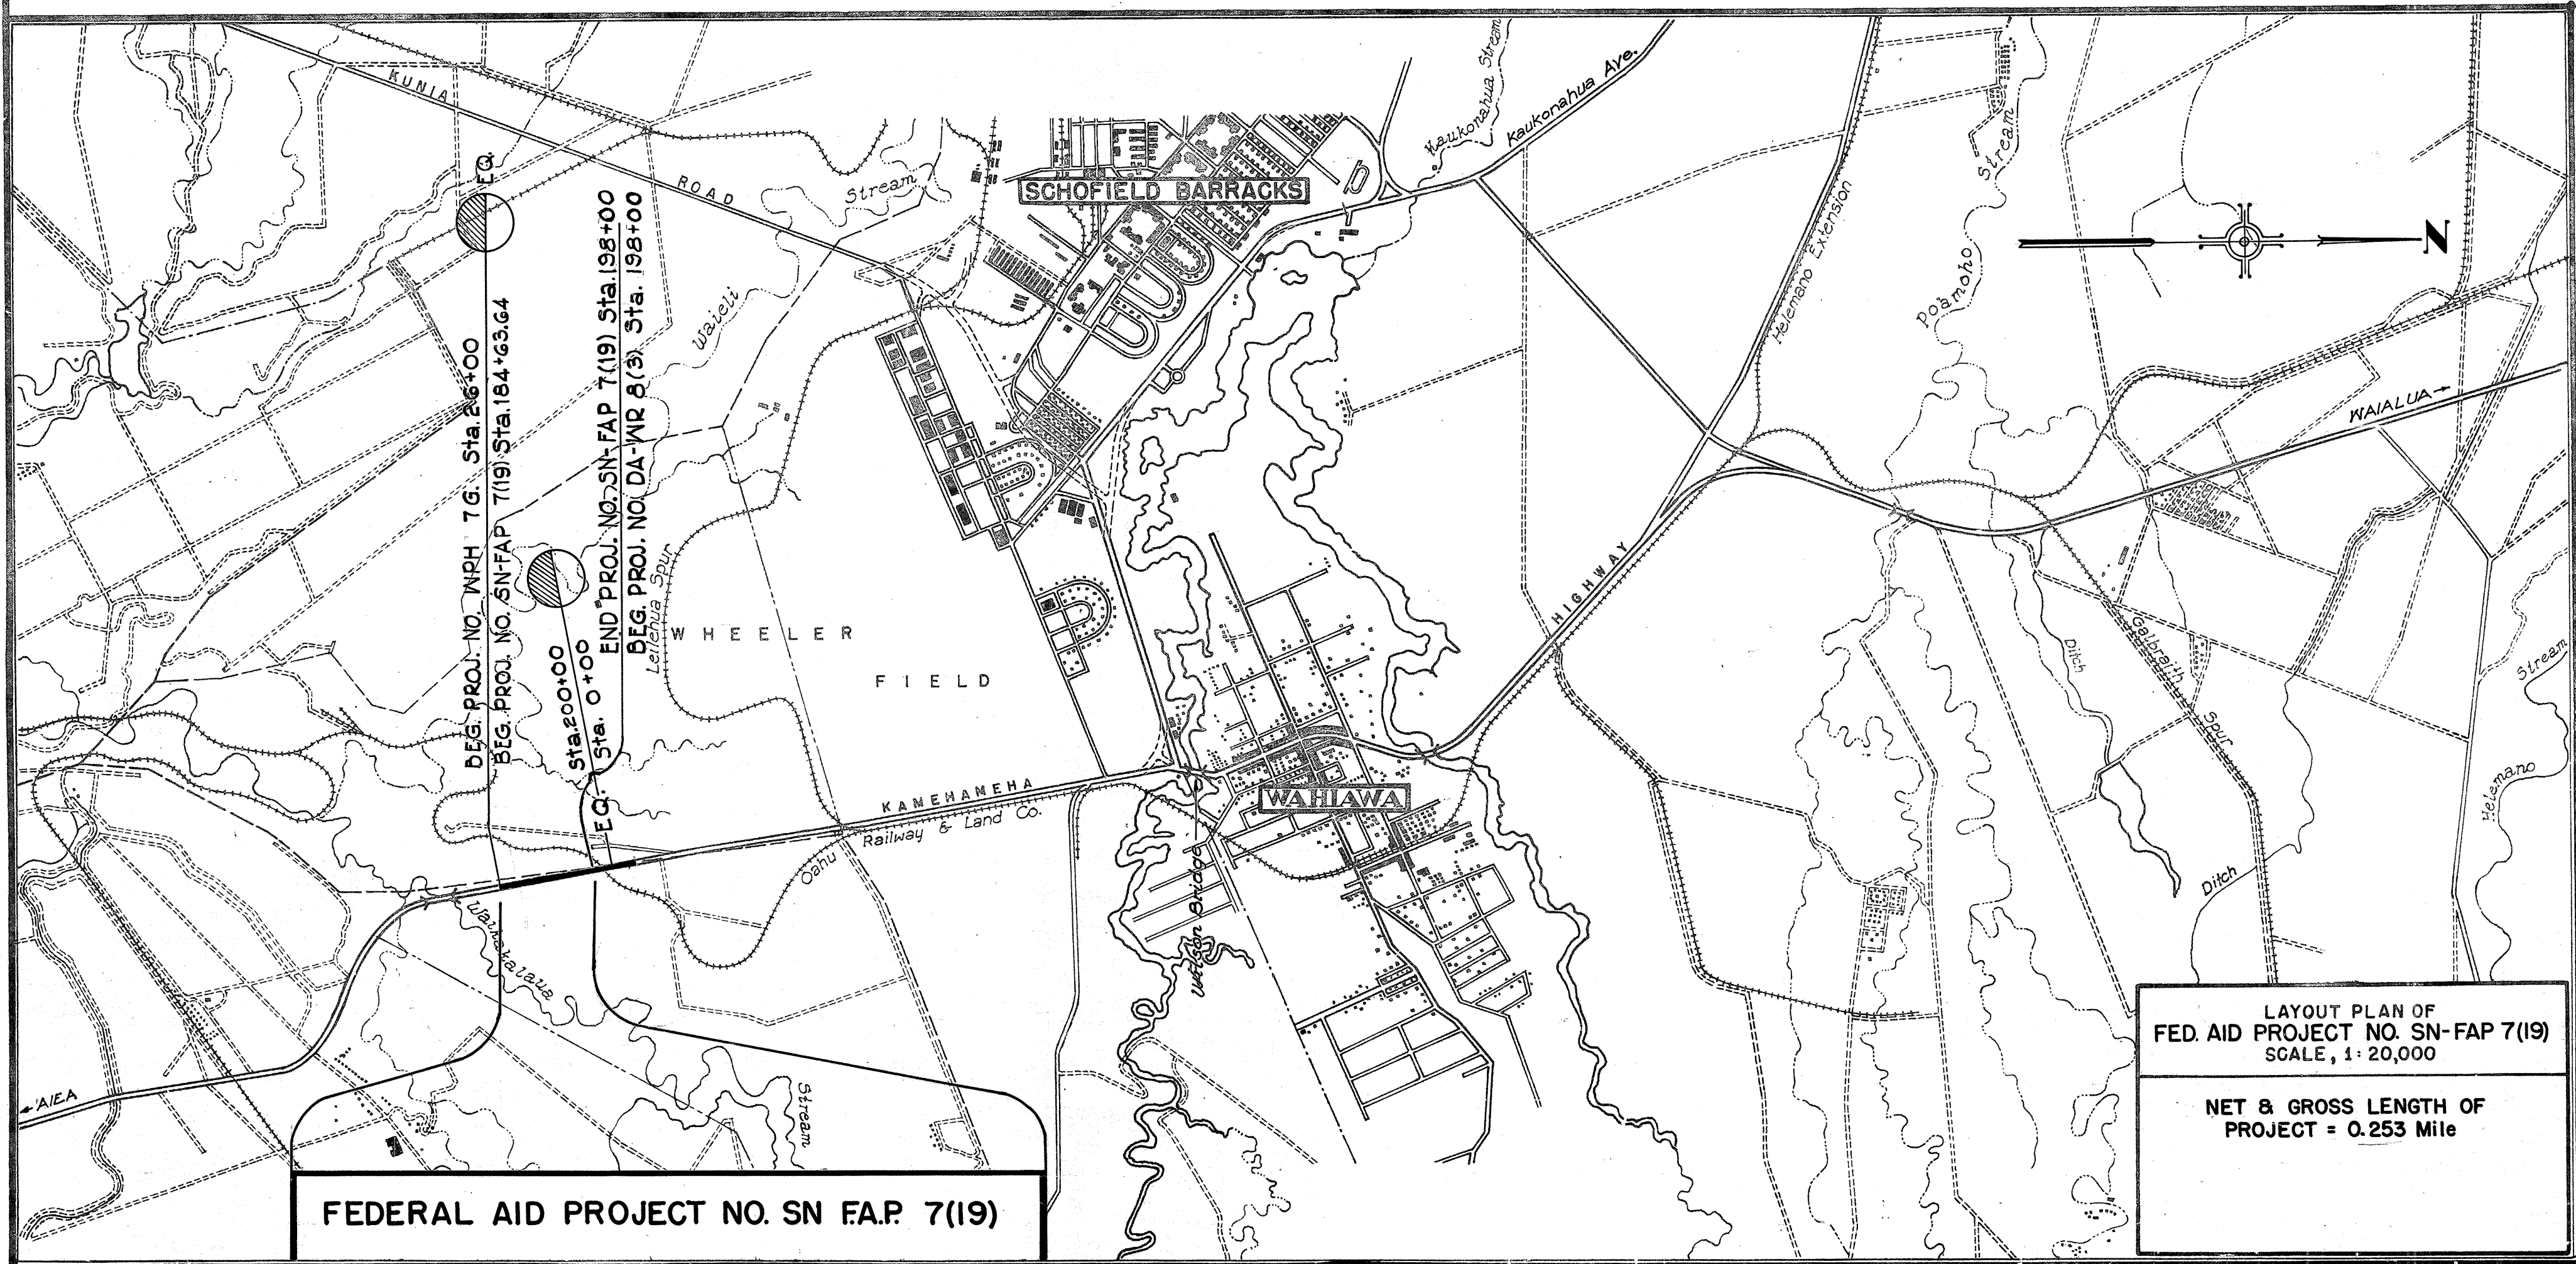

APPROVED: DATE 5-12-47

B. F. Rush

TERRITORIAL HIGHWAY ENGINEER

APPROVED: DATE 5-12-47

Don Belt

TERRITORIAL HIGHWAY ENGINEER

RECOMMENDED FOR APPROVAL:	DATE
DISTRICT ENGINEER PUBLIC ROADS ADMINISTRATION FEDERAL WORKS AGENCY	
APPROVED:	DATE
DIVISION ENGINEER PUBLIC ROADS ADMINISTRATION FEDERAL WORKS AGENCY	