


FED. ROAD DIST. NO.	STATE	FED. AID PROJ. NO.	FISCAL YEAR	SHEET NO.	TOTAL SHEETS
Hawaii	HAW	SN-(DC) FA-F 7(20)	1949	4	70

NOTE:
Territorial Highway Maintenance Dept.
shall Relocate Warning Signs C-35
C-36, C-38 and Regulatory Sign R-22
From the End of Proj. S1(DC)FA-7(20)
to their new location as shown on
this sheet. Signs and Numbers do not
correspond to those shown on the
Detail Sheet.

NOTE: All Buildings inside the Right-of-Way shall be removed by others.



NOTE: Resident Engineer to adjust drainage to meet field condition

NOTE:
Sta 0+00 to Sta 31+50 Left Existing
Barbed Wire Fence to be removed
and Disposed of by the Contractor


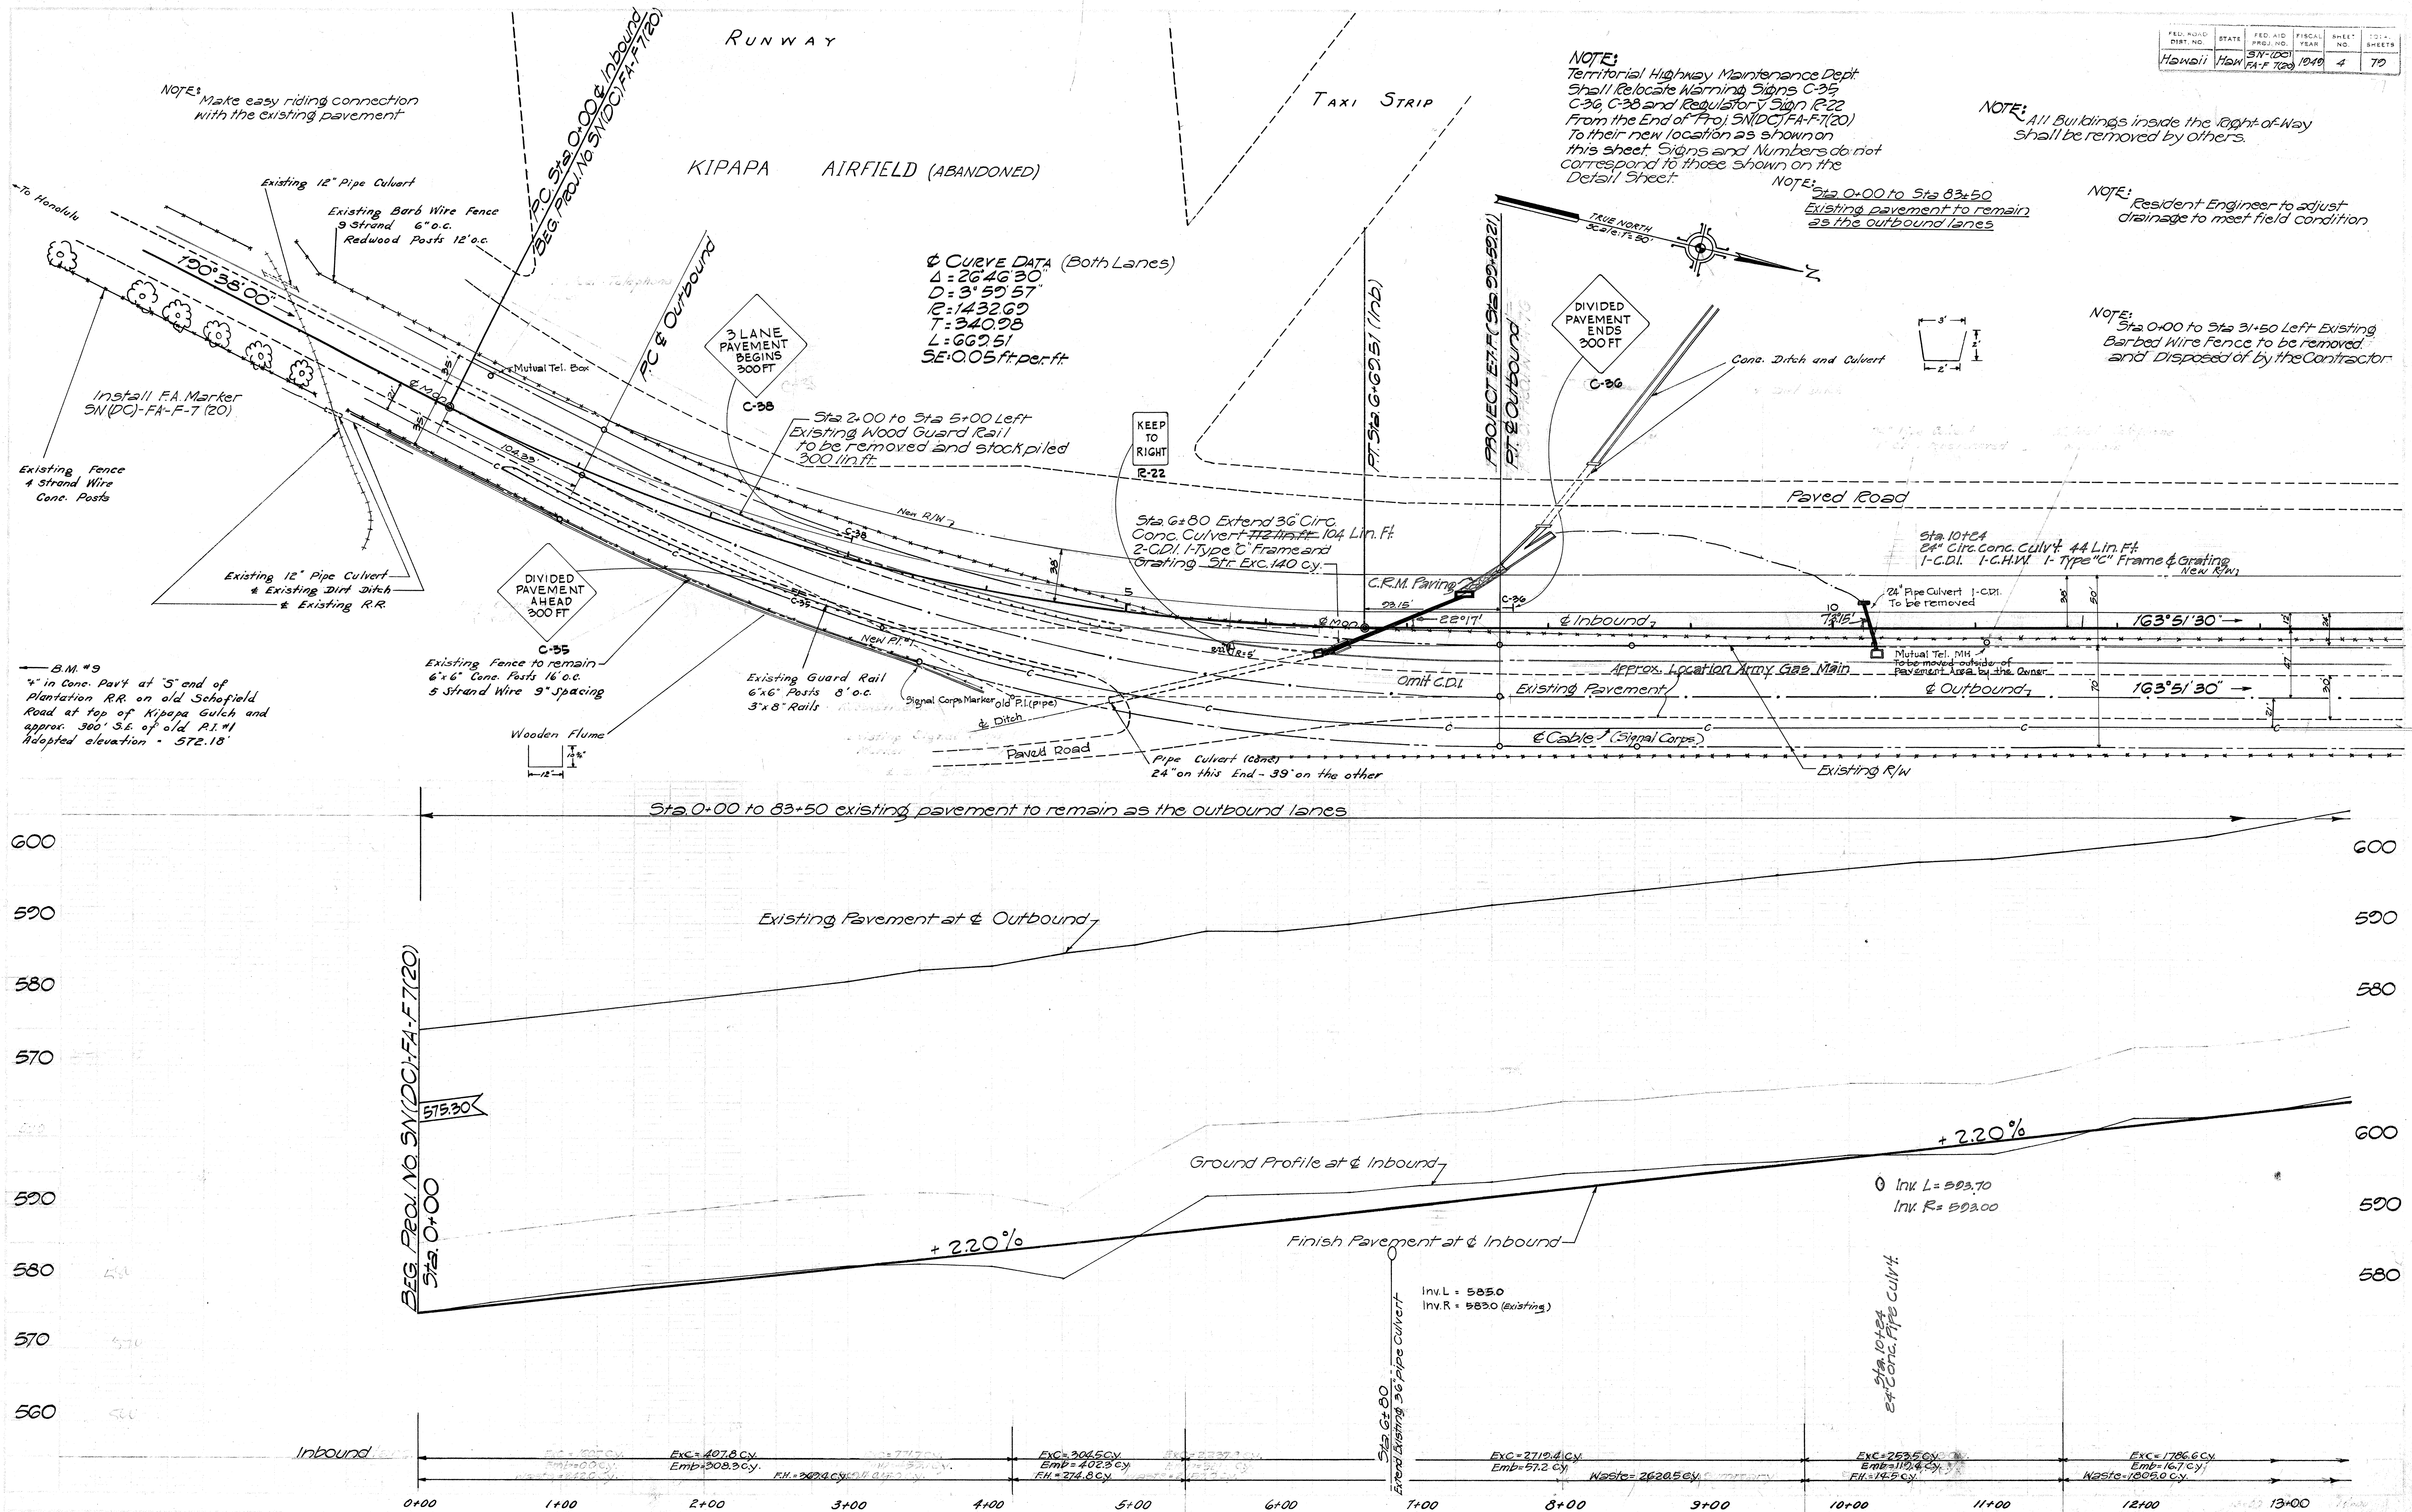



5 3 8 2 . 4



FED. ROAD DIST. NO.	STATE	FED. AID PROJ. NO.	FISCAL YEAR	SHEET NO.	TOTAL SHEETS
HAWAII	HAWAII	5N-100	1940	5	79

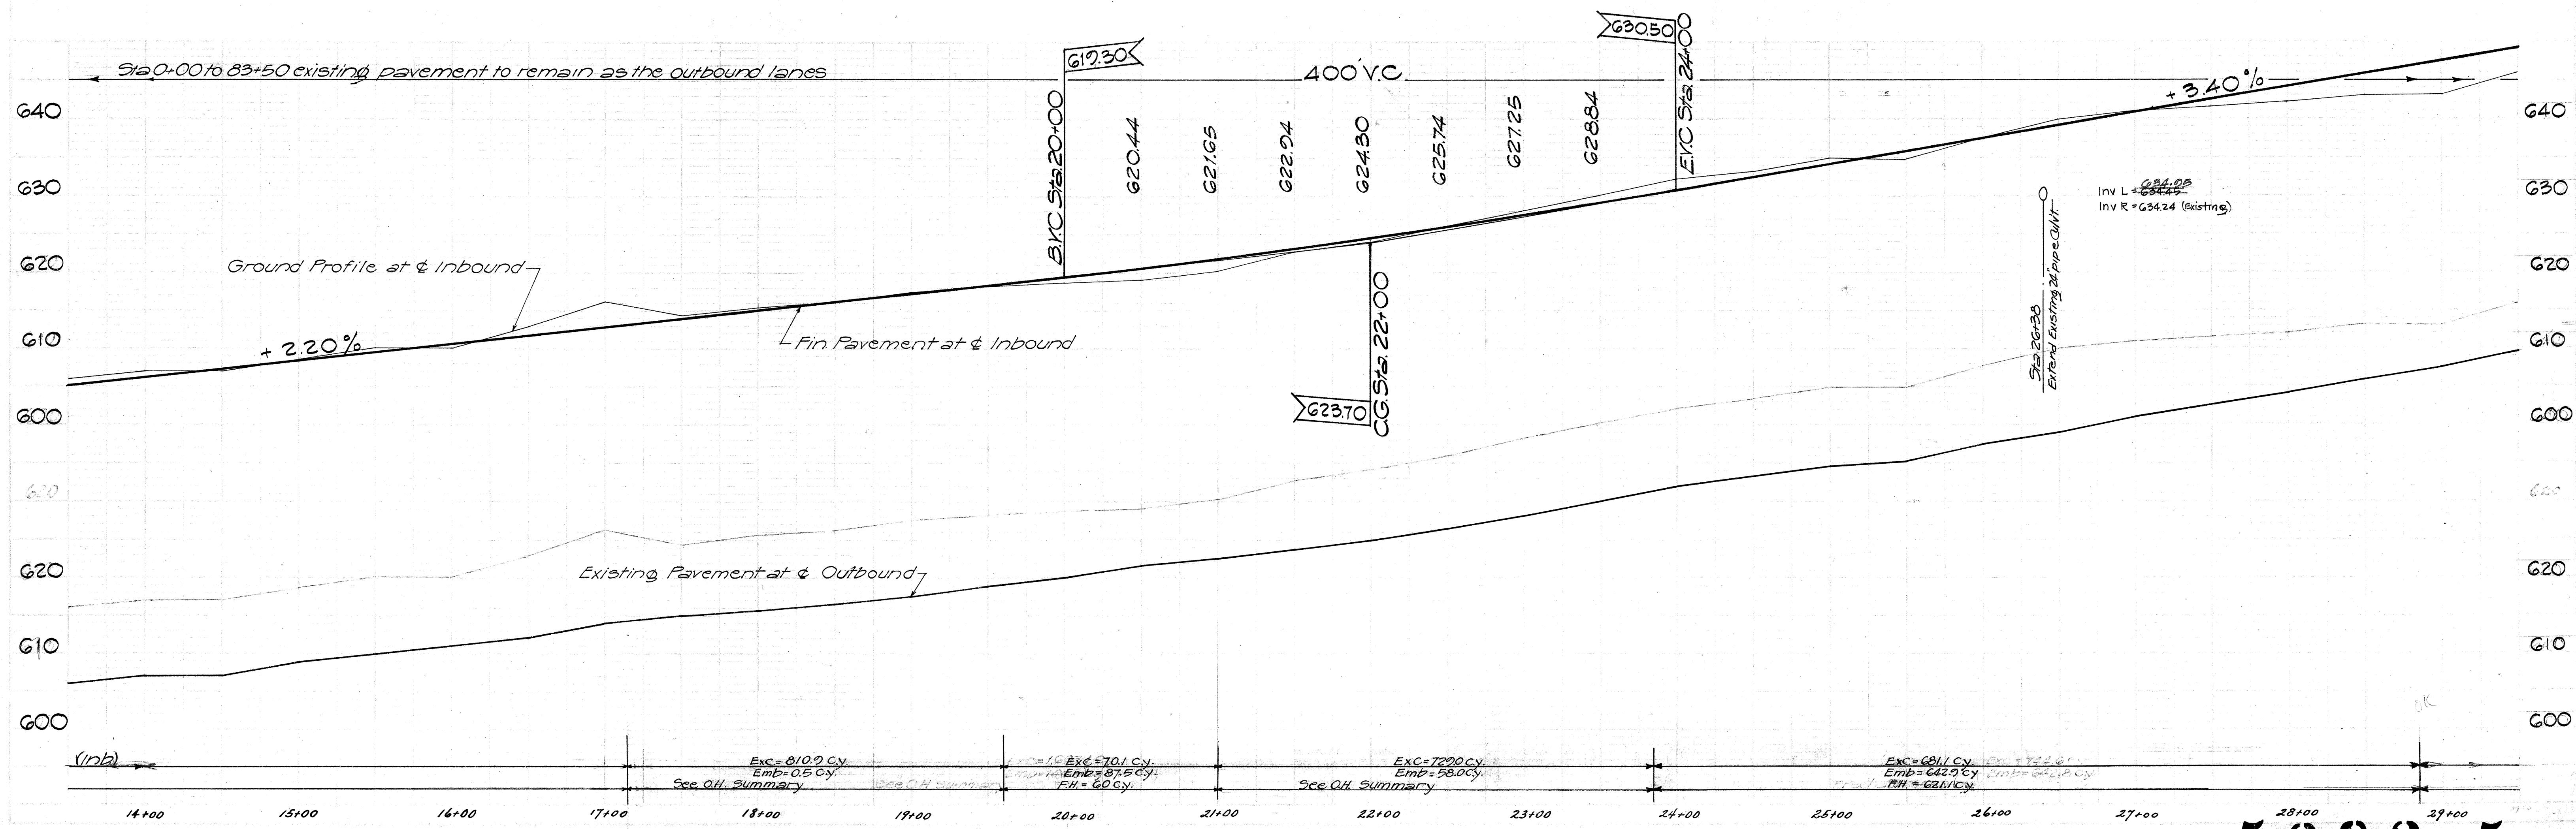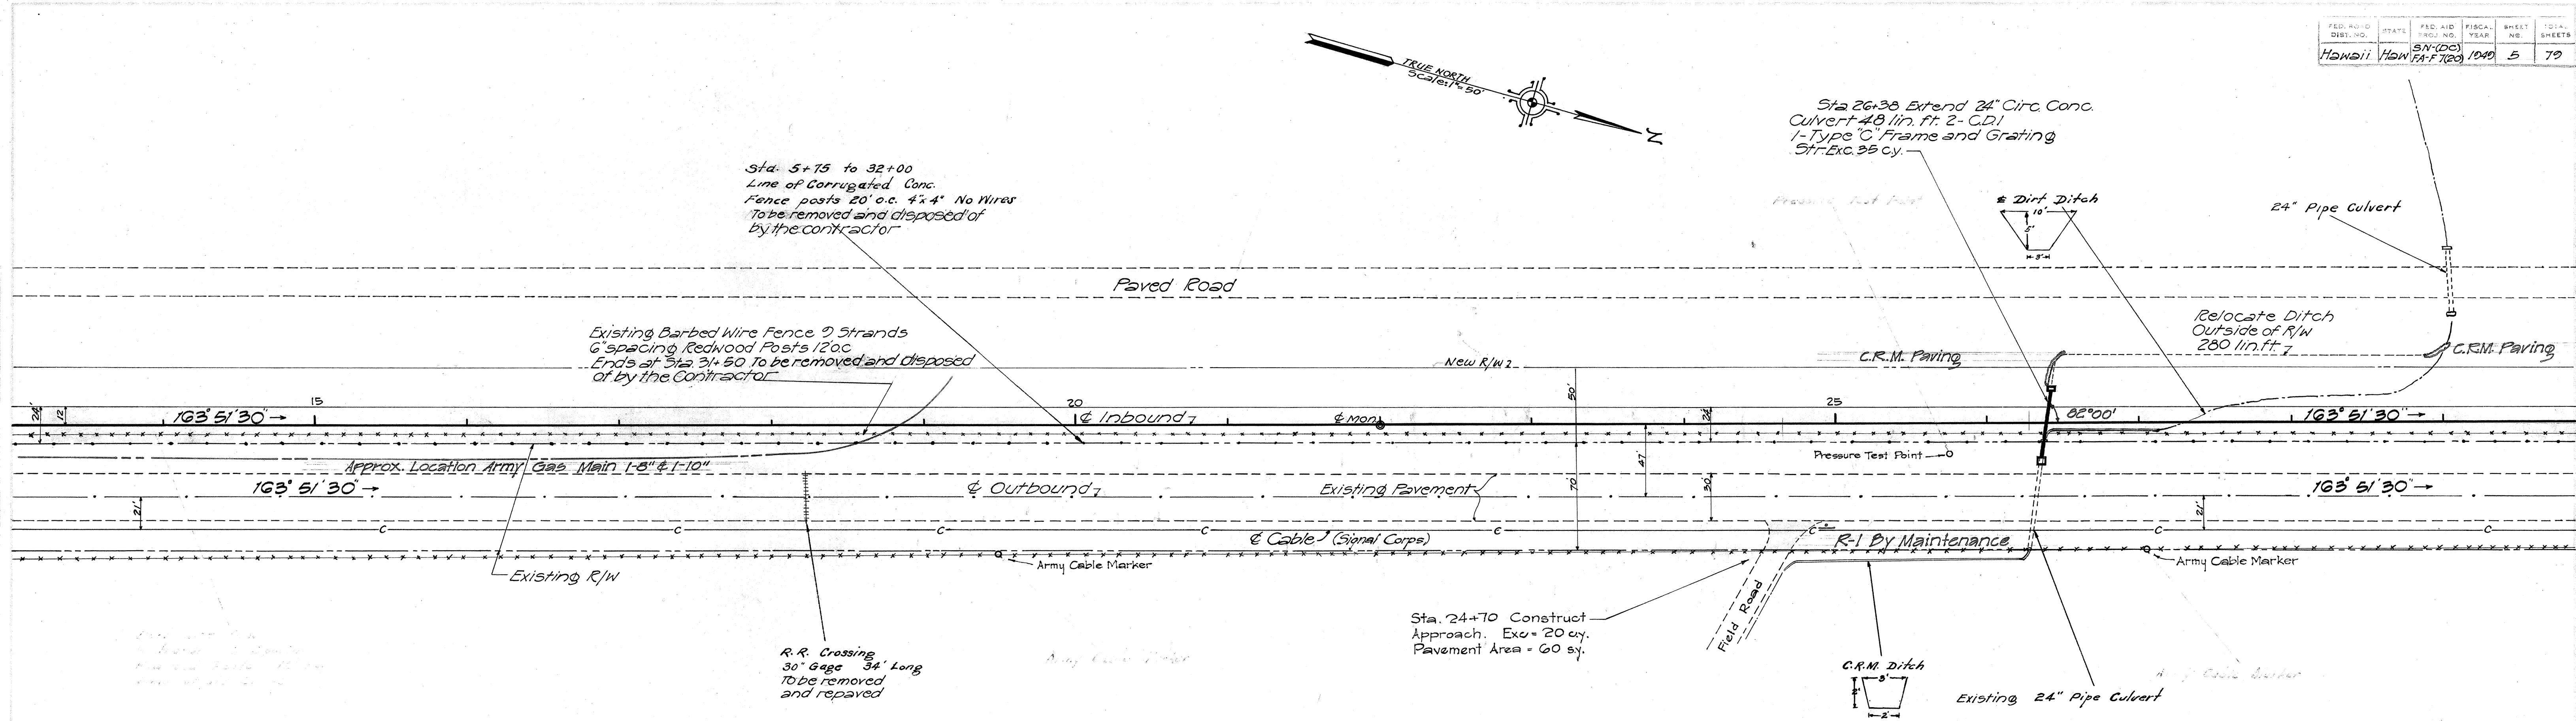


5382.5

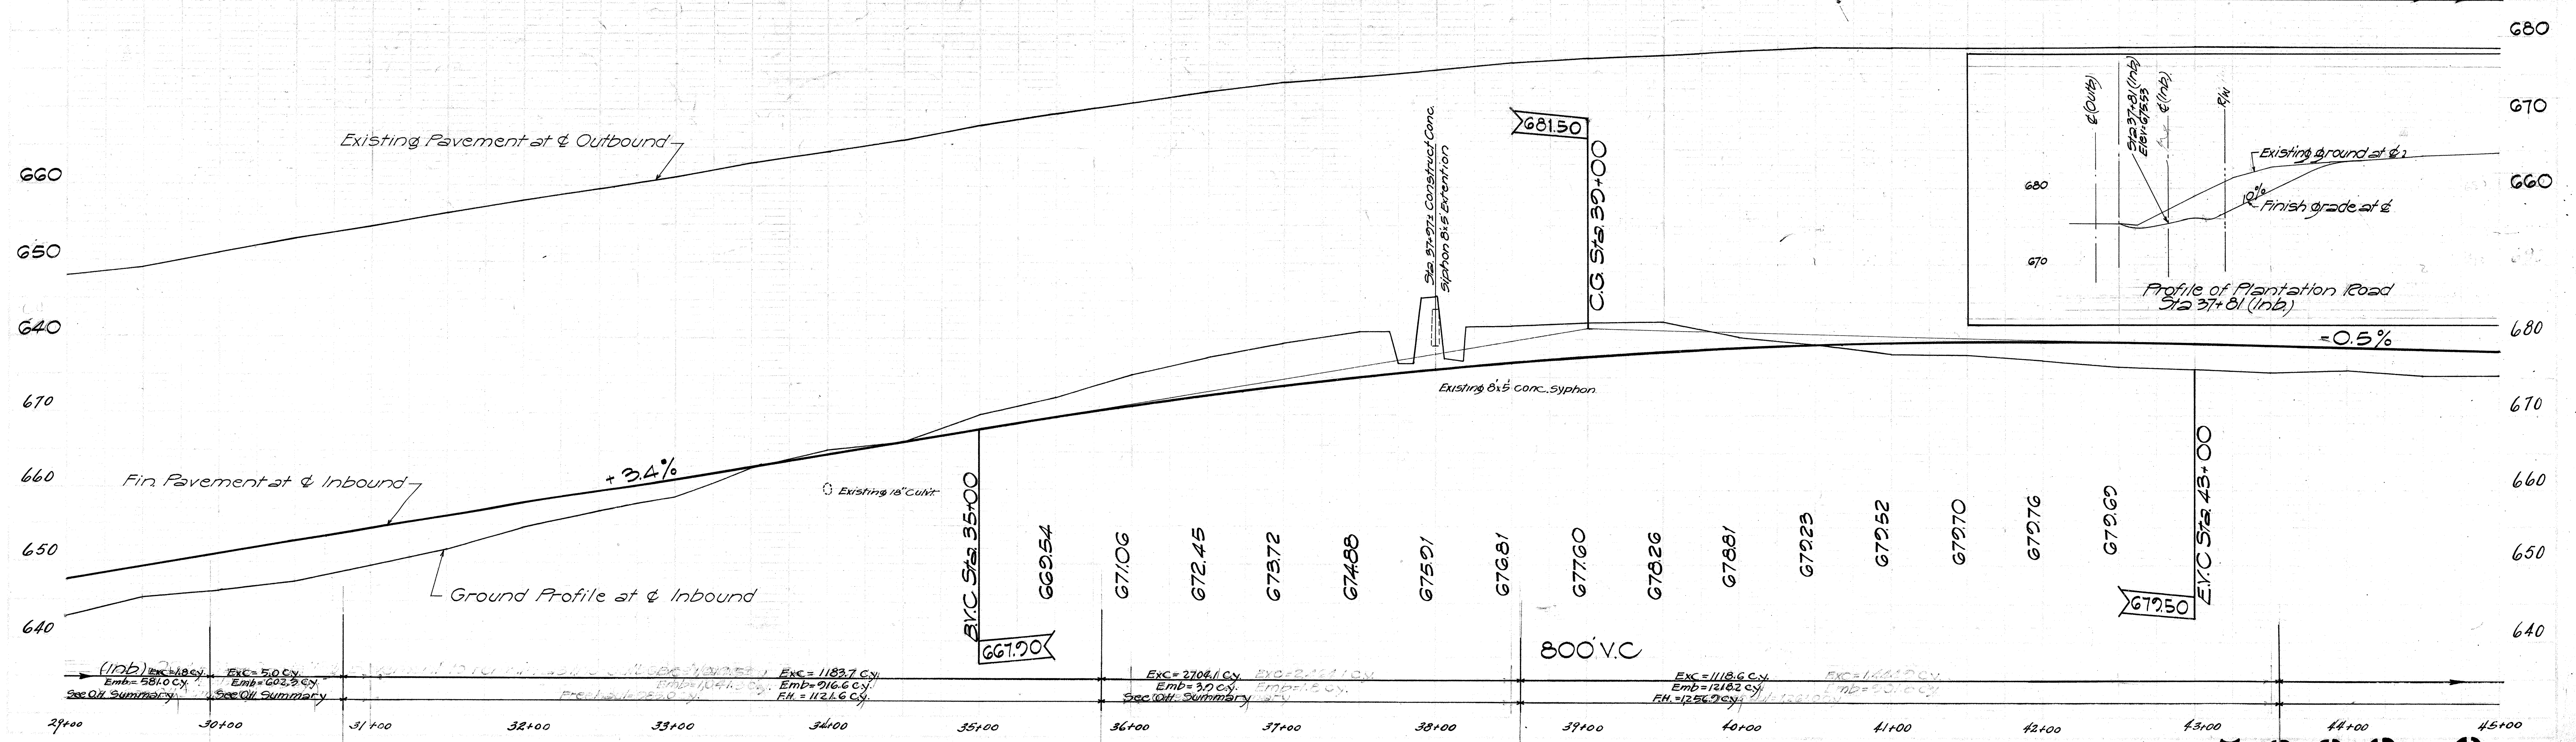
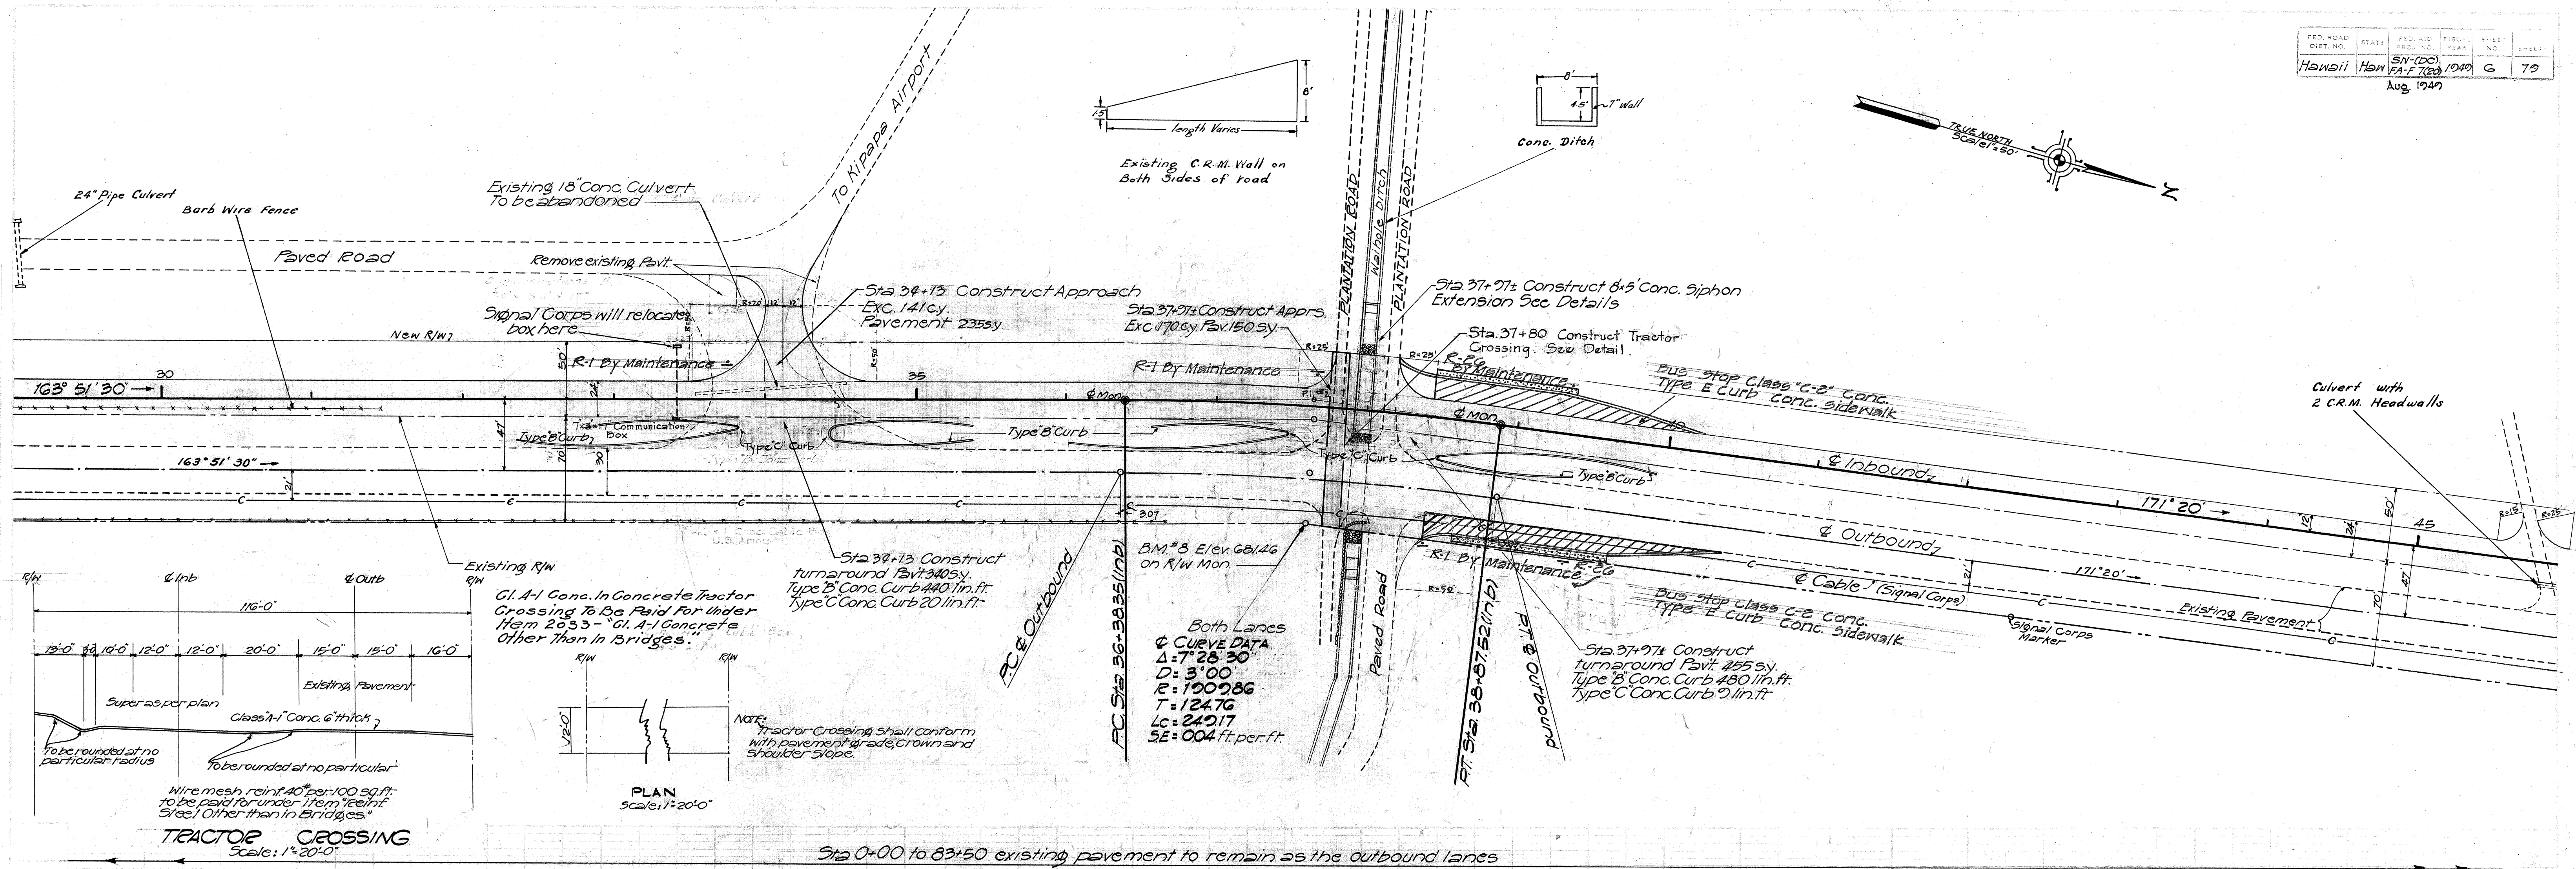



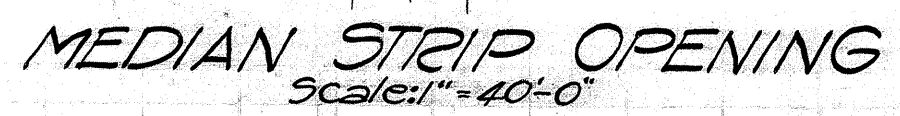


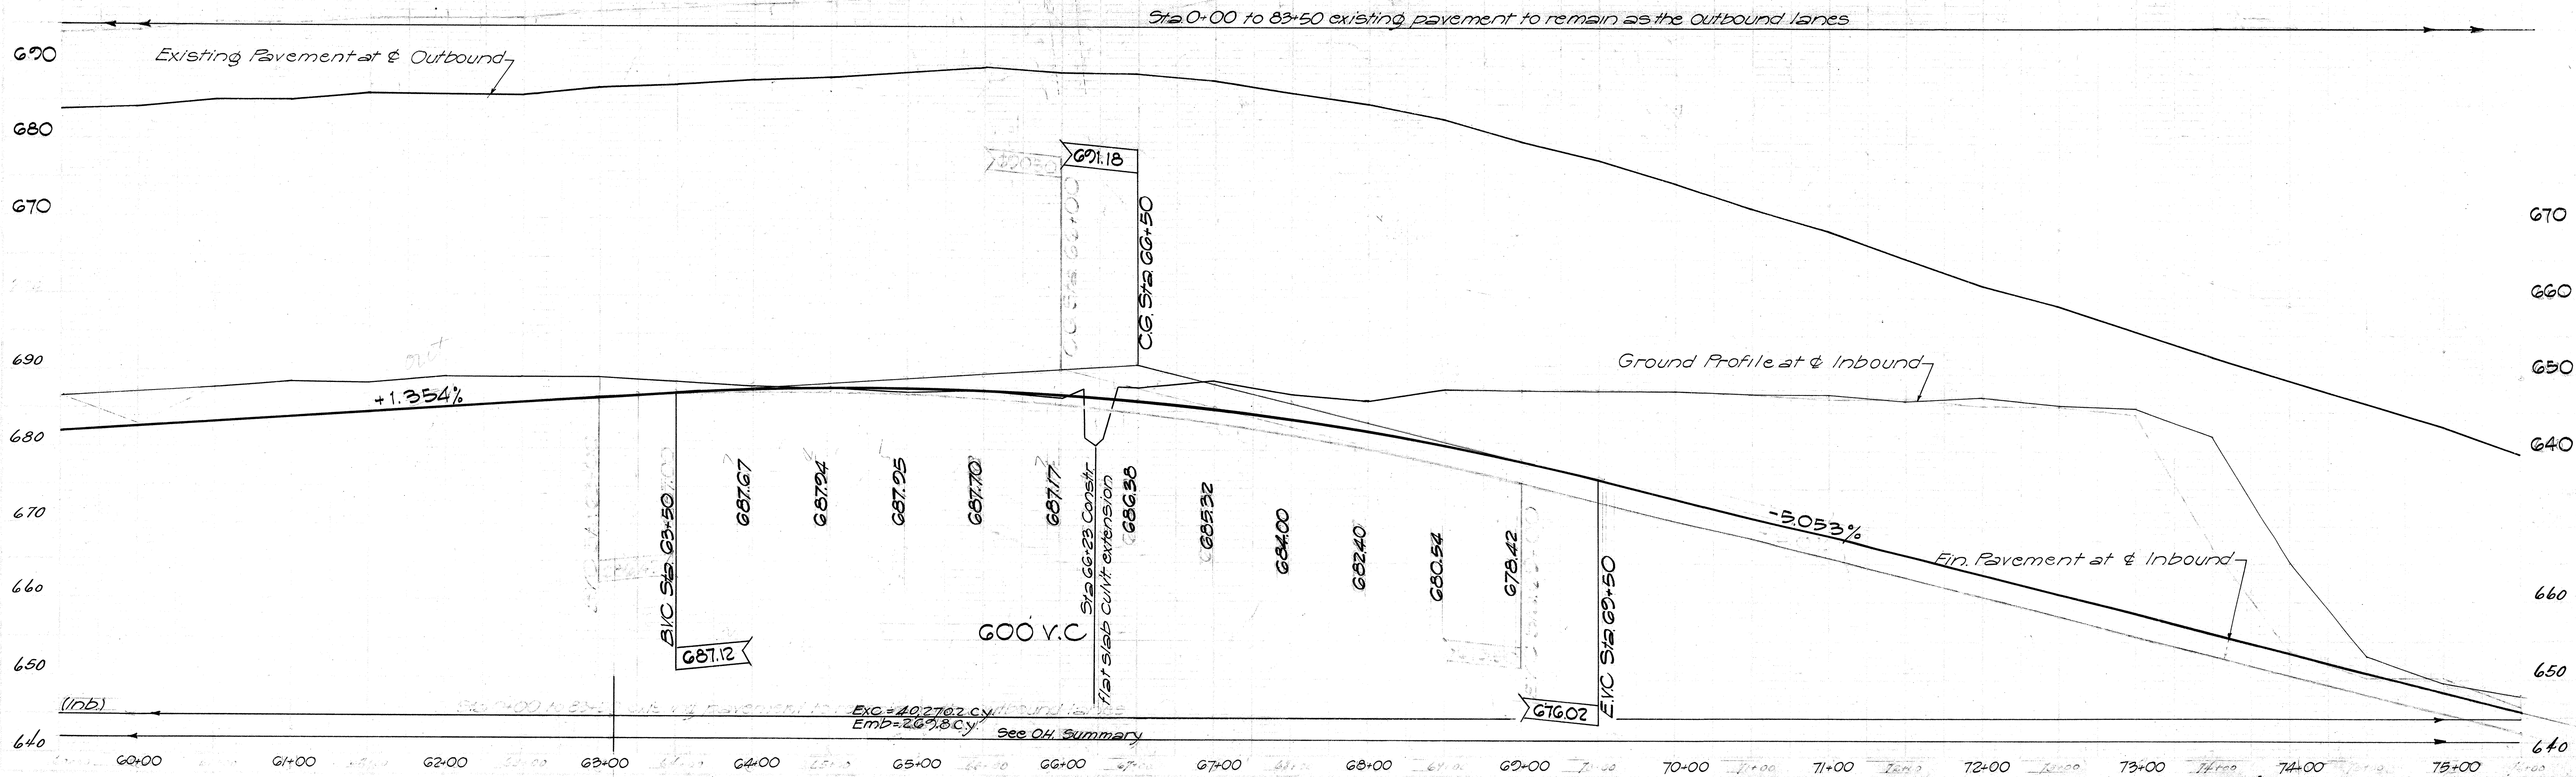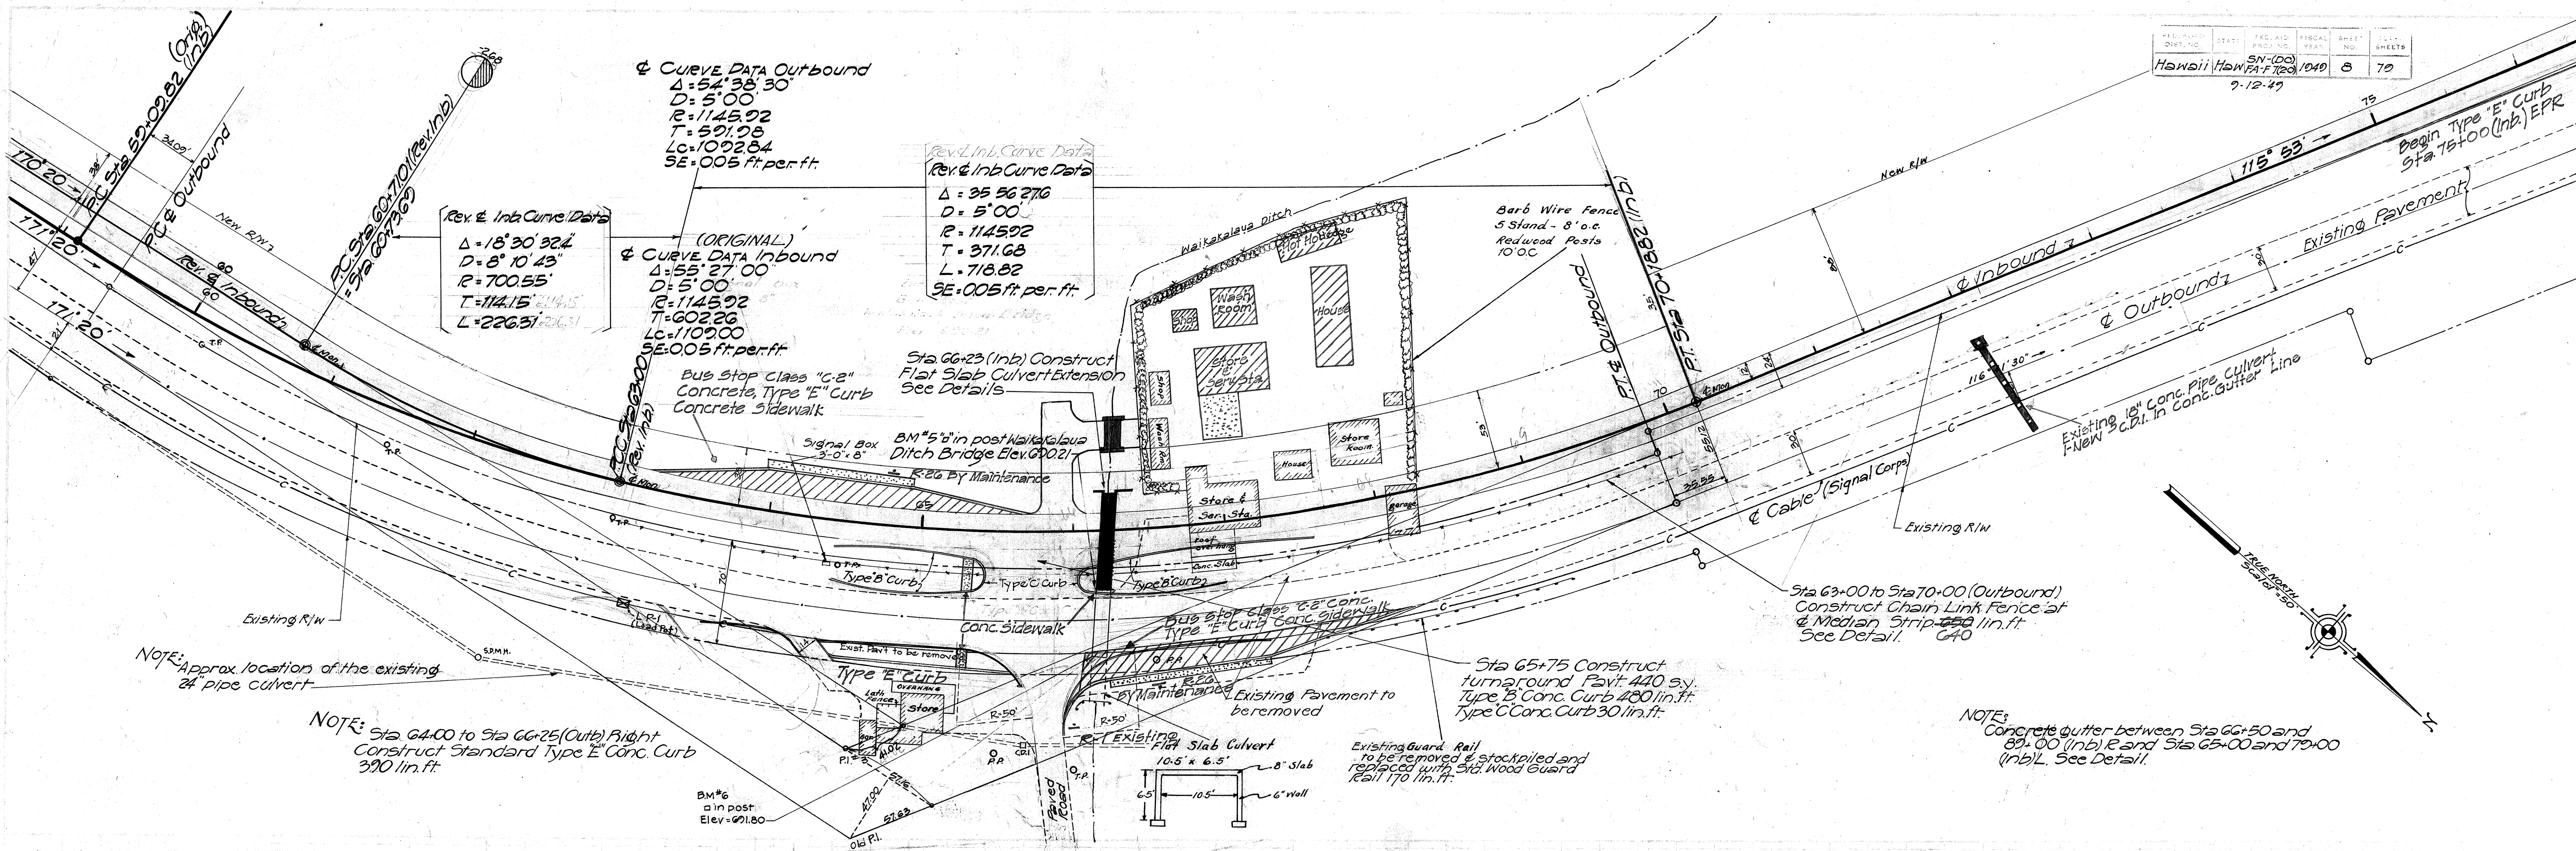

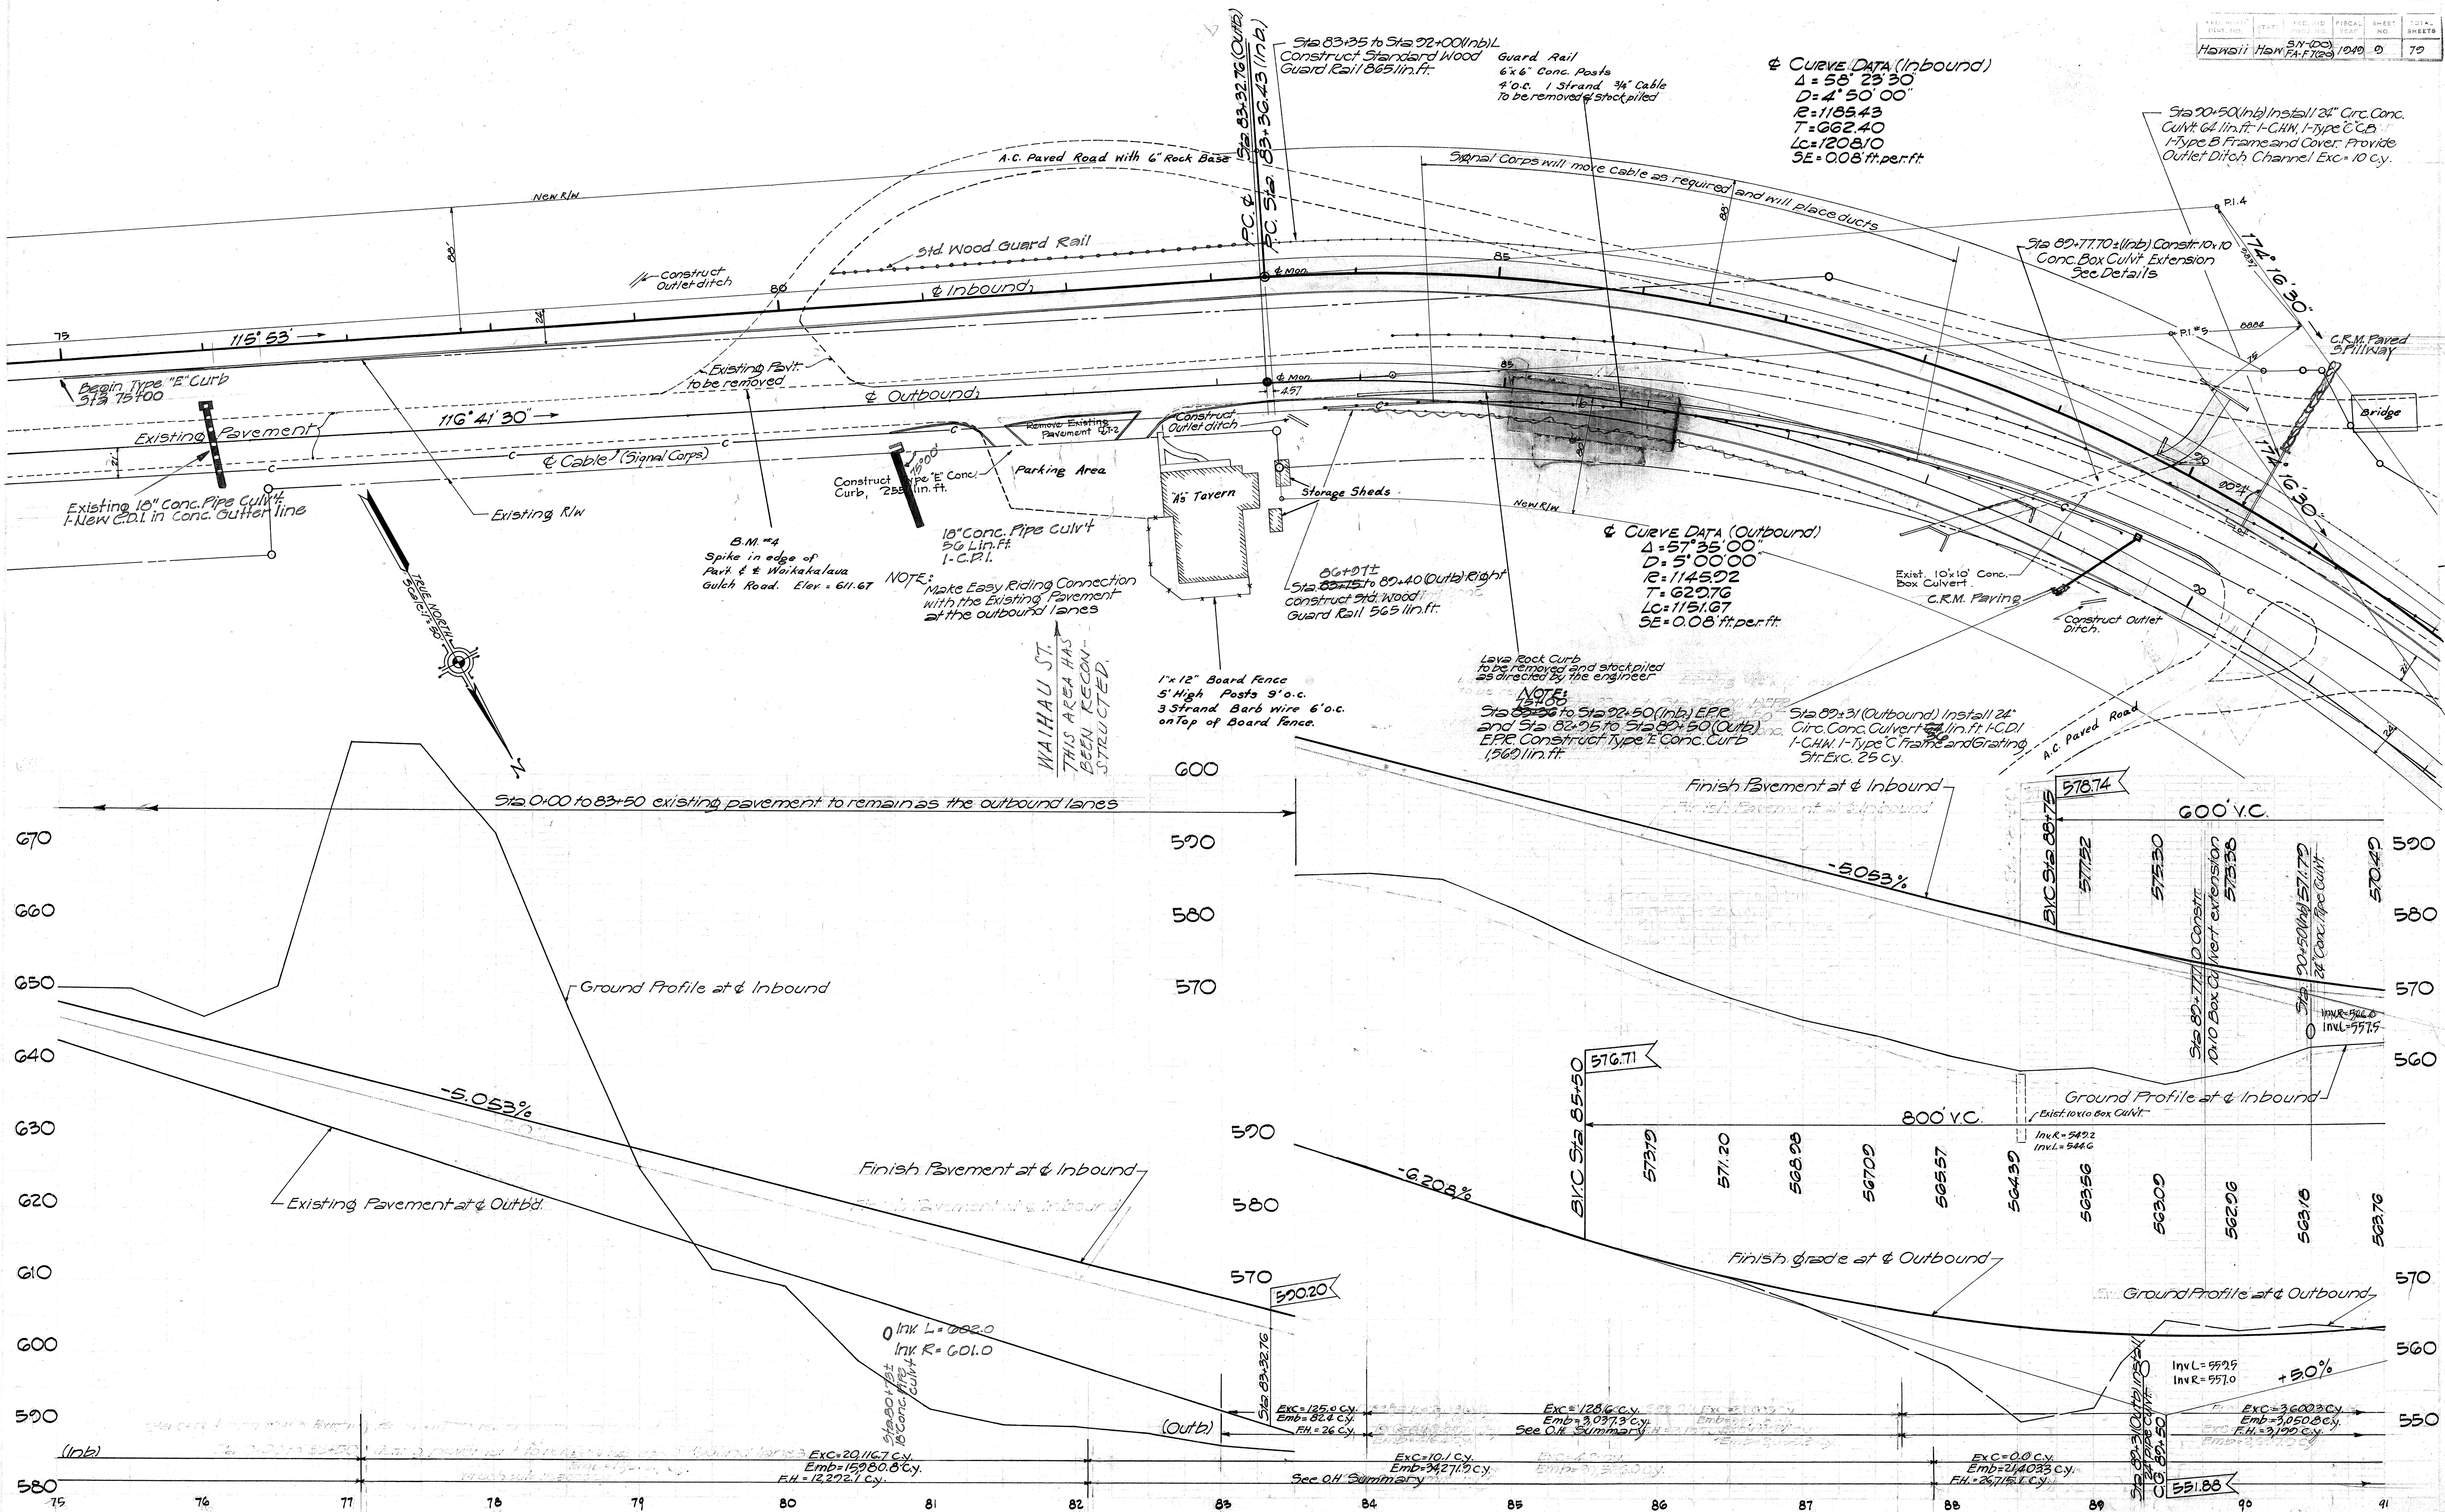

53 \$ 2.9

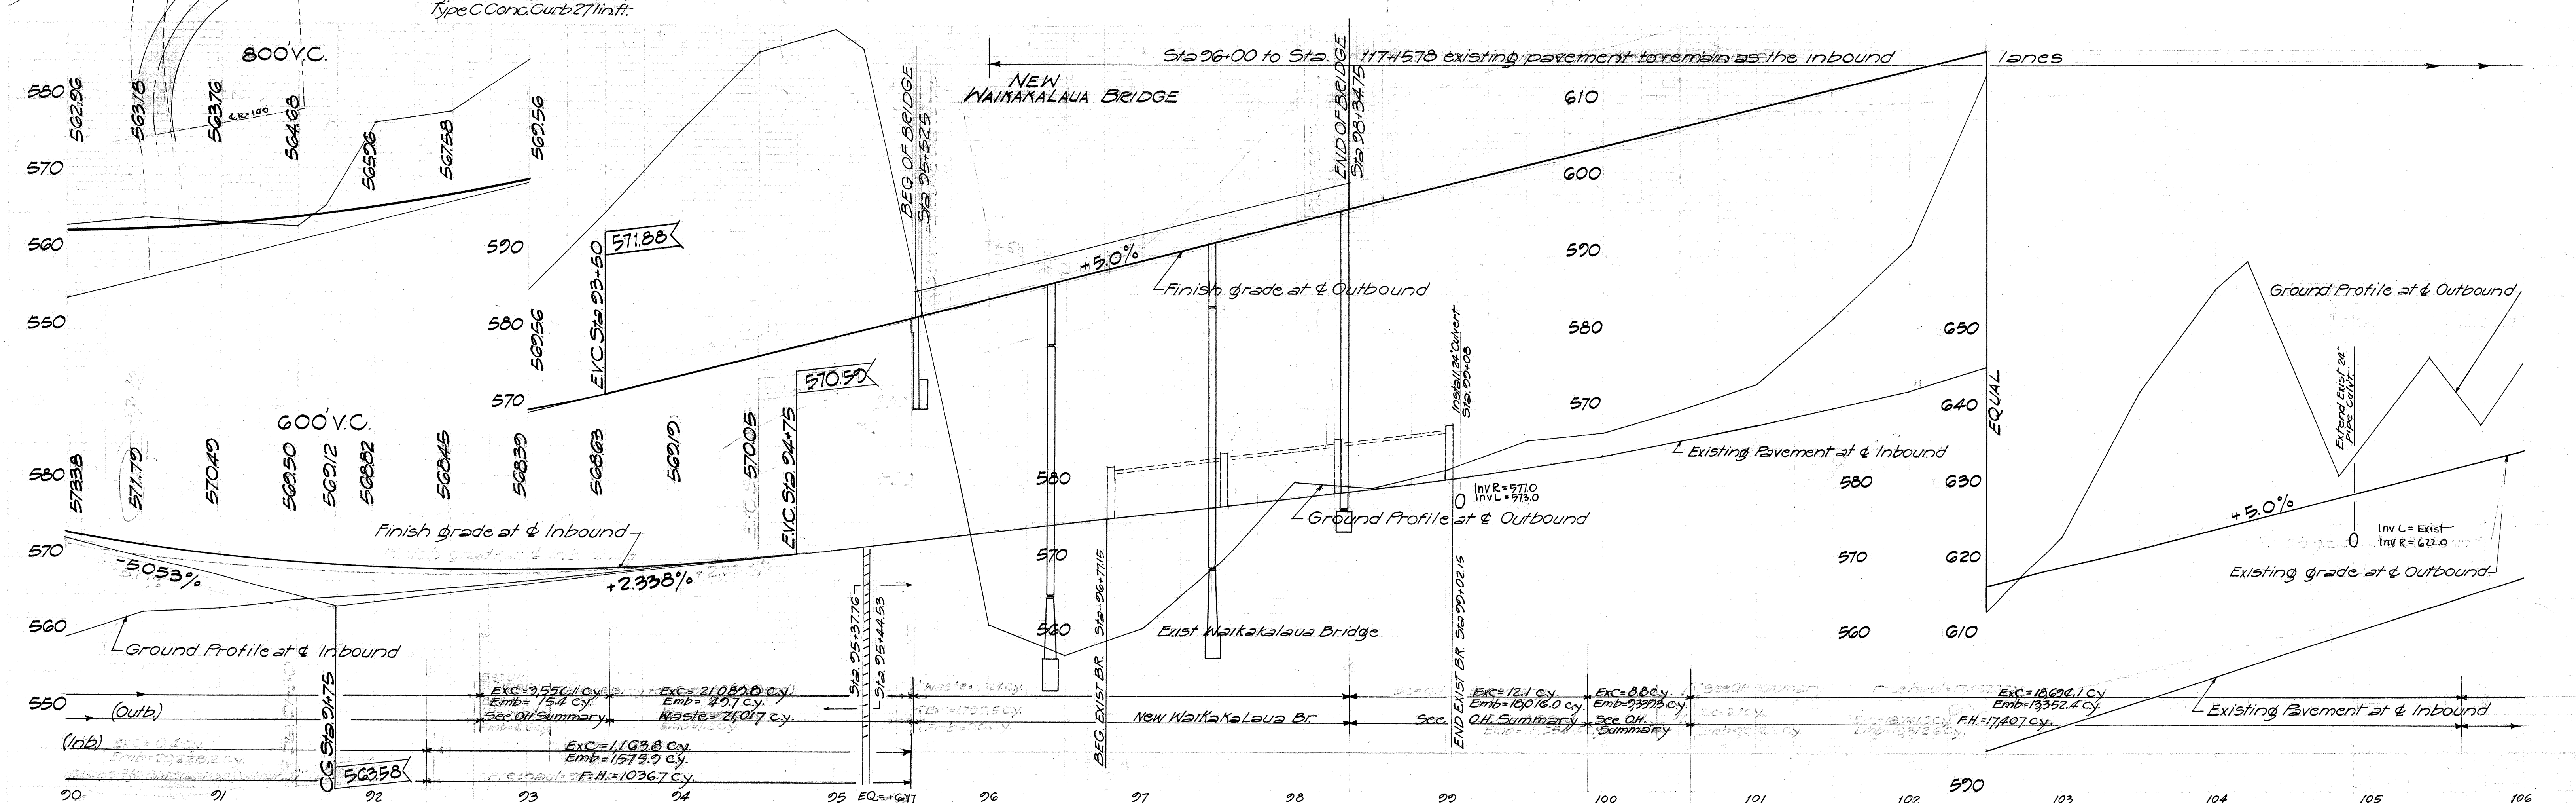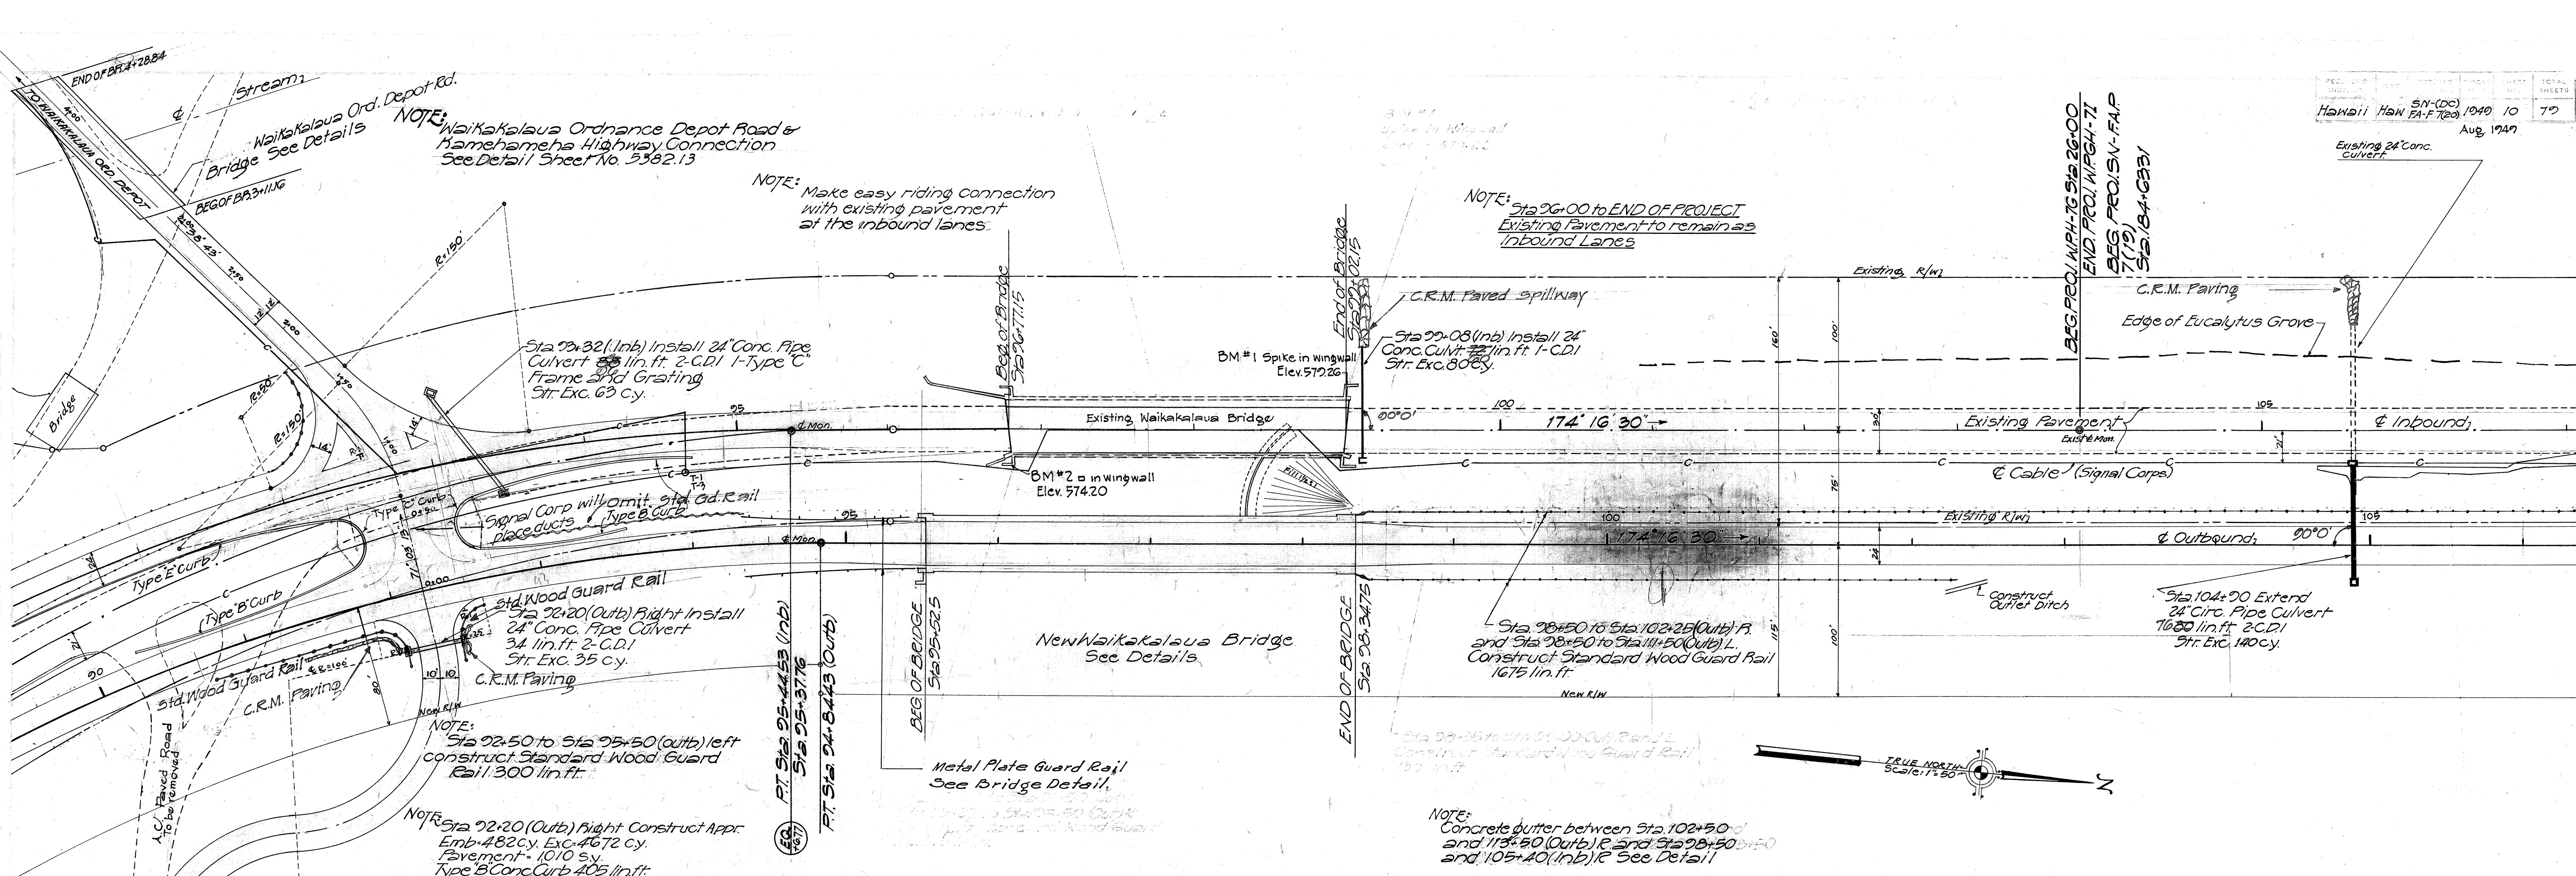

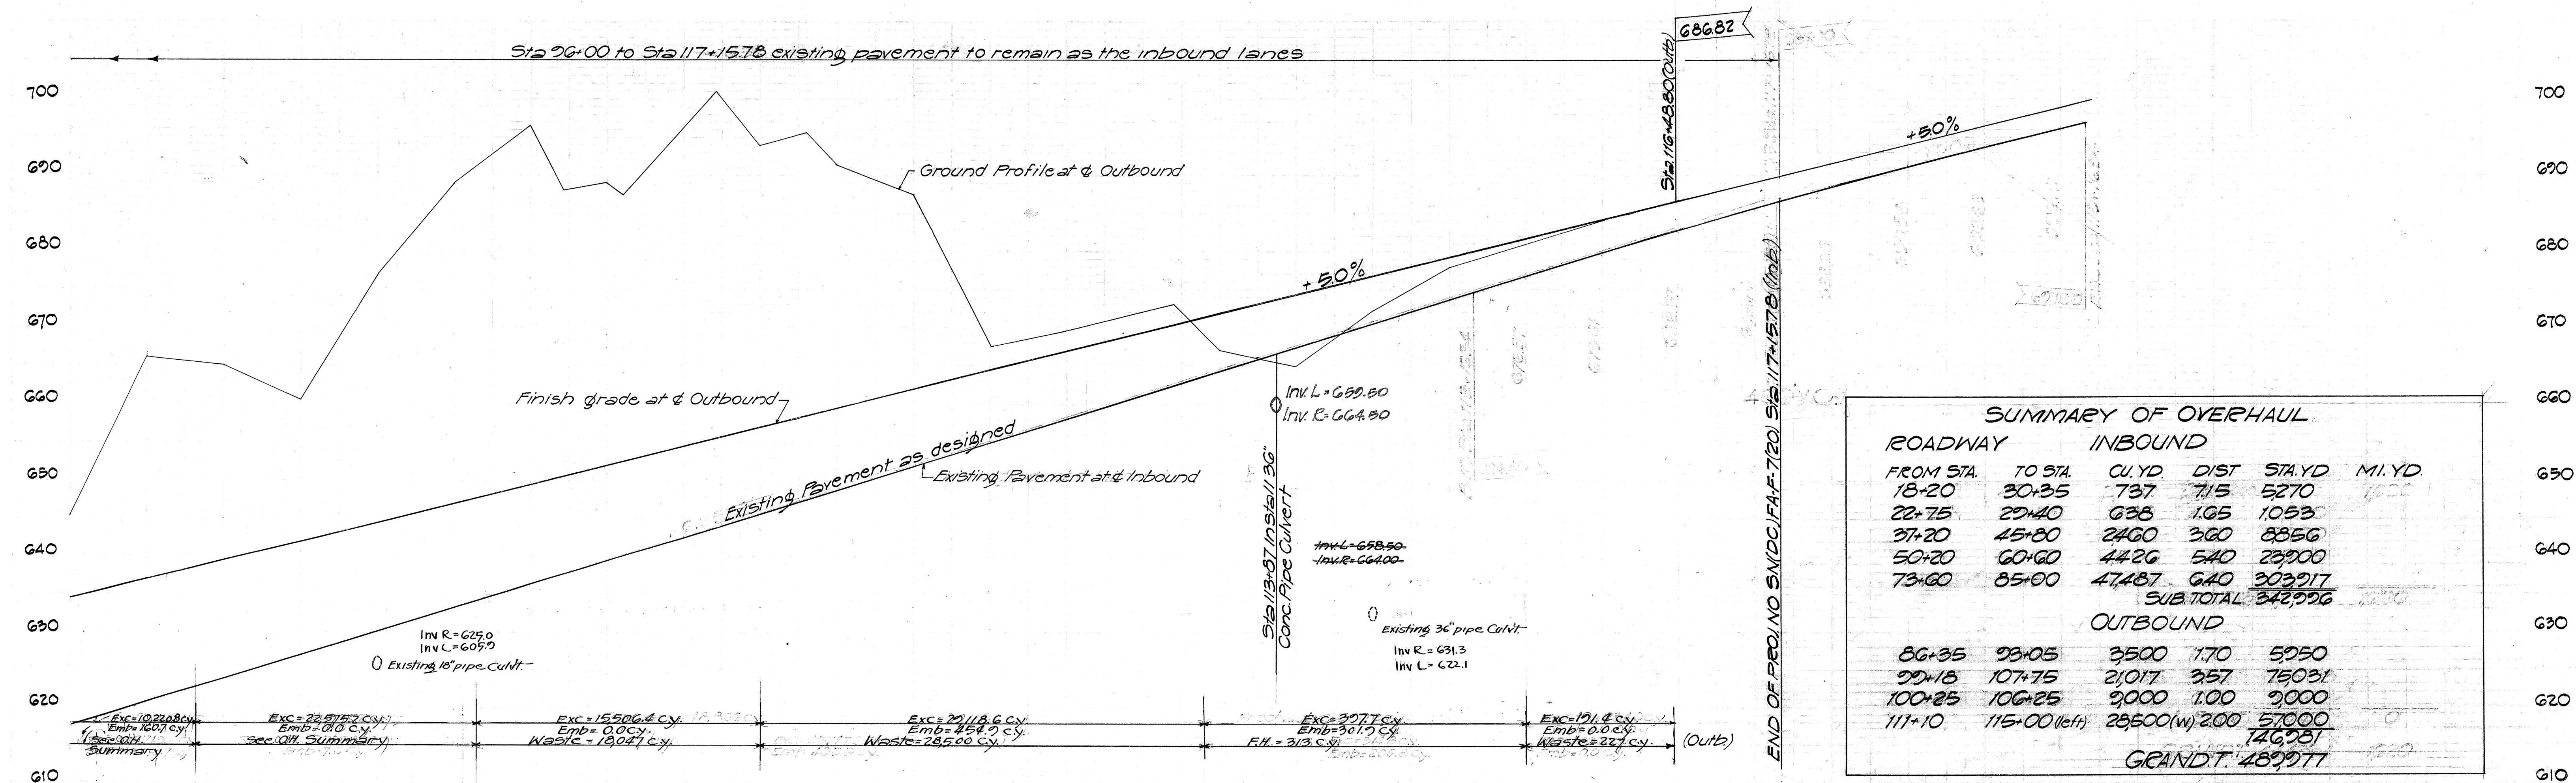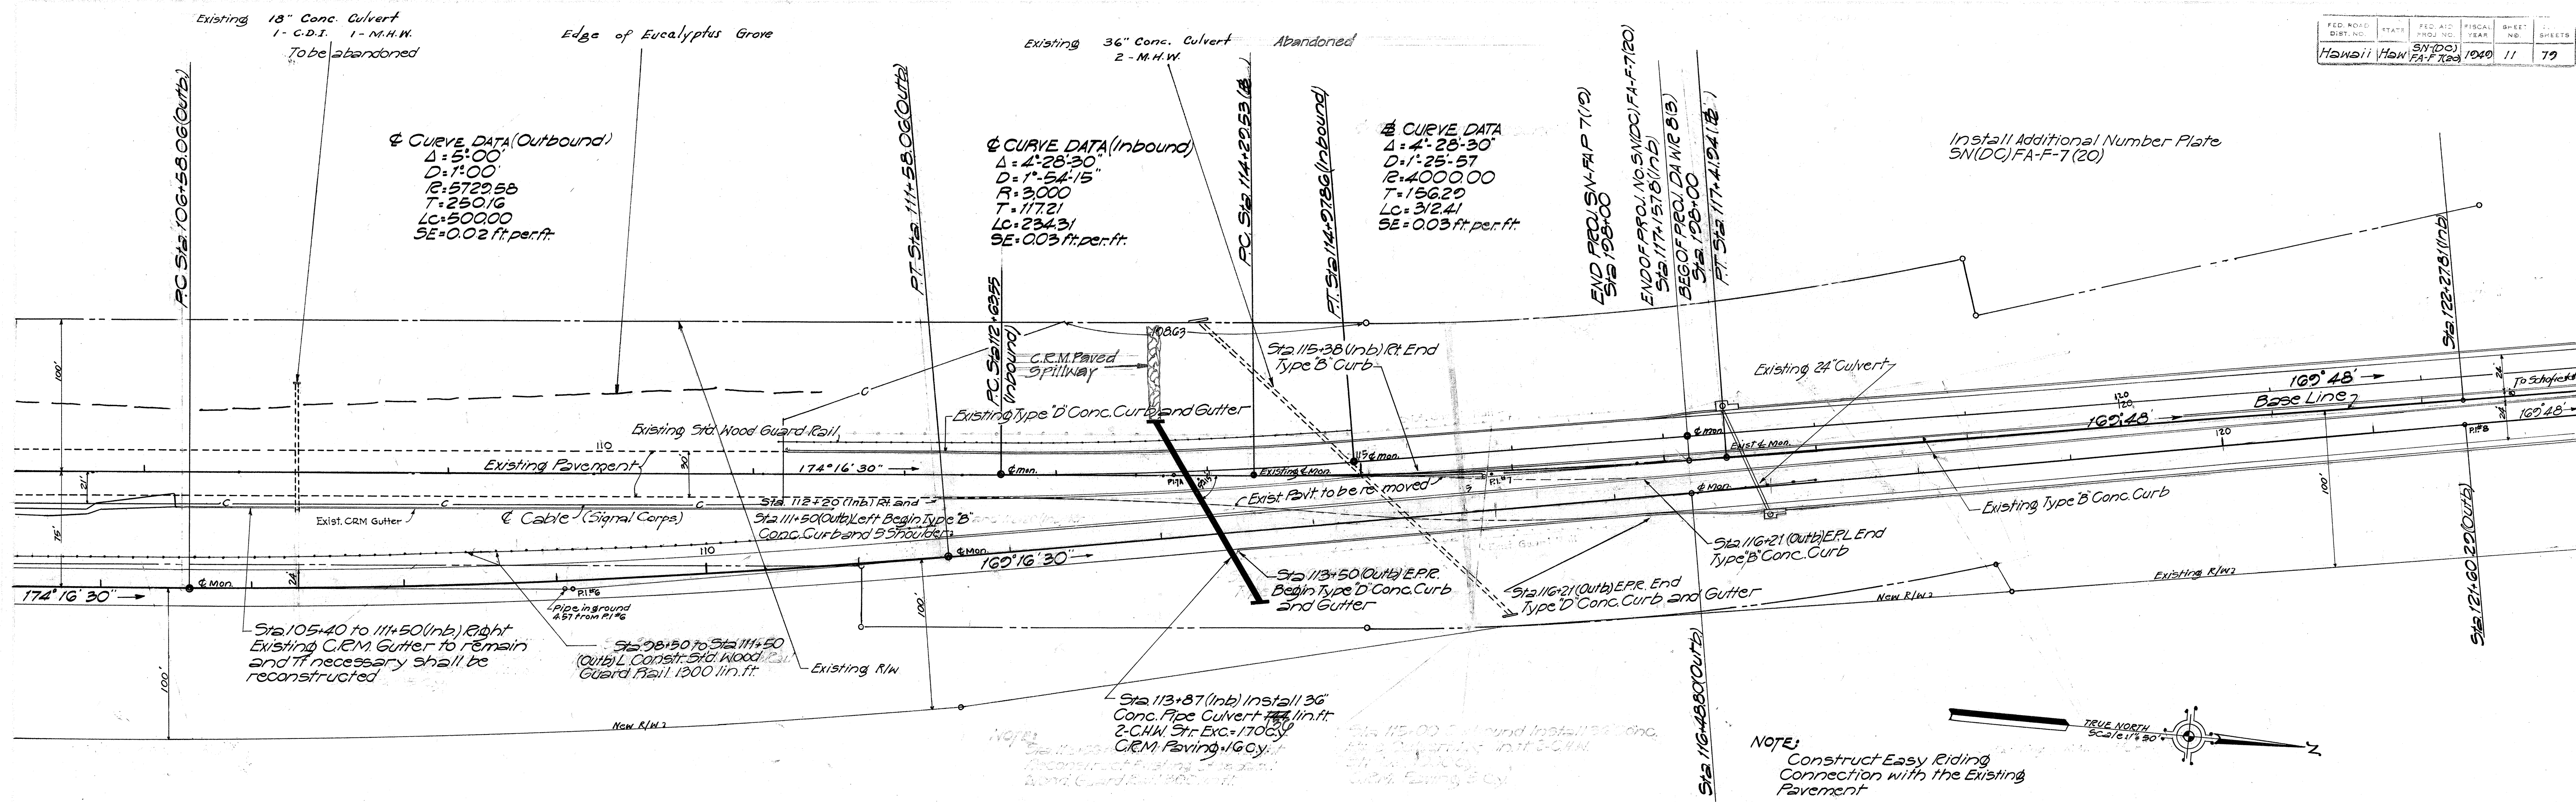

SUMMARY OF OVERHAUL					
ROADWAY		INBOUND			
FROM STA.	TO STA.	CU. YD.	DIST	STA. YD.	MI. YD.
18+20	30+35	737	7.15	5270	10.00
22+75	29+40	628	1.05	1053	
37+20	45+80	2460	3.60	8856	
50+20	60+60	4426	5.40	23900	
73+60	85+00	47487	6.40	303917	
SUB. TOTAL				342,926	10.00
OUTBOUND					
86+35	93+05	3500	1.70	5250	
99+18	107+75	21017	3.57	75031	
100+25	106+25	3000	1.00	9000	
111+10	115+00 (left)	28500 (w)	2.00	57000	
				146,281	10.00
GRAND T.				489,207	

PLAN	SURVEYED	BY	DATE
	NOTED		
	NOTED		
	NOTED		

PROFILE	SURVEYED	BY	DATE
	NOTED		
	NOTED		
	NOTED		

FED. ROAD DIST. NO.	STATE	FED. AID PROJ. NO.	FISCAL YEAR	SHEET NO.	TOTAL SHEETS
164	PA	100	1040	12	70

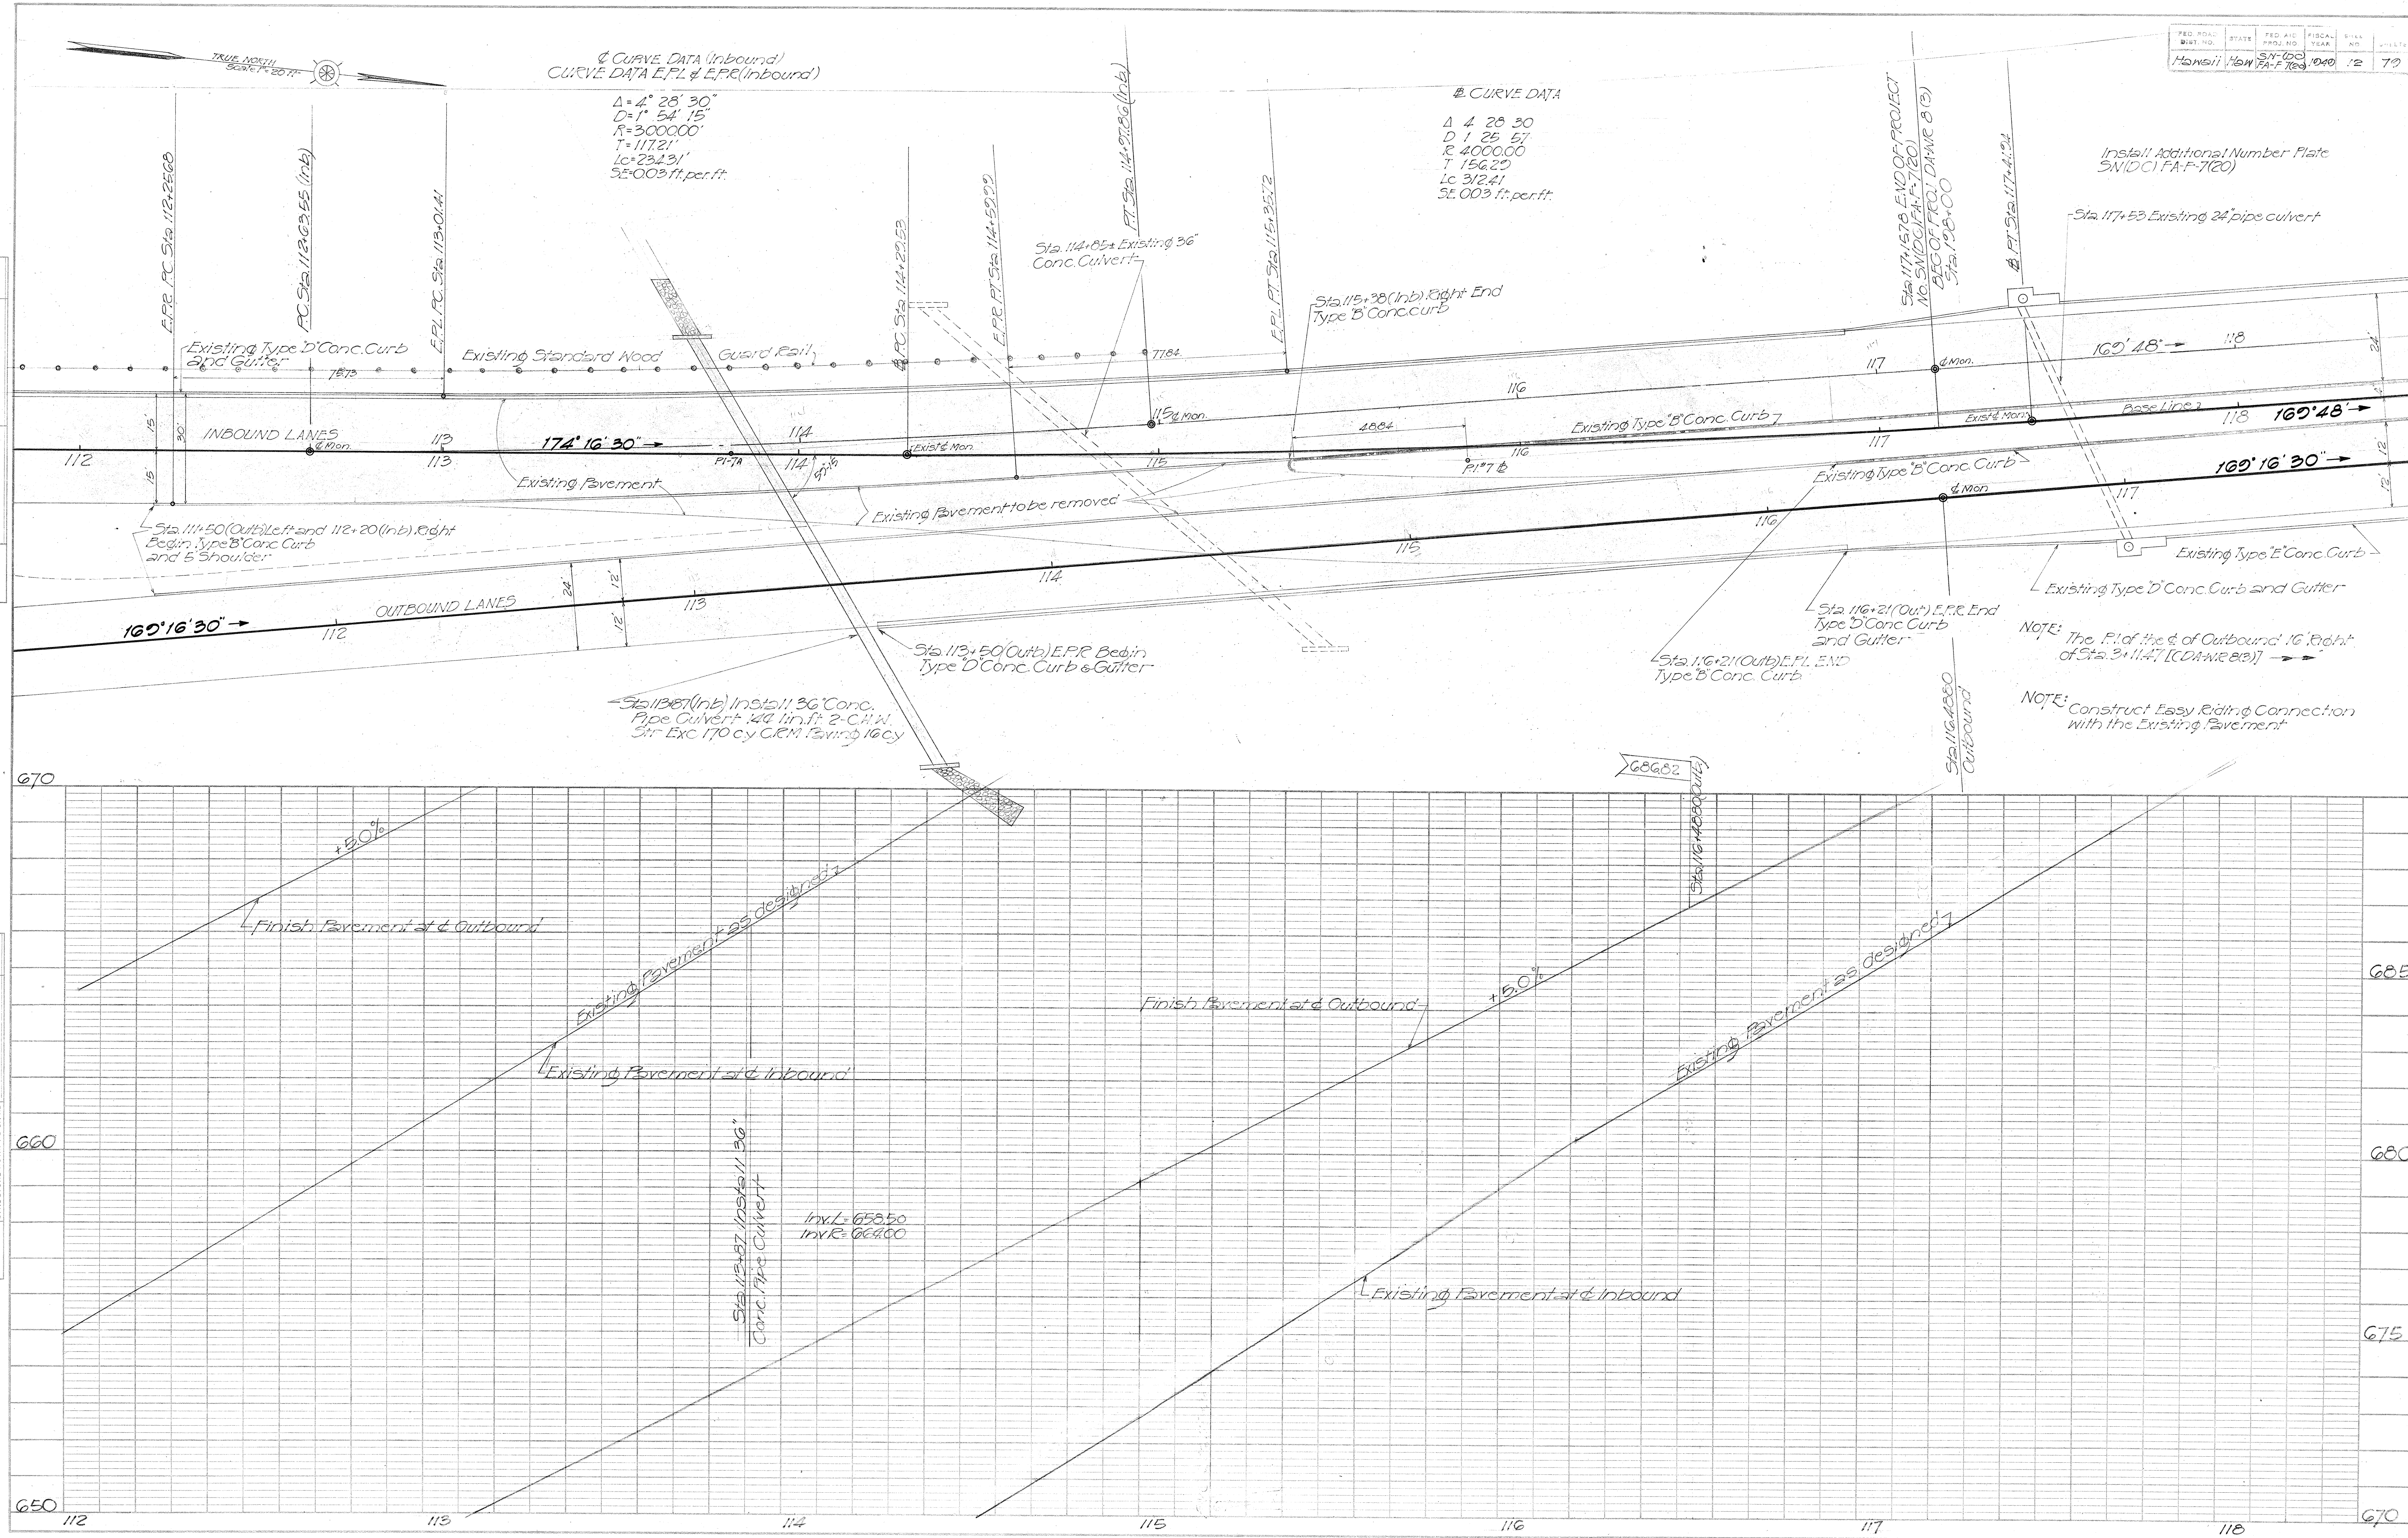


PLATE 1 - PLAN - PROFILE OF P.R. & S. STANDARD
 REUPPEL & ESSER CO. NEW YORK

5382.12