



INDEX TO DRAWINGS		INDEX TO DRAWINGS	
SHEET NO.	DESCRIPTION	SHEETNO	DESCRIPTION
1	TITLE SHEET	28-35	WAIKAKALAUA BRIDGE
2-3	TYPICAL SECTIONS	36-42	WAIKAKALAUA ORD DEPOT RD BR
4-12	PLAN & PROFILE	43-70	CROSS SECTIONS
13-14	WAIKAKALAUA ORD DEPOT ROAD		
15-20A	STANDARD DETAILS		
21	SYPHON DETAILS		
22-24	BOX CULVERT DETAILS		
25	WAIKAKALAUA STR. RELOCATION		
26	WASTE DISPOSAL AREA		
27	STANDARD BR. DETAILS		

TERRITORY OF HAWAII
TERRITORIAL HIGHWAY DEPARTMENT
HONOLULU, OAHU, T. H.


PLANS OF
KAMEHAMEHA HIGHWAY
WAIKAKALAU SECTION
FEDERAL AID PROJECT NO. SN(DC) FA-F 7(20)
DISTRICT OF EWA
ISLAND OF OAHU

SCALE

PLAN 1 INCH = 50 FEET
 PROFILE HOR. 1 INCH = 50 FEET
 VERT. 1 INCH = 10 FEET
 CROSS SECTION 1 INCH = 10 FEET

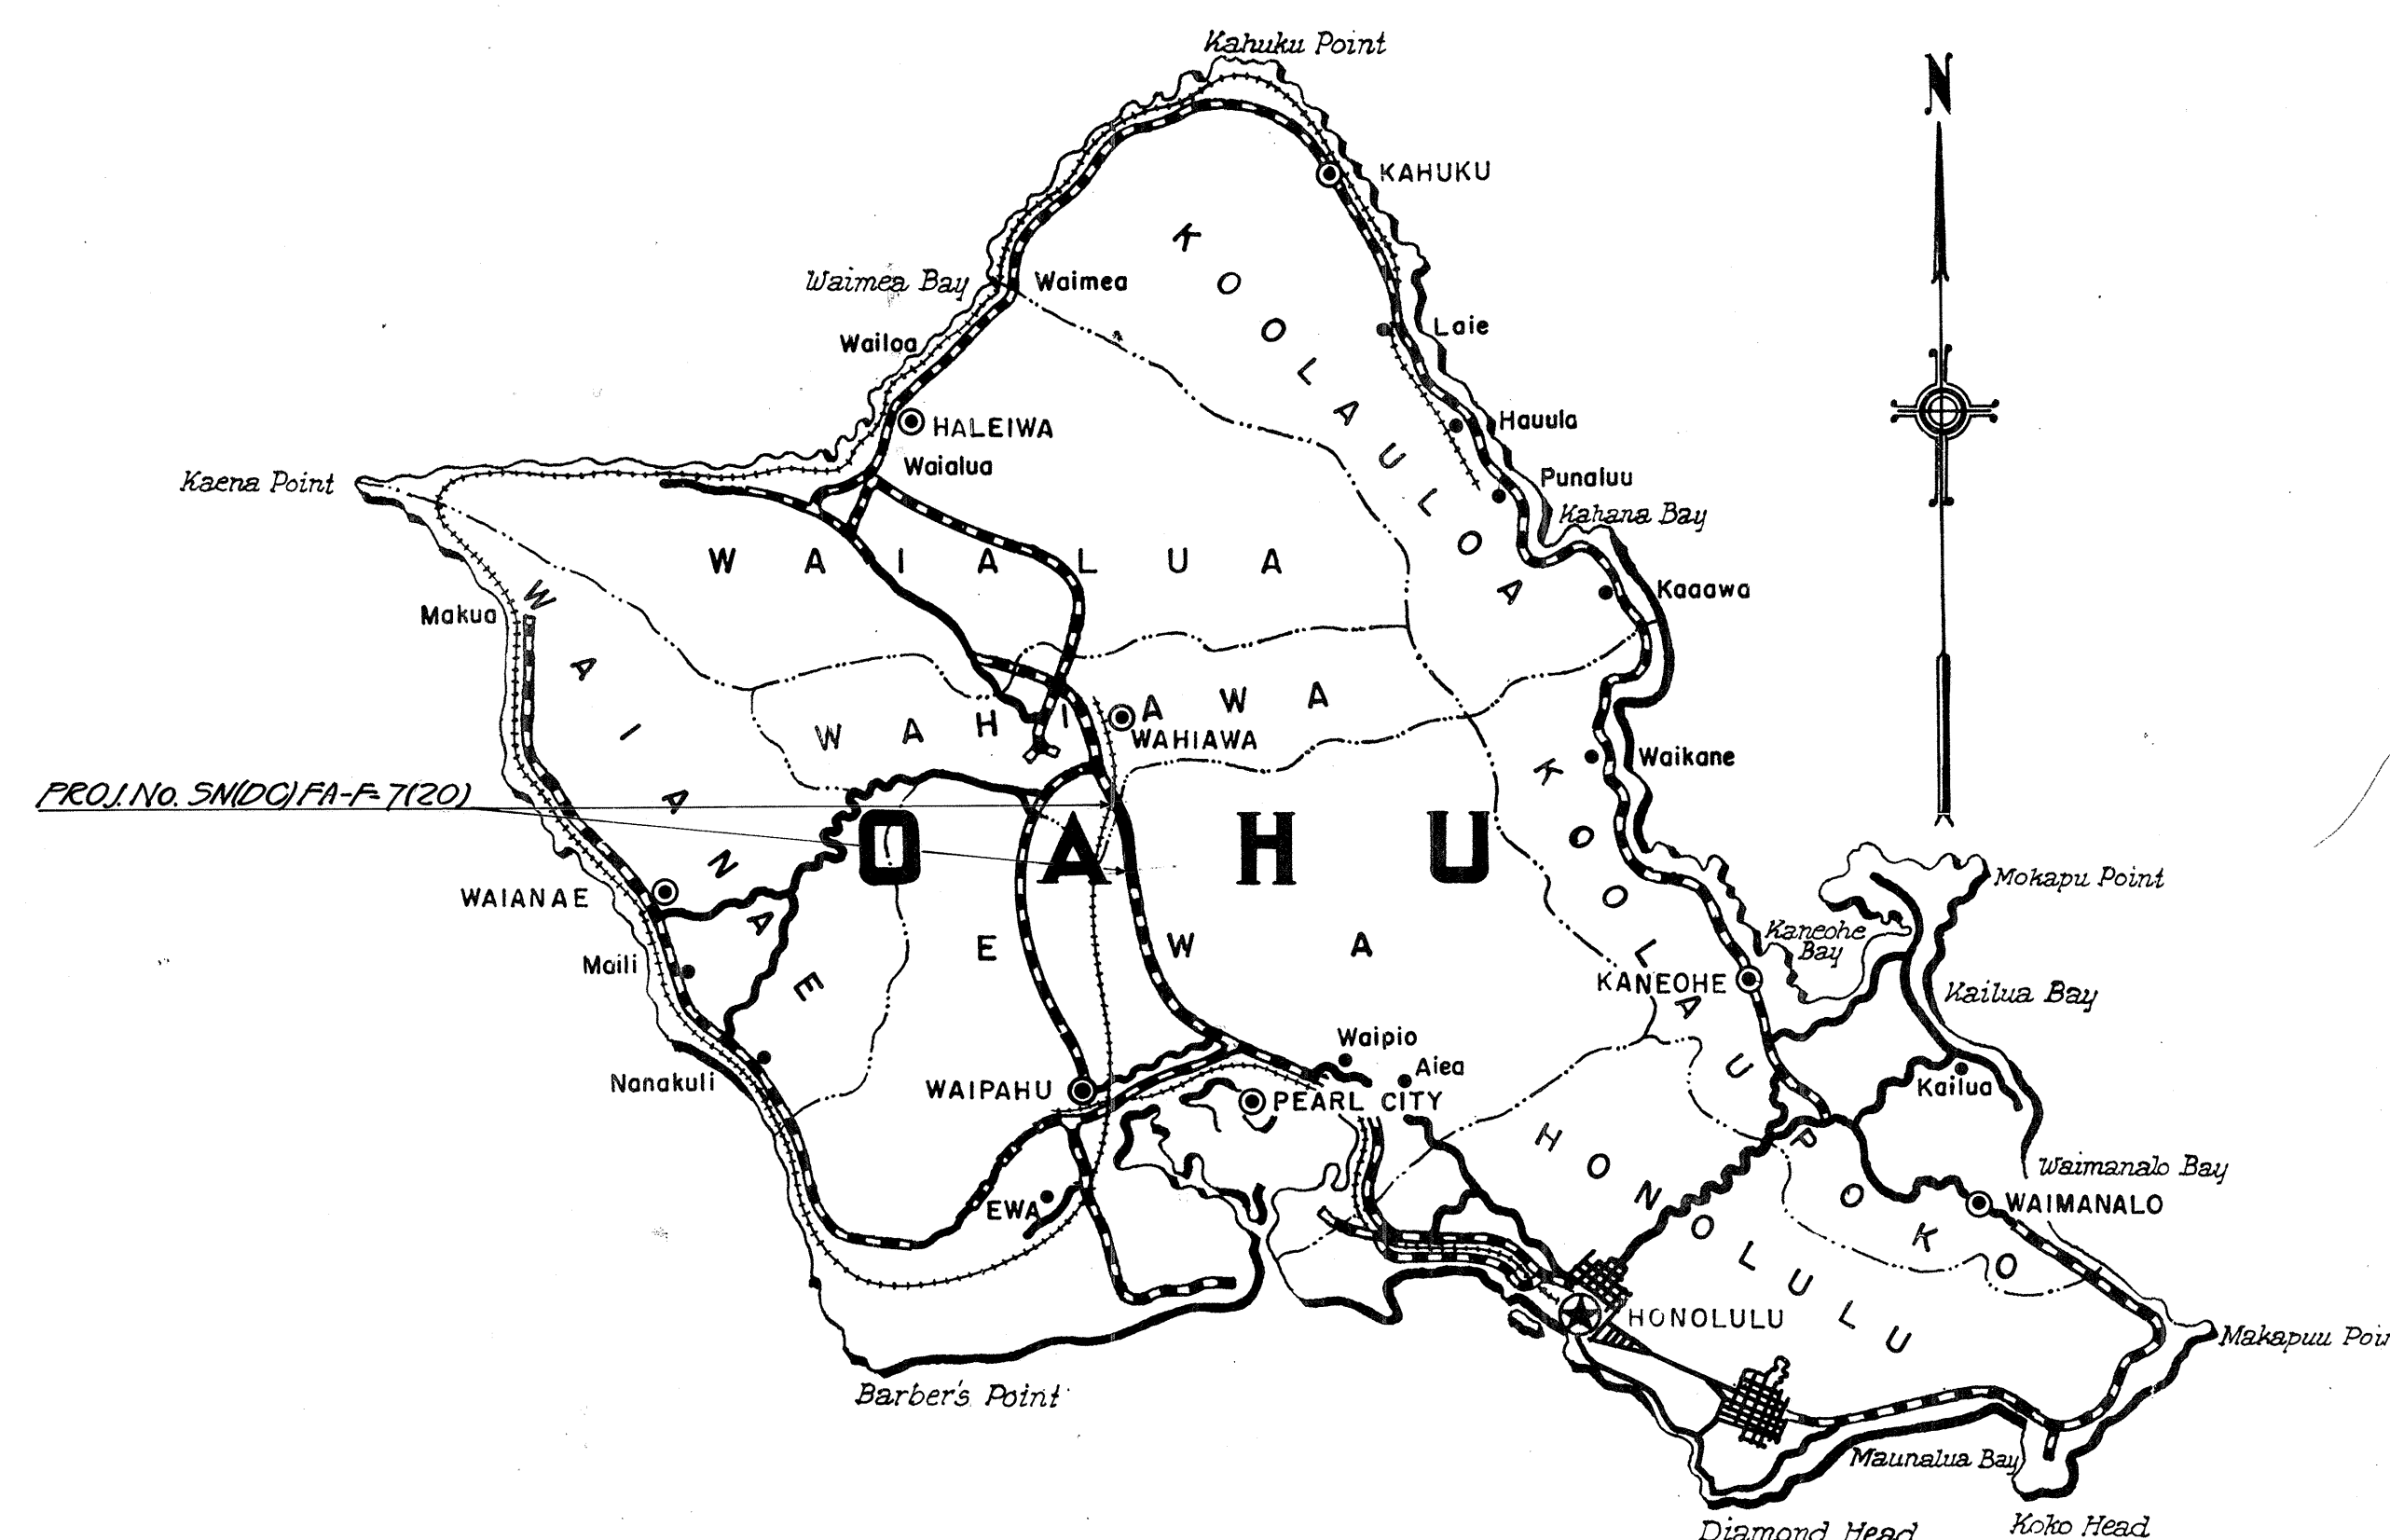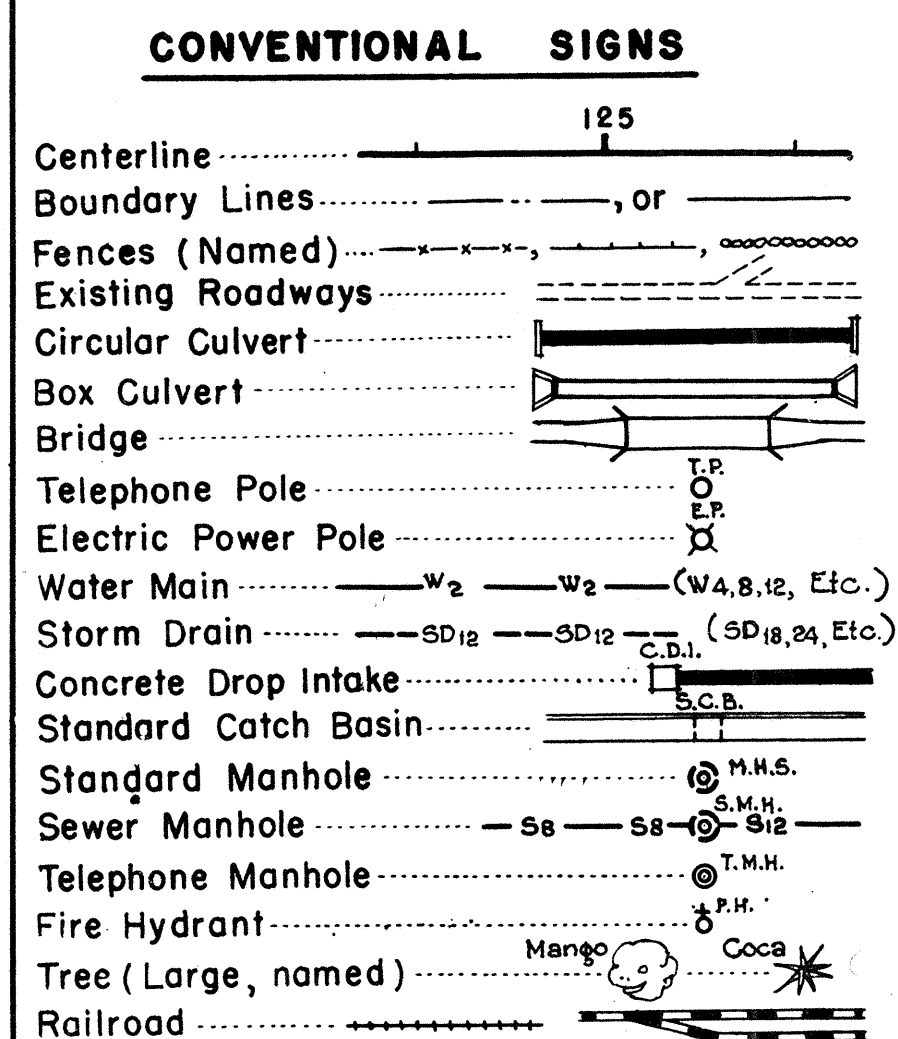

Federal Aid Projects Previously Constructed Or Under Construction

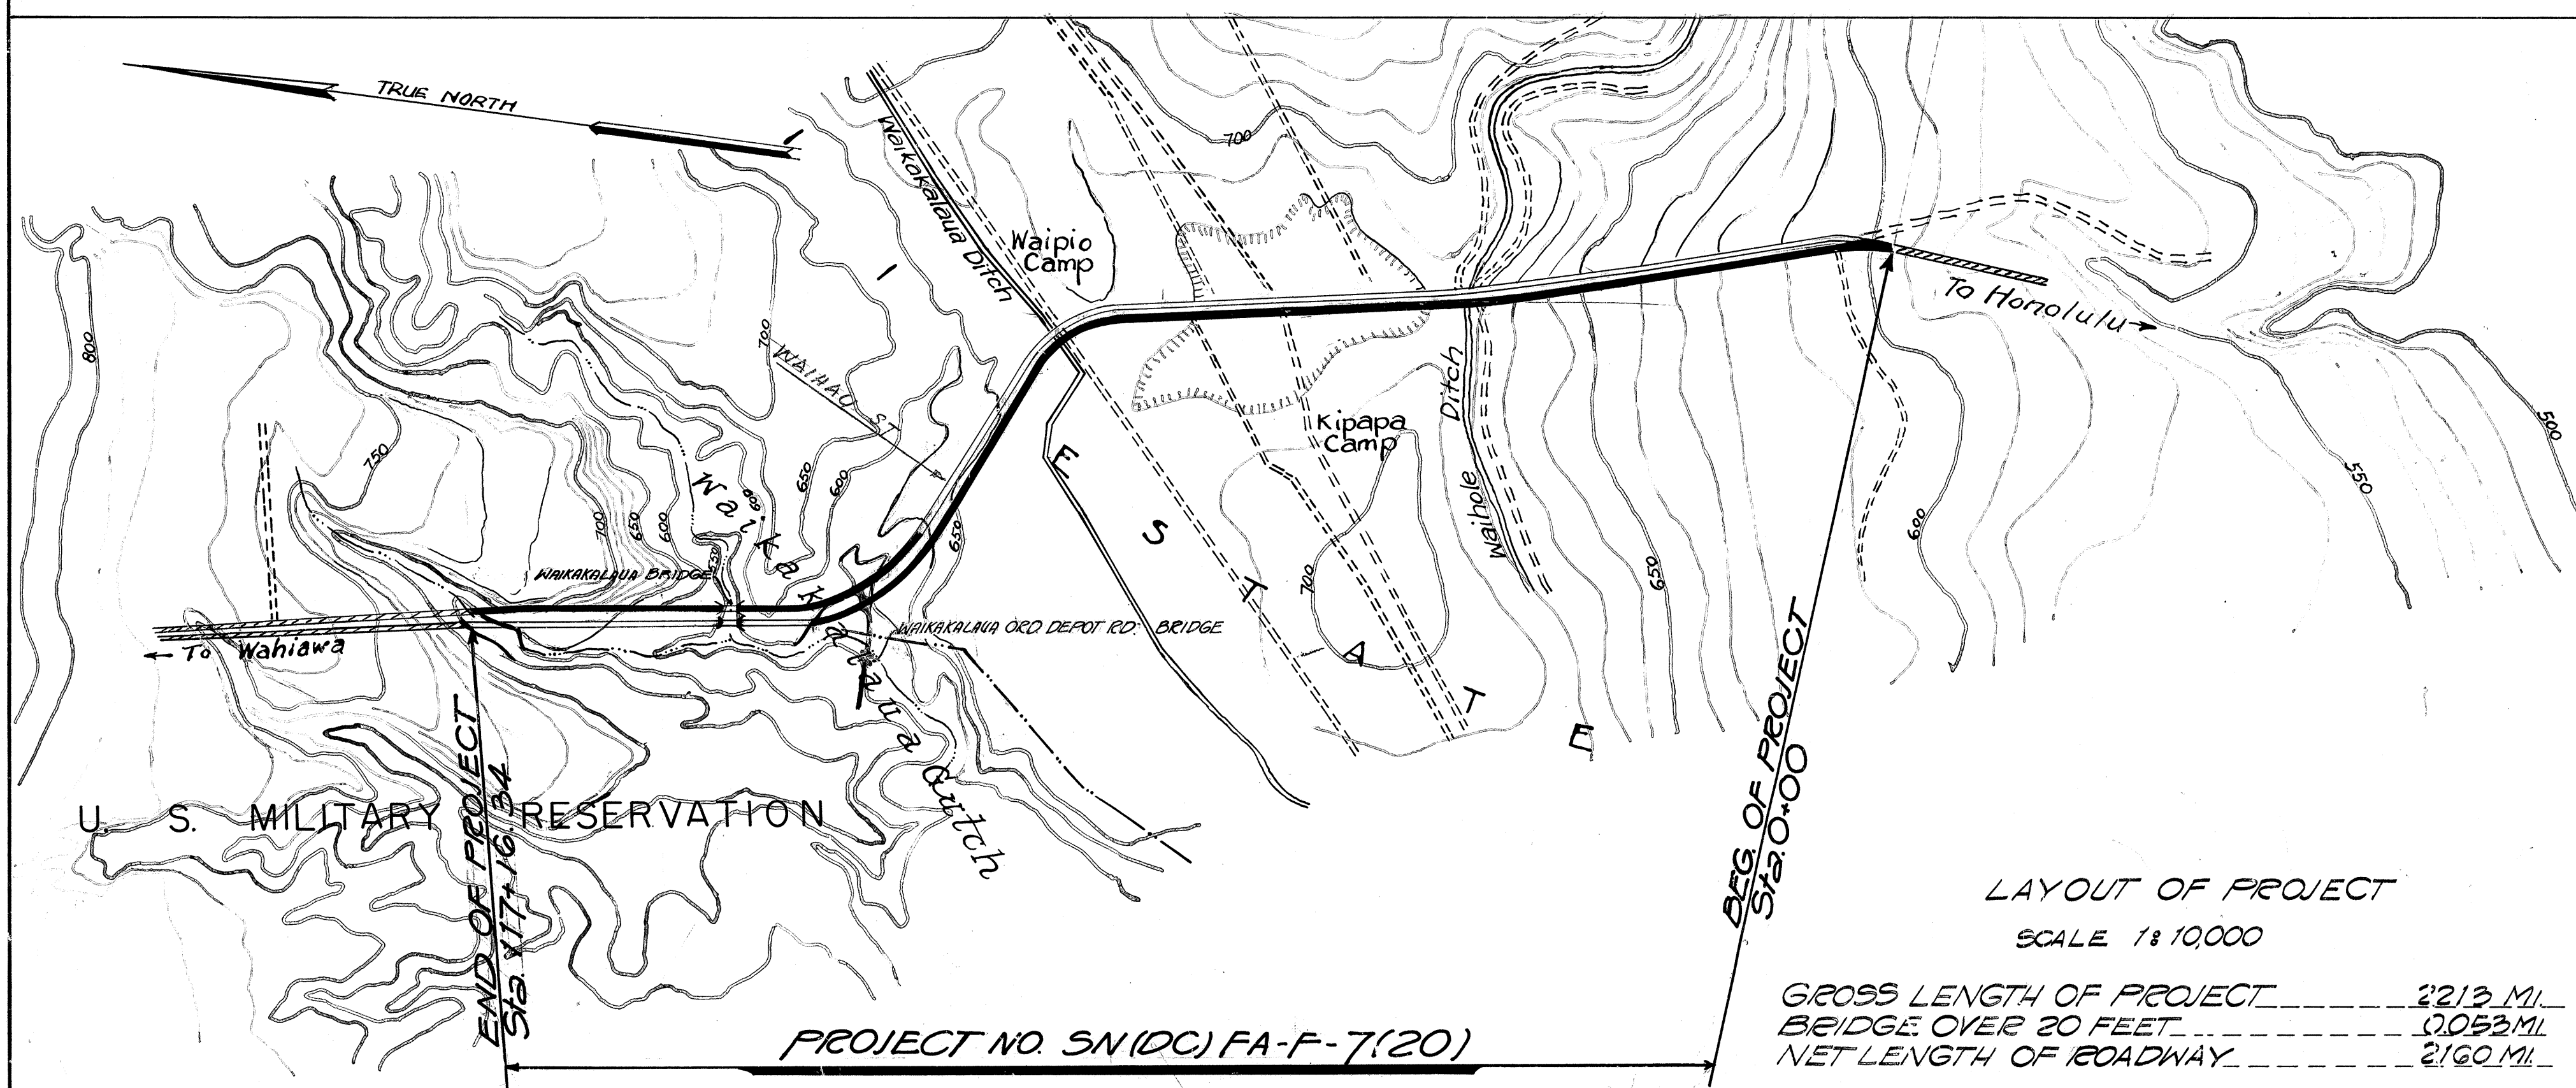

NOTE:

ALL CHANGES MADE DURING
CONSTRUCTION HAVE BEEN NOTED
IN THESE TRACINGS IN RED AND
CHECKED BY:

Howard P. Krumo
RESIDENT ENGINEER
DATE 8/16/50

RECOMMENDED FOR APPROVAL DATE. [REDACTED]

DISTRICT ENGINEER
PUBLIC ROADS ADMINISTRATION
FEDERAL WORKS AGENCY

APPROVED _____ DATE _____

DIVISION ENGINEER
PUBLIC ROADS ADMINISTRATION
FEDERAL WORKS AGENCY

APPROVED

DATE 6-17-49

TERRITORIAL HIGHWAY ENGINEER

5382.1