
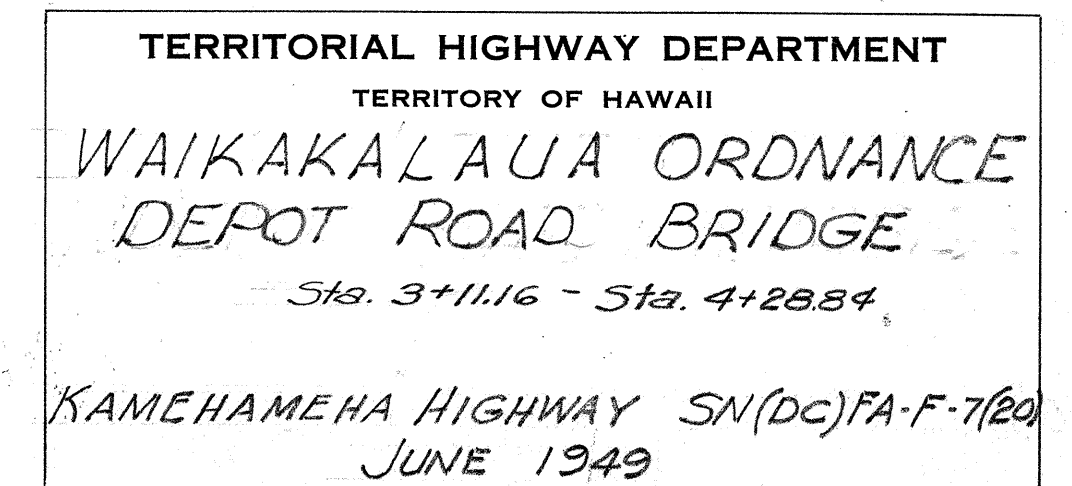
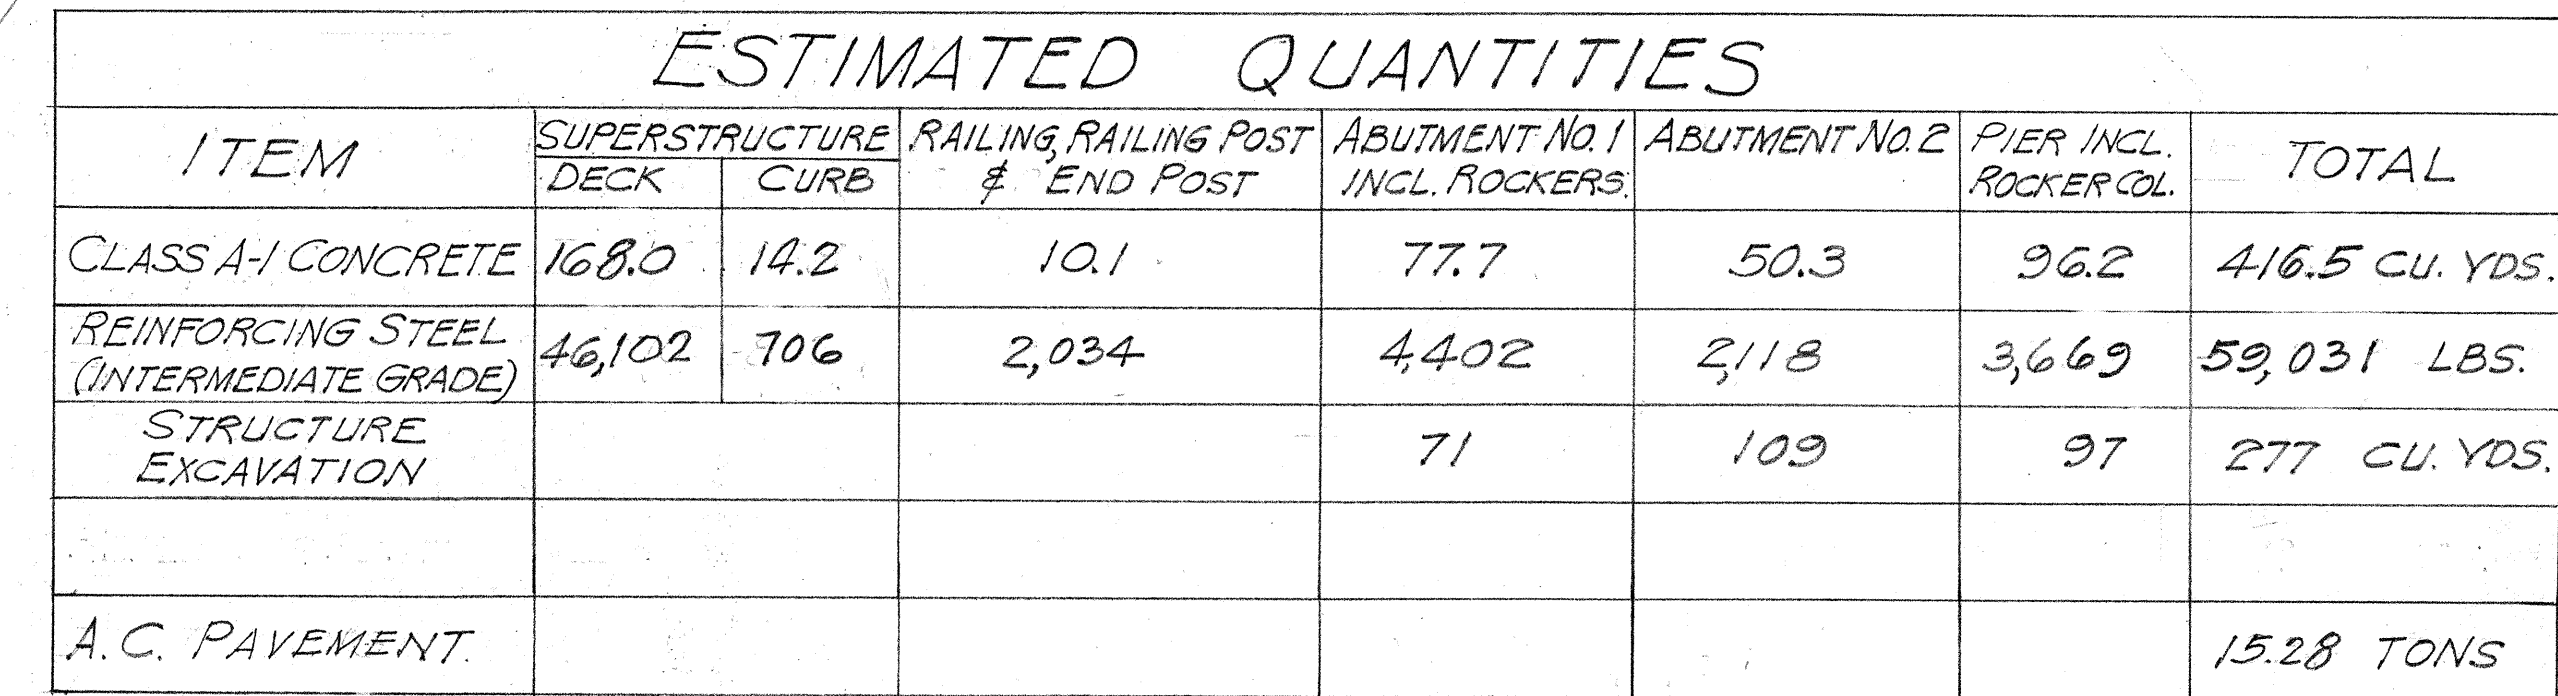


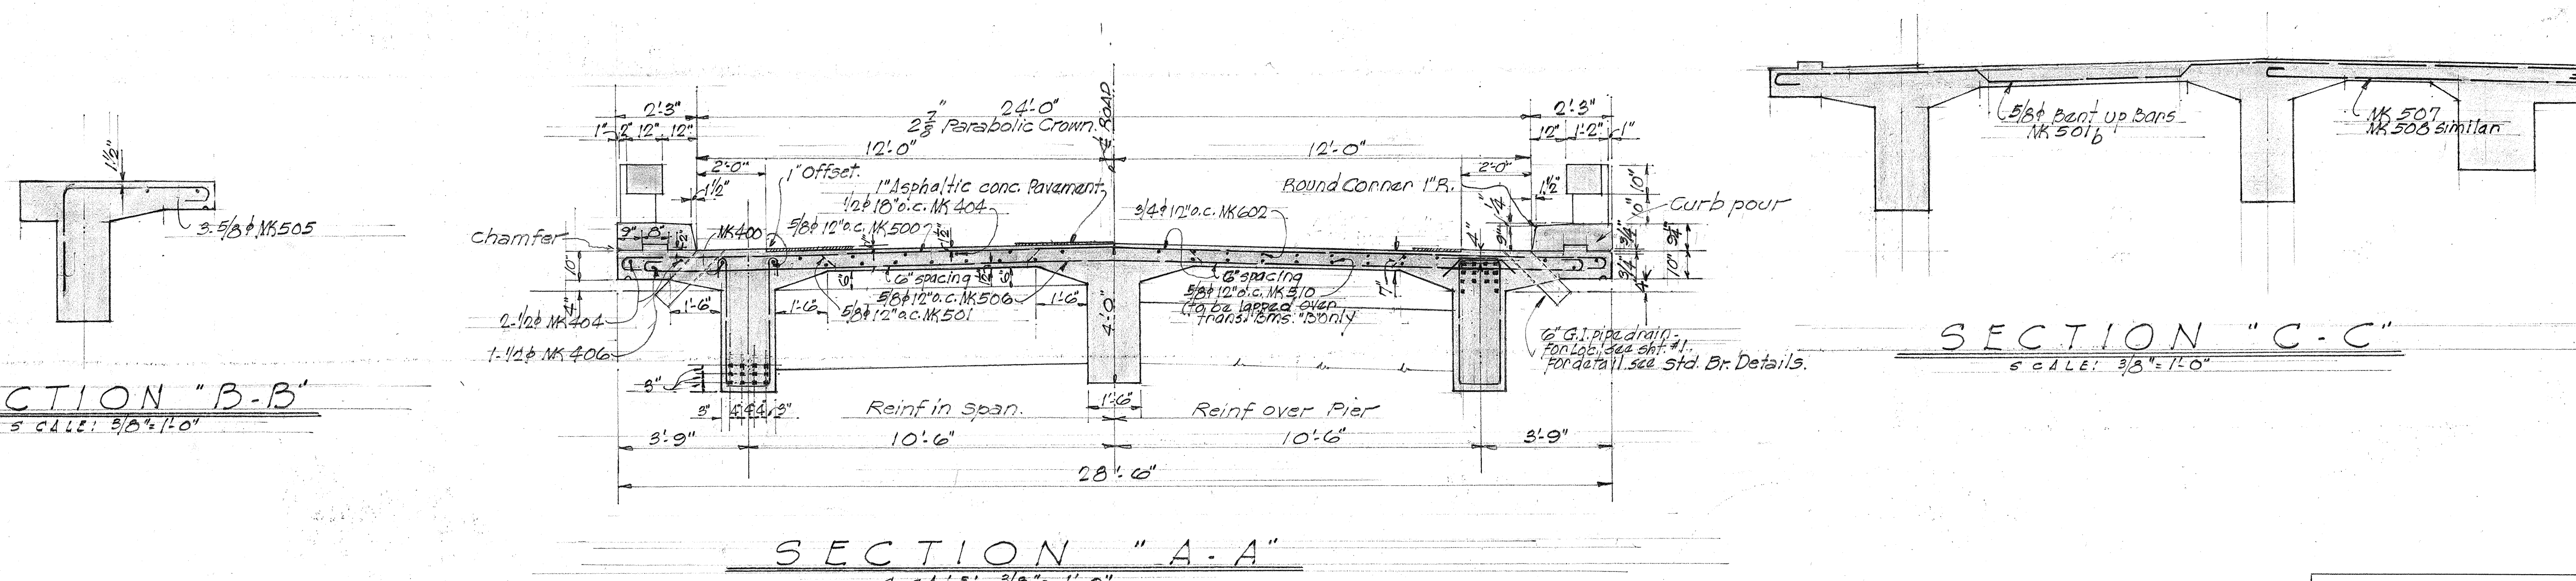


[illegible]

SHEET No. 2 OF 7 SHEETS


5382.37

FED. ROAD DIST. NO.	STATE	FED. AID PROJ. NO.	FISCAL YEAR	SHEET NO.	TOTAL SHEETS
150-1151	HI	5-1700	1940	40	70

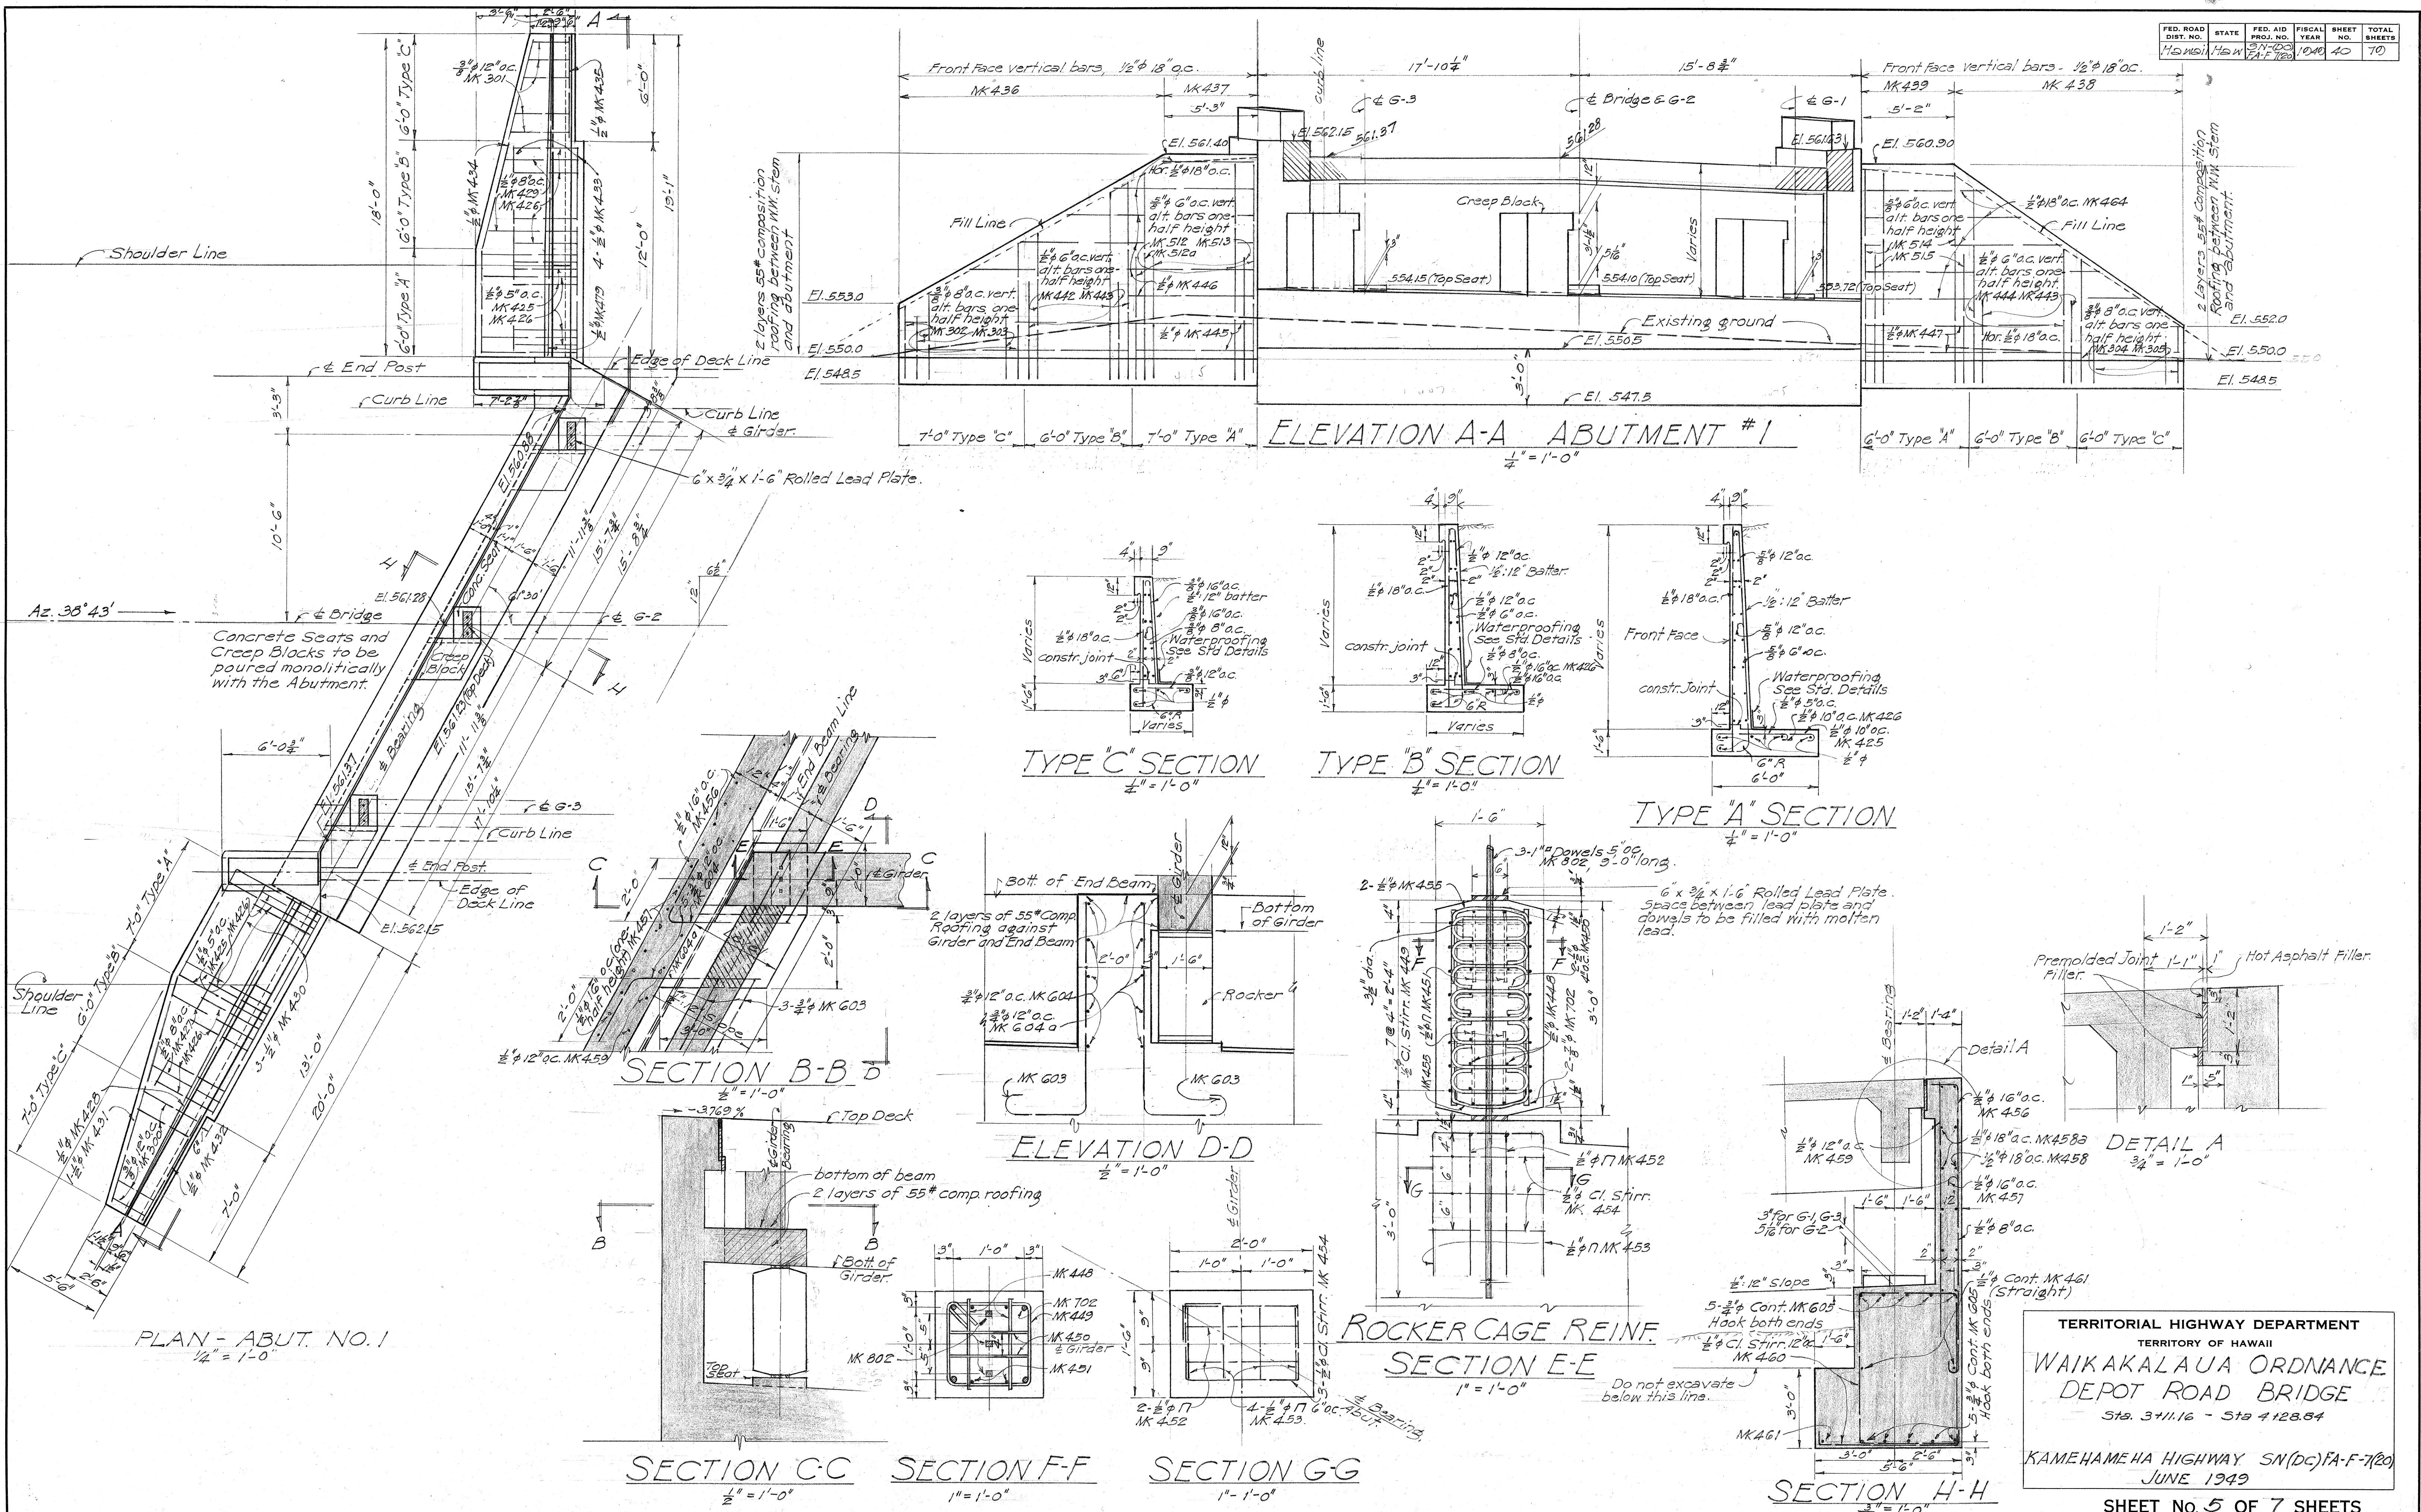


TERRITORIAL HIGHWAY DEPARTMENT
TERRITORY OF HAWAII
WAIKAKALAUA ORDNANCE
DEPOT ROAD BRIDGE
Sta. 3+11.16 - Sta. 4+28.84
KAMEHAMEHA HIGHWAY SN(DC)FA-F-7(20)
JUNE 1940


SHEET NO. 5 OF 7 SHEETS
5382.40

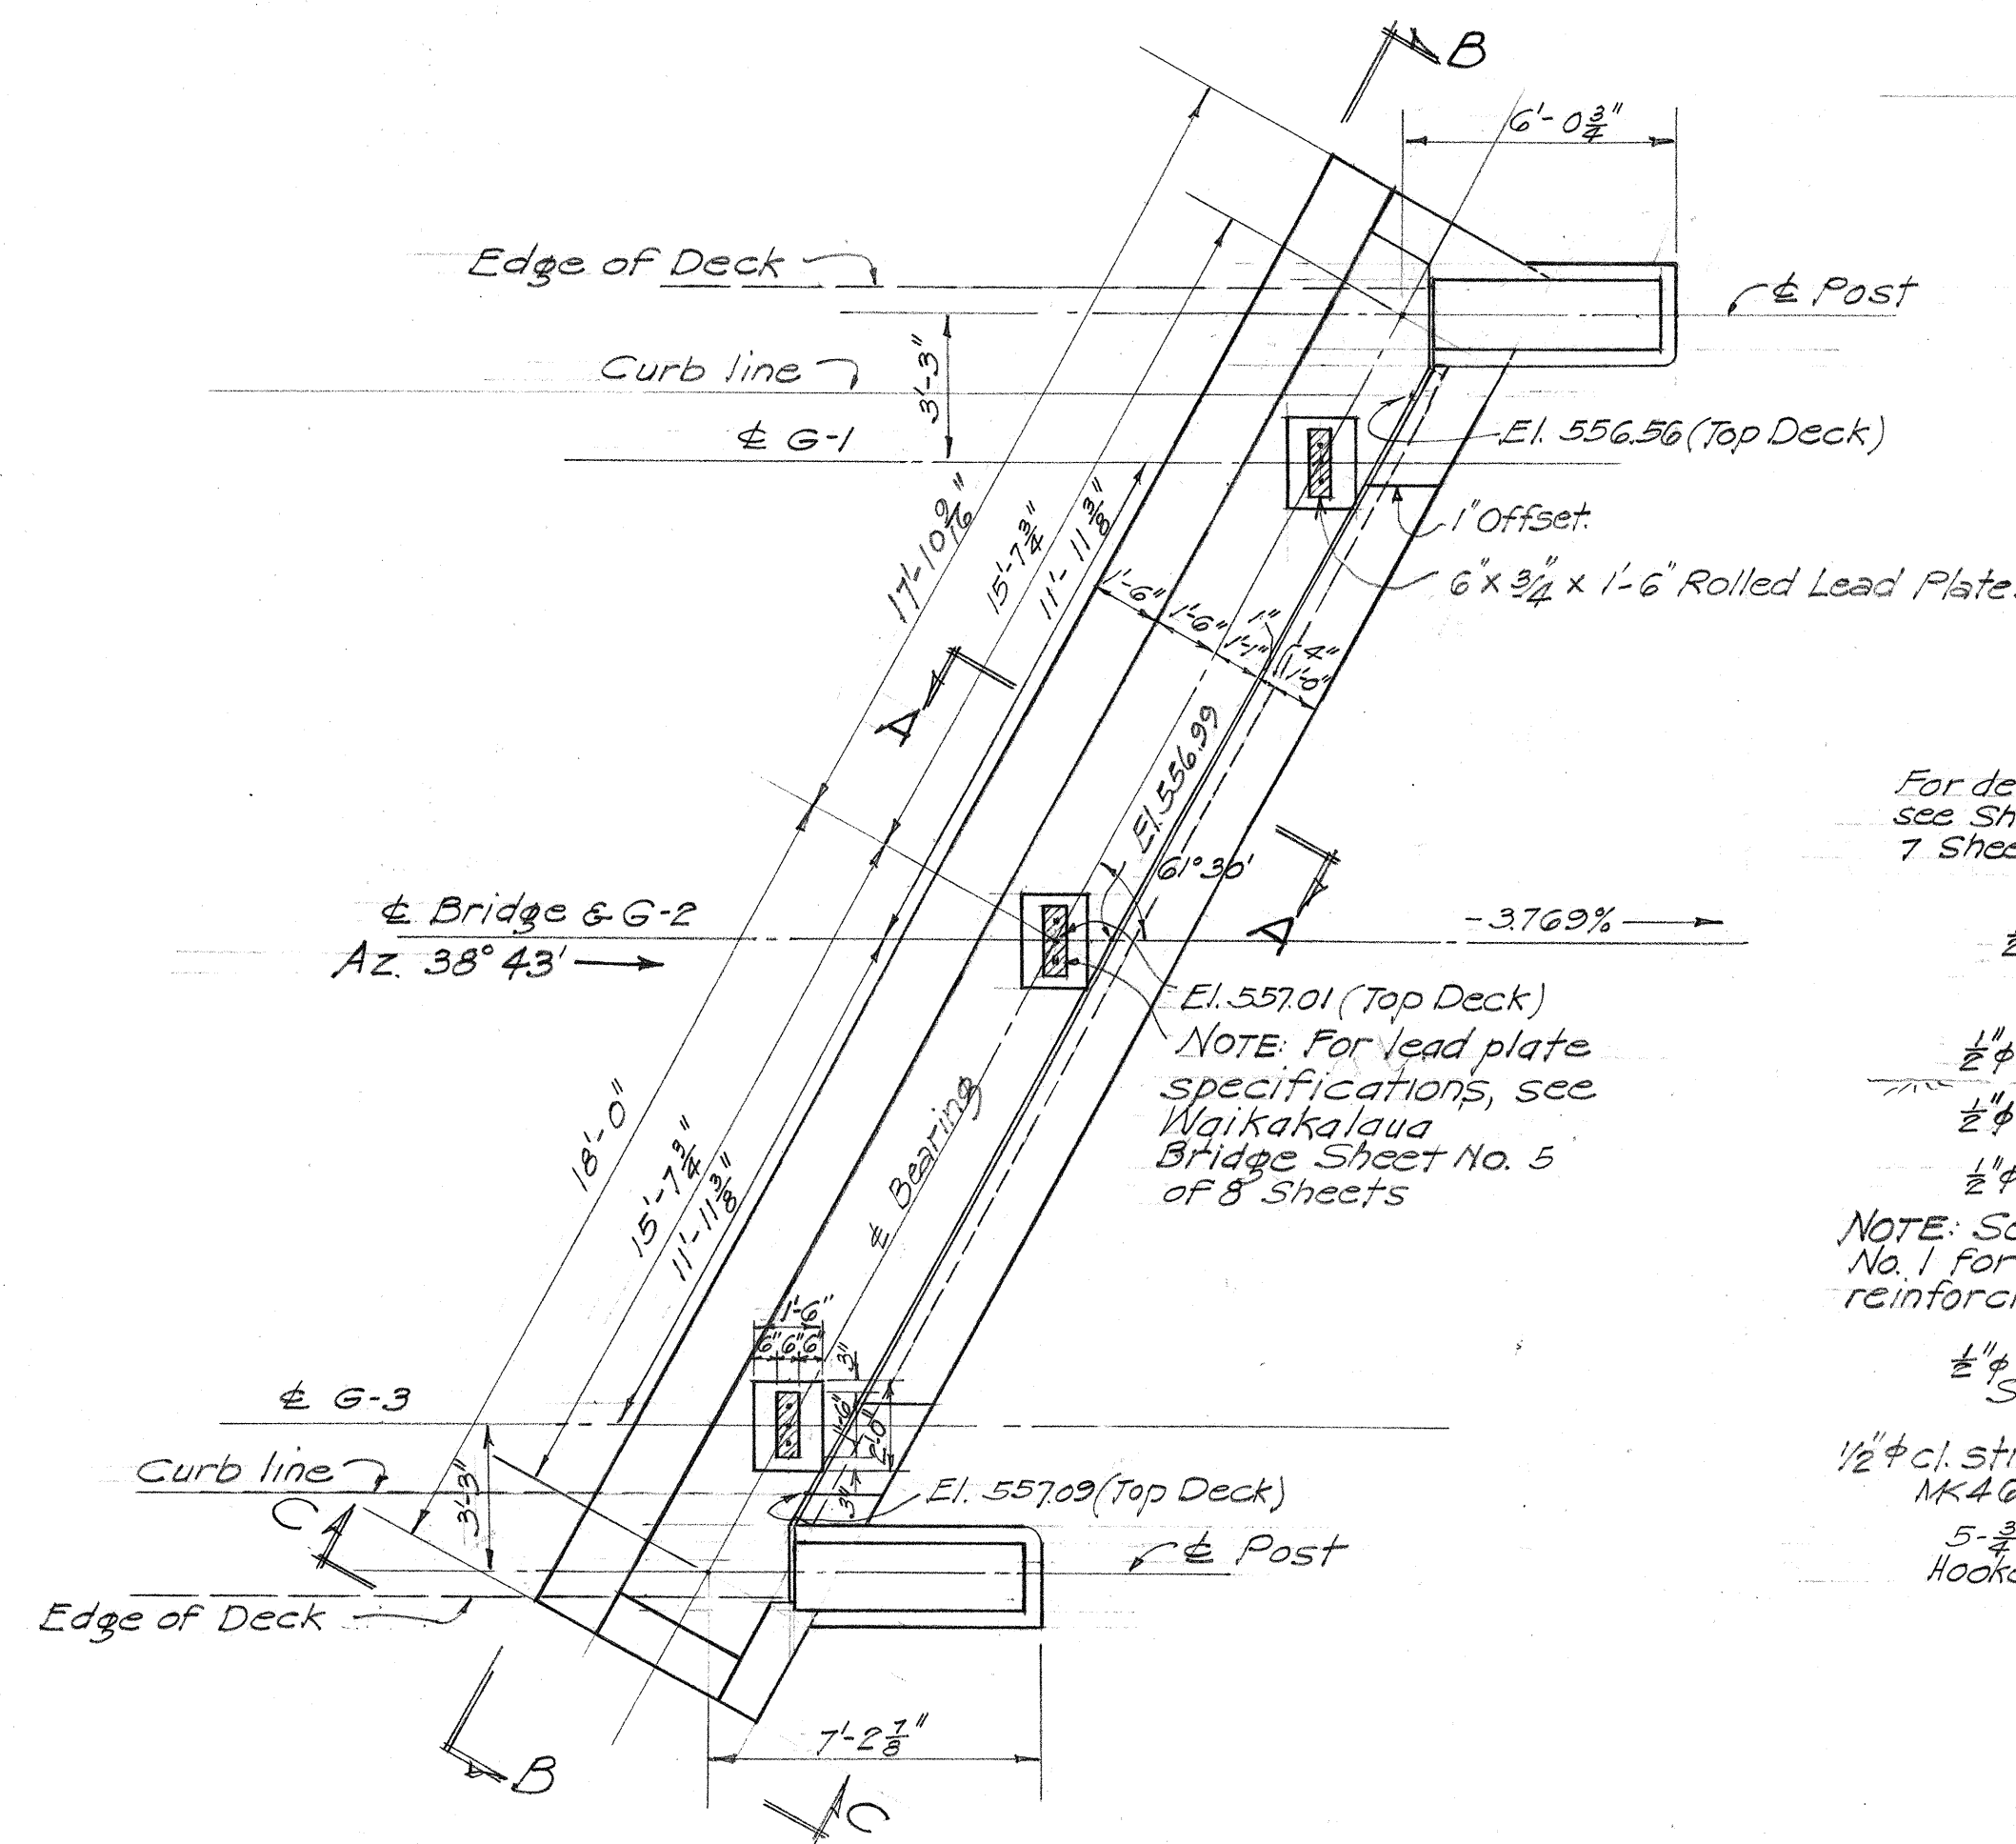

PLAN ABUTMENT No.2
1/4" = 1'-0"

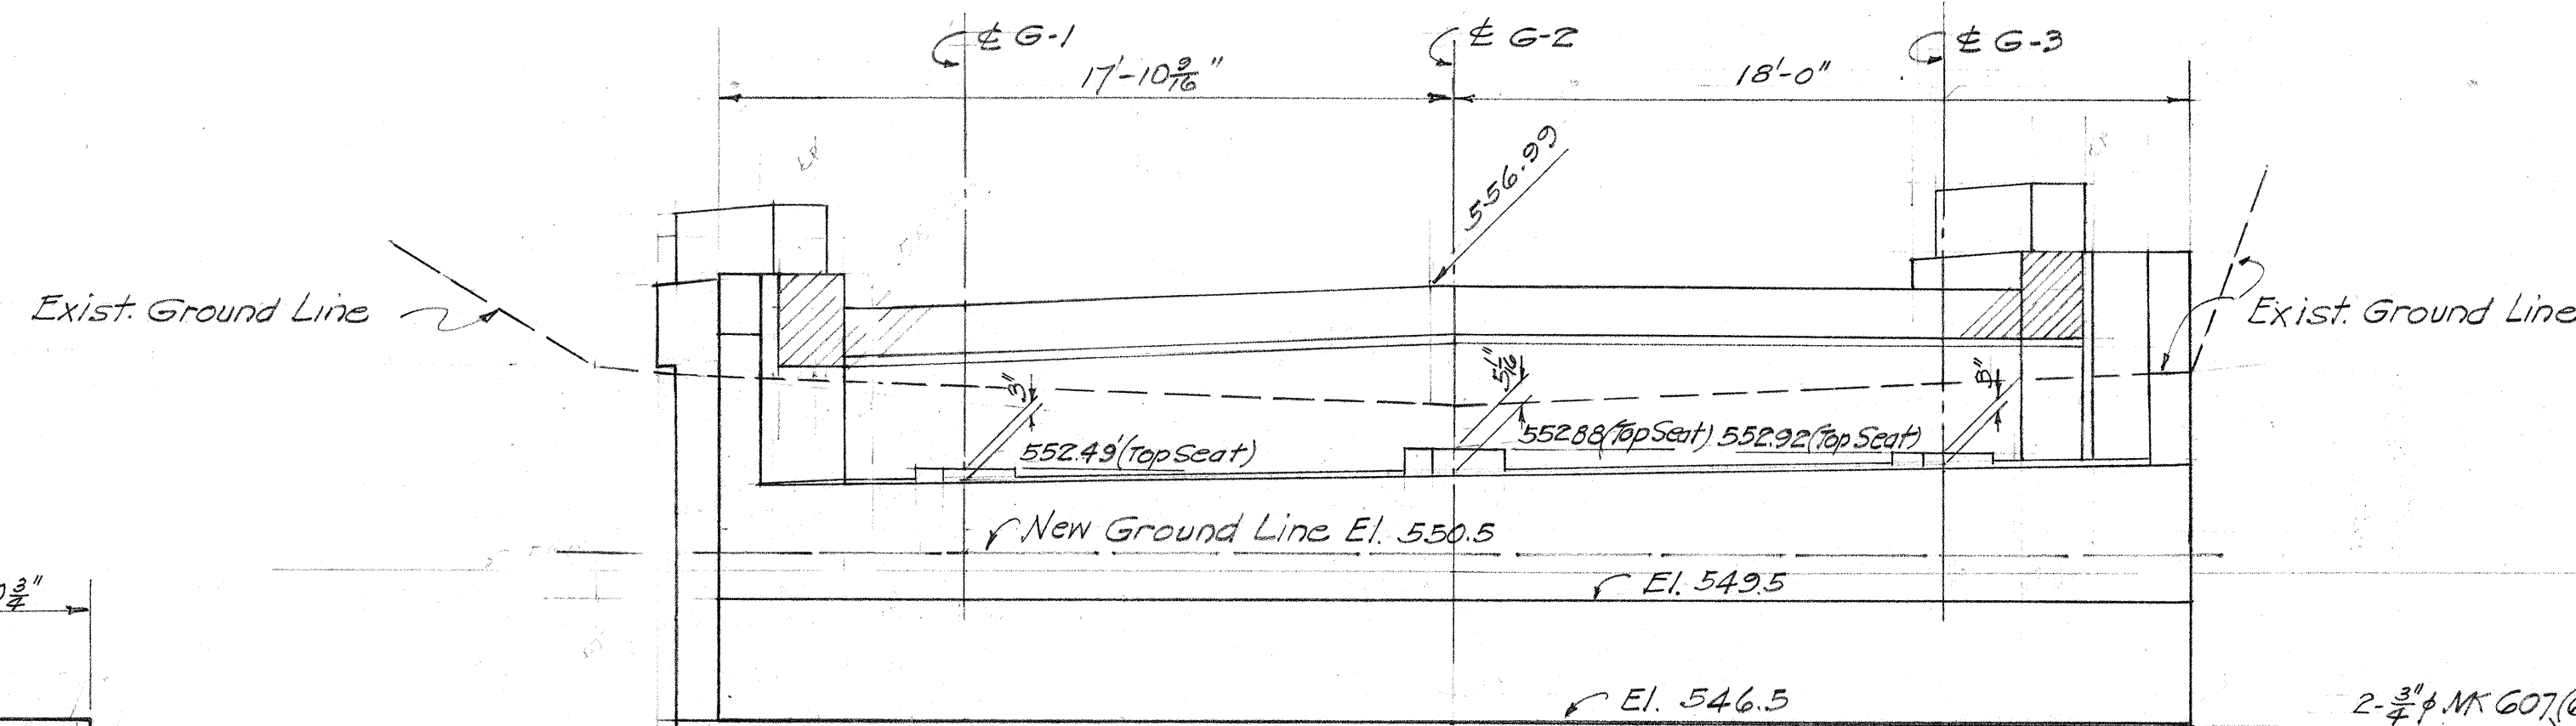


ELEVATION B-B
1/4" = 1'-0"

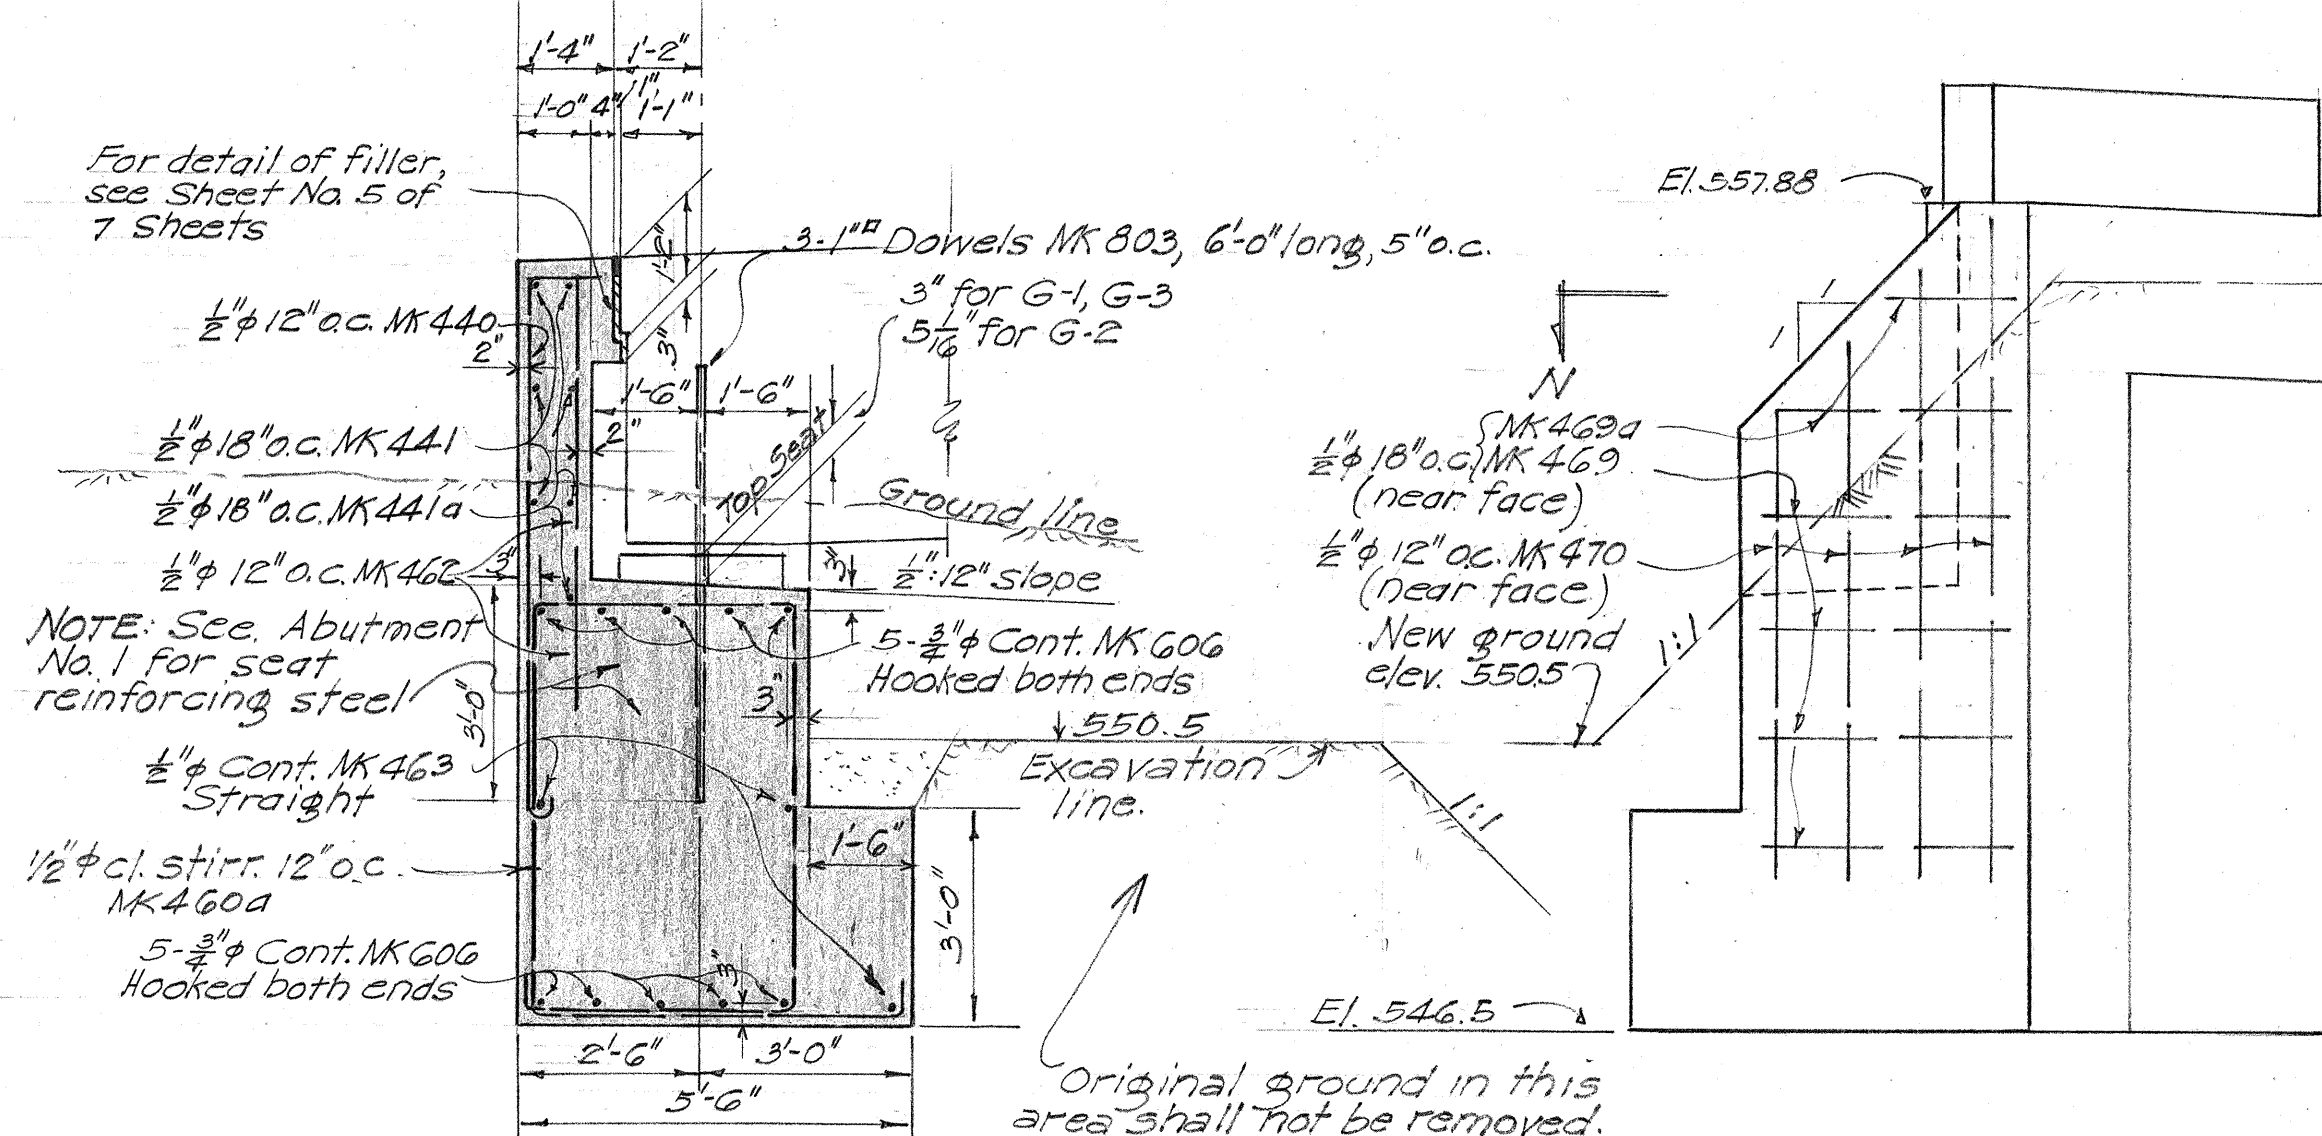


SECTION A-A
3/8" = 1'-0"

ELEVATION C-C
3/8" = 1'-0"

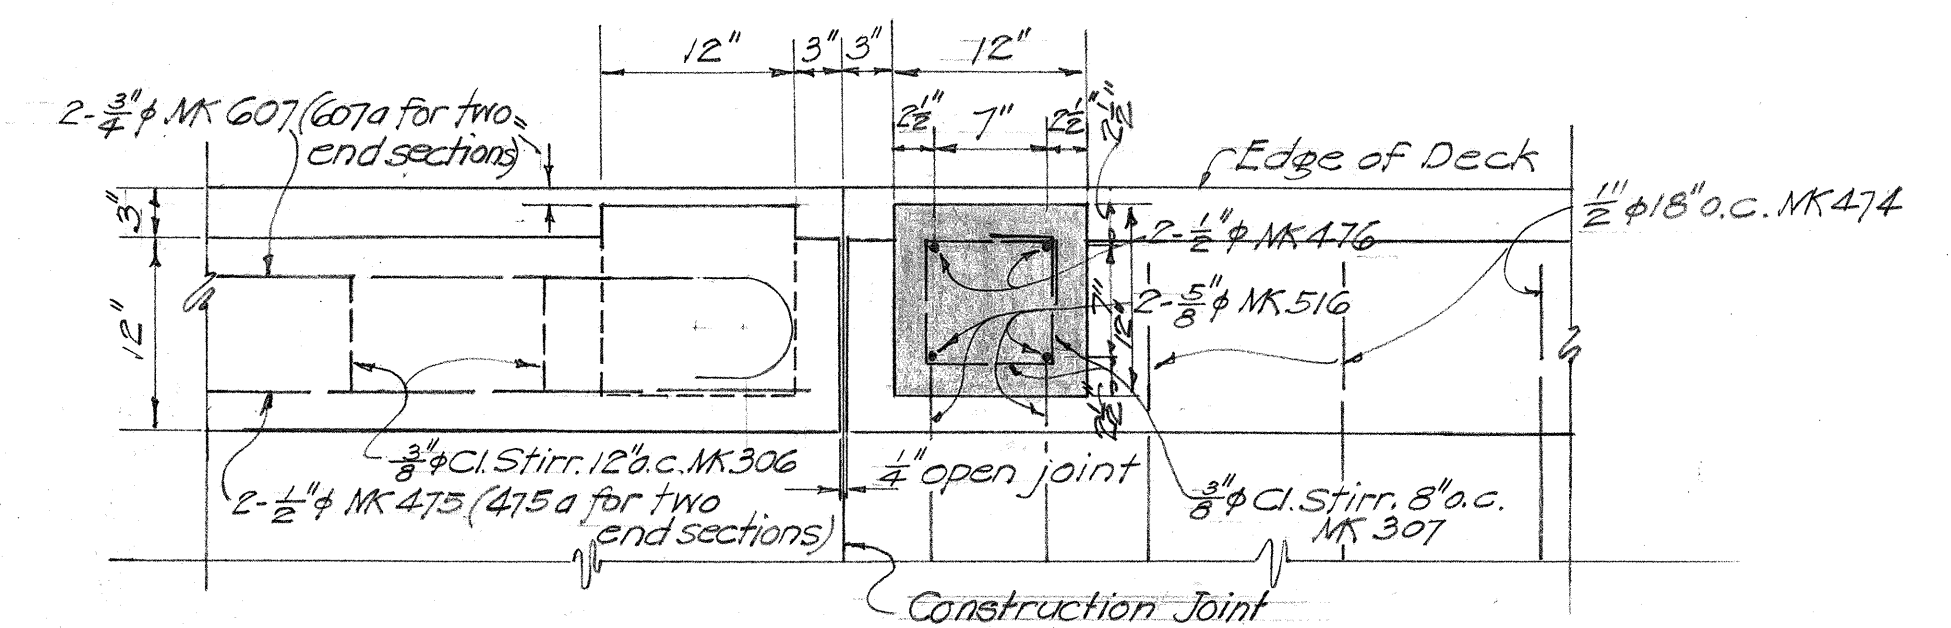


SECTION E-E
1" = 1'-0"

NOTE: See Sheet No. 7 of 7 Sheets for Section N-N

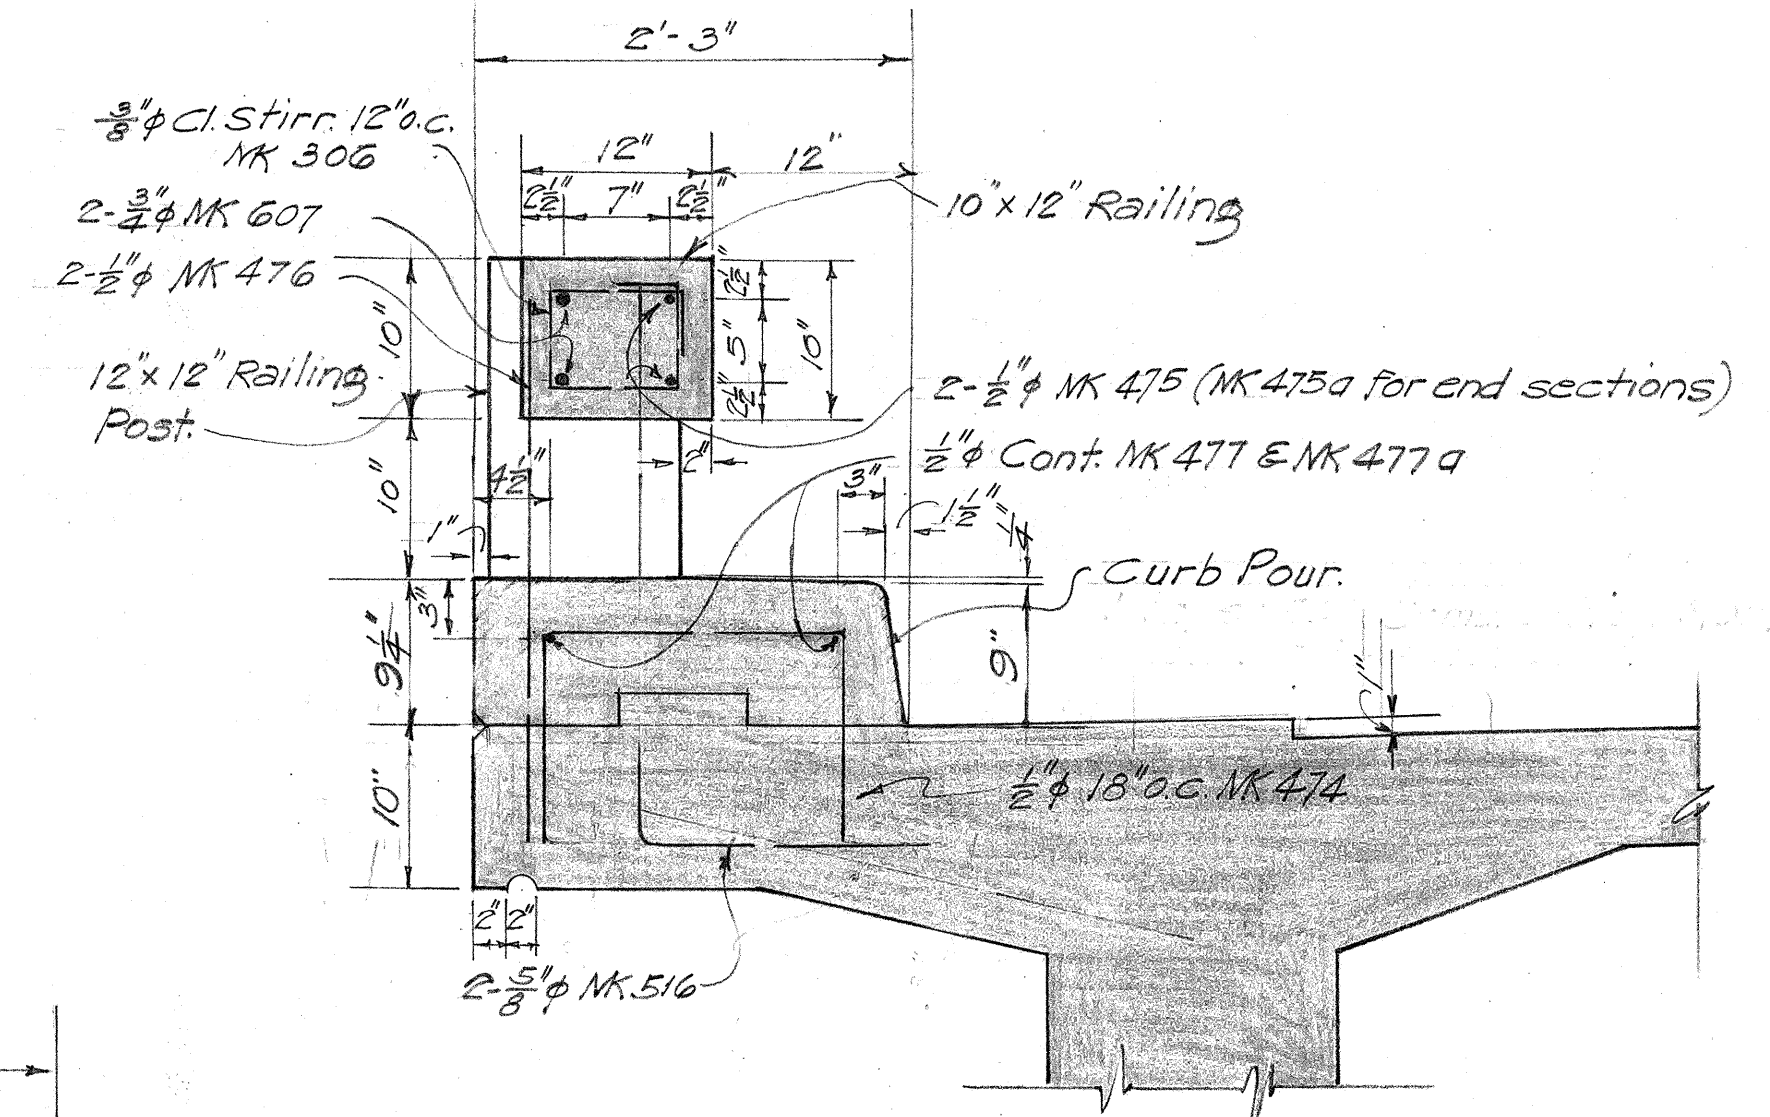

SECTION D-D
1" = 1'-0"

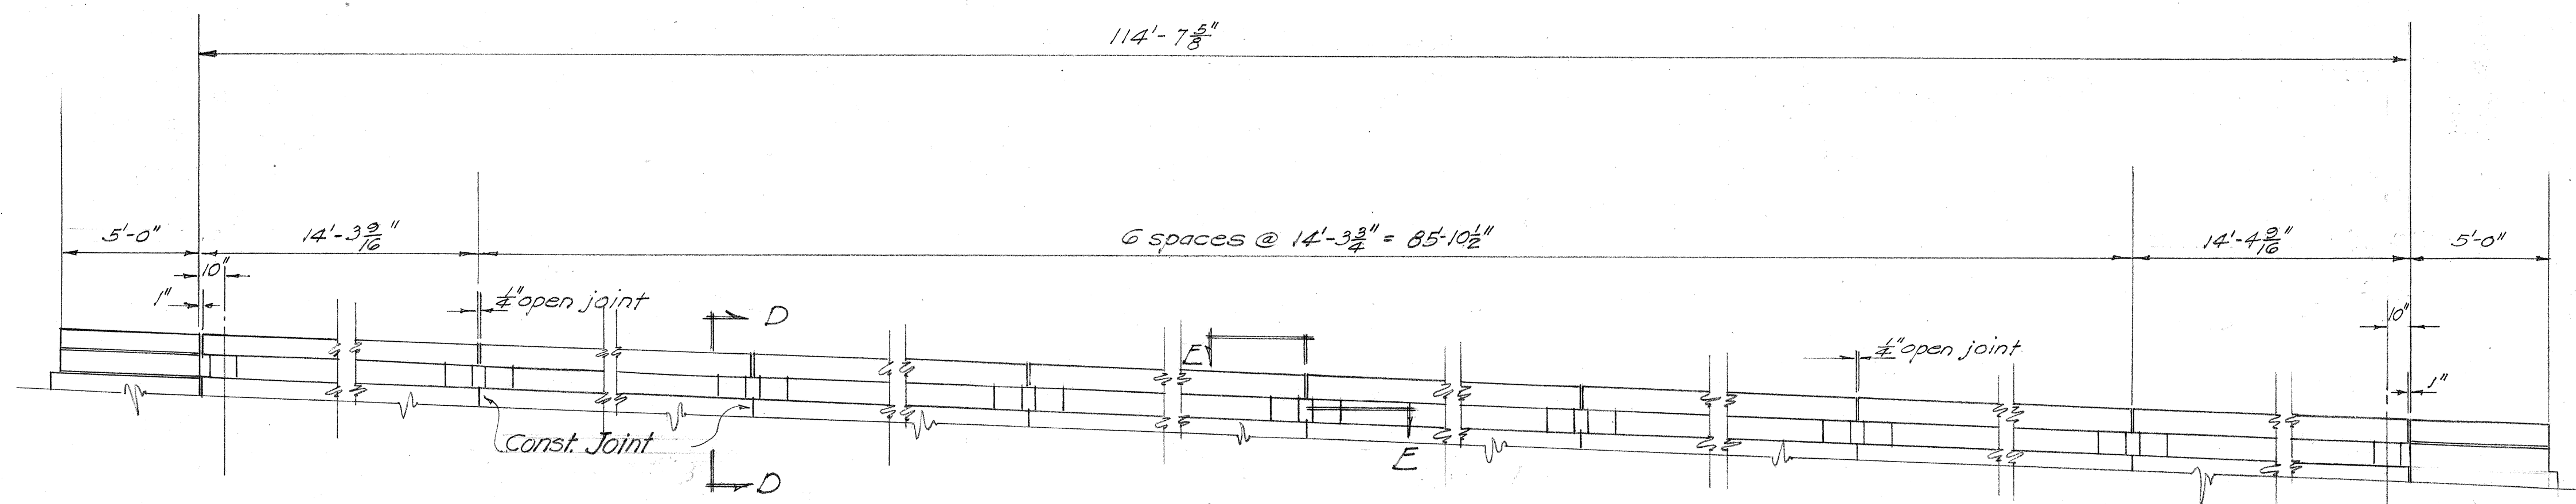

RAILING LAYOUT (LEFT)
1/4" = 1'-0"
(RIGHT RAILING SIMILAR)


TERRITORIAL HIGHWAY DEPARTMENT
TERRITORY OF HAWAII
WAIKAKALUA ORDNANCE
DEPOT ROAD BRIDGE
Sta. 3+11.16 - Sta. 4+28.84
KAMEHAMEHA HIGHWAY SN(DC)FA-F-7(20)
JUNE 1949

SHEET No. 6 OF 7 SHEETS

5382.41

SURVEY PLOTTED BY: J. E. 357416
DRAWN BY: J. E. 357416
CHECKED BY: J. E. 357416
DATE: 6-23-49
ORIGINAL PLAN NO. 1
NOTE BOOK NO. 1

FED. ROAD DIST. NO.	STATE	FED. AID PROJ. NO.	FISCAL YEAR	SHEET NO.	TOTAL SHEETS
HAWAII	HAWAII	507-700	1940	42	70

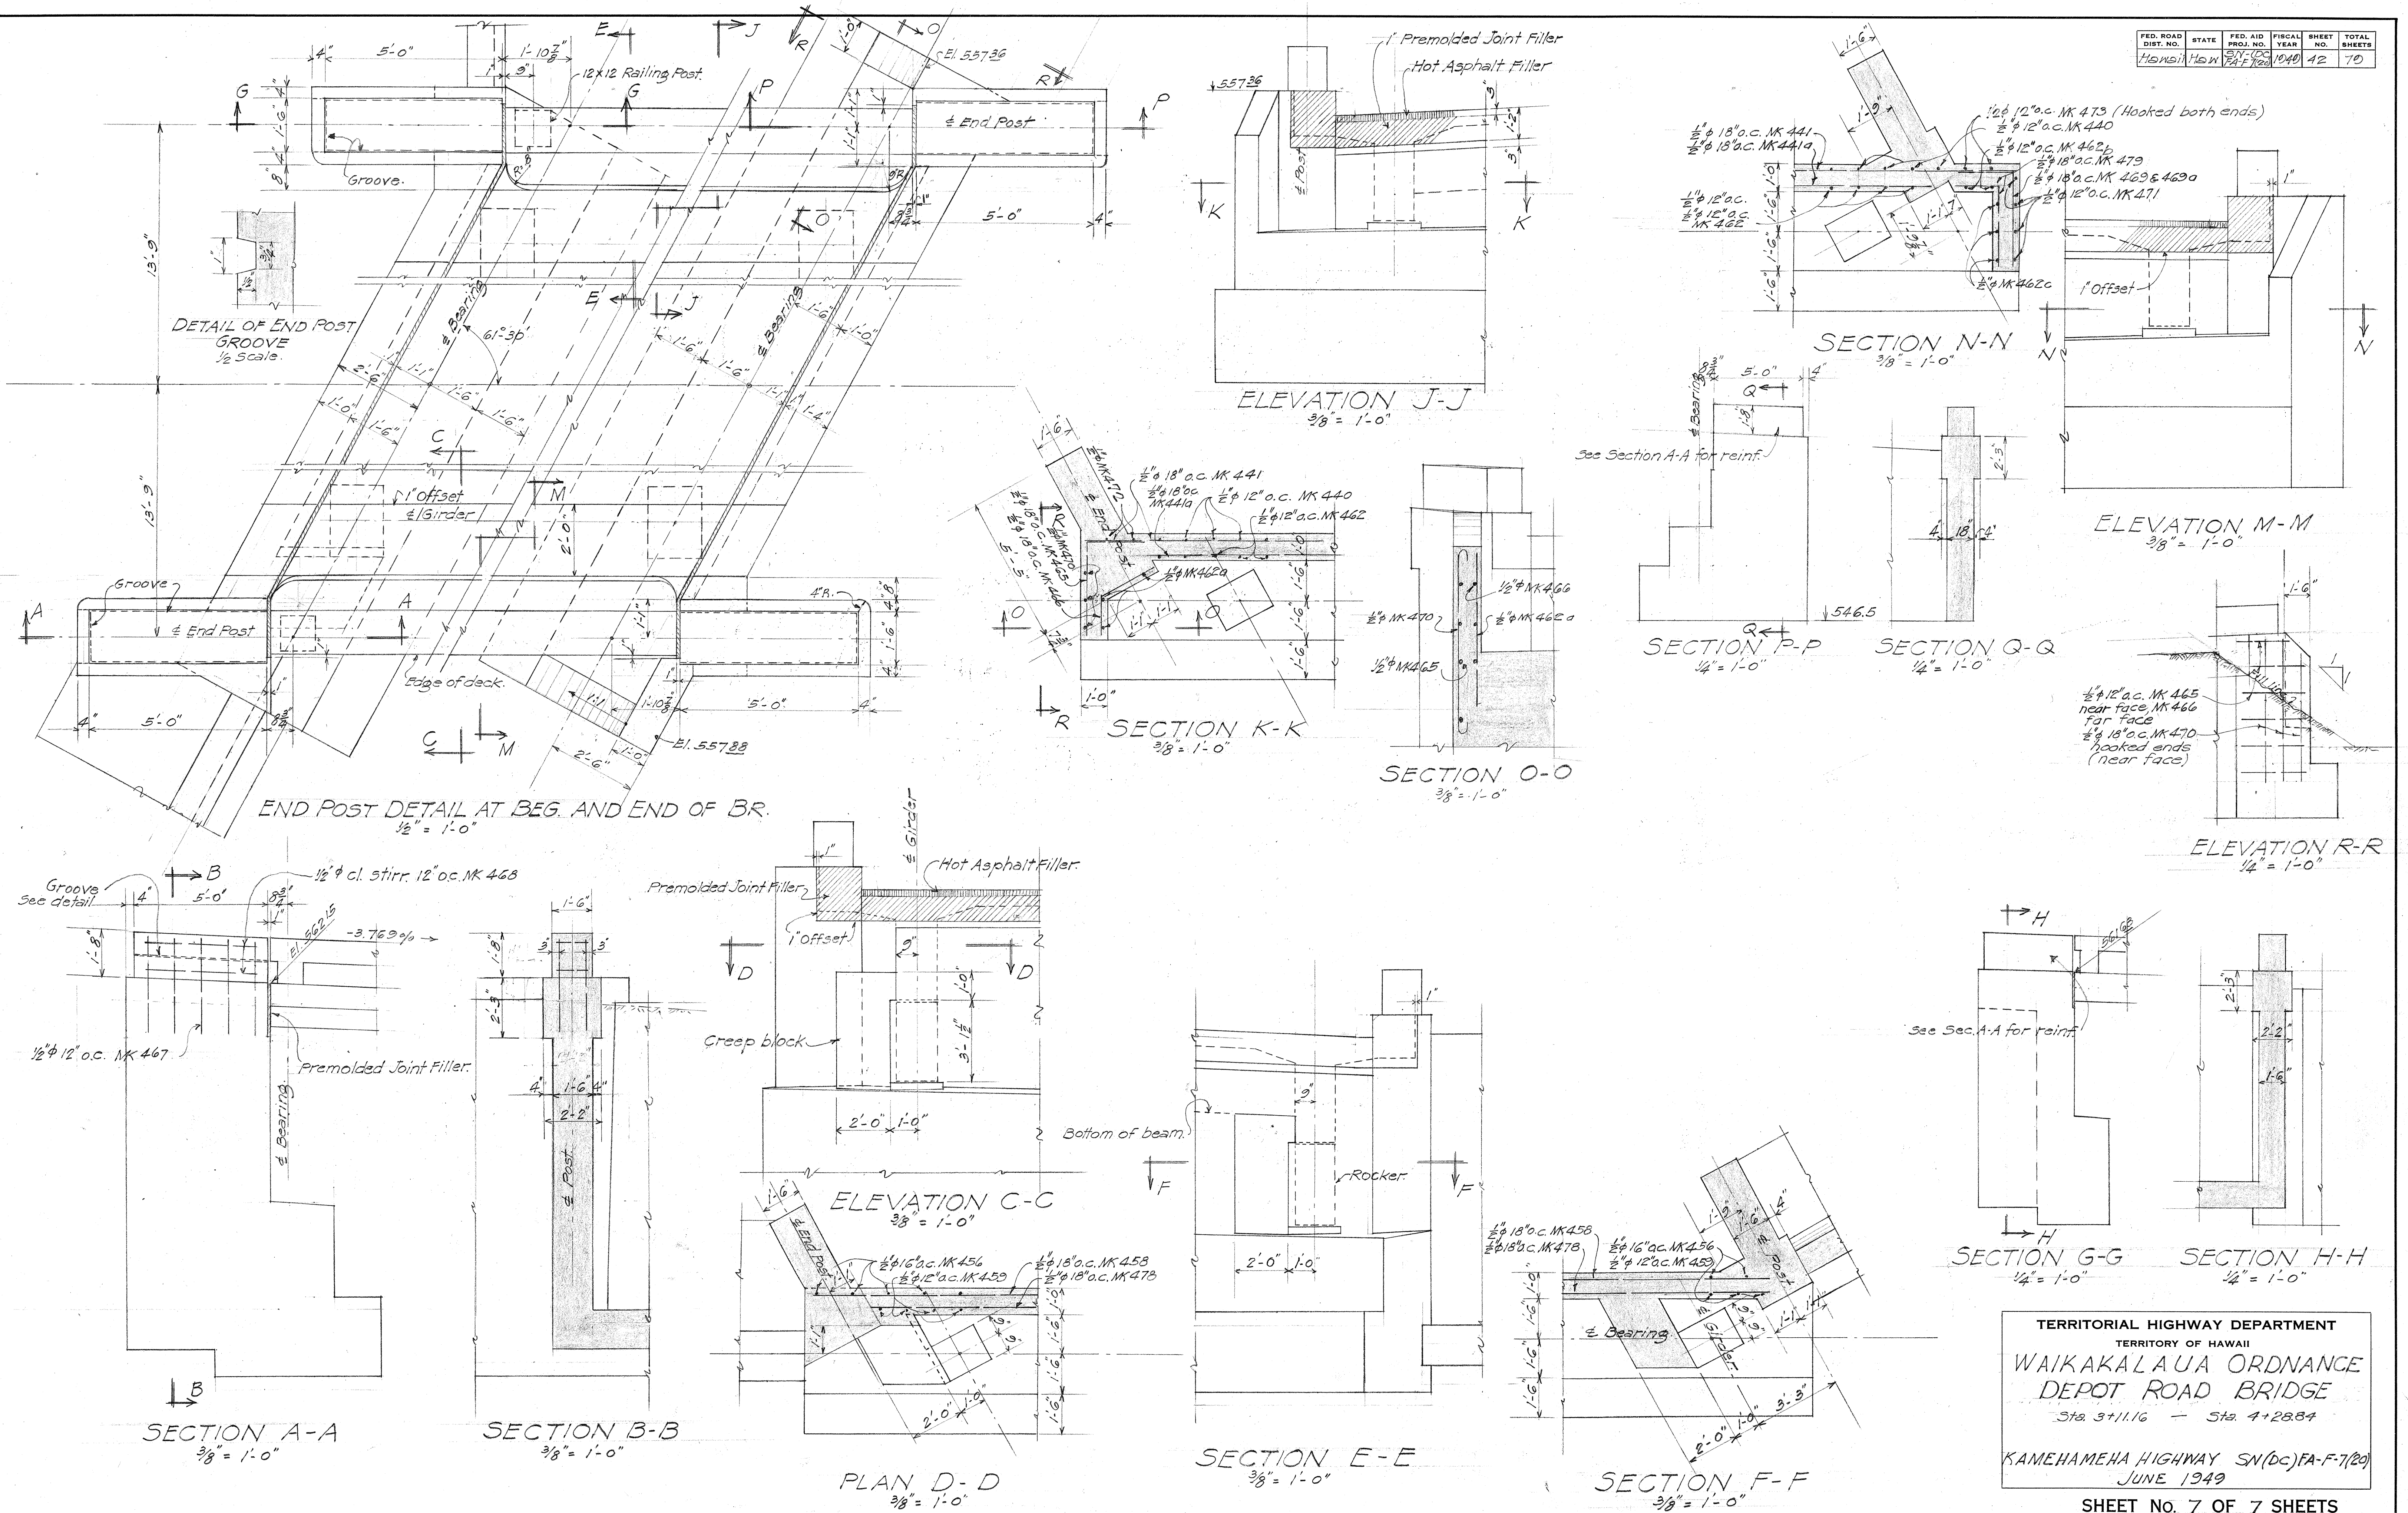

TERRITORIAL HIGHWAY DEPARTMENT
 TERRITORY OF HAWAII
 WAIKAKALAUA ORDINANCE
 DEPOT ROAD BRIDGE
 Sta. 3+11.16 - Sta. 4+28.84
 KAMEHAMEHA HIGHWAY SN(DC)FA-F-7(20)
 JUNE 1949