
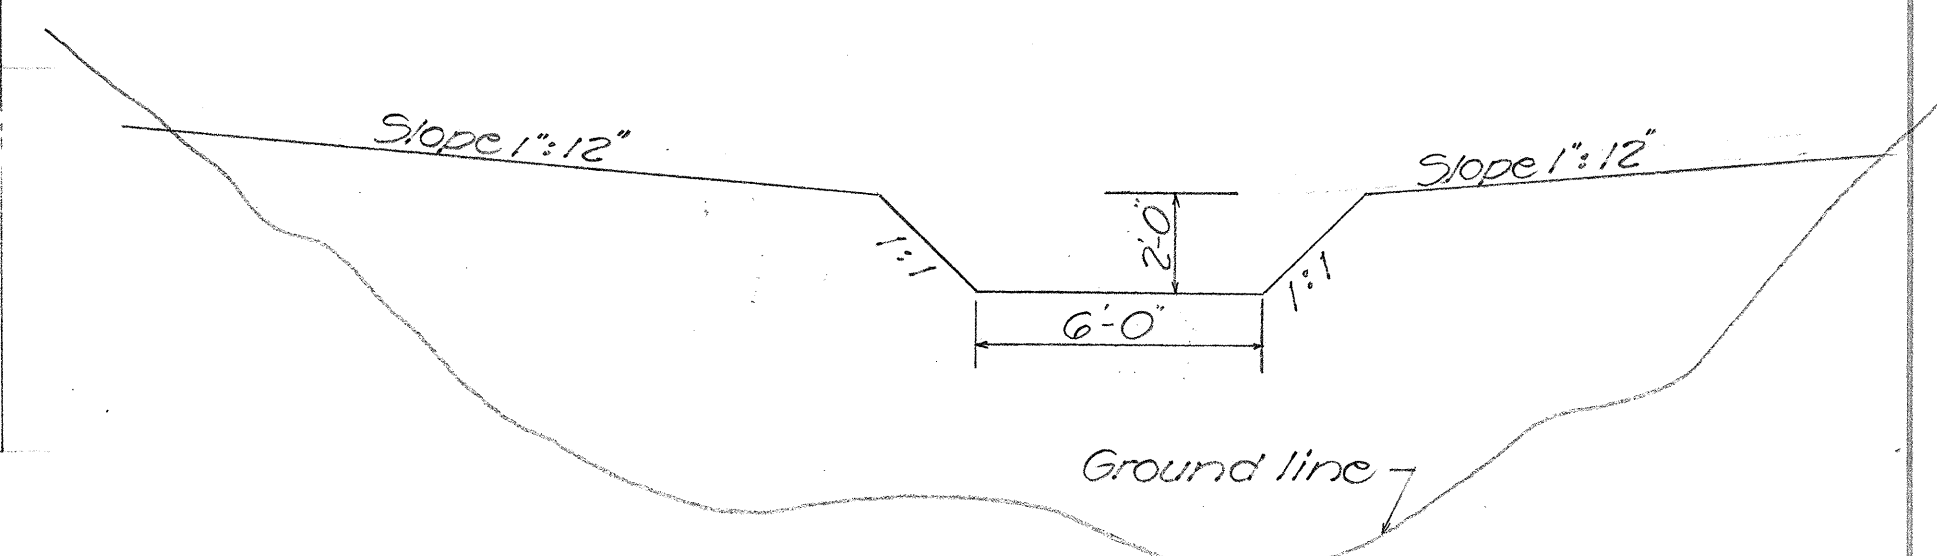


PLAN	SURVEYED	DATE
NOTE BOOK	BY	
ALIGNMENT CHECKED		
RT. OF WAY CHECKED		
NO.		

PROFILE	SURVEYED	DATE
NOTE BOOK	BY	
GRADES CHECKED		
STRUCTURE NOTATIONS CH'KD		
NO.		

FED. ROAD DIST. NO.	STATE	FED. AID PROJ. NO.	FISCAL YEAR	SHEET NO.	TOTAL SHEETS
HAWAII	HAWAII	57-100	1940	26	70

- NOTE:
1. Approximately 20,500 cu. y. of the excavated material between Sta. 110+00 and 113+50 shall be wasted in this area.
 2. Fill shall be constructed as per specifications and special provision.
 3. Drainage ditch shall be cut to the line, grade and section as shown on this sheet.

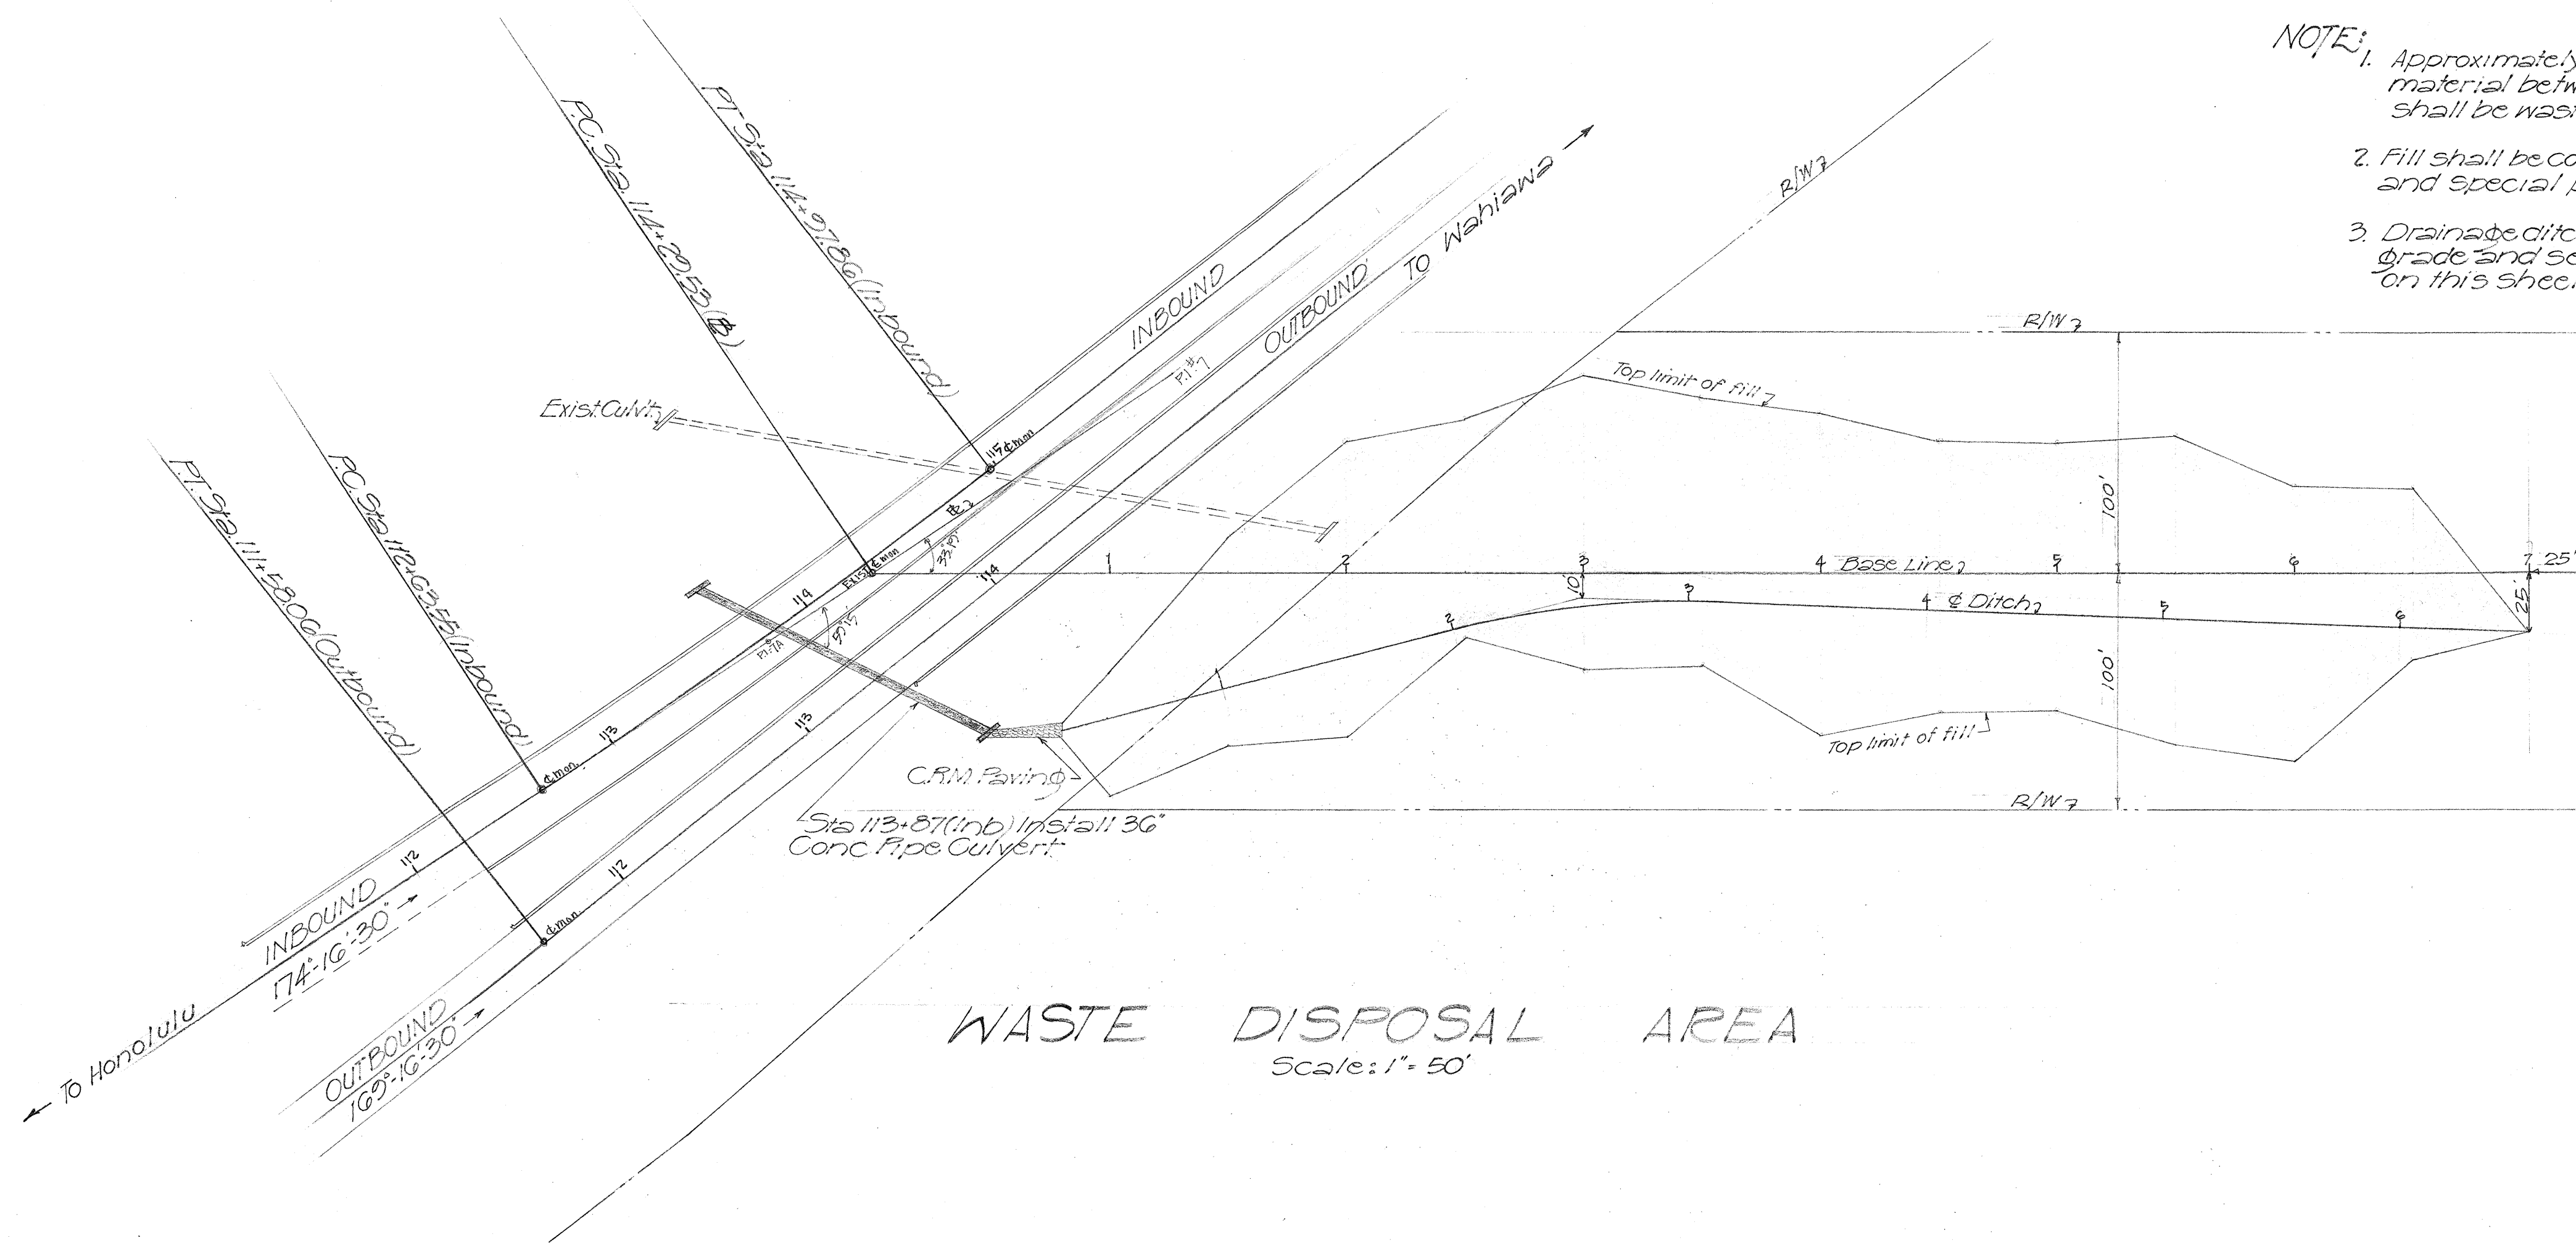

SECTION OF DITCH
Scale 1/4" = 1'-0"

