


FED ROAD DIST NO	STATE	FED AID PROJ NO	FISCAL YEAR	SHEET NO	TOTAL SHEETS
HAWAII	HAW	FO(34)	1050	1	4

2nd Unit

PLANS OF

The map displays the Hawaiian Islands with a focus on Oahu and Maui. Key locations marked include Kahu Point, Waimea, Wailoa, Haleiwa, Waiolu, Laie, Hauula, Punaluu, Kaneohe Bay, Waikane, Kaneohe, Kailua, Waimanalo, Koko Head, and Diamond Head. The project location is indicated by a crosshair symbol near Honolulu. A compass rose is located in the upper right corner, and a scale bar at the bottom indicates distances in miles.

Federal Aid Projects Previously Constructed Or Under Construction

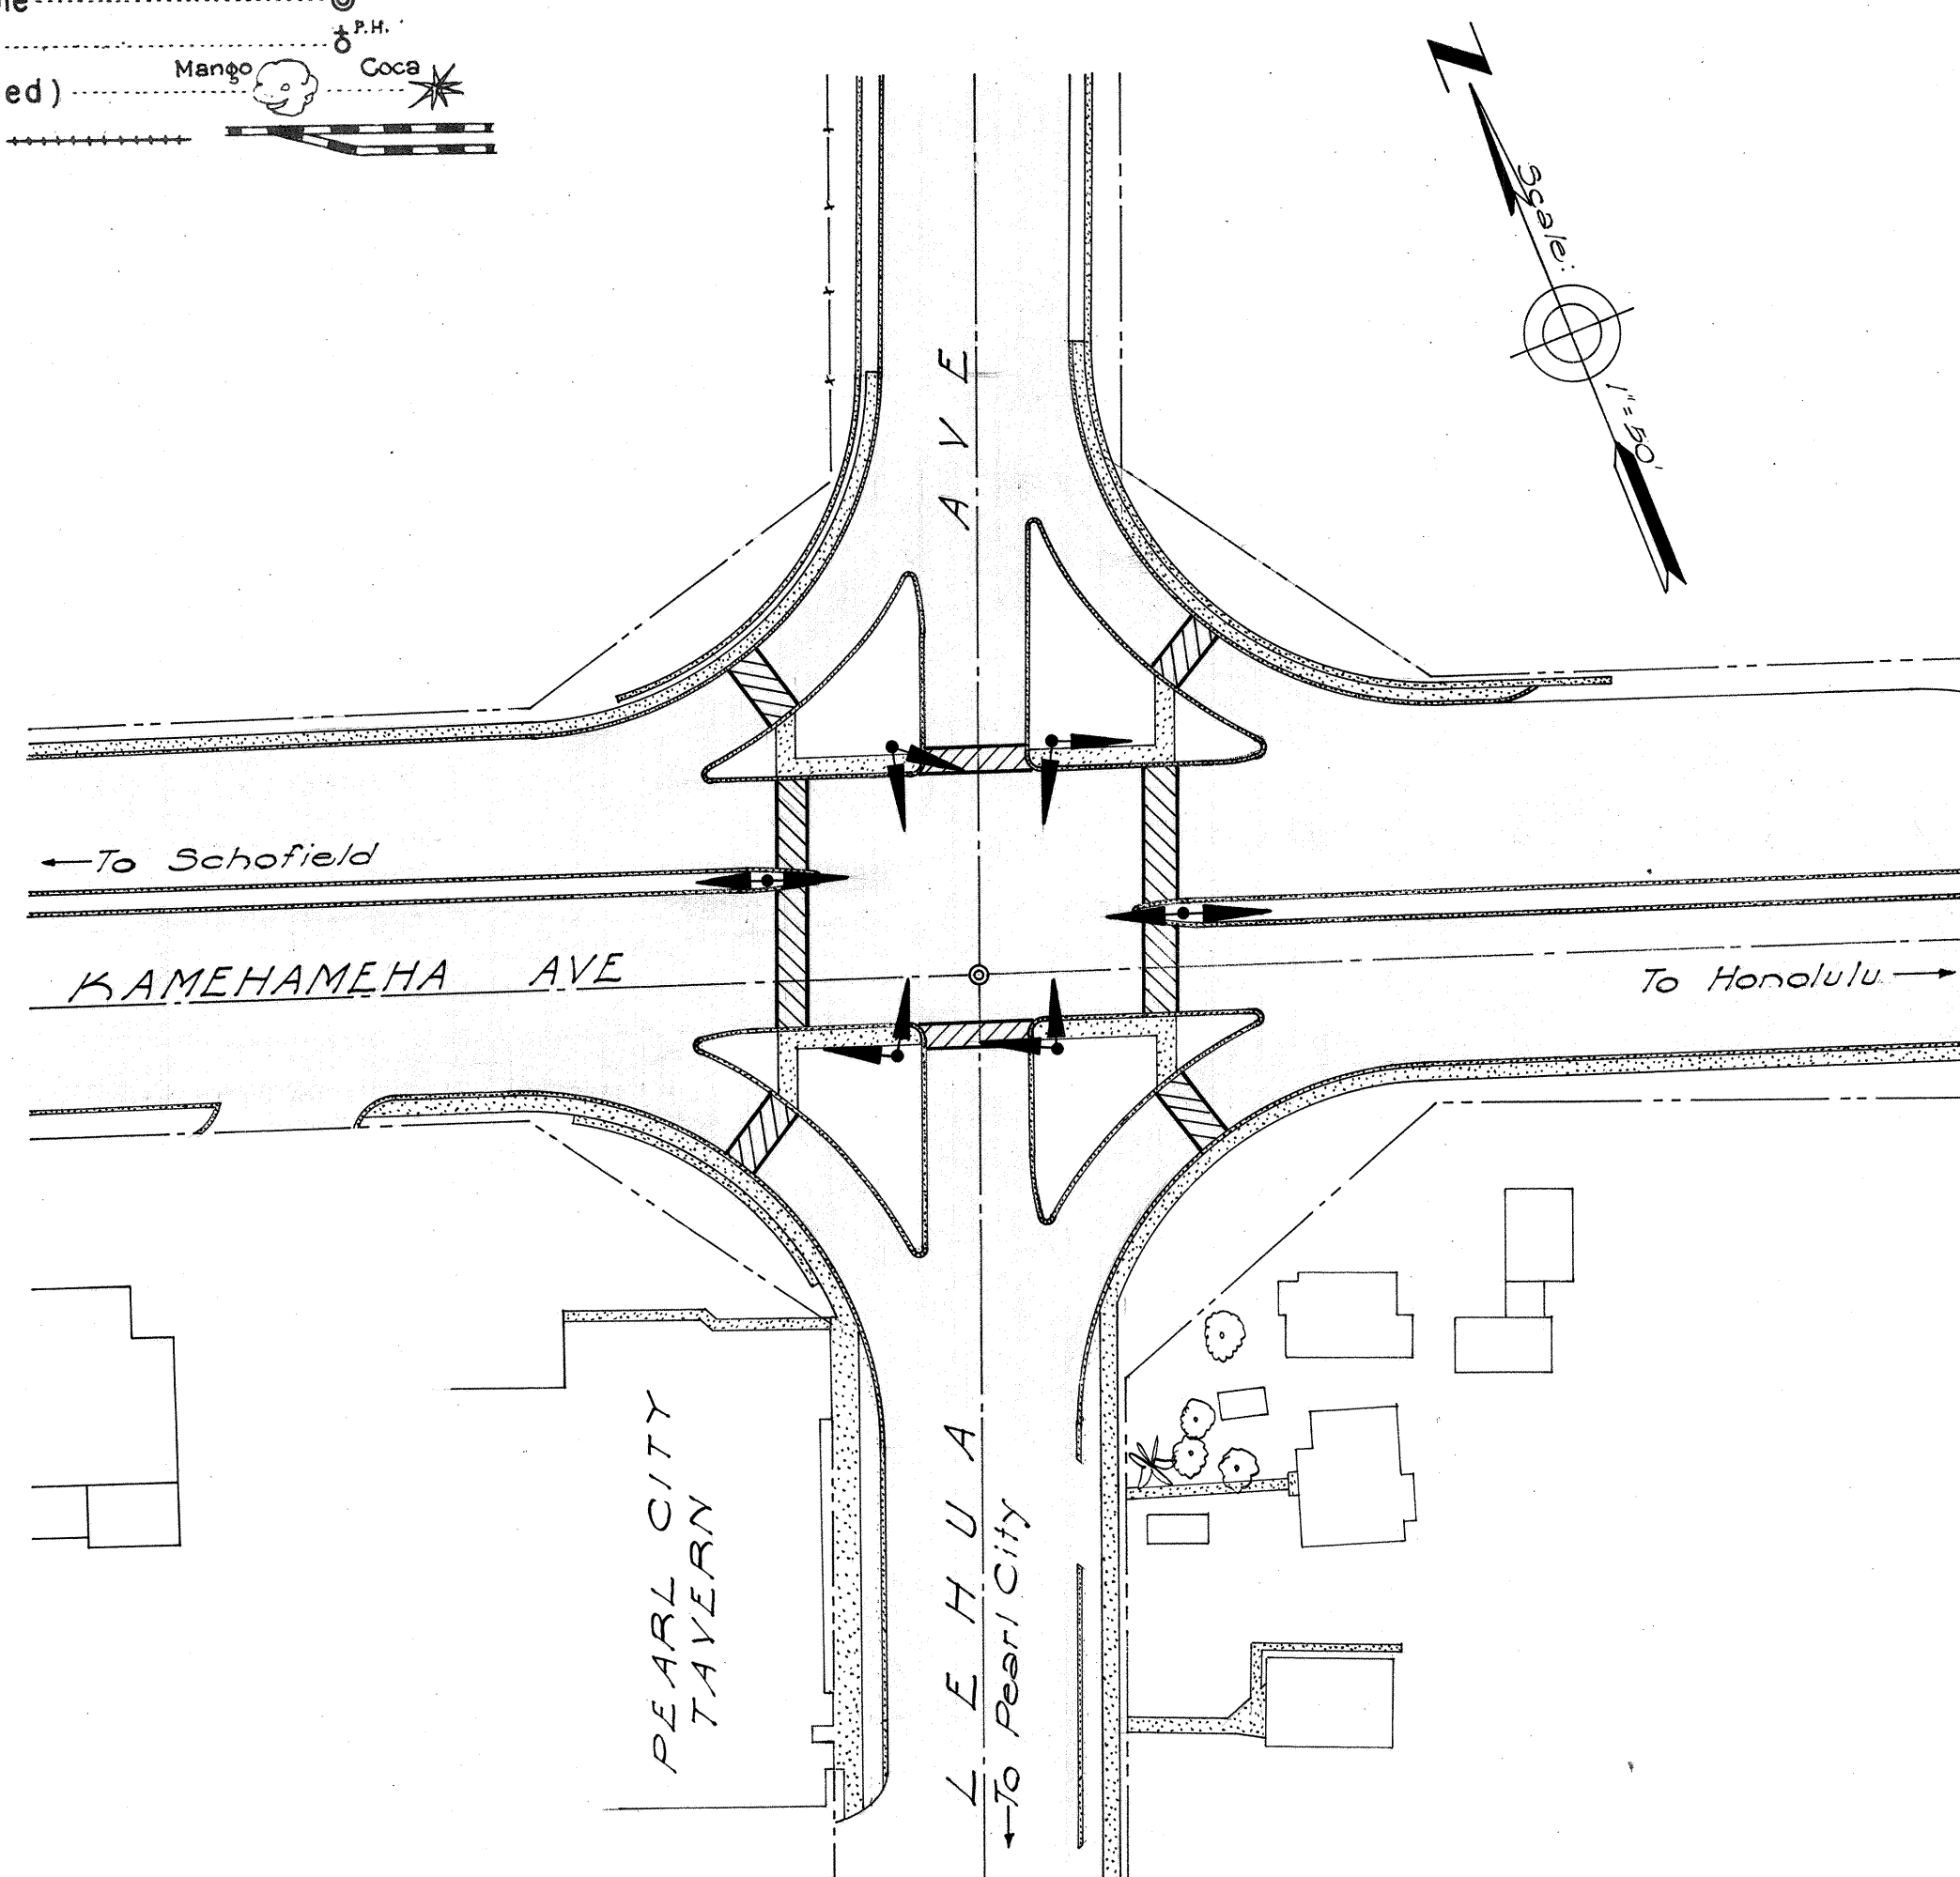

SCALE: 1" = 50'

DEPARTMENT OF COMMERCE BUREAU OF PUBLIC ROADS	
RECOMMENDED FOR APPROVAL:	
DISTRICT ENGINEER	DATE
APPROVED:	
DIVISION ENGINEER	DATE

5 4 6 4 . 1

ORIGINAL PLAN	SURVEY PLOTTED BY	DATE
NOTE BOOK	DESIGNED BY	
	DRAWN BY	
	TRACED BY	
	QUANTITIES BY	
	QUANTITIES CHECKED BY	
No.	CHECKED BY	