


FED. ROAD DIST. NO.	STATE	FED. AID PROJ. NO.	FISCAL YEAR	SHEET NO.	TOTAL SHEETS
HAWAII	HAWAII	FO(94)1080	2	4	4


2nd Unit

MODEL 82GD DISPATCHER

CONNECTOR PLUG & CABLE A-12629

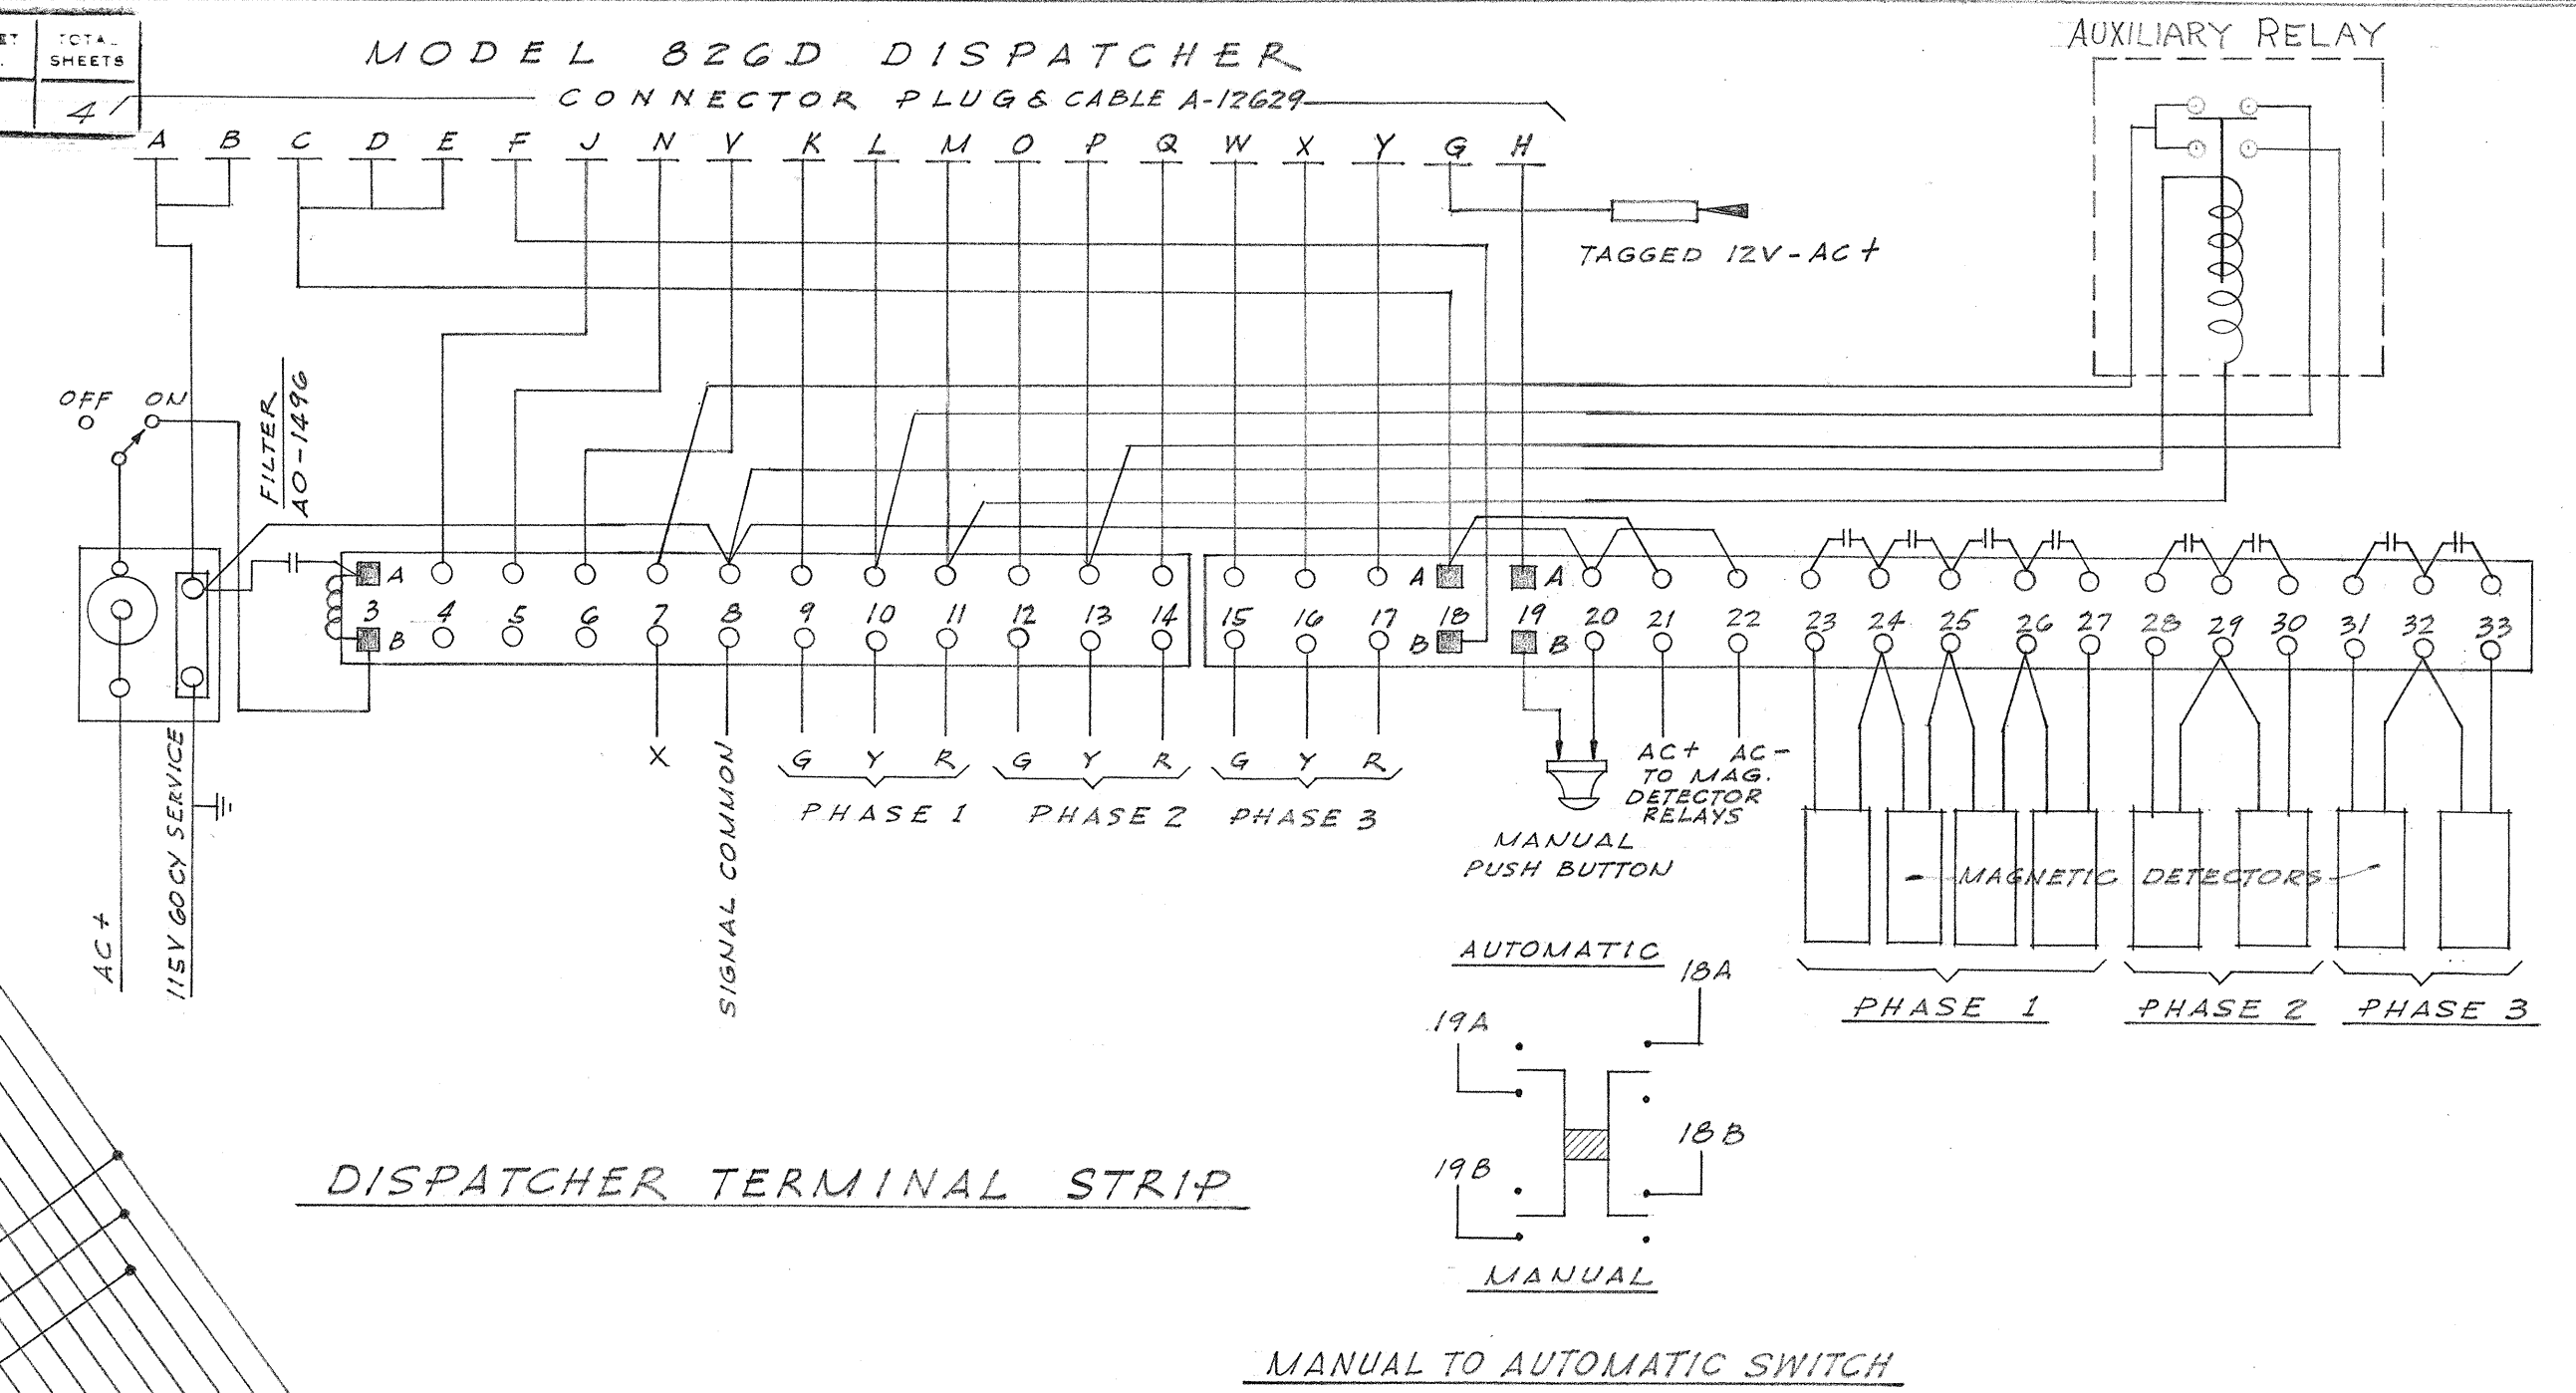

DISPATCHER TERMINAL STRIP

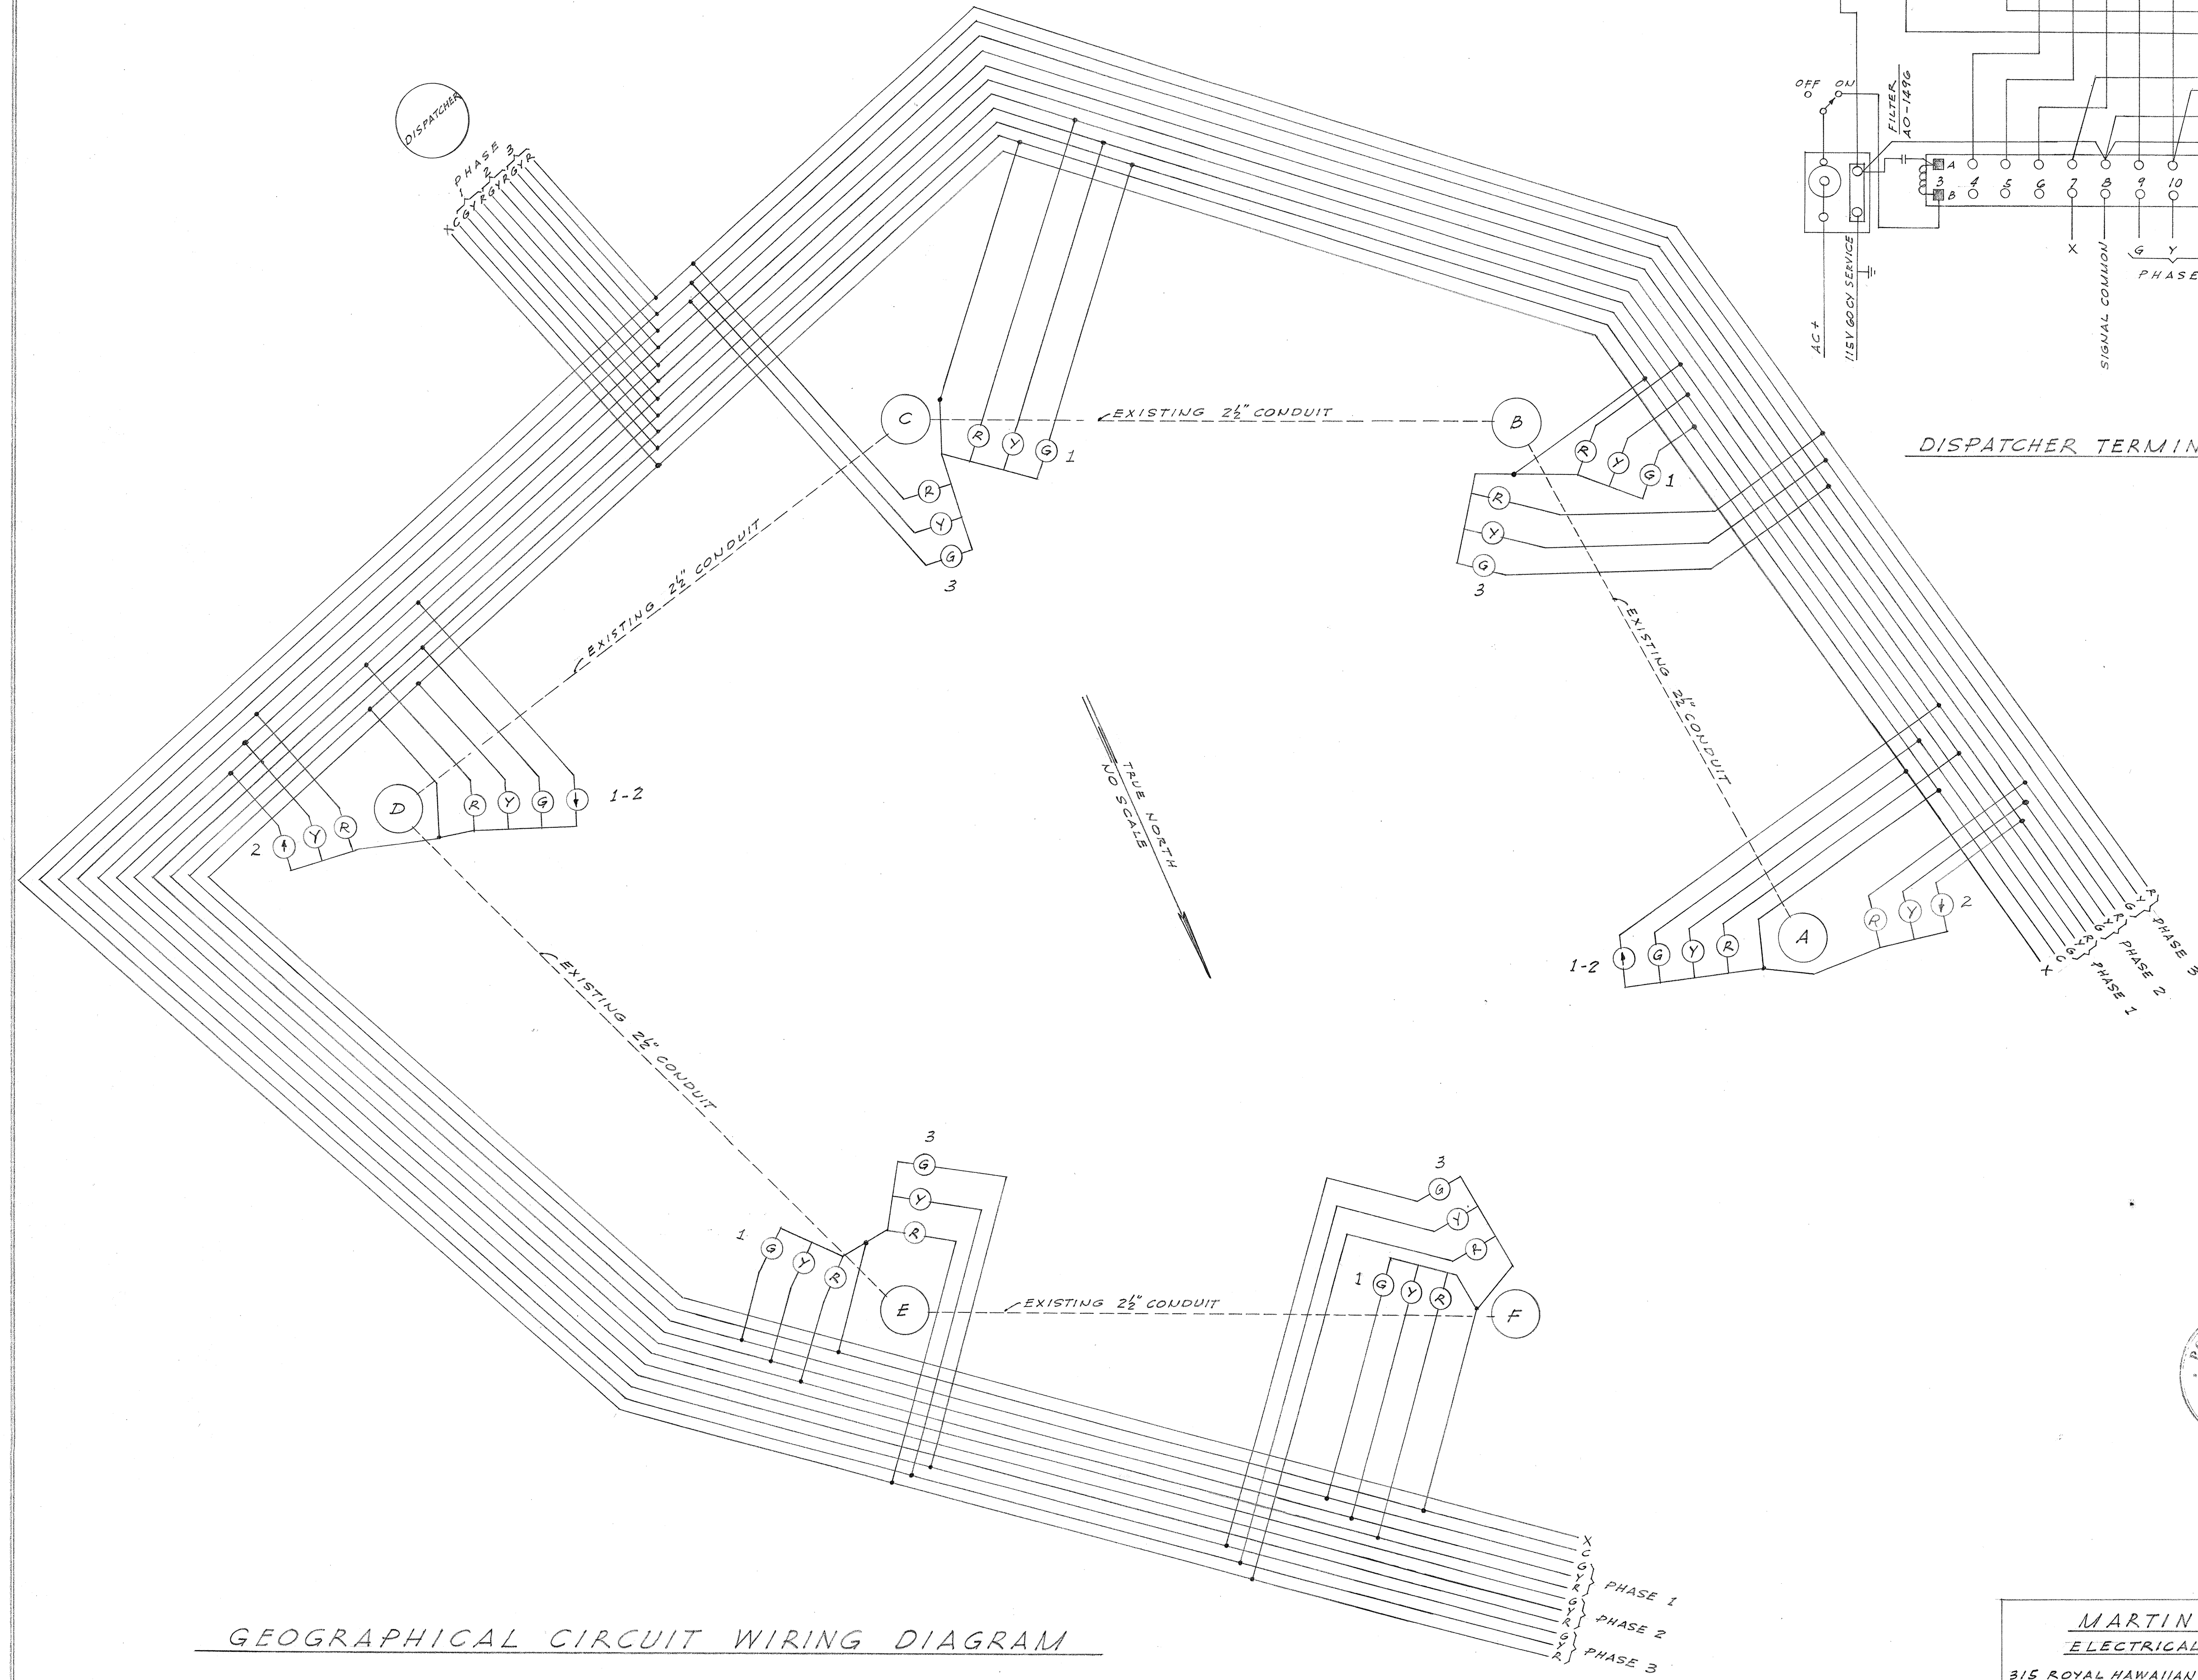

GEOGRAPHICAL CIRCUIT WIRING DIAGRAM



APPROVED: _____ DATE: _____
TERRITORIAL HIGHWAY ENGINEER

MARTIN & CURLEY
ELECTRICAL ENGINEERS
315 ROYAL HAWAIIAN AVE. HONOLULU, T.H.
JAN. 7, 1950

TERRITORIAL HIGHWAY DEPARTMENT
TERRITORY OF HAWAII
TRAFFIC SIGNAL SYSTEM
LEHUA AVE. & KAMEHAMEHA HIGHWAY

SCALE: NONE DATE: JAN. 7, 1950

SHEET NO. 2 OF 3 SHEETS

5464.3