

INDEX TO DRAWINGS	
SHEET NO.	DESCRIPTION
1	TITLE SHEET
2	TYPICAL SECTION
3-5	PLAN & PROFILE
6-11	STANDARD DETAILS
12	STD BRIDGE DETAILS
13-21	BRIDGE DETAILS
22-31	CROSS SECTIONS


CONVENTIONAL SIGNS	
Centerline	125
Boundary Lines	or
Fences (Named)	
Existing Roadways	
Circular Culvert	
Box Culvert	
Bridge	
Telephone Pole	T.P.
Electric Power Pole	E.P.P.
Water Main	W ₂ W ₂ (W ₄ , 8, 12, Etc.)
Storm Drain	SD ₁₂ SD ₁₂ (SD ₁₈ , 24, Etc.)
Concrete Drop Intake	C.D.I.
Standard Catch Basin	S.C.B.
Standard Manhole	M.H.S.
Sewer Manhole	S.M.H.
Telephone Manhole	T.M.H.
Fire Hydrant	F.H.
Tree (Large, named)	Mango, Cocoa
Railroad	
Mutual Telephone Underground Cable	MTC
Water Meter	WM

TERRITORY OF HAWAII
TERRITORIAL HIGHWAY DEPARTMENT
HONOLULU, OAHU, T. H.


PLANS OF KAMEHAMEHA HIGHWAY FEDERAL AID PROJECT NO.F 9(35)

DISTRICT OF EWA
ISLAND OF OAHU

SCALES	
PLAN	1 IN. = 50 FT.
PROFILE	HOR. 1 IN. = 50 FT. VERT. 1 IN. = 10 FT.
CROSS SECTION	HOR. 1 IN. = 10 FT. VERT. 1 IN. = 10 FT.

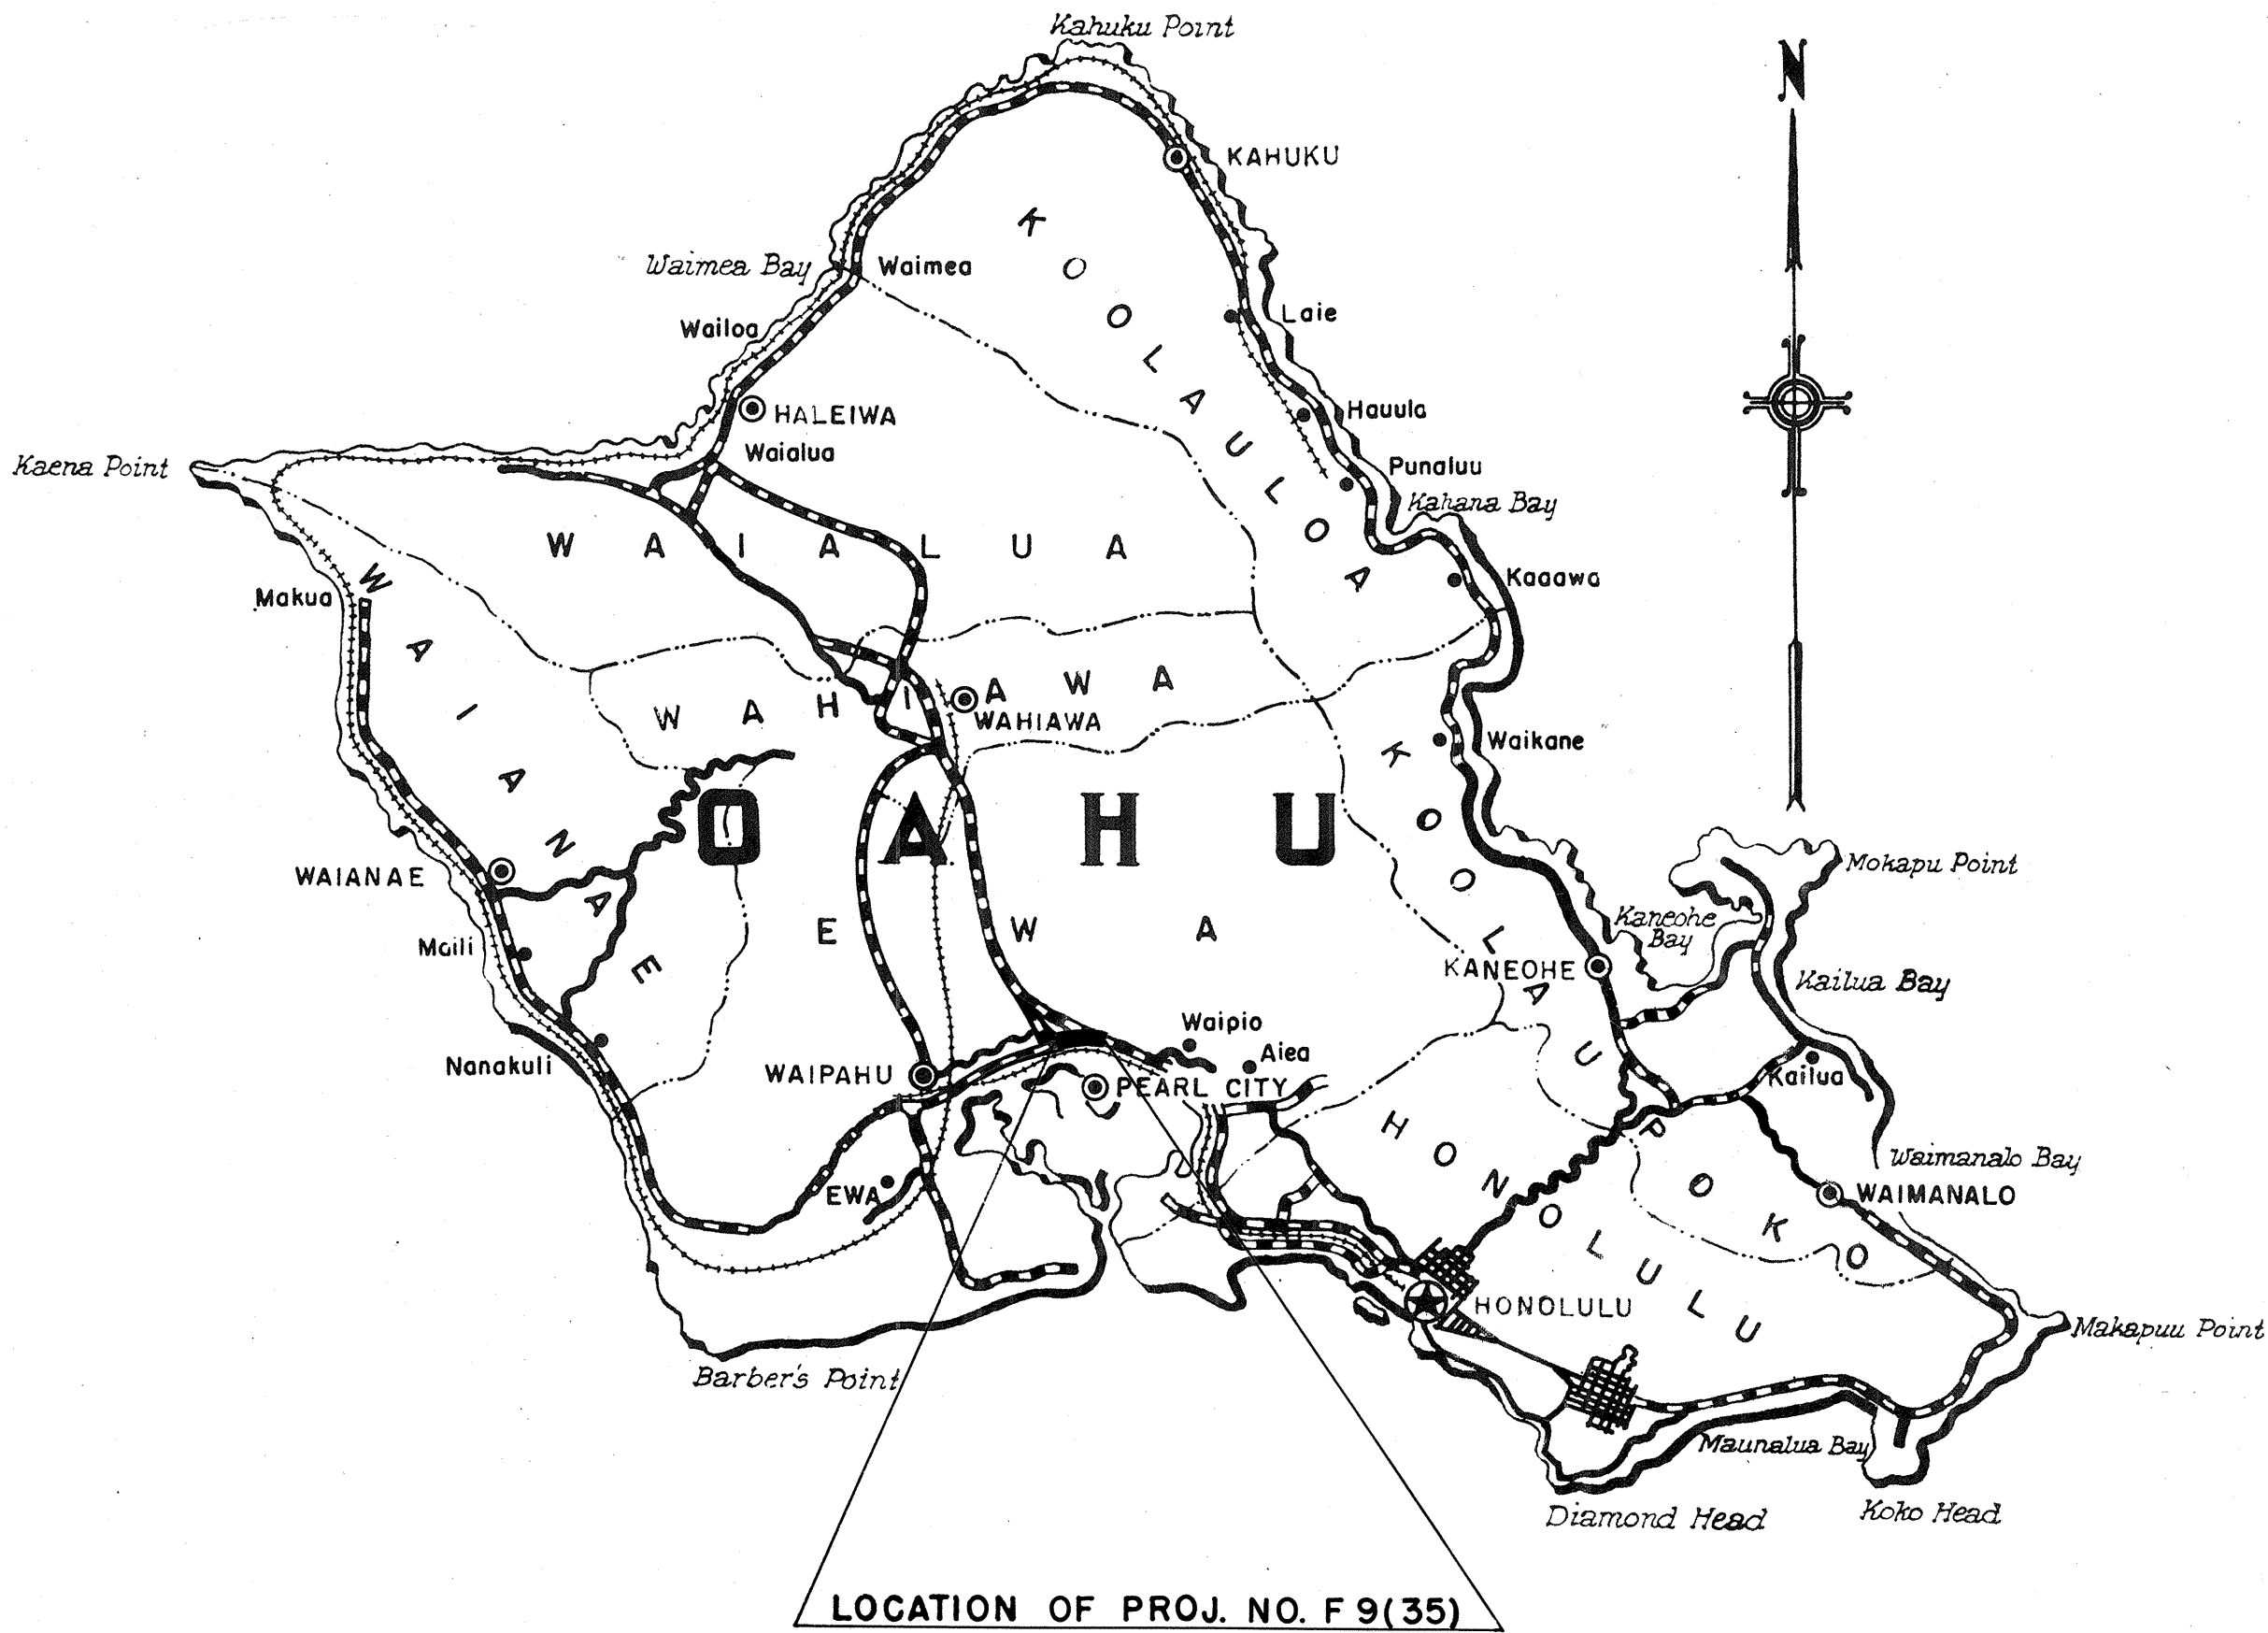

Federal Aid Projects Previously Constructed Or Under Construction

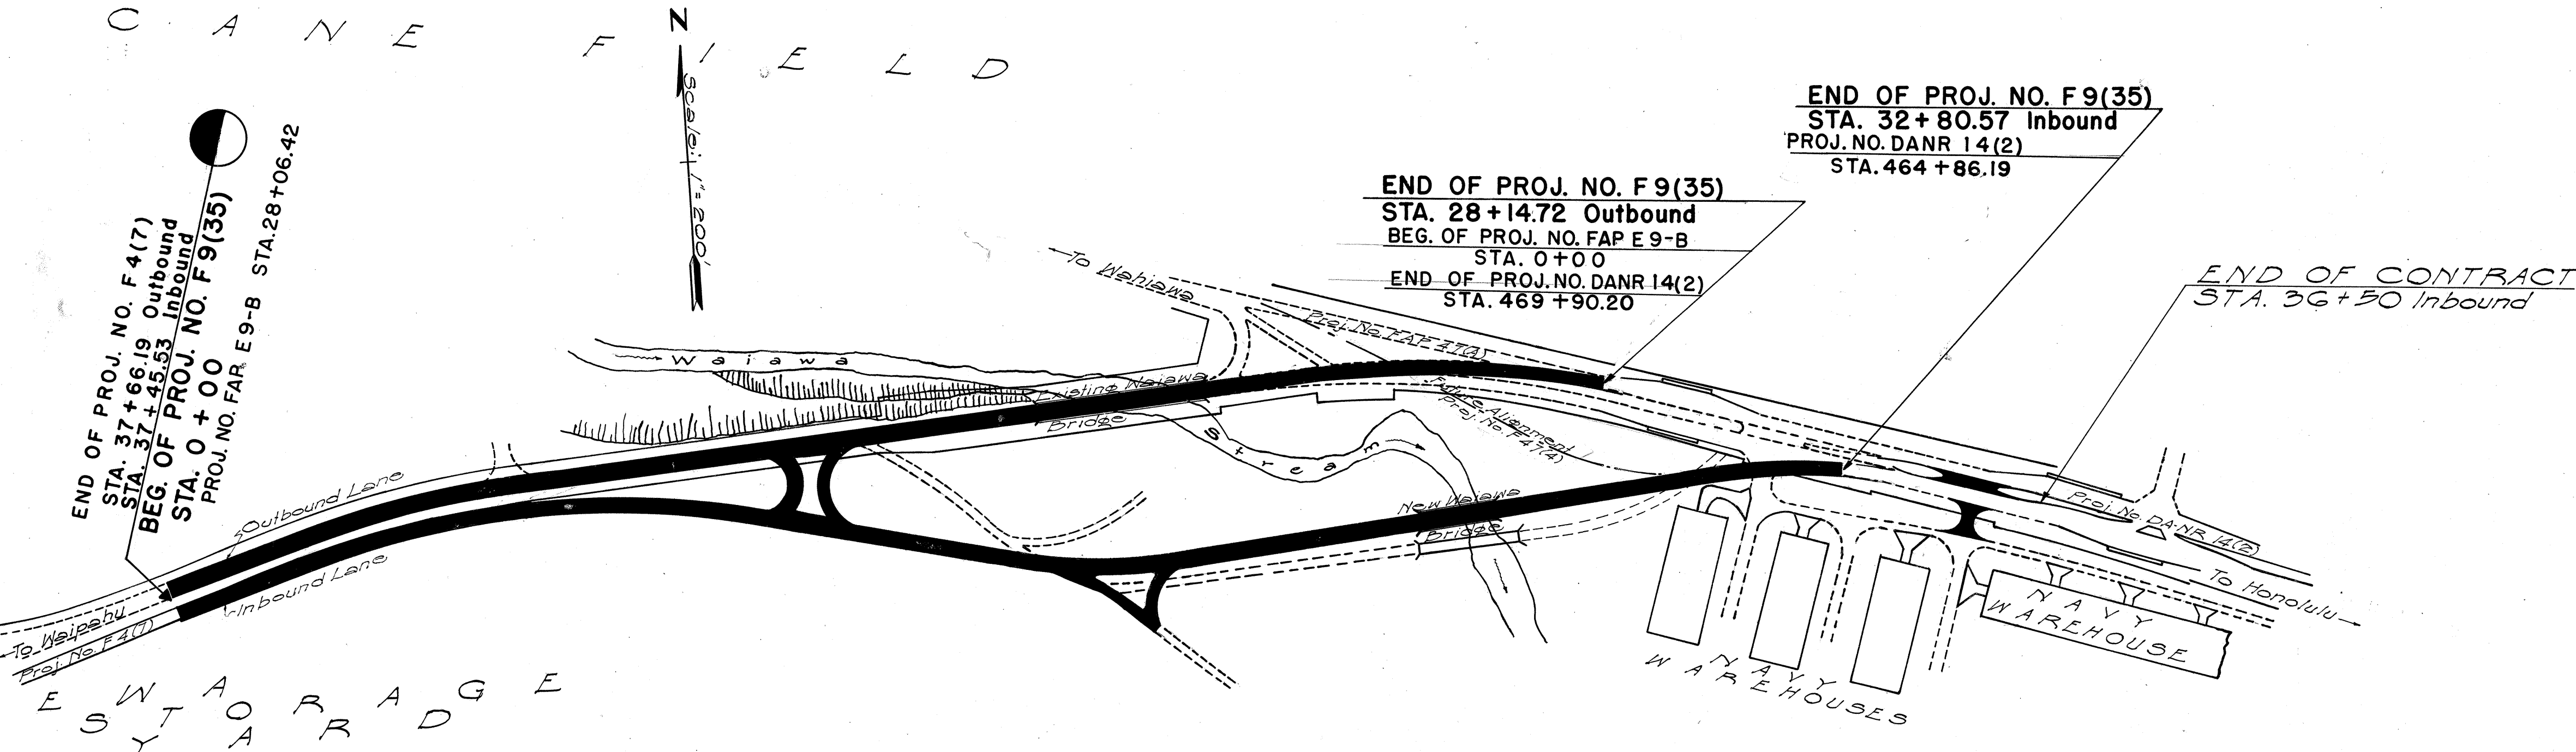

NOTE:
ALL CHANGES MADE DURING CONSTRUCTION
HAVE BEEN NOTED IN RED ON THESE
TRACINGS AND CHECKED BY:

Albert C. Fane
RESIDENT ENGINEER

9-15-52
DATE

LAYOUT OF PROJECT

Gross Length of Project.....0.277 Mile
Bridges Over 20 Ft. Span.....0.090 Mile
Net Length of Roadway.....0.227 Mile

APPROVED
[Signature]
TERRITORIAL HIGHWAY ENGINEER

DEPARTMENT OF COMMERCE BUREAU OF PUBLIC ROADS	
RECOMMENDED FOR APPROVAL:	
DISTRICT ENGINEER	DATE
APPROVED:	
DIVISION ENGINEER	DATE