

FED. ROAD DIST. NO.	STATE	FED. AID PROJ. NO.	FISCAL YEAR	SHEET NO.	TOTAL SHEETS
HAWAII	HAW	F4(7)	1951	7	25

B-51
C-B-51

COMPOUND CURVE

DATA	FOR
1. 14.45.00	
2. 18.36.00	
3. 18.36.00	
4. 18.36.00	
5. 18.36.00	
6. 18.36.00	

LEGEND

- AC Pavement
- Type "A" Cast-in-place Conc. Curb
- Type "B" Cast-in-place Conc. Curb
- Type "C" Cast-in-place Conc. Curb

NOTES:

Use Type "C" Cast-in-place Conc. Curb at all places.
For Details of Cast-in-place Conc. Curbs, see Standard Details.

TERRITORIAL HIGHWAY DEPARTMENT
TERRITORY OF HAWAII

INTERSECTION DETAIL
WAI'PAHU JUNCTION

PROJ. No. F-7(21) UNIT 1
PROJ. No. F-4 (?)

Scale: 1" = 20'

Jan 1951

SHEET NO. 1 OF 2 SHEETS

5548.4 5477.7

FED. ROAD DIST. NO.	STATE	FED. AID PROJ. NO.	FISCAL YEAR	SHEET NO.	TOTAL SHEETS
HAWAII	HAW	F 4(7)	1951	8	25
HAWAII	HAW	F 4(7) Unit 1	1951	8	15


5-51
6-51

LEGEND

- AC Pavement
- Type "A" Cast-in-place Conc. Curb
- Type "B" Cast-in-place Conc. Curb
- Type "C" Cast-in-place Conc. Curb

NOTES:

Use Type "C" Cast-in-place Conc. Curb at all angles.
For Details of Cast-in-place Conc. Curbs, see Standard Details.

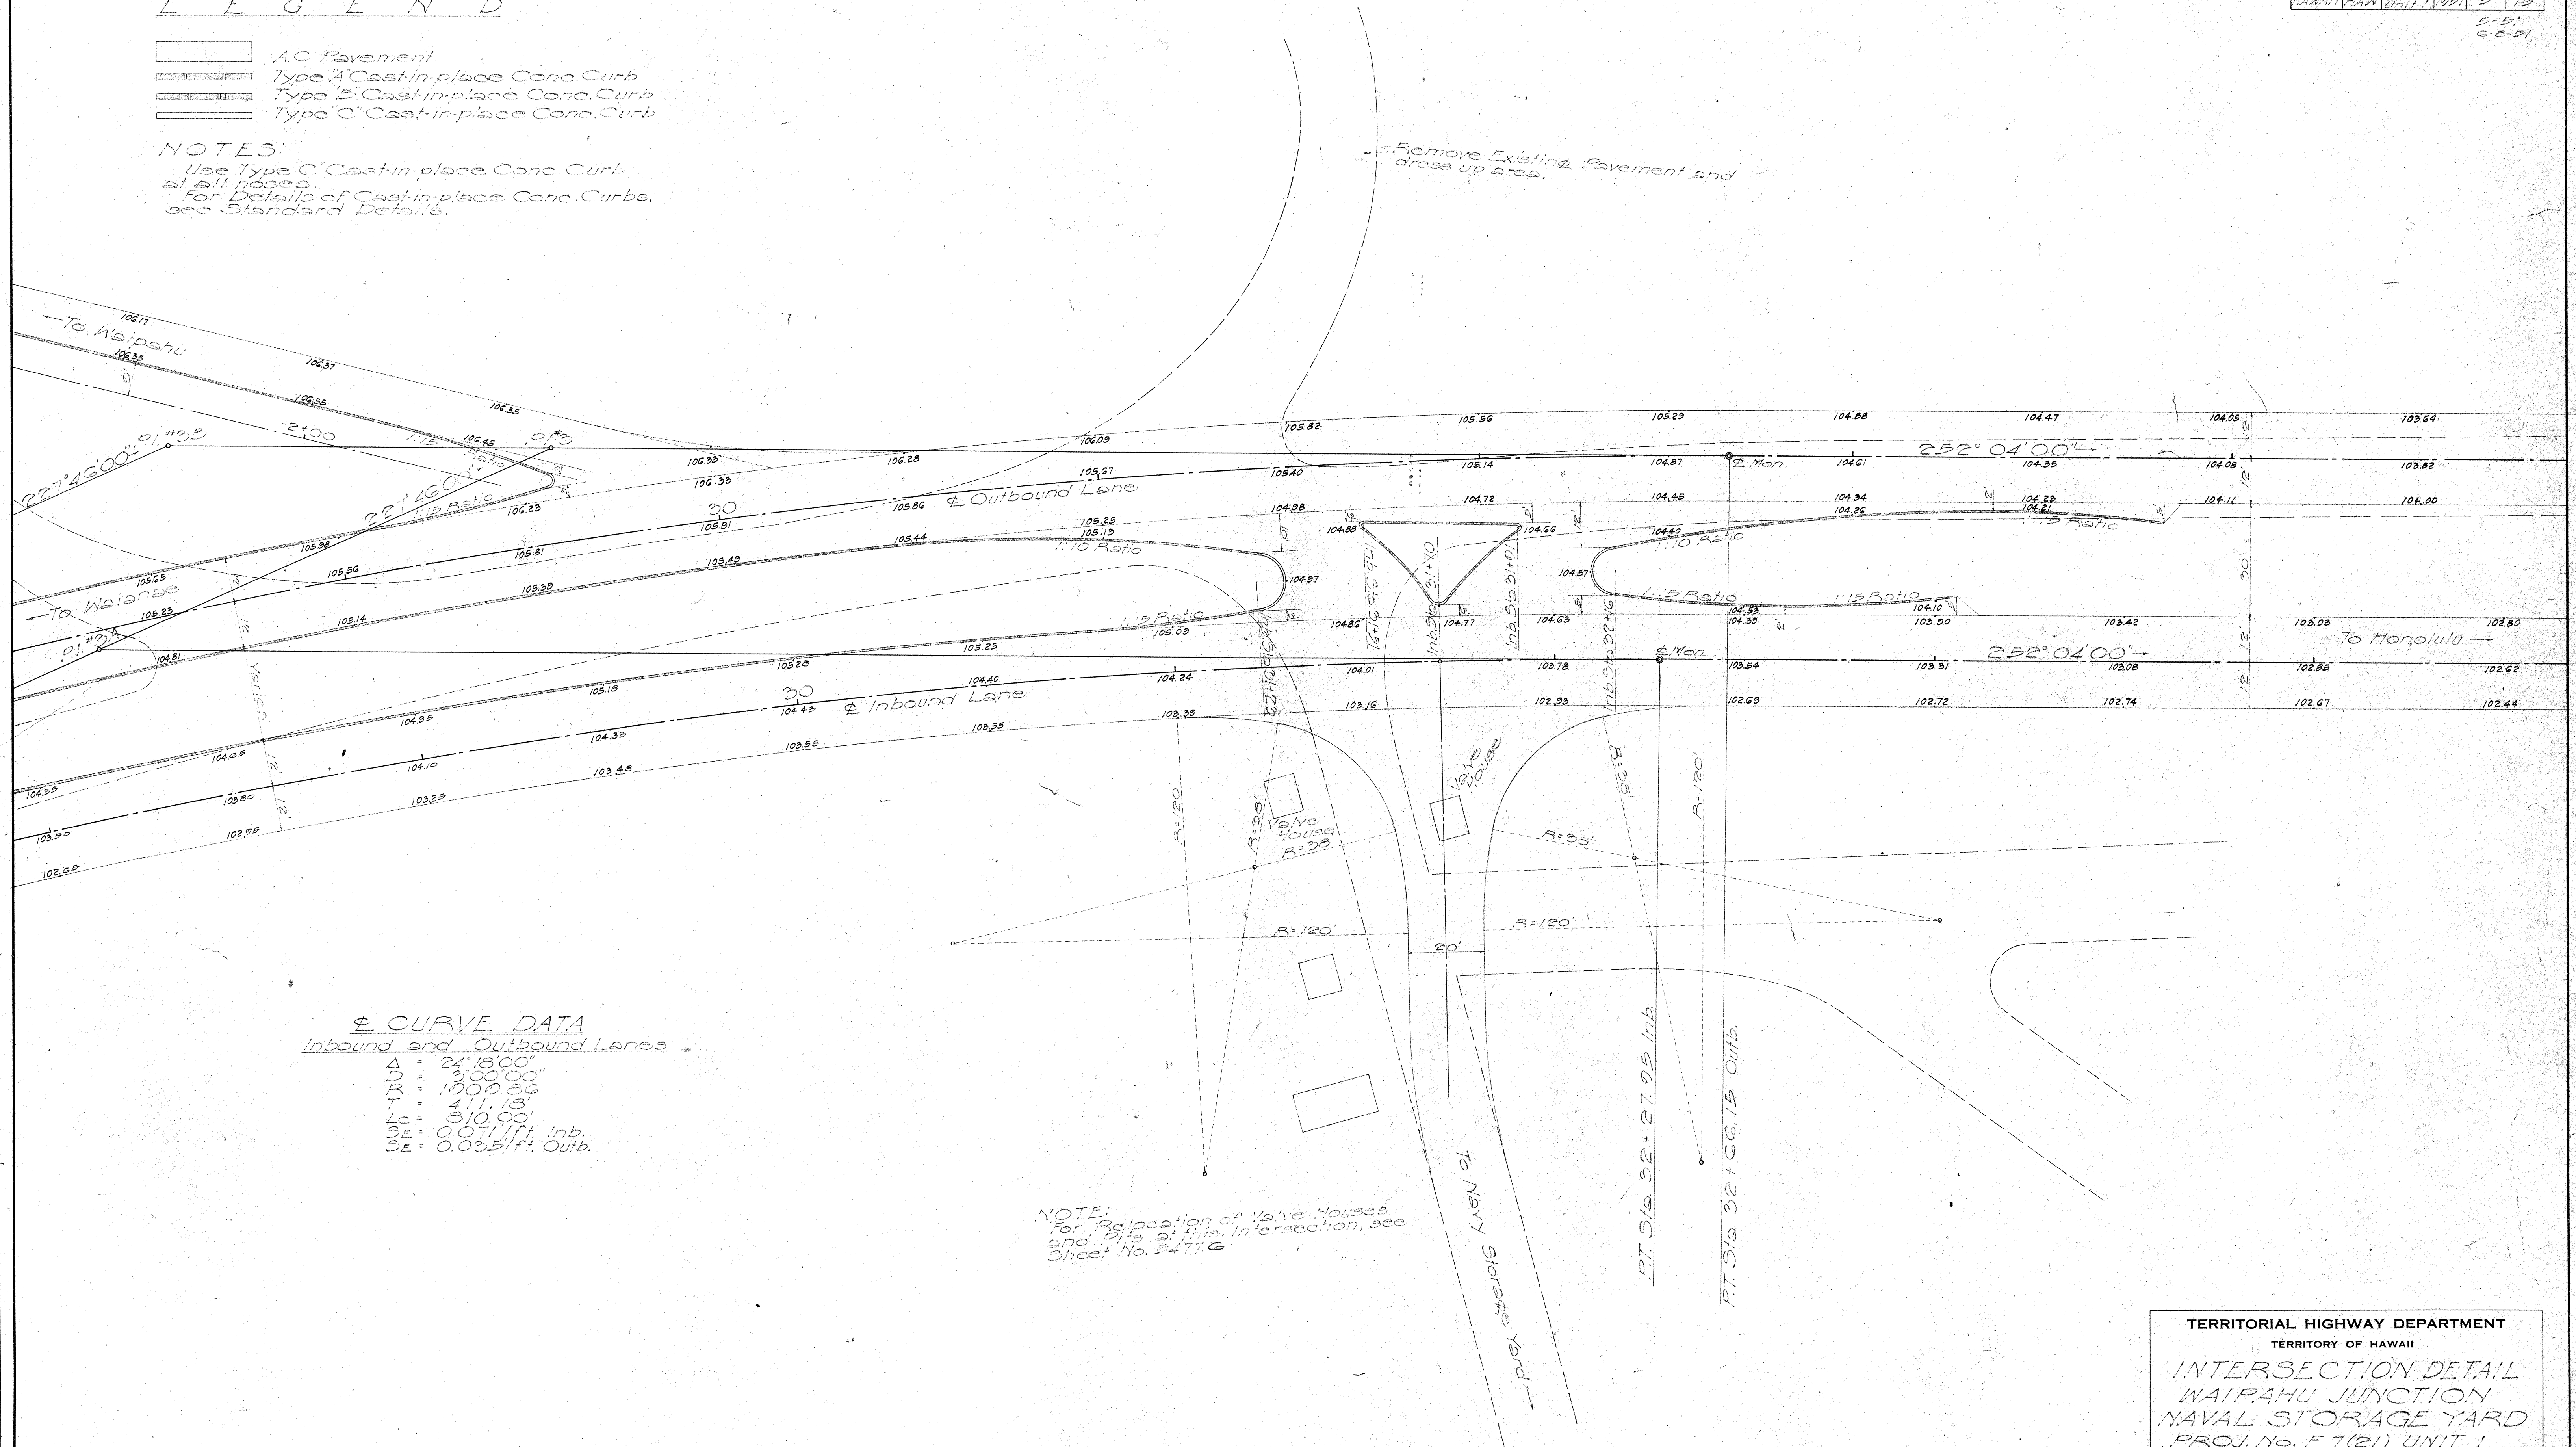

CURVE DATA Inbound and Outbound Lanes

Δ = 24° 18' 00"
L = 1000.00'
T = 411.18'
S = 510.00'
SE = 0.07117 Inb.
SE = 0.03571 Outb.

NOTE:
For Relocation of Valve Houses
and Data at this Intersection, see
Sheet No. 2471.6

TERRITORIAL HIGHWAY DEPARTMENT
TERRITORY OF HAWAII
INTERSECTION DETAIL
WAIPAHAU JUNCTION
NAVAL STORAGE YARD
PROJ. No. F 7(21) UNIT 1
PROJ. No. F 4(7)
Scale: 1"=50' Jan 1951

SHEET No. 2 OF 2 SHEETS

5548.5 5477.8