

INDEX TO DRAWINGS	
SHEET NO.	DESCRIPTION
1	TITLE SHEET
2	TYPICAL SECTION
3	PLAN & PROFILE
4-5	INTERSECTION DETAILS
6-10	STANDARD DETAILS
11-15	CROSS SECTIONS

CONVENTIONAL SIGNS	
Centerline	125
Boundary Lines	, or
Fences (Named)	
Existing Roadways	
Circular Culvert	
Box Culvert	
Bridge	
Telephone Pole	T.P.
Electric Power Pole	E.P.
Water Main	W ₂ W ₂ (W ₄ , 8, 12, Etc.)
Storm Drain	SD ₁₂ SD ₁₂ (SD ₁₈ , 24, Etc.)
Concrete Drop Intake	C.D.I.
Standard Catch Basin	S.C.B.
Standard Manhole	M.H.S.
Sewer Manhole	S.S. S.S. S ₁₂
Telephone Manhole	T.M.H.
Fire Hydrant	F.H.
Tree (Large, named)	Mango Coco
Railroad	
Mutual Telephone Underground Cable	MTC
Water Meter	WM

DATE	DESIGNED BY	CHECKED BY
PLAN	NOTED BY	CHECKED BY
NOTE BOOK	QUANTITIES BY	CHECKED BY
No.	DESIGNED BY	CHECKED BY



TERRITORY OF HAWAII
TERRITORIAL HIGHWAY DEPARTMENT
HONOLULU, OAHU, T. H.

PLANS OF
KAMEHAMEHA HIGHWAY

FEDERAL AID PROJECT NO.F 7(2I) UNIT I

DISTRICT OF EWA
ISLAND OF OAHU

SCALES	
PLAN	1 IN. = 50 FT.
PROFILE	HOR. 1 IN. = 50 FT.
	VERT. 1 IN. = 10 FT.
CROSS SECTION	HOR. 1 IN. = 10 FT.
	VERT. 1 IN. = 10 FT.

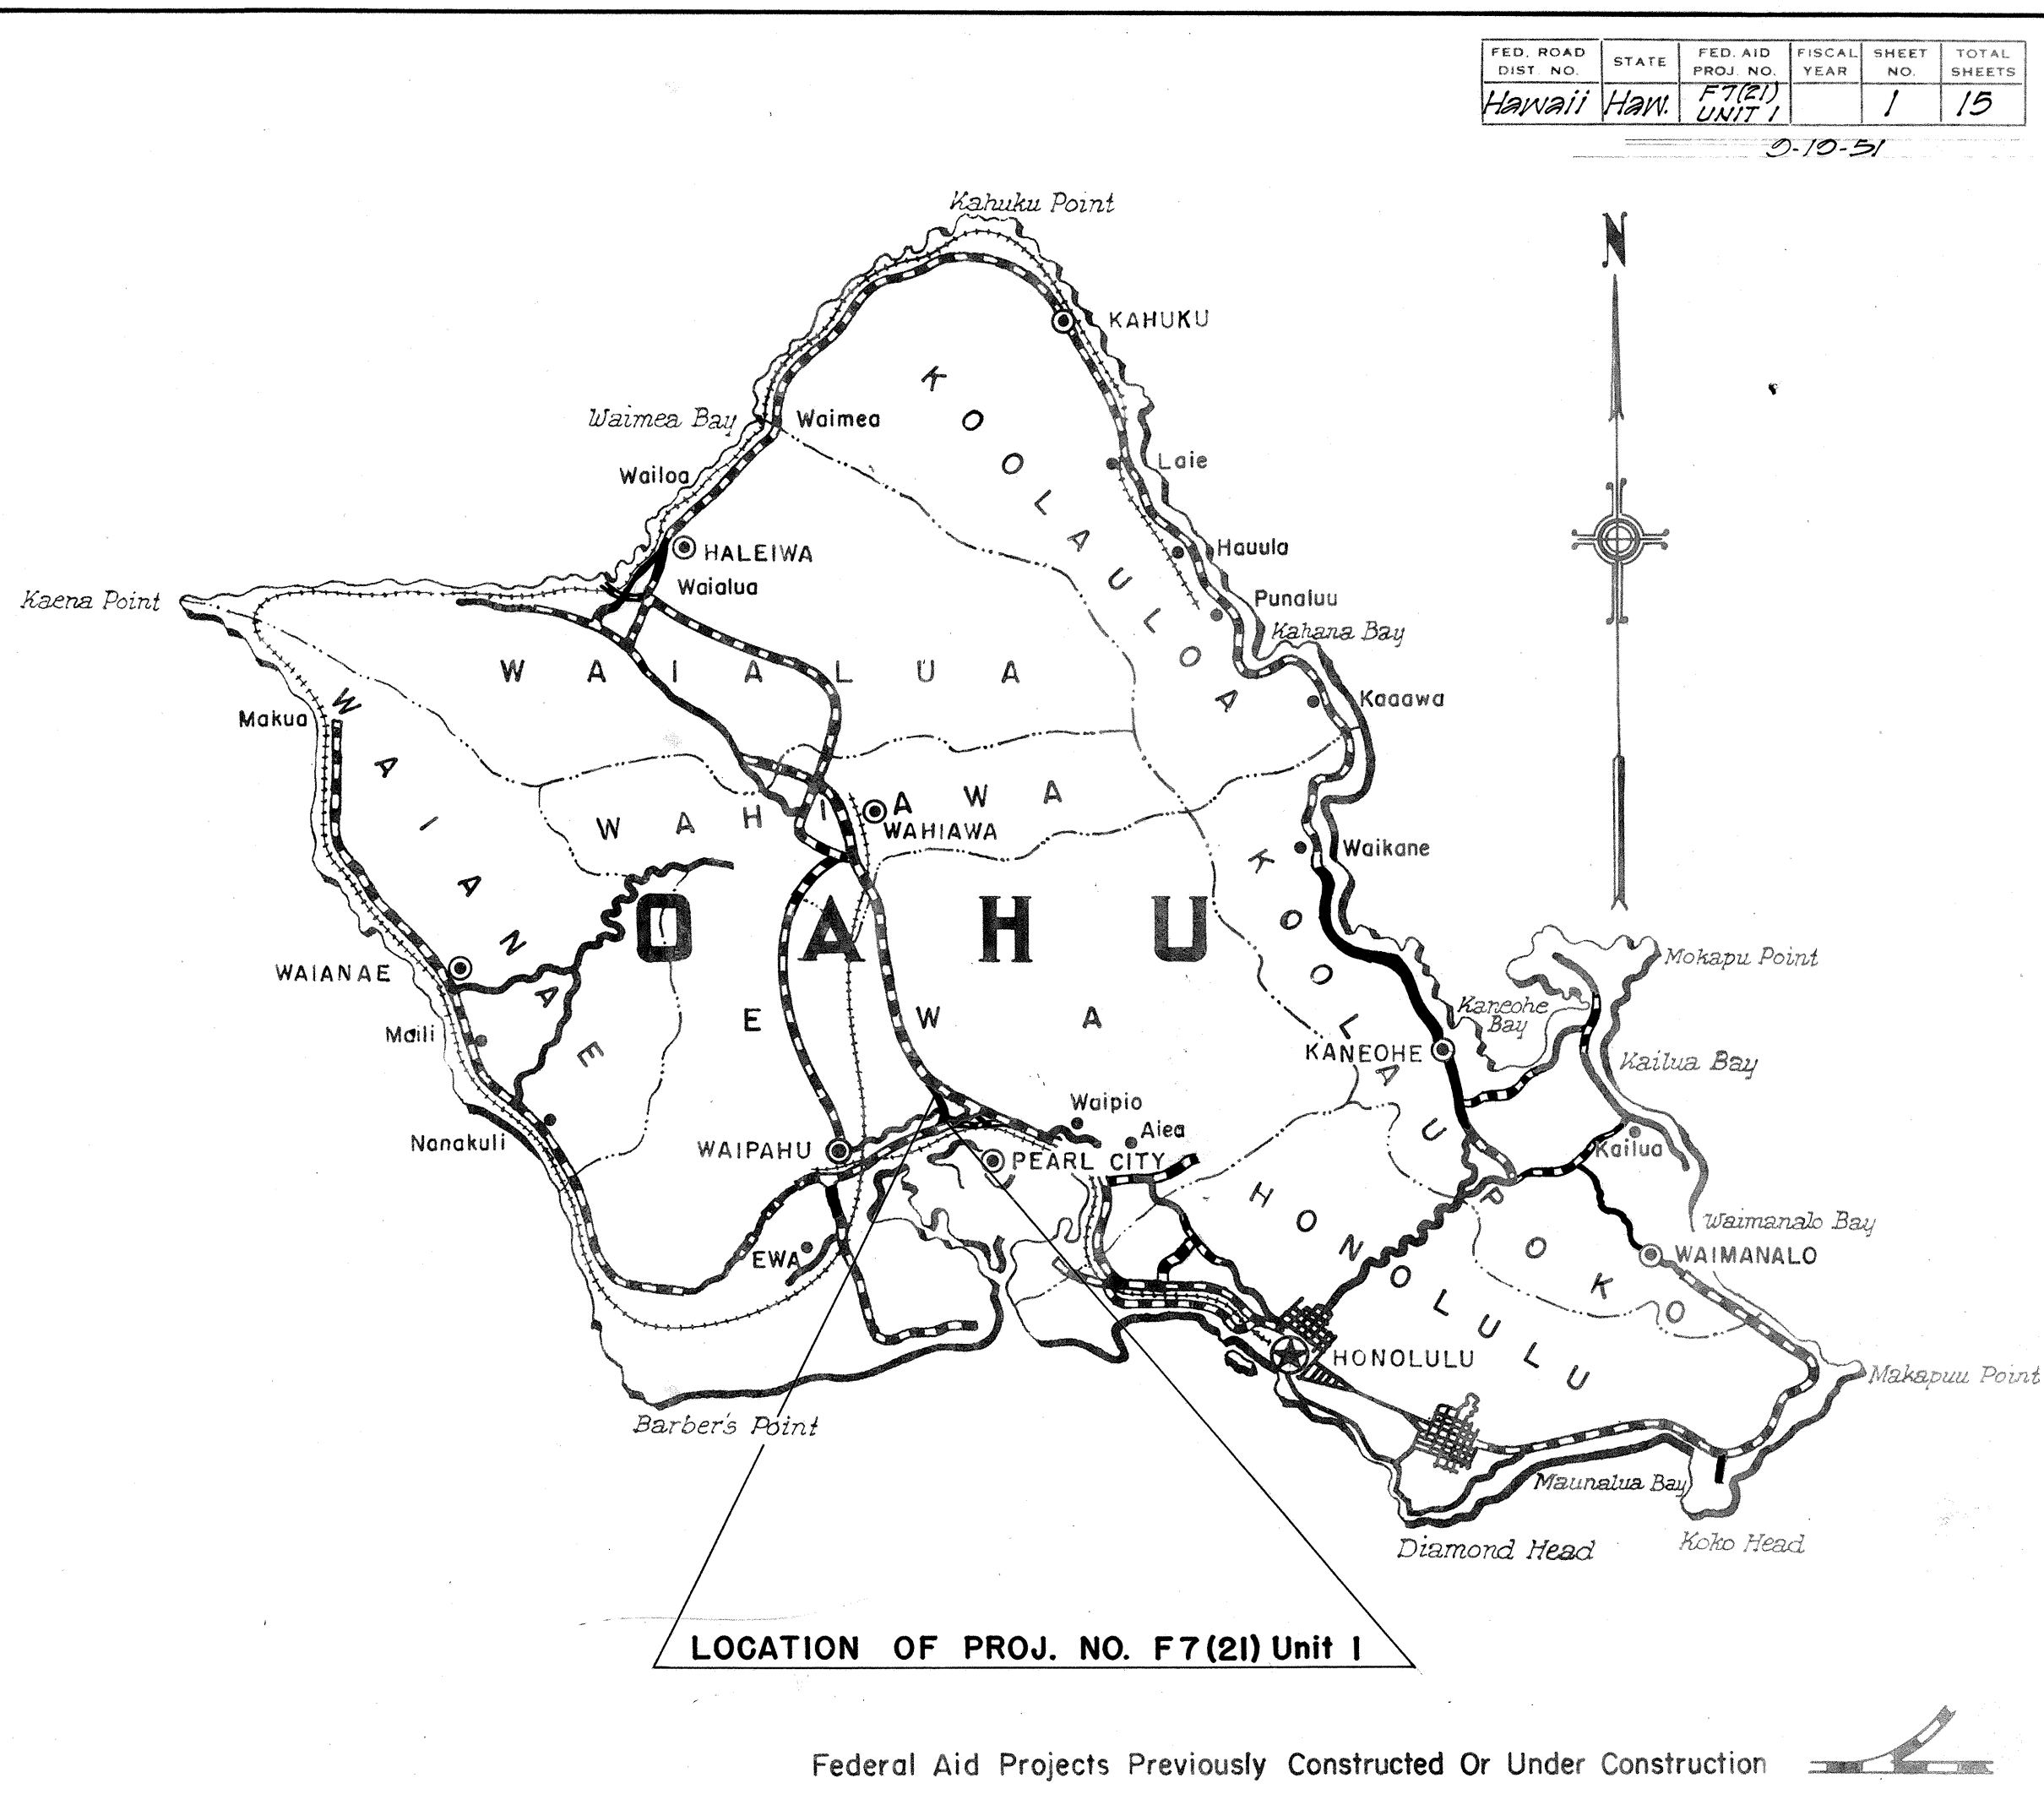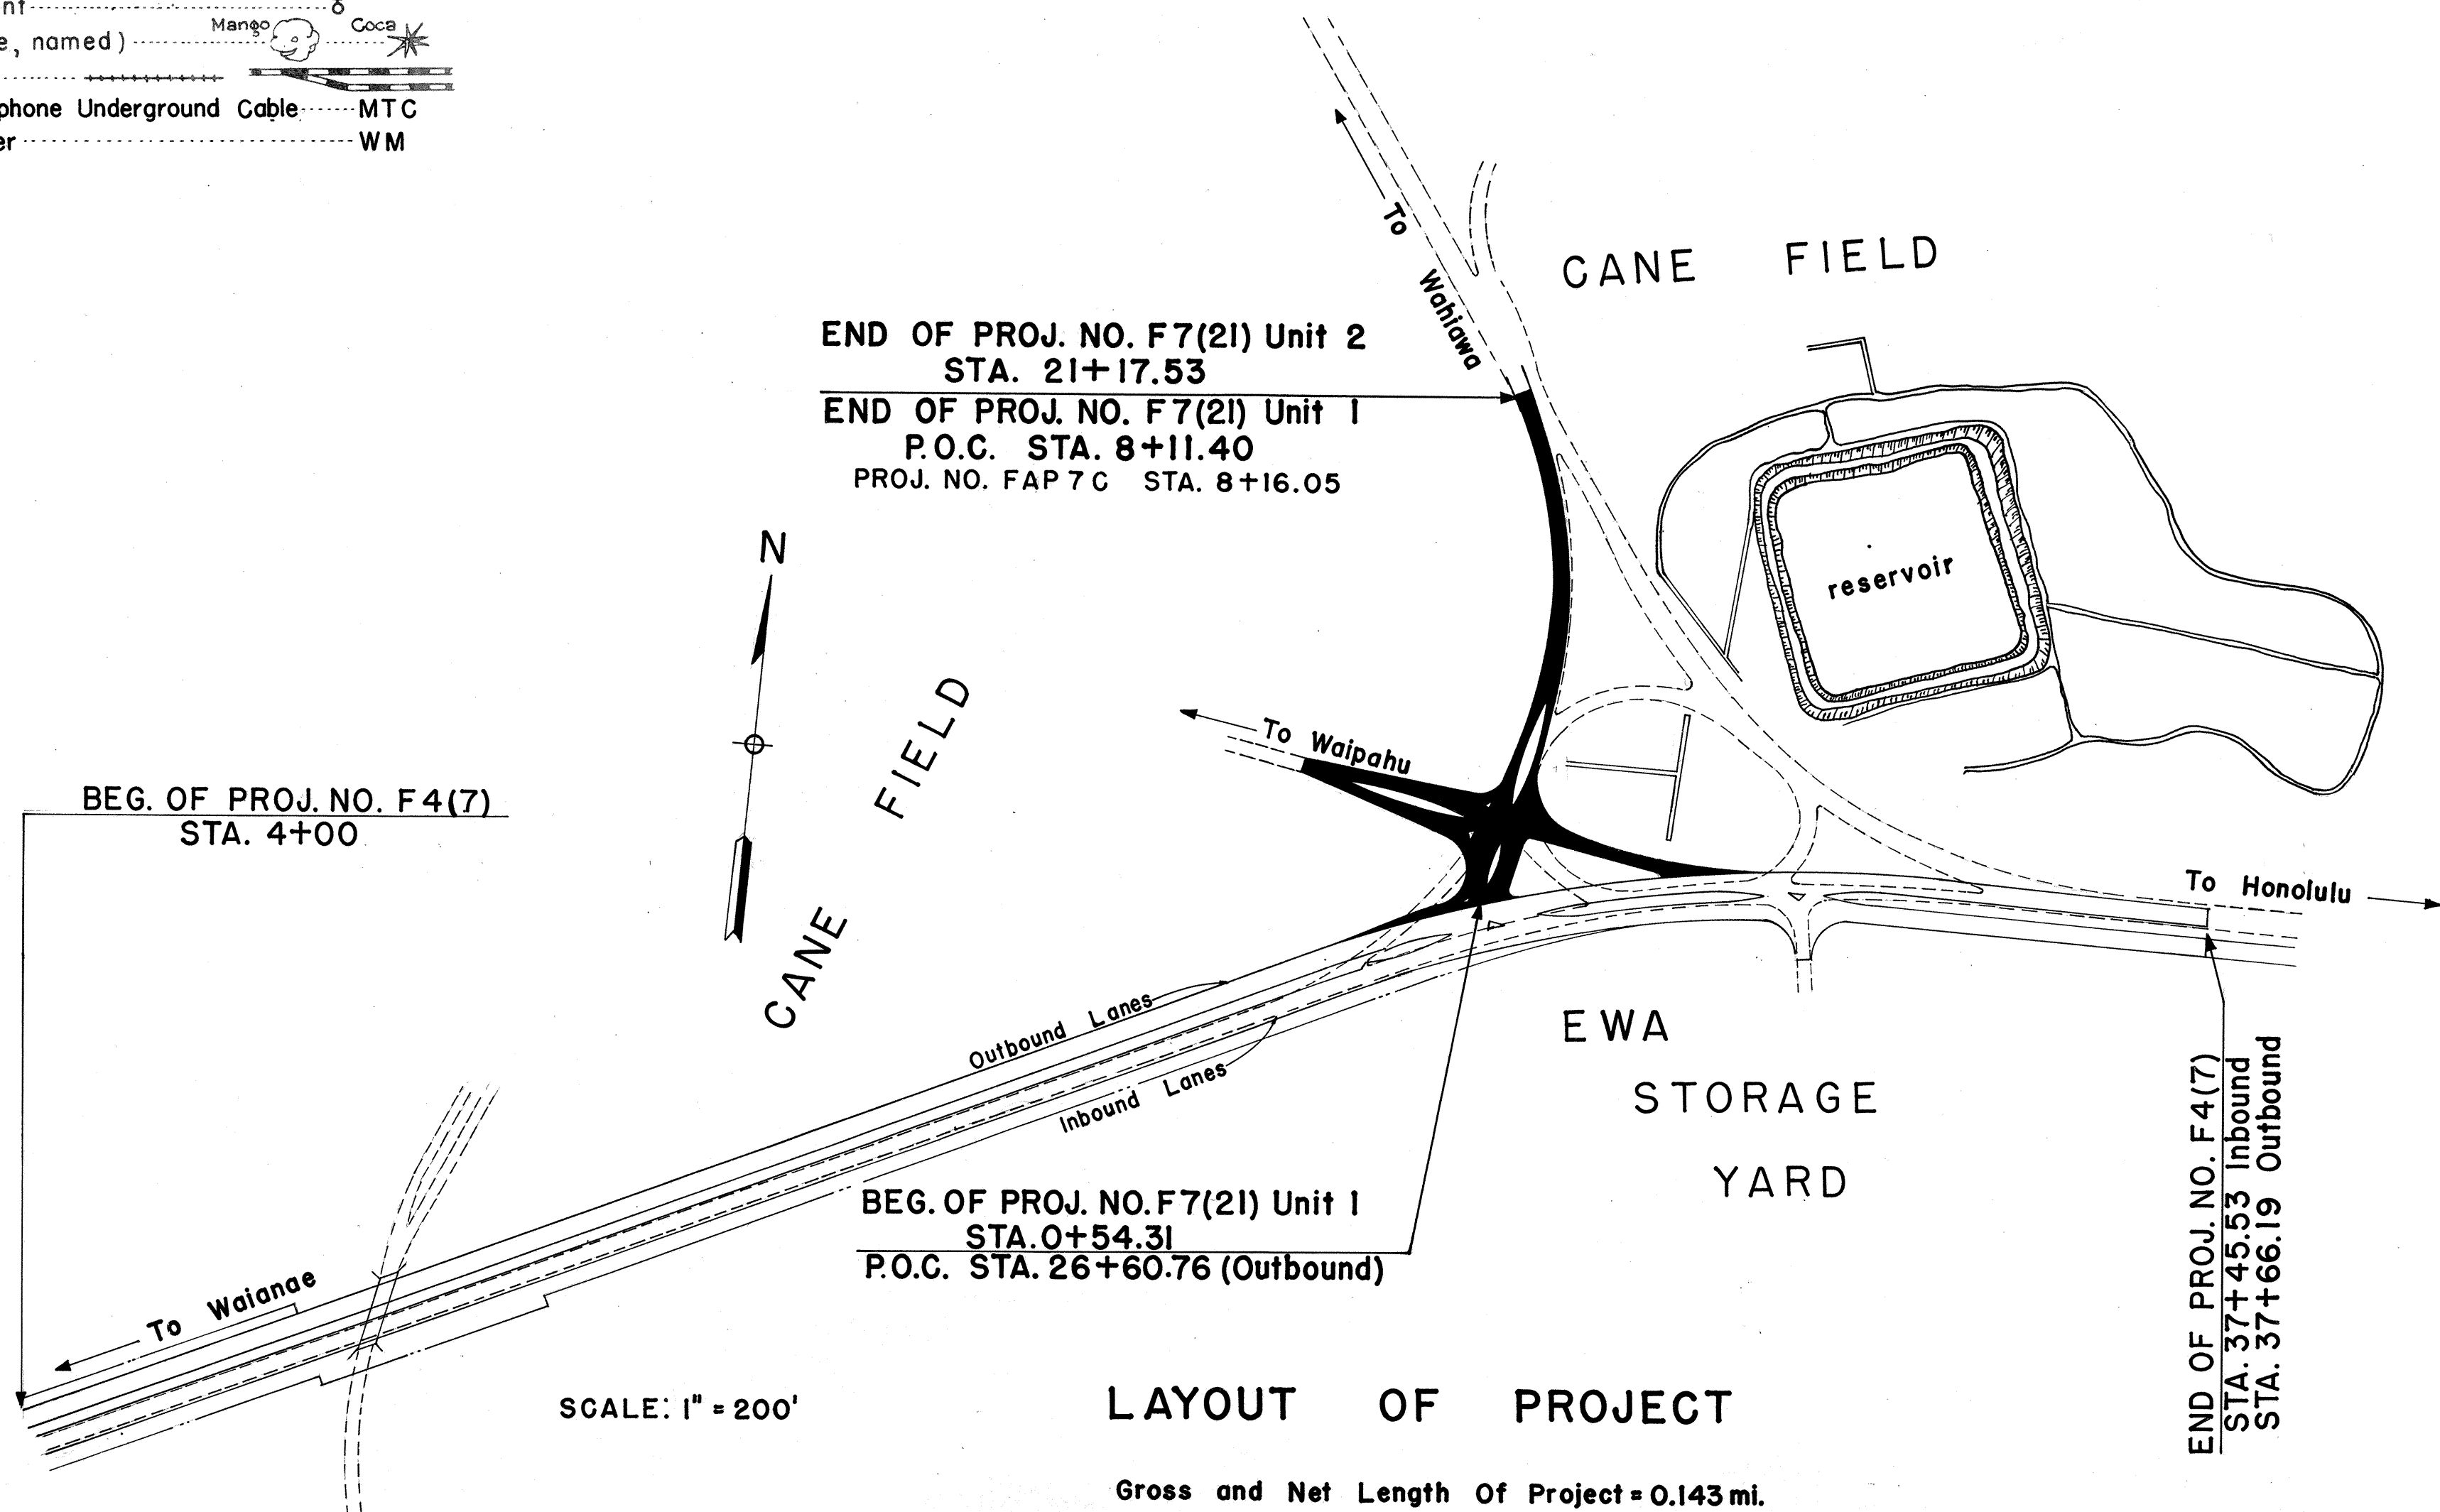

NOTE:
ALL CHANGES MADE DURING CONSTRUCTION
HAVE BEEN NOTED IN RED ON THESE TRACINGS
AND CHECKED BY:

[Signature]
RESIDENT ENGINEER
6/24/1952
DATE

APPROVED *[Signature]* DATE 6/23/51
TERRITORIAL HIGHWAY ENGINEER

DEPARTMENT OF COMMERCE BUREAU OF PUBLIC ROADS	
RECOMMENDED FOR APPROVAL:	
DISTRICT ENGINEER	DATE
APPROVED:	
DIVISION ENGINEER	DATE