


NOTE:
For Grades at Divided Highway and at Connections see Intersection Details, Sheets No. 5548.4 and No. 5548.5

TYPICAL SECTION ON DIVIDED HIGHWAY

Scale: 1/4" = 1'-0"

GENERAL NOTES ON PAVEMENT AND BASE COURSE

- (1) Pavement shall be Asphalt Concrete 2 1/2" thick when fully compacted, laid in two courses. A 1 1/2" Leveling Course using Mix No. III and a 1" Surface Course using Mix No. I.
- (2) Base Course shall be Waterbound Macadam Base Course of 8" compacted thickness laid in 2 layers of 4" compacted thickness each and consisting of Coarse Rock and Filler (1/2" to No. 100).
- Both above Courses subject to Specifications and Special Provisions.
- (3) Slow Curing Liquid Asphalt for Prime Coat shall be applied to the surface of the Base Course at the rate of 0.25 gal. per sq. yd. before placing the Leveling Course.

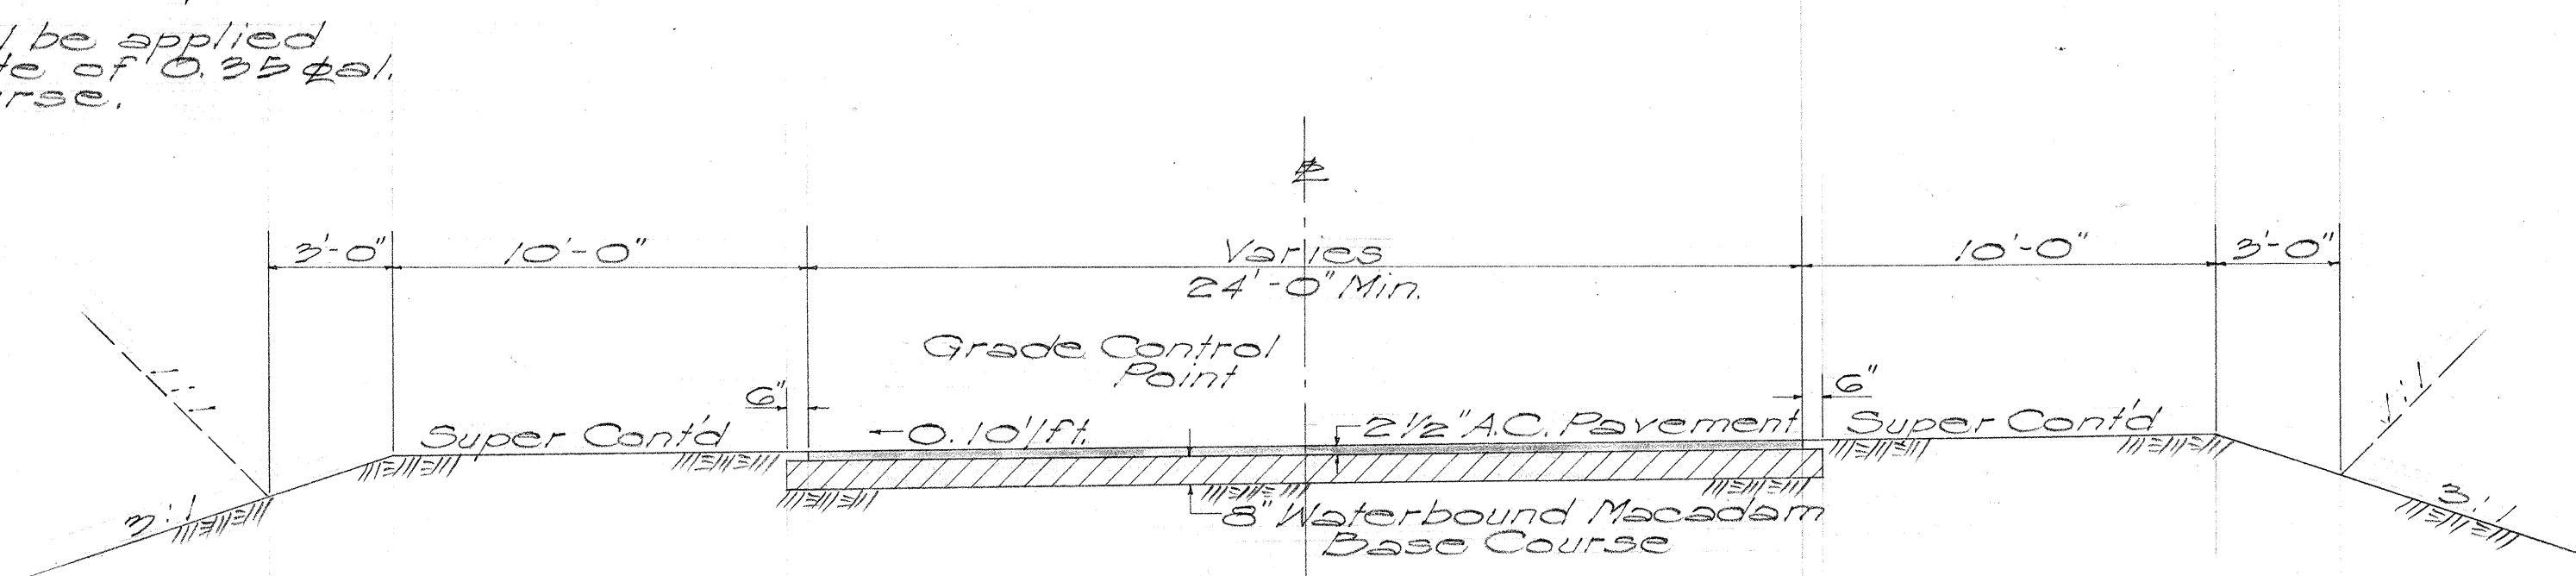

TYPICAL SECTION ON CURVE

Scale: 1/4" = 1'-0"

SURVEY PLOTTED BY	DATE
DESIGNED BY	
DRAWN BY	
CHECKED BY	
NOTE BOOK NO.	

TERRITORIAL HIGHWAY DEPARTMENT
TERRITORY OF HAWAII

TYPICAL SECTION
PROJ. No. F 7(21) UNIT 1

Scale: 1/4" = 1'-0" May 1951

SHEET No. OF SHEETS

5548.2