


GENERAL NOTES ON PAVEMENT AND BASE COURSE

1. Pavement shall be Asphalt Concrete 2 1/2" thick when fully compacted laid in two courses, a 1 1/2" Leveling Course using Mix No. III and a 1" Surface Course using Mix No. I.
2. Base Course shall be Waterbound Macadam Base Course of 8" compacted thickness laid in 2 layers of 4" compacted thickness each, and consisting of Coarse Rock and Filler (1/2" to No. 100). Both above Courses subject to Specification and Special Provisions.
3. Prime Coat of Slow Curing Liquid Asphalt shall be applied to the surface of Base Course at the rate of 0.35 gal. per sq. Yard before placing Leveling Course.

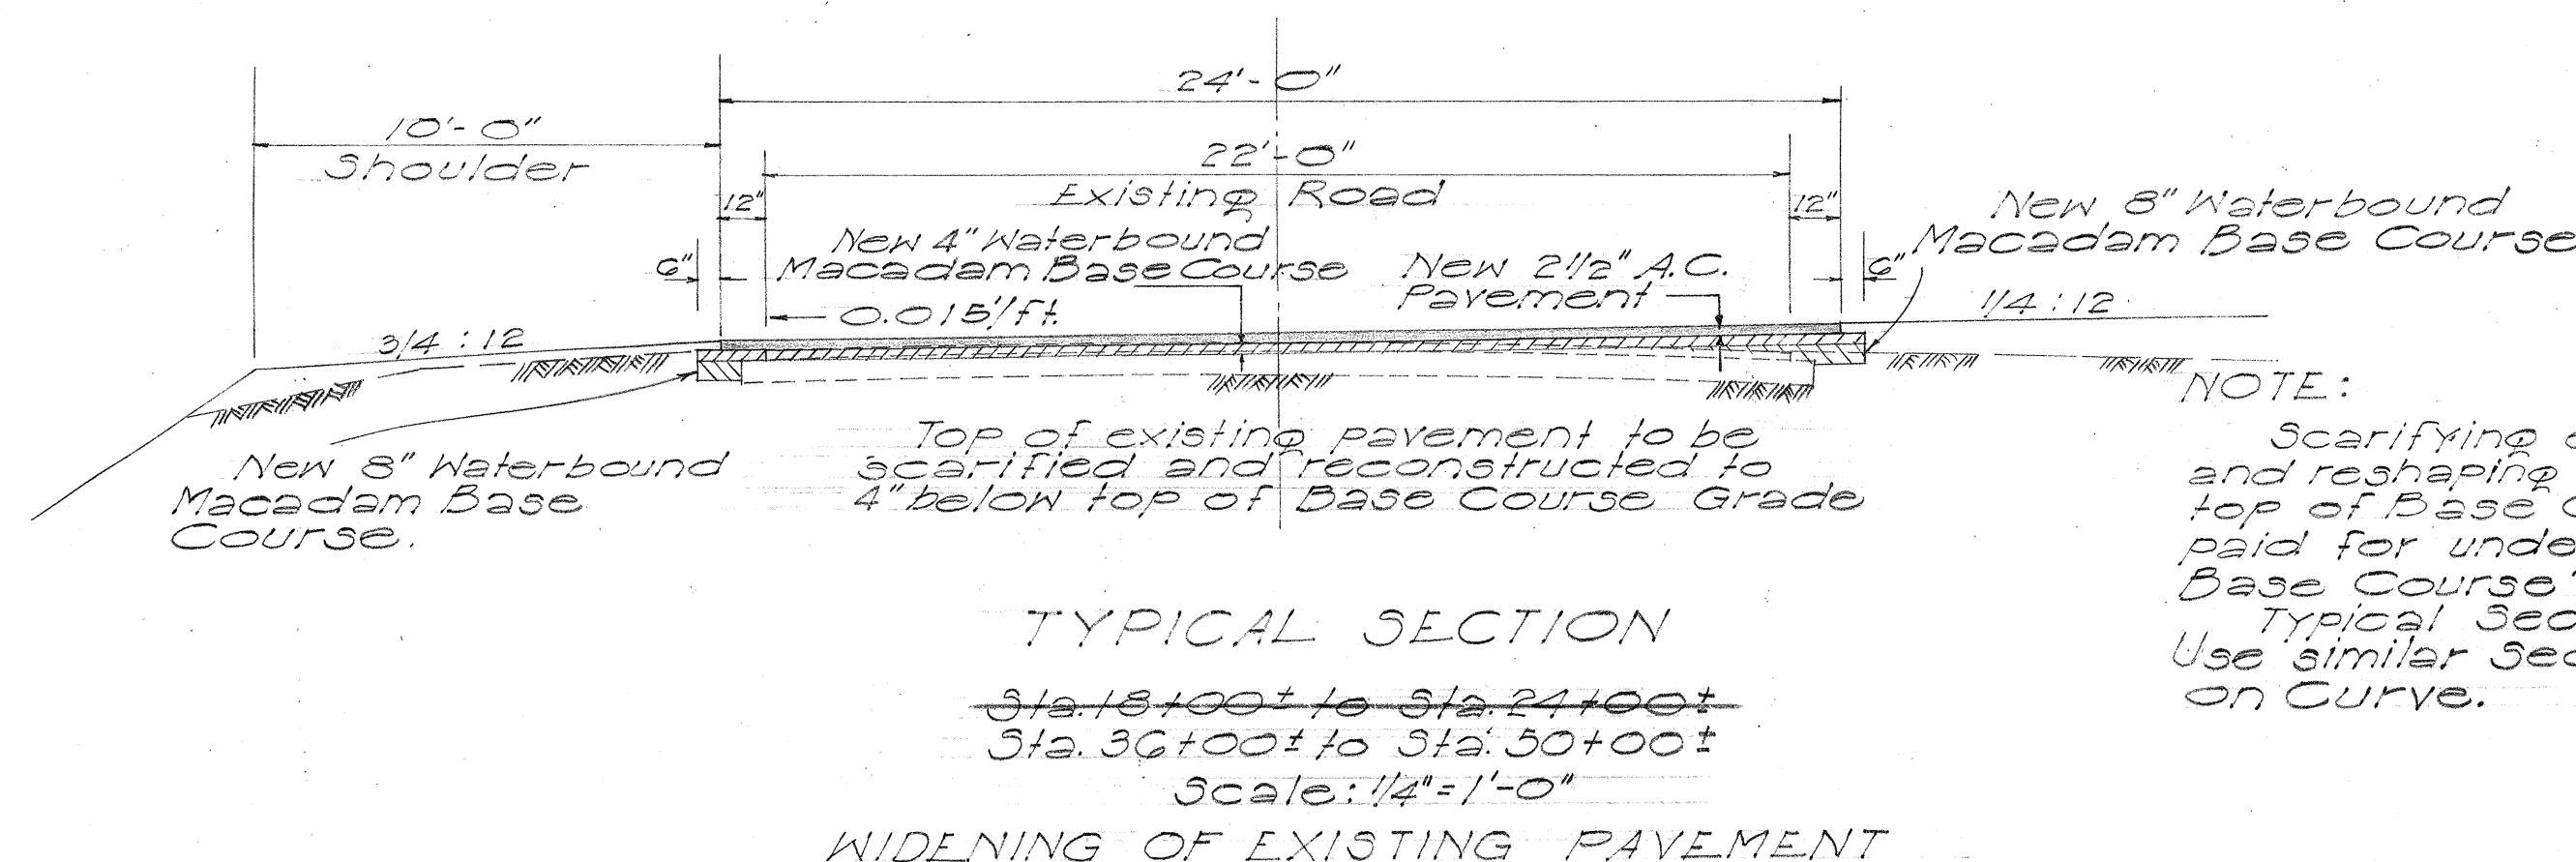

NOTE: Scarifying existing road surface and reshaping Base Course to 4" below top of Base Course grade will be paid for under "Reconstructed Rock Base Course" Per Sq. Yard. Typical Section on Tangent shown. Use similar Section with existing S.E. on Curve.

TERRITORIAL HIGHWAY DEPARTMENT
TERRITORY OF HAWAII

TYPICAL SECTIONS
WAIAWA CUTOFF
PROJECT NO. F47(4)

Scale: 1/4" = 1'-0" June, 1950

SHEET NO. OF SHEETS

5479.2