

INDEX TO DRAWINGS	
SHEET NO.	DESCRIPTION
1	TITLE SHEET
2	TYPICAL SECTION
3-5	PLAN & PROFILE
7-11	STANDARD DETAILS
12	STANDARD BRIDGE DETAILS
13-17	OVERCROSSING DETAILS
18-19	METAL FLUME DETAILS
19A-28	CROSS SECTIONS
6	TRAFFIC SIGNS
6A	RELOCATION OF VALVES


CONVENTIONAL SIGNS	
Centerline.....	125
Boundary Lines.....	or
Fences (Named).....	
Existing Roadways.....	
Circular Culvert.....	
Box Culvert.....	
Bridge.....	
Telephone Pole.....	
Electric Power Pole.....	
Water Main.....	W ₂ W ₂ (W ₄ , 8, 12, Etc.)
Storm Drain.....	SD ₁₂ SD ₁₂ (SD ₁₈ , 24, Etc.)
Concrete Drop Intake.....	
Standard Catch Basin.....	
Standard Manhole.....	M.H.S.
Sewer Manhole.....	S ₈ S ₈ S ₁₂
Telephone Manhole.....	T.M.H.
Fire Hydrant.....	F.H.
Tree (Large, named).....	Mango
Railroad.....	
Mutual Telephone Underground Cable.....	MTC
Water Meter.....	WM

TERRITORY OF HAWAII
TERRITORIAL HIGHWAY DEPARTMENT
HONOLULU, OAHU, T. H.

PLANS OF KAMEHAMEHA HIGHWAY FEDERAL AID PROJECT NO.F7(21) UNIT 2


DISTRICT OF EWA
ISLAND OF OAHU

SCALES	
PLAN	1 IN. = 50 FT.
PROFILE	HOR. 1 IN. = 50 FT.
	VERT. 1 IN. = 10 FT.
GROSS SECTION	HOR. 1 IN. = 10 FT.
	VERT. 1 IN. = 10 FT.

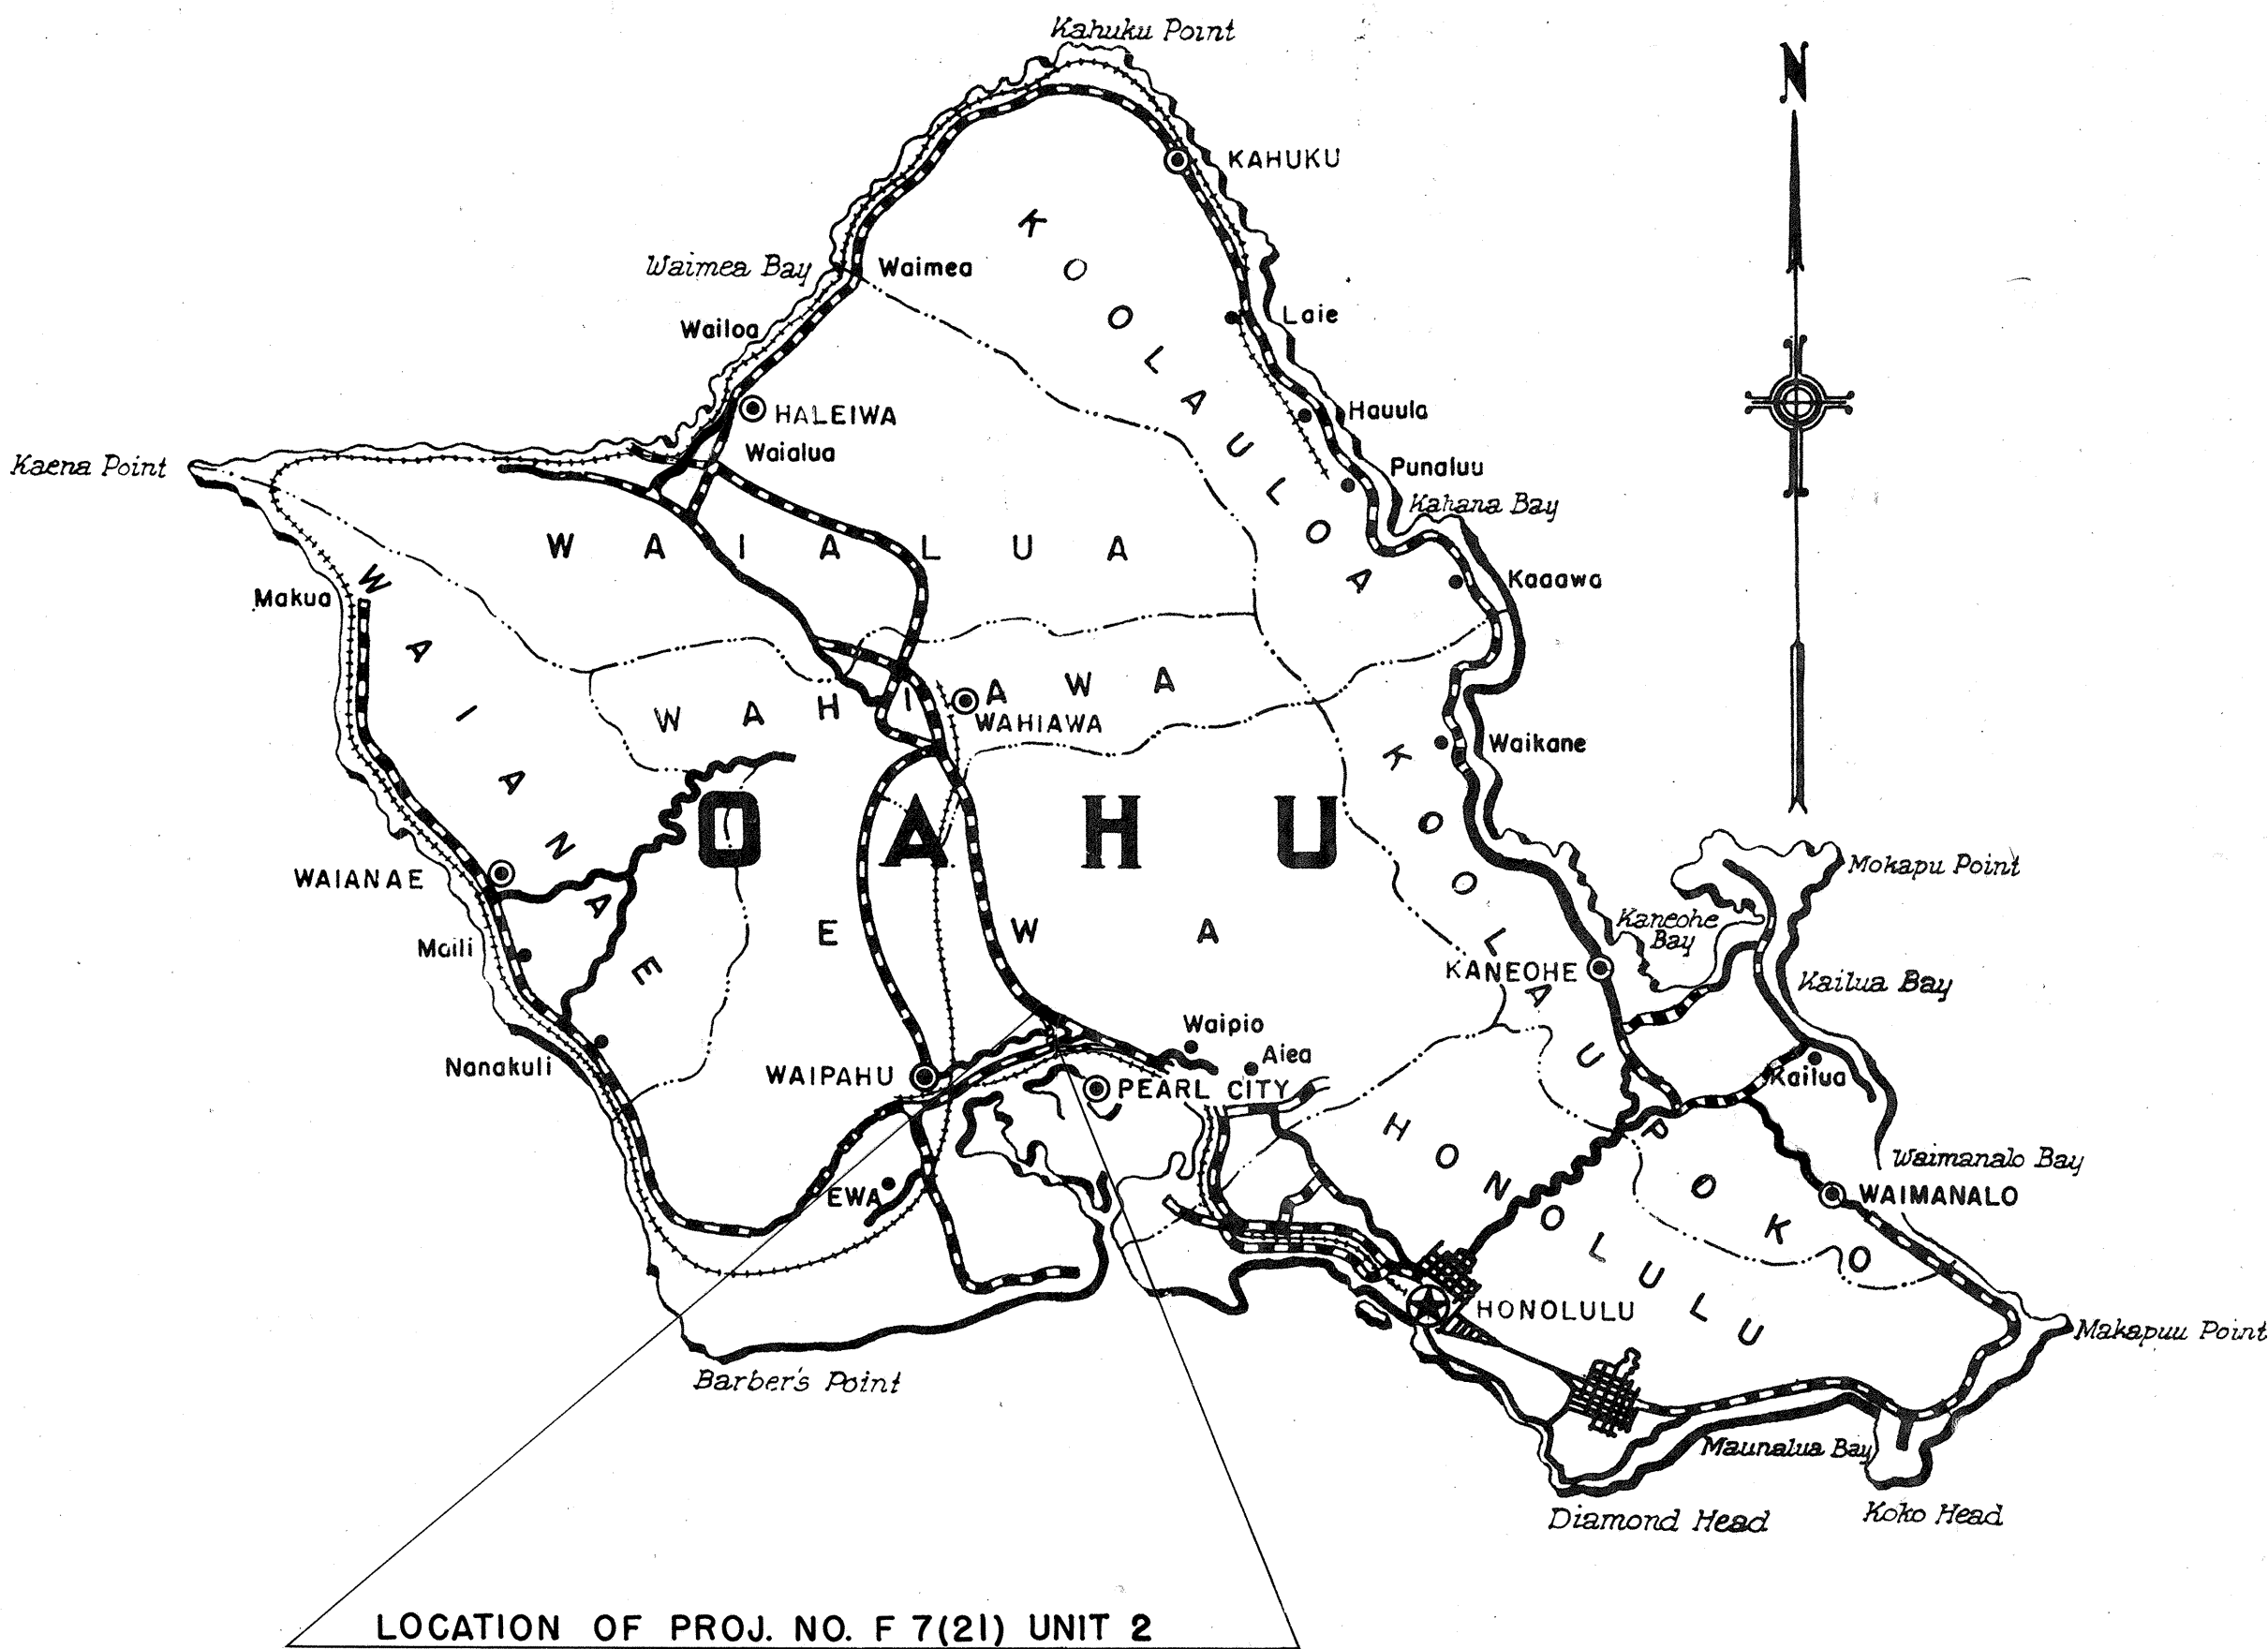

Federal Aid Projects Previously Constructed Or Under Construction

LAYOUT OF PROJECT
Scale: 1"= 200'

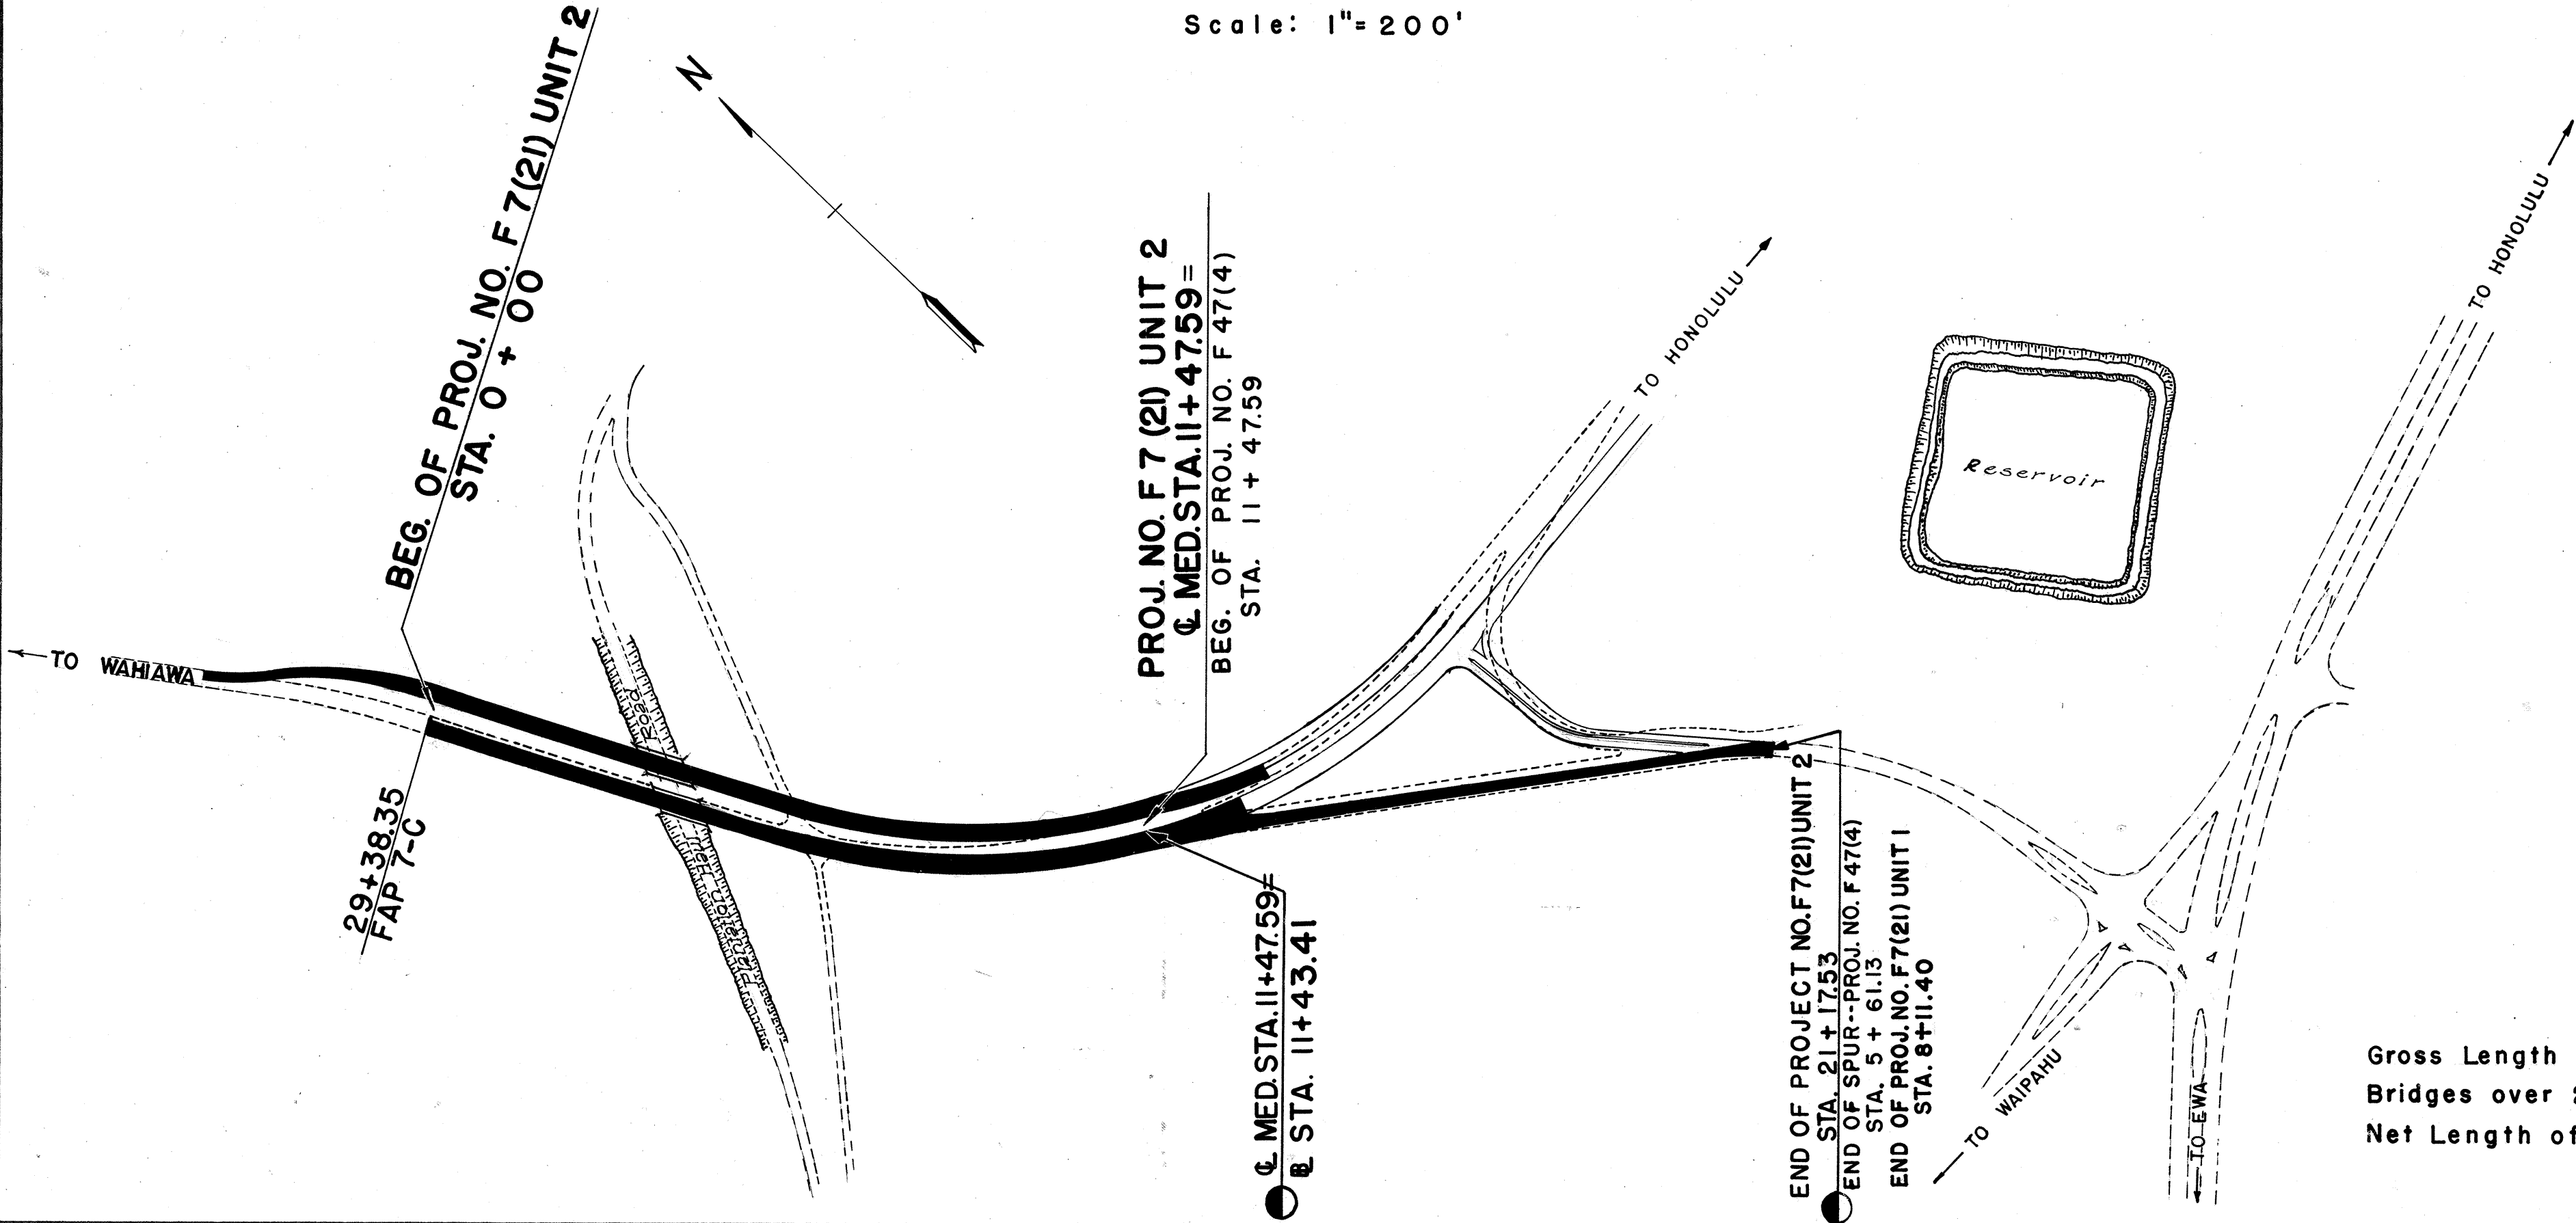

NOTE:
ALL CHANGES MADE DURING CONSTRUCTION
HAVE BEEN NOTED IN RED ON THESE TRACINGS
AND CHECKED BY:

Arthur C. Jones
RESIDENT ENGINEER
Apr 6, 1954
DATE

Gross Length of Project..... 0.402 Mile
Bridges over 20 ft. Span..... 0.012 "
Net Length of Roadway... 0.390 "

APPROVED
[Signature]
TERRITORIAL HIGHWAY ENGINEER

DEPARTMENT OF COMMERCE BUREAU OF PUBLIC ROADS	
RECOMMENDED FOR APPROVAL:	
DISTRICT ENGINEER	DATE
APPROVED:	
DIVISION ENGINEER	DATE