


FED. ROAD DIST. No.	STATE	FED. AID PROJ. No.	FISCAL YEAR	SHEET No.	TOTAL SHEETS
HAWAII	HAW.	F-090-1(3)	1957	2	6

FED. ROAD DIST. No.	STATE	FED. AID PROJ. No.	FISCAL YEAR	SHEET No.	TOTAL SHEETS
HAWAII	HAW.	F-092-1(3)	1957	2	6



Proj. F-092-1(3) Proj. F-090-1(3)

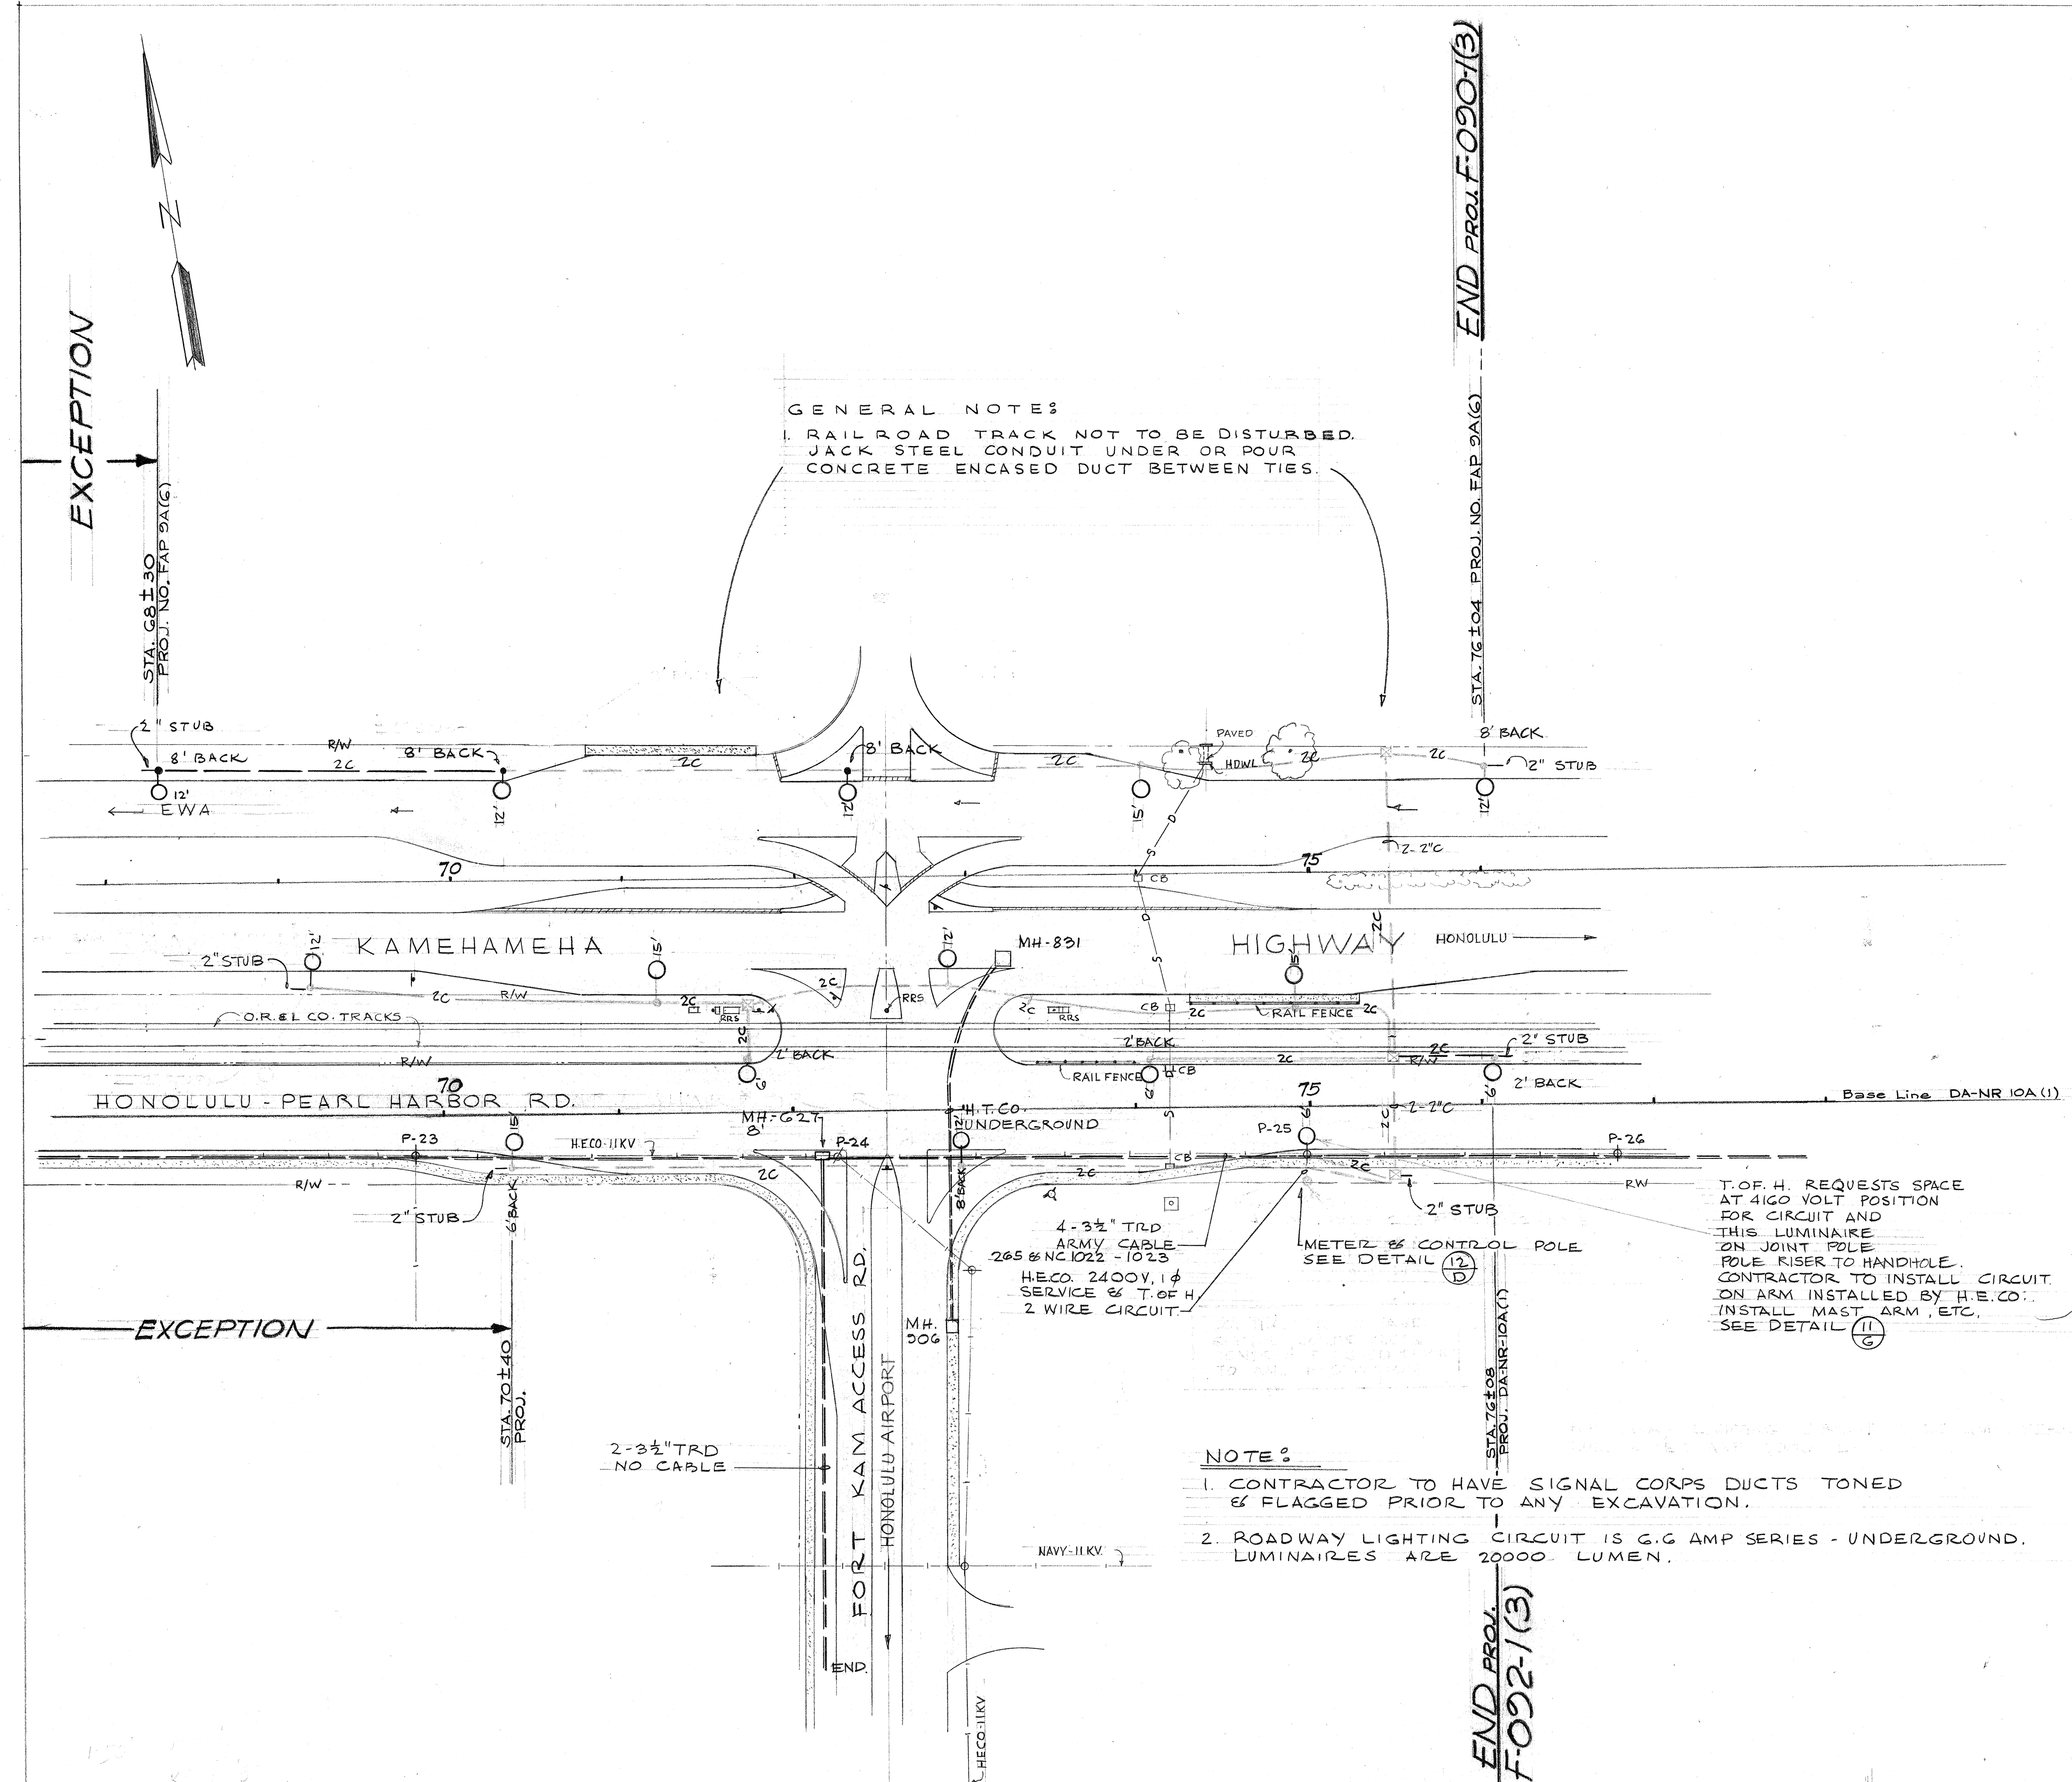

JAMES J. OBERHAUSEN
ELECTRICAL ENGINEER

TERRITORIAL HIGHWAY DEPARTMENT
TERRITORY OF HAWAII

INTERSECTION LIGHTING
KAM HIGHWAY & FORT KAM
ACCESS RD. & HONOLULU-PEARL
HARBOR RD.

PROJECT NOS. F-090-1(3) & F-092-1(3)
SCALE: 1" = 50' DATE: JUNE 1957

SHEET NO. 2 OF 5 SHEETS