
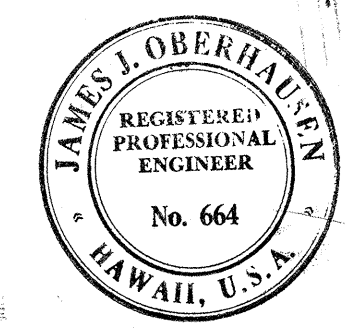


FED. ROAD DIST. No.	STATE	FED. AID PROJ. No.	FISCAL YEAR	SHEET No.	TOTAL SHEETS
HAWAII	HAW.	F090-1(3)	1957	3	6

FED. ROAD DIST. No.	STATE	FED. AID PROJ. No.	FISCAL YEAR	SHEET No.	TOTAL SHEETS
HAWAII	HAW.	F092-1(3)	1957	3	6

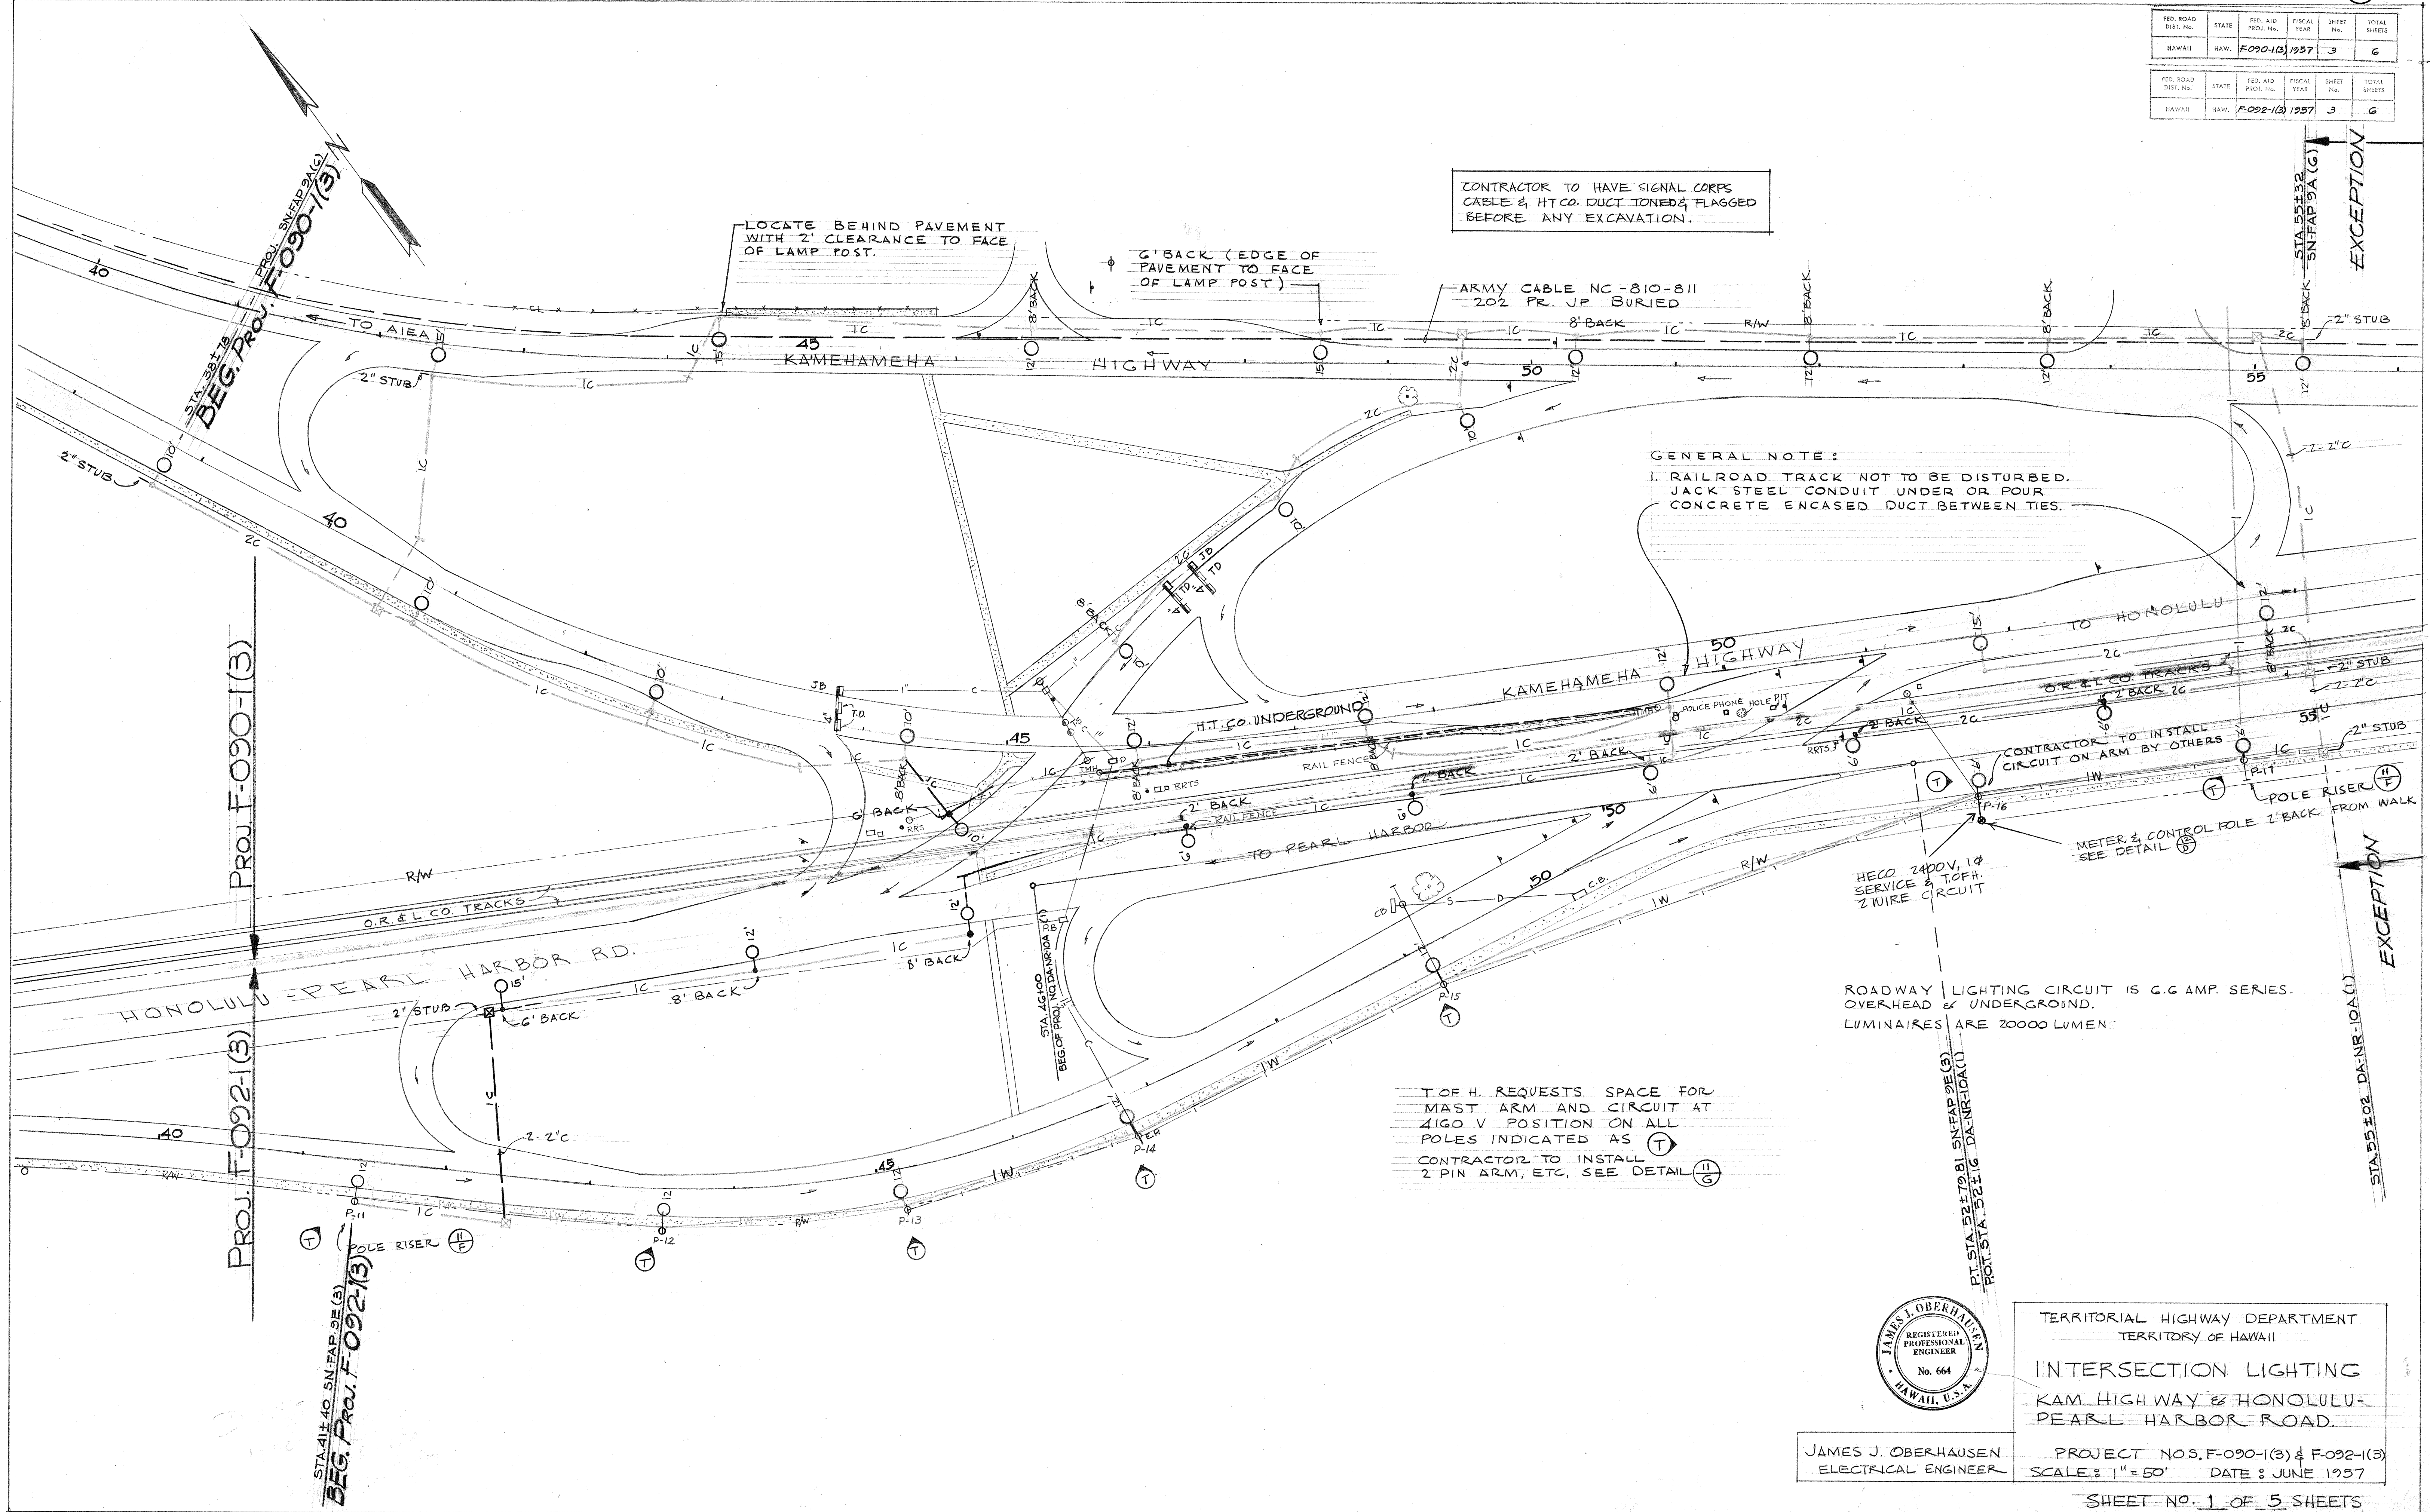

TERRITORIAL HIGHWAY DEPARTMENT
TERRITORY OF HAWAII

INTERSECTION LIGHTING
KAM. HIGHWAY & HONOLULU-
PEARL HARBOR ROAD.

JAMES J. OBERHAUSEN
ELECTRICAL ENGINEER

PROJECT NOS. F-090-1(3) & F-092-1(3)
SCALE: 1" = 50' DATE: JUNE 1957

SHEET NO. 1 OF 5 SHEETS